


# 30街区 画地出来形確認図 (6753.21m<sup>2</sup>)



S=1/500

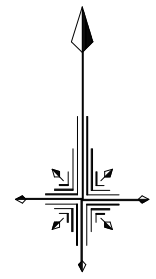


# 面積計算書 (座標法)

世界測地系 (測地成果2011)

所在	地番	公簿地目	現況地目	地積	所有者
前橋市六供町一丁目	30-1			221.34 m <sup>2</sup>	

点名	X座標	Y座標	辺長	方向角	測角	DX	倍積 (Y×DX)
30-101	41663.073	-68337.816	16.413	348-16-21	90-00-43	18.864	-1289124.561024
30-8	41679.143	-68341.152	10.900	258-13-56	89-57-35	13.847	-946319.931744
30-2	41676.920	-68351.823	4.001	213-21-23	135-07-27	-5.565	380377.894995
30-1	41673.578	-68354.023	13.583	168-16-02	134-54-39	-16.641	1137479.296743
30-102	41660.279	-68351.261	13.732	78-15-38	89-59-36	-10.505	718029.996805

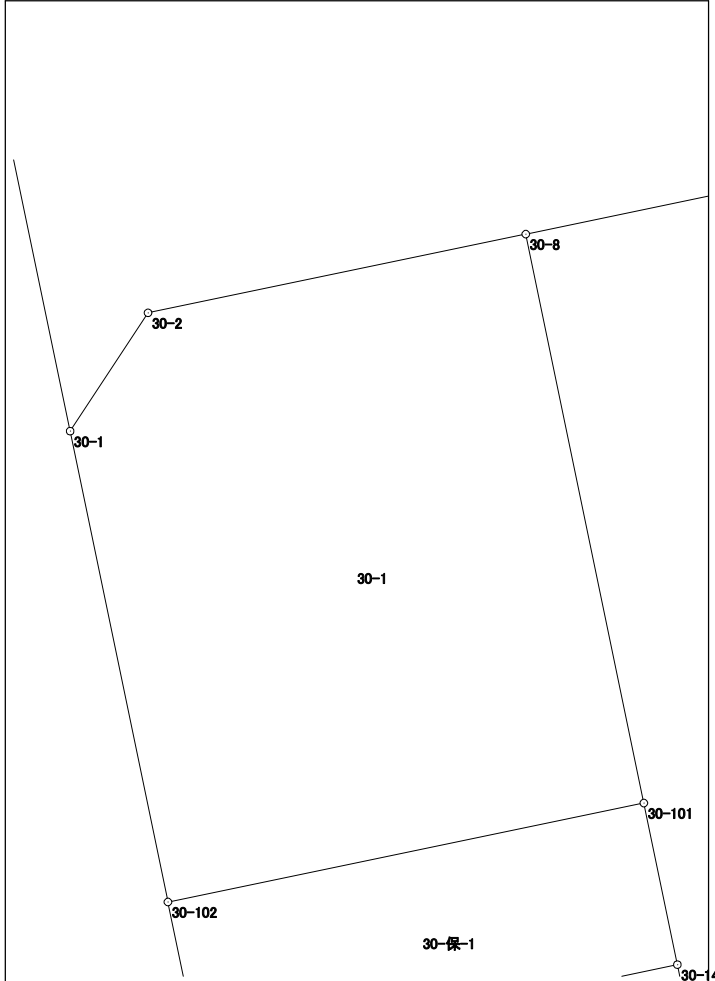

倍面積	442.695775
面積	221.3478875


# 面積計算書 (座標法)

世界測地系 (測地成果2011)

所在	地番	公簿地目	現況地目	地積	所有者
前橋市六供町一丁目	30-2			100.22 m <sup>2</sup>	

点名	X座標	Y座標	辺長	方向角	測角	Dx	倍積 (Y×Dx)
30-105	41649.294	-68334.955	7.300	348-15-44	89-59-55	9.940	-679249.452700
30-104	41656.441	-68336.440	13.730	258-15-46	90-00-02	4.354	-297536.859760
30-103	41653.648	-68349.883	7.299	168-16-11	90-00-25	-9.940	679397.837020
30-106	41646.501	-68348.399	13.731	78-15-49	89-59-38	-4.354	297588.929246

倍面積	200.453806
面積	100.2269030

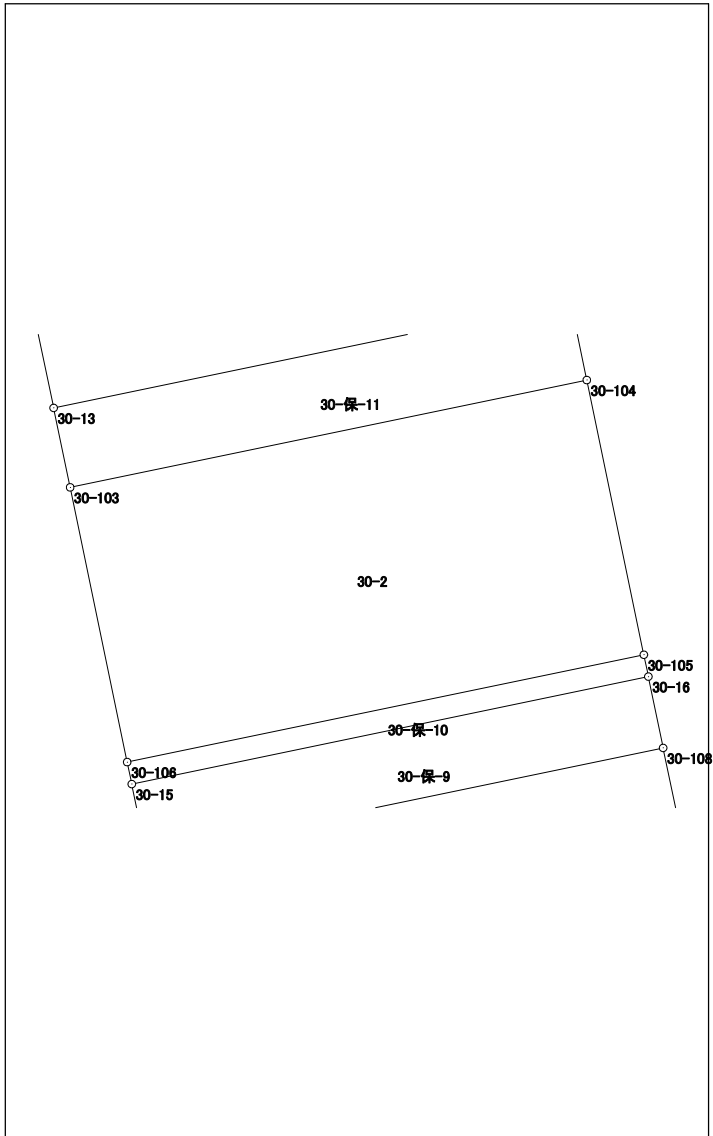


# 面積計算書（座標法）

世界測地系（測地成果2011）

所在	地番	公簿地目	現況地目	地積	所有者
前橋市六供町一丁目	30-3			88.42 m <sup>2</sup>	

点名	X座標	Y座標	辺長	方向角	測角	DX	倍積 (Y×DX)
30-107	41644.075	-68347.896	6.440	168-17-26	90-02-09	-9.101	622034.201496
30-17	41637.769	-68346.589	13.723	78-15-25	89-57-59	-3.513	240101.567157
30-18	41640.562	-68333.153	0.136	351-05-36	92-50-11	2.927	-200011.138831
30-28	41640.696	-68333.174	6.305	348-17-46	177-12-10	6.308	-431045.661592
30-108	41646.870	-68334.453	13.730	258-15-17	89-57-31	3.379	-230902.116687

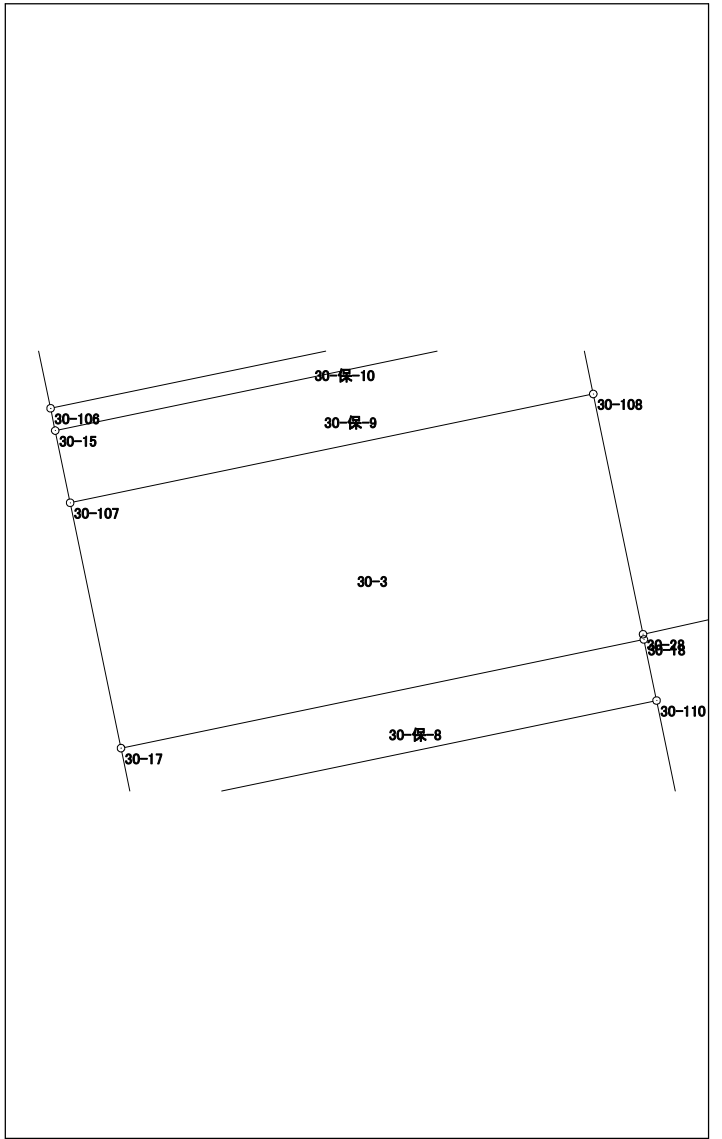


倍面積	176.851543
面積	88.4257715

# 面積計算書 (座標法)

世界測地系 (測地成果2011)

所 在	地 番	公簿地目	現況地目	地 積	所 有 者
前橋市六供町一丁目	30-4			76.32 m <sup>2</sup>	

点 名	X 座標	Y 座標	辺 長	方 向 角	測 角	DX	倍 積 (Y×DX)
30-109	41636.199	-68346.263	5.560	168-15-49	90-00-36	-8.238	563036.514594
30-142	41630.755	-68345.132	13.729	78-15-11	89-59-22	-2.649	181046.254668
30-152	41633.550	-68331.691	5.560	348-13-16	89-58-05	8.238	-562916.470458
30-110	41638.993	-68332.826	13.724	258-15-13	90-01-57	2.649	-181013.656074
						倍面積	152.642730
						面 積	76.3213650

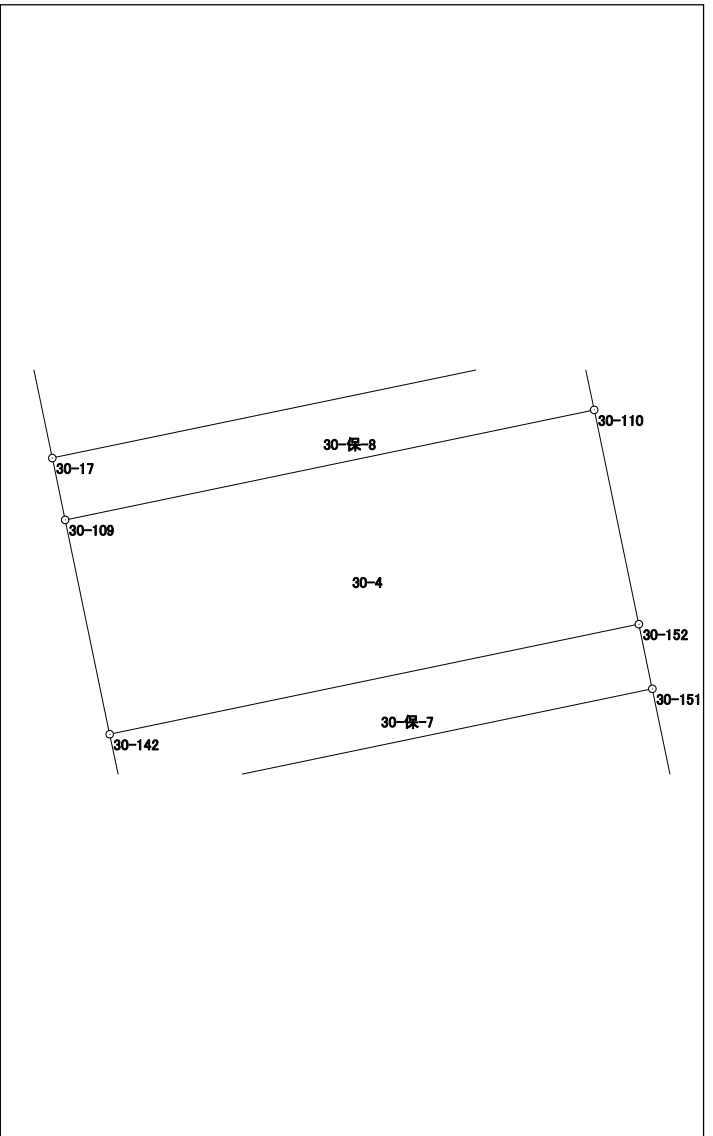


# 面積計算書（座標法）

世界測地系（測地成果2011）

所在	地番	公簿地目	現況地目	地積	所有者
前橋市六供町一丁目	30-5			84.34 m <sup>2</sup>	

点名	X座標	Y座標	辺長	方向角	測角	DX	倍積 (Y×DX)
30-150	41629.114	-68344.791	6.145	168-16-23	90-01-24	-8.813	602322.643083
30-21	41623.097	-68343.542	9.562	78-13-16	89-56-53	-4.065	277816.498230
30-111	41625.049	-68334.181	4.172	78-13-46	180-00-30	2.803	-191540.709343
30-22	41625.900	-68330.097	6.139	348-13-57	90-00-11	6.861	-468812.795517
30-151	41631.910	-68331.349	13.730	258-14-59	90-01-02	3.214	-219616.955686
						倍面積	168.680767
						面積	84.3403835

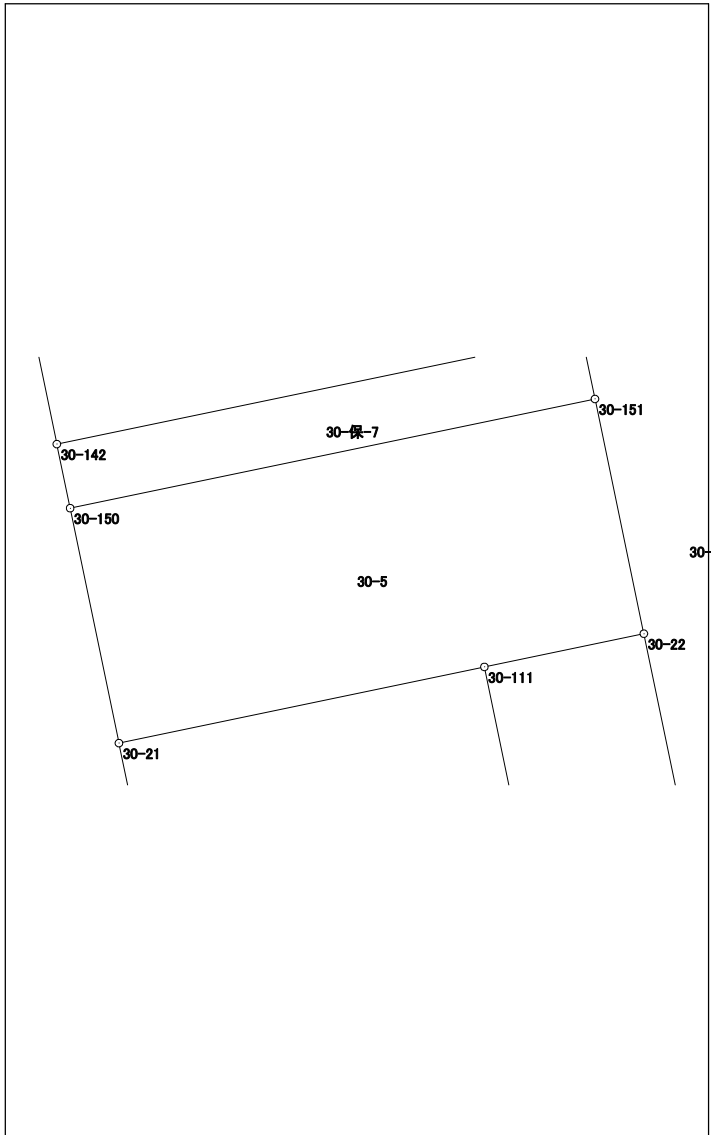


# 面積計算書 (座標法)

世界測地系 (測地成果2011)

所在	地番	公簿地目	現況地目	地積	所有者
前橋市六供町一丁目	30-6			106.20 m <sup>2</sup>	

点名	X座標	Y座標	辺長	方向角	測角	DX	倍積 (Y×DX)
30-111	41625.049	-68334.181	9.562	258-13-16	89-55-50	8.870	-606124.185470
30-21	41623.097	-68343.542	11.170	168-15-12	90-01-56	-12.888	880811.569296
30-6	41612.161	-68341.268	9.556	77-30-51	89-15-39	-8.870	606187.047160
30-112	41614.227	-68331.938	11.052	348-17-26	90-46-35	12.888	-880662.016944
						倍面積	212.414042
						面積	106.2070210

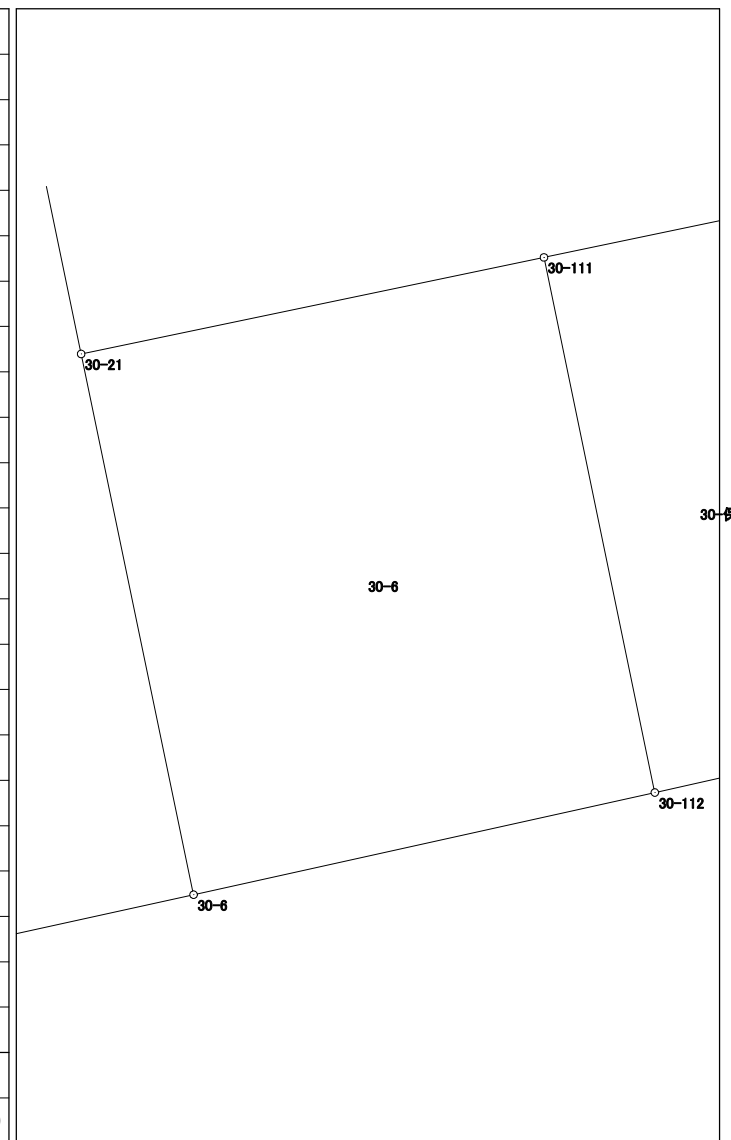


# 面積計算書 (座標法)

世界測地系 (測地成果2011)

所在	地番	公簿地目	現況地目	地積	所有者
前橋市六供町一丁目	30-7			777.68 m <sup>2</sup>	

点名	X座標	Y座標	辺長	方向角	測角	DX	倍積 (Y×DX)
30-129	41683.184	-68321.715	19.853	258-15-19	90-01-33	-1.104	75427.173360
30-8	41679.143	-68341.152	16.413	168-16-21	90-01-02	-20.111	1374408.907872
30-101	41663.073	-68337.816	4.661	168-16-40	180-00-19	-20.634	1410082.495344
30-14	41658.509	-68336.869	2.112	168-16-49	180-00-09	-6.632	453210.115208
30-104	41656.441	-68336.440	7.300	168-15-44	179-58-55	-9.215	629720.294600
30-105	41649.294	-68334.955	0.581	168-17-02	180-01-18	-7.716	527272.512780
30-16	41648.725	-68334.837	1.894	168-18-16	180-01-14	-2.424	165643.644888
30-108	41646.870	-68334.453	6.305	168-17-46	179-59-30	-8.029	548657.323137
30-28	41640.696	-68333.174	3.252	77-33-12	89-15-26	-5.473	373987.461302
30-132	41641.397	-68329.998	12.907	77-33-42	180-00-30	3.481	-237856.723038
30-30	41644.177	-68317.394	2.682	77-33-17	179-59-35	3.358	-229409.809052
30-114	41644.755	-68314.775	1.043	77-36-08	180-02-51	0.802	-54788.449550
30-130	41644.979	-68313.756	36.025	348-13-57	90-37-49	35.492	-2424591.827952
30-149	41680.247	-68321.103	3.000	348-13-46	179-59-49	38.205	-2610207.740115

倍面積	1555.378784
面積	777.6893920

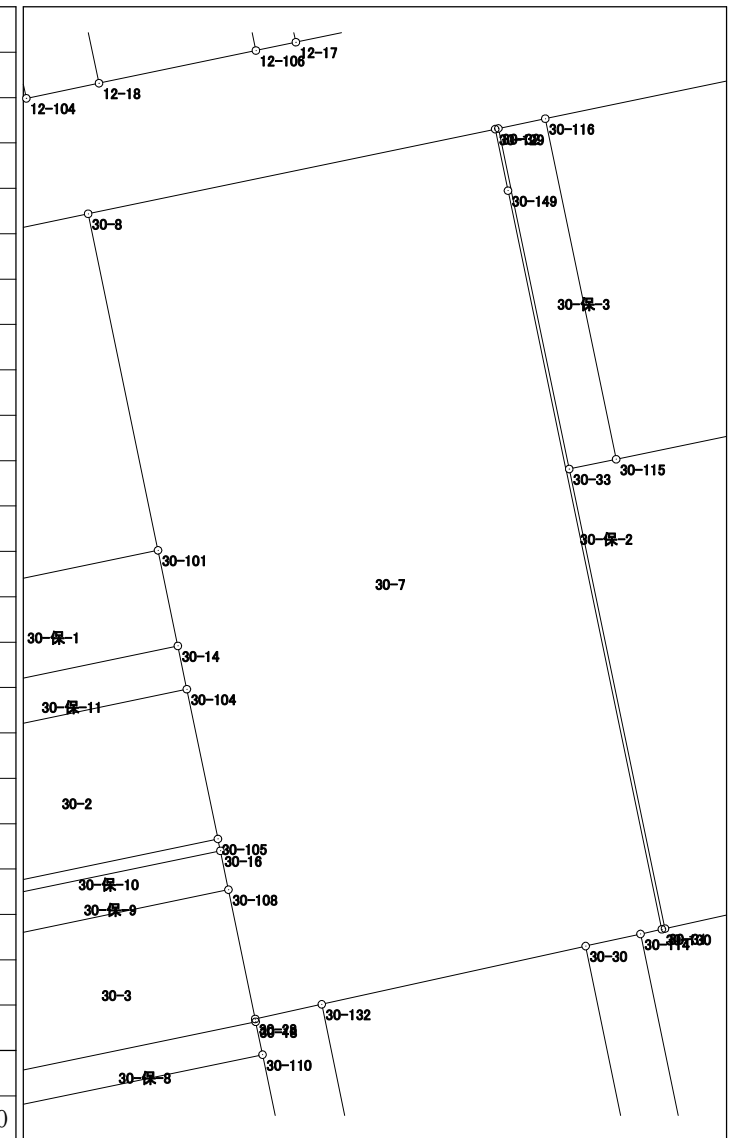






# 面積計算書（座標法）

世界測地系（測地成果2011）

所在	地番	公簿地目	現況地目	地積	所有者
前橋市六供町一丁目	30-9			706.10 m <sup>2</sup>	

点名	X座標	Y座標	辺長	方向角	測角	DX	倍積 (Y×DX)
30-33	41666.956	-68318.179	22.415	168-13-22	89-56-42	-22.408	1530873.755032
30-31	41645.013	-68313.604	18.674	77-33-21	89-19-59	-17.919	1224111.470076
30-27	41649.037	-68295.369	26.113	168-17-07	270-43-46	-21.545	1471423.725105
30-26	41623.468	-68290.067	6.004	77-40-53	89-23-46	-24.288	1658629.147296
30-23	41624.749	-68284.201	17.084	348-16-40	90-35-47	18.009	-1229730.175809
30-64	41641.477	-68287.672	25.982	348-16-05	179-59-25	42.167	-2879486.265224
30-37	41666.916	-68292.955	5.163	348-11-54	179-55-49	30.493	-2082457.076815
30-34	41671.970	-68294.011	22.394	258-16-47	90-04-53	0.505	-34488.475555
30-115	41667.421	-68315.938	2.289	258-16-40	179-59-53	-5.014	342536.113132

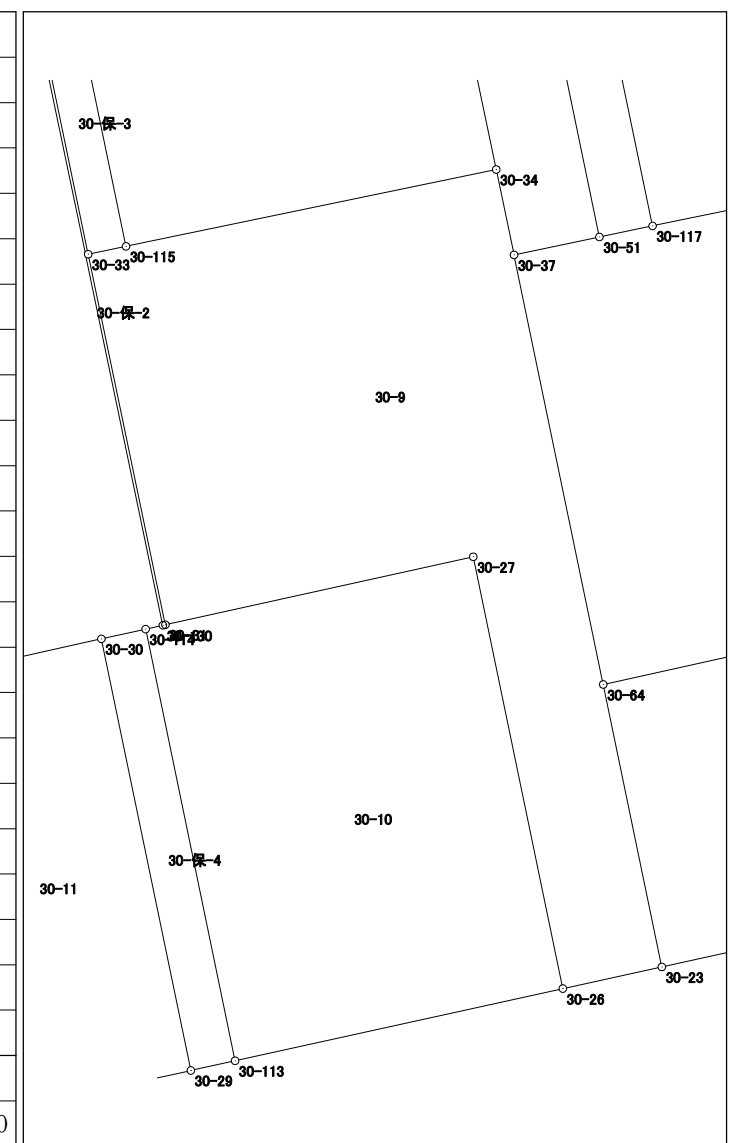


倍面積	1412.217238
面積	706.1086190

# 面積計算書 (座標法)

世界測地系 (測地成果2011)

所在	地番	公簿地目	現況地目	地積	所有者
前橋市六供町一丁目	30-10			518.84 m <sup>2</sup>	

点名	X座標	Y座標	辺長	方向角	測角	DX	倍積 (Y×DX)
30-113	41619.194	-68309.478	19.876	77-34-57	89-17-25	-21.287	1454103.858186
30-26	41623.468	-68290.067	26.113	348-17-07	90-42-10	29.843	-2037980.469481
30-27	41649.037	-68295.369	18.674	257-33-21	89-16-14	21.545	-1471423.725105
30-31	41645.013	-68313.604	0.156	257-23-29	179-50-08	-4.058	277216.605032
30-130	41644.979	-68313.756	1.043	257-36-08	180-12-39	-0.258	17624.949048
30-114	41644.755	-68314.775	26.104	168-17-32	90-41-24	-25.785	1761496.473375
						倍面積	1037.691055
						面積	518.845275

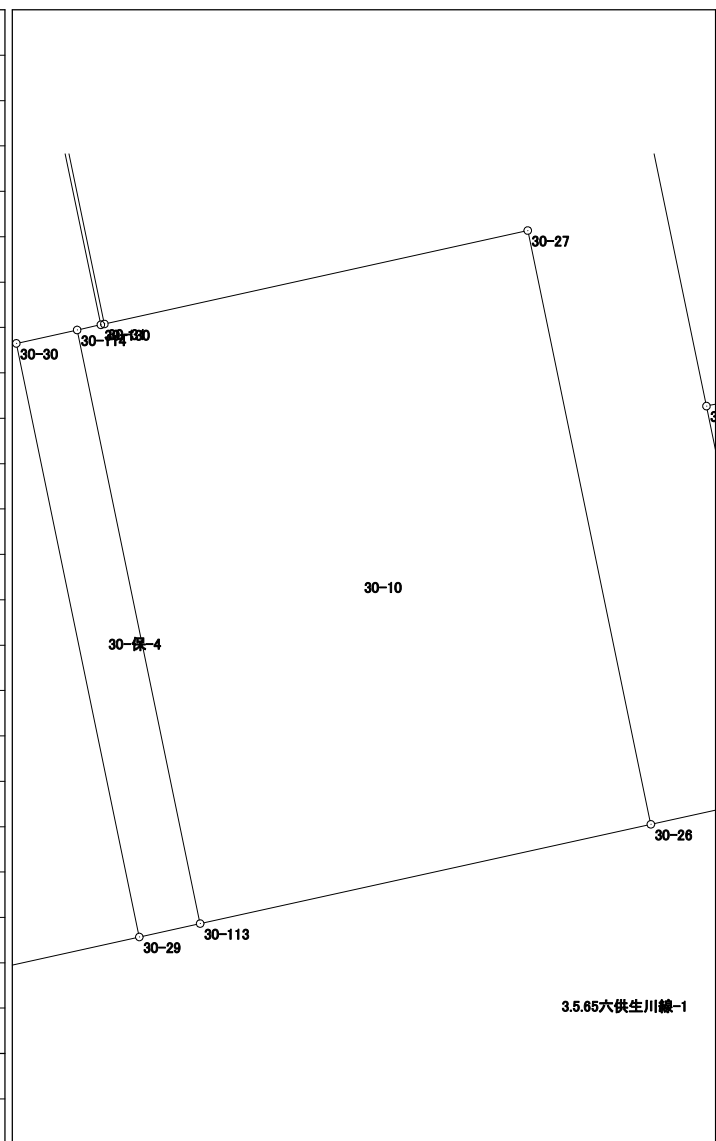


# 面積計算書（座標法）

世界測地系（測地成果2011）

所 在	地 番	公簿地目	現況地目	地 積	所 有 者
前橋市六供町一丁目	30-11			336.70 m <sup>2</sup>	

点 名	X 座標	Y 座標	辺 長	方 向 角	測 角	DX	倍 積 (Y×DX)
30-131	41615.833	-68324.682	12.889	77-31-34	89-16-24	-22.780	1556436.255960
30-29	41618.617	-68312.097	26.103	348-17-31	90-45-57	28.344	-1936238.077368
30-30	41644.177	-68317.394	12.907	257-33-42	89-16-11	22.780	-1556270.235320
30-132	41641.397	-68329.998	26.111	168-15-10	90-41-28	-28.344	1936745.463312
						倍面積	673.406584
						面 積	336.7032920

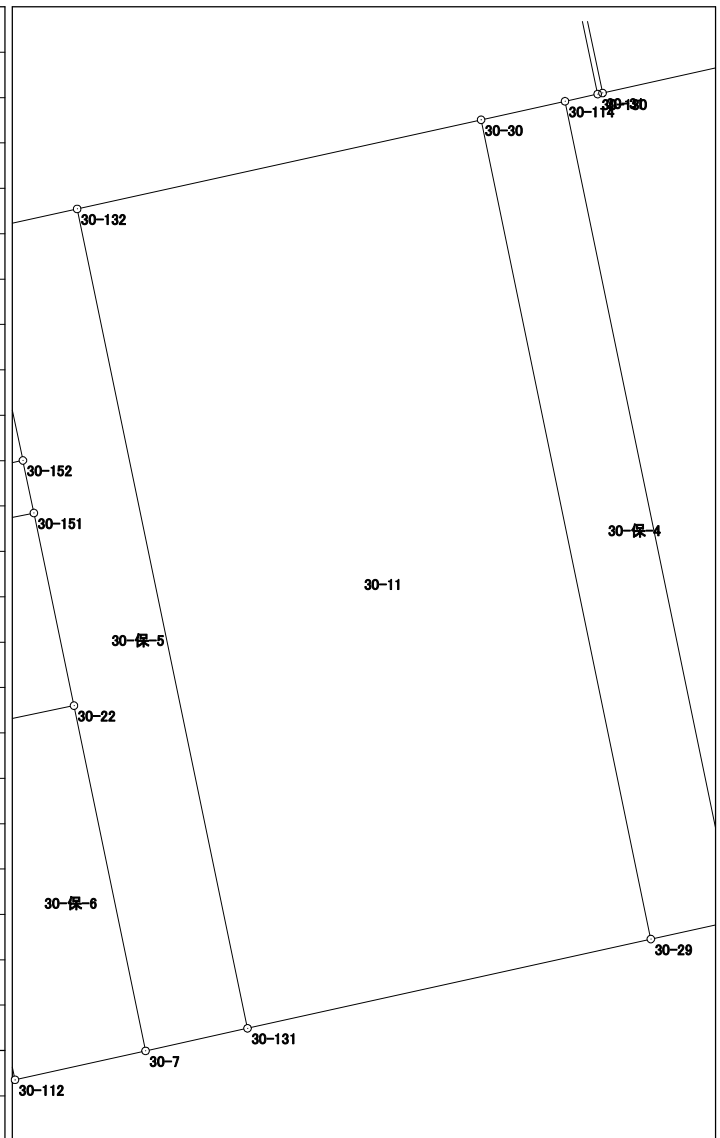


# 面積計算書（座標法）

世界測地系（測地成果2011）

所在	地番	公簿地目	現況地目	地積	所有者
前橋市六供町一丁目	30-12			324.70 m <sup>2</sup>	

点名	X座標	Y座標	辺長	方向角	測角	DX	倍積 (Y×DX)
30-117	41668.632	-68284.750	14.918	78-15-14	90-00-39	-18.277	1248040.375750
30-47	41671.669	-68270.144	19.098	348-14-18	89-59-04	21.734	-1483783.309696
30-123	41690.366	-68274.037	0.200	348-11-06	179-56-48	18.893	-1289901.381041
30-121	41690.562	-68274.078	0.790	348-14-05	180-02-59	0.969	-66157.581582
30-119	41691.335	-68274.239	1.675	348-13-14	179-59-09	2.413	-164745.738707
30-46	41692.975	-68274.581	14.916	258-17-00	90-03-46	-1.389	94833.393009
30-118	41689.946	-68289.186	21.771	168-14-35	89-57-35	-24.343	1662363.654798

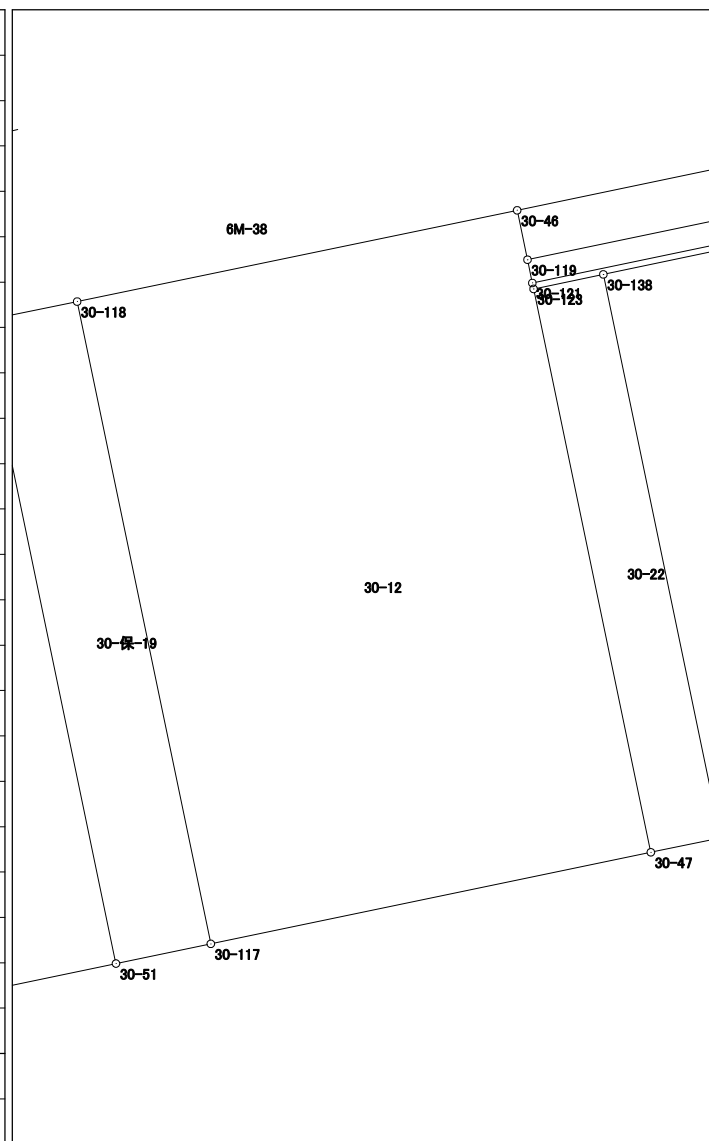


倍面積	649.412531
面積	324.7062655

# 面積計算書（座標法）

世界測地系（測地成果2011）

所在	地番	公簿地目	現況地目	地積	所有者
前橋市六供町一丁目	30-13-1			846.96 m <sup>2</sup>	

点名	X座標	Y座標	辺長	方向角	測角	DX	倍積 (Y×DX)
30-133	41672.826	-68264.585	3.313	258-14-32	89-59-37	41.152	-2809224.201920
30-137	41672.151	-68267.828	2.366	258-14-37	180-00-05	-1.157	78985.876996
30-47	41671.669	-68270.144	14.918	258-15-14	180-00-37	-3.519	240242.636736
30-117	41668.632	-68284.750	3.215	258-14-46	179-59-32	-3.692	252107.297000
30-51	41667.977	-68287.898	5.167	258-09-03	179-54-17	-1.716	117182.032968
30-37	41666.916	-68292.955	25.982	168-16-05	90-07-02	-26.500	1809763.307500
30-64	41641.477	-68287.672	23.214	77-33-51	89-17-46	-20.440	1395800.015680
30-63	41646.476	-68265.003	17.077	168-16-58	270-43-07	-11.722	800202.365166
30-62	41629.755	-68261.535	5.786	77-35-06	89-18-08	-15.477	1056483.777195
30-134	41630.999	-68255.884	42.722	348-14-55	90-39-49	43.071	-2939849.179764
倍面積							1693.927557
面積							846.9637785

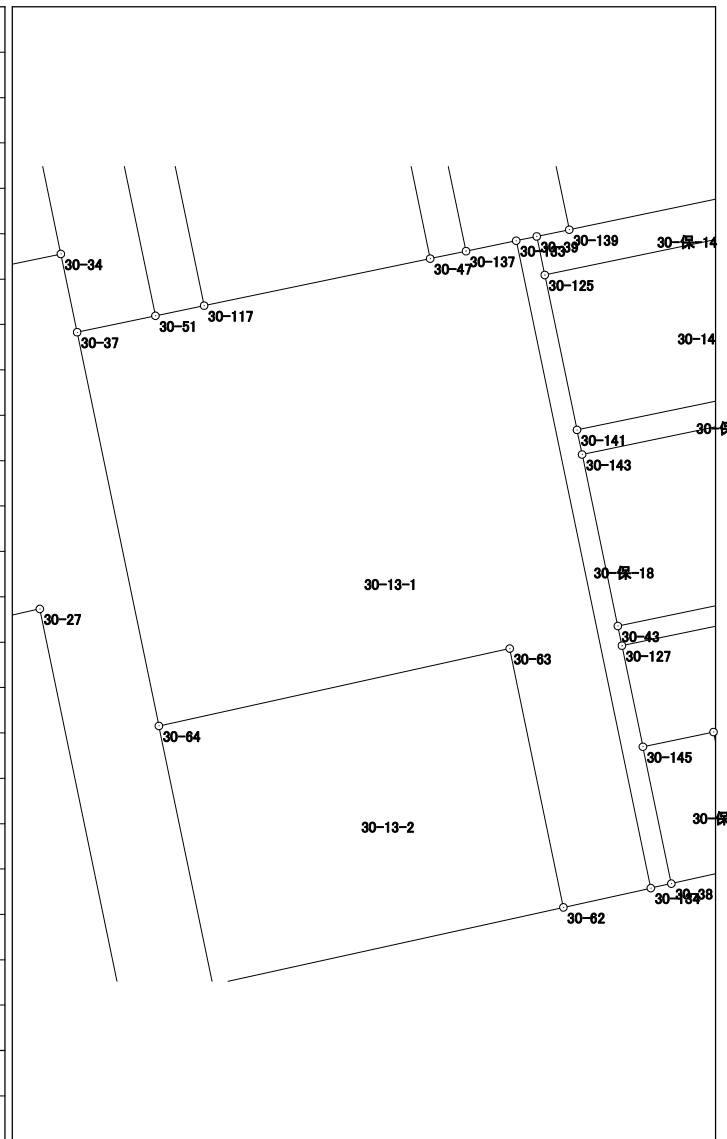


# 面積計算書 (座標法)

世界測地系 (測地成果2011)

所在	地番	公簿地目	現況地目	地積	所有者
前橋市六供町一丁目	30-13-2			396.45 m <sup>2</sup>	

点名	X座標	Y座標	辺長	方向角	測角	DX	倍積 (Y×DX)
30-64	41641.477	-68287.672	17.084	168-16-40	90-42-49	-21.727	1483686.249544
30-23	41624.749	-68284.201	23.212	77-32-44	89-16-04	-11.722	800427.404122
30-62	41629.755	-68261.535	17.077	348-16-58	90-44-14	21.727	-1483118.370945
30-63	41646.476	-68265.003	23.214	257-33-51	89-16-53	11.722	-800202.365166
						倍面積	792.917555
						面積	396.4587775

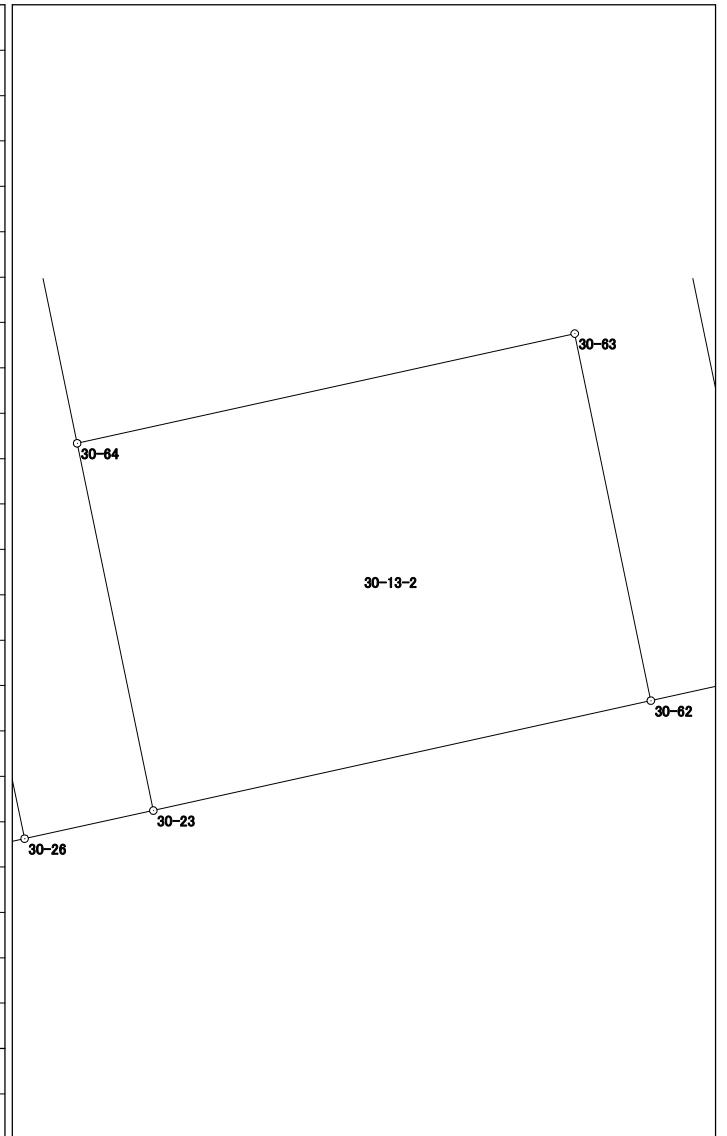






# 面積計算書 (座標法)

世界測地系 (測地成果2011)

所 在	地 番	公簿地目	現況地目	地 積	所 有 者
前橋市六供町一丁目	30-15			96.66 m <sup>2</sup>	

点 名	X 座標	Y 座標	辺 長	方 向 角	測 角	DX	倍 積 (Y×DX)
30-147	41632.291	-68250.005	10.865	77-36-04	89-20-02	-6.459	440826.782295
30-5	41634.624	-68239.393	8.855	347-56-52	90-20-48	10.993	-750155.647249
30-146	41643.284	-68241.242	10.815	258-15-28	90-18-36	6.459	-440770.182078
30-148	41641.083	-68251.831	8.980	168-16-02	90-00-34	-10.993	750292.378183
倍面積						193.331151	
面 積						96.6655755	

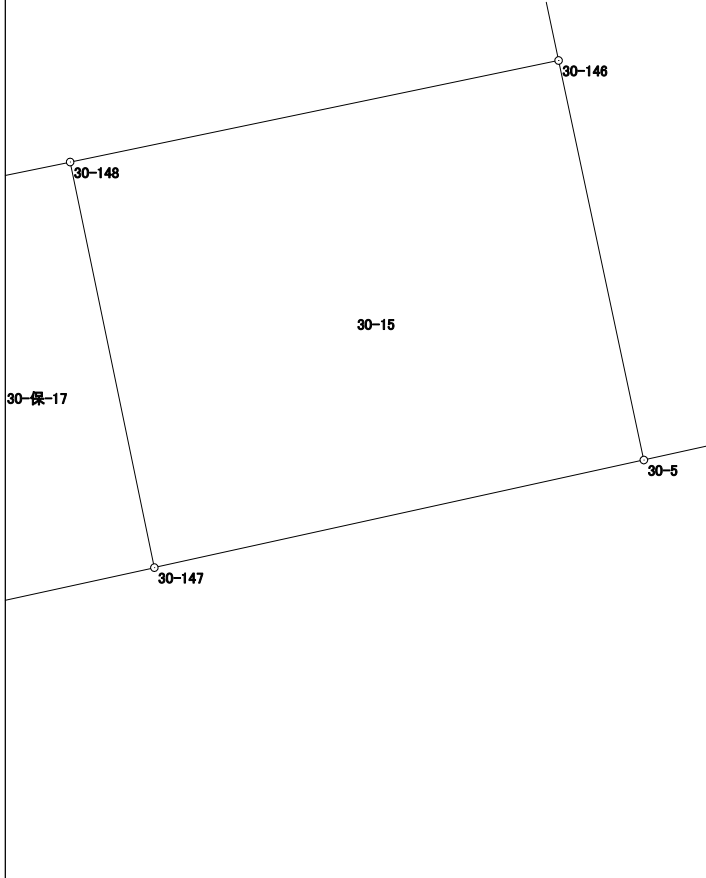




## 面積計算書（座標法）

世界測地系（測地成果2011）

所在	地番	公簿地目	現況地目	地積	所有者
前橋市六供町一丁目	30-17			174.43 m <sup>2</sup>	

点名	X座標	Y座標	辺長	方向角	測角	DX	倍積 (Y×DX)
30-143	41659.016	-68260.325	11.320	168-14-08	89-58-00	-14.211	970047.478575
30-43	41647.934	-68258.017	15.434	78-15-27	90-01-19	-7.941	542036.912997
30-42	41651.075	-68242.906	11.317	348-00-36	89-45-09	14.211	-969799.937166
30-144	41662.145	-68245.257	15.389	258-16-08	90-15-32	7.941	-541935.585837
						倍面積	348.868569
						面積	174.4342845

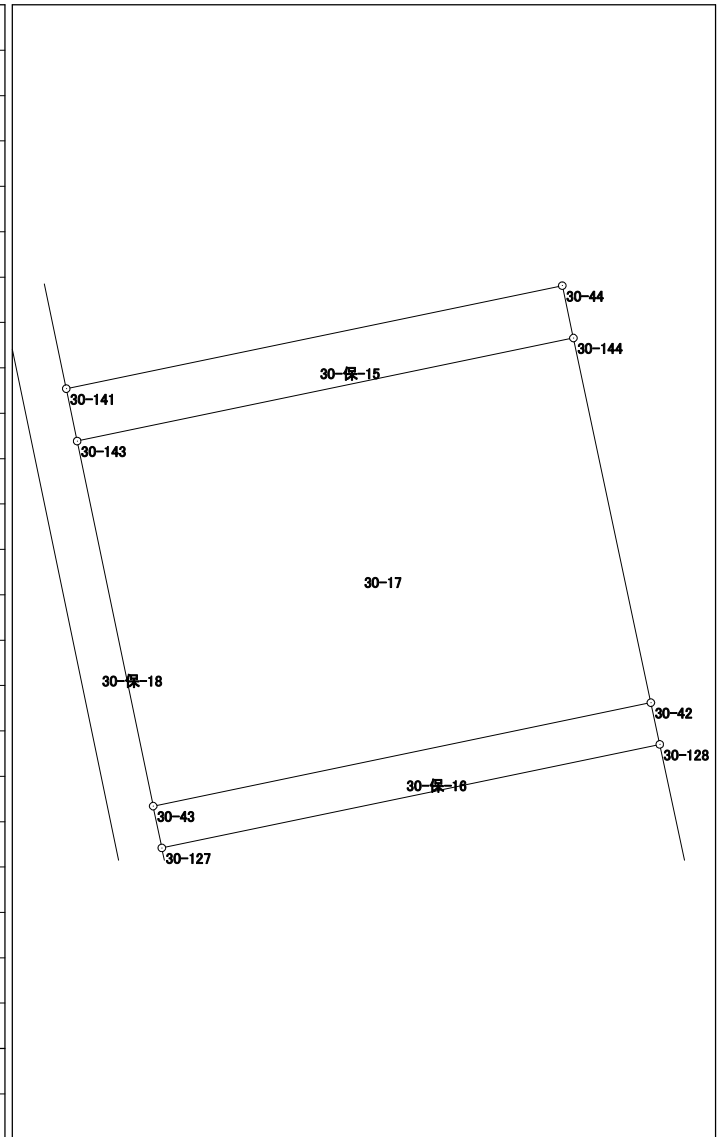


# 面積計算書 (座標法)

世界測地系 (測地成果2011)

所在	地番	公簿地目	現況地目	地積	所有者
前橋市六供町一丁目	30-18			130.15 m <sup>2</sup>	

点名	X 座標	Y 座標	辺長	方向角	測角	DX	倍積 (Y×DX)
30-138	41690.848	-68271.721	19.098	168-14-18	90-00-24	-20.087	1371374.059727
30-137	41672.151	-68267.828	3.313	78-14-32	90-00-14	-18.022	1230322.796216
30-133	41672.826	-68264.585	1.355	78-15-02	180-00-30	0.951	-64919.620335
30-39	41673.102	-68263.258	2.147	78-15-20	180-00-18	0.713	-48671.702954
30-139	41673.539	-68261.156	19.100	348-14-22	89-59-02	19.136	-1306245.481216
30-140	41692.238	-68265.049	6.815	258-13-54	89-59-32	17.309	-1181599.733141
						倍面積	260.318297
						面積	130.1591485

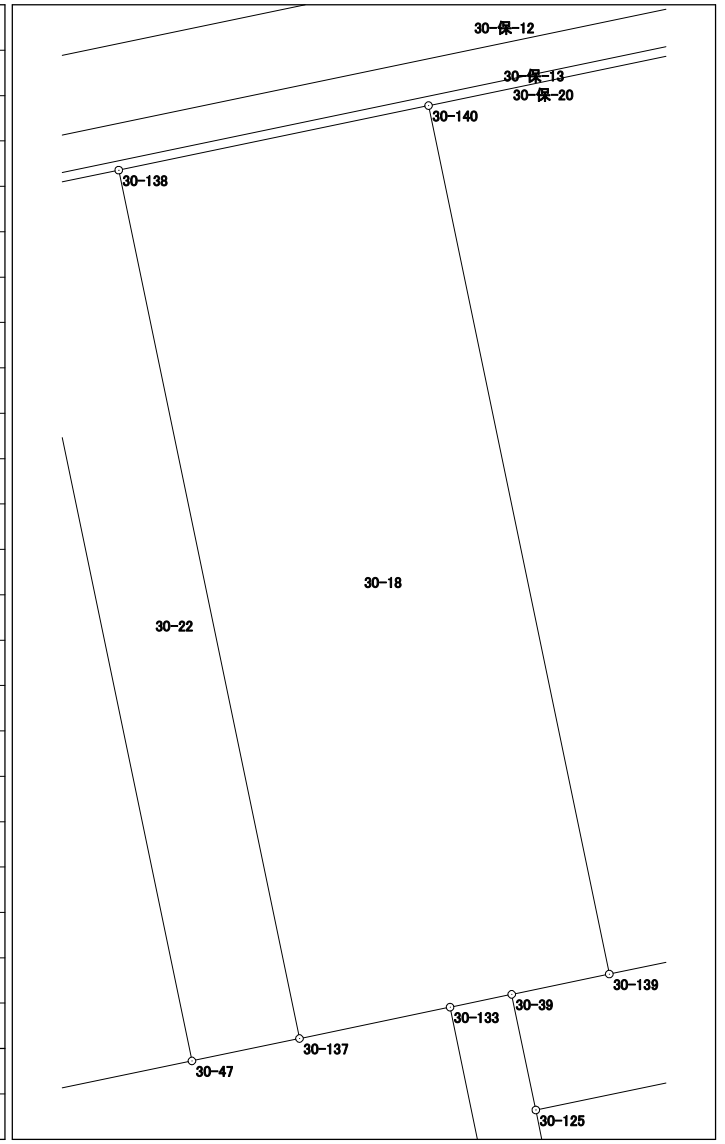


# 面積計算書 (座標法)

世界測地系 (測地成果2011)

所在	地番	公簿地目	現況地目	地積	所有者
前橋市六供町一丁目	30-19			251.24 m <sup>2</sup>	

点名	X座標	Y座標	辺長	方向角	測角	DX	倍積 (Y×DX)
30-139	41673.539	-68261.156	13.181	78-16-39	90-02-17	-16.021	1093611.980276
30-36	41676.217	-68248.250	18.925	348-03-51	89-47-12	21.194	-1446453.410500
30-4	41694.733	-68252.164	0.261	303-15-48	135-11-57	18.659	-1273517.128076
30-124	41694.876	-68252.382	12.939	258-14-09	134-58-21	-2.495	170289.693090
30-140	41692.238	-68265.049	19.100	168-14-22	90-00-13	-21.337	1456571.350513

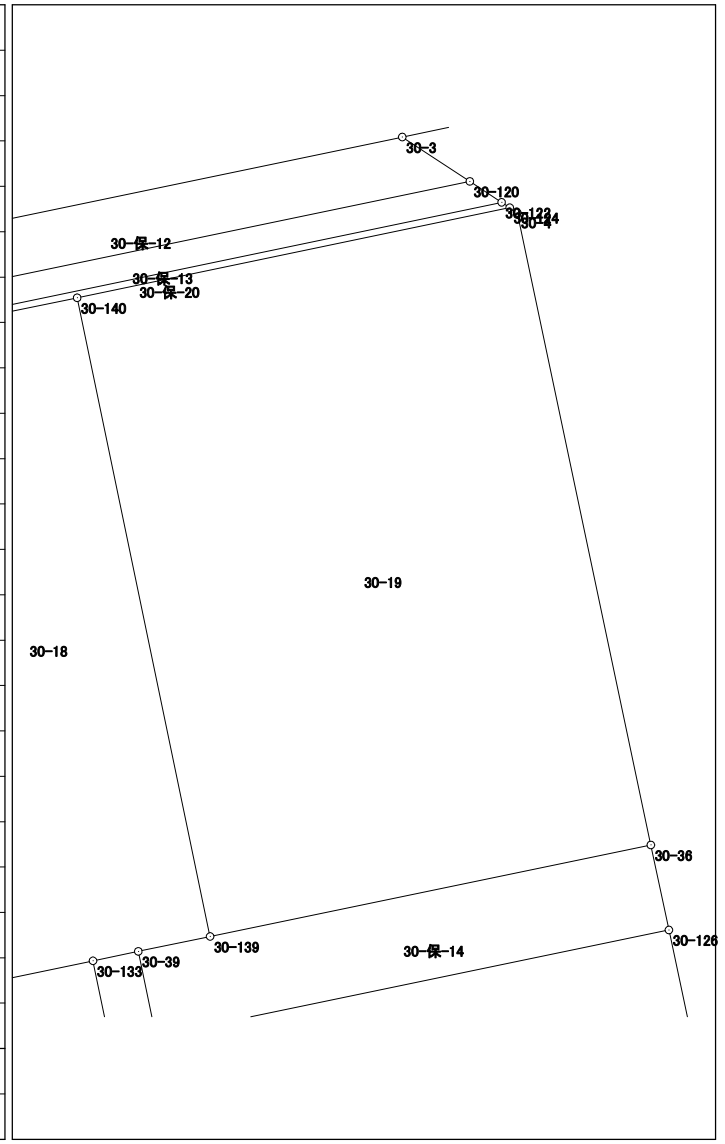


倍面積	502.485303
面積	251.2426515

# 面積計算書 (座標法)

世界測地系 (測地成果2011)

所 在	地 番	公簿地目	現況地目	地 積	所 有 者
前橋市六供町一丁目	30-22			45.17 m <sup>2</sup>	

点 名	X 座標	Y 座標	辺 長	方 向 角	測 角	DX	倍 積 (Y×DX)
30-123	41690.366	-68274.037	19.098	168-14-18	89-59-41	-19.179	1309427.755623
30-47	41671.669	-68270.144	2.366	78-14-37	90-00-19	-18.215	1243540.672960
30-137	41672.151	-68267.828	19.098	348-14-18	89-59-41	19.179	-1309308.673212
30-138	41690.848	-68271.721	2.366	258-14-37	90-00-19	18.215	-1243569.398015
倍面積						90.357356	
面 積						45.1786780	

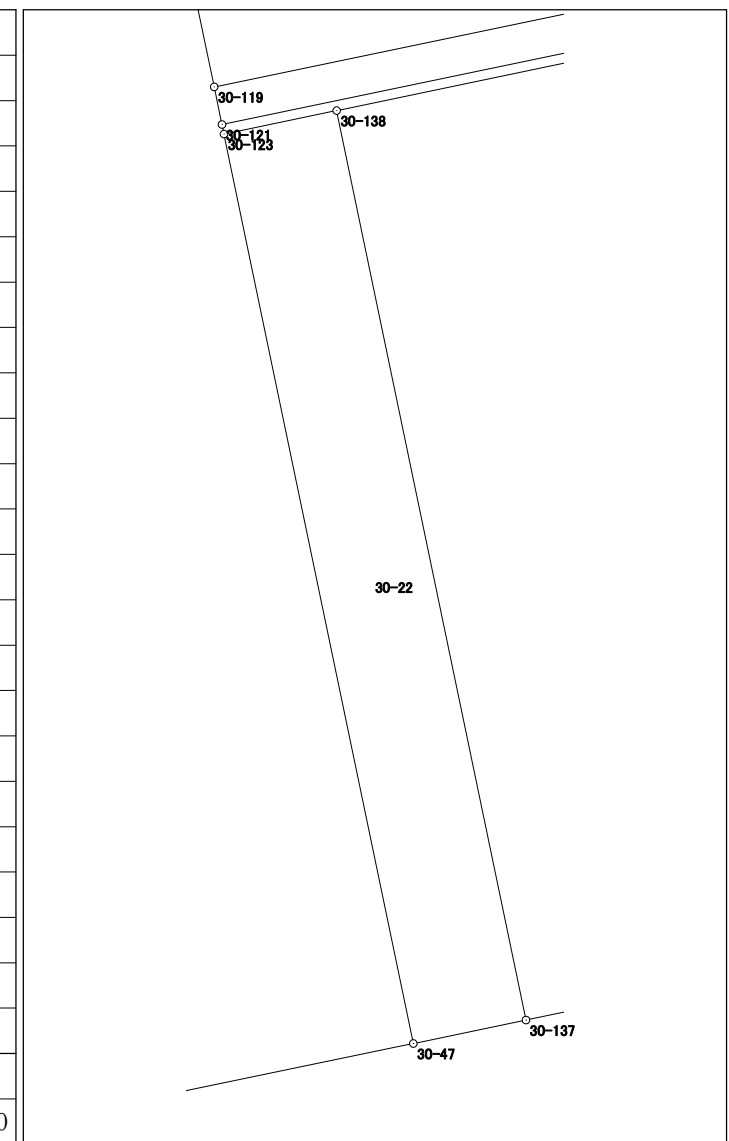

# 面積計算書（座標法）

世界測地系（測地成果2011）

所 在	地 番	公簿地目	現況地目	地 積	所 有 者
前橋市六供町一丁目	30-保-1			64.00 m <sup>2</sup>	


点 名	X 座標	Y 座標	辺 長	方 向 角	測 角	DX	倍 積 (Y×DX)	
30-13	41655.716	-68350.313	13.731	78-15-49	90-00-01	-1.770	120980.054010	
30-14	41658.509	-68336.869	4.661	348-16-40	90-00-51	7.357	-502754.345233	
30-101	41663.073	-68337.816	13.732	258-15-38	89-58-58	1.770	-120957.934320	
30-102	41660.279	-68351.261	4.660	168-15-48	90-00-10	-7.357	502860.227177	
倍面積						128.001634		
面 積						64.0008170		

## 面積計算書（座標法）

世界測地系（測地成果2011）

所 在	地 番	公簿地目	現況地目	地 積	所 有 者
前橋市六供町一丁目	30-保-2			6.00 m <sup>2</sup>	

点 名	X 座 標	Y 座 標	辺 長	方 向 角	測 角	DX	倍 積 (Y×DX)
30-31	41645.013	-68313.604	22.415	348-13-22	90-49-53	21.977	-1501328.075108
30-33	41666.956	-68318.179	16.608	348-14-49	180-01-27	38.203	-2609959.392337
30-32	41683.216	-68321.562	0.156	258-11-13	89-56-24	16.228	-1108722.308136
30-129	41683.184	-68321.715	3.000	168-13-46	90-02-33	-2.969	202847.171835
30-149	41680.247	-68321.103	36.025	168-13-57	180-00-11	-38.205	2610207.740115
30-130	41644.979	-68313.756	0.156	77-23-29	89-09-32	-35.234	2406966.878904
						倍面積	12.015273
						面 積	6.0076365

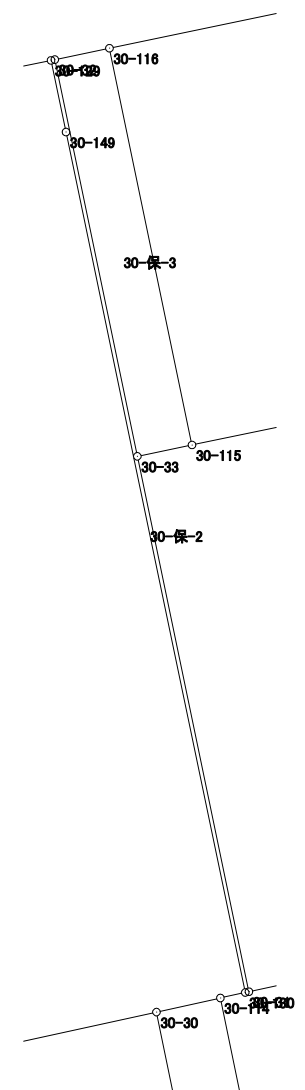




# 面積計算書 (座標法)

世界測地系 (測地成果2011)

所 在	地 番	公簿地目	現況地目	地 積	所 有 者
前橋市六供町一丁目	30-保-3			38.00 m <sup>2</sup>	

点 名	X 座標	Y 座標	辺 長	方 向 角	測 角	DX	倍 積 (Y×DX)
30-32	41683.216	-68321.562	16.608	168-14-49	89-59-56	-16.726	1142746.446012
30-33	41666.956	-68318.179	2.289	78-16-40	90-01-51	-15.795	1079085.637305
30-115	41667.421	-68315.938	16.609	348-14-39	89-57-59	16.726	-1142652.378988
30-116	41683.682	-68319.322	2.288	258-14-53	90-00-14	15.795	-1079103.690990
						倍面積	76.013339
						面 積	38.0066695

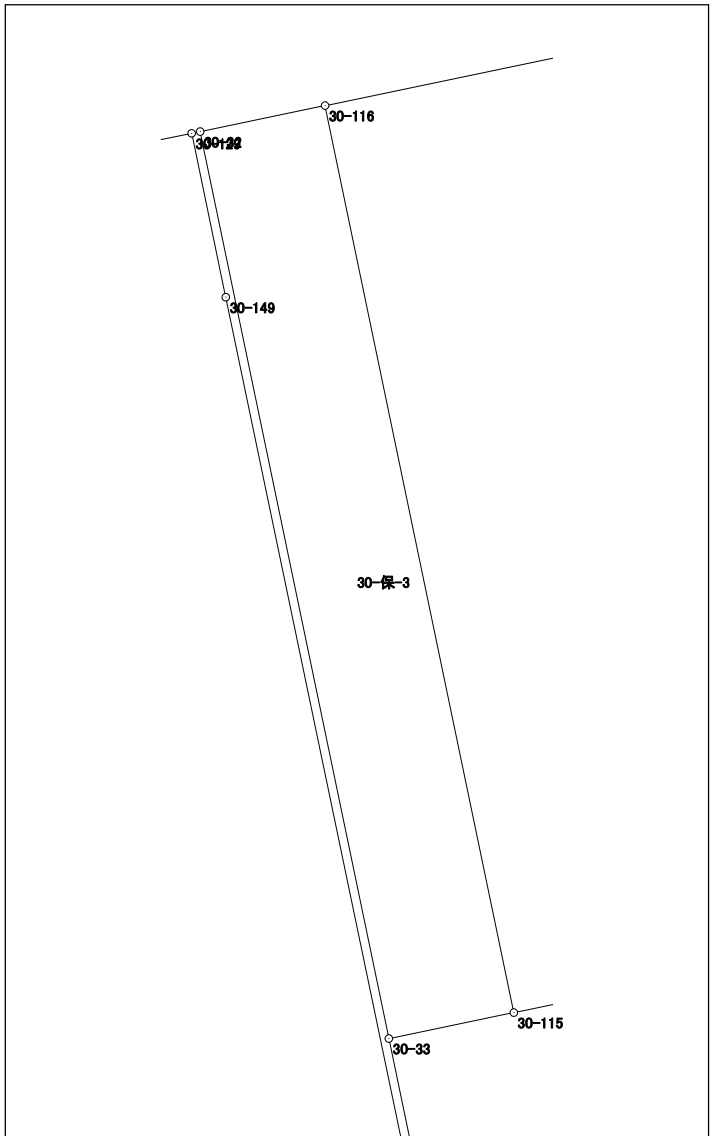


# 面積計算書 (座標法)

世界測地系 (測地成果2011)

所在	地番	公簿地目	現況地目	地積	所有者
前橋市六供町一丁目	30-保-4			70.00 m <sup>2</sup>	

点名	X座標	Y座標	辺長	方向角	測角	DX	倍積 (Y×DX)
30-29	41618.617	-68312.097	2.682	77-34-32	89-17-01	-24.983	1706641.119351
30-113	41619.194	-68309.478	26.104	348-17-32	90-43-00	26.138	-1785473.135964
30-114	41644.755	-68314.775	2.682	257-33-17	89-15-45	24.983	-1706708.023825
30-30	41644.177	-68317.394	26.103	168-17-31	90-44-14	-26.138	1785680.044372
						倍面積	140.003934
						面積	70.0019670

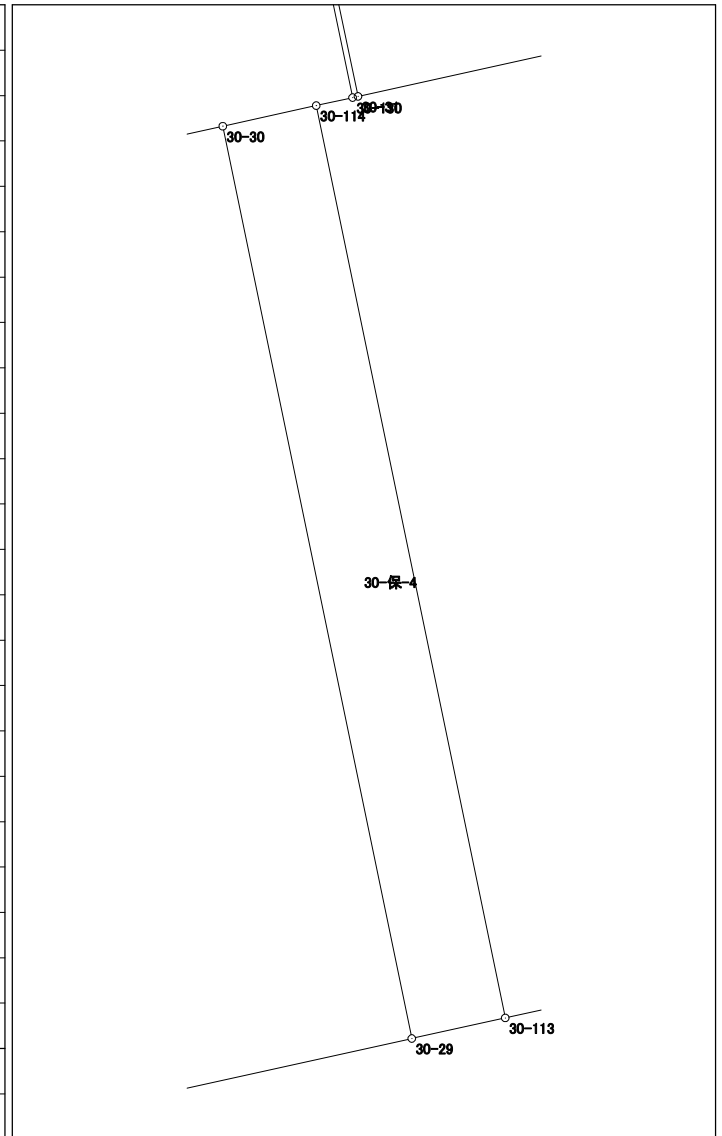




# 面積計算書 (座標法)

世界測地系 (測地成果2011)

所在	地番	公簿地目	現況地目	地積	所有者
前橋市六供町一丁目	30-保-6			46.00 m <sup>2</sup>	

点名	X座標	Y座標	辺長	方向角	測角	DX	倍積 (Y×DX)
30-22	41625.900	-68330.097	4.172	258-13-46	89-56-31	9.920	-677834.562240
30-111	41625.049	-68334.181	11.052	168-17-26	90-03-40	-11.673	797664.894813
30-112	41614.227	-68331.938	4.173	77-30-57	89-13-31	-9.920	677852.824960
30-7	41615.129	-68327.864	11.000	348-17-15	90-46-18	11.673	-797591.156472
						倍面積	92.001061
						面積	46.0005305

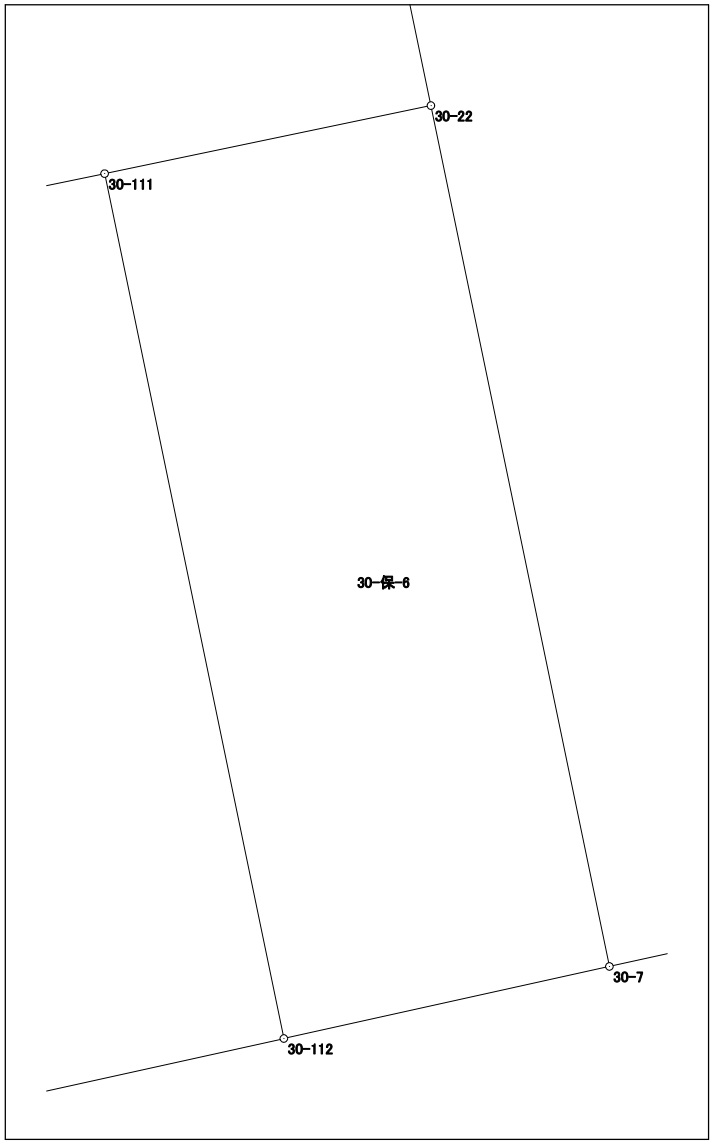


# 面積計算書（座標法）

世界測地系（測地成果2011）

所 在	地 番	公簿地目	現況地目	地 積	所 有 者
前橋市六供町一丁目	30-保-7			23.00 m <sup>2</sup>	

点 名	X 座標	Y 座標	辺 長	方 向 角	測 角	DX	倍 積 (Y×DX)
30-152	41633.550	-68331.691	13.729	258-15-11	90-01-57	-1.155	78923.103105
30-142	41630.755	-68345.132	1.676	168-15-40	90-00-29	-4.436	303179.005552
30-150	41629.114	-68344.791	13.730	78-14-59	89-59-19	1.155	-78938.233605
30-151	41631.910	-68331.349	1.675	348-13-14	89-58-15	4.436	-303117.864164
						倍面積	46.010888
						面 積	23.0054440

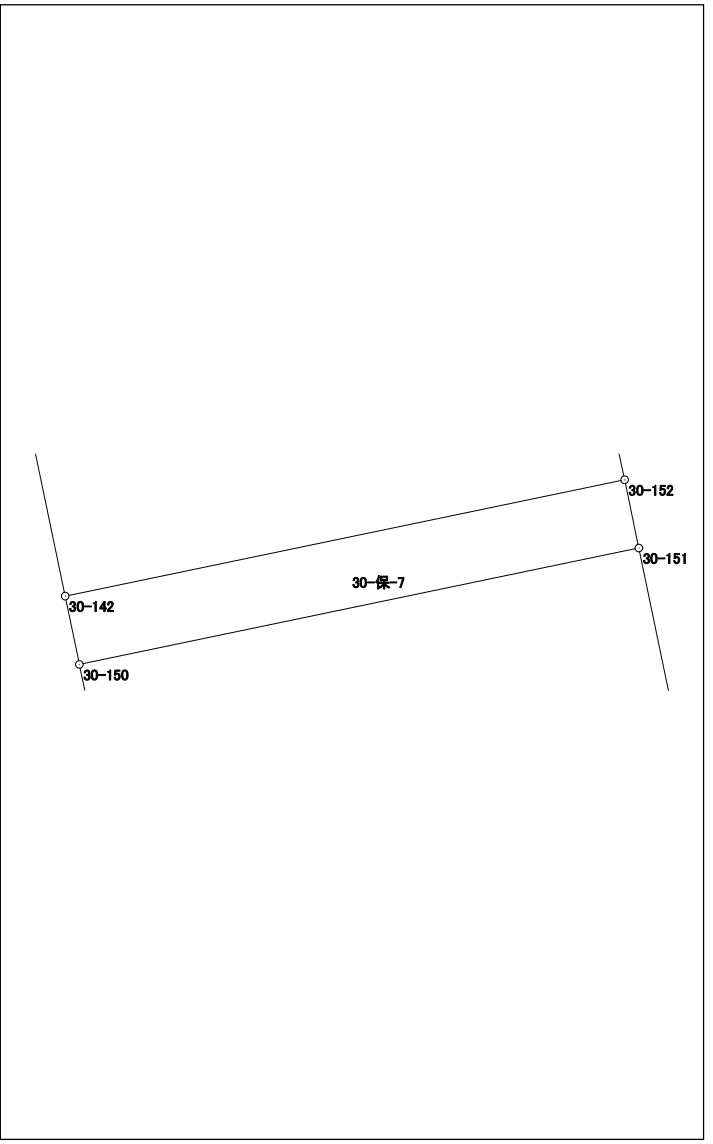


# 面積計算書（座標法）

世界測地系（測地成果2011）

所 在	地 番	公簿地目	現況地目	地 積	所 有 者
前橋市六供町一丁目	30-保-8			22.00 m <sup>2</sup>	

点 名	X 座標	Y 座標	辺 長	方 向 角	測 角	DX	倍 積 (Y×DX)
30-17	41637.769	-68346.589	1.603	168-16-11	90-00-46	-4.363	298196.167807
30-109	41636.199	-68346.263	13.724	78-15-13	89-59-02	1.224	-83655.825912
30-110	41638.993	-68332.826	1.603	348-13-38	89-58-25	4.363	-298136.119838
30-18	41640.562	-68333.153	13.723	258-15-25	90-01-47	-1.224	83639.779272
						倍面積	44.001329
						面 積	22.0006645

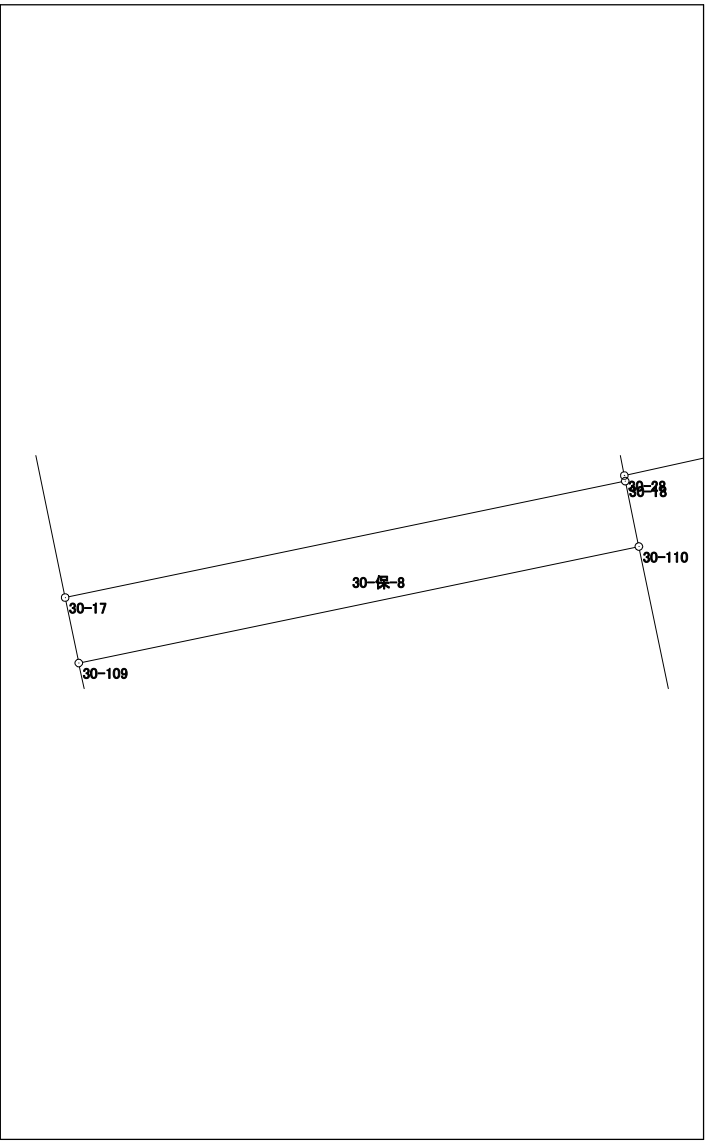

# 面積計算書（座標法）

世界測地系（測地成果2011）

所 在	地 番	公簿地目	現況地目	地 積	所 有 者
前橋市六供町一丁目	30-保-9			26.00 m <sup>2</sup>	


点 名	X 座標	Y 座標	辺 長	方 向 角	測 角	DX	倍 積 (Y×DX)		
30-15	41645.929	-68348.280	1.893	168-17-54	90-02-52	-4.650	317819.502000		
30-107	41644.075	-68347.896	13.730	78-15-17	89-57-23	0.941	-64315.370136		
30-108	41646.870	-68334.453	1.894	348-18-16	90-02-59	4.650	-317755.206450		
30-16	41648.725	-68334.837	13.731	258-15-02	89-56-46	-0.941	64303.081617		
							倍面積		52.007031
							面 積		26.0035155

## 面積計算書（座標法）

世界測地系（測地成果2011）

所 在	地 番	公簿地目	現況地目	地 積	所 有 者
前橋市六供町一丁目	30-保-10			8.00 m <sup>2</sup>	

点 名	X 座標	Y 座標	辺 長	方 向 角	測 角	DX	倍 積 (Y×DX)
30-15	41645.929	-68348.280	13.731	78-15-02	90-00-10	2.224	-152006.574720
30-16	41648.725	-68334.837	0.581	348-17-02	90-02-00	3.365	-229946.726505
30-105	41649.294	-68334.955	13.731	258-15-49	89-58-47	-2.224	151976.939920
30-106	41646.501	-68348.399	0.584	168-14-52	89-59-03	-3.365	229992.362635
						倍面積	16.001330
						面 積	8.0006650

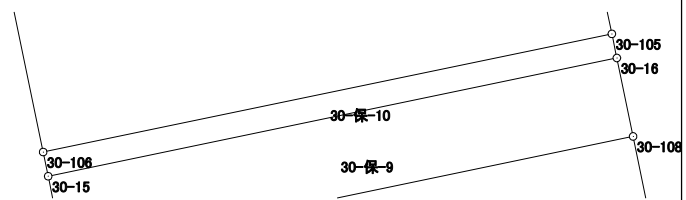




# 面積計算書（座標法）

世界測地系（測地成果2011）

所 在	地 番	公簿地目	現況地目	地 積	所 有 者
前橋市六供町一丁目	30-保-11			29.00 m <sup>2</sup>	

点 名	X 座 標	Y 座 標	辺 長	方 向 角	測 角	DX	倍 積 (Y×DX)
30-13	41655.716	-68350.313	2.112	168-15-14	89-59-25	-4.861	332250.871493
30-103	41653.648	-68349.883	13.730	78-15-46	90-00-32	0.725	-49553.665175
30-104	41656.441	-68336.440	2.112	348-16-49	90-01-03	4.861	-332183.434840
30-14	41658.509	-68336.869	13.731	258-15-49	89-59-00	-0.725	49544.230025
						倍面積	58.001503
						面 積	29.0007515

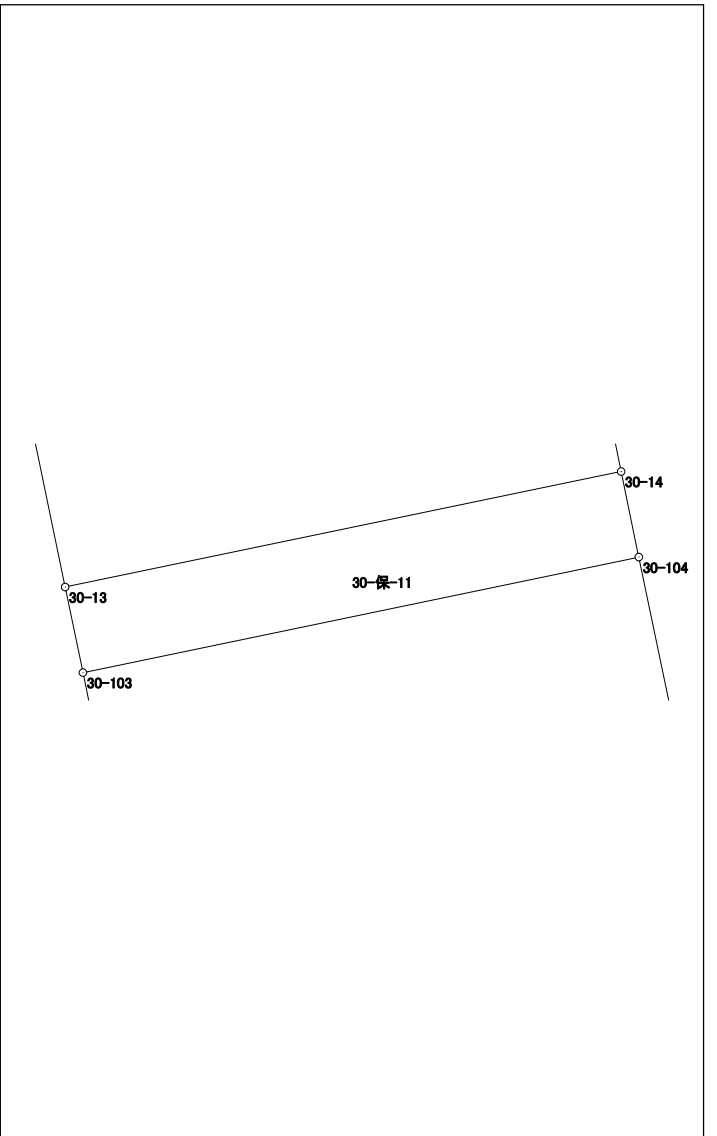


# 面積計算書 (座標法)

世界測地系 (測地成果2011)

所在	地番	公簿地目	現況地目	地積	所有者
前橋市六供町一丁目	30-保-12			34.00 m <sup>2</sup>	

点名	X座標	Y座標	辺長	方向角	測角	DX	倍積 (Y×DX)
30-46	41692.975	-68274.581	1.675	168-13-14	89-59-18	-5.609	382952.124829
30-119	41691.335	-68274.239	21.132	78-13-54	90-00-40	2.670	-182292.218130
30-120	41695.645	-68253.551	2.366	303-17-38	45-03-44	5.609	-382834.167559
30-3	41696.944	-68255.529	19.461	258-13-56	134-56-18	-2.670	182242.262430
						倍面積	68.001570
						面積	34.0007850

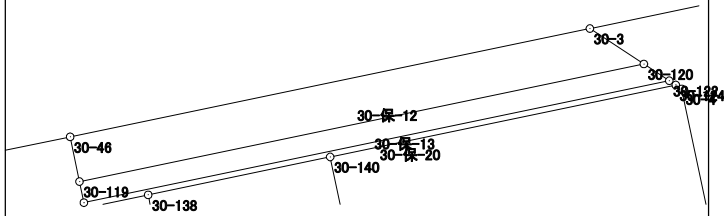


# 面積計算書（座標法）

世界測地系（測地成果2011）

所 在	地 番	公簿地目	現況地目	地 積	所 有 者
前橋市六供町一丁目	30-保-13			17.00 m <sup>2</sup>	


点 名	X 座標	Y 座標	辺 長	方 向 角	測 角	DX	倍 積 (Y×DX)
30-120	41695.645	-68253.551	21.132	258-13-54	134-53-52	-3.697	252333.378047
30-119	41691.335	-68274.239	0.790	168-14-05	90-00-11	-5.083	347037.956837
30-121	41690.562	-68274.078	21.920	78-14-00	89-59-55	3.697	-252409.266366
30-122	41695.032	-68252.619	1.116	303-20-02	45-06-02	5.083	-346928.062377
						倍面積	34.006141
						面 積	17.0030705

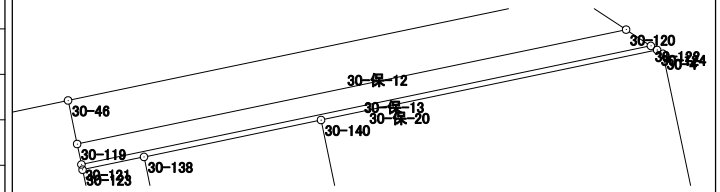

# 面積計算書 (座標法)

世界測地系 (測地成果2011)

所 在	地 番	公簿地目	現況地目	地 積	所 有 者
前橋市六供町一丁目	30-保-14			39.00 m <sup>2</sup>	

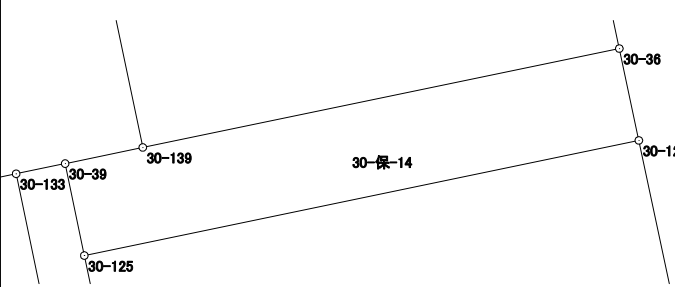点 名	X 座標	Y 座標	辺 長	方 向 角	測 角	DX	倍 積 (Y×DX)	
30-39	41673.102	-68263.258	2.544	168-13-34	89-58-14	-2.927	199806.556166	
30-125	41670.612	-68262.739	15.338	78-16-29	90-02-55	0.627	-42800.737353	
30-126	41673.729	-68247.721	2.544	347-59-47	89-43-18	5.605	-382528.476205	
30-36	41676.217	-68248.250	13.181	258-16-39	90-16-52	-0.190	12967.167500	
30-139	41673.539	-68261.156	2.147	258-15-20	179-58-41	-3.115	212633.500940	
						倍面積	78.011048	
						面 積	39.005240	




## 面積計算書 (座標法)

世界測地系 (測地成果2011)

所在	地番	公簿地目	現況地目	地積	所有者
前橋市六供町一丁目	30-保-16			20.00 m <sup>2</sup>	

点名	X座標	Y座標	辺長	方向角	測角	DX	倍積 (Y×DX)
30-43	41647.934	-68258.017	1.296	168-17-28	90-02-01	-4.410	301017.854970
30-127	41646.665	-68257.754	15.442	78-15-23	89-57-55	1.874	-127915.030996
30-128	41649.808	-68242.635	1.296	347-55-37	89-40-14	4.410	-300950.020350
30-42	41651.075	-68242.906	15.434	258-15-27	90-19-50	-1.874	127887.205844

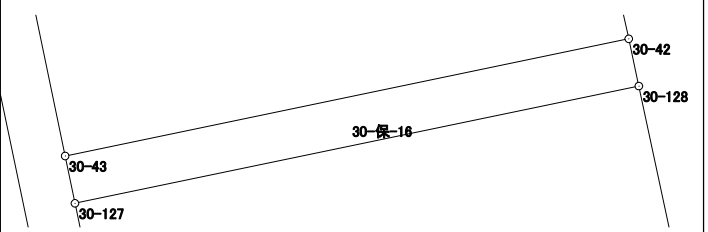


倍面積	40.009468
面積	20.0047340

# 面積計算書 (座標法)

世界測地系 (測地成果2011)

所在	地番	公簿地目	現況地目	地積	所有者
前橋市六供町一丁目	30-保-17			42.00 m <sup>2</sup>	

点名	X座標	Y座標	辺長	方向角	測角	DX	倍積 (Y×DX)
30-145	41640.134	-68256.397	9.033	168-15-57	90-00-25	-9.793	668434.895821
30-38	41631.290	-68254.560	4.664	77-36-21	89-20-24	-7.843	535320.514080
30-147	41632.291	-68250.005	8.980	348-16-02	90-39-41	9.793	-668372.298965
30-148	41641.083	-68251.831	4.664	258-15-32	89-59-30	7.843	-535299.110533

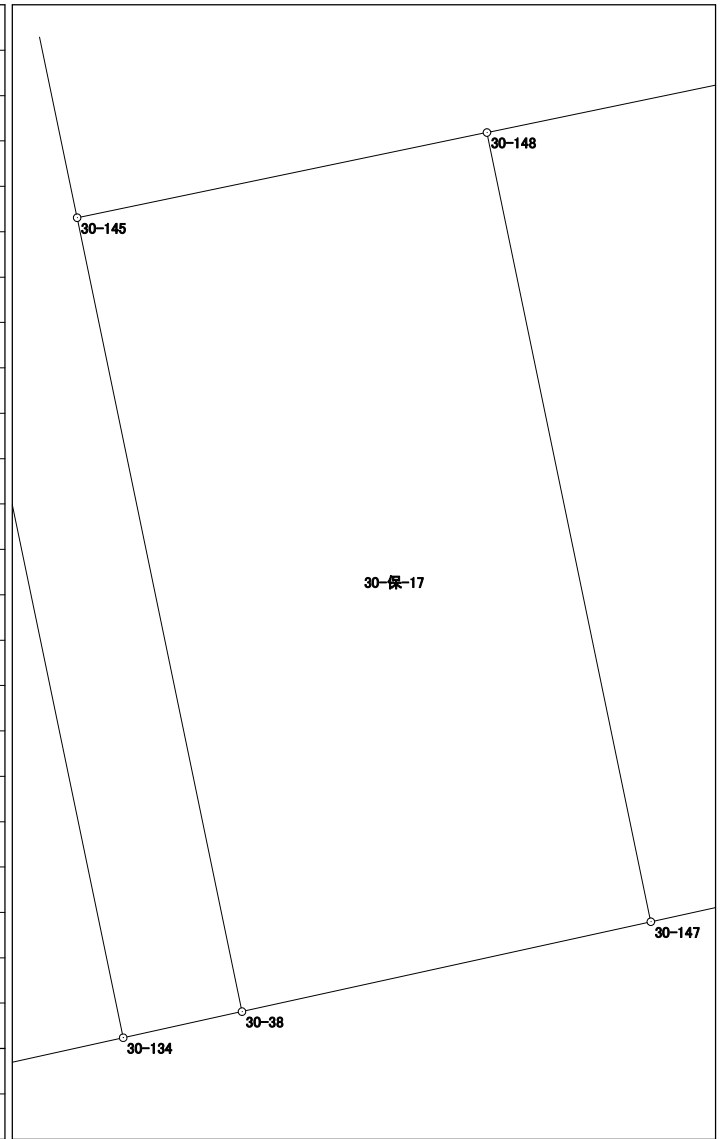


# 面積計算書 (座標法)

世界測地系 (測地成果2011)

所在	地番	公簿地目	現況地目	地積	所有者
前橋市六供町一丁目	30-保-18			58.00 m <sup>2</sup>	

点名	X座標	Y座標	辺長	方向角	測角	D <sub>X</sub>	倍積 (Y×D <sub>X</sub> )
30-43	41647.934	-68258.017	11.320	348-14-08	179-56-40	12.351	-843054.767967
30-143	41659.016	-68260.325	1.625	348-14-51	180-00-43	12.673	-865063.098725
30-141	41660.607	-68260.656	10.220	348-14-21	179-59-30	11.596	-791550.566976
30-125	41670.612	-68262.739	2.544	348-13-34	179-59-13	12.495	-852942.923805
30-39	41673.102	-68263.258	1.355	258-15-02	90-01-28	2.214	-151134.853212
30-133	41672.826	-68264.585	42.722	168-14-55	89-59-53	-42.103	2874143.822255
30-134	41630.999	-68255.884	1.356	77-36-15	89-21-20	-41.536	2835076.397824
30-38	41631.290	-68254.560	9.033	348-15-57	90-39-42	9.135	-623505.405600
30-145	41640.134	-68256.397	6.670	348-15-44	179-59-47	15.375	-1049442.103875
30-127	41646.665	-68257.754	1.296	348-17-28	180-01-44	7.800	-532410.481200
						倍面積	116.018719
						面積	58.0093595

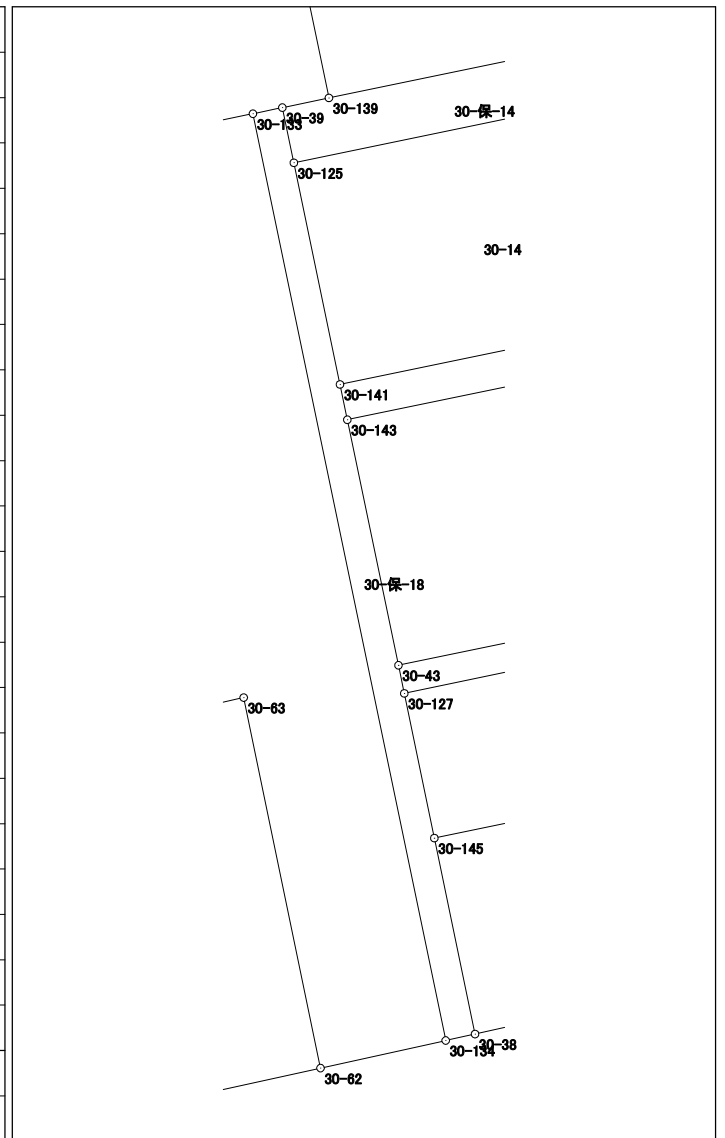





# 面積計算書 (座標法)

世界測地系 (測地成果2011)

所 在	地 番	公簿地目	現況地目	地 積	所 有 者
前橋市六供町一丁目	30-保-20			4.41 m <sup>2</sup>	

点 名	X 座標	Y 座標	辺 長	方 向 角	測 角	DX	倍 積 (Y×DX)	
30-122	41695.032	-68252.619	21.920	258-14-00	134-52-46	-4.314	294441.798366	
30-121	41690.562	-68274.078	0.200	168-11-06	89-57-06	-4.666	318566.847948	
30-123	41690.366	-68274.037	2.366	78-14-37	90-03-31	0.286	-19526.374582	
30-138	41690.848	-68271.721	6.815	78-13-54	179-59-17	1.872	-127804.661712	
30-140	41692.238	-68265.049	12.939	78-14-09	180-00-15	4.028	-274971.617372	
30-124	41694.876	-68252.382	0.284	303-21-14	45-07-05	2.794	-190697.155308	
							倍面積	8.837340
							面 積	4.4186700

## 面積計算書（座標法）

世界測地系（測地成果2011）

所 在	地 番	公簿地目	現況地目	地 積	所 有 者
前橋市六供町一丁目	30-保-21			112.64 m <sup>2</sup>	

点 名	X 座標	Y 座標	辺 長	方 向 角	測 角	DX	倍 積 (Y×DX)
30-24	41688.236	-68297.402	16.616	168-13-27	90-00-18	-17.323	1183115.894846
30-34	41671.970	-68294.011	5.163	168-11-54	179-58-27	-21.320	1456028.314520
30-37	41666.916	-68292.955	5.167	78-09-03	89-57-09	-3.993	272693.769315
30-51	41667.977	-68287.898	21.773	348-14-39	90-05-36	22.377	-1528078.293546
30-50	41689.293	-68292.334	5.177	258-13-09	89-58-30	20.259	-1383534.394506
						倍面積	225.290629
						面 積	112.6453145

