



31街区 画地出来形確認図 (2262.53m²)

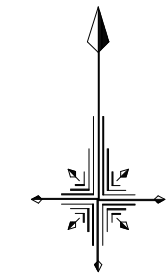

S=1/500

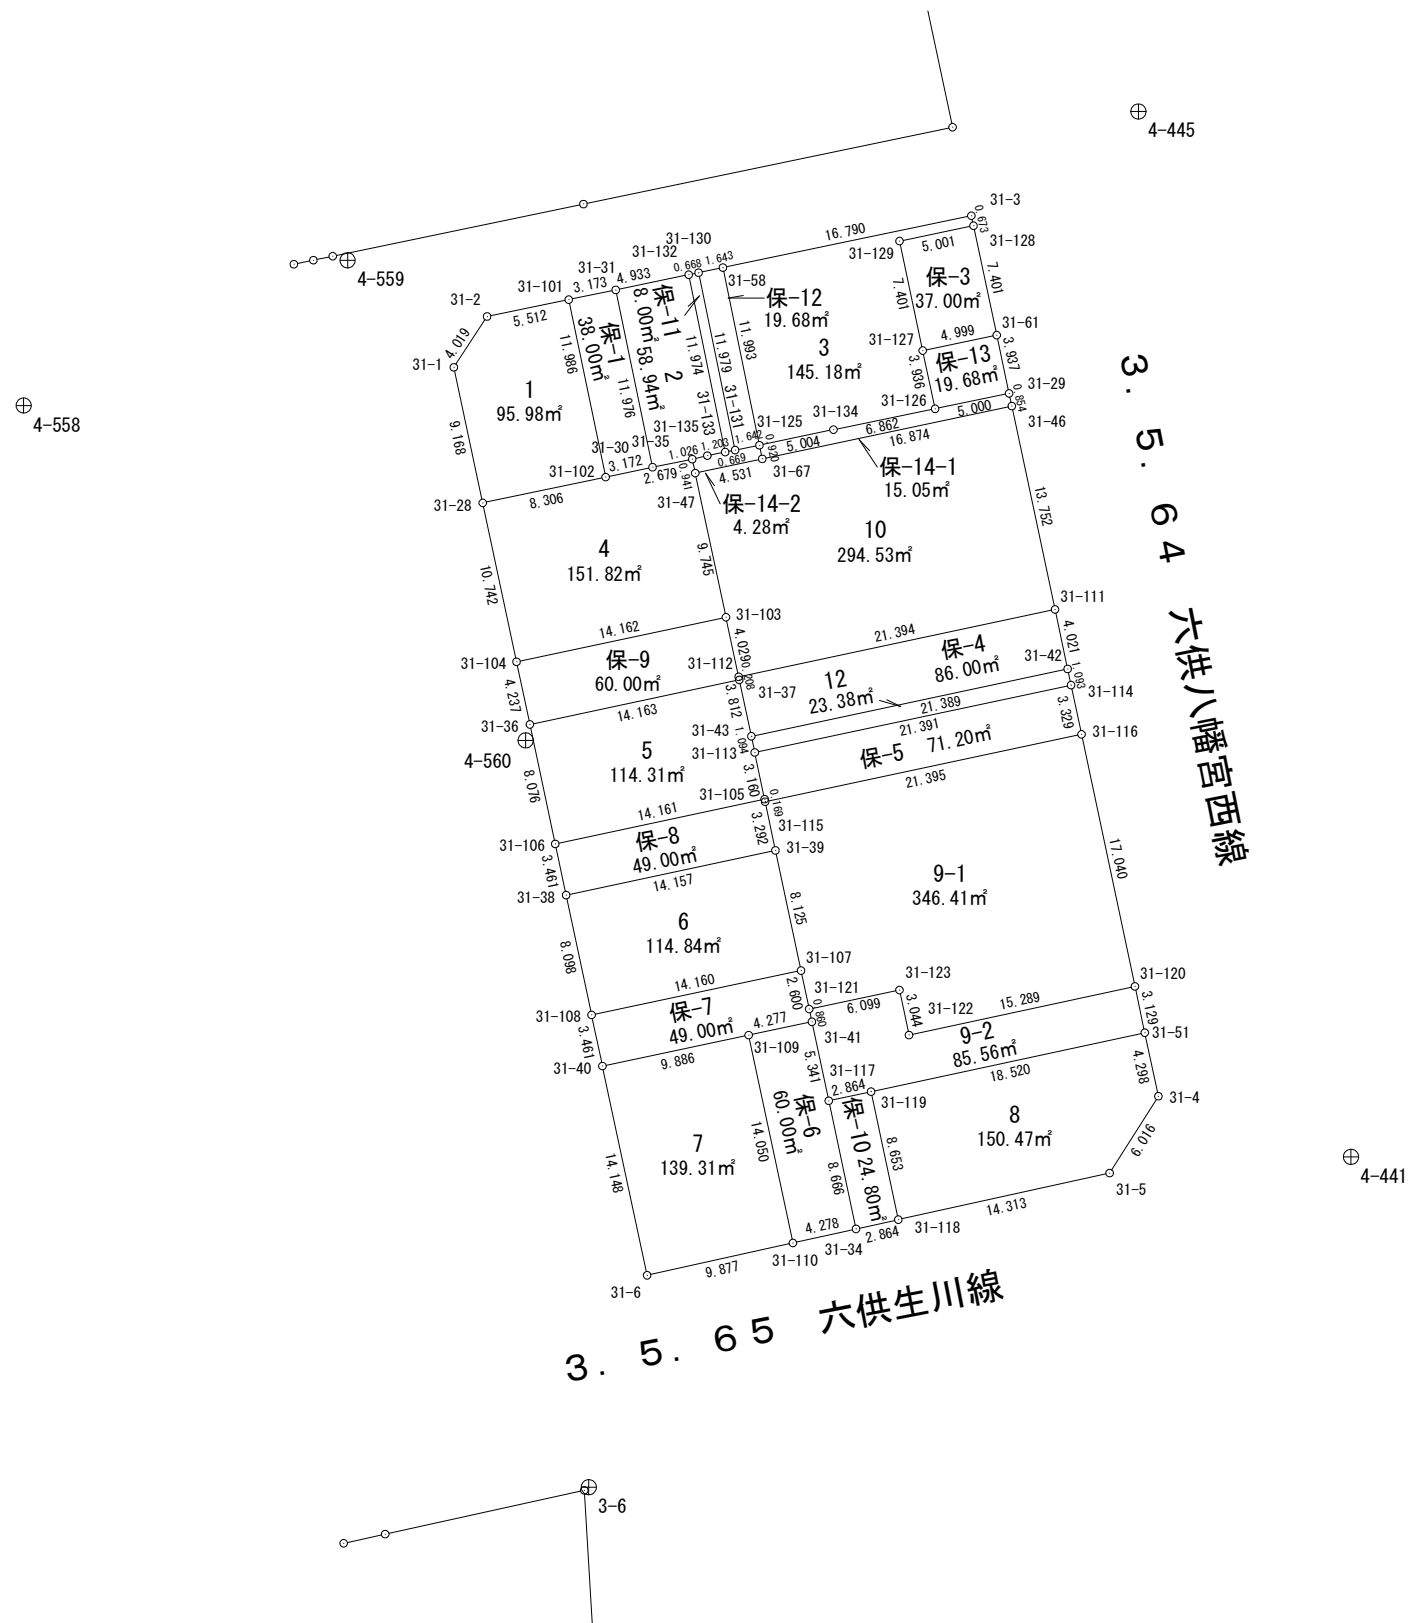


面積計算書（座標法）

世界測地系（測地成果2011）

所 在	地 番	公簿地目	現況地目	地 積	所 有 者
前橋市六供町一丁目	31-3			145.18 m ²	

点 名	X 座標	Y 座標	辺 長	方 向 角	測 角	DX	倍 積 (Y×DX)
31-58	41702.554	-68228.522	11.993	168-22-24	90-09-28	-15.176	1035436.049872
31-125	41690.807	-68226.105	5.004	78-05-50	89-43-26	-10.715	731042.715075
31-134	41691.839	-68221.209	6.862	78-24-24	180-18-34	2.411	-164481.334899
31-126	41693.218	-68214.487	3.936	348-00-18	89-35-54	5.229	-356693.552523
31-127	41697.068	-68215.305	7.401	348-00-52	180-00-34	11.090	-756507.732450
31-129	41704.308	-68216.842	5.001	78-15-55	270-15-03	8.257	-563266.464394
31-128	41705.325	-68211.946	0.673	347-59-19	89-43-24	1.675	-114255.009550
31-3	41705.983	-68212.086	16.790	258-12-56	90-13-37	-2.771	189015.690306

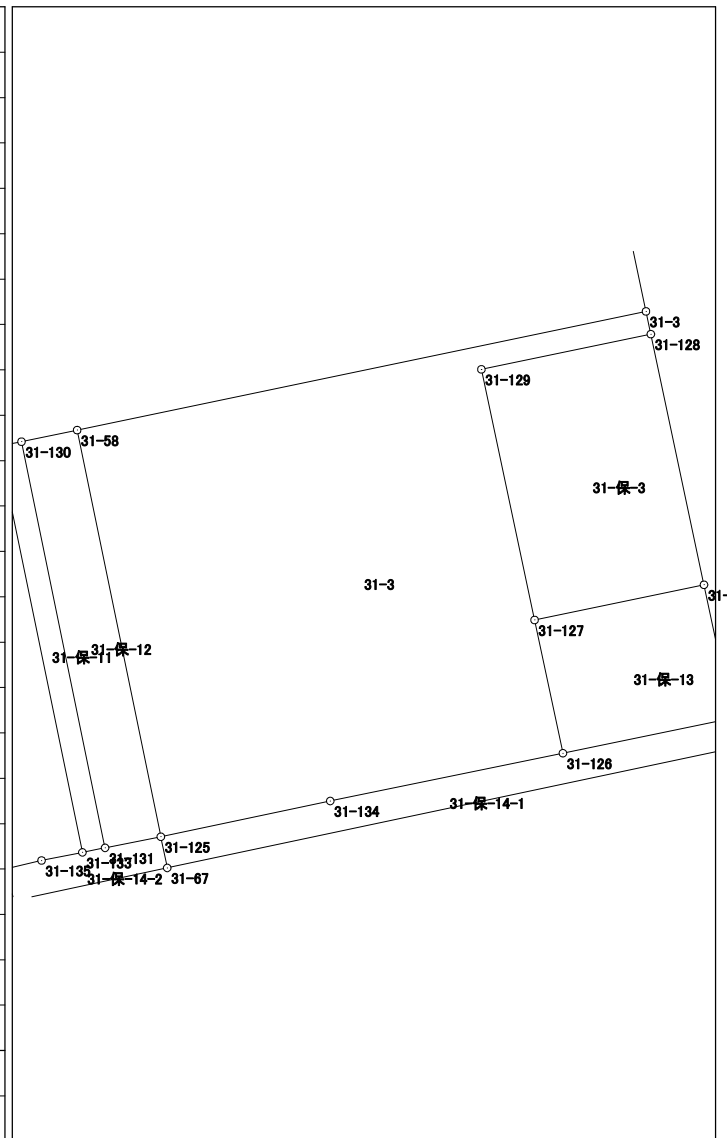


倍面積	290.361437
面 積	145.1807185

面積計算書（座標法）

世界測地系（測地成果2011）

所 在	地 番	公簿地目	現況地目	地 積	所 有 者
前橋市六供町一丁目	31-5			114.31 m ²	

点 名	X 座標	Y 座標	辺 長	方 向 角	測 角	DX	倍 積 (Y×DX)
31-105	41667.400	-68225.763	3.160	348-05-34	90-08-29	6.048	-412629.414624
31-113	41670.492	-68226.415	1.094	348-04-25	179-58-51	4.162	-283958.339230
31-43	41671.562	-68226.641	3.812	347-56-50	179-52-25	4.798	-327351.423518
31-37	41675.290	-68227.437	14.163	257-59-39	90-02-49	0.782	-53353.855734
31-36	41672.344	-68241.290	8.076	168-00-30	90-00-51	-10.846	740145.031340
31-106	41664.444	-68239.612	14.161	77-57-05	89-56-35	-4.944	337376.641728
						倍面積	228.639962
						面 積	114.3199810

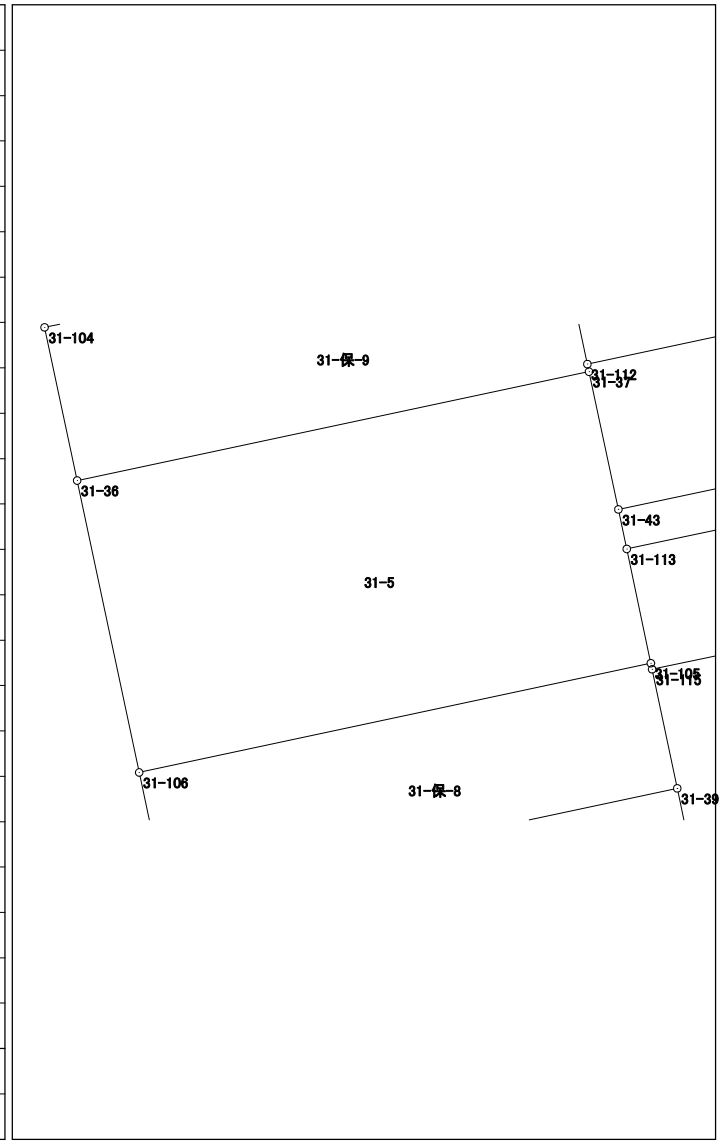


面積計算書 (座標法)

世界測地系 (測地成果2011)

所在	地番	公簿地目	現況地目	地積	所有者
前橋市六供町一丁目	31-6			114.84 m ²	


点名	X座標	Y座標	辺長	方向角	測角	Dx	倍積 (Y×Dx)
31-107	41656.067	-68223.356	8.125	347-58-50	89-55-20	10.877	-742065.443212
31-39	41664.014	-68225.048	14.157	257-56-53	89-58-03	4.991	-340511.214568
31-38	41661.058	-68238.893	8.098	168-00-16	90-03-23	-10.877	742234.439161
31-108	41653.137	-68237.210	14.160	78-03-30	90-03-14	-4.991	340571.915110
						倍面積	229.696491
						面積	114.8482455

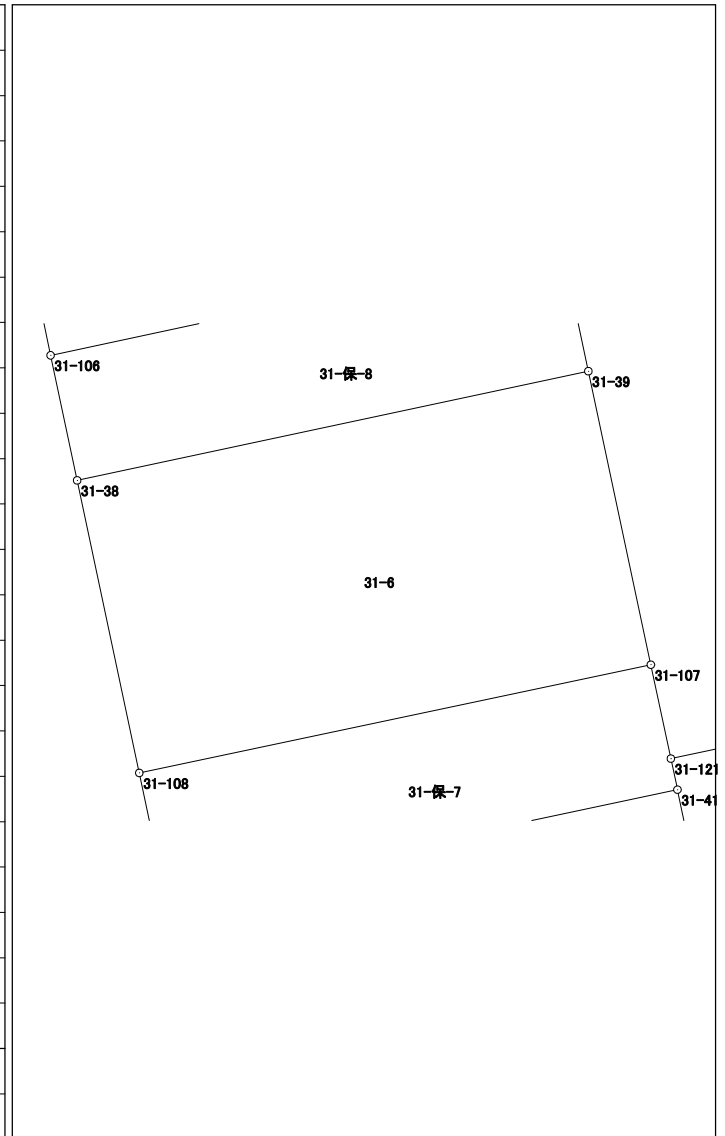

面積計算書 (座標法)

所在	地番	公簿地目	現況地目	地積	所有者
前橋市六供町一丁目	31-7			139.31 m ²	

点名	X座標	Y座標	辺長	方向角	測角	DX	倍積 (Y×DX)
31-109	41651.798	-68226.819	9.886	258-03-21	90-04-33	11.696	-797980.875024
31-40	41649.752	-68236.491	14.148	167-56-25	89-53-04	-15.882	1083731.950062
31-6	41635.916	-68233.535	9.877	77-29-11	89-32-46	-11.696	798059.425360
31-110	41638.056	-68223.893	14.050	347-58-48	90-29-37	15.882	-1083531.868626
倍面積							278.631772
面積							139.3158860

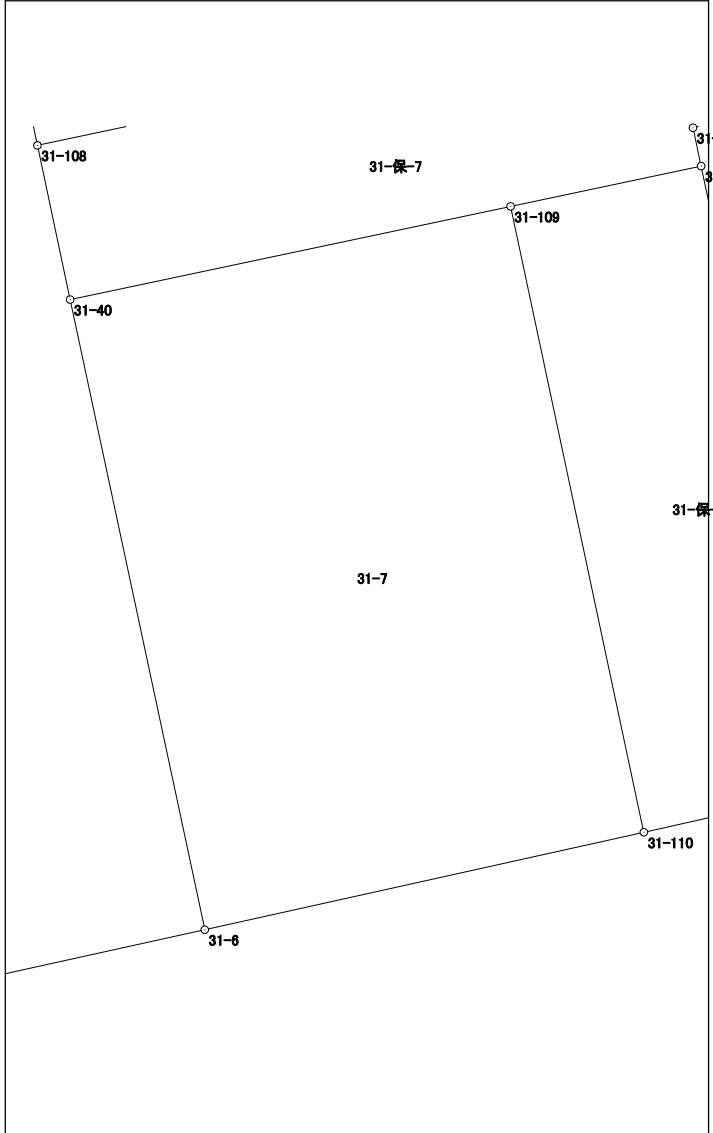


面積計算書 (座標法)

世界測地系 (測地成果2011)

所 在	地 番	公簿地目	現況地目	地 積	所 有 者
前橋市六供町一丁目	31-8			150.47 m ²	

点 名	X 座標	Y 座標	辺 長	方 向 角	測 角	DX	倍 積 (Y×DX)
31-118	41639.599	-68216.920	14.313	77-34-53	89-36-06	-5.385	367348.114200
31-5	41642.677	-68202.942	6.016	32-24-22	134-49-29	8.157	-556331.397894
31-4	41647.756	-68199.718	4.298	347-55-36	135-31-14	9.282	-633029.782476
31-51	41651.959	-68200.617	18.520	257-51-10	89-55-34	0.306	-20869.388802
31-119	41648.062	-68218.722	8.653	167-58-47	90-07-37	-12.360	843183.403920

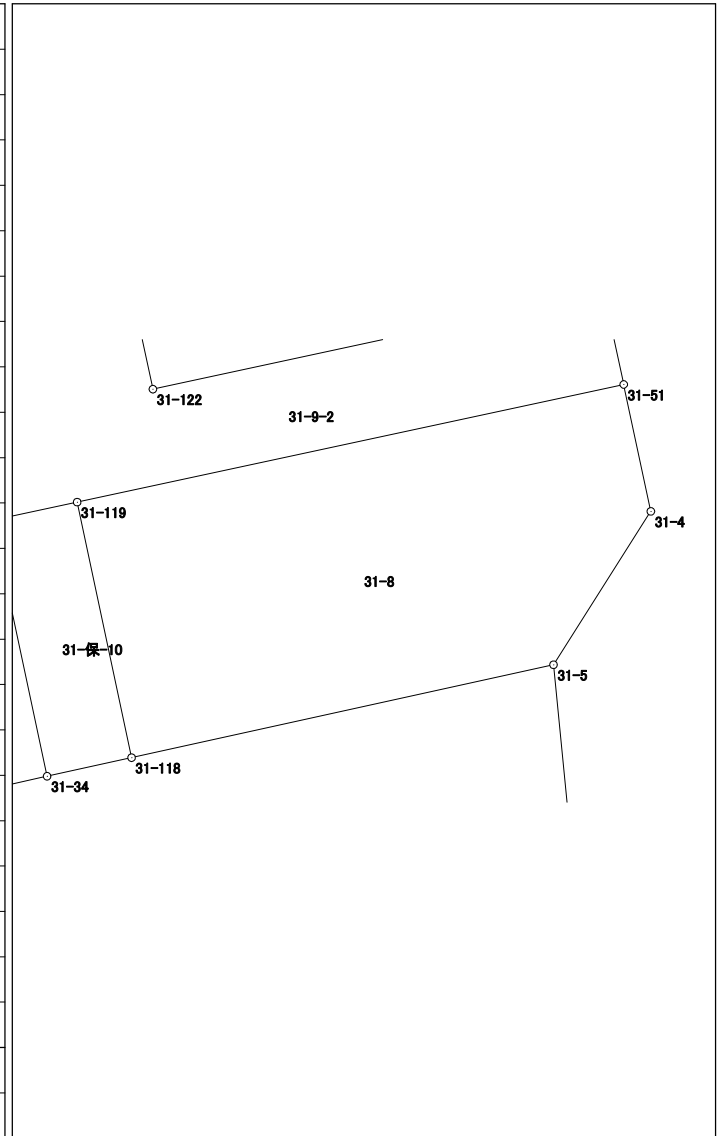


倍面積	300.948948
面積	150.4744740

面積計算書（座標法）

世界測地系（測地成果2011）

所在	地番	公簿地目	現況地目	地積	所有者
前橋市六供町一丁目	31-9-2			85.56 m ²	

点名	X座標	Y座標	辺長	方向角	測角	DX	倍積 (Y×DX)	
31-121	41653.524	-68222.814	0.860	167-59-04	89-52-09	-2.097	143063.240958	
31-41	41652.683	-68222.635	5.341	167-58-22	179-59-18	-6.065	413770.281275	
31-117	41647.459	-68221.522	2.864	77-50-48	89-52-26	-4.621	315251.653162	
31-119	41648.062	-68218.722	18.520	77-51-10	180-00-22	4.500	-306984.249000	
31-51	41651.959	-68200.617	3.129	348-01-45	90-10-35	6.958	-474539.893086	
31-120	41655.020	-68201.266	15.289	257-51-13	89-49-28	-0.156	10639.397496	
31-122	41651.803	-68216.213	3.044	347-59-45	270-08-32	-0.240	16371.891120	
31-123	41654.780	-68216.846	6.099	258-06-55	90-07-10	1.721	-117401.191966	
							倍面積	171.129959
							面積	85.5649795

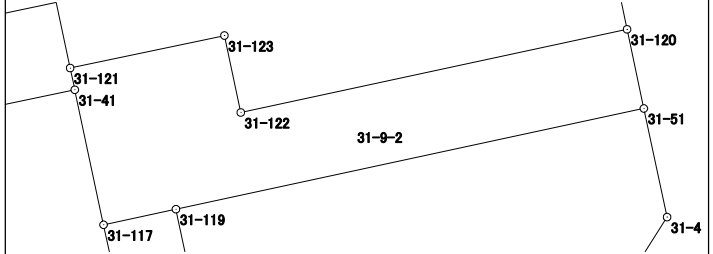


面積計算書（座標法）

世界測地系（測地成果2011）

所在	地番	公簿地目	現況地目	地積	所有者
前橋市六供町一丁目	31-10			294.53 m ²	

点名	X座標	Y座標	辺長	方向角	測角	DX	倍積 (Y×DX)
31-111	41679.947	-68206.555	13.752	348-00-34	90-01-24	17.905	-1221238.367275
31-46	41693.399	-68209.412	16.874	258-03-10	90-02-36	9.959	-679297.534108
31-67	41689.906	-68225.920	4.531	258-00-47	179-57-37	-4.434	302513.729280
31-47	41688.965	-68230.352	9.745	167-57-53	89-57-06	-10.472	714508.246144
31-103	41679.434	-68228.320	4.029	167-57-53	180-00-00	-13.471	919103.698720
31-112	41675.494	-68227.480	21.394	77-59-10	90-01-17	0.513	-35000.697240

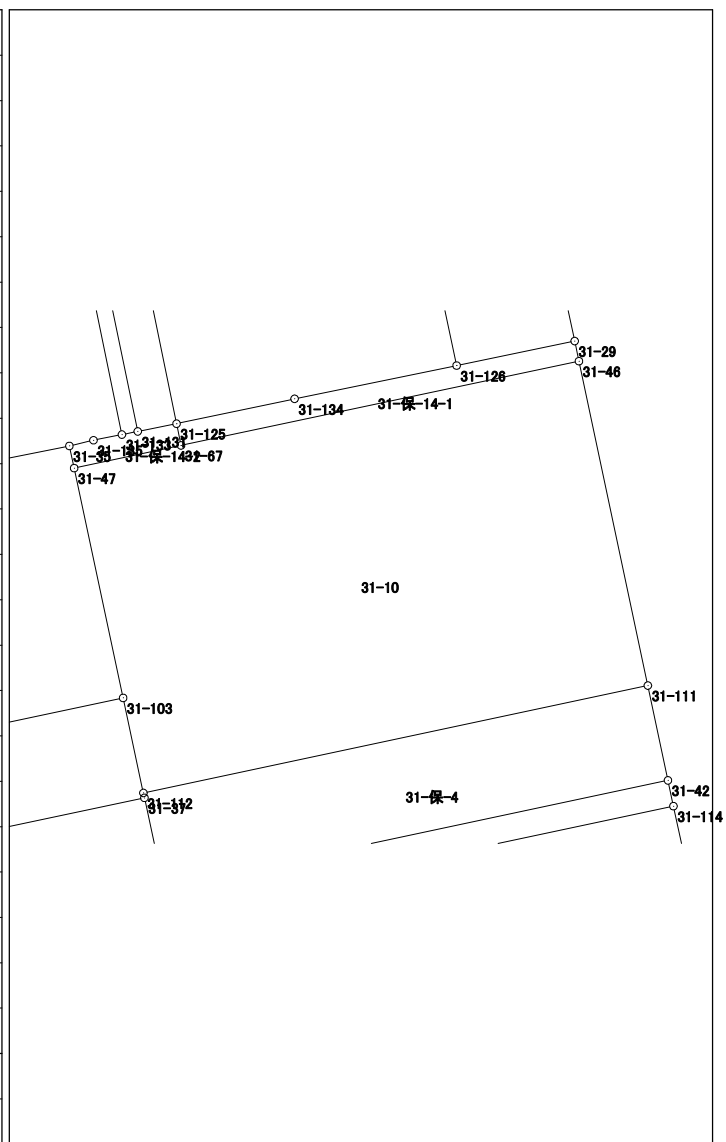


面積計算書 (座標法)

世界測地系 (測地成果2011)

所在	地番	公簿地目	現況地目	地積	所有者
前橋市六供町一丁目	31-12			23.38 m ²	

点名	X座標	Y座標	辺長	方向角	測角	DX	倍積 (Y×DX)
31-43	41671.562	-68226.641	1.094	168-04-25	90-05-13	-5.522	376747.511602
31-113	41670.492	-68226.415	21.391	77-59-04	89-54-39	3.383	-230809.961945
31-114	41674.945	-68205.493	1.093	348-00-41	90-01-37	5.522	-376630.732346
31-42	41676.014	-68205.720	21.389	257-59-12	89-58-31	-3.383	230739.950760

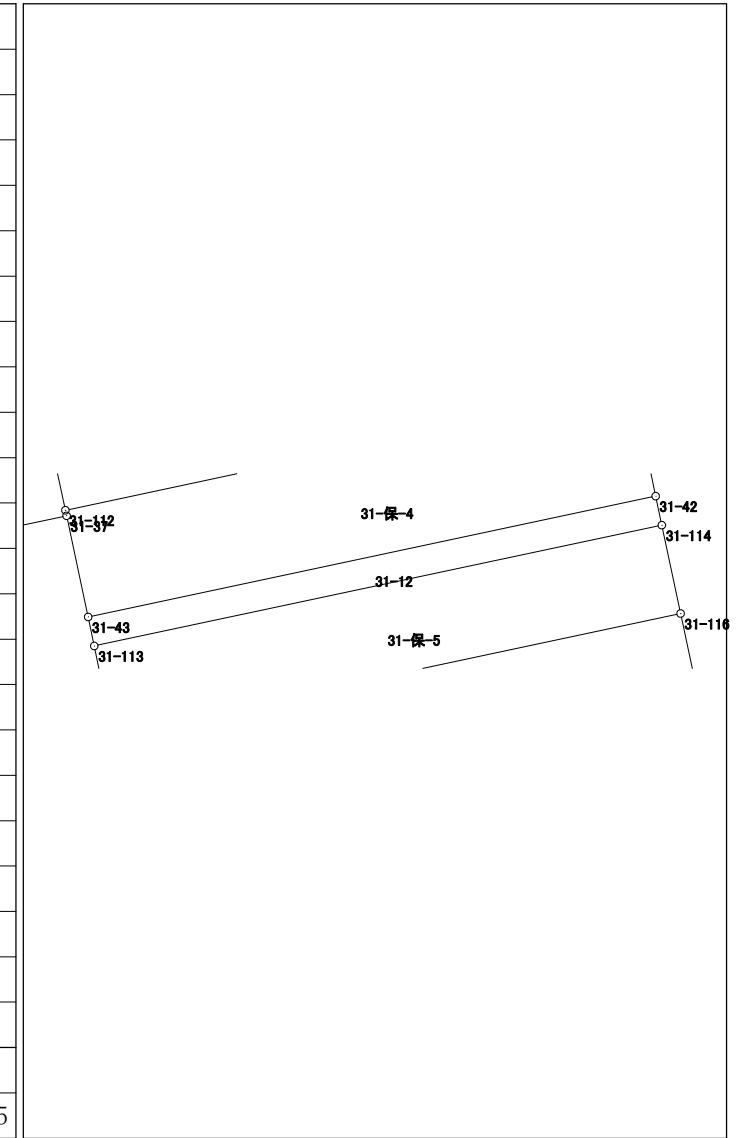


倍面積	46.768071
面積	23.3840355

面積計算書 (座標法)

世界測地系 (測地成果2011)

所在	地番	公簿地目	現況地目	地積	所有者
前橋市六供町一丁目	31-保-3			37.00 m ²	

点名	X 座標	Y 座標	辺長	方向角	測角	D _X	倍積 (Y×D _X)
31-61	41698.085	-68210.411	7.401	348-01-47	89-46-08	8.257	-563213.363627
31-128	41705.325	-68211.946	5.001	258-15-55	90-14-08	6.223	-424482.939958
31-129	41704.308	-68216.842	7.401	168-00-52	89-44-57	-8.257	563266.464394
31-127	41697.068	-68215.305	4.999	78-15-39	90-14-47	-6.223	424503.843015
						倍面積	74.003824
						面積	37.0019120

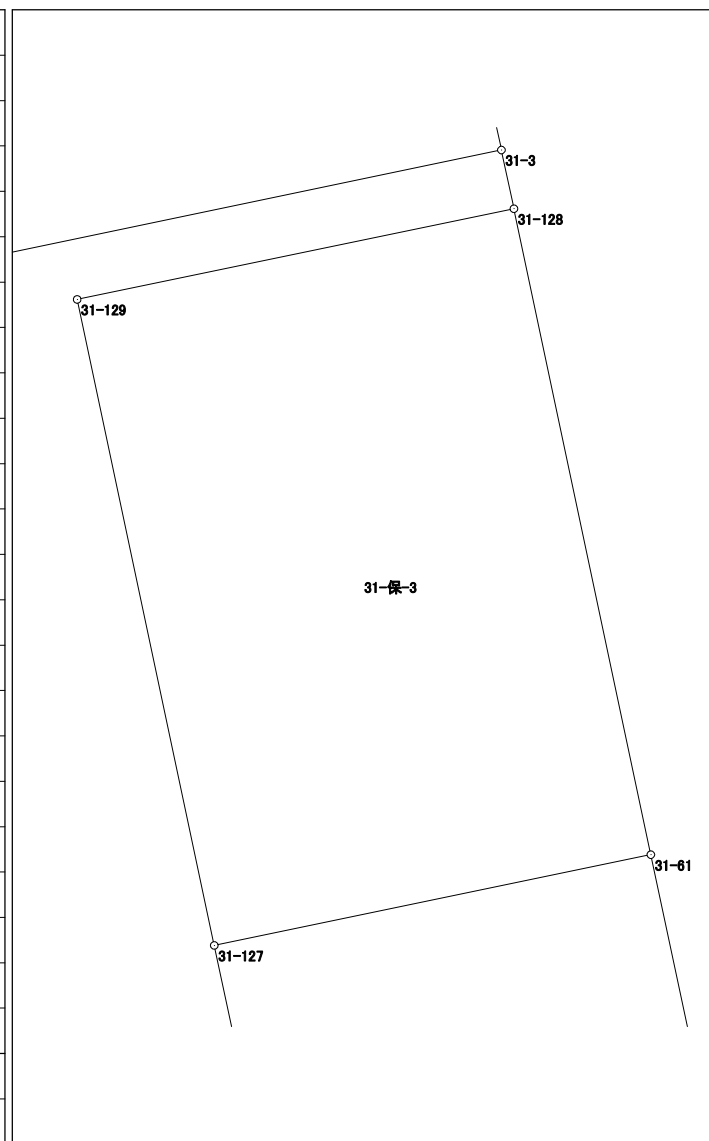


面積計算書 (座標法)

世界測地系 (測地成果2011)

所在	地番	公簿地目	現況地目	地積	所有者
前橋市六供町一丁目	31-保-4			86.00 m ²	

点名	X座標	Y座標	辺長	方向角	測角	DX	倍積 (Y×DX)
31-43	41671.562	-68226.641	21.389	77-59-12	90-02-22	0.724	-49396.088084
31-42	41676.014	-68205.720	4.021	348-00-49	90-01-37	8.385	-571904.962200
31-111	41679.947	-68206.555	21.394	257-59-10	89-58-21	-0.520	35467.408600
31-112	41675.494	-68227.480	0.208	168-05-50	90-06-40	-4.657	317735.374360
31-37	41675.290	-68227.437	3.812	167-56-50	179-51-00	-3.932	268270.282284
						倍面積	172.014960
						面積	86.0074800

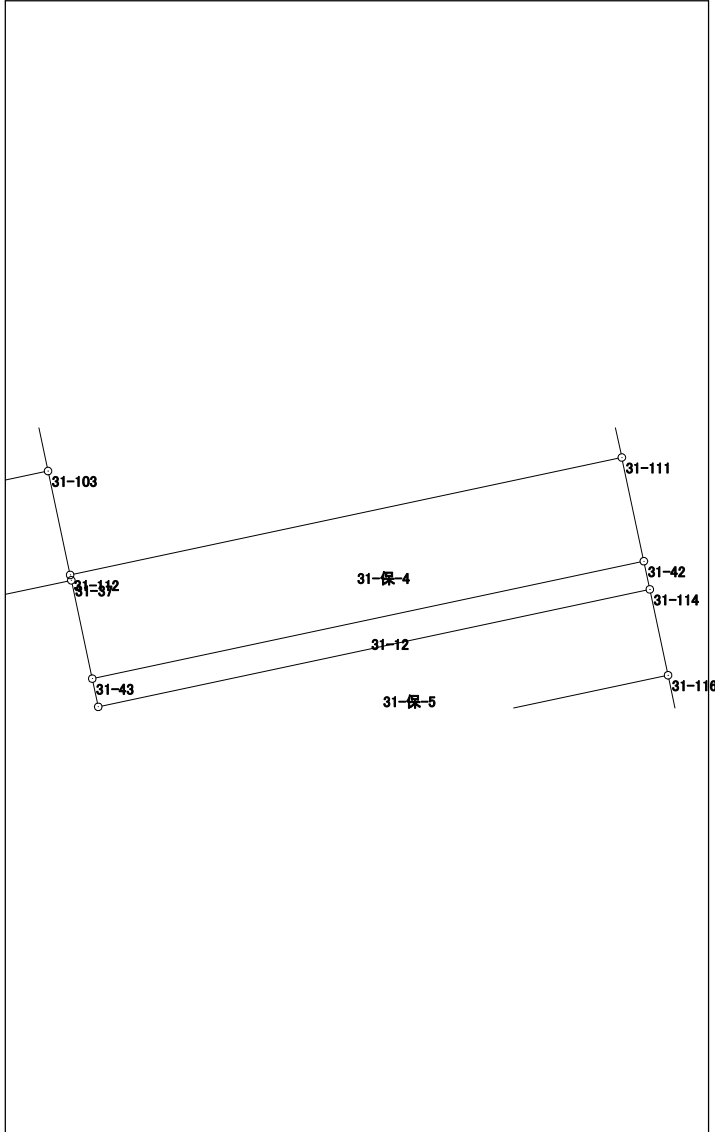


面積計算書（座標法）

世界測地系（測地成果2011）

所在	地番	公簿地目	現況地目	地積	所有者
前橋市六供町一丁目	31-保-5			71.20 m ²	

点名	X座標	Y座標	辺長	方向角	測角	DX	倍積 (Y×DX)
31-114	41674.945	-68205.493	21.391	257-59-04	89-57-58	-1.197	81641.975121
31-113	41670.492	-68226.415	3.160	168-05-34	90-06-30	-7.545	514768.301175
31-105	41667.400	-68225.763	0.169	168-01-26	179-55-52	-3.257	222211.310091
31-115	41667.235	-68225.728	21.395	77-59-03	89-57-37	4.289	-292620.147392
31-116	41671.689	-68204.802	3.329	348-01-06	90-02-03	7.710	-525859.023420

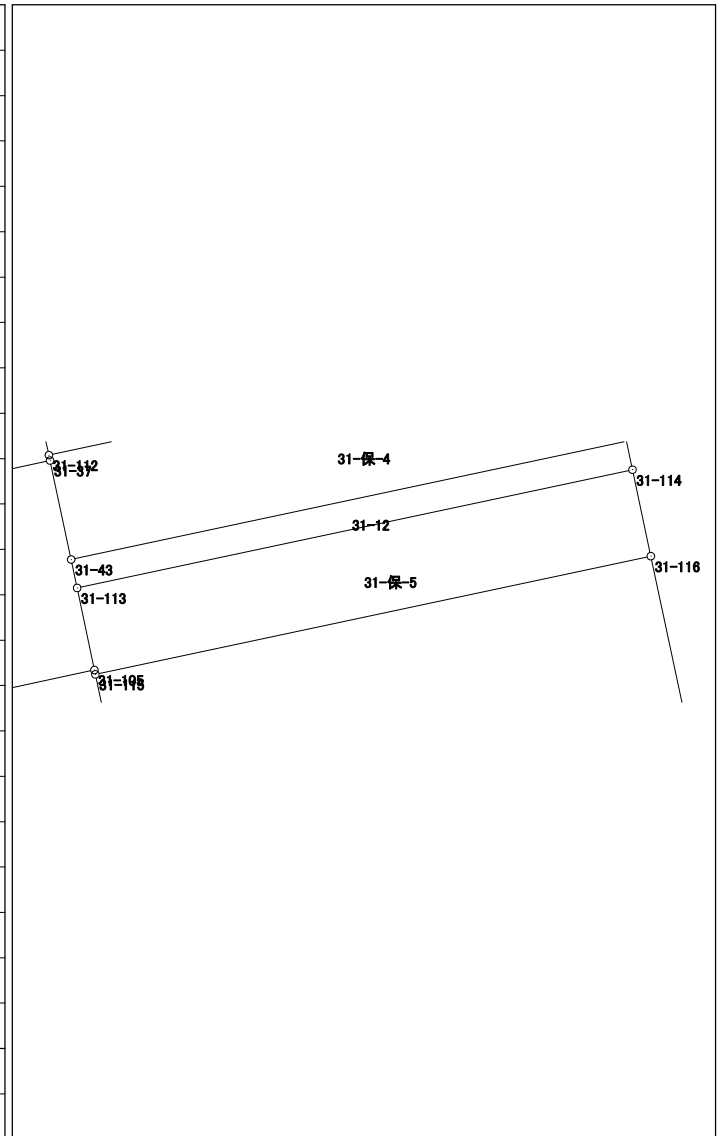

倍面積	142.415575
面積	71.2077875


面積計算書（座標法）

世界測地系（測地成果2011）

所在	地番	公簿地目	現況地目	地積	所有者
前橋市六供町一丁目	31-保-6			60.00 m ²	

点名	X座標	Y座標	辺長	方向角	測角	Dx	倍積 (Y×Dx)
31-41	41652.683	-68222.635	4.277	258-03-25	90-05-03	4.339	-296018.013265
31-109	41651.798	-68226.819	14.050	167-58-48	89-55-23	-14.627	997953.681513
31-110	41638.056	-68223.893	4.278	77-29-03	89-30-15	-12.815	874289.188795
31-34	41638.983	-68219.717	8.666	347-58-42	90-29-39	9.403	-641469.998951
31-117	41647.459	-68221.522	5.341	347-58-22	179-59-40	13.700	-934634.851400

倍面積	120.006692
面積	60.0033460

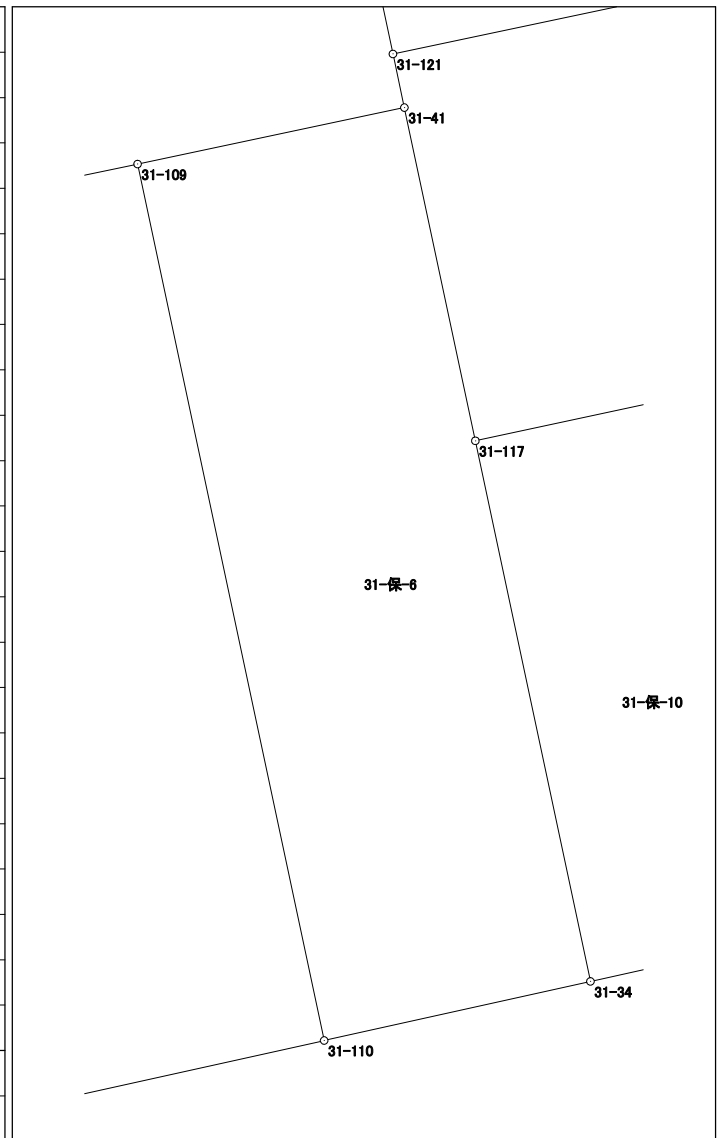


面積計算書 (座標法)

世界測地系 (測地成果2011)

所在	地番	公簿地目	現況地目	地積	所有者
前橋市六供町一丁目	31-保-7			49.00 m ²	

点名	X座標	Y座標	辺長	方向角	測角	DX	倍積 (Y×DX)
31-41	41652.683	-68222.635	0.860	347-59-04	89-55-39	1.726	-117752.268010
31-121	41653.524	-68222.814	2.600	347-58-06	179-59-02	3.384	-230866.002576
31-107	41656.067	-68223.356	14.160	258-03-30	90-05-24	-0.387	26402.438772
31-108	41653.137	-68237.210	3.461	168-00-29	89-56-59	-6.315	430917.981150
31-40	41649.752	-68236.491	9.886	78-03-21	90-02-52	-1.339	91368.661449
31-109	41651.798	-68226.819	4.277	78-03-25	180-00-04	2.931	-199972.806489
						倍面積	98.004296
						面積	49.0021480

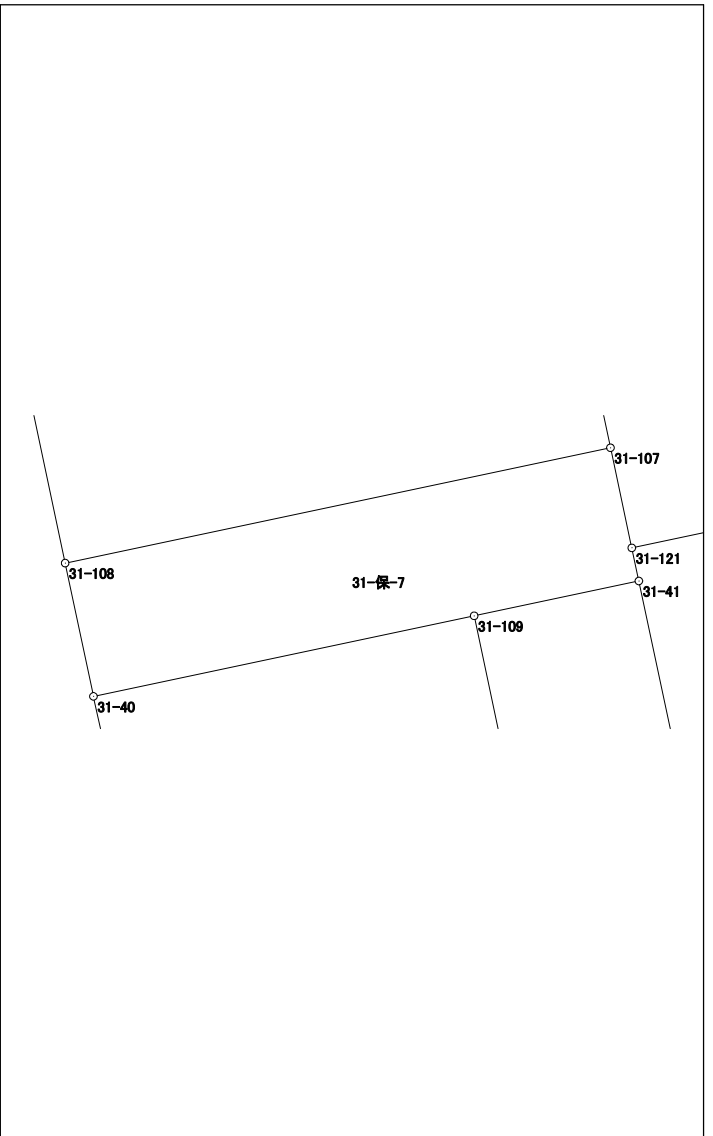


面積計算書（座標法）

世界測地系（測地成果2011）

所在	地番	公簿地目	現況地目	地積	所有者
前橋市六供町一丁目	31-保-9			60.00 m ²	

点名	X座標	Y座標	辺長	方向角	測角	Dx	倍積 (Y×Dx)
31-36	41672.344	-68241.290	14.163	77-59-39	90-00-35	-1.198	81753.065420
31-37	41675.290	-68227.437	0.208	348-05-50	90-06-11	3.150	-214916.426550
31-112	41675.494	-68227.480	4.029	347-57-53	179-52-03	4.144	-282734.677120
31-103	41679.434	-68228.320	14.162	257-59-36	90-01-43	0.994	-67818.950080
31-104	41676.488	-68242.172	4.237	167-59-04	89-59-28	-7.090	483836.999480

倍面積	120.011150
面積	60.0055750

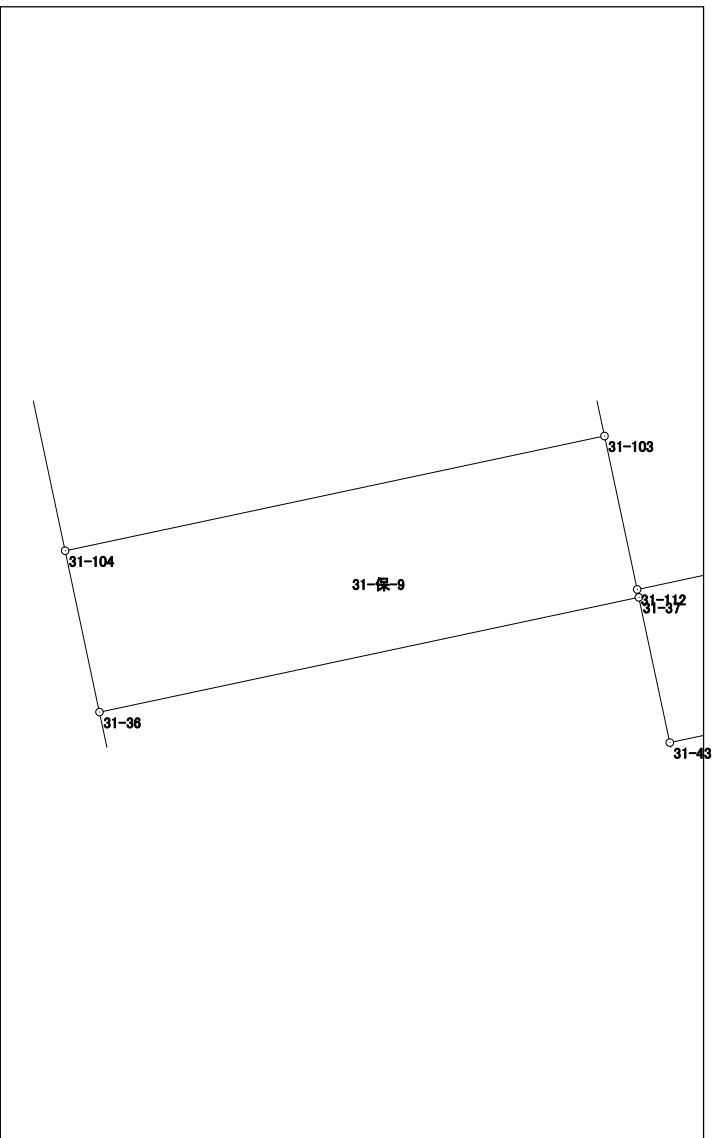


面積計算書（座標法）

世界測地系（測地成果2011）

所 在	地 番	公簿地目	現況地目	地 積	所 有 者
前橋市六供町一丁目	31-保-10			24.80 m ²	

点 名	X 座標	Y 座標	辺 長	方 向 角	測 角	D X	倍 積 (Y×DX)
31-34	41638.983	-68219.717	2.864	77-34-47	89-36-05	-7.860	536206.975620
31-118	41639.599	-68216.920	8.653	347-58-47	90-24-00	9.079	-619341.416680
31-119	41648.062	-68218.722	2.864	257-50-48	89-52-01	7.860	-536199.154920
31-117	41647.459	-68221.522	8.666	167-58-42	90-07-54	-9.079	619383.198238

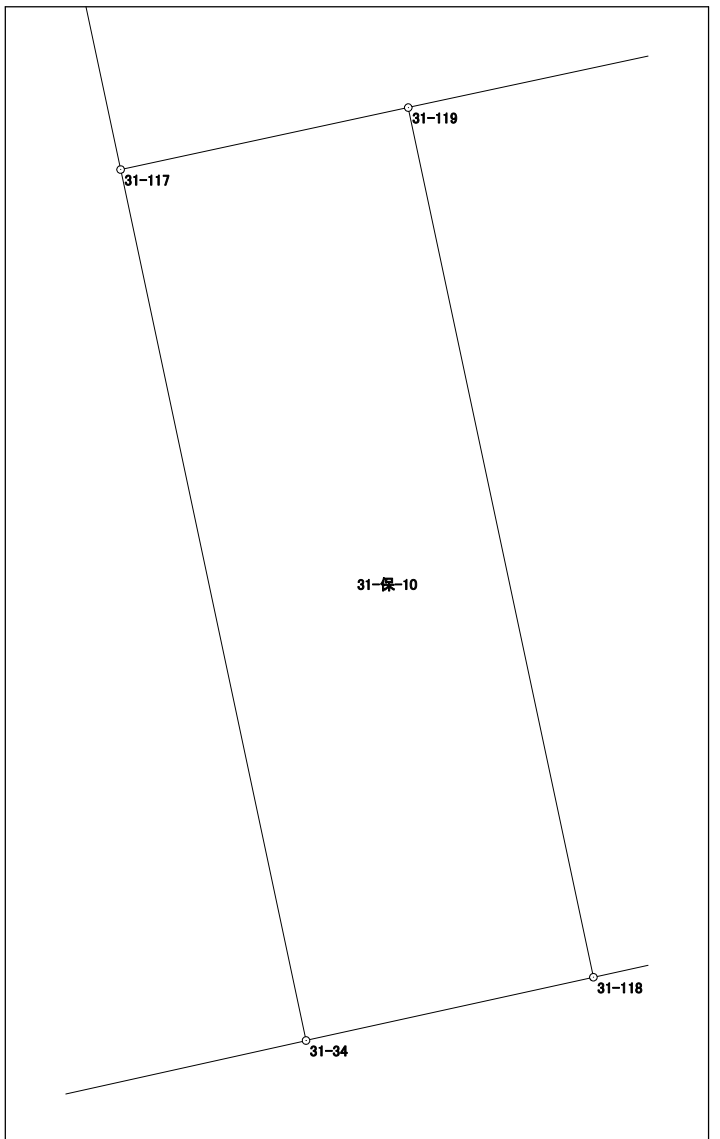


倍面積	49.602258
面 積	24.8011290

面積計算書（座標法）

世界測地系（測地成果2011）

所在	地番	公簿地目	現況地目	地積	所有者
前橋市六供町一丁目	31-保-11			8.00 m ²	

点名	X座標	Y座標	辺長	方向角	測角	DX	倍積 (Y×DX)
31-131	41690.486	-68227.715	11.979	348-22-09	89-39-44	11.864	-809453.610760
31-130	41702.219	-68230.130	0.668	258-15-10	89-53-01	11.597	-791264.817610
31-132	41702.083	-68230.784	11.974	168-22-26	90-07-16	-11.864	809490.021376
31-133	41690.355	-68228.371	0.669	78-42-25	90-19-59	-11.597	791244.418487
						倍面積	16.011493
						面積	8.0057465

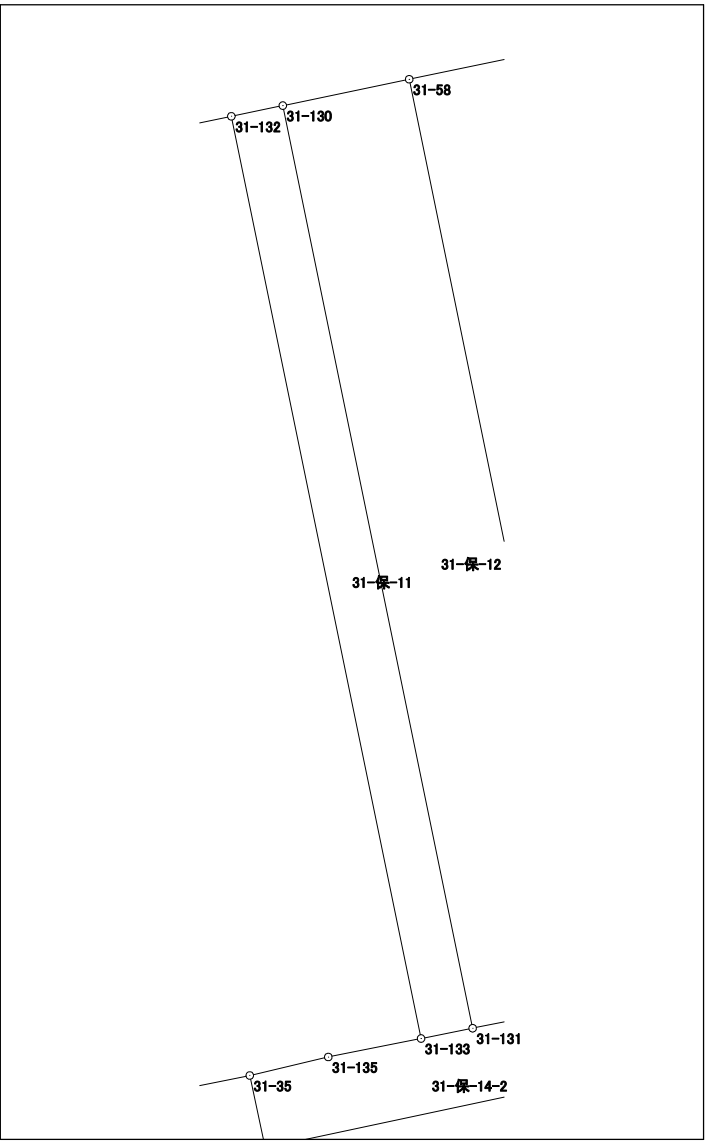


面積計算書 (座標法)

世界測地系 (測地成果2011)

所在	地番	公簿地目	現況地目	地積	所有者
前橋市六供町一丁目	31-保-12			19.68 m ²	

点名	X座標	Y座標	辺長	方向角	測角	DX	倍積 (Y×DX)
31-125	41690.807	-68226.105	11.993	348-22-24	89-38-57	12.068	-823352.635140
31-58	41702.554	-68228.522	1.643	258-13-54	89-51-30	11.412	-778623.893064
31-130	41702.219	-68230.130	11.979	168-22-09	90-08-15	-12.068	823401.208840
31-131	41690.486	-68227.715	1.642	78-43-27	90-21-18	-11.412	778614.683580
						倍面積	39.364216
						面積	19.6821080

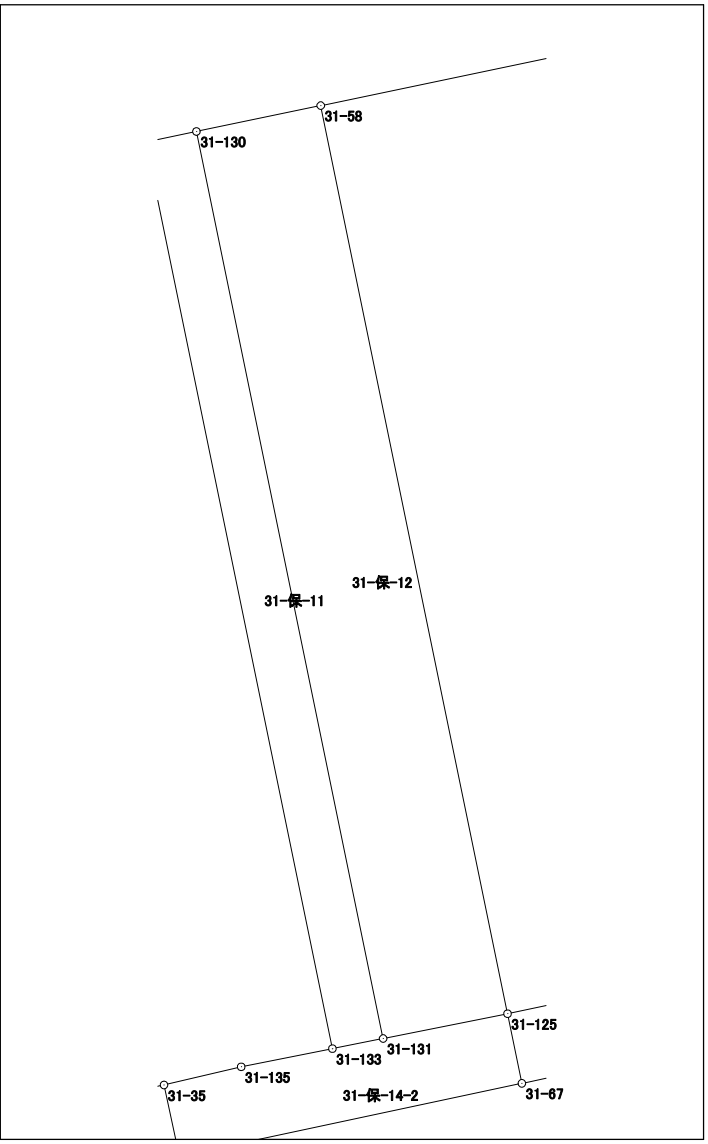

面積計算書（座標法）

世界測地系（測地成果2011）

所 在	地 番	公簿地目	現況地目	地 積	所 有 者
前橋市六供町一丁目	31-保-14-1			15.05 m ²	

点 名	X 座標	Y 座標	辺 長	方 向 角	測 角	DX	倍 積 (Y×DX)	
31-125	41690.807	-68226.105	0.920	168-23-49	90-17-59	-1.933	131881.060965	
31-67	41689.906	-68225.920	16.874	78-03-10	89-39-21	2.592	-176841.584640	
31-46	41693.399	-68209.412	0.854	347-54-02	89-50-52	4.328	-295210.335136	
31-29	41694.234	-68209.591	5.000	258-16-36	90-22-34	-0.181	12345.935971	
31-126	41693.218	-68214.487	6.862	258-24-24	180-07-48	-2.395	163373.696365	
31-134	41691.839	-68221.209	5.004	258-05-50	179-41-26	-2.411	164481.334899	
						倍面積	30.108424	
						面 積	15.0542120	

面積計算書 (座標法)

世界測地系 (測地成果2011)

所在	地番	公簿地目	現況地目	地積	所有者
前橋市六供町一丁目	31-保-14-2			4.28 m ²	

点名	X座標	Y座標	辺長	方向角	測角	DX	倍積 (Y×DX)	
31-35	41689.885	-68230.550	0.941	167-51-15	91-05-29	-1.155	78806.285250	
31-47	41688.965	-68230.352	4.531	78-00-47	90-09-32	0.021	-1432.837392	
31-67	41689.906	-68225.920	0.920	348-23-49	90-23-02	1.842	-125672.144640	
31-125	41690.807	-68226.105	1.642	258-43-27	90-19-38	0.580	-39571.140900	
31-131	41690.486	-68227.715	0.669	258-42-25	179-58-58	-0.452	30838.927180	
31-133	41690.355	-68228.371	1.203	258-44-12	180-01-47	-0.366	24971.583786	
31-135	41690.120	-68229.551	1.026	256-45-46	178-01-34	-0.470	32067.888970	
倍面積							8.562254	
面積							4.2811270	