


3 2 街区 画地出来形確認図 (2407.73m²)



S=1/500

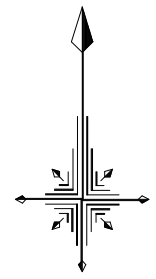


面積計算書 (座標法)

世界測地系 (測地成果2011)

所在	地番	公簿地目	現況地目	地積	所有者
前橋市六供町二丁目	32-1			94.75 m ²	


点名	X座標	Y座標	辺長	方向角	測角	DX	倍積 (Y×DX)
32-44	41602.652	-68230.528	4.565	86-30-32	89-58-09	-20.081	1370137.232768
32-101	41602.930	-68225.971	21.116	356-32-18	90-01-46	21.355	-1456965.610705
32-102	41624.007	-68227.246	4.622	257-33-16	81-00-58	20.081	-1370071.326926
32-1	41623.011	-68231.759	20.396	176-32-23	98-59-07	-21.355	1457089.213445
						倍面積	189.508582
						面積	94.7542910

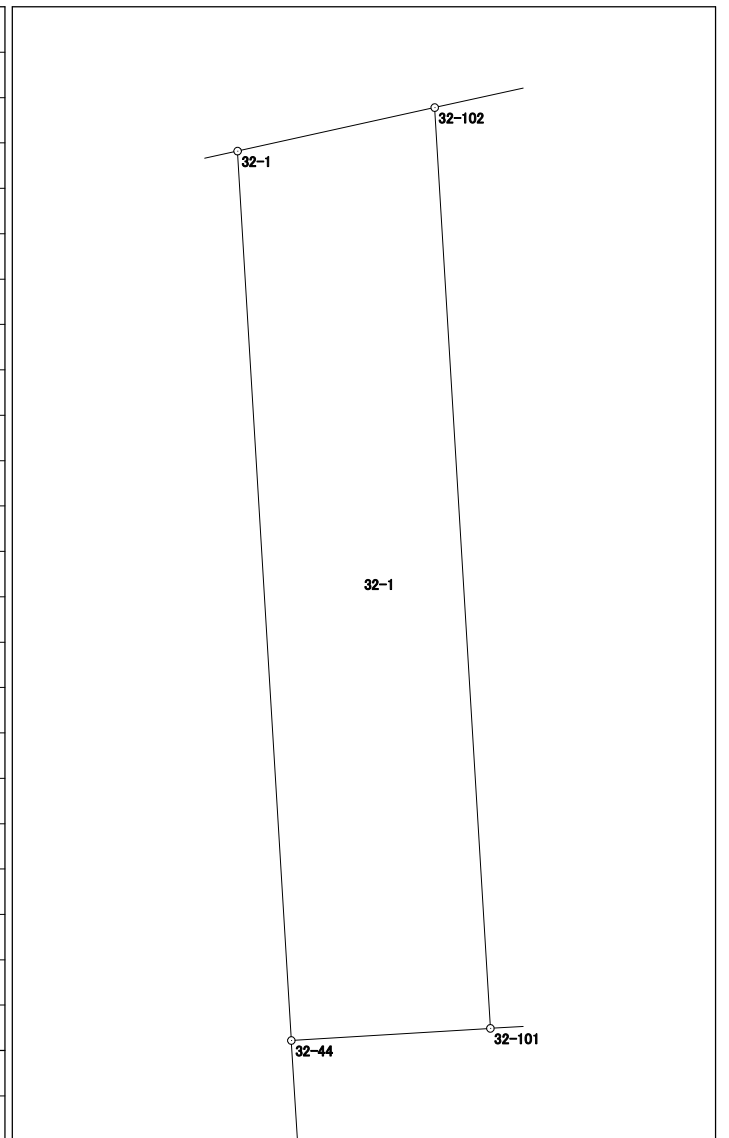

面積計算書 (座標法)

所在	地番	公簿地目	現況地目	地積	所有者
前橋市六供町二丁目	32-2			250.13 m ²	

点名	X座標	Y座標	辺長	方向角	測角	DX	倍積 (Y×DX)
32-113	41624.653	-68224.316	17.800	176-32-16	98-58-41	-20.456	1395596.608096
32-114	41606.885	-68223.241	7.335	86-32-16	90-00-00	-17.325	1181967.650325
32-116	41607.328	-68215.919	3.779	176-32-27	270-00-11	-3.329	227090.794351
32-115	41603.556	-68215.691	0.771	86-30-25	89-57-58	-3.725	254103.448975
32-51	41603.603	-68214.921	4.217	86-31-10	180-00-45	0.303	-20669.121063
32-68	41603.859	-68210.712	2.187	356-30-49	89-59-39	2.439	-166365.926568
32-110	41606.042	-68210.845	10.935	356-30-30	179-59-41	13.098	-893425.647810
32-70	41616.957	-68211.511	10.402	356-34-59	180-04-29	21.299	-1452836.972789
32-69	41627.341	-68212.131	12.478	257-33-35	80-58-36	7.696	-524960.560176
						倍面積	500.273341
						面積	250.1366705

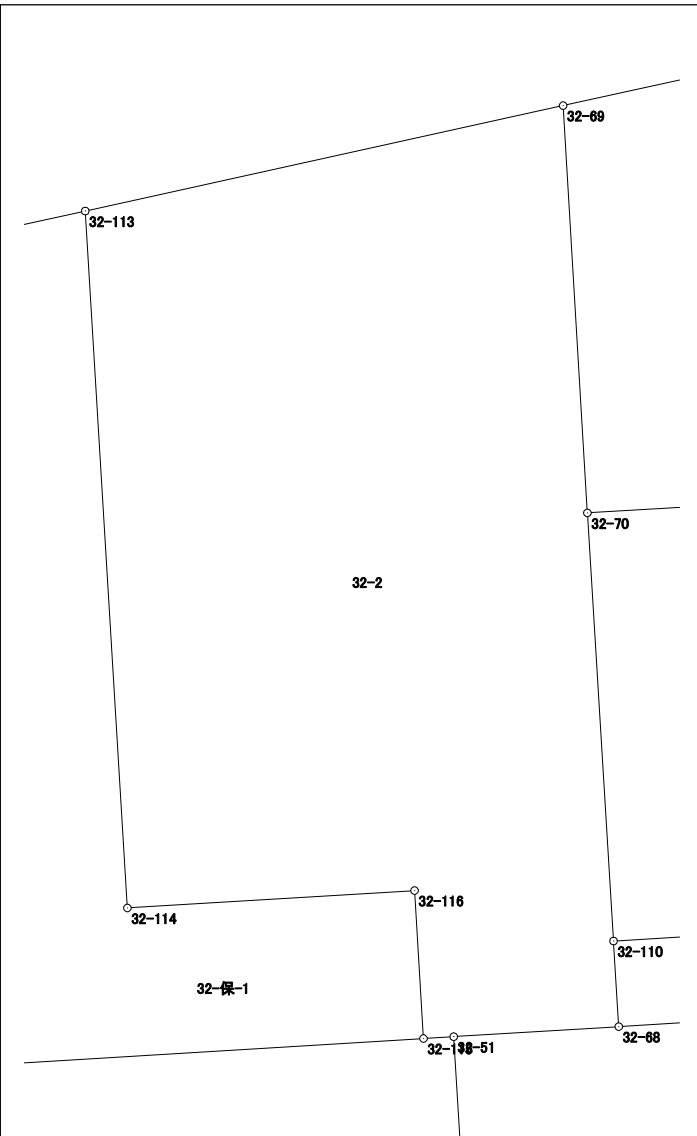


面積計算書（座標法）

世界測地系（測地成果2011）

所 在	地 番	公簿地目	現況地目	地 積	所 有 者
前橋市六供町二丁目	32-3			162.02 m ²	

点 名	X 座標	Y 座標	辺 長	方 向 角	測 角	DX	倍 積 (Y×DX)
32-107	41596.407	-68195.117	8.382	356-33-59	90-01-52	9.535	-650240.440595
32-45	41604.774	-68195.619	15.121	266-31-51	89-57-52	7.452	-508193.752788
32-68	41603.859	-68210.712	4.217	266-31-10	179-59-19	-1.171	79874.743752
32-51	41603.603	-68214.921	7.227	176-29-36	89-58-26	-7.469	509497.244949
32-112	41596.390	-68214.479	1.153	176-31-11	180-01-35	-8.364	570545.902356
32-108	41595.239	-68214.409	19.327	86-32-07	90-00-56	0.017	-1159.644953

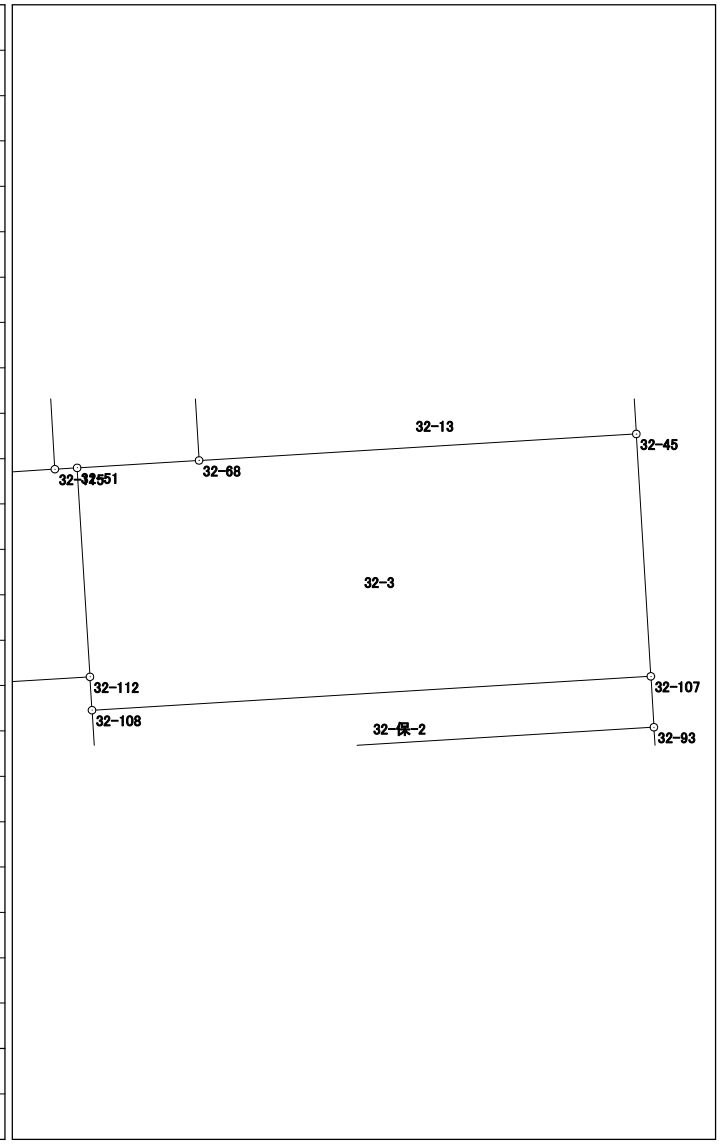


倍面積	324.052721
面積	162.0263605

面積計算書 (座標法)

世界測地系 (測地成果2011)

所在	地番	公簿地目	現況地目	地積	所有者
前橋市六供町二丁目	32-5			366.59 m ²	

点名	X座標	Y座標	辺長	方向角	測角	DX	倍積 (Y×DX)
32-103	41571.546	-68193.615	18.974	356-32-47	89-58-43	20.097	-1370487.080655
32-96	41590.486	-68194.758	19.332	266-31-17	89-58-30	17.767	-1211616.265386
32-97	41589.313	-68214.054	16.319	176-31-32	90-00-15	-17.462	1191153.810948
32-99	41573.024	-68213.065	2.640	176-32-49	180-01-17	-18.924	1290864.042060
32-104	41570.389	-68212.906	19.326	86-34-04	90-01-15	-1.478	100818.675068
倍面積							733.182035
面積							366.5910175

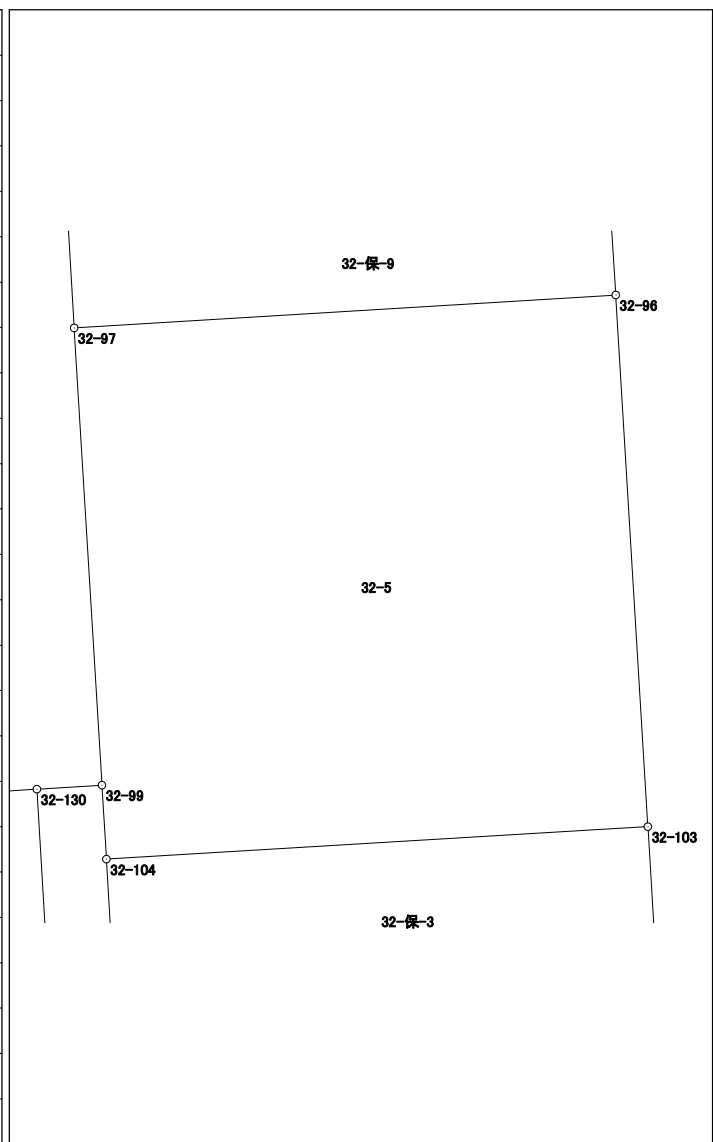


面積計算書（座標法）

世界測地系（測地成果2011）

所在	地番	公簿地目	現況地目	地積	所有者
前橋市六供町二丁目	32-6			61.89 m ²	

点名	X座標	Y座標	辺長	方向角	測角	DX	倍積 (Y×DX)
32-123	41562.973	-68207.410	5.110	176-31-20	89-57-10	-5.956	406243.333960
32-121	41557.872	-68207.100	2.291	86-35-49	90-04-29	-4.965	338648.251500
32-125	41558.008	-68204.813	0.598	356-32-57	89-57-08	0.733	-49994.127929
32-127	41558.605	-68204.849	0.335	356-34-24	180-01-27	0.931	-63498.714419
32-129	41558.939	-68204.869	11.999	86-36-11	270-01-47	1.045	-71274.088105
32-128	41559.650	-68192.891	4.186	356-29-37	89-53-26	4.889	-333395.044099
32-124	41563.828	-68193.147	14.289	266-34-10	90-04-33	3.323	-226605.827481

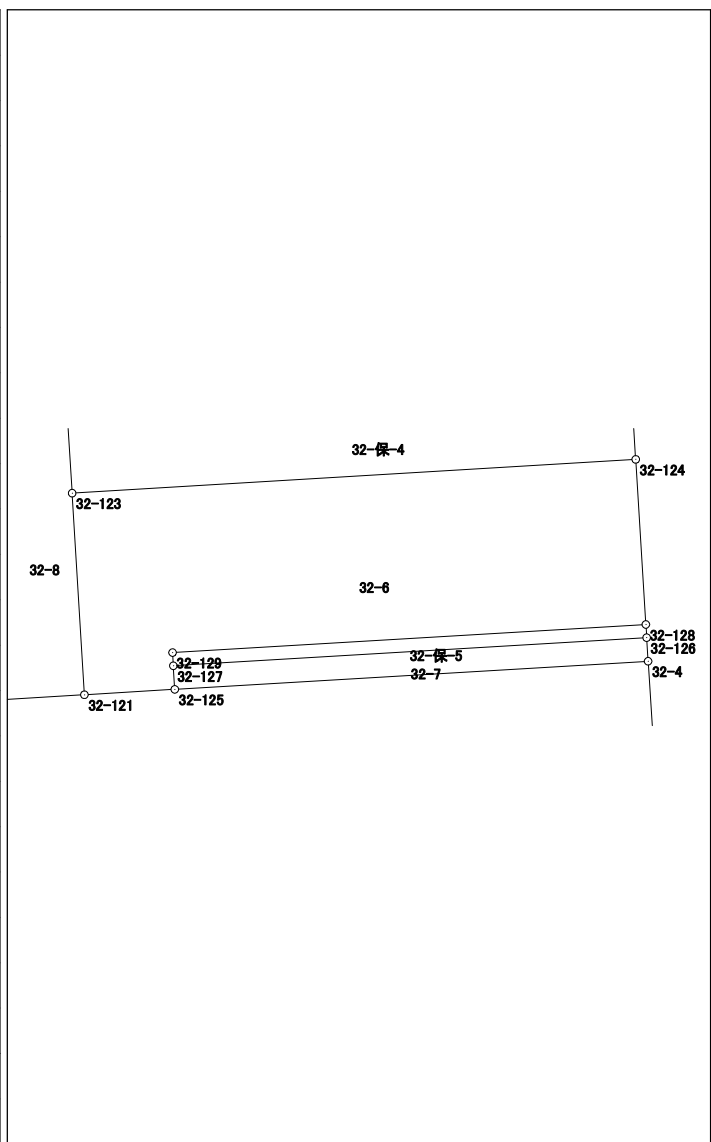

倍面積	123.783427
面積	61.8917135

面積計算書（座標法）

世界測地系（測地成果2011）

所在	地番	公簿地目	現況地目	地積	所有者
前橋市六供町二丁目	32-7			7.17 m ²	


点名	X座標	Y座標	辺長	方向角	測角	DX	倍積 (Y×DX)		
32-4	41558.720	-68192.834	0.598	356-27-13	89-51-18	1.309	-89264.419706		
32-126	41559.317	-68192.871	11.999	266-35-54	90-08-41	-0.115	7842.180165		
32-127	41558.605	-68204.849	0.598	176-32-57	89-57-03	-1.309	89280.147341		
32-125	41558.008	-68204.813	12.000	86-35-55	90-02-58	0.115	-7843.553495		
							倍面積		14.354305
							面積		7.1771525

面積計算書 (座標法)

世界測地系 (測地成果2011)

所在	地番	公簿地目	現況地目	地積	所有者
前橋市六供町二丁目	32-8			16.58 m ²	

点名	X座標	Y座標	辺長	方向角	測角	DX	倍積 (Y×DX)
32-120	41564.718	-68209.890	7.000	176-31-09	89-57-19	-7.129	486268.305810
32-119	41557.731	-68209.465	2.369	86-35-17	90-04-08	-6.846	466961.997390
32-121	41557.872	-68207.100	5.110	356-31-20	89-56-03	5.242	-357541.618200
32-123	41562.973	-68207.410	1.891	356-30-45	179-59-25	6.988	-476633.381080
32-122	41564.860	-68207.525	2.369	266-33-50	90-03-05	1.745	-119022.131125

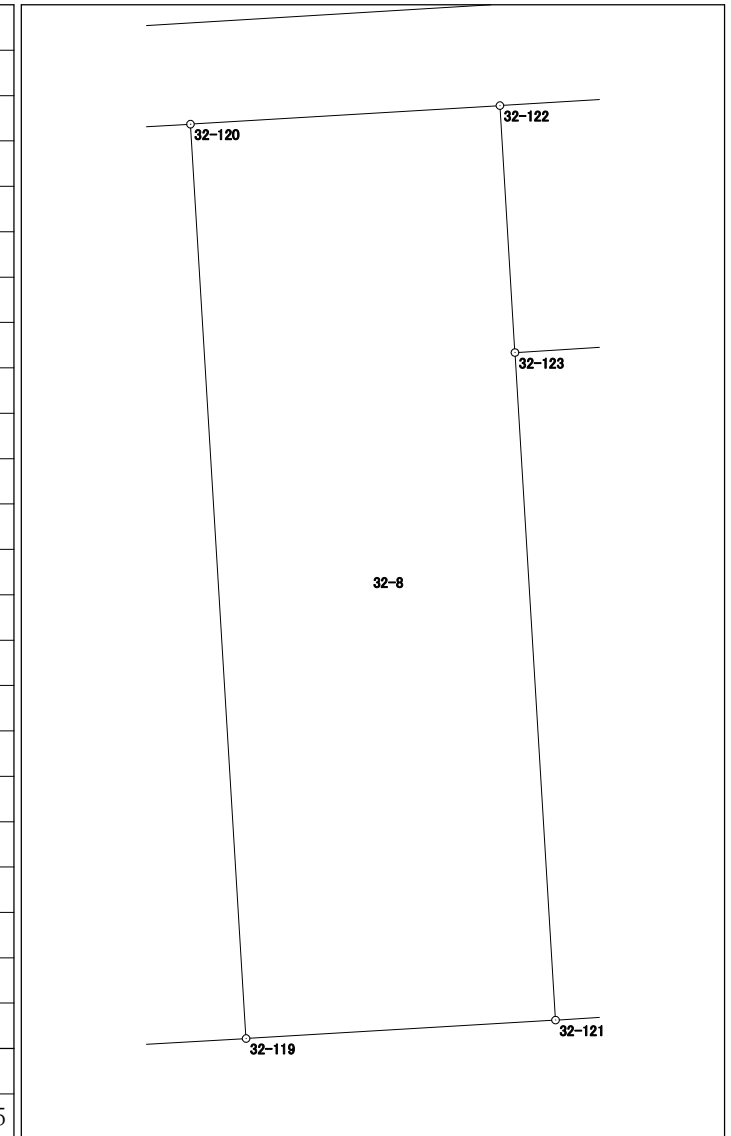


倍面積	33.172795
面積	16.5863975

面積計算書（座標法）

世界測地系（測地成果2011）

所 在	地 番	公簿地目	現況地目	地 積	所 有 者
前橋市六供町二丁目	32-9-1			365.97 m ²	

点 名	X 座 標	Y 座 標	辺 長	方 向 角	測 角	DX	倍 積 (Y×DX)
32-111	41595.439	-68230.089	23.411	176-30-46	89-59-57	-24.319	1659287.534391
32-98	41572.071	-68228.665	13.308	86-30-37	89-59-51	-22.558	1539102.225070
32-130	41572.881	-68215.382	2.321	86-28-06	179-57-29	0.953	-65009.259046
32-99	41573.024	-68213.065	16.319	356-31-32	90-03-26	16.432	-1120877.084080
32-97	41589.313	-68214.054	4.177	356-36-37	180-05-05	20.459	-1395591.330786
32-92	41593.483	-68214.301	1.759	356-28-50	179-52-13	5.926	-404237.947726
32-108	41595.239	-68214.409	1.153	356-31-11	180-02-21	2.907	-198299.286963
32-112	41596.390	-68214.479	15.639	266-30-49	89-59-38	0.200	-13642.895800
						倍面積	731.955060
						面 積	365.9775300

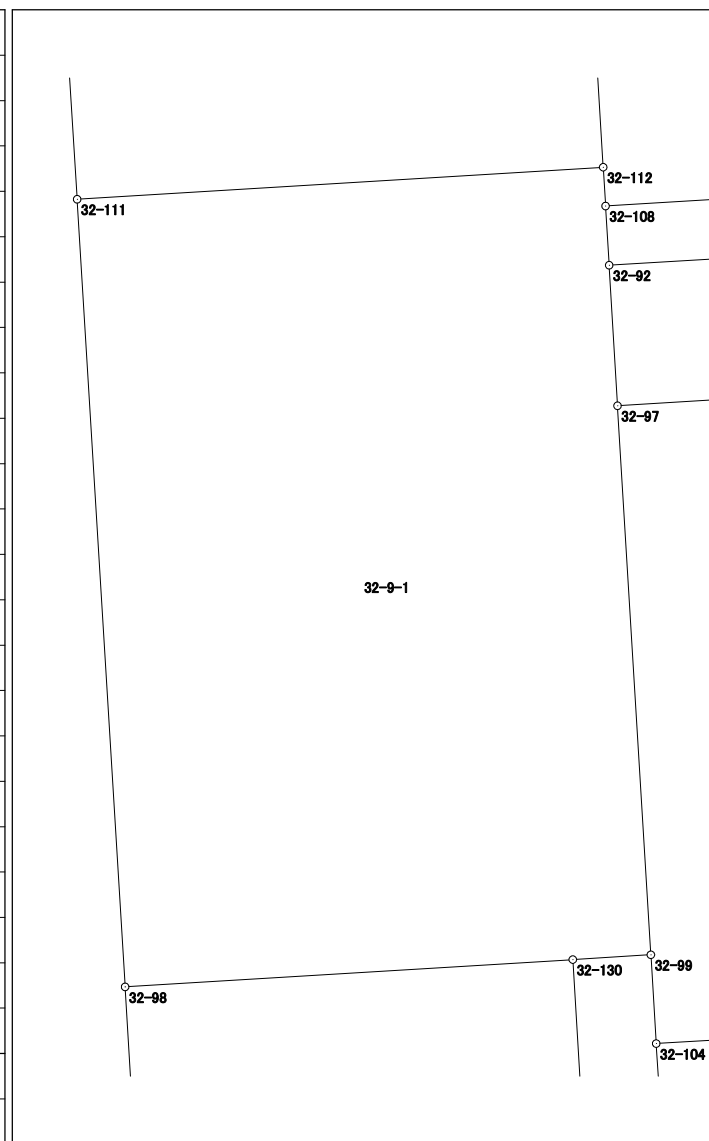


面積計算書 (座標法)

世界測地系 (測地成果2011)

所在	地番	公簿地目	現況地目	地積	所有者
前橋市六供町二丁目	32-9-2			201.92 m ²	

点名	X座標	Y座標	辺長	方向角	測角	DX	倍積 (Y×DX)
32-130	41572.881	-68215.382	13.308	266-30-37	89-58-40	14.637	-998468.546334
32-98	41572.071	-68228.665	12.666	176-33-03	90-02-26	-13.453	917880.230245
32-6	41559.428	-68227.903	3.996	131-01-22	134-28-19	-15.266	1041567.167198
32-5	41556.805	-68224.888	10.461	86-33-10	135-31-48	-1.994	136040.426672
32-131	41557.434	-68214.446	15.475	356-31-57	89-58-47	16.076	-1096615.433896

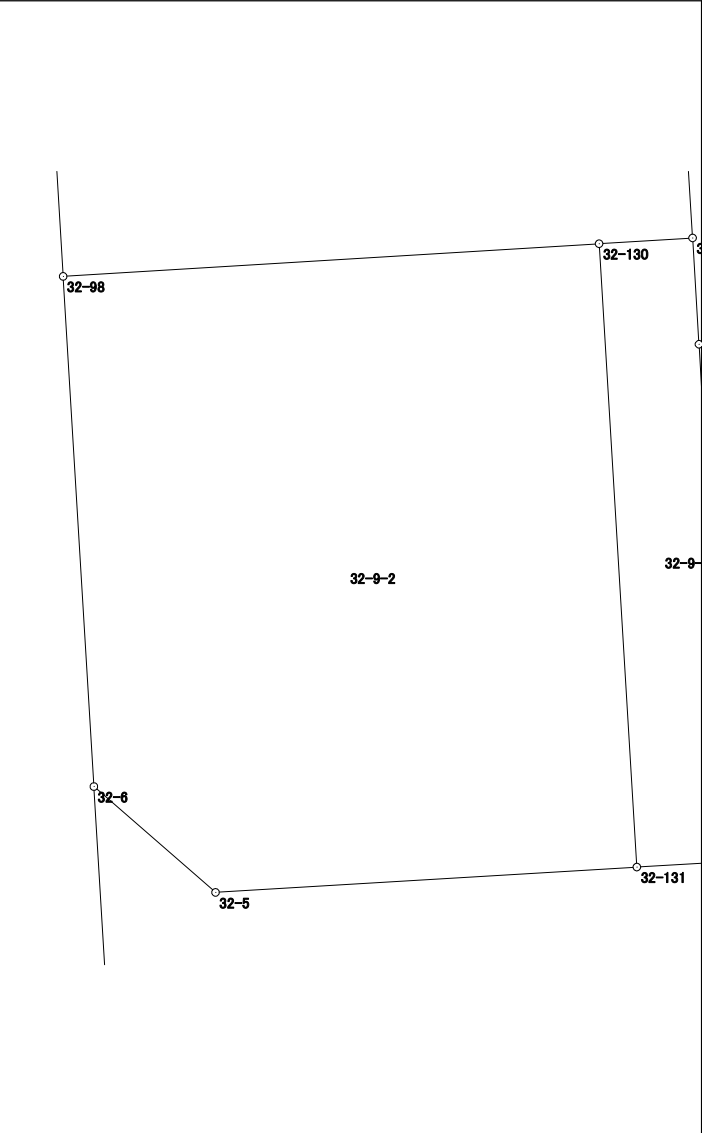

倍面積	403.843885
面積	201.9219425


面積計算書 (座標法)

世界測地系 (測地成果2011)

所在	地番	公簿地目	現況地目	地積	所有者
前橋市六供町二丁目	32-9-3			35.92 m ²	

点名	X座標	Y座標	辺長	方向角	測角	DX	倍積 (Y×DX)
32-50	41557.573	-68212.128	6.998	356-31-05	89-56-59	7.124	-485943.199872
32-117	41564.558	-68212.553	0.773	356-30-58	179-59-53	7.757	-529124.773621
32-105	41565.330	-68212.600	0.204	356-38-01	180-07-03	0.976	-66575.497600
32-95	41565.534	-68212.612	4.864	356-32-05	179-54-04	5.059	-345087.604108
32-104	41570.389	-68212.906	2.640	356-32-49	180-00-44	7.490	-510914.665940
32-99	41573.024	-68213.065	2.321	266-28-06	89-55-17	2.492	-169986.957980
32-130	41572.881	-68215.382	15.475	176-31-57	90-03-51	-15.590	1063477.805380
32-131	41557.434	-68214.446	2.322	86-34-06	90-02-09	-15.308	1044226.739368

倍面積	71.845627
面積	35.9228135

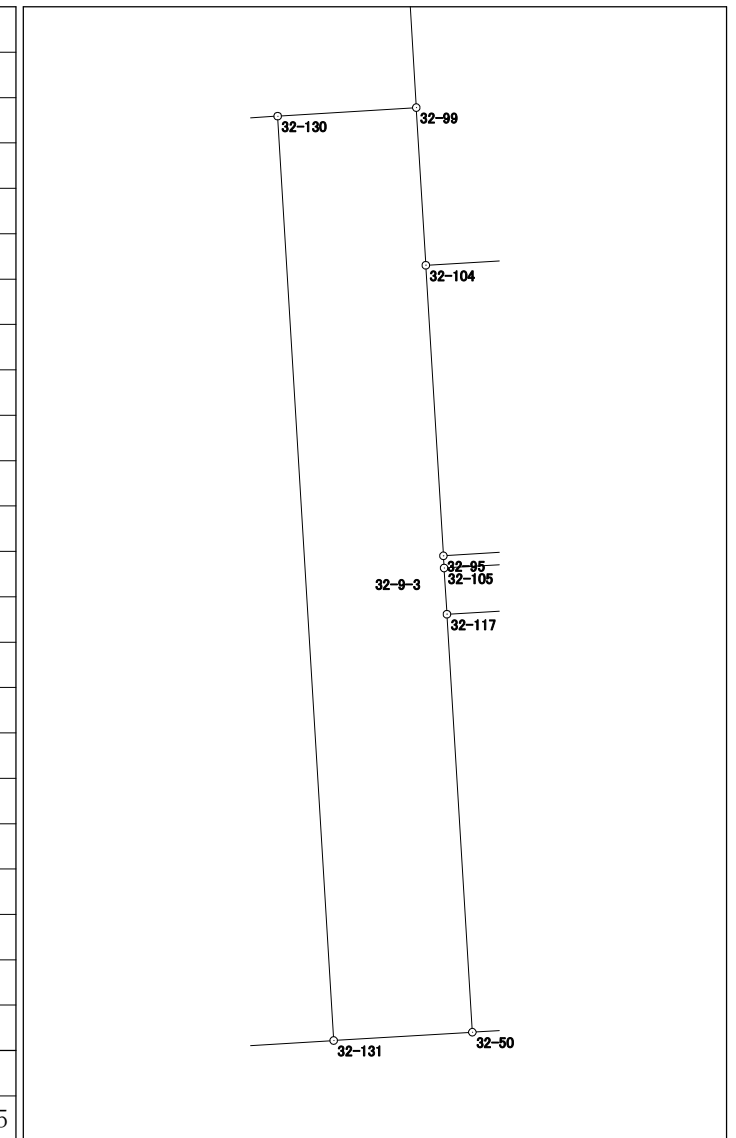


面積計算書 (座標法)

世界測地系 (測地成果2011)

所在	地番	公簿地目	現況地目	地積	所有者
前橋市六供町二丁目	32-11			165.22 m ²	

点名	X座標	Y座標	辺長	方向角	測角	DX	倍積 (Y×DX)
32-69	41627.341	-68212.131	10.402	176-34-59	99-01-49	-12.697	866089.427307
32-70	41616.957	-68211.511	15.120	86-36-51	90-01-52	-9.491	647395.450901
32-71	41617.850	-68196.417	8.233	356-39-03	90-02-12	9.112	-621405.751704
32-3	41626.069	-68196.898	5.954	307-01-12	130-22-09	11.804	-804996.183992
32-2	41629.654	-68201.652	10.731	257-33-10	130-31-58	1.272	-86752.501344
						倍面積	330.441168
						面積	165.2205840

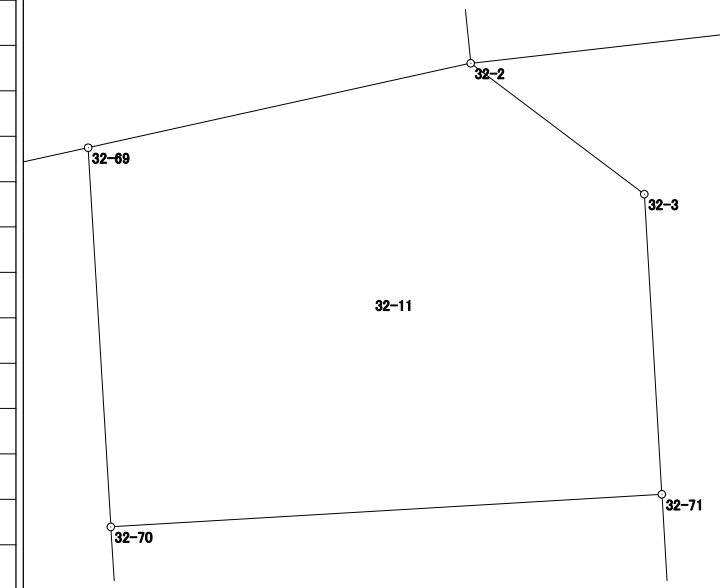


面積計算書 (座標法)

世界測地系 (測地成果2011)

所在	地番	公簿地目	現況地目	地積	所有者
前橋市六供町二丁目	32-12			165.18 m ²	

点名	X座標	Y座標	辺長	方向角	測角	Dx	倍積 (Y×Dx)
32-109	41606.957	-68195.752	10.913	356-30-23	89-58-32	11.808	-805255.439616
32-71	41617.850	-68196.417	15.120	266-36-51	90-06-28	10.000	-681964.170000
32-70	41616.957	-68211.511	10.935	176-30-30	89-53-39	-11.808	805441.521888
32-110	41606.042	-68210.845	15.121	86-31-51	90-01-21	-10.000	682108.450000
						倍面積	330.362272
						面積	165.1811360

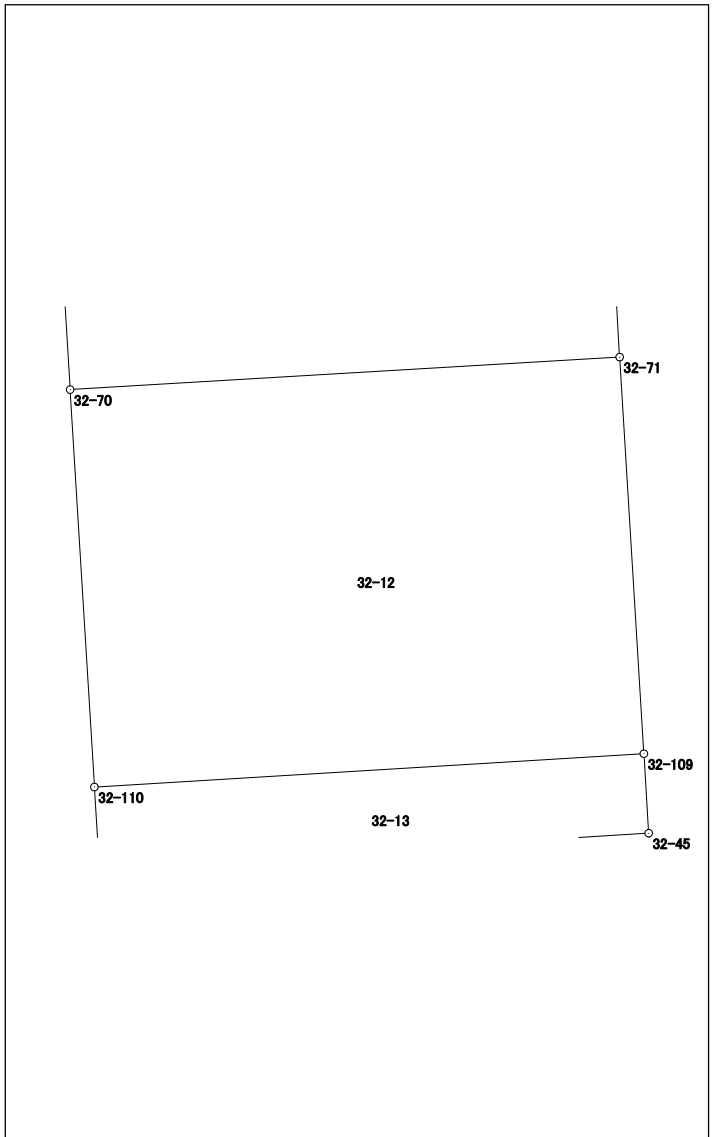


面積計算書（座標法）

世界測地系（測地成果2011）

所在	地番	公簿地目	現況地目	地積	所有者
前橋市六供町二丁目	32-13			33.06 m ²	


点名	X 座標	Y 座標	辺長	方向角	測角	DX	倍積 (Y×DX)
32-45	41604.774	-68195.619	2.187	356-30-49	89-58-58	3.098	-211270.027662
32-109	41606.957	-68195.752	15.121	266-31-51	90-01-02	1.268	-86472.213536
32-110	41606.042	-68210.845	2.187	176-30-49	89-58-58	-3.098	211317.197810
32-68	41603.859	-68210.712	15.121	86-31-51	90-01-02	-1.268	86491.182816
倍面積							66.139428
面積							33.0697140

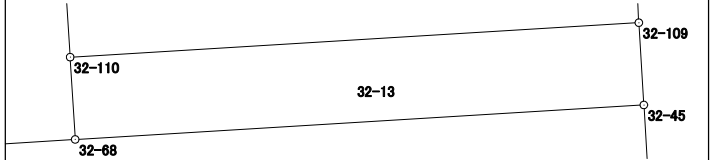

面積計算書（座標法）

所在	地番	公簿地目	現況地目	地積	所有者
前橋市六供町二丁目	32-14			14.93 m ²	

点名	X座標	Y座標	辺長	方向角	測角	DX	倍積 (Y×DX)
32-105	41565.330	-68212.600	0.773	176-30-58	89-56-44	-1.928	131513.892800
32-117	41564.558	-68212.553	2.668	86-33-42	90-02-44	-0.612	41746.082436
32-120	41564.718	-68209.890	2.369	86-33-50	180-00-08	0.302	-20599.386780
32-122	41564.860	-68207.525	14.288	86-34-24	180-00-34	0.996	-67934.694900
32-118	41565.714	-68193.263	0.773	356-30-58	89-56-34	1.626	-110882.245638
32-106	41566.486	-68193.310	19.325	266-34-14	90-03-16	-0.384	26186.231040

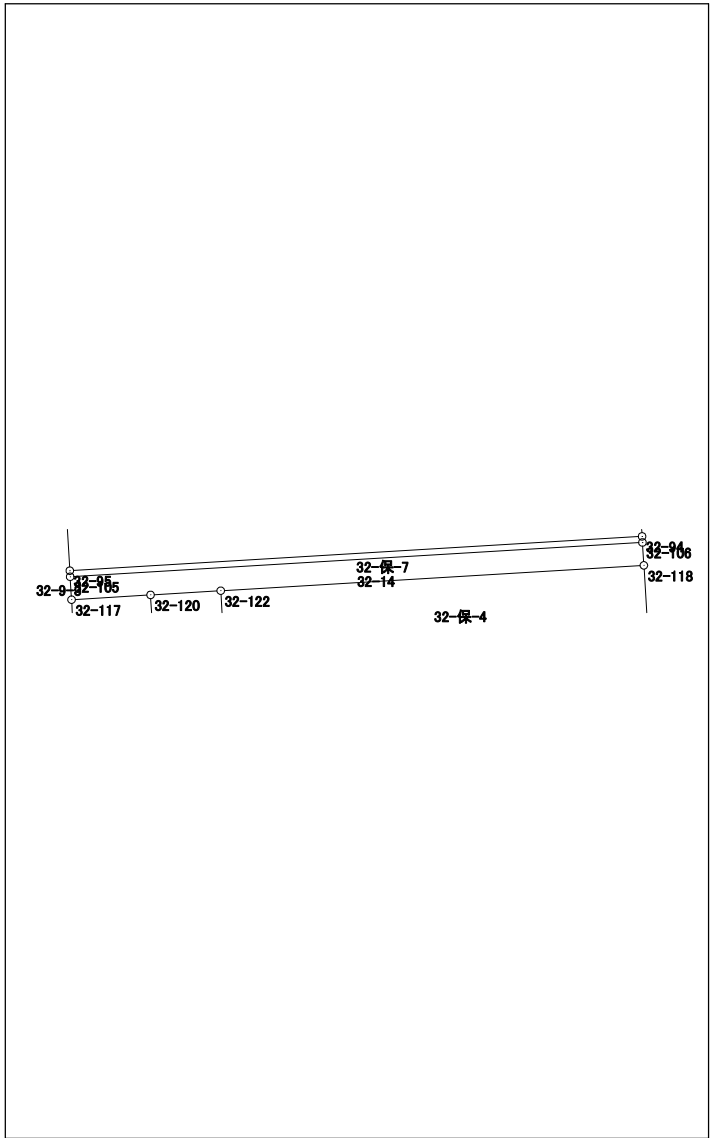


面積計算書 (座標法)

世界測地系 (測地成果2011)

所 在	地 番	公簿地目	現況地目	地 積	所 有 者
前橋市六供町二丁目	32-保-2			34.00 m ²	

点 名	X 座標	Y 座標	辺 長	方 向 角	測 角	DX	倍 積 (Y×DX)
32-92	41593.483	-68214.301	19.324	86-32-16	90-03-26	-0.589	40178.223289
32-93	41594.650	-68195.012	1.760	356-34-48	90-02-32	2.924	-199402.215088
32-107	41596.407	-68195.117	19.327	266-32-07	89-57-19	0.589	-40166.923913
32-108	41595.239	-68214.409	1.759	176-28-50	89-56-43	-2.924	199458.931916

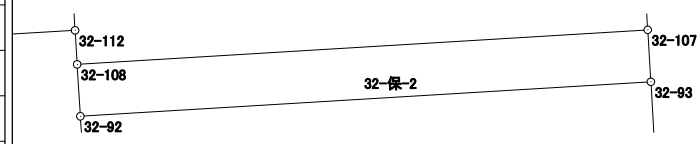


倍面積	68.016204
面 積	34.0081020

面積計算書 (座標法)

世界測地系 (測地成果2011)

所在	地番	公簿地目	現況地目	地積	所有者
前橋市六供町二丁目	32-保-3			94.00 m ²	

点名	X座標	Y座標	辺長	方向角	測角	DX	倍積 (Y×DX)
32-95	41565.534	-68212.612	19.325	86-34-14	90-02-09	-3.699	252318.451788
32-94	41566.690	-68193.322	4.865	356-32-50	89-58-36	6.012	-409978.251864
32-103	41571.546	-68193.615	19.326	266-34-04	90-01-14	3.699	-252248.181885
32-104	41570.389	-68212.906	4.864	176-32-05	89-58-01	-6.012	410095.990872

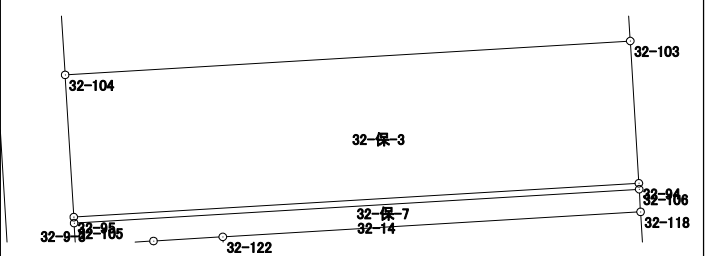


倍面積	188.008911
面積	94.0044555

面積計算書（座標法）

所在	地番	公簿地目	現況地目	地積	所有者
前橋市六供町二丁目	32-保-5			4.00 m ²	

点名	X座標	Y座標	辺長	方向角	測角	DX	倍積 (Y×DX)
32-126	41559.317	-68192.871	0.334	356-33-47	89-57-53	1.045	-71261.550195
32-128	41559.650	-68192.891	11.999	266-36-11	90-02-24	-0.378	25776.912798
32-129	41558.939	-68204.869	0.335	176-34-24	89-58-13	-1.045	71274.088105
32-127	41558.605	-68204.849	11.999	86-35-54	90-01-30	0.378	-25781.432922
倍面積						8.017786	
面積						4.0088930	

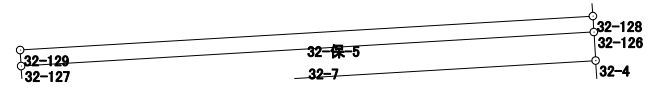


面積計算書 (座標法)

世界測地系 (測地成果2011)

所在	地番	公簿地目	現況地目	地積	所有者
前橋市六供町二丁目	32-保-6			113.00 m ²	

点名	X座標	Y座標	辺長	方向角	測角	DX	倍積 (Y×DX)
32-44	41602.652	-68230.528	7.226	176-31-02	90-00-30	-7.491	511114.885248
32-111	41595.439	-68230.089	15.639	86-30-49	89-59-47	-6.262	427256.817318
32-112	41596.390	-68214.479	7.227	356-29-36	89-58-47	8.164	-556903.006556
32-51	41603.603	-68214.921	0.771	266-30-25	90-00-49	7.166	-488828.123886
32-115	41603.556	-68215.691	10.299	266-30-55	180-00-30	-0.673	45909.160043
32-101	41602.930	-68225.971	4.565	266-30-32	179-59-37	-0.904	61676.277784

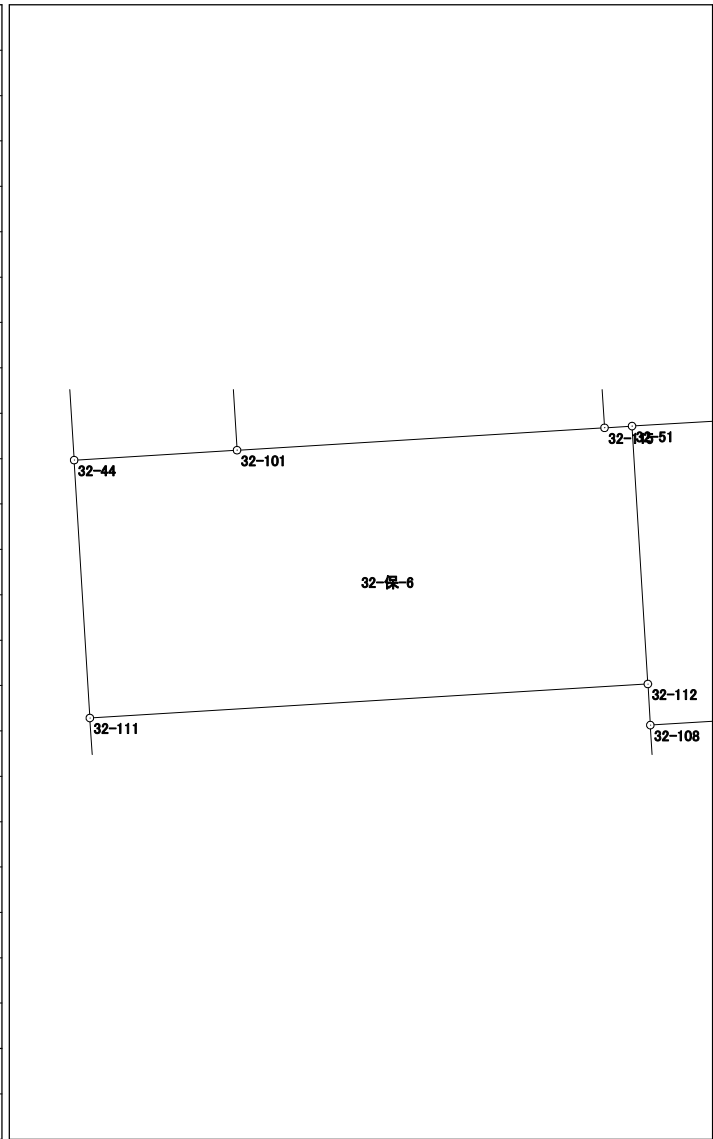


面積計算書 (座標法)

世界測地系 (測地成果2011)

所 在	地 番	公簿地目	現況地目	地 積	所 有 者
前橋市六供町二丁目	32-保-7			3.94 m ²	

点 名	X 座標	Y 座標	辺 長	方 向 角	測 角	DX	倍 積 (Y×DX)
32-94	41566.690	-68193.322	19.325	266-34-14	89-56-13	-0.952	64920.042544
32-95	41565.534	-68212.612	0.204	176-38-01	90-03-47	-1.360	92769.152320
32-105	41565.330	-68212.600	19.325	86-34-14	89-56-13	0.952	-64938.395200
32-106	41566.486	-68193.310	0.204	356-38-01	90-03-47	1.360	-92742.901600
						倍面積	7.898064
						面 積	3.9490320

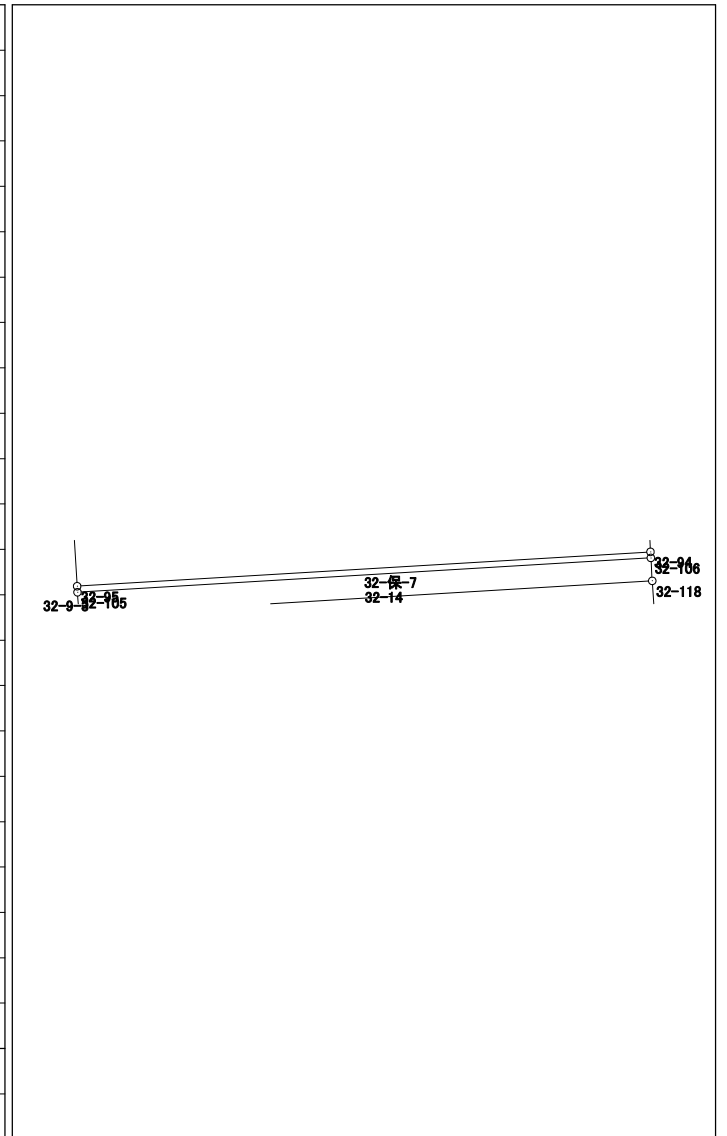

面積計算書 (座標法)

世界測地系 (測地成果2011)

所在	地番	公簿地目	現況地目	地積	所有者
前橋市六供町二丁目	32-保-8			18.67 m ²	

点名	X座標	Y座標	辺長	方向角	測角	DX	倍積 (Y×DX)
32-117	41564.558	-68212.553	6.998	176-31-05	89-57-23	-7.145	487378.691185
32-50	41557.573	-68212.128	2.668	86-36-16	90-05-11	-6.827	465684.197856
32-119	41557.731	-68209.465	7.000	356-31-09	89-54-53	7.145	-487356.627425
32-120	41564.718	-68209.890	2.668	266-33-42	90-02-33	6.827	-465668.919030
						倍面積	37.342586
						面積	18.6712930

