



33街区 画地出来形確認図 (2968.39m²)

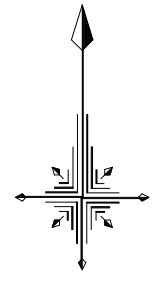

S=1/500

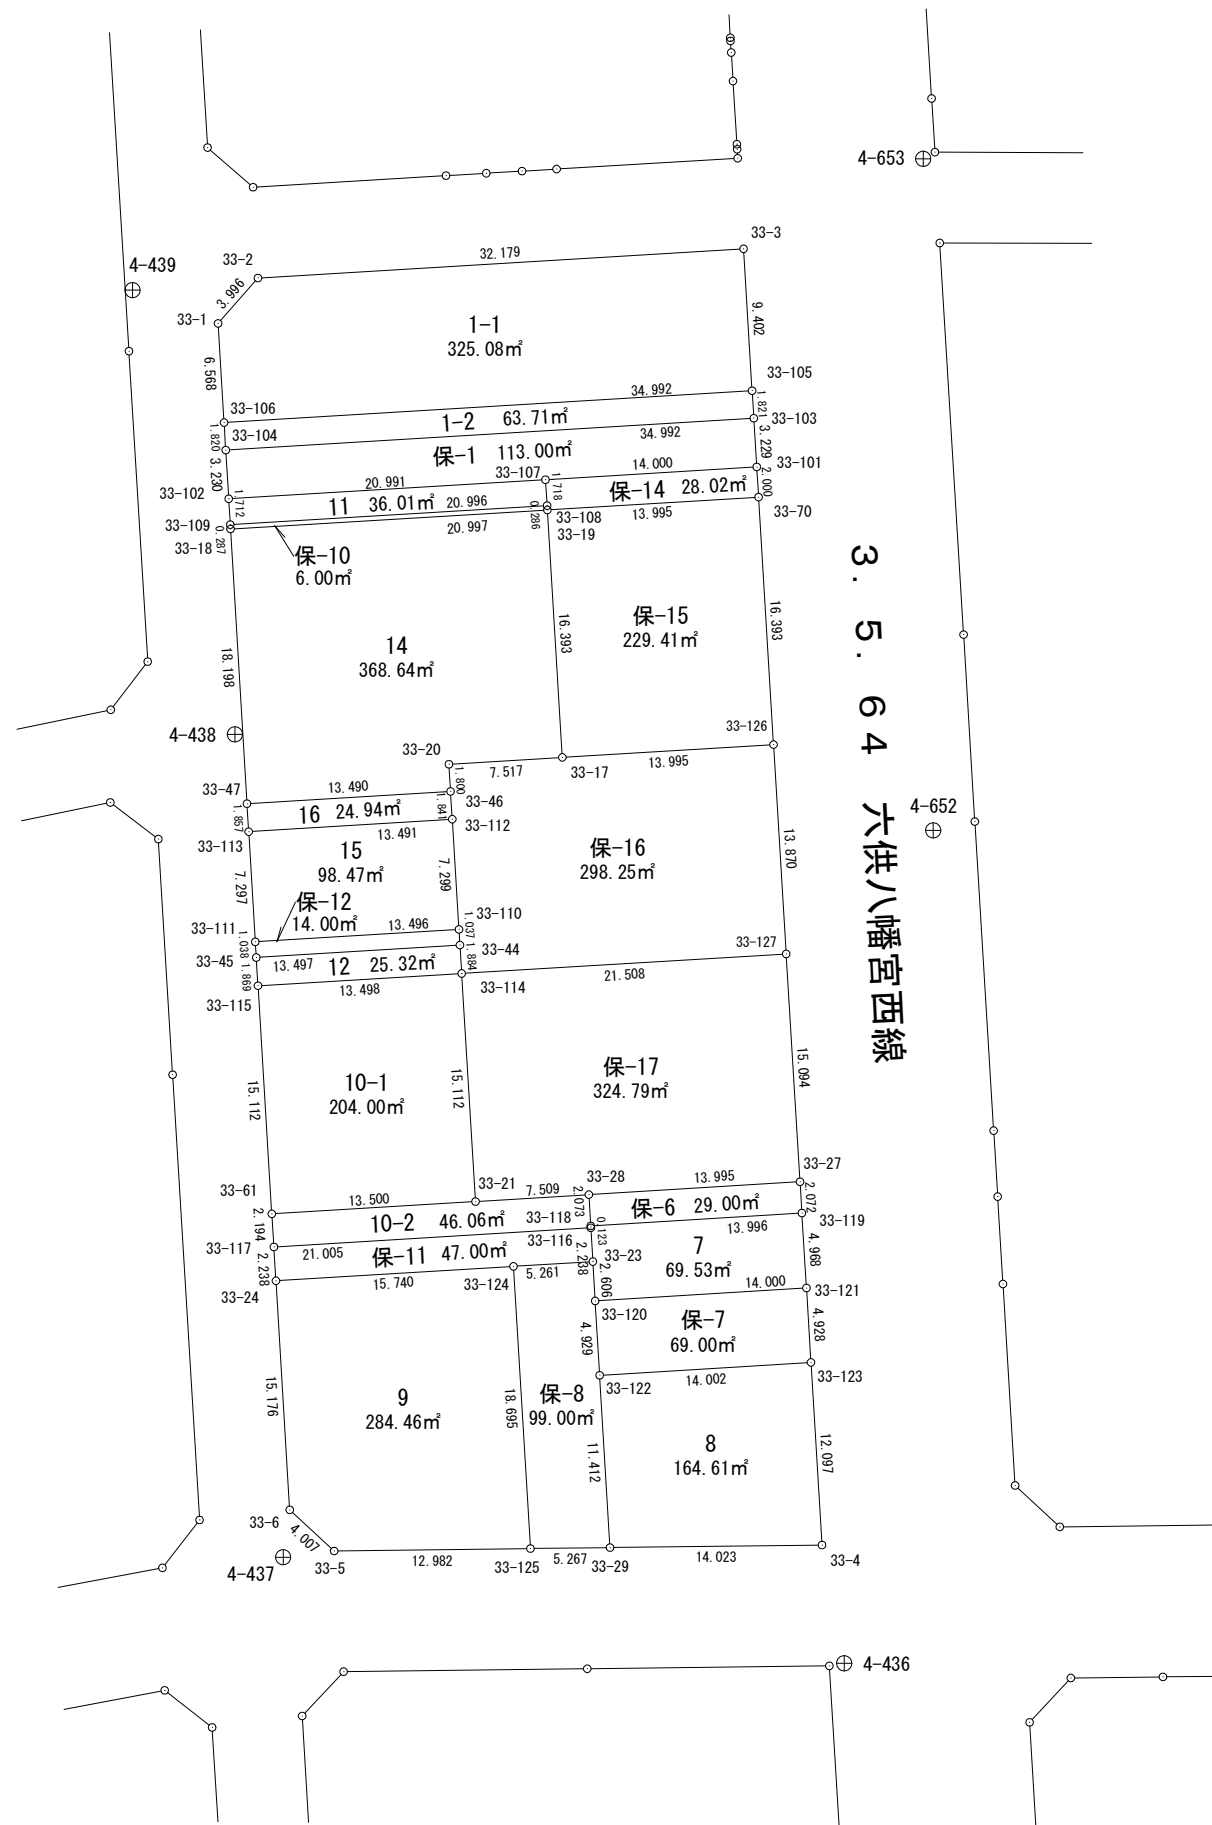


面積計算書 (座標法)

世界測地系 (測地成果2011)

所 在	地 番	公簿地目	現況地目	地 積	所 有 者
前橋市六供町二丁目	33-1-2			63.71 m ²	

点 名	X 座標	Y 座標	辺 長	方 向 角	測 角	DX	倍 積 (Y×DX)
33-103	41541.532	-68191.770	1.821	356-32-15	89-59-16	3.924	-267584.505480
33-105	41543.350	-68191.880	34.992	266-32-53	90-00-38	-0.289	19707.453320
33-106	41541.243	-68226.809	1.820	176-32-08	89-59-15	-3.924	267721.998516
33-104	41539.426	-68226.699	34.992	86-32-59	90-00-51	0.289	-19717.516011

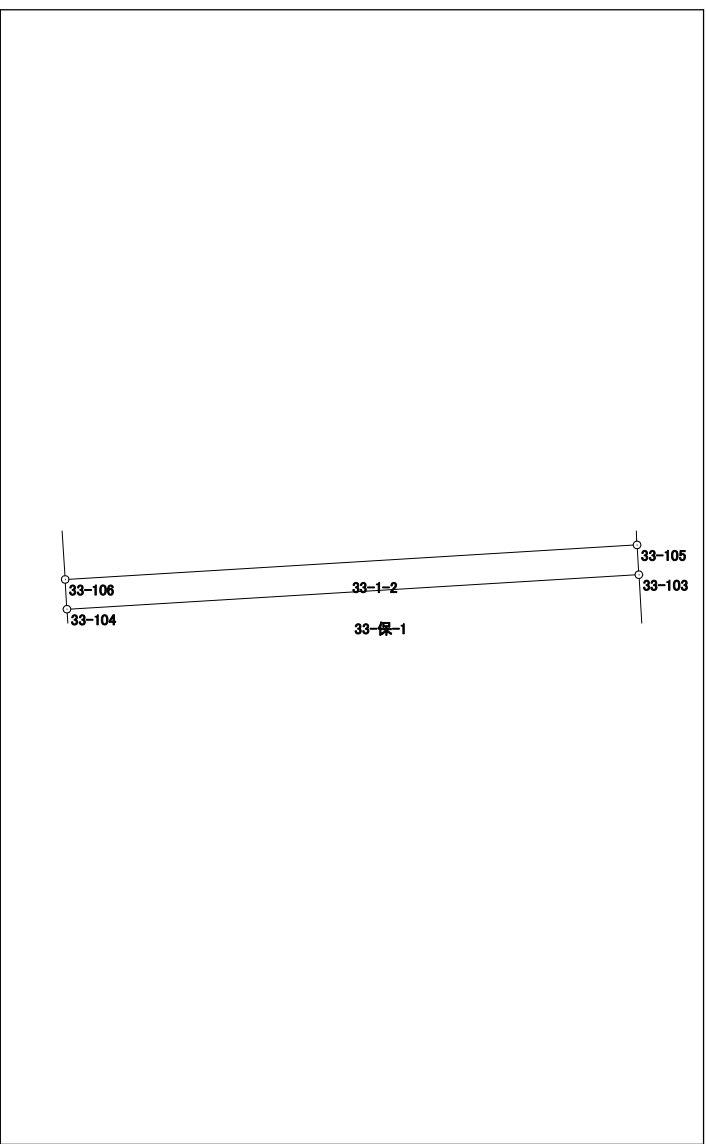

倍面積	127.430345
面 積	63.7151725

面積計算書（座標法）

世界測地系（測地成果2011）

所 在	地 番	公簿地目	現況地目	地 積	所 有 者
前橋市六供町二丁目	33-7			69.53 m ²	


点 名	X 座標	Y 座標	辺 長	方 向 角	測 角	DX	倍 積 (Y×DX)	
33-119	41488.971	-68188.586	13.996	266-30-21	89-58-04	4.106	-279982.334116	
33-118	41488.118	-68202.556	0.123	176-44-34	90-14-13	-0.976	66565.694656	
33-116	41487.995	-68202.549	2.238	176-35-35	179-51-01	-2.357	160753.407993	
33-23	41485.761	-68202.416	2.606	176-34-04	179-58-29	-4.835	329758.681360	
33-120	41483.160	-68202.260	14.000	86-30-40	89-56-36	-1.749	119285.752740	
33-121	41484.012	-68188.286	4.968	356-32-17	90-01-37	5.811	-396242.129946	
							倍面積	139.072687
							面 積	69.5363435

面積計算書 (座標法)

世界測地系 (測地成果2011)

所在	地番	公簿地目	現況地目	地積	所有者
前橋市六供町二丁目	33-8			164.61 m ²	

点名	X座標	Y座標	辺長	方向角	測角	DX	倍積 (Y×DX)
33-122	41478.240	-68201.964	11.412	176-33-13	90-02-46	-12.244	835064.847216
33-29	41466.849	-68201.278	14.023	89-18-34	92-45-21	-11.222	765354.741716
33-4	41467.018	-68187.256	12.097	356-31-51	87-13-17	12.244	-834884.762464
33-123	41479.093	-68187.988	14.002	266-30-27	89-58-36	11.222	-765205.601336

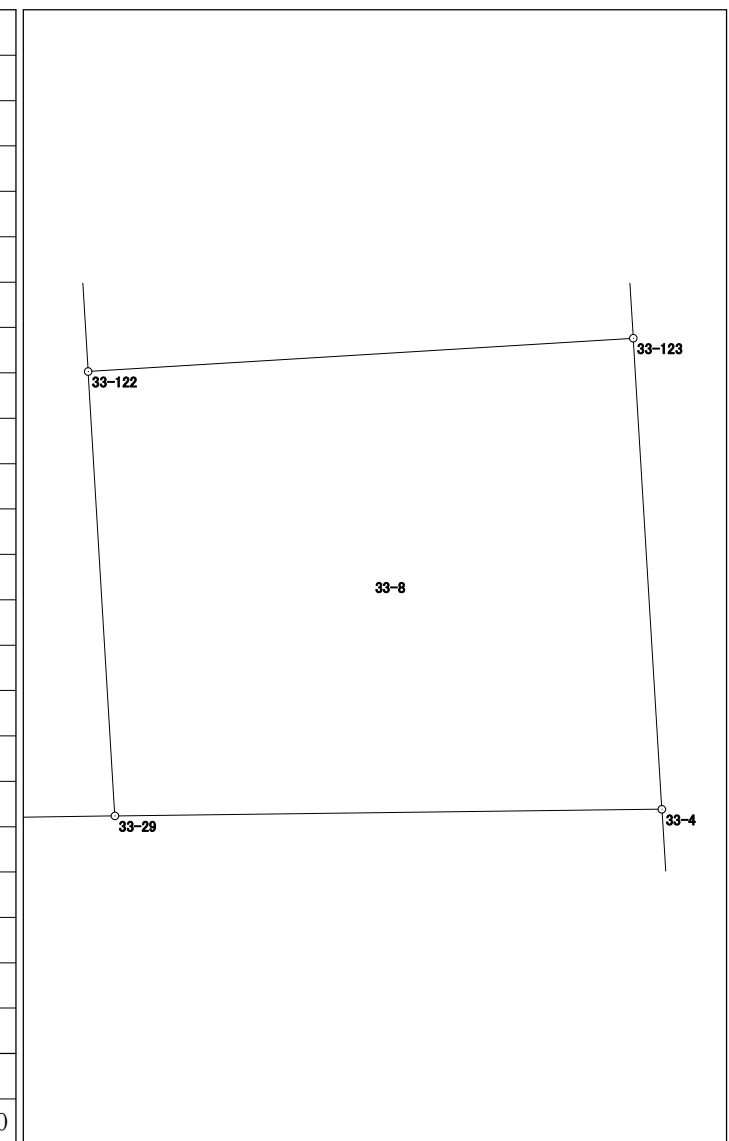


倍面積	329.225132
面積	164.6125660

面積計算書 (座標法)

世界測地系 (測地成果2011)

所在	地番	公簿地目	現況地目	地積	所有者
前橋市六供町二丁目	33-9			284.46 m ²	

点名	X座標	Y座標	辺長	方向角	測角	DX	倍積 (Y×DX)
33-124	41485.444	-68207.667	15.740	266-32-23	89-58-50	17.711	-1208025.990237
33-24	41484.494	-68223.378	15.176	176-33-17	90-00-54	-16.099	1098328.162422
33-6	41469.345	-68222.466	4.007	132-48-20	136-15-03	-17.872	1219271.912352
33-5	41466.622	-68219.526	12.982	89-17-22	136-29-02	-2.562	174778.425612
33-125	41466.783	-68206.545	18.695	356-33-33	87-16-11	18.822	-1283783.589990
						倍面積	568.920159
						面積	284.4600795

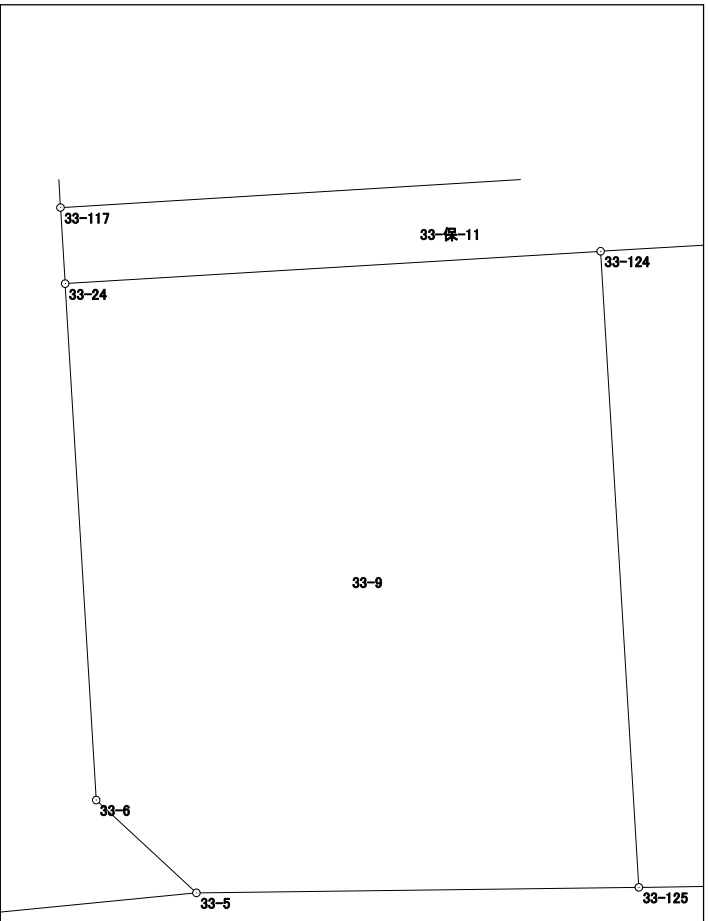


面積計算書 (座標法)

世界測地系 (測地成果2011)

所在	地番	公簿地目	現況地目	地積	所有者
前橋市六供町二丁目	33-10-1			204.00 m ²	

点名	X座標	Y座標	辺長	方向角	測角	DX	倍積 (Y×DX)
33-21	41489.729	-68210.175	15.112	356-31-02	89-57-40	15.895	-1084200.731625
33-114	41504.813	-68211.093	13.498	266-33-20	90-02-18	14.273	-973576.930389
33-115	41504.002	-68224.567	15.112	176-31-30	89-58-10	-15.895	1084429.492465
33-61	41488.918	-68223.651	13.500	86-33-22	90-01-52	-14.273	973756.170723

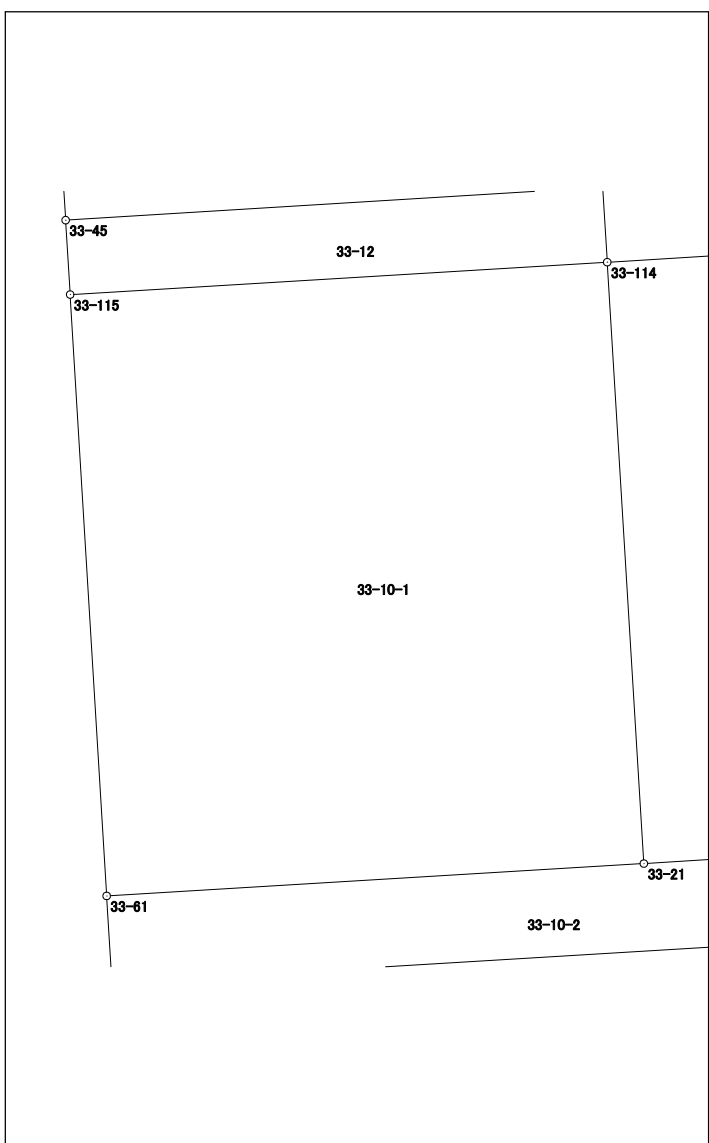


倍面積	408.001174
面積	204.0005870

面積計算書 (座標法)

世界測地系 (測地成果2011)

所在	地番	公簿地目	現況地目	地積	所有者
前橋市六供町二丁目	33-10-2			46.06 m ²	

点名	X座標	Y座標	辺長	方向角	測角	DX	倍積 (Y×DX)
33-116	41487.995	-68202.549	0.123	356-44-34	90-12-03	1.390	-94801.543110
33-118	41488.118	-68202.556	2.073	356-34-13	179-49-39	2.192	-149500.002752
33-28	41490.187	-68202.680	7.509	266-30-11	89-55-58	1.611	-109874.517480
33-21	41489.729	-68210.175	13.500	266-33-22	180-03-11	-1.269	86558.712075
33-61	41488.918	-68223.651	2.194	176-28-21	89-54-59	-3.001	204739.176651
33-117	41486.728	-68223.516	21.005	86-32-31	90-04-10	-0.923	62970.305268

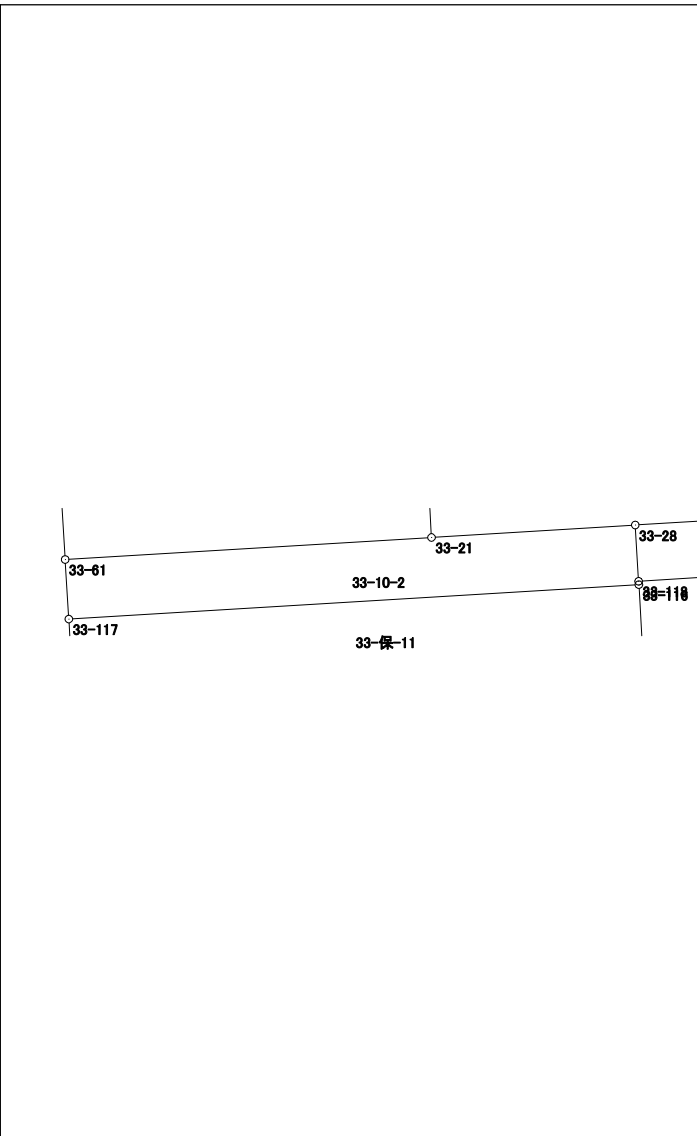


倍面積	92.130652
面積	46.0653260

面積計算書 (座標法)

世界測地系 (測地成果2011)

所在	地番	公簿地目	現況地目	地積	所有者
前橋市六供町二丁目	33-11			36.01 m ²	

点名	X座標	Y座標	辺長	方向角	測角	DX	倍積 (Y×DX)
33-108	41535.751	-68205.441	1.718	356-21-48	89-47-54	2.973	-202774.776093
33-107	41537.466	-68205.550	20.991	266-32-52	90-11-04	0.451	-30760.703050
33-102	41536.202	-68226.503	1.712	176-31-03	89-58-11	-2.973	202837.393419
33-109	41534.493	-68226.399	20.996	86-33-54	90-02-51	-0.451	30770.105949

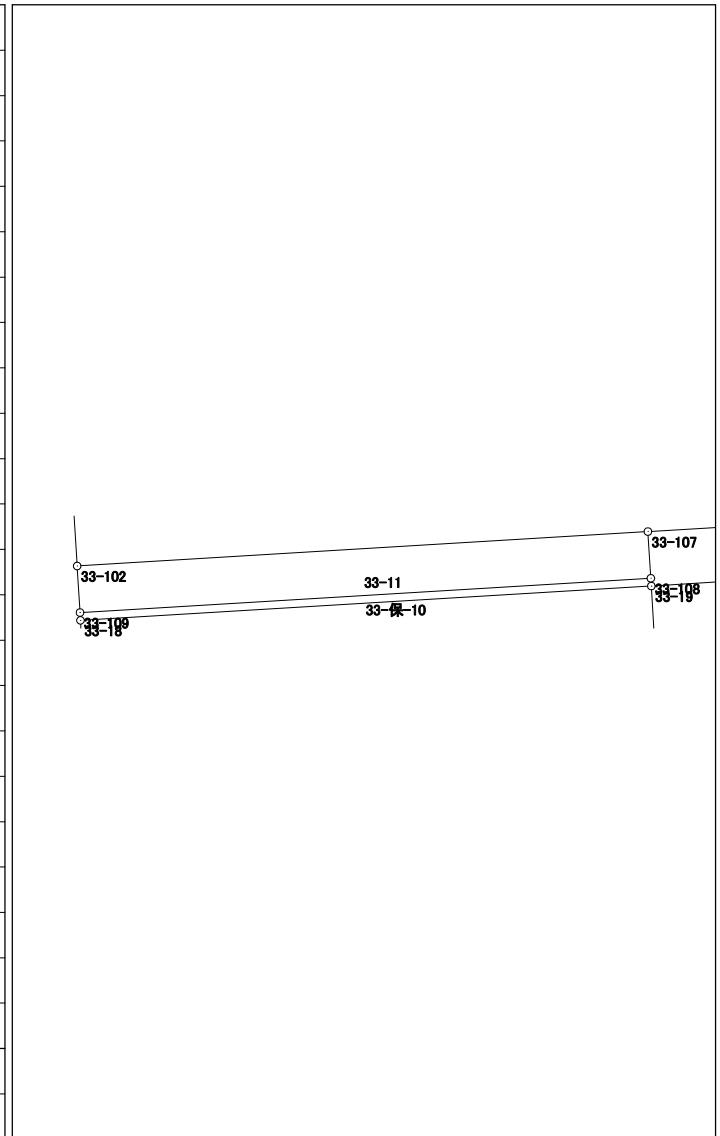


倍面積	72.020225
面積	36.0101125

面積計算書 (座標法)

世界測地系 (測地成果2011)

所在	地番	公簿地目	現況地目	地積	所有者
前橋市六供町二丁目	33-12			25.32 m ²	

点名	X座標	Y座標	辺長	方向角	測角	D _X	倍積 (Y×D _X)
33-114	41504.813	-68211.093	1.884	356-29-58	89-56-38	2.691	-183556.051263
33-44	41506.693	-68211.208	13.497	266-29-44	89-59-46	1.055	-71962.824440
33-45	41505.868	-68224.680	1.869	176-32-04	90-02-20	-2.691	183592.613880
33-115	41504.002	-68224.567	13.498	86-33-20	90-01-16	-1.055	71976.918185

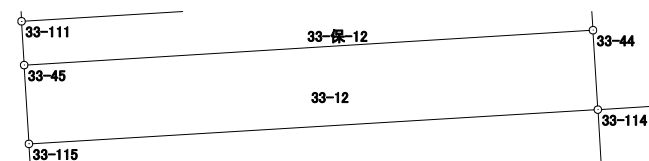


倍面積	50.656362
面積	25.3281810

面積計算書（座標法）

世界測地系（測地成果2011）

所在	地番	公簿地目	現況地目	地積	所有者
前橋市六供町二丁目	33-14			368.64 m ²	

点名	X座標	Y座標	辺長	方向角	測角	DX	倍積 (Y×DX)
33-18	41534.207	-68226.382	18.198	176-34-09	90-00-24	-19.424	1325229.243968
33-47	41516.042	-68225.293	13.490	86-33-43	89-59-34	-17.356	1184118.185308
33-46	41516.851	-68211.827	1.800	356-33-38	89-59-55	2.606	-177760.021162
33-20	41518.648	-68211.935	7.517	86-31-47	269-58-09	2.252	-153613.277620
33-17	41519.103	-68204.432	16.393	356-32-03	90-00-16	16.818	-1147062.137376
33-19	41535.466	-68205.423	20.997	266-33-45	90-01-42	15.104	-1030174.708992

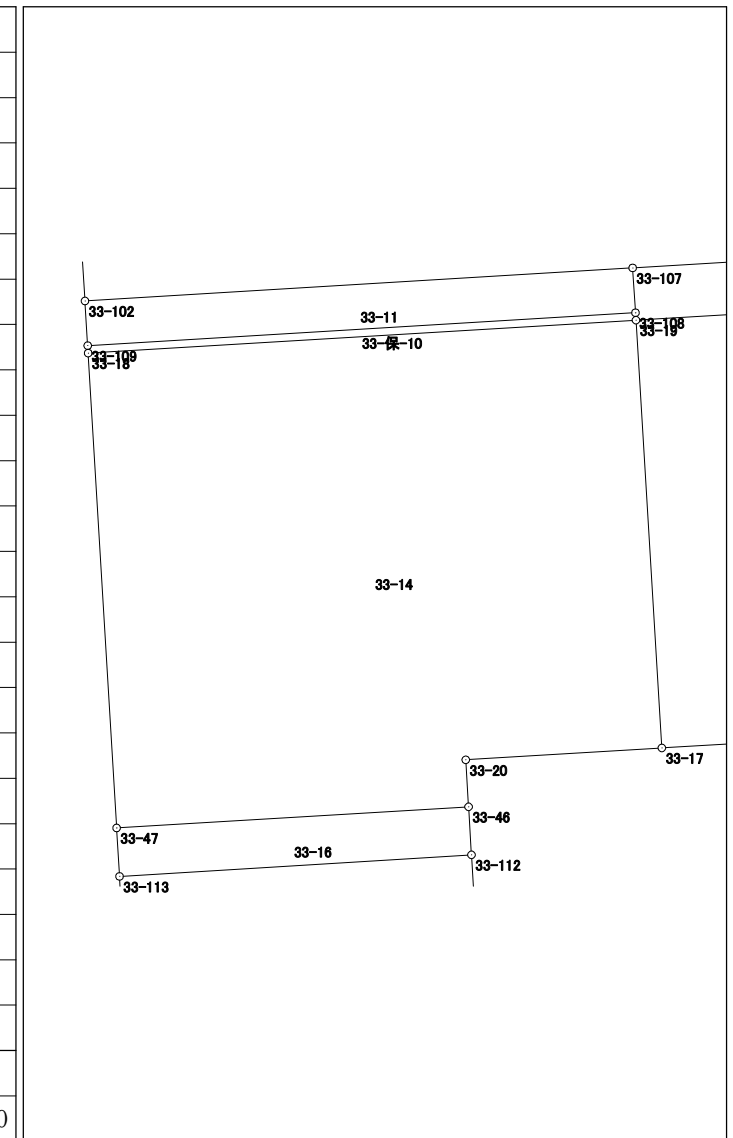


倍面積	737.284126
面積	368.6420630

面積計算書 (座標法)

世界測地系 (測地成果2011)

所在	地番	公簿地目	現況地目	地積	所有者
前橋市六供町二丁目	33-15			98.47 m ²	

点名	X座標	Y座標	辺長	方向角	測角	DX	倍積 (Y×DX)
33-110	41507.728	-68211.271	7.299	356-30-44	90-00-45	8.109	-553125.196539
33-112	41515.013	-68211.715	13.491	266-29-39	89-58-55	6.460	-440647.678900
33-113	41514.188	-68225.181	7.297	176-33-04	90-03-25	-8.109	553237.992729
33-111	41506.904	-68224.742	13.496	86-29-59	89-56-55	-6.460	440731.833320
						倍面積	196.950610
						面積	98.4753050

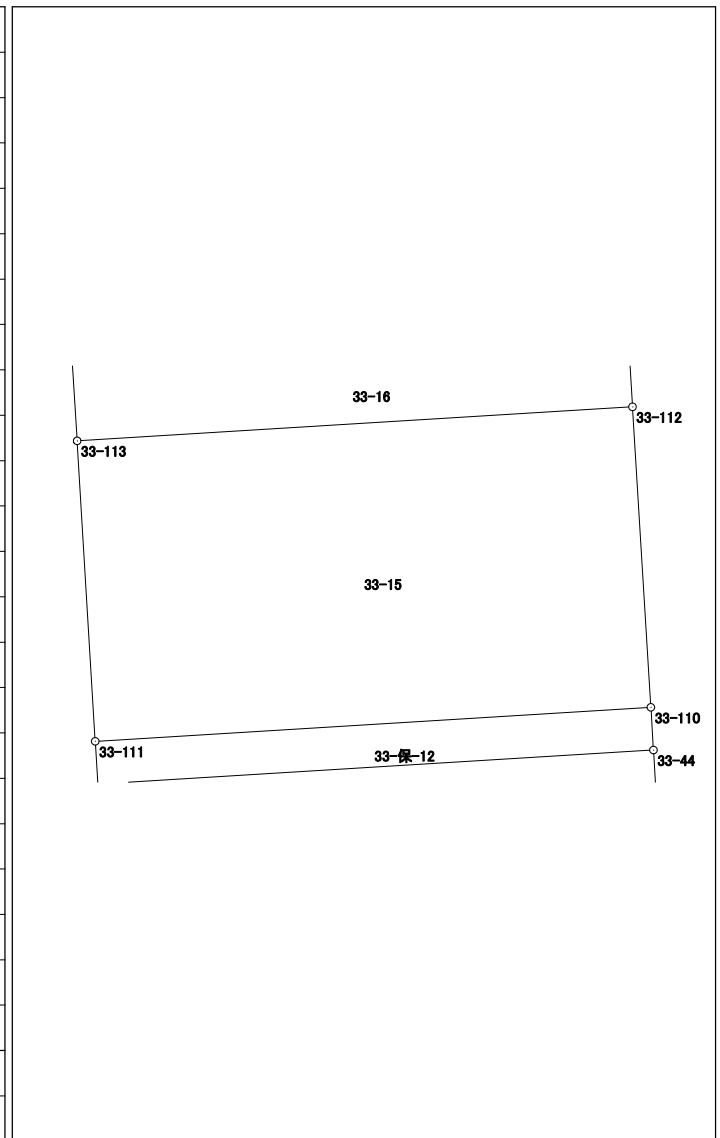


面積計算書（座標法）

世界測地系（測地成果2011）

所 在	地 番	公簿地目	現況地目	地 積	所 有 者
前橋市六供町二丁目	33-保-1			113.00 m ²	

点 名	X 座標	Y 座標	辺 長	方 向 角	測 角	DX	倍 積 (Y×DX)
33-102	41536.202	-68226.503	20.991	86-32-52	90-01-36	-1.960	133723.945880
33-107	41537.466	-68205.550	14.000	86-32-53	180-00-01	2.107	-143709.093850
33-101	41538.309	-68191.575	3.229	356-32-16	89-59-23	4.066	-277266.943950
33-103	41541.532	-68191.770	34.992	266-32-59	90-00-43	1.117	-76170.207090
33-104	41539.426	-68226.699	3.230	176-31-16	89-58-17	-5.330	363648.305670
						倍面積	226.006660
						面 積	113.0033300

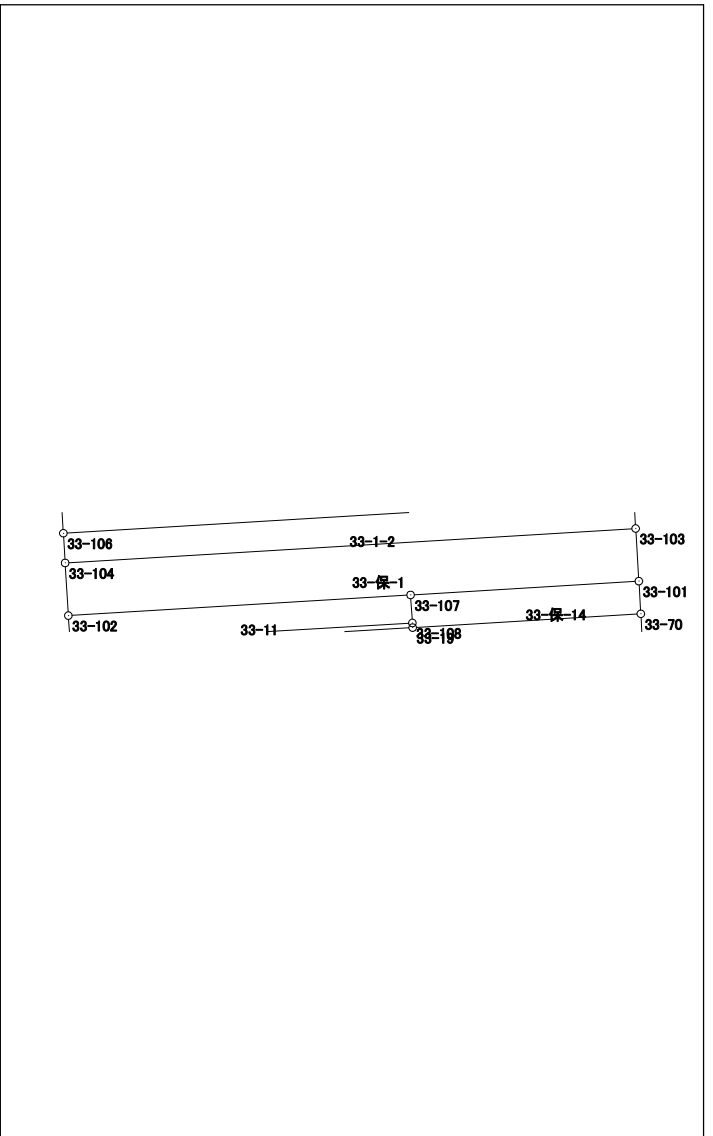

面積計算書（座標法）

世界測地系（測地成果2011）

所 在	地 番	公簿地目	現況地目	地 積	所 有 者
前橋市六供町二丁目	33-保-6			29.00 m ²	


点 名	X 座標	Y 座標	辺 長	方 向 角	測 角	DX	倍 積 (Y×DX)		
33-28	41490.187	-68202.680	2.073	176-34-13	90-03-38	-2.921	199220.028280		
33-118	41488.118	-68202.556	13.996	86-30-21	89-56-08	-1.216	82934.308096		
33-119	41488.971	-68188.586	2.072	356-32-28	90-02-07	2.921	-199178.859706		
33-27	41491.039	-68188.711	13.995	266-30-35	89-58-07	1.216	-82917.472576		
倍面積							58.004094		
面 積							29.0020470		

面積計算書 (座標法)

世界測地系 (測地成果2011)

所在	地番	公簿地目	現況地目	地積	所有者
前橋市六供町二丁目	33-保-8			99.00 m ²	

点名	X座標	Y座標	辺長	方向角	測角	DX	倍積 (Y×DX)
33-23	41485.761	-68202.416	5.261	266-32-43	89-58-39	2.284	-155774.318144
33-124	41485.444	-68207.667	18.695	176-33-33	90-00-50	-18.978	1294445.104326
33-125	41466.783	-68206.545	5.267	89-16-55	92-43-22	-18.595	1268300.704275
33-29	41466.849	-68201.278	11.412	356-33-13	87-16-18	11.457	-781382.042046
33-122	41478.240	-68201.964	4.929	356-33-26	180-00-13	16.311	-1112442.234804
33-120	41483.160	-68202.260	2.606	356-34-04	180-00-38	7.521	-512949.197460
						倍面積	198.016147
						面積	99.0080735

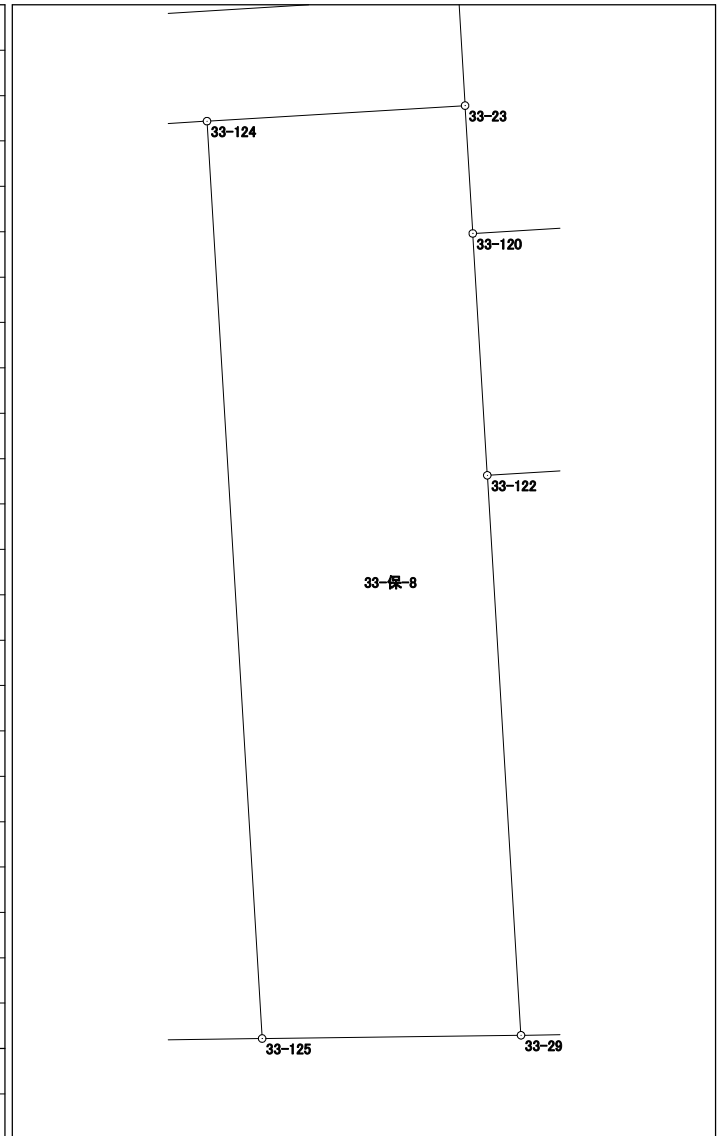


面積計算書 (座標法)

世界測地系 (測地成果2011)

所在	地番	公簿地目	現況地目	地積	所有者
前橋市六供町二丁目	33-保-10			6.00 m ²	

点名	X座標	Y座標	辺長	方向角	測角	DX	倍積 (Y×DX)
33-19	41535.466	-68205.423	0.286	356-23-10	89-49-25	1.544	-105309.173112
33-108	41535.751	-68205.441	20.996	266-33-54	90-10-44	-0.973	66363.894093
33-109	41534.493	-68226.399	0.287	176-35-54	90-02-00	-1.544	105341.560056
33-18	41534.207	-68226.382	20.997	86-33-45	89-57-51	0.973	-66384.269686
						倍面積	12.011351
						面積	6.0056755

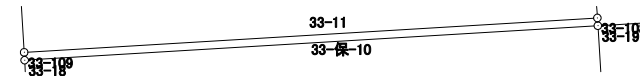


面積計算書 (座標法)

世界測地系 (測地成果2011)

所 在	地 番	公簿地目	現況地目	地 積	所 有 者
前橋市六供町二丁目	33-保-11			47.00 m ²	

点 名	X 座標	Y 座標	辺 長	方 向 角	測 角	DX	倍 積 (Y×DX)
33-24	41484.494	-68223.378	15.740	86-32-23	90-04-28	-1.284	87598.817352
33-124	41485.444	-68207.667	5.261	86-32-43	180-00-20	1.267	-86419.114089
33-23	41485.761	-68202.416	2.238	356-35-35	90-02-52	2.551	-173984.363216
33-116	41487.995	-68202.549	21.005	266-32-31	89-56-56	0.967	-65951.864883
33-117	41486.728	-68223.516	2.238	176-27-55	89-55-24	-3.501	238850.529516
						倍面積	94.004680
						面 積	47.0023400

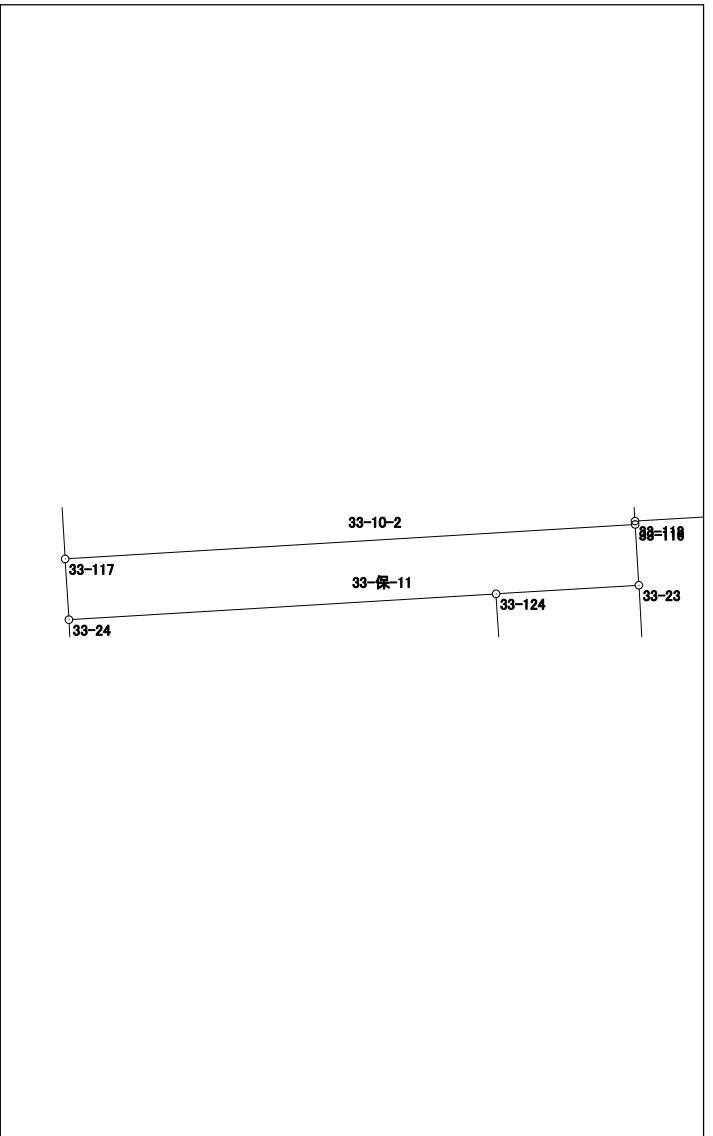


面積計算書（座標法）

世界測地系（測地成果2011）

所 在	地 番	公簿地目	現況地目	地 積	所 有 者
前橋市六供町二丁目	33-保-12			14.00 m ²	

点 名	X 座標	Y 座標	辺 長	方 向 角	測 角	DX	倍 積 (Y×DX)
33-45	41505.868	-68224.680	13.497	86-29-44	89-55-13	-0.211	14395.407480
33-44	41506.693	-68211.208	1.037	356-31-00	90-01-16	1.860	-126872.846880
33-110	41507.728	-68211.271	13.496	266-29-59	89-58-59	0.211	-14392.578181
33-111	41506.904	-68224.742	1.038	176-34-31	90-04-32	-1.860	126898.020120

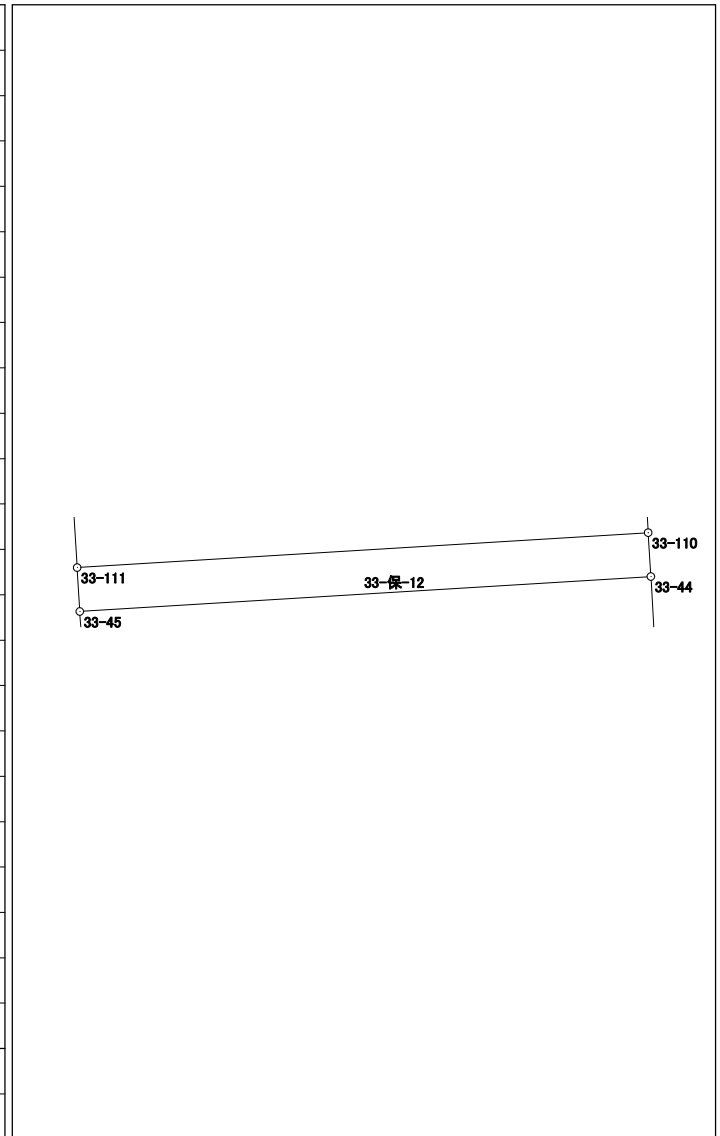

面積計算書（座標法）

世界測地系（測地成果2011）

所 在	地 番	公簿地目	現況地目	地 積	所 有 者
前橋市六供町二丁目	33-保-14			28.02 m ²	

点 名	X 座標	Y 座標	辺 長	方 向 角	測 角	DX	倍 積 (Y×DX)	
33-19	41535.466	-68205.423	13.995	86-31-49	90-08-39	0.562	-38331.447726	
33-70	41536.313	-68191.454	2.000	356-31-51	90-00-02	2.843	-193868.303722	
33-101	41538.309	-68191.575	14.000	266-32-53	90-01-02	1.153	-78624.885975	
33-107	41537.466	-68205.550	1.718	176-21-48	89-48-55	-2.558	174469.796900	
33-108	41535.751	-68205.441	0.286	176-23-10	180-01-22	-2.000	136410.882000	
						倍面積	56.041477	
						面 積	28.0207385	

面積計算書 (座標法)

世界測地系 (測地成果2011)

所在	地番	公簿地目	現況地目	地積	所有者
前橋市六供町二丁目	33-保-15			229.41 m ²	


点名	X 座標	Y 座標	辺長	方向角	測角	DX	倍積 (Y×DX)	
33-19	41535.466	-68205.423	16.393	176-32-03	90-00-14	-17.210	1173815.329830	
33-17	41519.103	-68204.432	13.995	86-31-49	89-59-46	-15.516	1058259.966912	
33-126	41519.950	-68190.463	16.393	356-32-03	90-00-14	17.210	-1173557.868230	
33-70	41536.313	-68191.454	13.995	266-31-49	89-59-46	15.516	-1058058.600264	
							倍面積	
							面積	229.414240

面積計算書 (座標法)

世界測地系 (測地成果2011)

所在	地番	公簿地目	現況地目	地積	所有者
前橋市六供町二丁目	33-保-16			298.25 m ²	

点名	X座標	Y座標	辺長	方向角	測角	DX	倍積 (Y×DX)
33-20	41518.648	-68211.935	1.800	176-33-38	90-01-51	-2.252	153613.277620
33-46	41516.851	-68211.827	1.841	176-30-47	179-57-09	-3.635	247949.991145
33-112	41515.013	-68211.715	7.299	176-30-44	179-59-57	-9.123	622295.475945
33-110	41507.728	-68211.271	1.037	176-31-00	180-00-16	-8.320	567517.774720
33-44	41506.693	-68211.208	1.884	176-29-58	179-58-58	-2.915	198835.671320
33-114	41504.813	-68211.093	21.508	86-33-22	90-03-24	-0.588	40108.122684
33-127	41506.105	-68189.624	13.870	356-31-56	89-58-34	15.137	-1032186.338488
33-126	41519.950	-68190.463	13.995	266-31-49	89-59-53	12.998	-886339.638074
33-17	41519.103	-68204.432	7.517	266-31-47	179-59-58	-1.302	88802.170464
						倍面積	596.507336
						面積	298.2536680

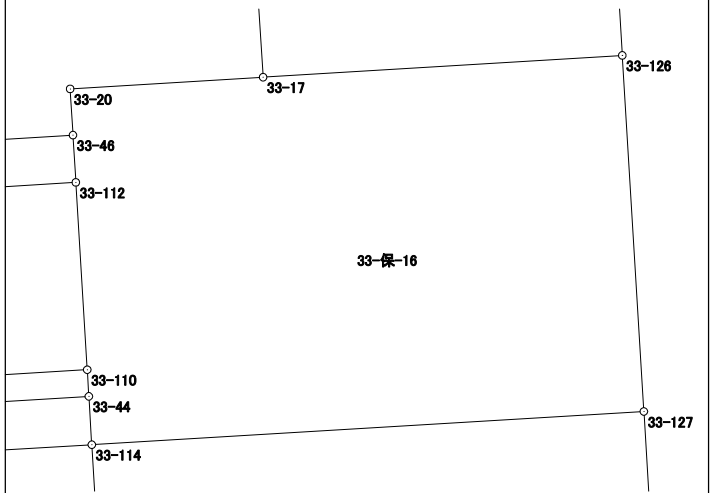

面積計算書 (座標法)

世界測地系 (測地成果2011)

所 在	地 番	公簿地目	現況地目	地 積	所 有 者
前橋市六供町二丁目	33-保-17			324.79 m ²	

点 名	X 座標	Y 座標	辺 長	方 向 角	測 角	DX	倍 積 (Y×DX)
33-114	41504.813	-68211.093	15.112	176-31-02	89-57-40	-16.376	1117024.858968
33-21	41489.729	-68210.175	7.509	86-30-11	89-59-09	-14.626	997642.019550
33-28	41490.187	-68202.680	13.995	86-30-35	180-00-24	1.310	-89345.510800
33-27	41491.039	-68188.711	15.094	356-31-56	90-01-21	15.918	-1085427.901698
33-127	41506.105	-68189.624	21.508	266-33-22	90-01-26	13.774	-939243.880976
						倍面積	649.585044
						面 積	324.7925220

