



3 4 街区 画地出来形確認図 (3867.31m²)

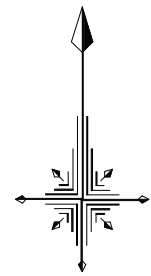

S=1/500

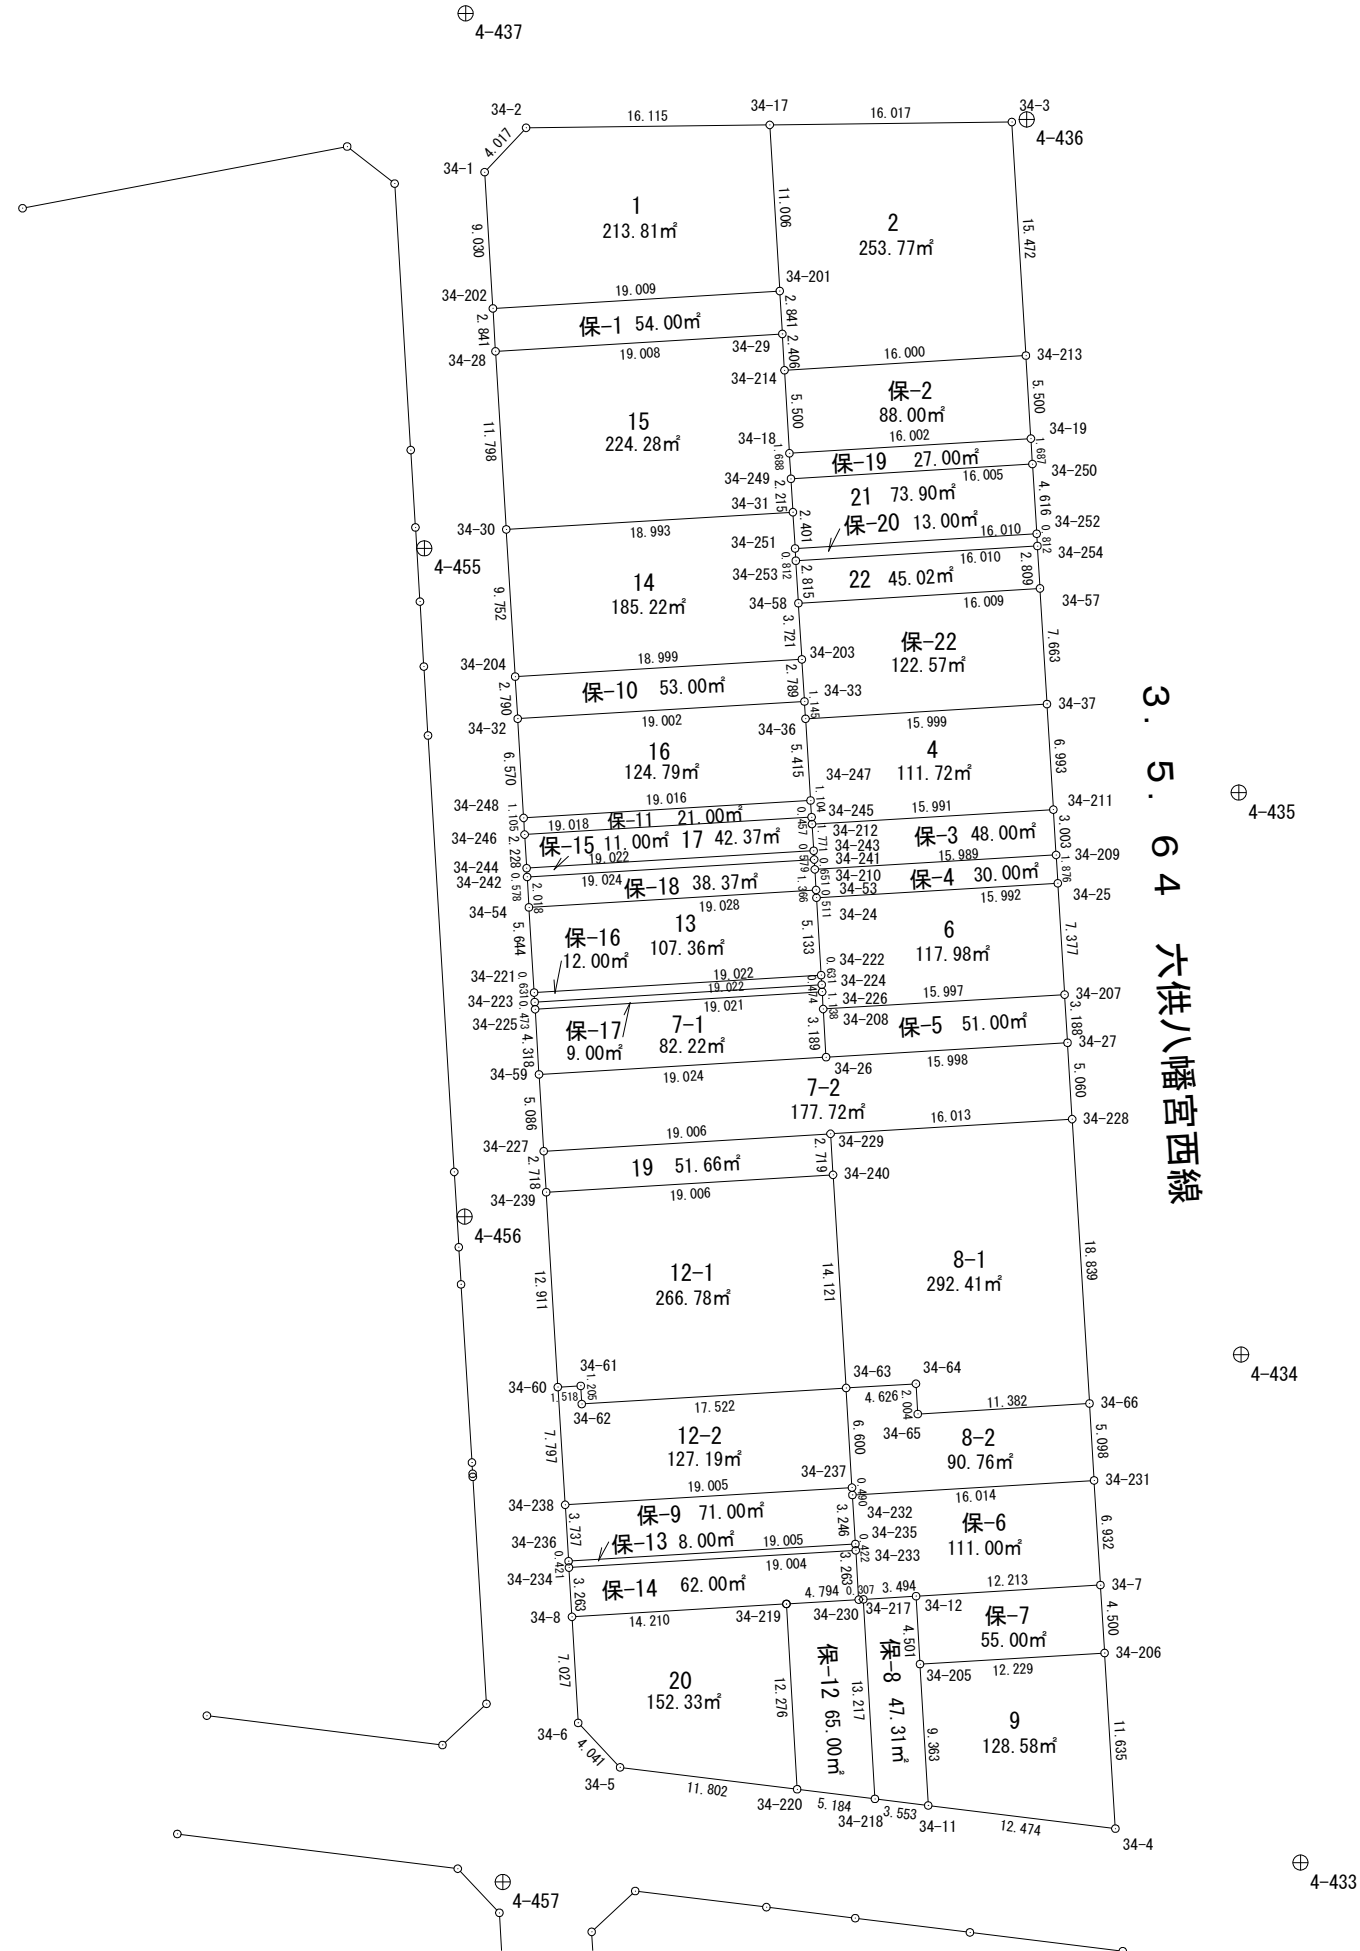

面積計算書（座標法）

世界測地系（測地成果2011）

所在	地番	公簿地目	現況地目	地積	所有者
前橋市六供町二丁目	34-1			213.81 m ²	


点名	X座標	Y座標	辺長	方向角	測角	DX	倍積 (Y×DX)		
34-201	41447.849	-68202.124	11.006	356-33-06	90-01-12	12.136	-827700.976864		
34-17	41458.835	-68202.786	16.115	269-19-28	92-46-22	10.796	-736317.277656		
34-2	41458.645	-68218.900	4.017	223-06-13	133-46-45	-3.123	213047.624700		
34-1	41455.712	-68221.645	9.030	176-31-37	133-25-24	-11.946	814975.771170		
34-202	41446.699	-68221.098	19.009	86-31-54	90-00-17	-7.863	536422.493574		
							倍面積		427.634924
							面積		213.8174620

面積計算書 (座標法)

世界測地系 (測地成果2011)

所在	地番	公簿地目	現況地目	地積	所有者
前橋市六供町二丁目	34-2			253.77 m ²	

点名	X座標	Y座標	辺長	方向角	測角	DX	倍積 (Y×DX)
34-213	41443.583	-68185.840	15.472	356-33-14	90-02-13	16.416	-1119338.749440
34-3	41459.027	-68186.770	16.017	269-18-47	92-45-33	15.252	-1039984.616040
34-17	41458.835	-68202.786	11.006	176-33-06	87-14-19	-11.178	762370.741908
34-201	41447.849	-68202.124	2.841	176-32-58	179-59-52	-13.822	942689.757928
34-29	41445.013	-68201.953	2.406	176-35-35	180-02-37	-5.238	357241.829814
34-214	41442.611	-68201.810	16.000	86-31-01	89-55-26	-1.430	97528.588300
倍面積						507.552470	
面積						253.7762350	

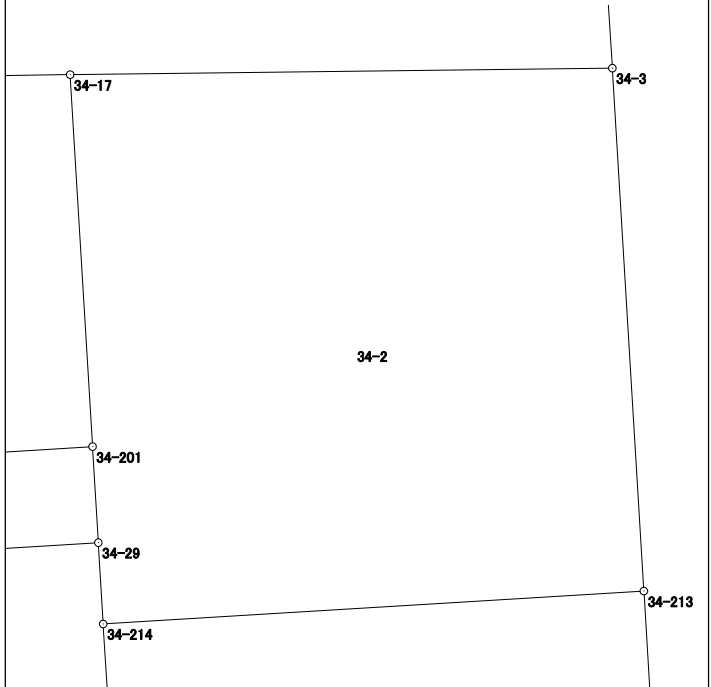

面積計算書 (座標法)

世界測地系 (測地成果2011)

所 在	地 番	公簿地目	現況地目	地 積	所 有 者
前橋市六供町二丁目	34-4			111.72 m ²	


点 名	X 座標	Y 座標	辺 長	方 向 角	測 角	DX	倍 積 (Y×DX)	
34-211	41413.557	-68184.026	6.993	356-31-55	89-57-07	7.934	-540972.062284	
34-37	41420.537	-68184.449	15.999	266-31-14	89-59-19	6.009	-409720.354041	
34-36	41419.566	-68200.419	5.415	176-28-28	89-57-14	-6.376	434845.871544	
34-247	41414.161	-68200.086	1.104	176-28-08	179-59-40	-6.507	443777.959602	
34-245	41413.059	-68200.018	0.457	176-21-40	179-53-32	-1.558	106255.628044	
34-212	41412.603	-68199.989	15.991	86-34-48	90-13-08	0.498	-33963.594522	
							倍面積	223.448343
							面 積	111.7241715

面積計算書（座標法）

世界測地系（測地成果2011）

所 在	地 番	公簿地目	現況地目	地 積	所 有 者
前橋市六供町二丁目	34-7-1			82.22 m ²	

点 名	X 座標	Y 座標	辺 長	方 向 角	測 角	DX	倍 積 (Y×DX)
34-225	41400.356	-68218.305	4.318	176-34-28	90-02-37	-5.461	372540.163605
34-59	41396.046	-68218.047	19.024	86-33-31	89-59-03	-3.168	216114.772896
34-26	41397.188	-68199.057	3.189	356-31-49	89-58-18	4.325	-294960.921525
34-208	41400.371	-68199.250	1.138	356-31-27	179-59-38	4.319	-294552.560750
34-226	41401.507	-68199.319	19.021	266-31-51	90-00-24	-0.015	1022.989785
						倍面積	164.444011
						面 積	82.2220055

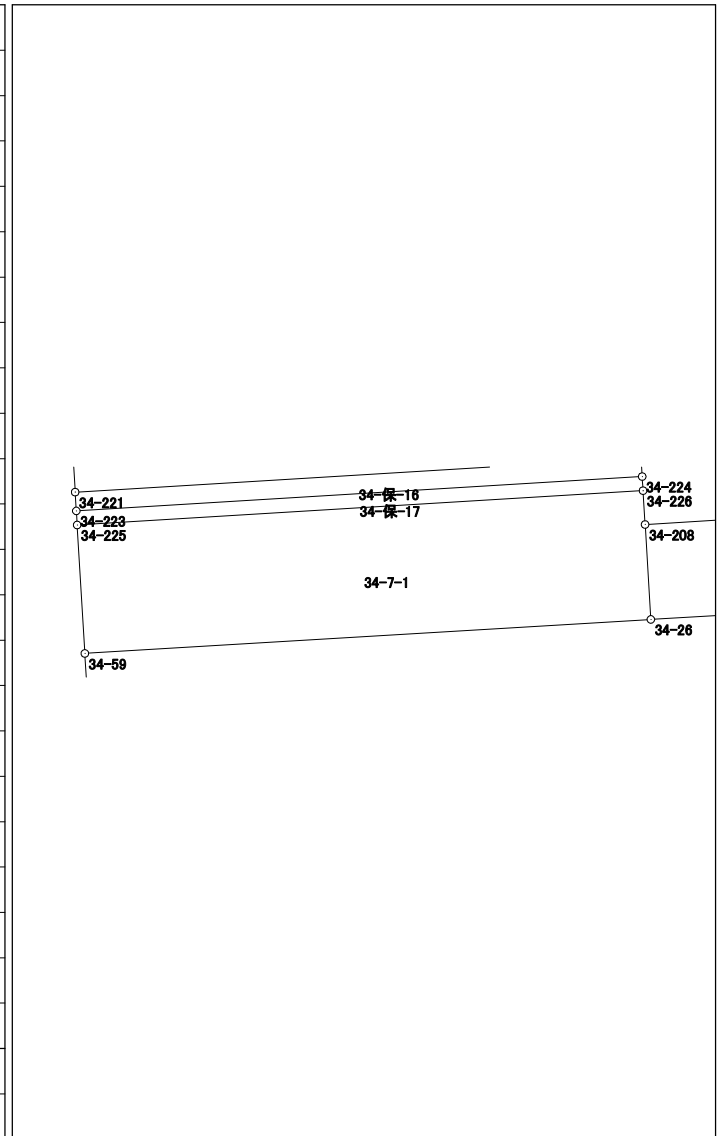


面積計算書 (座標法)

世界測地系 (測地成果2011)

所在	地番	公簿地目	現況地目	地積	所有者
前橋市六供町二丁目	34-7-2			177.72 m ²	

点名	X座標	Y座標	辺長	方向角	測角	Dx	倍積 (Y×Dx)
34-59	41396.046	-68218.047	5.086	176-29-38	89-56-07	-6.218	424179.816246
34-227	41390.970	-68217.736	19.006	86-31-41	90-02-03	-3.925	267754.613800
34-229	41392.121	-68198.765	16.013	86-31-38	179-59-57	2.121	-144649.580565
34-228	41393.091	-68182.781	5.060	356-31-59	90-00-21	6.021	-410528.524401
34-27	41398.142	-68183.087	15.998	266-34-53	90-02-54	4.097	-279346.107439
34-26	41397.188	-68199.057	19.024	266-33-31	179-58-38	-2.096	142945.223472

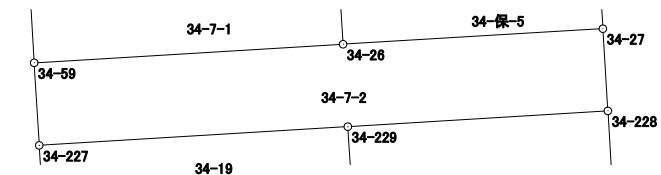


倍面積	355.441113
面積	177.7205565

面積計算書 (座標法)

世界測地系 (測地成果2011)

所 在	地 番	公簿地目	現況地目	地 積	所 有 者
前橋市六供町二丁目	34-8-1			292.41 m ²	

点 名	X 座 標	Y 座 標	辺 長	方 向 角	測 角	DX	倍 積 (Y×DX)
34-229	41392.121	-68198.765	2.719	176-31-15	89-59-37	-3.684	251244.250260
34-240	41389.407	-68198.600	14.121	176-28-33	179-57-18	-16.808	1146282.068800
34-63	41375.313	-68197.732	4.626	86-34-02	90-05-29	-13.817	942288.063044
34-64	41375.590	-68193.114	2.004	176-37-31	270-03-29	-1.724	117564.928536
34-65	41373.589	-68192.996	11.382	86-29-03	89-51-32	-1.303	88855.473788
34-66	41374.287	-68181.635	18.839	356-30-45	90-01-42	19.502	-1329678.245770
34-228	41393.091	-68182.781	16.013	266-31-38	90-00-53	17.834	-1215971.716354

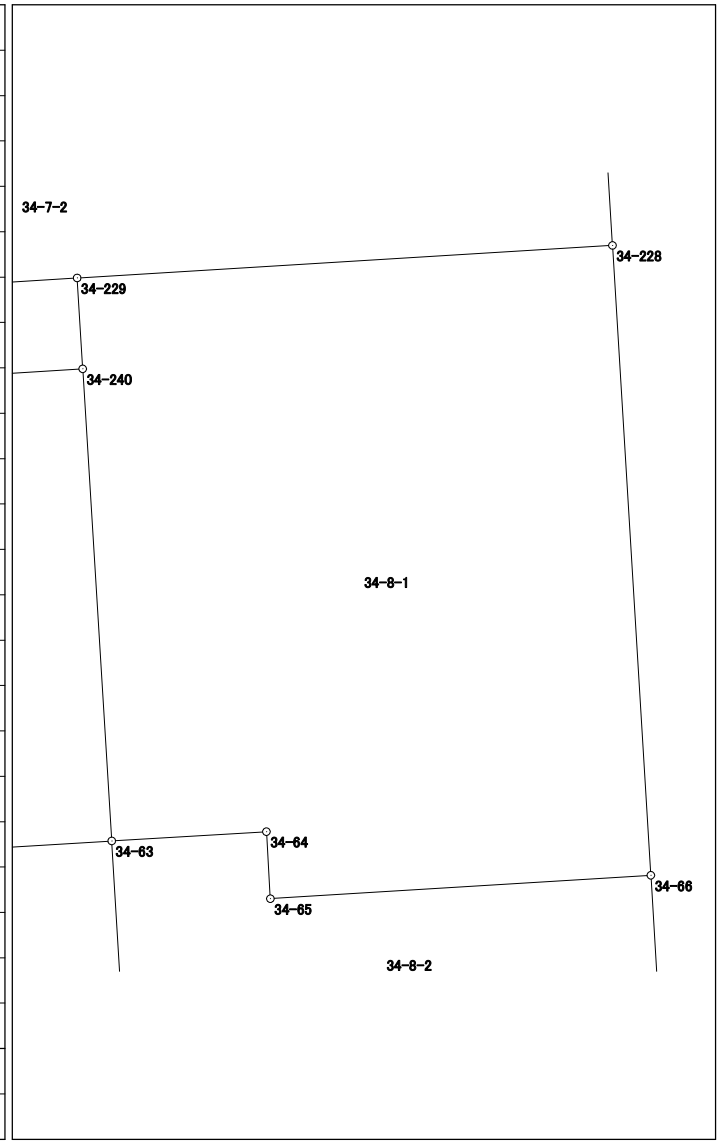


倍面積	584.822304
面 積	292.411520

面積計算書（座標法）

世界測地系（測地成果2011）

所 在	地 番	公簿地目	現況地目	地 積	所 有 者
前橋市六供町二丁目	34-8-2			90.76 m ²	

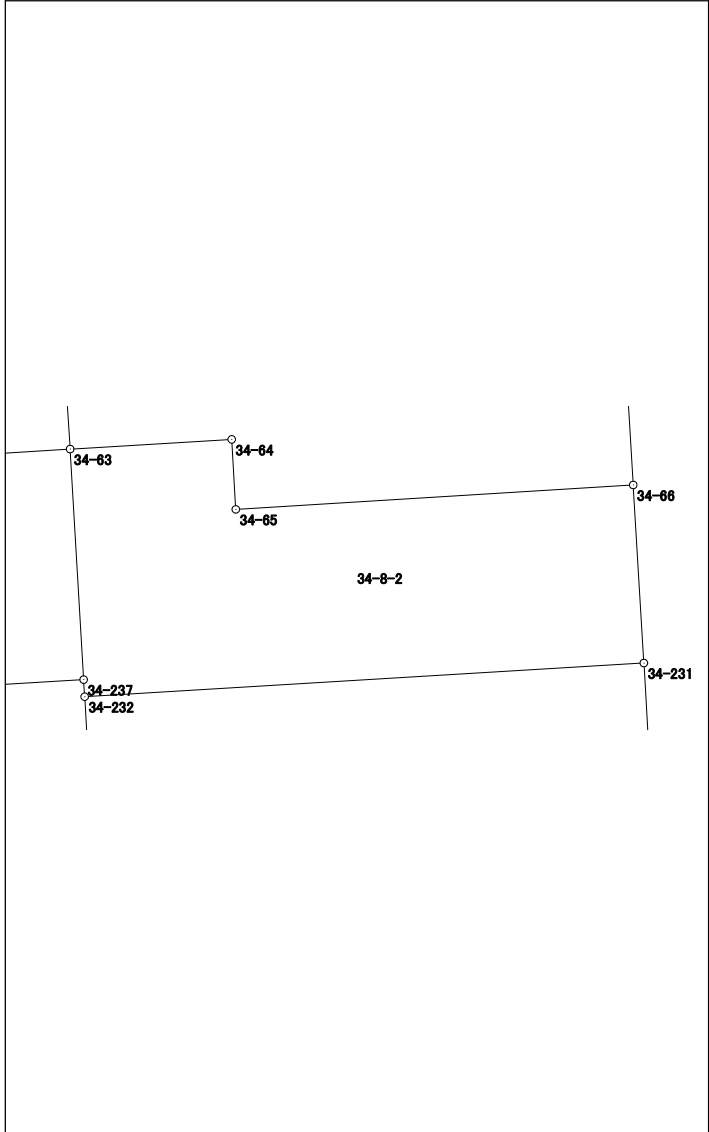
点 名	X 座標	Y 座標	辺 長	方 向 角	測 角	DX	倍 積 (Y×DX)	
34-63	41375.313	-68197.732	6.600	176-38-50	90-04-48	-6.866	468245.627912	
34-237	41368.724	-68197.346	0.490	176-36-22	179-57-32	-7.078	482700.814988	
34-232	41368.235	-68197.317	16.014	86-33-09	89-56-47	0.474	-32325.528258	
34-231	41369.198	-68181.332	5.098	356-35-33	90-02-24	6.052	-412633.421264	
34-66	41374.287	-68181.635	11.382	266-29-03	89-53-30	4.391	-299385.559285	
34-65	41373.589	-68192.996	2.004	356-37-31	270-08-28	1.303	-88855.473788	
34-64	41375.590	-68193.114	4.626	266-34-02	89-56-31	1.724	-117564.928536	
倍面積							181.531769	
面 積							90.7658845	

面積計算書（座標法）

世界測地系（測地成果2011）

所 在	地 番	公簿地目	現況地目	地 積	所 有 者
前橋市六供町二丁目	34-9			128.58 m ²	

点 名	X 座 標	Y 座 標	辺 長	方 向 角	測 角	DX	倍 積 (Y×DX)
34-205	41357.051	-68192.844	9.363	176-40-53	90-07-54	-10.083	687588.446052
34-11	41347.704	-68192.302	12.474	97-02-43	100-21-50	-10.877	741727.668854
34-4	41346.174	-68179.922	11.635	356-28-37	79-25-54	10.083	-687458.153526
34-206	41357.787	-68180.637	12.229	266-32-59	90-04-22	10.877	-741600.788649

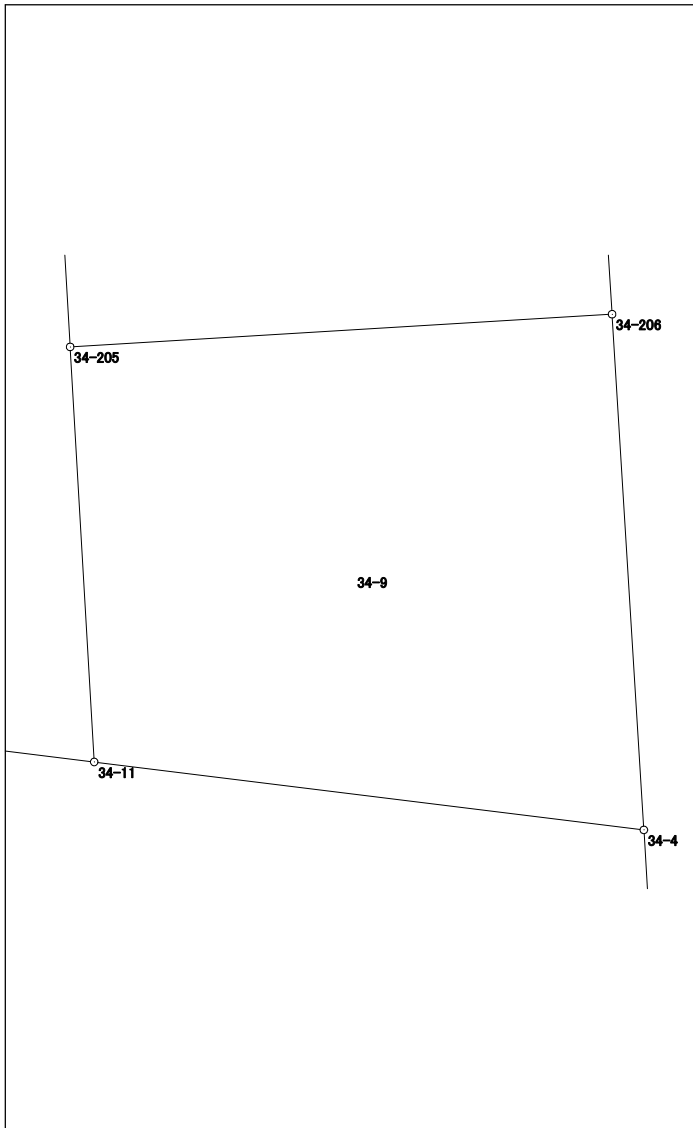


面積計算書 (座標法)

世界測地系 (測地成果2011)

所在	地番	公簿地目	現況地目	地積	所有者
前橋市六供町二丁目	34-12-1			266.78 m ²	

点名	X座標	Y座標	辺長	方向角	測角	DX	倍積 (Y×DX)
34-239	41388.257	-68217.571	12.911	176-35-39	90-03-47	-14.038	957638.261698
34-60	41375.369	-68216.804	1.518	86-51-58	90-16-19	-12.805	873516.175220
34-61	41375.452	-68215.288	1.205	176-51-35	269-59-37	-1.120	76401.122560
34-62	41374.249	-68215.222	17.522	86-31-07	89-39-32	-0.139	9481.915858
34-63	41375.313	-68197.732	14.121	356-28-33	89-57-26	15.158	-1033741.221656
34-240	41389.407	-68198.600	19.006	266-31-52	90-03-19	12.944	-882762.678400

倍面積	533.575280
面積	266.7876400

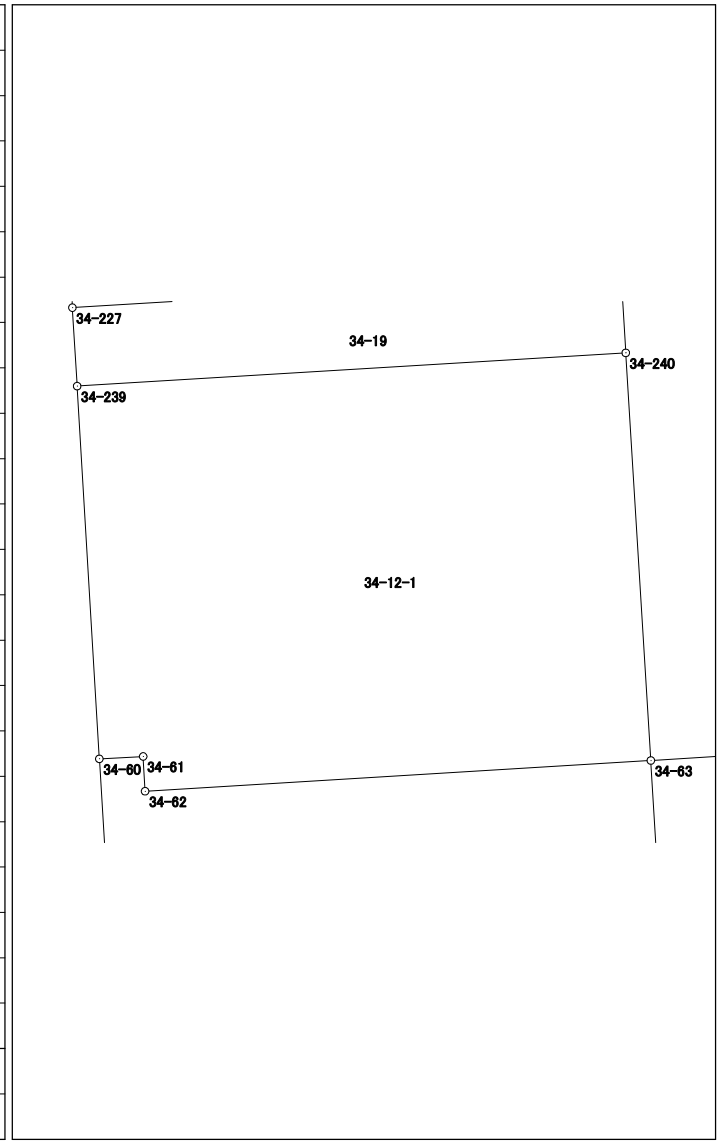

面積計算書（座標法）

世界測地系（測地成果2011）

所 在	地 番	公簿地目	現況地目	地 積	所 有 者
前橋市六供町二丁目	34-12-2			127.19 m ²	


点 名	X 座標	Y 座標	辺 長	方 向 角	測 角	DX	倍 積 (Y×DX)	
34-60	41375.369	-68216.804	7.797	176-25-09	89-33-11	-7.865	536525.163460	
34-238	41367.587	-68216.317	19.005	86-34-13	90-09-04	-6.645	453297.426465	
34-237	41368.724	-68197.346	6.600	356-38-50	90-04-37	7.726	-526892.695196	
34-63	41375.313	-68197.732	17.522	266-31-07	89-52-17	5.525	-376792.469300	
34-62	41374.249	-68215.222	1.205	356-51-35	270-20-28	0.139	-9481.915858	
34-61	41375.452	-68215.288	1.518	266-51-58	90-00-23	1.120	-76401.122560	
						倍面積	254.387011	
						面 積	127.1935055	

面積計算書 (座標法)

世界測地系 (測地成果2011)

所在	地番	公簿地目	現況地目	地積	所有者
前橋市六供町二丁目	34-13			107.36 m ²	

点名	X座標	Y座標	辺長	方向角	測角	DX	倍積 (Y×DX)
34-54	41407.092	-68218.714	5.644	176-31-34	89-59-49	-6.786	462932.193204
34-221	41401.458	-68218.372	19.022	86-31-41	90-00-07	-4.482	305754.743304
34-222	41402.610	-68199.385	5.133	356-32-16	90-00-35	6.276	-428019.340260
34-24	41407.734	-68199.695	0.511	357-04-54	180-32-38	5.634	-384237.081630
34-53	41408.244	-68199.721	19.028	266-31-45	89-26-51	-0.642	43784.220882

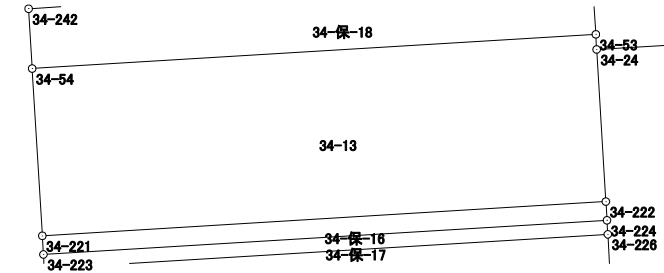


倍面積	214.735500
面積	107.3677500

面積計算書（座標法）

世界測地系（測地成果2011）

所在	地番	公簿地目	現況地目	地積	所有者
前橋市六供町二丁目	34-14			185.22 m ²	

点名	X座標	Y座標	辺長	方向角	測角	DX	倍積 (Y×DX)
34-203	41423.493	-68200.660	3.721	356-29-13	89-55-37	4.854	-331046.003640
34-58	41427.207	-68200.888	2.815	356-31-03	180-01-50	6.524	-444942.593312
34-253	41430.017	-68201.059	0.812	356-32-33	180-01-30	3.621	-246956.034639
34-251	41430.828	-68201.108	2.401	356-30-52	179-58-19	3.208	-218789.154464
34-31	41433.225	-68201.254	18.993	266-33-54	90-03-02	1.259	-85865.378786
34-30	41432.087	-68220.213	9.752	176-32-35	89-58-41	-10.872	741690.155736
34-204	41422.353	-68219.625	18.999	86-33-36	90-01-01	-8.594	586279.457250

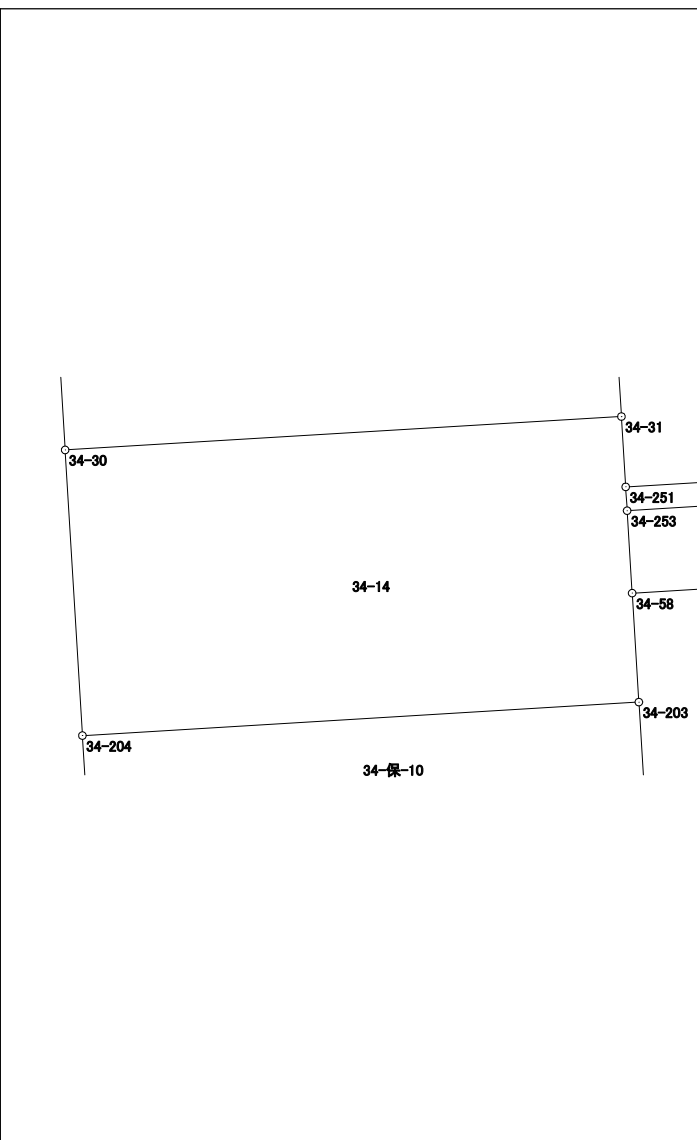


倍面積	370.448145
面積	185.2240725

面積計算書 (座標法)

世界測地系 (測地成果2011)

所在	地番	公簿地目	現況地目	地積	所有者
前橋市六供町二丁目	34-16			124.79 m ²	

点名	X座標	Y座標	辺長	方向角	測角	DX	倍積 (Y×DX)
34-247	41414.161	-68200.086	5.415	356-28-28	89-56-41	6.556	-447119.763816
34-36	41419.566	-68200.419	1.145	356-29-44	180-01-16	6.548	-446576.343612
34-33	41420.709	-68200.489	19.002	266-33-27	90-03-43	0.002	-136.400978
34-32	41419.568	-68219.457	6.570	176-35-48	90-02-21	-7.699	525221.599443
34-248	41413.010	-68219.067	19.016	86-31-47	89-55-59	-5.407	368860.495269
						倍面積	249.586306
						面積	124.7931530

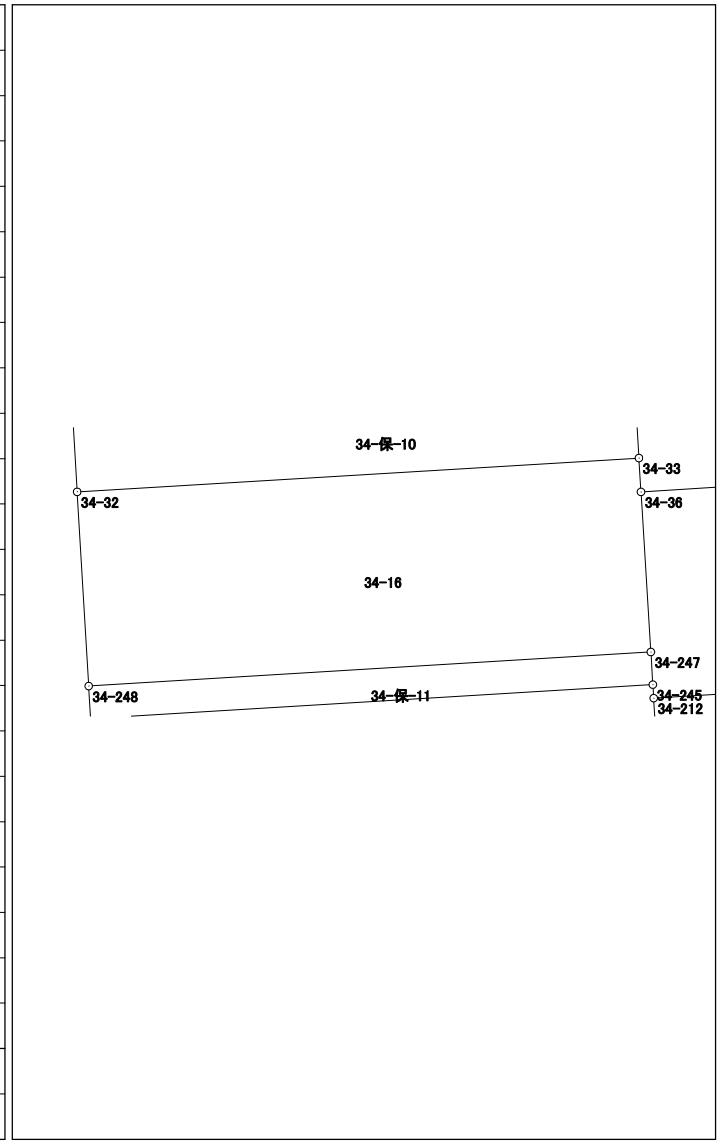


面積計算書（座標法）

世界測地系（測地成果2011）

所 在	地 番	公簿地目	現況地目	地 積	所 有 者
前橋市六供町二丁目	34-17			42.37 m ²	

点 名	X 座標	Y 座標	辺 長	方 向 角	測 角	DX	倍 積 (Y×DX)
34-244	41409.683	-68218.868	19.022	86-31-41	89-57-01	-1.072	73130.626496
34-243	41410.835	-68199.881	1.771	356-30-16	89-58-35	2.920	-199143.652520
34-212	41412.603	-68199.989	0.457	356-21-40	179-51-24	2.224	-151676.775536
34-245	41413.059	-68200.018	19.018	266-31-38	90-09-58	-0.696	47467.212528
34-246	41411.907	-68219.001	2.228	176-34-40	90-03-02	-3.376	230307.347376
倍面積						84.758344	
面 積						42.3791720	

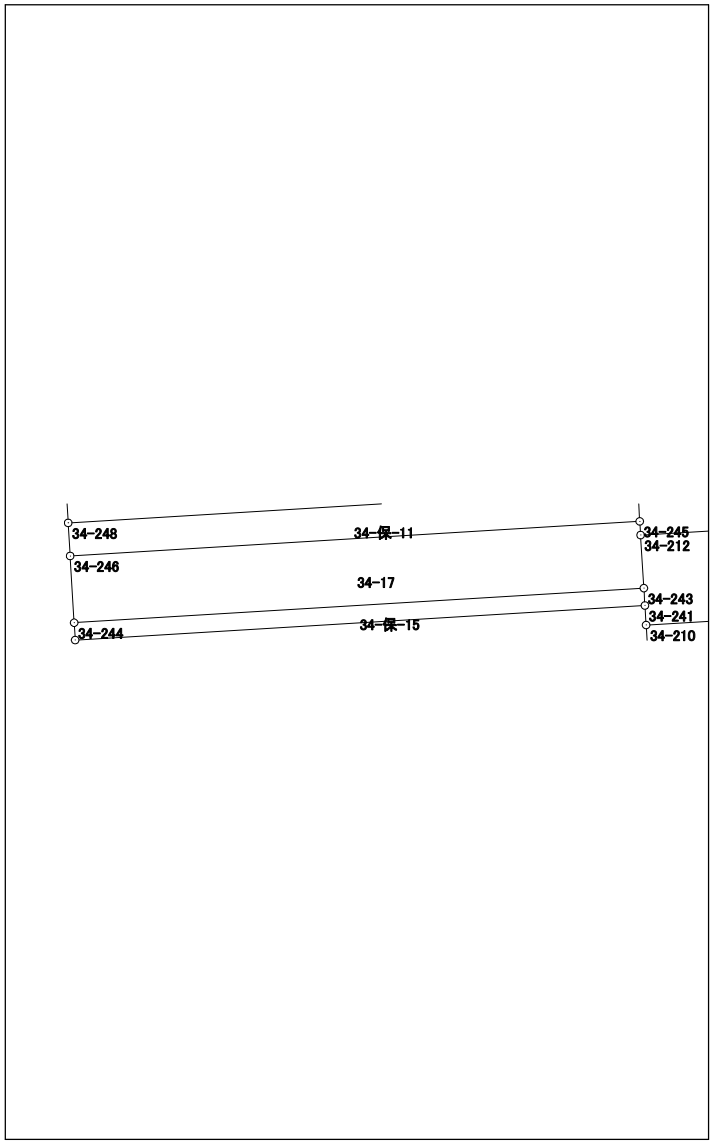


面積計算書 (座標法)

世界測地系 (測地成果2011)

所在	地番	公簿地目	現況地目	地積	所有者
前橋市六供町二丁目	34-19			51.66 m ²	

点名	X座標	Y座標	辺長	方向角	測角	DX	倍積 (Y×DX)
34-229	41392.121	-68198.765	19.006	266-31-41	90-00-26	1.563	-106594.669695
34-227	41390.970	-68217.736	2.718	176-31-11	89-59-30	-3.864	263593.331904
34-239	41388.257	-68217.571	19.006	86-31-52	90-00-41	-1.563	106624.063473
34-240	41389.407	-68198.600	2.719	356-31-15	89-59-23	3.864	-263519.390400

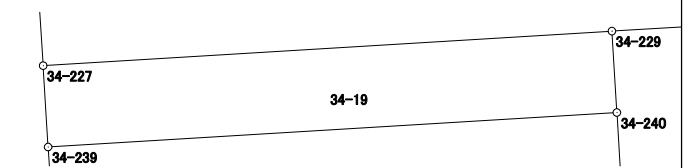


倍面積	103.335282
面積	51.6676410

面積計算書（座標法）

世界測地系（測地成果2011）

所在	地番	公簿地目	現況地目	地積	所有者
前橋市六供町二丁目	34-20			152.33 m ²	

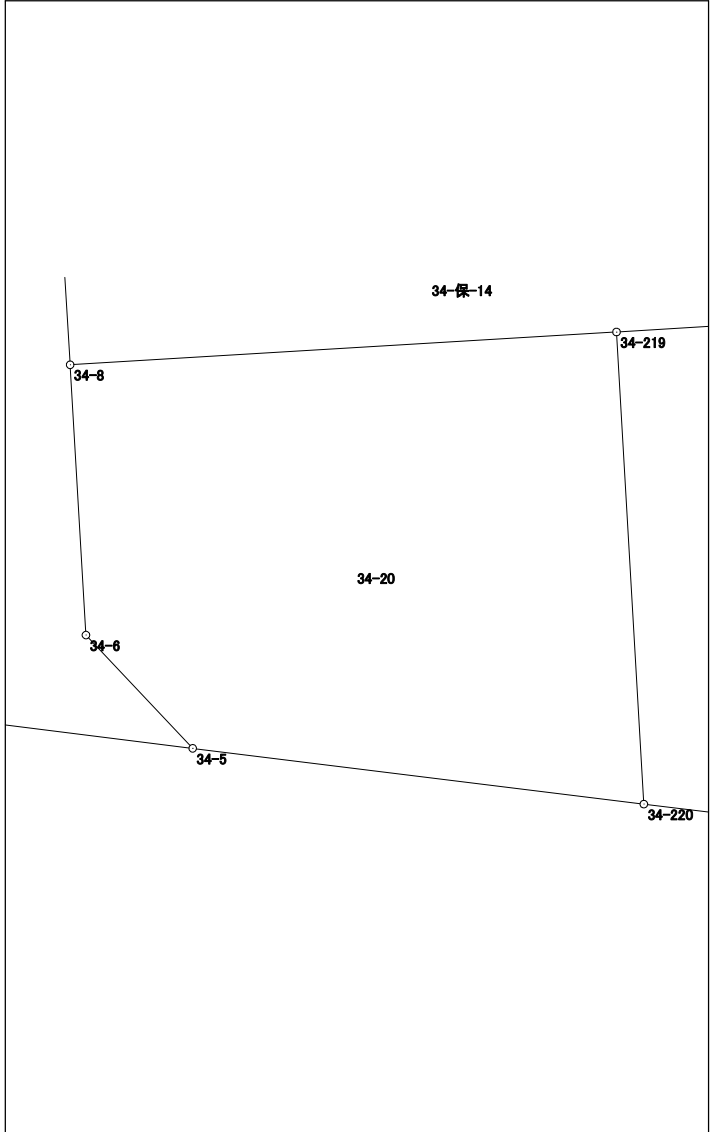
点名	X座標	Y座標	辺長	方向角	測角	DX	倍積 (Y×DX)		
34-219	41361.031	-68201.683	14.210	266-34-00	89-52-57	11.404	-777771.992932		
34-8	41360.180	-68215.867	7.027	176-39-18	90-05-18	-7.866	536586.009822		
34-6	41353.165	-68215.457	4.041	136-42-17	140-02-59	-9.956	679153.089892		
34-5	41350.224	-68212.686	11.802	97-02-50	140-20-33	-4.389	299385.478854		
34-220	41348.776	-68200.973	12.276	356-41-03	79-38-13	10.807	-737047.915211		
							倍面積		304.670425
							面積		152.3352125

面積計算書 (座標法)

世界測地系 (測地成果2011)

所在	地番	公簿地目	現況地目	地積	所有者
前橋市六供町二丁目	34-21			73.90 m ²	

点名	X座標	Y座標	辺長	方向角	測角	DX	倍積 (Y×DX)
34-250	41436.409	-68185.408	16.005	266-30-52	89-59-30	3.635	-247853.958080
34-249	41435.436	-68201.383	2.215	176-39-39	90-08-47	-3.184	217153.203472
34-31	41433.225	-68201.254	2.401	176-30-52	179-51-13	-4.608	314271.378432
34-251	41430.828	-68201.108	16.010	86-30-56	90-00-04	-1.424	97118.377792
34-252	41431.801	-68185.128	4.616	356-31-22	90-00-26	5.581	-380541.199368
倍面積							147.802248
面積							73.9011240

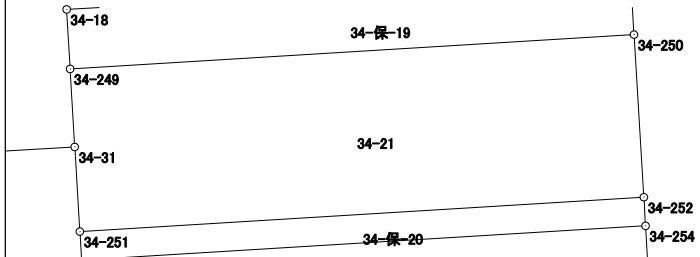


面積計算書 (座標法)

世界測地系 (測地成果2011)

所在	地番	公簿地目	現況地目	地積	所有者
前橋市六供町二丁目	34-22			45.02 m ²	

点名	X座標	Y座標	辺長	方向角	測角	DX	倍積 (Y×DX)
34-253	41430.017	-68201.059	2.815	176-31-03	90-00-07	-3.783	258004.606197
34-58	41427.207	-68200.888	16.009	86-29-38	89-58-35	-1.831	124875.825928
34-57	41428.186	-68184.909	2.809	356-31-50	90-02-12	3.783	-257943.510747
34-254	41430.990	-68185.079	16.010	266-30-56	89-59-06	1.831	-124846.879649
						倍面積	90.041729
						面積	45.0208645

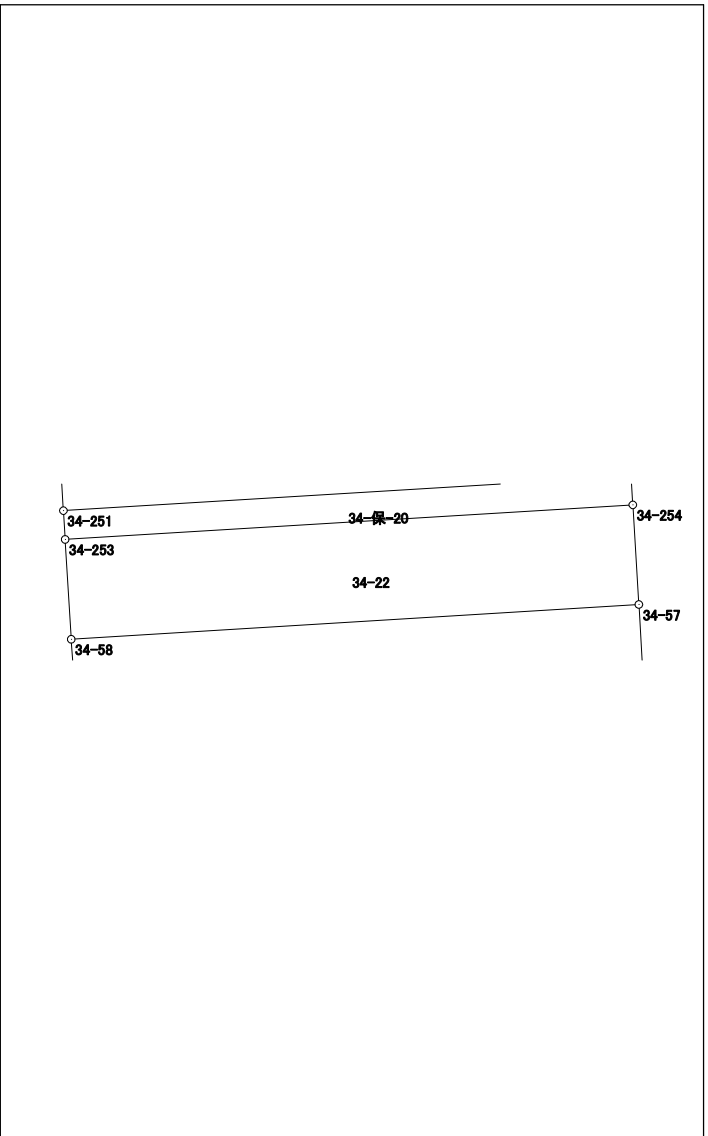


面積計算書 (座標法)

世界測地系 (測地成果2011)

所在	地番	公簿地目	現況地目	地積	所有者
前橋市六供町二丁目	34-保-1			54.00 m ²	

点名	X座標	Y座標	辺長	方向角	測角	DX	倍積 (Y×DX)
34-28	41443.863	-68220.926	19.008	86-31-53	90-00-07	-1.686	115020.481236
34-29	41445.013	-68201.953	2.841	356-32-58	90-01-05	3.986	-271852.984658
34-201	41447.849	-68202.124	19.009	266-31-54	89-58-56	1.686	-114988.781064
34-202	41446.699	-68221.098	2.841	176-31-46	89-59-52	-3.986	271929.296628

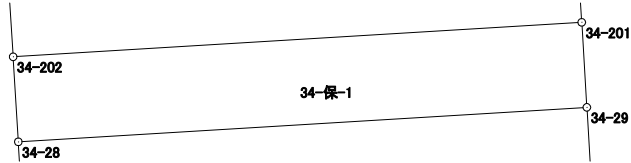


倍面積	108.012142
面積	54.0060710

面積計算書（座標法）

世界測地系（測地成果2011）

所 在	地 番	公簿地目	現況地目	地 積	所 有 者
前橋市六供町二丁目	34-保-3			48.00 m ²	

点 名	X 座標	Y 座標	辺 長	方 向 角	測 角	DX	倍 積 (Y×DX)
34-210	41409.607	-68199.805	15.989	86-34-59	90-06-16	0.303	-20664.540915
34-209	41410.560	-68183.844	3.003	356-31-29	89-56-30	3.950	-269326.183800
34-211	41413.557	-68184.026	15.991	266-34-48	90-03-19	2.043	-139299.965118
34-212	41412.603	-68199.989	1.771	176-30-16	89-55-28	-2.722	185640.370058
34-243	41410.835	-68199.881	0.579	176-26-10	179-55-54	-2.346	159996.920826
34-241	41410.257	-68199.845	0.651	176-28-43	180-02-33	-1.228	83749.409660

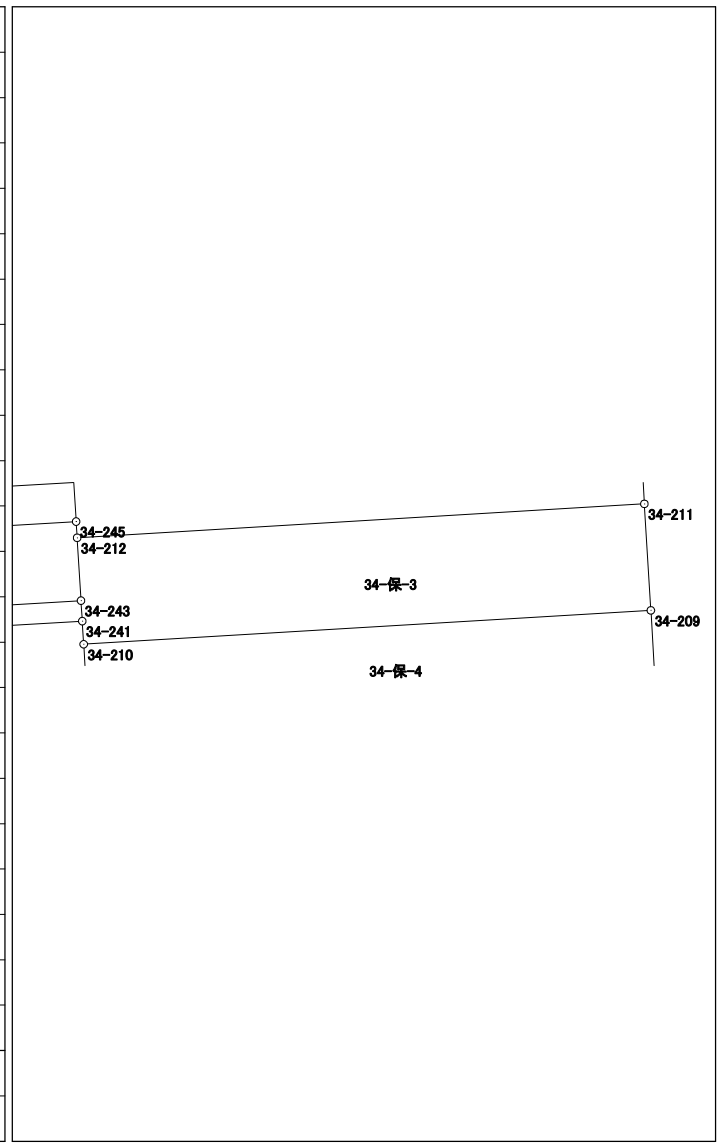


倍面積	96.010711
面 積	48.0053555

面積計算書（座標法）

世界測地系（測地成果2011）

所 在	地 番	公簿地目	現況地目	地 積	所 有 者
前橋市六供町二丁目	34-保-4			30.00 m ²	

点 名	X 座標	Y 座標	辺 長	方 向 角	測 角	DX	倍 積 (Y×DX)
34-24	41407.734	-68199.695	15.992	86-35-01	89-30-07	0.443	-30212.464885
34-25	41408.687	-68183.731	1.876	356-32-51	89-57-50	2.826	-192687.223806
34-209	41410.560	-68183.844	15.989	266-34-59	90-02-08	0.920	-62729.136480
34-210	41409.607	-68199.805	1.366	176-28-24	89-53-25	-2.316	157950.748380
34-53	41408.244	-68199.721	0.511	177-04-54	180-36-30	-1.873	127738.077433
倍面積							60.000642
面 積							30.0003210

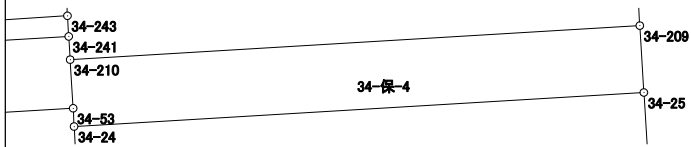

面積計算書 (座標法)

世界測地系 (測地成果2011)


所 在	地 番	公簿地目	現況地目	地 積	所 有 者
前橋市六供町二丁目	34-保-5			51.00 m ²	

点 名	X 座標	Y 座標	辺 長	方 向 角	測 角	DX	倍 積 (Y×DX)	
34-27	41398.142	-68183.087	3.188	356-30-40	89-55-47	4.136	-282005.247832	
34-207	41401.324	-68183.281	15.997	266-35-05	90-04-25	2.229	-151980.533349	
34-208	41400.371	-68199.250	3.189	176-31-49	89-56-44	-4.136	282072.098000	
34-26	41397.188	-68199.057	15.998	86-34-53	90-03-04	-2.229	152015.698053	
							倍面積	
							面 積	51.0074360

面積計算書 (座標法)

世界測地系 (測地成果2011)

所在	地番	公簿地目	現況地目	地積	所有者
前橋市六供町二丁目	34-保-6			111.00 m ²	

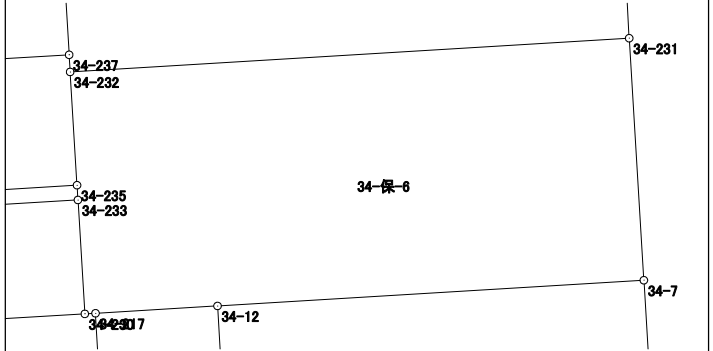
点名	X座標	Y座標	辺長	方向角	測角	DX	倍積 (Y×DX)	
34-12	41361.544	-68193.104	12.213	86-32-59	179-58-44	0.944	-64374.290176	
34-7	41362.279	-68180.913	6.932	356-32-04	89-59-05	7.654	-521856.708102	
34-231	41369.198	-68181.332	16.014	266-33-09	90-01-05	5.956	-406088.013392	
34-232	41368.235	-68197.317	3.246	176-31-14	89-58-05	-4.203	286633.323351	
34-235	41364.995	-68197.120	0.422	176-36-06	180-04-52	-3.661	249669.656320	
34-233	41364.574	-68197.095	3.263	176-32-19	179-56-13	-3.678	250828.915410	
34-230	41361.317	-68196.898	0.307	86-38-01	90-05-42	-3.239	220889.752622	
34-217	41361.335	-68196.592	3.494	86-34-15	179-56-14	0.227	-15480.626384	
倍面積							222.009649	
面積							111.0048245	

面積計算書 (座標法)

世界測地系 (測地成果2011)

所在	地番	公簿地目	現況地目	地積	所有者
前橋市六供町二丁目	34-保-7			55.00 m ²	

点名	X座標	Y座標	辺長	方向角	測角	DX	倍積 (Y×DX)
34-12	41361.544	-68193.104	4.501	176-41-17	90-08-18	-5.228	356513.547712
34-205	41357.051	-68192.844	12.229	86-32-59	89-51-42	-3.757	256200.514908
34-206	41357.787	-68180.637	4.500	356-29-02	89-56-03	5.228	-356448.370236
34-7	41362.279	-68180.913	12.213	266-32-59	90-03-57	3.757	-256155.690141

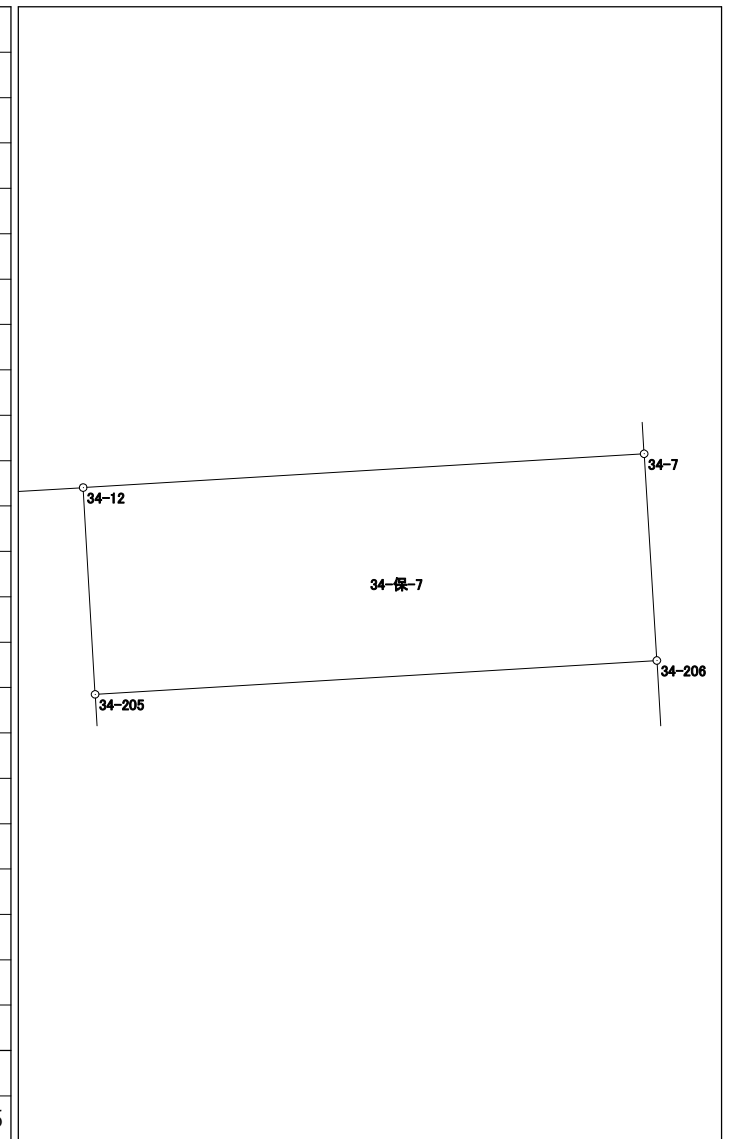


倍面積	110.002243
面積	55.0011215

面積計算書（座標法）

世界測地系（測地成果2011）

所在	地番	公簿地目	現況地目	地積	所有者
前橋市六供町二丁目	34-保-9			71.00 m ²	

点名	X座標	Y座標	辺長	方向角	測角	DX	倍積 (Y×DX)
34-236	41363.857	-68216.091	19.005	86-34-02	90-02-04	-2.592	176816.107872
34-235	41364.995	-68197.120	3.246	356-31-14	89-57-12	4.378	-298566.991360
34-232	41368.235	-68197.317	0.490	356-36-22	180-05-08	3.729	-254307.795093
34-237	41368.724	-68197.346	19.005	266-34-13	89-57-51	-0.648	44191.880208
34-238	41367.587	-68216.317	3.737	176-31-58	89-57-45	-4.867	332008.814839

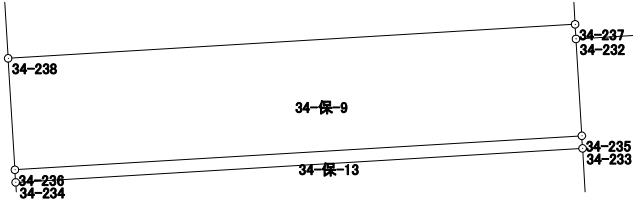


倍面積	142.016466
面積	71.0082330

面積計算書 (座標法)

世界測地系 (測地成果2011)

所在	地番	公簿地目	現況地目	地積	所有者
前橋市六供町二丁目	34-保-10			53.00 m ²	

点名	X座標	Y座標	辺長	方向角	測角	DX	倍積 (Y×DX)
34-32	41419.568	-68219.457	19.002	86-33-27	90-00-34	-1.644	112152.787308
34-33	41420.709	-68200.489	2.789	356-29-07	89-55-40	3.925	-267686.919325
34-203	41423.493	-68200.660	18.999	266-33-36	90-04-29	1.644	-112121.885040
34-204	41422.353	-68219.625	2.790	176-32-53	89-59-17	-3.925	267762.028125

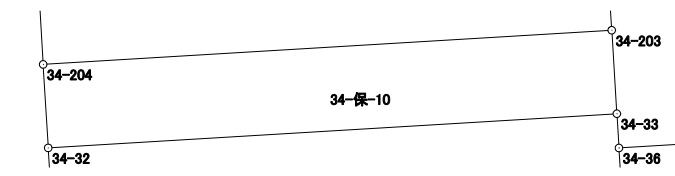

倍面積	106.011068
面積	53.0055340


面積計算書（座標法）

世界測地系（測地成果2011）

所 在	地 番	公簿地目	現況地目	地 積	所 有 者
前橋市六供町二丁目	34-保-11			21.00 m ²	

点 名	X 座標	Y 座標	辺 長	方 向 角	測 角	DX	倍 積 (Y×DX)
34-246	41411.907	-68219.001	19.018	86-31-38	89-57-06	0.049	-3342.731049
34-245	41413.059	-68200.018	1.104	356-28-08	89-56-30	2.254	-153722.840572
34-247	41414.161	-68200.086	19.016	266-31-47	90-03-39	-0.049	3341.804214
34-248	41413.010	-68219.067	1.105	176-34-32	90-02-45	-2.254	153765.777018

倍面積	42.009611
面 積	21.0048055

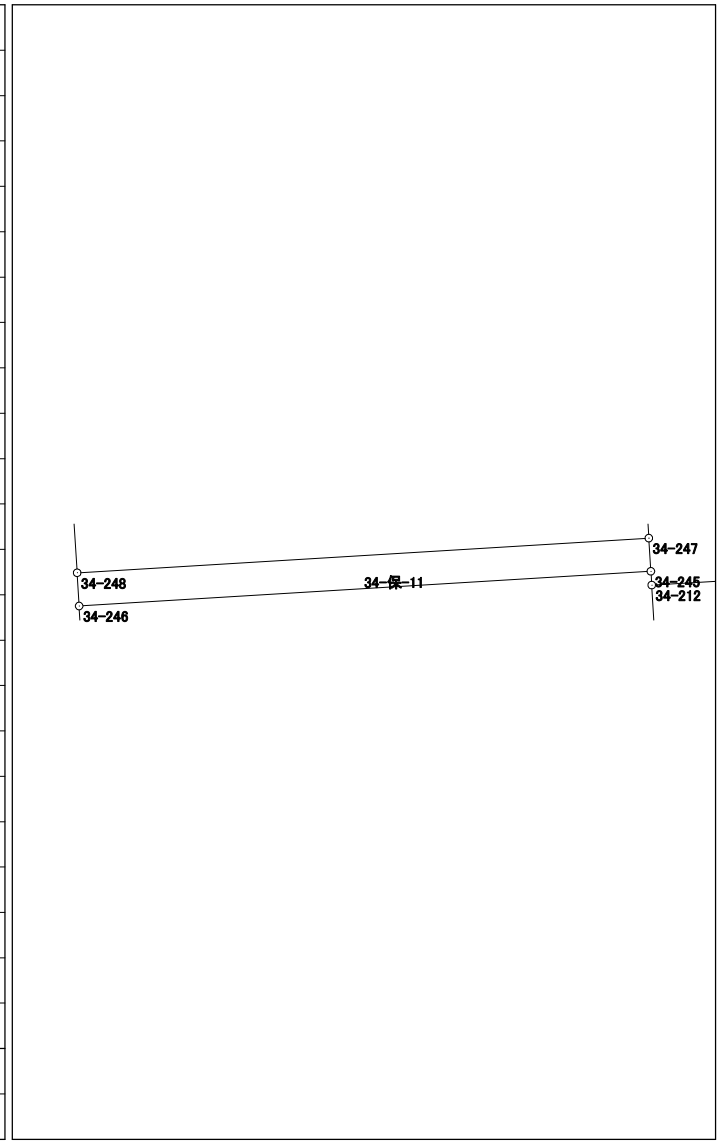


面積計算書（座標法）

世界測地系（測地成果2011）

所 在	地 番	公簿地目	現況地目	地 積	所 有 者
前橋市六供町二丁目	34-保-13			8.00 m ²	

点 名	X 座標	Y 座標	辺 長	方 向 角	測 角	DX	倍 積 (Y×DX)
34-233	41364.574	-68197.095	0.422	356-36-06	90-01-54	1.558	-106251.074010
34-235	41364.995	-68197.120	19.005	266-34-02	89-57-56	-0.717	48897.335040
34-236	41363.857	-68216.091	0.421	176-27-27	89-53-25	-1.558	106280.669778
34-234	41363.437	-68216.065	19.004	86-34-12	90-06-45	0.717	-48910.918605

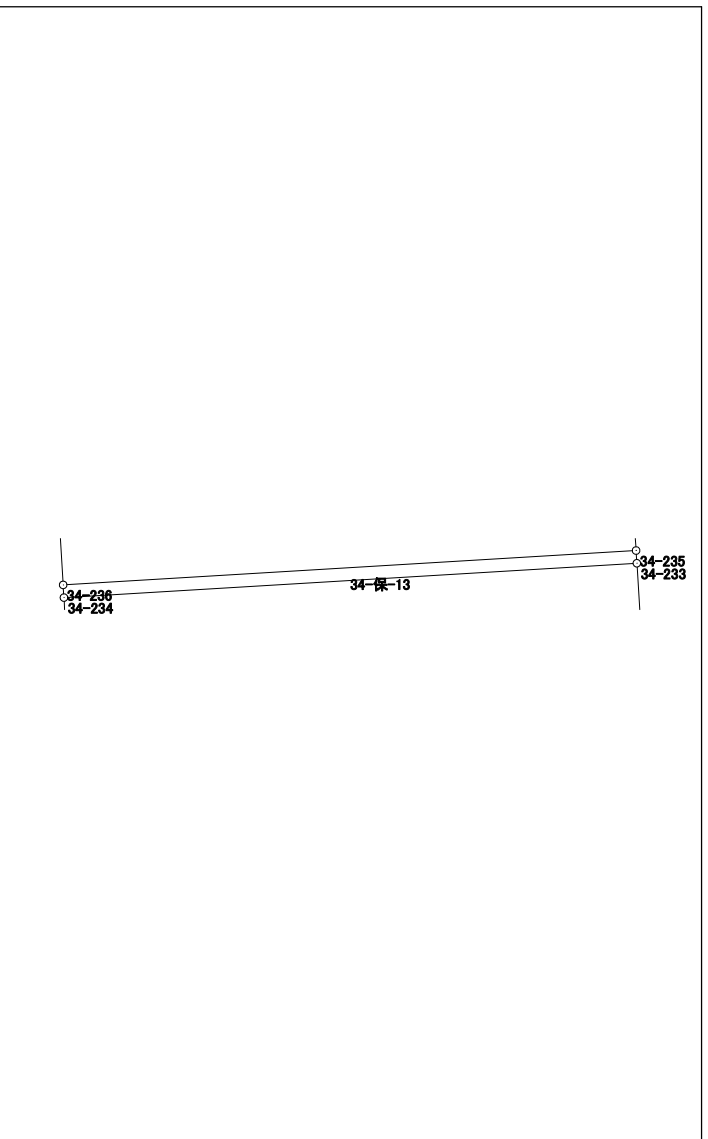


面積計算書 (座標法)

世界測地系 (測地成果2011)

所在	地番	公簿地目	現況地目	地積	所有者
前橋市六供町二丁目	34-保-14			62.00 m ²	

点名	X座標	Y座標	辺長	方向角	測角	DX	倍積 (Y×DX)
34-219	41361.031	-68201.683	4.794	86-34-46	180-00-46	1.137	-77545.313571
34-230	41361.317	-68196.898	3.263	356-32-19	89-57-33	3.543	-241621.609614
34-233	41364.574	-68197.095	19.004	266-34-12	90-01-53	2.120	-144577.841400
34-234	41363.437	-68216.065	3.263	176-31-16	89-57-04	-4.394	299741.389610
34-8	41360.180	-68215.867	14.210	86-34-00	90-02-44	-2.406	164127.376002
						倍面積	124.001027
						面積	62.0005135

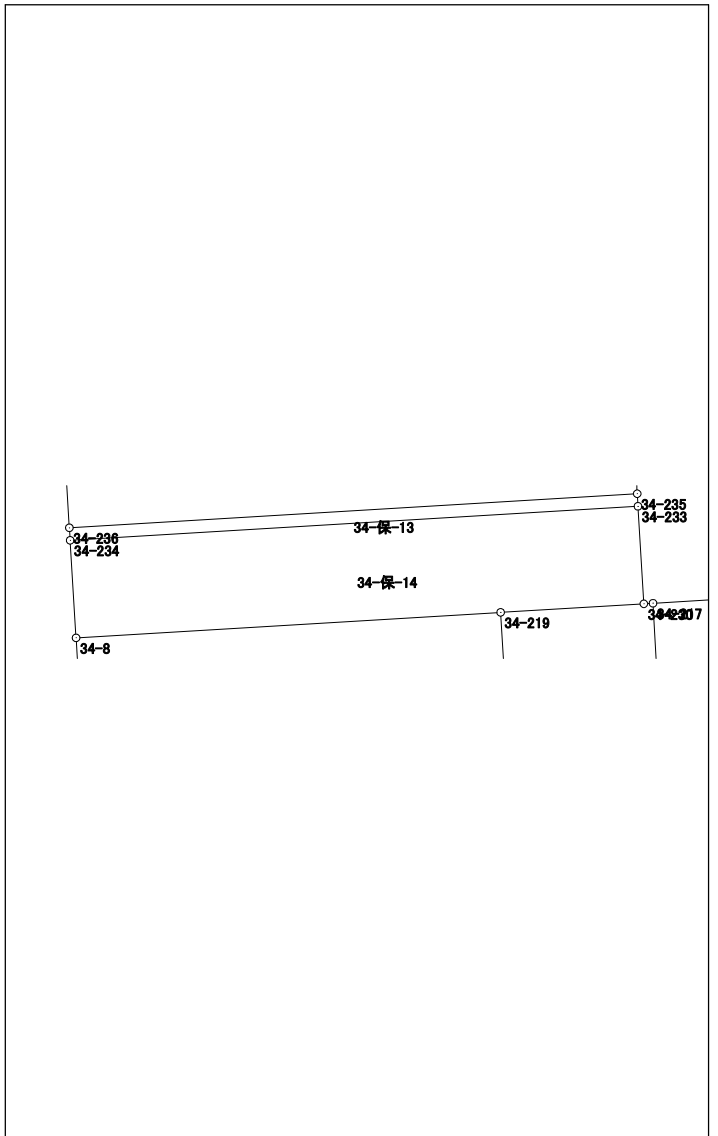


面積計算書 (座標法)

世界測地系 (測地成果2011)

所在	地番	公簿地目	現況地目	地積	所有者
前橋市六供町二丁目	34-保-15			11.00 m ²	

点名	X座標	Y座標	辺長	方向角	測角	DX	倍積 (Y×DX)
34-241	41410.257	-68199.845	0.579	356-26-10	89-54-17	1.729	-117917.532005
34-243	41410.835	-68199.881	19.022	266-31-41	90-05-31	-0.574	39146.731694
34-244	41409.683	-68218.868	0.578	176-37-40	90-05-59	-1.729	117950.422772
34-242	41409.106	-68218.834	19.024	86-31-53	89-54-13	0.574	-39157.610716
倍面積						22.011745	
面積						11.0058725	

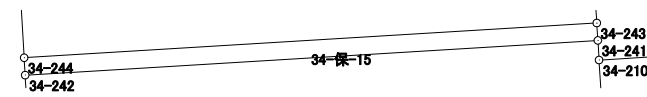


面積計算書 (座標法)

世界測地系 (測地成果2011)

所 在	地 番	公簿地目	現況地目	地 積	所 有 者
前橋市六供町二丁目	34-保-16			12.00 m ²	

点 名	X 座標	Y 座標	辺 長	方 向 角	測 角	DX	倍 積 (Y×DX)
34-222	41402.610	-68199.385	19.022	266-31-41	89-58-47	-0.522	35600.078970
34-221	41401.458	-68218.372	0.631	176-32-54	90-01-13	-1.782	121565.138904
34-223	41400.828	-68218.334	19.022	86-31-41	89-58-47	0.522	-35609.970348
34-224	41401.980	-68199.347	0.631	356-32-54	90-01-13	1.782	-121531.236354
						倍面積	24.011172
						面積	12.0055860

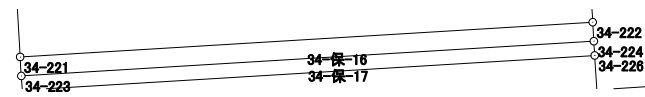


面積計算書（座標法）

世界測地系（測地成果2011）

所 在	地 番	公簿地目	現況地目	地 積	所 有 者
前橋市六供町二丁目	34-保-17			9.00 m ²	

点 名	X 座標	Y 座標	辺 長	方 向 角	測 角	DX	倍 積 (Y×DX)
34-224	41401.980	-68199.347	19.022	266-31-41	89-54-57	-0.679	46307.356613
34-223	41400.828	-68218.334	0.473	176-29-03	89-57-22	-1.624	110786.574416
34-225	41400.356	-68218.305	19.021	86-31-51	90-02-48	0.679	-46320.229095
34-226	41401.507	-68199.319	0.474	356-36-44	90-04-53	1.624	-110755.694056

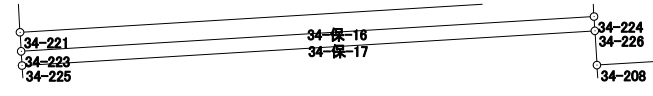


倍面積 18.007878
 面 積 9.0039390

面積計算書 (座標法)

世界測地系 (測地成果2011)

所在	地番	公簿地目	現況地目	地積	所有者
前橋市六供町二丁目	34-保-18			38.37 m ²	

点名	X座標	Y座標	辺長	方向角	測角	DX	倍積 (Y×DX)
34-54	41407.092	-68218.714	19.028	86-31-45	89-56-20	-0.862	58804.531468
34-53	41408.244	-68199.721	1.366	356-28-24	89-56-39	2.515	-171522.298315
34-210	41409.607	-68199.805	0.651	356-28-43	180-00-19	2.013	-137286.207465
34-241	41410.257	-68199.845	19.024	266-31-53	90-03-10	-0.501	34168.122345
34-242	41409.106	-68218.834	2.018	176-35-25	90-03-32	-3.165	215912.609610
						倍面積	76.757643
						面積	38.3788215

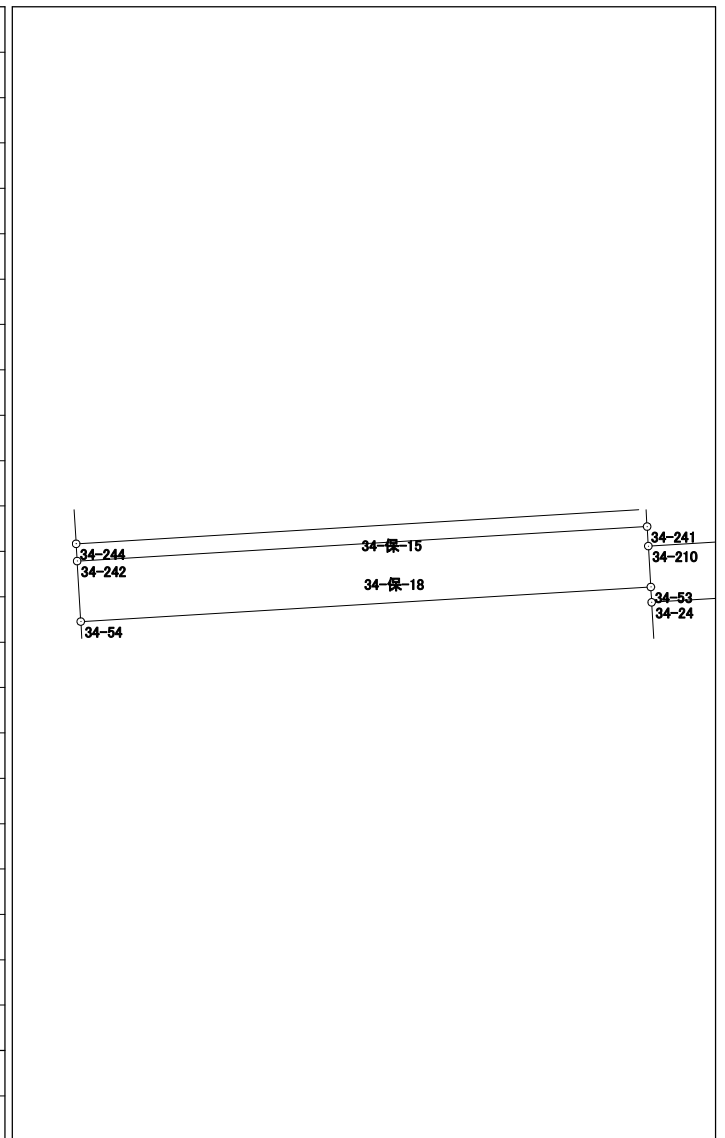


面積計算書（座標法）

世界測地系（測地成果2011）

所在	地番	公簿地目	現況地目	地積	所有者
前橋市六供町二丁目	34-保-19			27.00 m ²	

点名	X座標	Y座標	辺長	方向角	測角	DX	倍積 (Y×DX)
34-19	41438.093	-68185.510	16.002	266-31-03	89-59-01	0.712	-48548.083120
34-18	41437.121	-68201.482	1.688	176-38-15	90-07-12	-2.657	181211.337674
34-249	41435.436	-68201.383	16.005	86-30-52	89-52-37	-0.712	48559.384696
34-250	41436.409	-68185.408	1.687	356-32-02	90-01-10	2.657	-181168.629056
						倍面積	54.010194
						面積	27.0050970

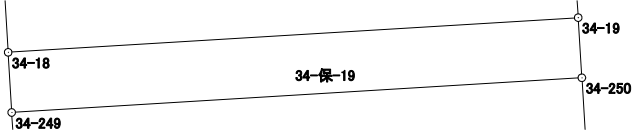

面積計算書 (座標法)

世界測地系 (測地成果2011)

所在	地番	公簿地目	現況地目	地積	所有者
前橋市六供町二丁目	34-保-20			13.00 m ²	

点名	X座標	Y座標	辺長	方向角	測角	DX	倍積 (Y×DX)	
34-252	41431.801	-68185.128	16.010	266-30-56	89-58-23	-0.162	11045.990736	
34-251	41430.828	-68201.108	0.812	176-32-33	90-01-37	-1.784	121670.776672	
34-253	41430.017	-68201.059	16.010	86-30-56	89-58-23	0.162	-11048.571558	
34-254	41430.990	-68185.079	0.812	356-32-33	90-01-37	1.784	-121642.180936	
						倍面積	26.014914	
						面積	13.0074570	

面積計算書（座標法）

世界測地系（測地成果2011）

所 在	地 番	公簿地目	現況地目	地 積	所 有 者
前橋市六供町二丁目	34-保-22			122.57 m ²	

点 名	X 座標	Y 座標	辺 長	方 向 角	測 角	DX	倍 積 (Y×DX)	
34-58	41427.207	-68200.888	3.721	176-29-13	89-59-35	-4.693	320066.767384	
34-203	41423.493	-68200.660	2.789	176-29-07	179-59-54	-6.498	443167.888680	
34-33	41420.709	-68200.489	1.145	176-29-44	180-00-37	-3.927	267823.320303	
34-36	41419.566	-68200.419	15.999	86-31-14	90-01-30	-0.172	11730.472068	
34-37	41420.537	-68184.449	7.663	356-33-30	90-02-16	8.620	-587749.950380	
34-57	41428.186	-68184.909	16.009	266-29-38	89-56-08	6.670	-454793.343030	
倍面積							245.155025	
面 積							122.5775125	