


35街区 画地出来形確認図 (6950.67m²)



S=1/500

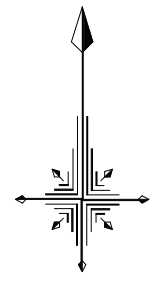


面積計算書（座標法）

世界測地系（測地成果2011）

所在	地番	公簿地目	現況地目	地積	所有者
前橋市六供町二丁目	35-1			201.50 m ²	

点名	X座標	Y座標	辺長	方向角	測角	DX	倍積 (Y×DX)
35-107	41434.771	-68286.694	11.780	349-18-57	90-01-30	14.802	-1010779.644588
35-10	41446.347	-68288.878	14.709	259-13-29	89-54-32	8.826	-602717.637228
35-2	41443.597	-68303.328	3.994	214-00-30	134-47-01	-6.061	413986.471008
35-1	41440.286	-68305.562	8.926	168-18-04	134-17-34	-12.052	823218.633224
35-108	41431.545	-68303.752	17.360	79-17-27	90-59-23	-5.515	376695.192280
倍面積							403.014696
面積							201.5073480

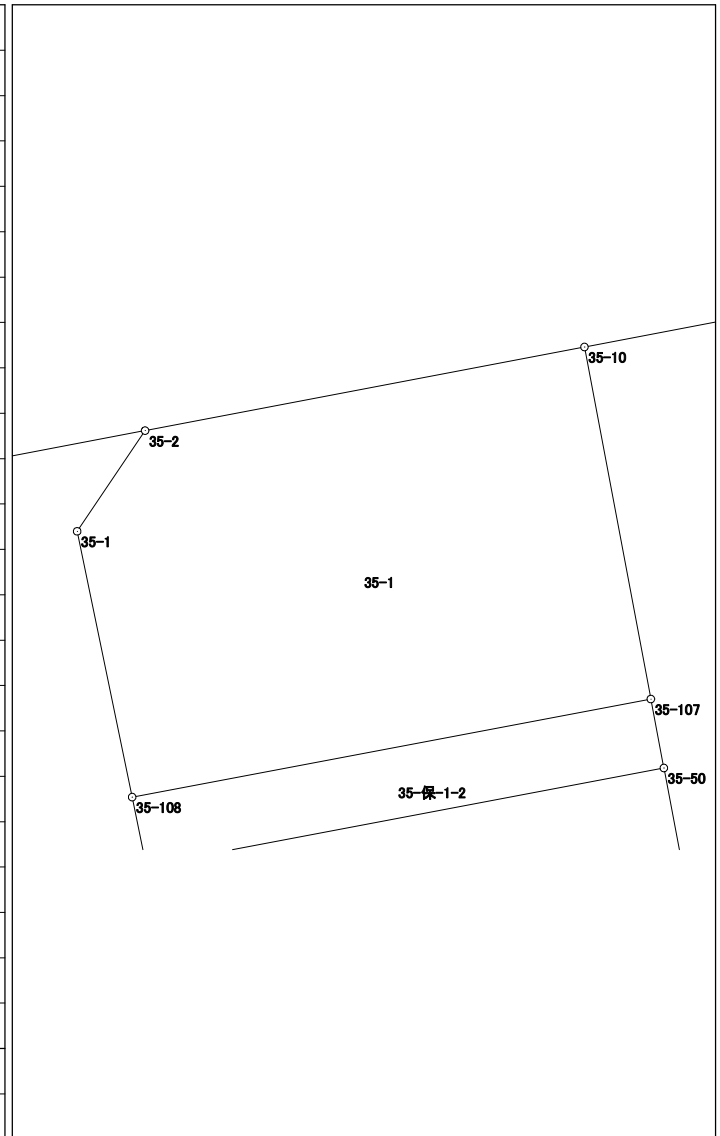


面積計算書 (座標法)

世界測地系 (測地成果2011)

所在	地番	公簿地目	現況地目	地積	所有者
前橋市六供町二丁目	35-2			455.43 m ²	

点名	X座標	Y座標	辺長	方向角	測角	DX	倍積 (Y×DX)
35-10	41446.347	-68288.878	11.780	169-18-57	90-03-44	-14.628	998929.707384
35-107	41434.771	-68286.694	2.307	169-18-31	179-59-34	-13.843	945292.705042
35-50	41432.504	-68286.266	11.294	169-16-05	179-57-34	-13.363	912509.372558
35-109	41421.408	-68284.163	2.339	169-15-25	179-59-20	-13.394	914598.079222
35-9	41419.110	-68283.727	16.381	79-52-52	90-37-27	0.580	-39604.561660
35-11	41421.988	-68267.601	27.899	349-15-59	89-23-07	30.289	-2067757.366689
35-12	41449.399	-68272.797	16.368	259-15-13	89-59-14	24.359	-1663057.062123

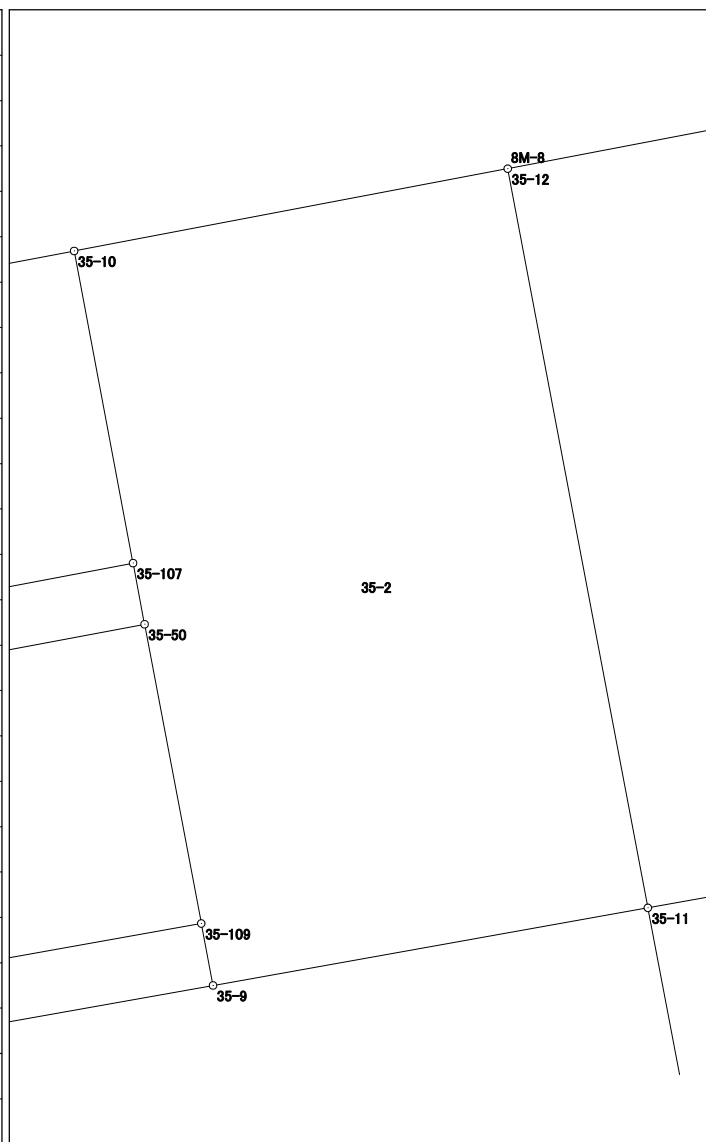


倍面積	910.873734
面積	455.4368670

面積計算書 (座標法)

世界測地系 (測地成果2011)

所在	地番	公簿地目	現況地目	地積	所有者
前橋市六供町二丁目	35-3			536.72 m ²	

点名	X座標	Y座標	辺長	方向角	測角	DX	倍積 (Y×DX)
35-12	41449.399	-68272.797	27.899	169-15-59	90-03-38	-31.336	2139396.366792
35-11	41421.988	-68267.601	17.357	79-53-46	90-37-47	-24.366	1663408.365966
35-33	41425.033	-68250.513	0.776	356-36-12	96-42-26	3.820	-260716.959660
35-103	41425.808	-68250.559	4.913	356-35-33	179-59-21	5.679	-387594.924561
35-101	41430.712	-68250.851	5.126	356-35-20	179-59-47	10.021	-683941.777871
35-40	41435.829	-68251.156	17.527	356-33-08	179-57-48	22.612	-1543295.139472
35-13	41453.324	-68252.210	20.958	259-12-21	82-39-13	13.570	-926182.489700
						倍面積	1073.441494
						面積	536.7207470

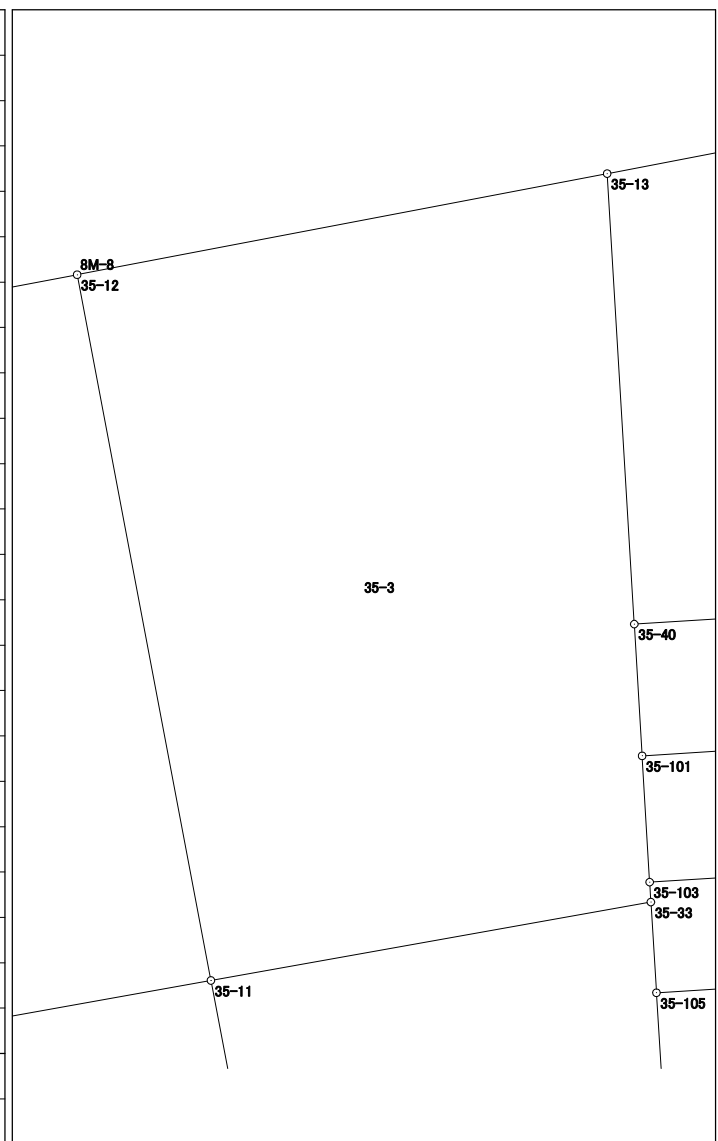

面積計算書 (座標法)

世界測地系 (測地成果2011)


所 在	地 番	公簿地目	現況地目	地 積	所 有 者
前橋市六供町二丁目	35-4			466.63 m ²	

点 名	X 座標	Y 座標	辺 長	方 向 角	測 角	DX	倍 積 (Y×DX)	
35-13	41453.324	-68252.210	17.527	176-33-08	97-19-17	-21.579	1472814.439590	
35-40	41435.829	-68251.156	24.670	86-30-01	89-56-53	-15.989	1091267.733284	
35-41	41437.335	-68226.532	17.651	356-32-16	90-02-15	19.125	-1304832.424500	
35-4	41454.954	-68227.598	3.985	308-00-31	131-28-15	20.073	-1369532.574654	
35-3	41457.408	-68230.738	21.857	259-13-51	131-13-20	-1.630	111216.102940	
倍面積							933.276660	
面 積							466.6383300	

面積計算書（座標法）

世界測地系（測地成果2011）

所 在	地 番	公簿地目	現況地目	地 積	所 有 者
前橋市六供町二丁目	35-6			121.23 m ²	

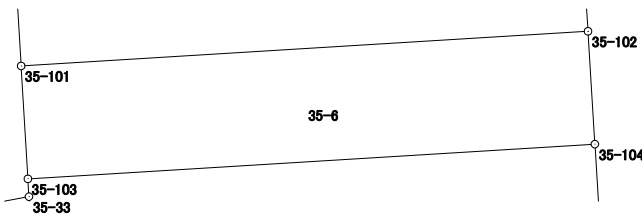点 名	X 座標	Y 座標	辺 長	方 向 角	測 角	DX	倍 積 (Y×DX)	
35-101	41430.712	-68250.851	4.913	176-35-33	90-05-30	-6.410	437487.954910	
35-103	41425.808	-68250.559	24.680	86-30-06	89-54-33	-3.398	231915.399482	
35-104	41427.314	-68225.925	4.913	356-32-03	90-01-57	6.410	-437328.179250	
35-102	41432.218	-68226.222	24.675	266-30-03	89-58-00	3.398	-231832.702356	
						倍面積	242.472786	
						面 積	121.2363930	

面積計算書 (座標法)

世界測地系 (測地成果2011)

所在	地番	公簿地目	現況地目	地積	所有者
前橋市六供町二丁目	35-7			106.23 m ²	


点名	X座標	Y座標	辺長	方向角	測角	DX	倍積 (Y×DX)	
35-104	41427.314	-68225.925	24.680	266-30-06	89-57-51	2.791	-190418.556675	
35-103	41425.808	-68250.559	0.776	176-36-12	90-06-06	-2.281	155679.525079	
35-33	41425.033	-68250.513	3.528	176-28-24	179-52-12	-4.296	293204.203848	
35-105	41421.512	-68250.296	24.677	86-30-12	90-01-48	-2.016	137592.596736	
35-106	41423.017	-68225.665	4.305	356-32-15	90-02-03	5.802	-395845.308330	
						倍面積	212.460658	
						面積	106.2303290	

面積計算書（座標法）

世界測地系（測地成果2011）

所 在	地 番	公簿地目	現況地目	地 積	所 有 者
前橋市六供町二丁目	35-8			290.90 m ²	

点 名	X 座標	Y 座標	辺 長	方 向 角	測 角	DX	倍 積 (Y×DX)
35-125	41380.671	-68247.826	11.784	176-29-32	89-57-45	-13.255	904624.933630
35-23	41368.909	-68247.105	24.664	86-34-42	90-05-10	-10.290	702262.710450
35-24	41370.381	-68222.485	11.805	356-29-54	89-55-12	13.255	-904289.038675
35-126	41382.164	-68223.206	24.665	266-31-47	90-01-53	10.290	-702016.789740
						倍面積	581.815665
						面 積	290.9078325

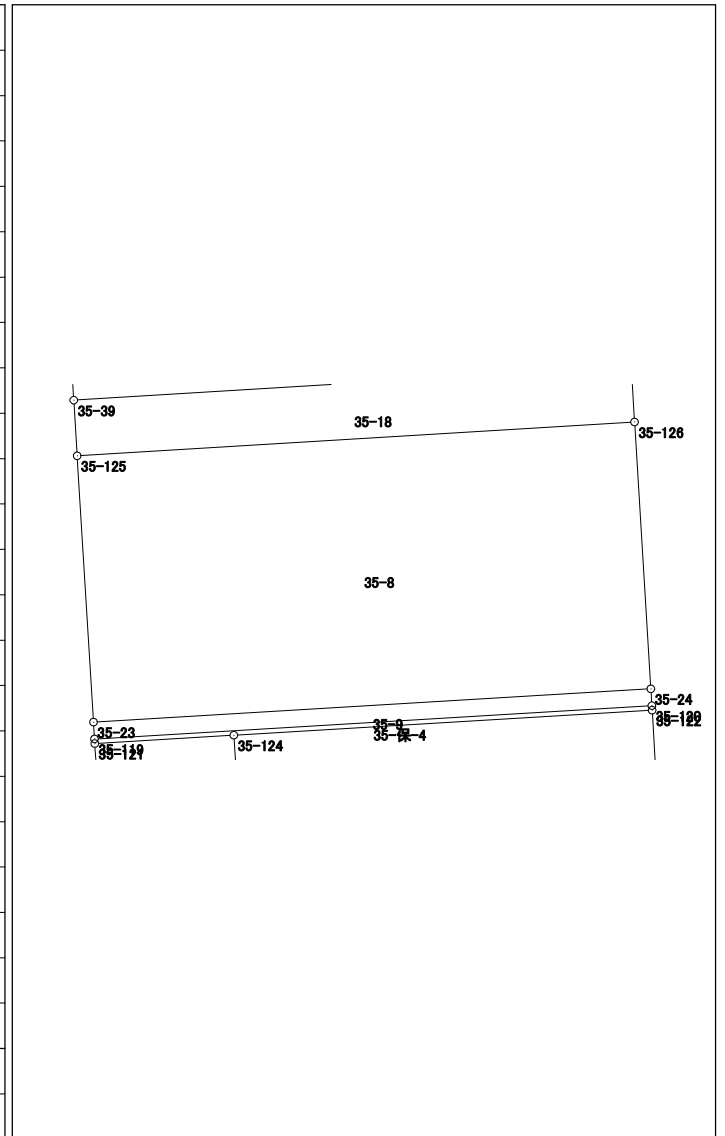


面積計算書（座標法）

世界測地系（測地成果2011）

所在	地番	公簿地目	現況地目	地積	所有者
前橋市六供町二丁目	35-9			18.37 m ²	

点名	X座標	Y座標	辺長	方向角	測角	DX	倍積 (Y×DX)
35-23	41368.909	-68247.105	0.744	176-32-03	89-57-21	-2.215	151167.337575
35-119	41368.166	-68247.060	24.664	86-34-51	90-02-48	0.728	-49683.859680
35-120	41369.637	-68222.440	0.745	356-32-19	89-57-28	2.215	-151112.704600
35-24	41370.381	-68222.485	24.664	266-34-42	90-02-23	-0.728	49665.969080
倍面積							36.742375
面積							18.3711875

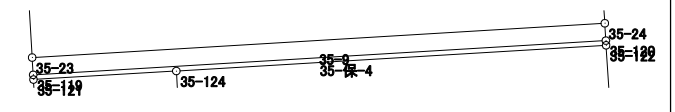


面積計算書（座標法）

世界測地系（測地成果2011）

所 在	地 番	公簿地目	現況地目	地 積	所 有 者
前橋市六供町二丁目	35-10			299.41 m ²	

点 名	X 座標	Y 座標	辺 長	方 向 角	測 角	DX	倍 積 (Y×DX)
35-123	41353.642	-68240.018	15.705	97-06-12	100-34-01	-16.630	1134831.499340
35-6	41351.700	-68224.434	3.988	46-52-47	129-46-35	0.784	-53487.956256
35-5	41354.426	-68221.523	15.036	356-32-58	129-40-11	17.735	-1209908.710405
35-122	41369.435	-68222.428	18.512	266-34-41	90-01-43	13.904	-948564.638912
35-124	41368.330	-68240.907	14.715	176-32-11	89-57-30	-15.793	1077728.644251
						倍面積	598.838018
						面 積	299.419090

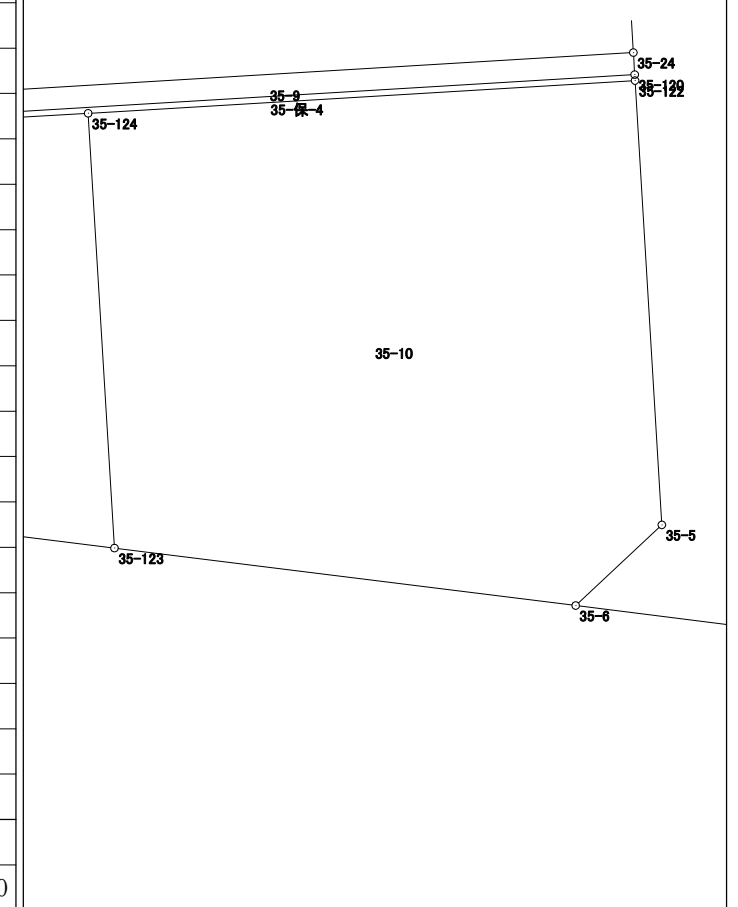


面積計算書 (座標法)

世界測地系 (測地成果2011)

所在	地番	公簿地目	現況地目	地積	所有者
前橋市六供町二丁目	35-11			2432.73 m ²	

点名	X座標	Y座標	辺長	方向角	測角	DX	倍積(Y×DX)
35-129	41407.631	-68298.783	36.016	168-16-18	88-22-31	-41.108	2807626.371564
35-29	41372.367	-68291.462	17.475	86-33-55	98-17-37	-34.217	2336728.955254
35-28	41373.414	-68274.018	6.241	176-32-46	269-58-51	-5.183	353864.235294
35-111	41367.184	-68273.642	0.667	176-38-55	180-06-09	-6.896	470815.035232
35-35	41366.518	-68273.603	8.780	176-29-37	179-50-42	-9.430	643820.076290
35-27	41357.754	-68273.066	27.046	97-05-22	100-35-45	-12.102	826240.644732
35-14	41354.416	-68246.227	13.572	356-31-55	79-26-33	10.209	-696725.731443
35-121	41367.963	-68247.048	0.203	356-37-01	180-05-06	13.750	-938396.910000
35-119	41368.166	-68247.060	0.744	356-32-03	179-55-02	0.946	-64561.718760
35-23	41368.909	-68247.105	11.784	356-29-32	179-57-29	12.505	-853430.048025
35-125	41380.671	-68247.826	2.461	356-28-54	179-59-22	14.218	-970347.590068
35-39	41383.127	-68247.977	4.986	356-33-02	180-04-08	7.433	-507287.213041
35-128	41388.104	-68248.277	28.923	356-33-11	180-00-09	33.848	-2310067.679896
35-48	41416.975	-68250.016	4.546	356-28-07	179-54-56	33.408	-2280096.534528
35-105	41421.512	-68250.296	3.528	356-28-24	180-00-17	8.058	-549960.885168
35-33	41425.033	-68250.513	17.357	259-53-46	83-25-22	0.476	-32487.244188
35-11	41421.988	-68267.601	8.665	169-15-52	89-22-06	-11.558	789036.932358
35-130	41413.475	-68265.987	33.313	259-53-47	270-37-55	-14.357	980094.775359

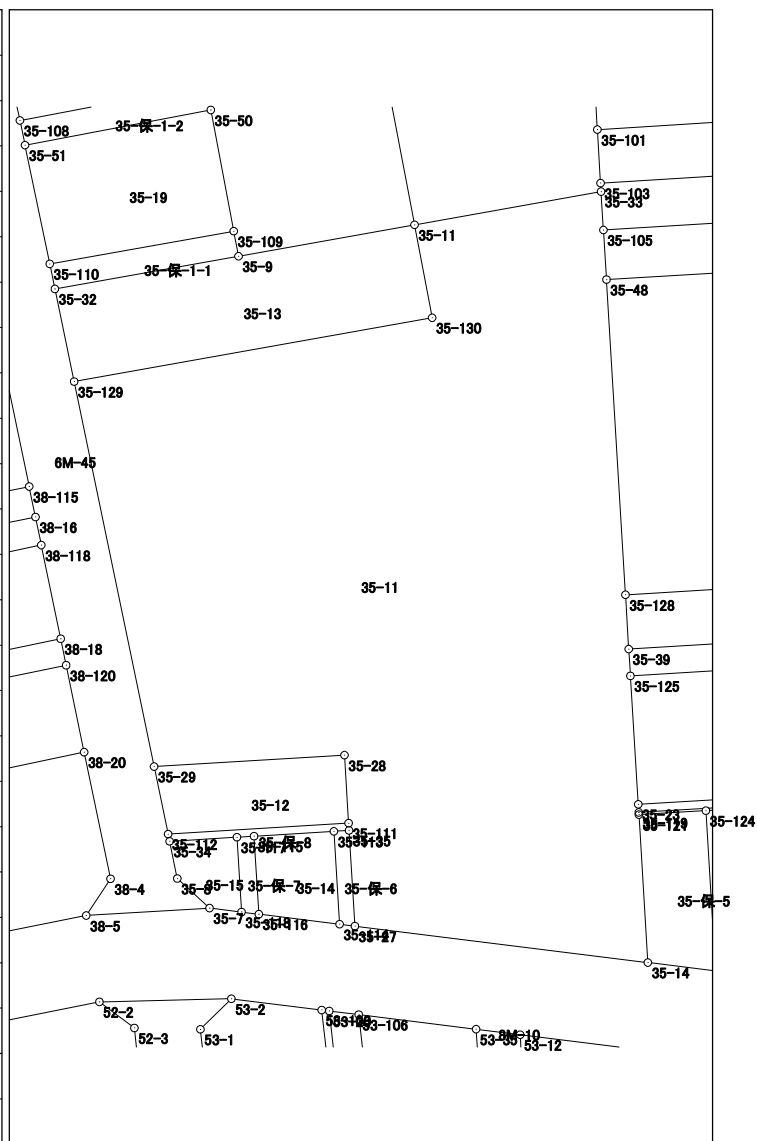


倍面積	4865.470966
面積	2432.7354830

面積計算書（座標法）

世界測地系（測地成果2011）

所在	地番	公簿地目	現況地目	地積	所有者
前橋市六供町二丁目	35-12			106.31 m ²	

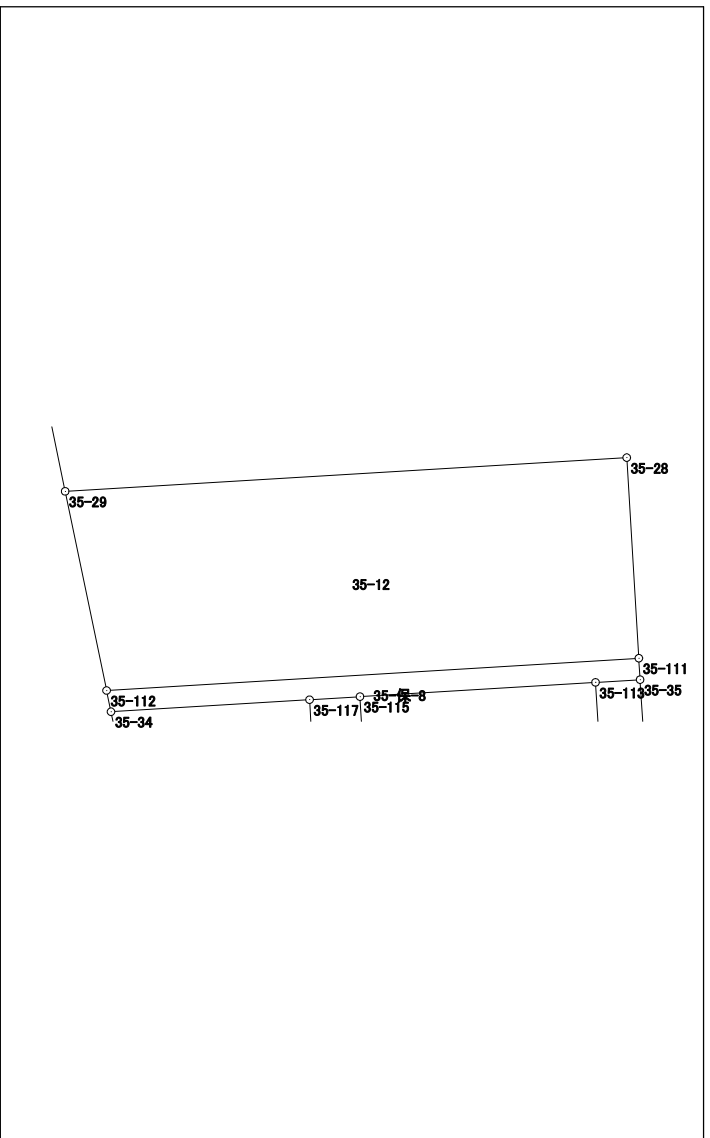
点名	X座標	Y座標	辺長	方向角	測角	DX	倍積 (Y×DX)	
35-111	41367.184	-68273.642	6.241	356-32-46	90-01-04	7.233	-493823.252586	
35-28	41373.414	-68274.018	17.475	266-33-55	90-01-09	5.183	-353864.235294	
35-29	41372.367	-68291.462	6.318	168-14-50	81-40-55	-7.233	493952.144646	
35-112	41366.181	-68290.175	16.563	86-31-42	98-16-52	-5.183	353947.977025	
						倍面積	212.633791	
						面積	106.3168955	

面積計算書 (座標法)

世界測地系 (測地成果2011)

所在	地番	公簿地目	現況地目	地積	所有者
前橋市六供町二丁目	35-13			289.20 m ²	

点名	X座標	Y座標	辺長	方向角	測角	DX	倍積 (Y×DX)
35-32	41416.118	-68300.545	8.668	168-16-17	88-21-33	-11.479	784021.956055
35-129	41407.631	-68298.783	33.313	79-53-47	91-37-30	-2.643	180513.683469
35-130	41413.475	-68265.987	8.665	349-15-52	89-22-05	14.357	-980094.775359
35-11	41421.988	-68267.601	16.381	259-52-52	90-37-00	5.635	-384687.931635
35-9	41419.110	-68283.727	17.082	259-54-44	180-01-52	-5.870	400825.477490

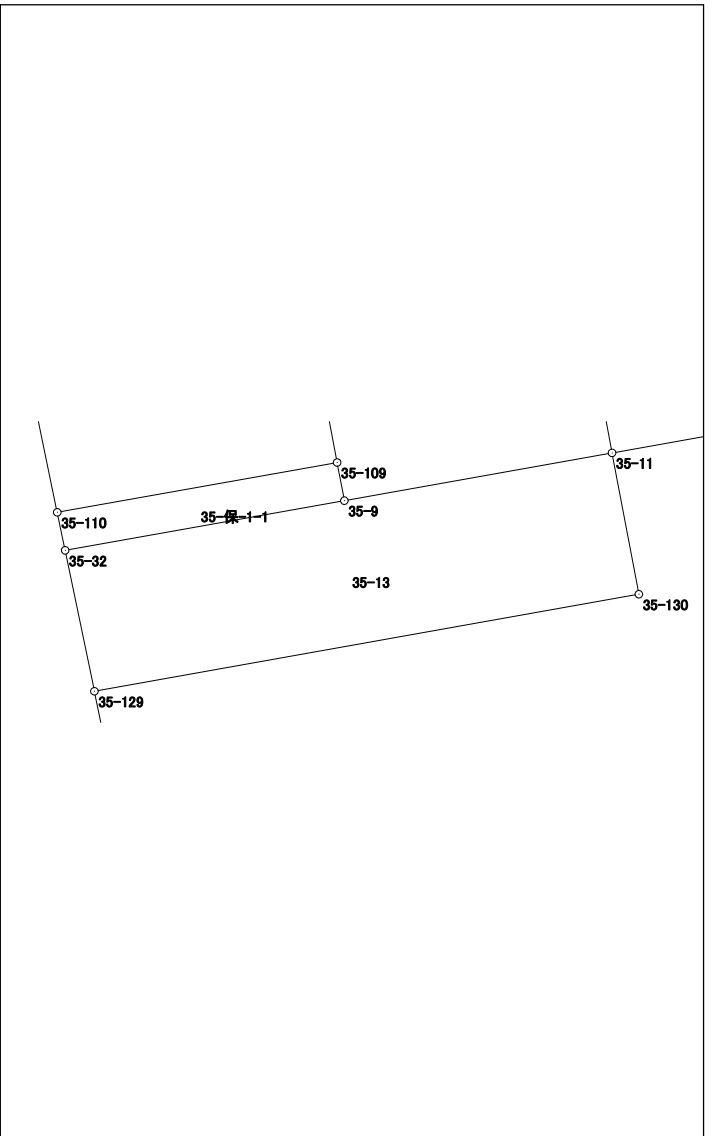


倍面積	578.410020
面積	289.2050100

面積計算書 (座標法)

世界測地系 (測地成果2011)

所在	地番	公簿地目	現況地目	地積	所有者
前橋市六供町二丁目	35-14			57.47 m ²	

点名	X座標	Y座標	辺長	方向角	測角	DX	倍積 (Y×DX)
35-114	41357.928	-68274.466	8.522	356-29-18	79-25-31	7.589	-518134.922474
35-113	41366.434	-68274.988	7.329	266-32-05	90-02-47	8.063	-550501.228244
35-115	41365.991	-68282.304	7.159	176-30-02	89-57-57	-7.589	518194.405056
35-116	41358.845	-68281.867	7.458	97-03-47	100-33-45	-8.063	550556.693621

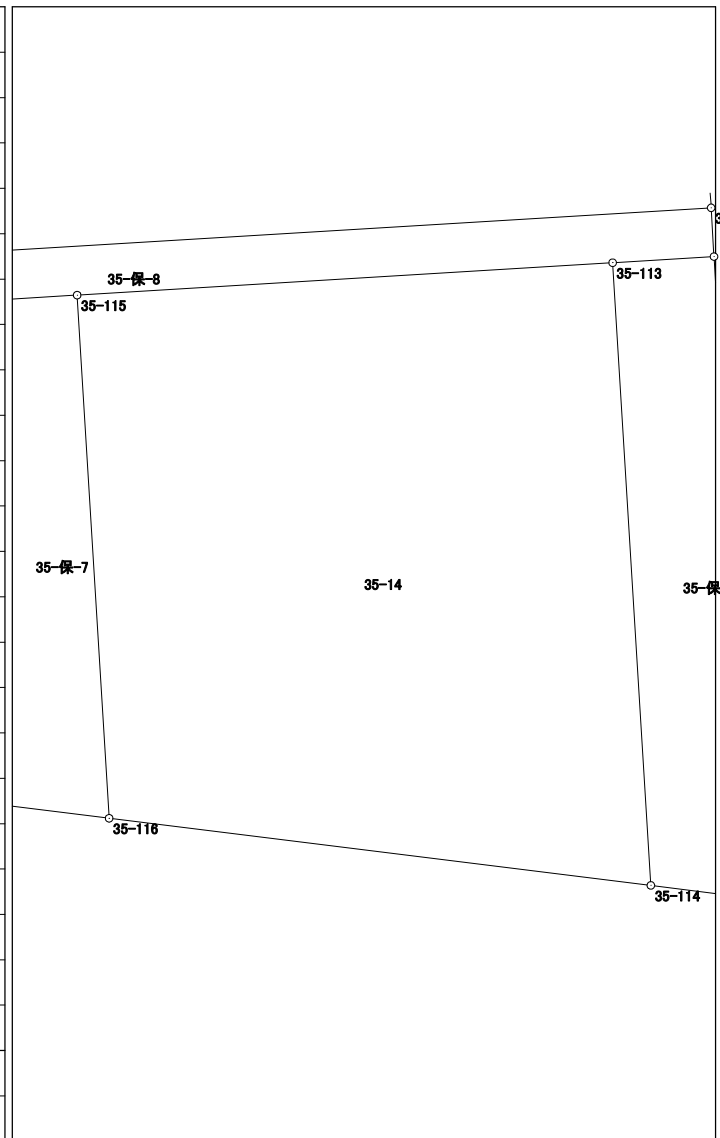


倍面積	114.947959
面積	57.4739795

面積計算書（座標法）

所在	地番	公簿地目	現況地目	地積	所有者
前橋市六供町二丁目	35-15			33.59 m ²	

点名	X座標	Y座標	辺長	方向角	測角	DX	倍積 (Y×DX)
35-117	41365.896	-68283.870	6.179	266-31-48	90-02-10	6.481	-442547.761470
35-34	41365.522	-68290.038	3.480	168-19-42	81-47-54	-3.782	258272.923716
35-8	41362.114	-68289.334	4.007	132-31-57	144-12-15	-6.117	417725.856078
35-7	41359.405	-68286.381	2.954	97-04-45	144-32-48	-3.073	209844.048813
35-118	41359.041	-68283.450	6.868	356-29-38	79-24-53	6.491	-443227.873950

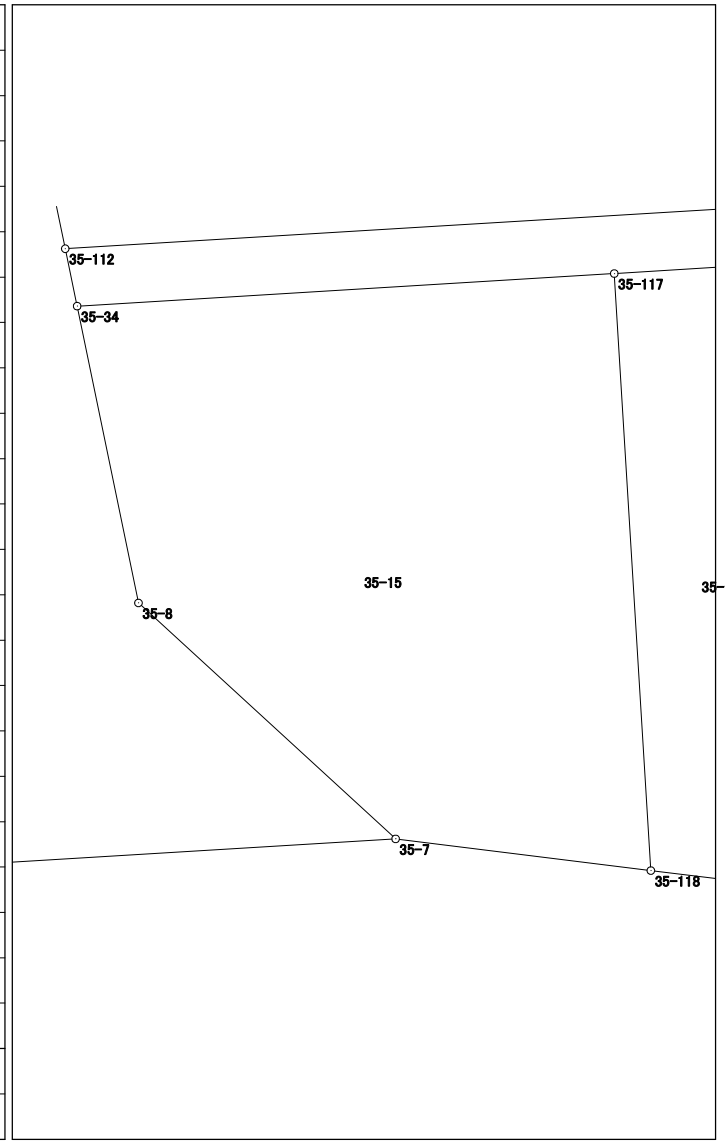


倍面積	67.193187
面積	33.5965935

面積計算書 (座標法)

世界測地系 (測地成果2011)

所 在	地 番	公簿地目	現況地目	地 積	所 有 者
前橋市六供町二丁目	35-16			112.40 m ²	

点 名	X 座標	Y 座標	辺 長	方 向 角	測 角	DX	倍 積 (Y×DX)
35-105	41421.512	-68250.296	4.546	176-28-07	89-57-55	-6.042	412368.288432
35-48	41416.975	-68250.016	24.672	86-32-57	90-04-50	-3.052	208299.048832
35-49	41418.460	-68225.389	4.565	356-32-03	89-59-06	6.042	-412217.800338
35-106	41423.017	-68225.665	24.677	266-30-12	89-58-09	3.052	-208224.729580
						倍面積	224.807346
						面 積	112.4036730

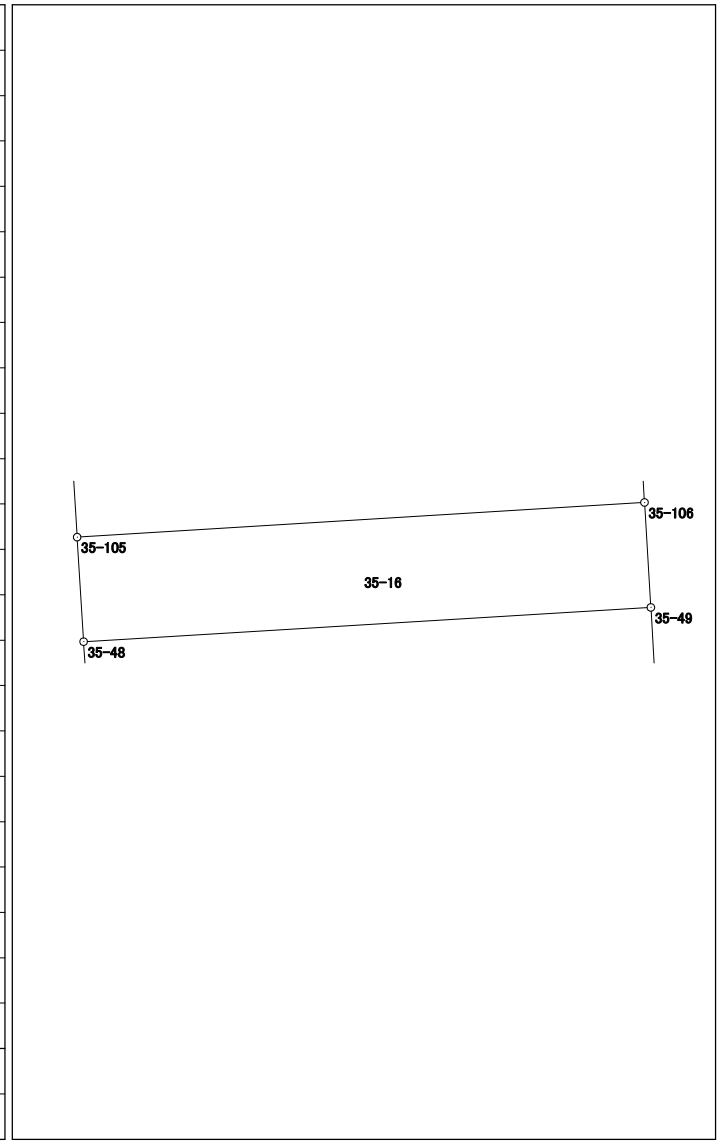


面積計算書（座標法）

世界測地系（測地成果2011）

所 在	地 番	公簿地目	現況地目	地 積	所 有 者
前橋市六供町二丁目	35-17			713.40 m ²	

点 名	X 座標	Y 座標	辺 長	方 向 角	測 角	DX	倍 積 (Y×DX)
35-127	41389.598	-68223.655	28.914	356-33-43	90-02-03	30.356	-2070997.271180
35-49	41418.460	-68225.389	24.672	266-32-57	89-59-14	27.377	-1867806.474653
35-48	41416.975	-68250.016	28.923	176-33-11	90-00-14	-30.356	2071797.485696
35-128	41388.104	-68248.277	24.667	86-31-40	89-58-29	-27.377	1868433.079429
						倍面積	1426.819292
						面 積	713.4096460

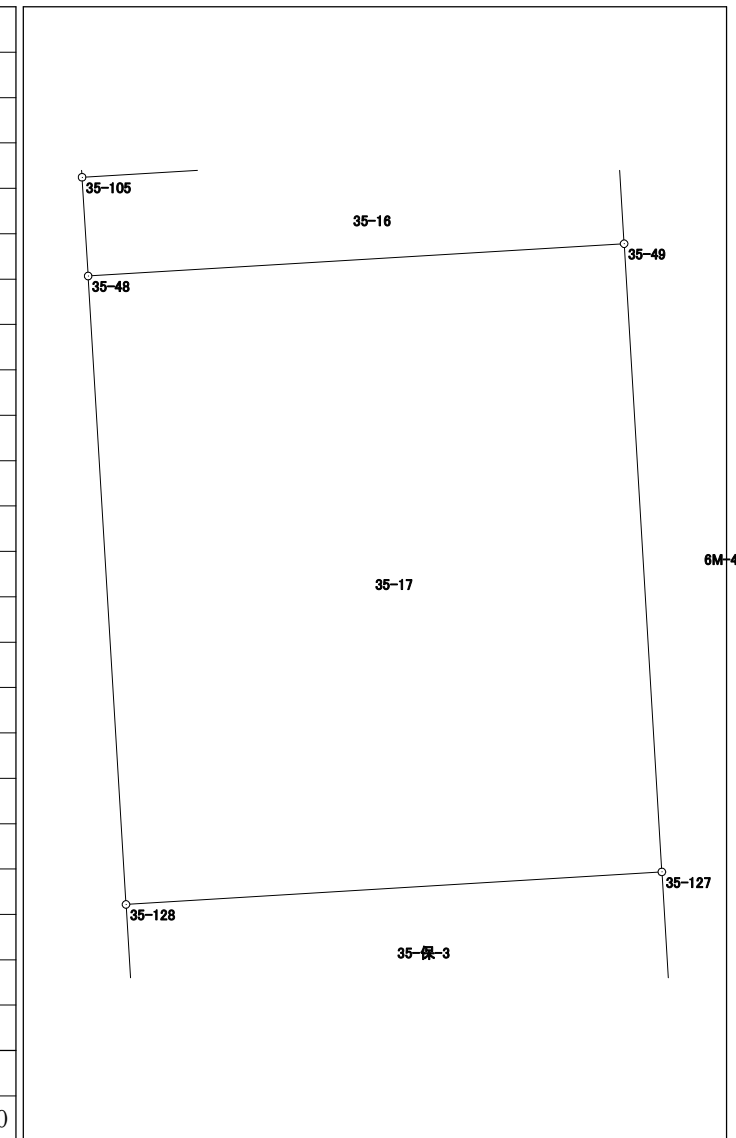


面積計算書 (座標法)

世界測地系 (測地成果2011)

所 在	地 番	公簿地目	現況地目	地 積	所 有 者
前橋市六供町二丁目	35-18			60.69 m ²	

点 名	X 座標	Y 座標	辺 長	方 向 角	測 角	DX	倍 積 (Y×DX)
35-39	41383.127	-68247.977	2.461	176-28-54	89-57-06	-3.949	269511.261173
35-125	41380.671	-68247.826	24.665	86-31-47	90-02-53	-0.963	65722.656438
35-126	41382.164	-68223.206	2.461	356-30-18	89-58-31	3.949	-269413.440494
35-38	41384.620	-68223.356	24.666	266-31-48	90-01-30	0.963	-65699.091828
						倍面積	121.385289
						面 積	60.6926445

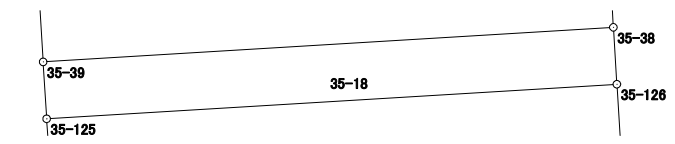


面積計算書（座標法）

世界測地系（測地成果2011）

所在	地番	公簿地目	現況地目	地積	所有者
前橋市六供町二丁目	35-19			192.87 m ²	

点名	X座標	Y座標	辺長	方向角	測角	DX	倍積 (Y×DX)
35-109	41421.408	-68284.163	11.294	349-16-05	89-21-19	14.095	-962465.277485
35-50	41432.504	-68286.266	17.320	259-17-32	90-01-27	7.878	-537959.203548
35-51	41429.286	-68303.284	11.110	168-14-49	88-57-17	-14.095	962734.787980
35-110	41418.409	-68301.021	17.123	79-54-46	91-39-57	-7.878	538075.443438

倍面積	385.750385
面積	192.8751925

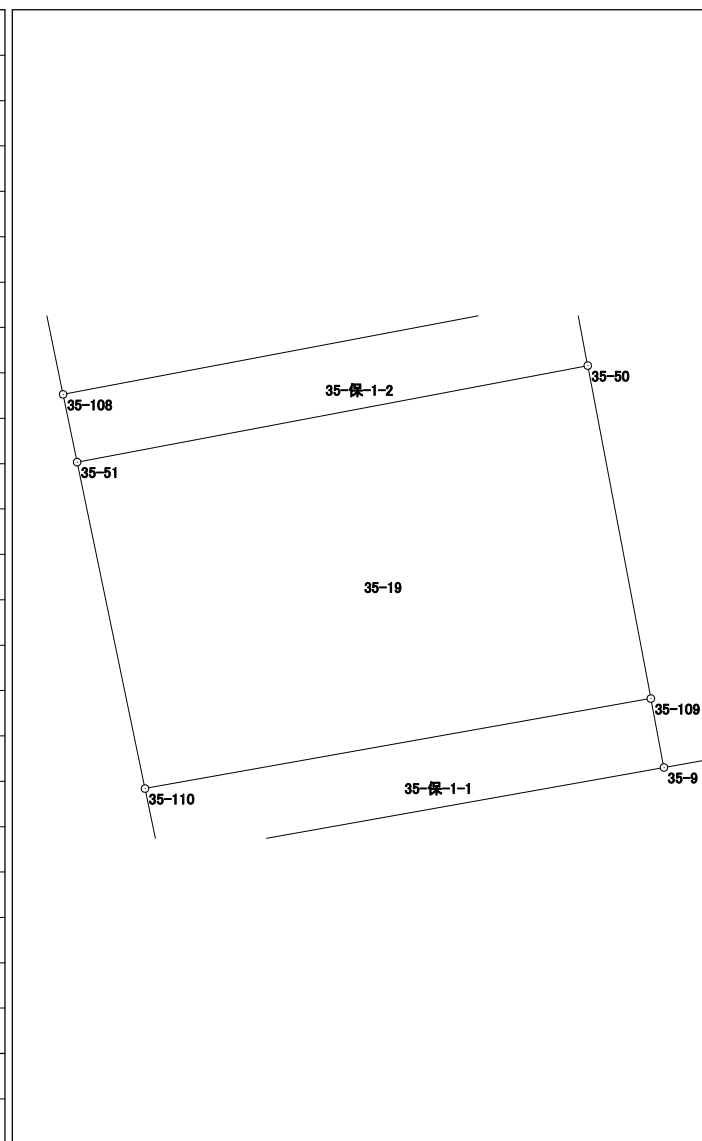


面積計算書 (座標法)

世界測地系 (測地成果2011)

所在	地番	公簿地目	現況地目	地積	所有者
前橋市六供町二丁目	35-保-1-1			40.00 m ²	

点名	X座標	Y座標	辺長	方向角	測角	Dx	倍積 (Y×Dx)
35-32	41416.118	-68300.545	17.082	79-54-44	91-38-58	0.701	-47878.682045
35-9	41419.110	-68283.727	2.339	349-15-25	89-20-41	5.290	-361220.915830
35-109	41421.408	-68284.163	17.123	259-54-46	90-39-21	-0.701	47867.198263
35-110	41418.409	-68301.021	2.340	168-15-46	88-21-00	-5.290	361312.401090

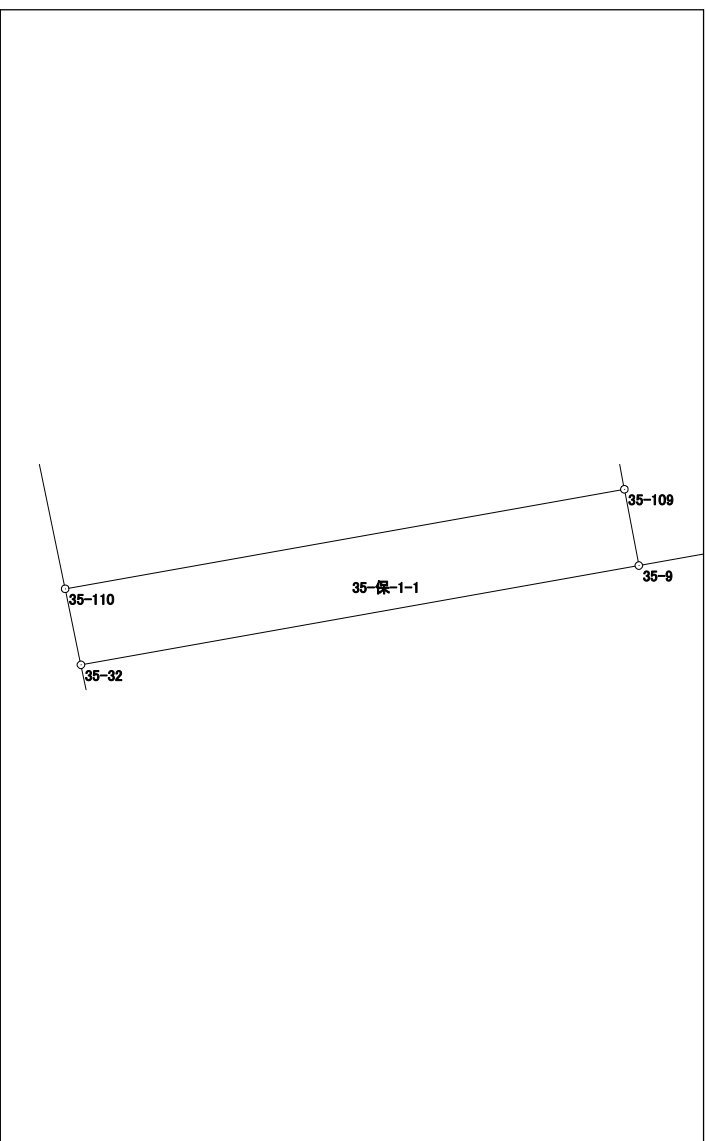


倍面積	80.001478
面積	40.0007390

面積計算書 (座標法)

世界測地系 (測地成果2011)

所在	地番	公簿地目	現況地目	地積	所有者
前橋市六供町二丁目	35-保-1-2			40.00 m ²	

点名	X座標	Y座標	辺長	方向角	測角	DX	倍積 (Y×DX)
35-51	41429.286	-68303.284	17.320	79-17-32	90-59-48	0.959	-65502.849356
35-50	41432.504	-68286.266	2.307	349-18-31	90-00-59	5.485	-374550.169010
35-107	41434.771	-68286.694	17.360	259-17-27	89-58-56	-0.959	65486.939546
35-108	41431.545	-68303.752	2.307	168-17-44	89-00-17	-5.485	374646.079720
倍面積						80.000900	
面積						40.0004500	

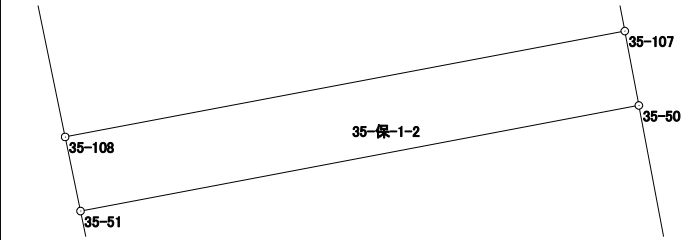


面積計算書（座標法）

世界測地系（測地成果2011）

所在	地番	公簿地目	現況地目	地積	所有者
前橋市六供町二丁目	35-保-3			123.00 m ²	

点名	X座標	Y座標	辺長	方向角	測角	Dx	倍積(Y×Dx)
35-39	41383.127	-68247.977	24.666	86-31-48	89-58-46	-3.484	237775.951868
35-38	41384.620	-68223.356	4.987	356-33-46	90-01-58	6.471	-441473.336676
35-127	41389.598	-68223.655	24.667	266-31-40	89-57-54	3.484	-237691.214020
35-128	41388.104	-68248.277	4.986	176-33-02	90-01-22	-6.471	441634.600467

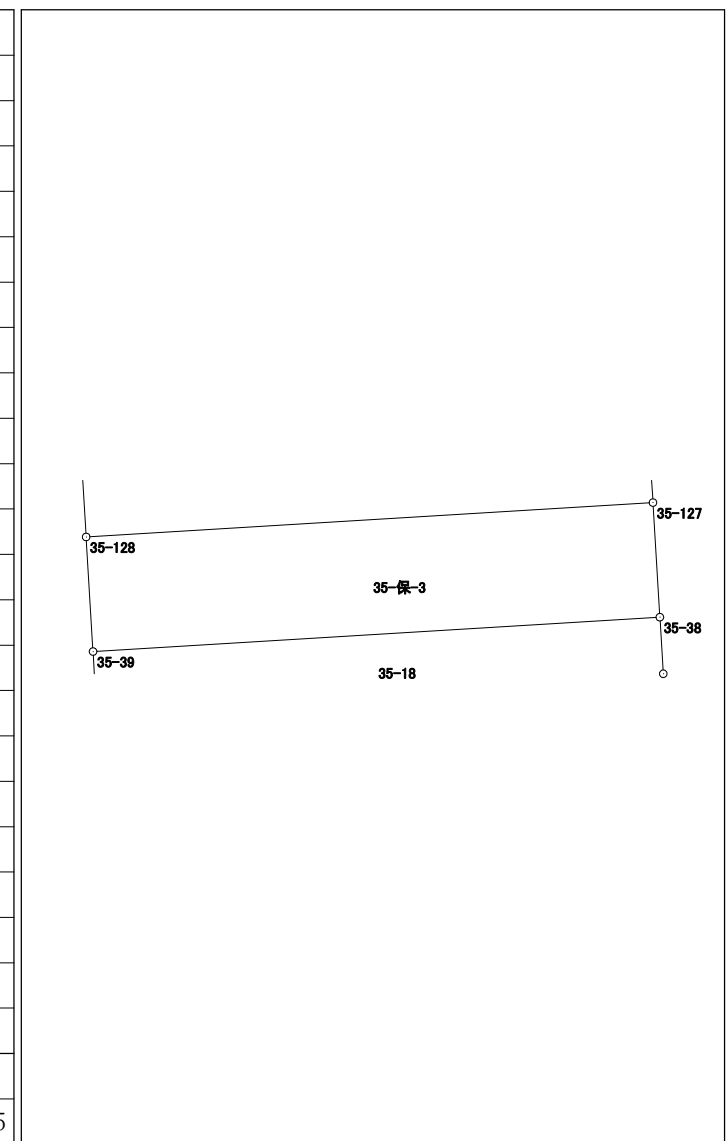


倍面積	246.001639
面積	123.0008195

面積計算書 (座標法)

世界測地系 (測地成果2011)

所 在	地 番	公簿地目	現況地目	地 積	所 有 者
前橋市六供町二丁目	35-保-4			5.00 m ²	

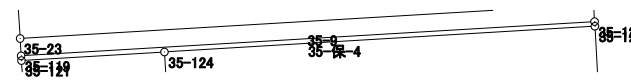点 名	X 座標	Y 座標	辺 長	方 向 角	測 角	DX	倍 積 (Y×DX)	
35-119	41368.166	-68247.060	0.203	176-37-01	90-02-10	-1.674	114245.578440	
35-121	41367.963	-68247.048	6.152	86-34-48	89-57-47	0.164	-11192.515872	
35-124	41368.330	-68240.907	18.512	86-34-41	179-59-53	1.472	-100450.615104	
35-122	41369.435	-68222.428	0.202	356-36-01	90-01-20	1.307	-89166.713396	
35-120	41369.637	-68222.440	24.664	266-34-51	89-58-50	-1.269	86574.276360	
						倍面積	10.010428	
						面 積	5.0052140	


面積計算書 (座標法)

世界測地系 (測地成果2011)

所 在	地 番	公簿地目	現況地目	地 積	所 有 者
前橋市六供町二丁目	35-保-5			87.00 m ²	

点 名	X 座標	Y 座標	辺 長	方 向 角	測 角	DX	倍 積 (Y×DX)
35-121	41367.963	-68247.048	13.572	176-31-55	89-57-07	-13.914	949589.425872
35-14	41354.416	-68246.227	6.257	97-06-21	100-34-26	-14.321	977354.216867
35-123	41353.642	-68240.018	14.715	356-32-11	79-25-50	13.914	-949491.610452
35-124	41368.330	-68240.907	6.152	266-34-48	90-02-37	14.321	-977278.029147

倍面積	174.003140
面 積	87.0015700

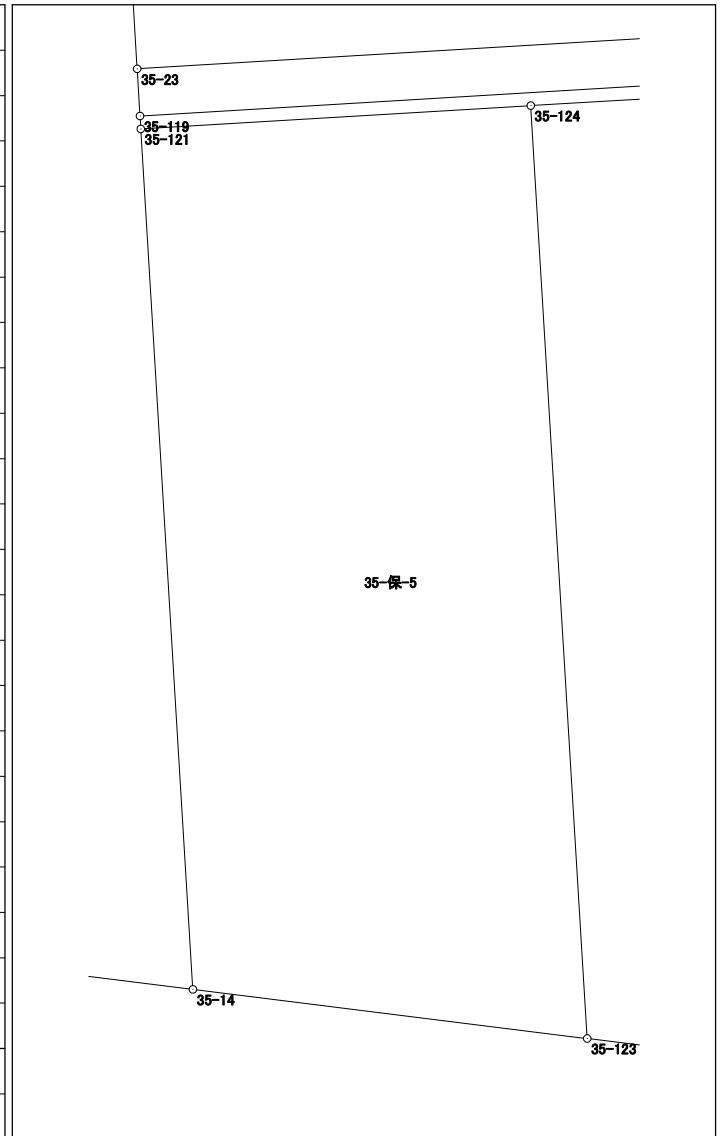


面積計算書 (座標法)

世界測地系 (測地成果2011)

所在	地番	公簿地目	現況地目	地積	所有者
前橋市六供町二丁目	35-保-6			12.00 m ²	

点名	X 座標	Y 座標	辺長	方向角	測角	DX	倍積 (Y×DX)
35-35	41366.518	-68273.603	1.388	266-31-45	90-02-08	8.680	-592614.874040
35-113	41366.434	-68274.988	8.522	176-29-18	89-57-33	-8.590	586482.146920
35-114	41357.928	-68274.466	1.411	97-05-05	100-35-47	-8.680	592622.364880
35-27	41357.754	-68273.066	8.780	356-29-37	79-24-32	8.590	-586465.636940

倍面積	24.000820
面積	12.0004100

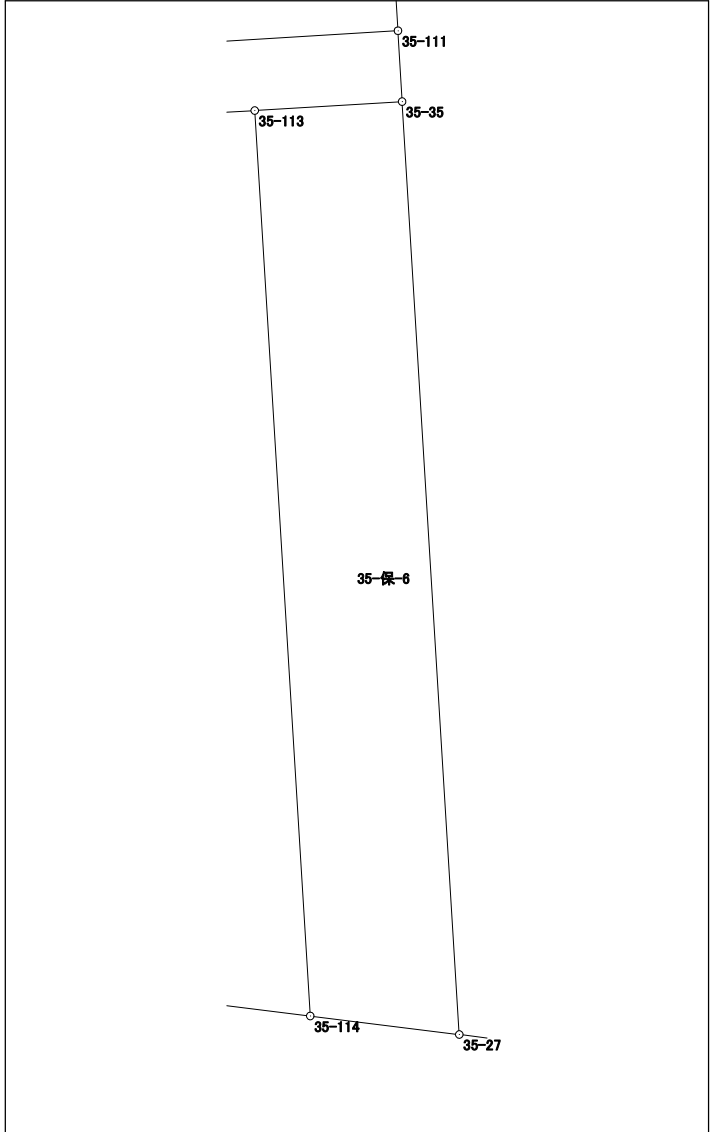


面積計算書（座標法）

世界測地系（測地成果2011）

所 在	地 番	公簿地目	現況地目	地 積	所 有 者
前橋市六供町二丁目	35-保-7			11.00 m ²	


点 名	X 座標	Y 座標	辺 長	方 向 角	測 角	D _X	倍 積 (Y×D _X)
35-115	41365.991	-68282.304	1.569	266-31-42	90-01-40	7.051	-481458.525504
35-117	41365.896	-68283.870	6.868	176-29-38	89-57-56	-6.950	474572.896500
35-118	41359.041	-68283.450	1.595	97-03-29	100-33-51	-7.051	481466.605950
35-116	41358.845	-68281.867	7.159	356-30-02	79-26-33	6.950	-474558.975650
						倍面積	22.001296
						面 積	11.0006480

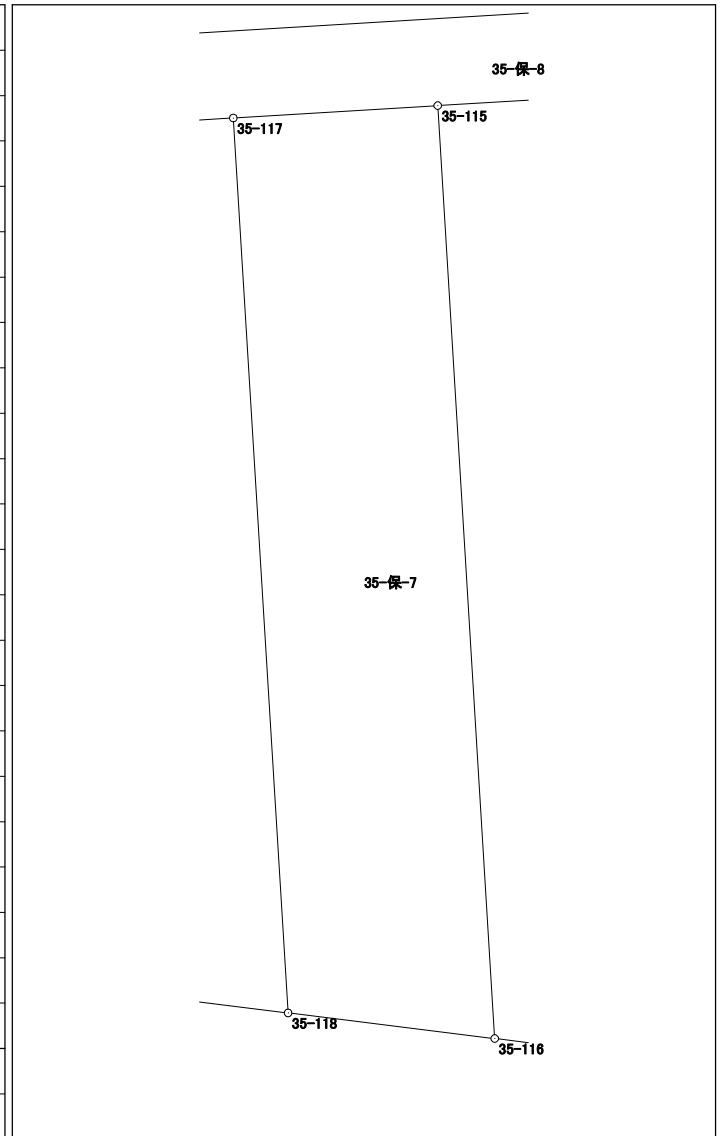

面積計算書（座標法）

世界測地系（測地成果2011）

所 在	地 番	公簿地目	現況地目	地 積	所 有 者
前橋市六供町二丁目	35-保-8			11.00 m ²	

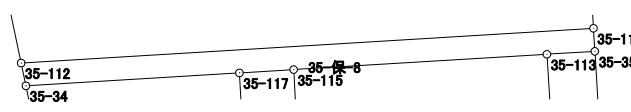点 名	X 座標	Y 座標	辺 長	方 向 角	測 角	DX	倍 積 (Y×DX)	
35-35	41366.518	-68273.603	0.667	356-38-55	90-07-10	0.750	-51205.202250	
35-111	41367.184	-68273.642	16.563	266-31-42	89-52-47	-0.337	23008.217354	
35-112	41366.181	-68290.175	0.673	168-15-22	81-43-40	-1.662	113498.270850	
35-34	41365.522	-68290.038	6.179	86-31-48	98-16-26	-0.285	19462.660830	
35-117	41365.896	-68283.870	1.569	86-31-42	179-59-54	0.469	-32025.135030	
35-115	41365.991	-68282.304	7.329	86-32-05	180-00-23	0.538	-36735.879552	
35-113	41366.434	-68274.988	1.388	86-31-45	179-59-40	0.527	-35980.918676	
						倍面積	22.013526	
						面 積	11.0067630	