


39街区 画地出来形確認図 (2447.49m²)



S=1/500

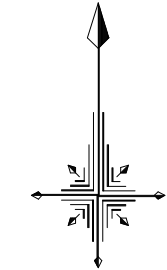


面積計算書 (座標法)

世界測地系 (測地成果2011)

所在	地番	公簿地目	現況地目	地積	所有者
前橋市六供町二丁目	39-1			143.62 m ²	

点名	X座標	Y座標	辺長	方向角	測角	DX	倍積 (Y×DX)
39-101	41469.026	-68421.025	9.804	348-48-50	90-05-36	12.503	-855468.075575
39-19	41478.644	-68422.927	11.956	260-09-57	91-21-07	7.576	-518372.094952
39-2	41476.602	-68434.707	3.994	214-22-43	134-12-46	-5.338	365304.465966
39-1	41473.306	-68436.962	7.315	168-23-26	134-00-43	-10.461	715919.059482
39-102	41466.141	-68435.490	14.750	78-43-14	90-19-48	-4.280	292903.897200

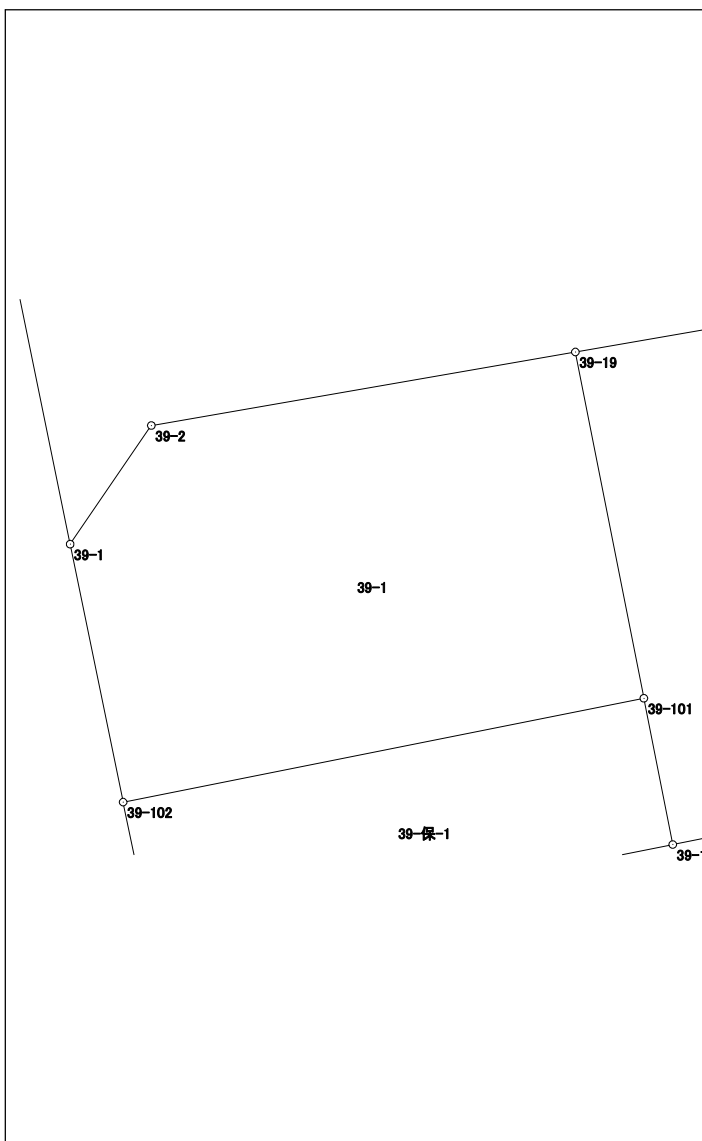


倍面積	287.252121
面積	143.6260605

面積計算書（座標法）

所 在	地 番	公簿地目	現況地目	地 積	所 有 者
前橋市六供町二丁目	39-2			134.11 m ²	

点 名	X 座標	Y 座標	辺 長	方 向 角	測 角	DX	倍 積 (Y×DX)
39-16	41466.878	-68410.596	13.706	347-52-42	89-07-27	15.314	-1047639.867144
39-113	41480.278	-68413.474	9.593	260-11-35	92-18-53	11.766	-804952.935084
39-19	41478.644	-68422.927	9.804	168-48-50	88-37-15	-11.252	769894.774604
39-101	41469.026	-68421.025	4.141	168-49-03	180-00-13	-13.680	935999.622000
39-18	41464.964	-68420.222	9.814	78-45-15	89-56-12	-2.148	146966.636856

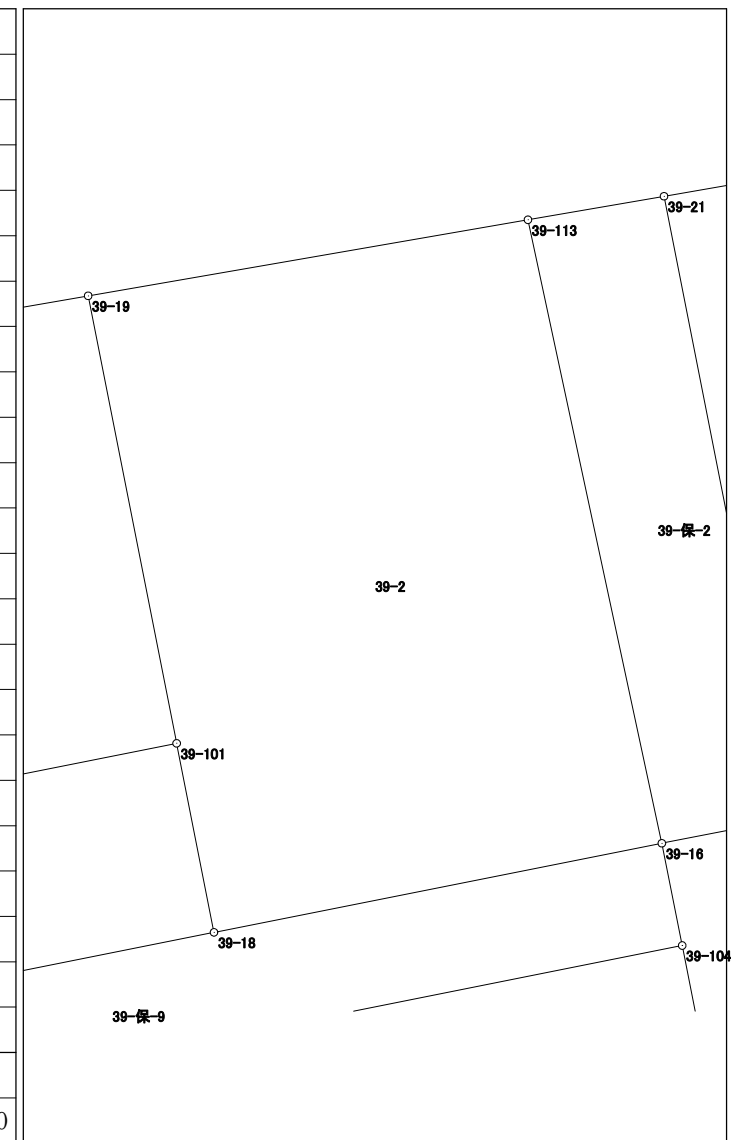


倍面積	268.231232
面 積	134.1156160

面積計算書（座標法）

世界測地系（測地成果2011）

所在	地番	公簿地目	現況地目	地積	所有者
前橋市六供町二丁目	39-3-1			291.88 m ²	

点名	X座標	Y座標	辺長	方向角	測角	Dx	倍積 (Y×Dx)
39-21	41480.783	-68410.549	12.892	168-50-11	88-40-26	-16.632	1137804.250968
39-30	41468.135	-68408.053	23.333	78-18-50	89-28-39	-7.922	541928.595866
39-31	41472.861	-68385.204	12.140	348-44-31	90-25-41	16.632	-1137382.712928
39-3	41484.767	-68387.574	23.318	260-09-45	91-25-14	7.922	-541766.361228

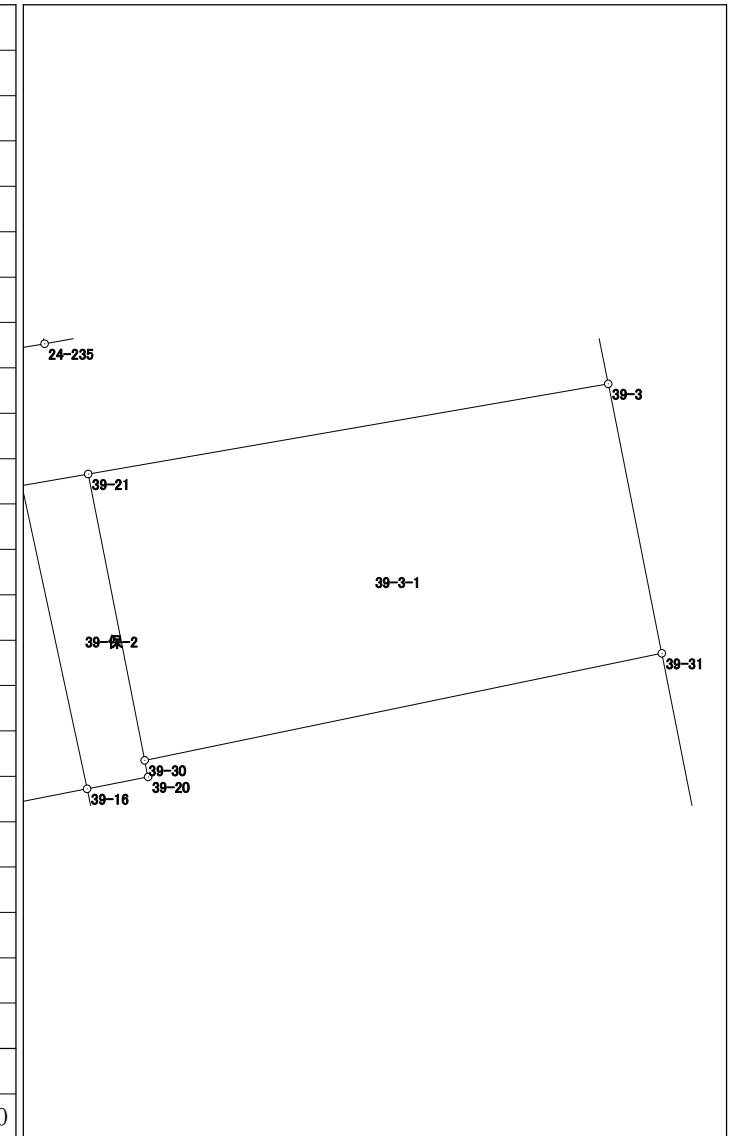


面積計算書（座標法）

世界測地系（測地成果2011）

所在	地番	公簿地目	現況地目	地積	所有者
前橋市六供町二丁目	39-3-2			456.61 m ²	

点名	X 座標	Y 座標	辺長	方向角	測角	DX	倍積 (Y×DX)
39-116	41455.513	-68381.754	17.688	348-45-08	90-01-12	22.443	-1534691.705022
39-31	41472.861	-68385.204	23.333	258-18-50	89-33-42	12.622	-863158.044888
39-30	41468.135	-68408.053	0.749	168-12-36	89-53-46	-5.459	373439.561327
39-20	41467.402	-68407.900	2.746	259-00-04	270-47-28	-1.257	85988.730300
39-16	41466.878	-68410.596	2.240	168-43-31	89-43-27	-2.721	186145.231716
39-104	41464.681	-68410.158	10.496	168-43-31	180-00-00	-12.490	854442.873420
39-14	41454.388	-68408.106	1.759	168-55-12	180-11-41	-12.019	822197.026014
39-106	41452.662	-68407.768	2.287	168-52-54	179-57-42	-3.970	271578.838960
39-117	41450.418	-68407.327	26.076	78-43-56	89-51-02	2.851	-195029.289277

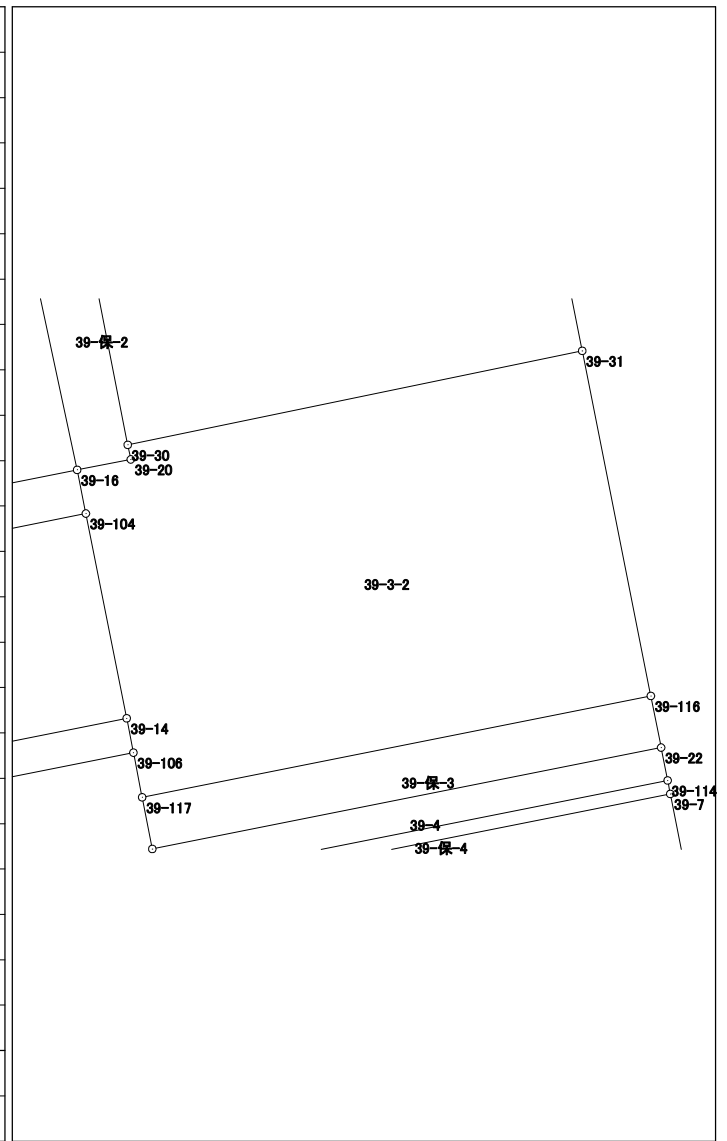


倍面積	913.222550
面積	456.6112750

面積計算書 (座標法)

世界測地系 (測地成果2011)

所 在	地 番	公簿地目	現況地目	地 積	所 有 者
前橋市六供町二丁目	39-5			171.35 m ²	

点 名	X 座標	Y 座標	辺 長	方 向 角	測 角	DX	倍 積 (Y×DX)
39-111	41443.726	-68397.433	9.684	168-45-47	89-28-19	-12.784	874392.783472
39-10	41434.228	-68395.546	17.707	79-17-32	90-31-45	-6.208	424599.549568
39-4	41437.518	-68378.147	9.684	348-37-30	89-19-58	12.784	-874146.231248
39-112	41447.012	-68380.057	17.684	259-17-28	90-39-58	6.208	-424503.393856
						倍面積	342.707936
						面 積	171.3539680

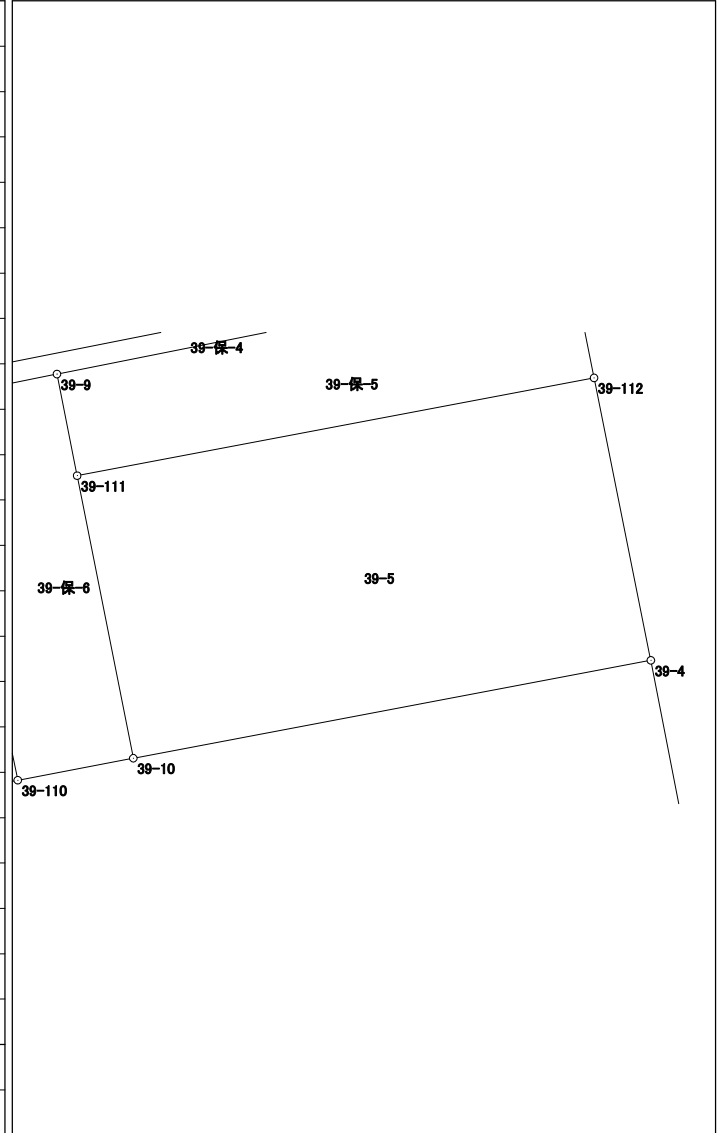


面積計算書 (座標法)

世界測地系 (測地成果2011)

所 在	地 番	公簿地目	現況地目	地 積	所 有 者
前橋市六供町二丁目	39-6			150.15 m ²	

点 名	X 座標	Y 座標	辺 長	方 向 角	測 角	DX	倍 積 (Y×DX)
39-109	41446.370	-68401.991	4.443	258-46-25	90-00-48	12.017	-821986.725847
39-13	41445.505	-68406.349	7.030	258-48-13	180-01-48	-2.230	152546.158270
39-11	41444.140	-68413.245	13.047	168-44-49	89-56-36	-14.161	968799.962445
39-12	41431.344	-68410.699	11.470	79-13-37	90-28-48	-10.652	728710.765748
39-110	41433.488	-68399.431	13.134	348-45-37	89-32-00	15.026	-1027769.850206

倍面積	300.310410
面 積	150.1552050

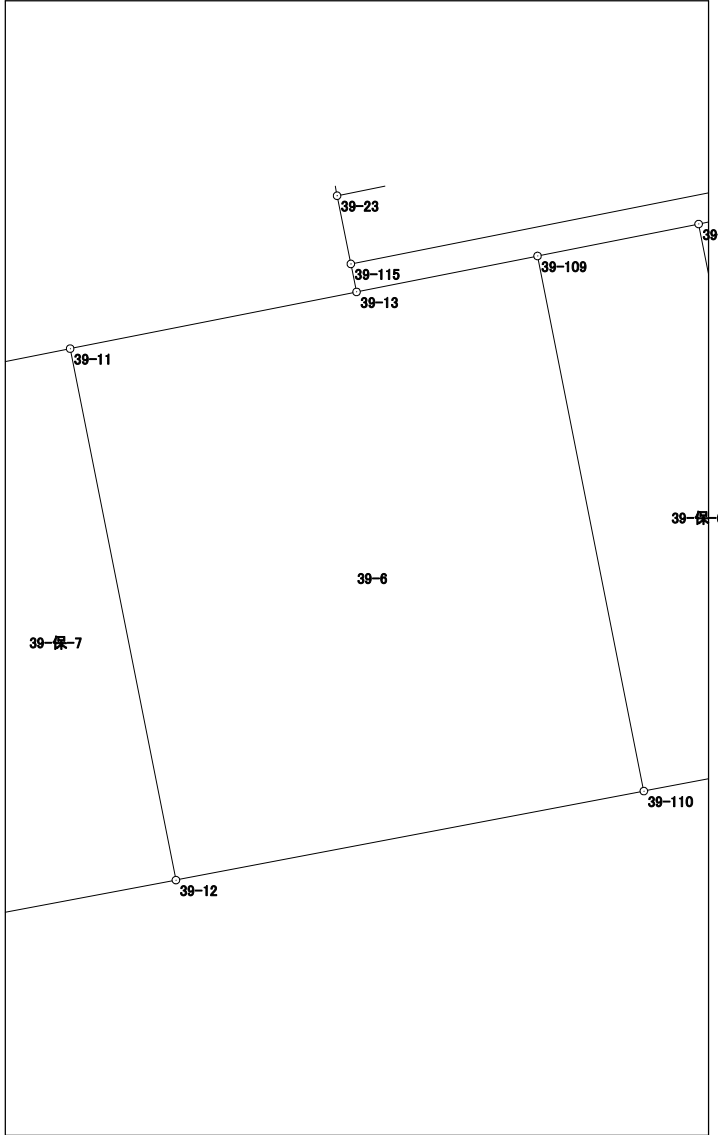


面積計算書 (座標法)

世界測地系 (測地成果2011)

所在	地番	公簿地目	現況地目	地積	所有者
前橋市六供町二丁目	39-保-6			52.00 m ²	

点名	X座標	Y座標	辺長	方向角	測角	DX	倍積 (Y×DX)
39-9	41447.140	-68398.112	3.955	258-46-21	90-01-16	2.644	-180844.608128
39-109	41446.370	-68401.991	13.134	168-45-37	89-59-16	-13.652	933823.981132
39-110	41433.488	-68399.431	3.955	79-12-57	90-27-20	-12.142	830505.891202
39-10	41434.228	-68395.546	9.684	348-45-47	89-32-50	10.238	-700233.599948
39-111	41443.726	-68397.433	3.481	348-45-05	179-59-18	12.912	-883147.654896
						倍面積	104.009362
						面積	52.0046810

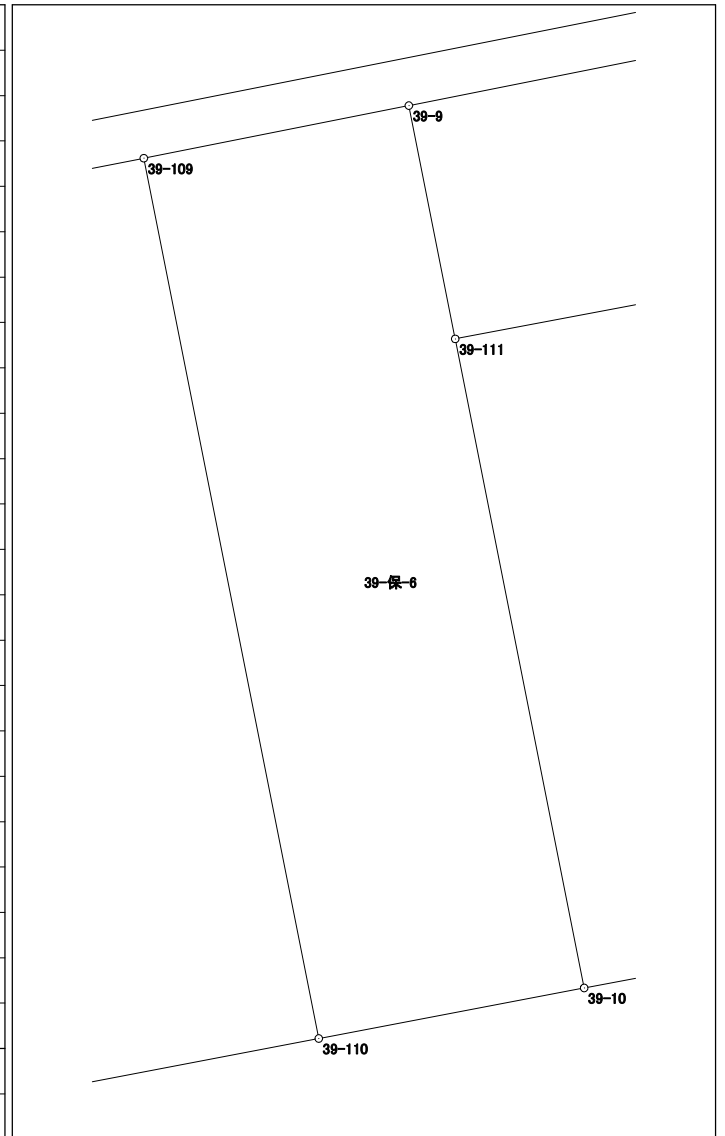


面積計算書（座標法）

世界測地系（測地成果2011）

所 在	地 番	公簿地目	現況地目	地 積	所 有 者
前橋市六供町二丁目	39-保-7			60.00 m ²	

点 名	X 座標	Y 座標	辺 長	方 向 角	測 角	DX	倍 積 (Y×DX)
39-11	41444.140	-68413.245	4.606	258-46-14	90-01-25	11.899	-814049.202255
39-107	41443.243	-68417.763	13.005	168-45-02	89-58-48	-13.652	934039.300476
39-108	41430.488	-68415.226	4.607	79-17-33	90-32-31	-11.899	814072.774174
39-12	41431.344	-68410.699	13.047	348-44-49	89-27-16	13.652	-933942.862748
						倍面積	120.009647
						面 積	60.0048235

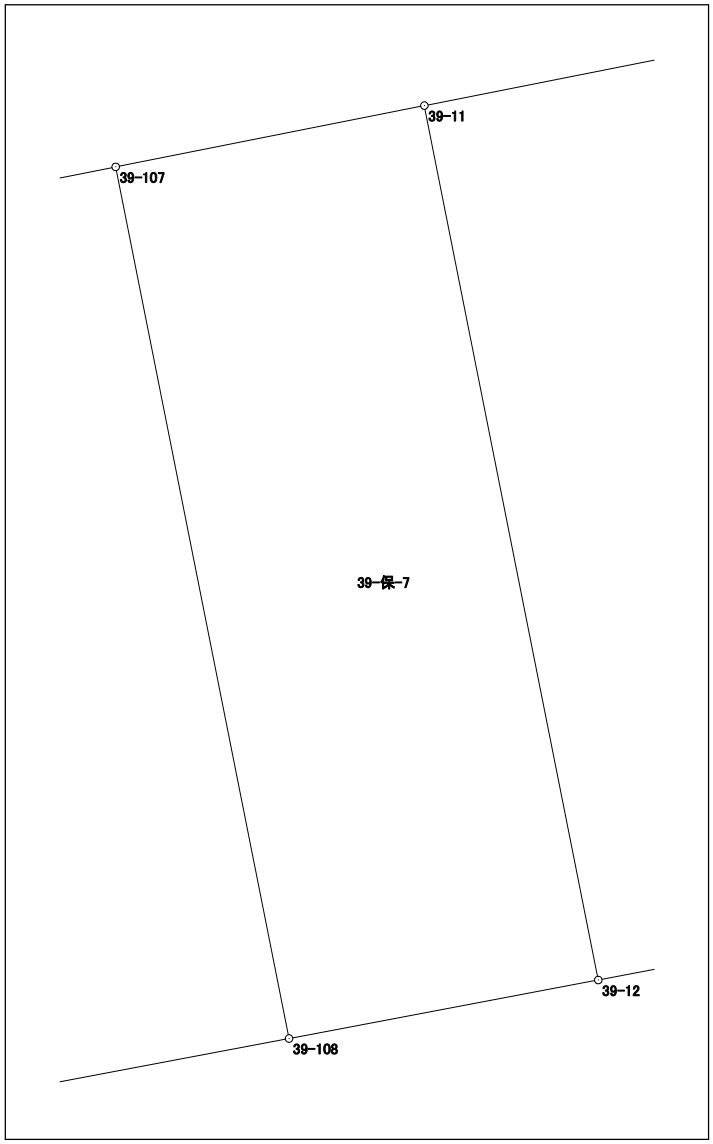


面積計算書（座標法）

世界測地系（測地成果2011）

所 在	地 番	公簿地目	現況地目	地 積	所 有 者
前橋市六供町二丁目	39-保-8			43.00 m ²	

点 名	X 座標	Y 座標	辺 長	方 向 角	測 角	DX	倍 積 (Y×DX)
39-15	41449.608	-68432.098	1.758	168-29-08	89-45-12	-6.503	445013.933294
39-105	41447.885	-68431.747	24.450	78-44-00	90-14-52	3.054	-208990.555338
39-106	41452.662	-68407.768	1.759	348-55-12	90-11-12	6.503	-444855.715304
39-14	41454.388	-68408.106	24.464	258-43-56	89-48-44	-3.054	208918.355724
						倍面積	86.018376
						面 積	43.0091880

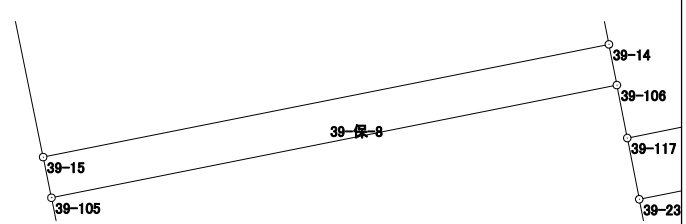


面積計算書 (座標法)

世界測地系 (測地成果2011)

所在	地番	公簿地目	現況地目	地積	所有者
前橋市六供町二丁目	39-保-9			55.00 m ²	

点名	X座標	Y座標	辺長	方向角	測角	DX	倍積 (Y×DX)
39-18	41464.964	-68420.222	14.718	258-43-25	179-58-10	-4.792	327869.703824
39-17	41462.086	-68434.656	2.242	168-25-10	89-41-45	-5.074	347237.444544
39-103	41459.890	-68434.206	24.521	78-43-58	90-18-48	2.595	-177586.764570
39-104	41464.681	-68410.158	2.240	348-43-31	89-59-33	6.988	-478050.184104
39-16	41466.878	-68410.596	9.814	258-45-15	90-01-44	0.283	-19360.198668

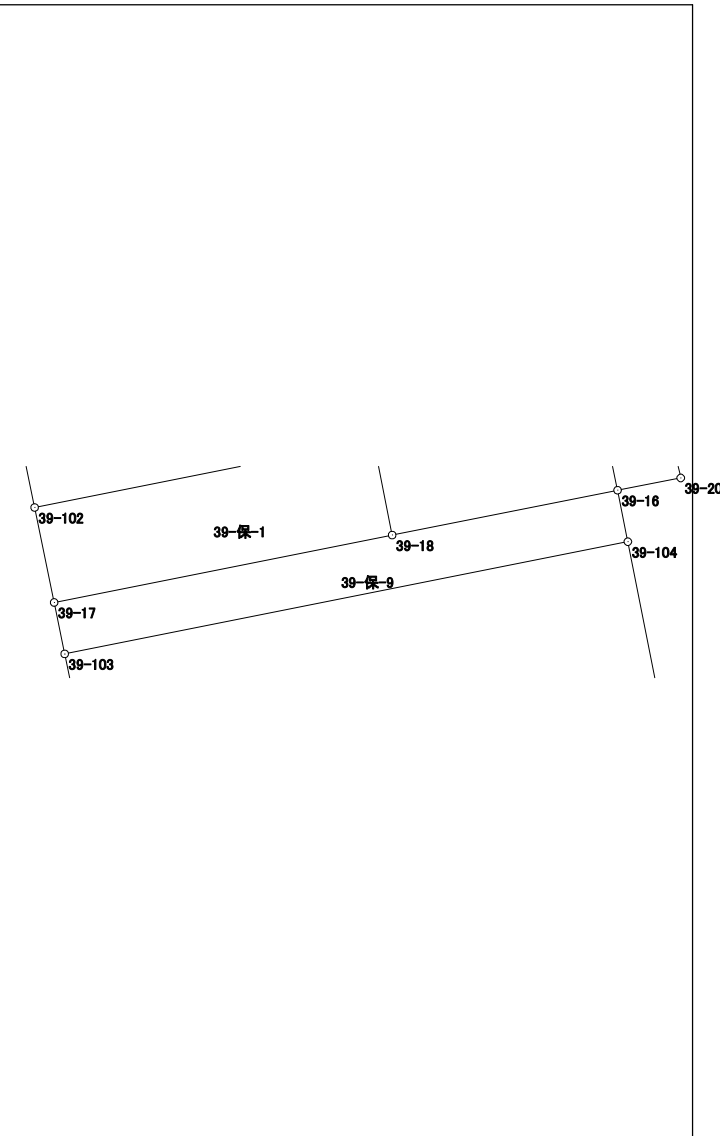

倍面積	110.001026
面積	55.0005130