


3-1 街区  
3-2 街区


# 画地出来形確認図

(795.01㎡)  
(652.82㎡)

(拡大図)

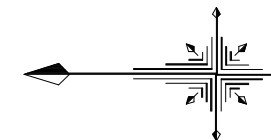

S=1/250

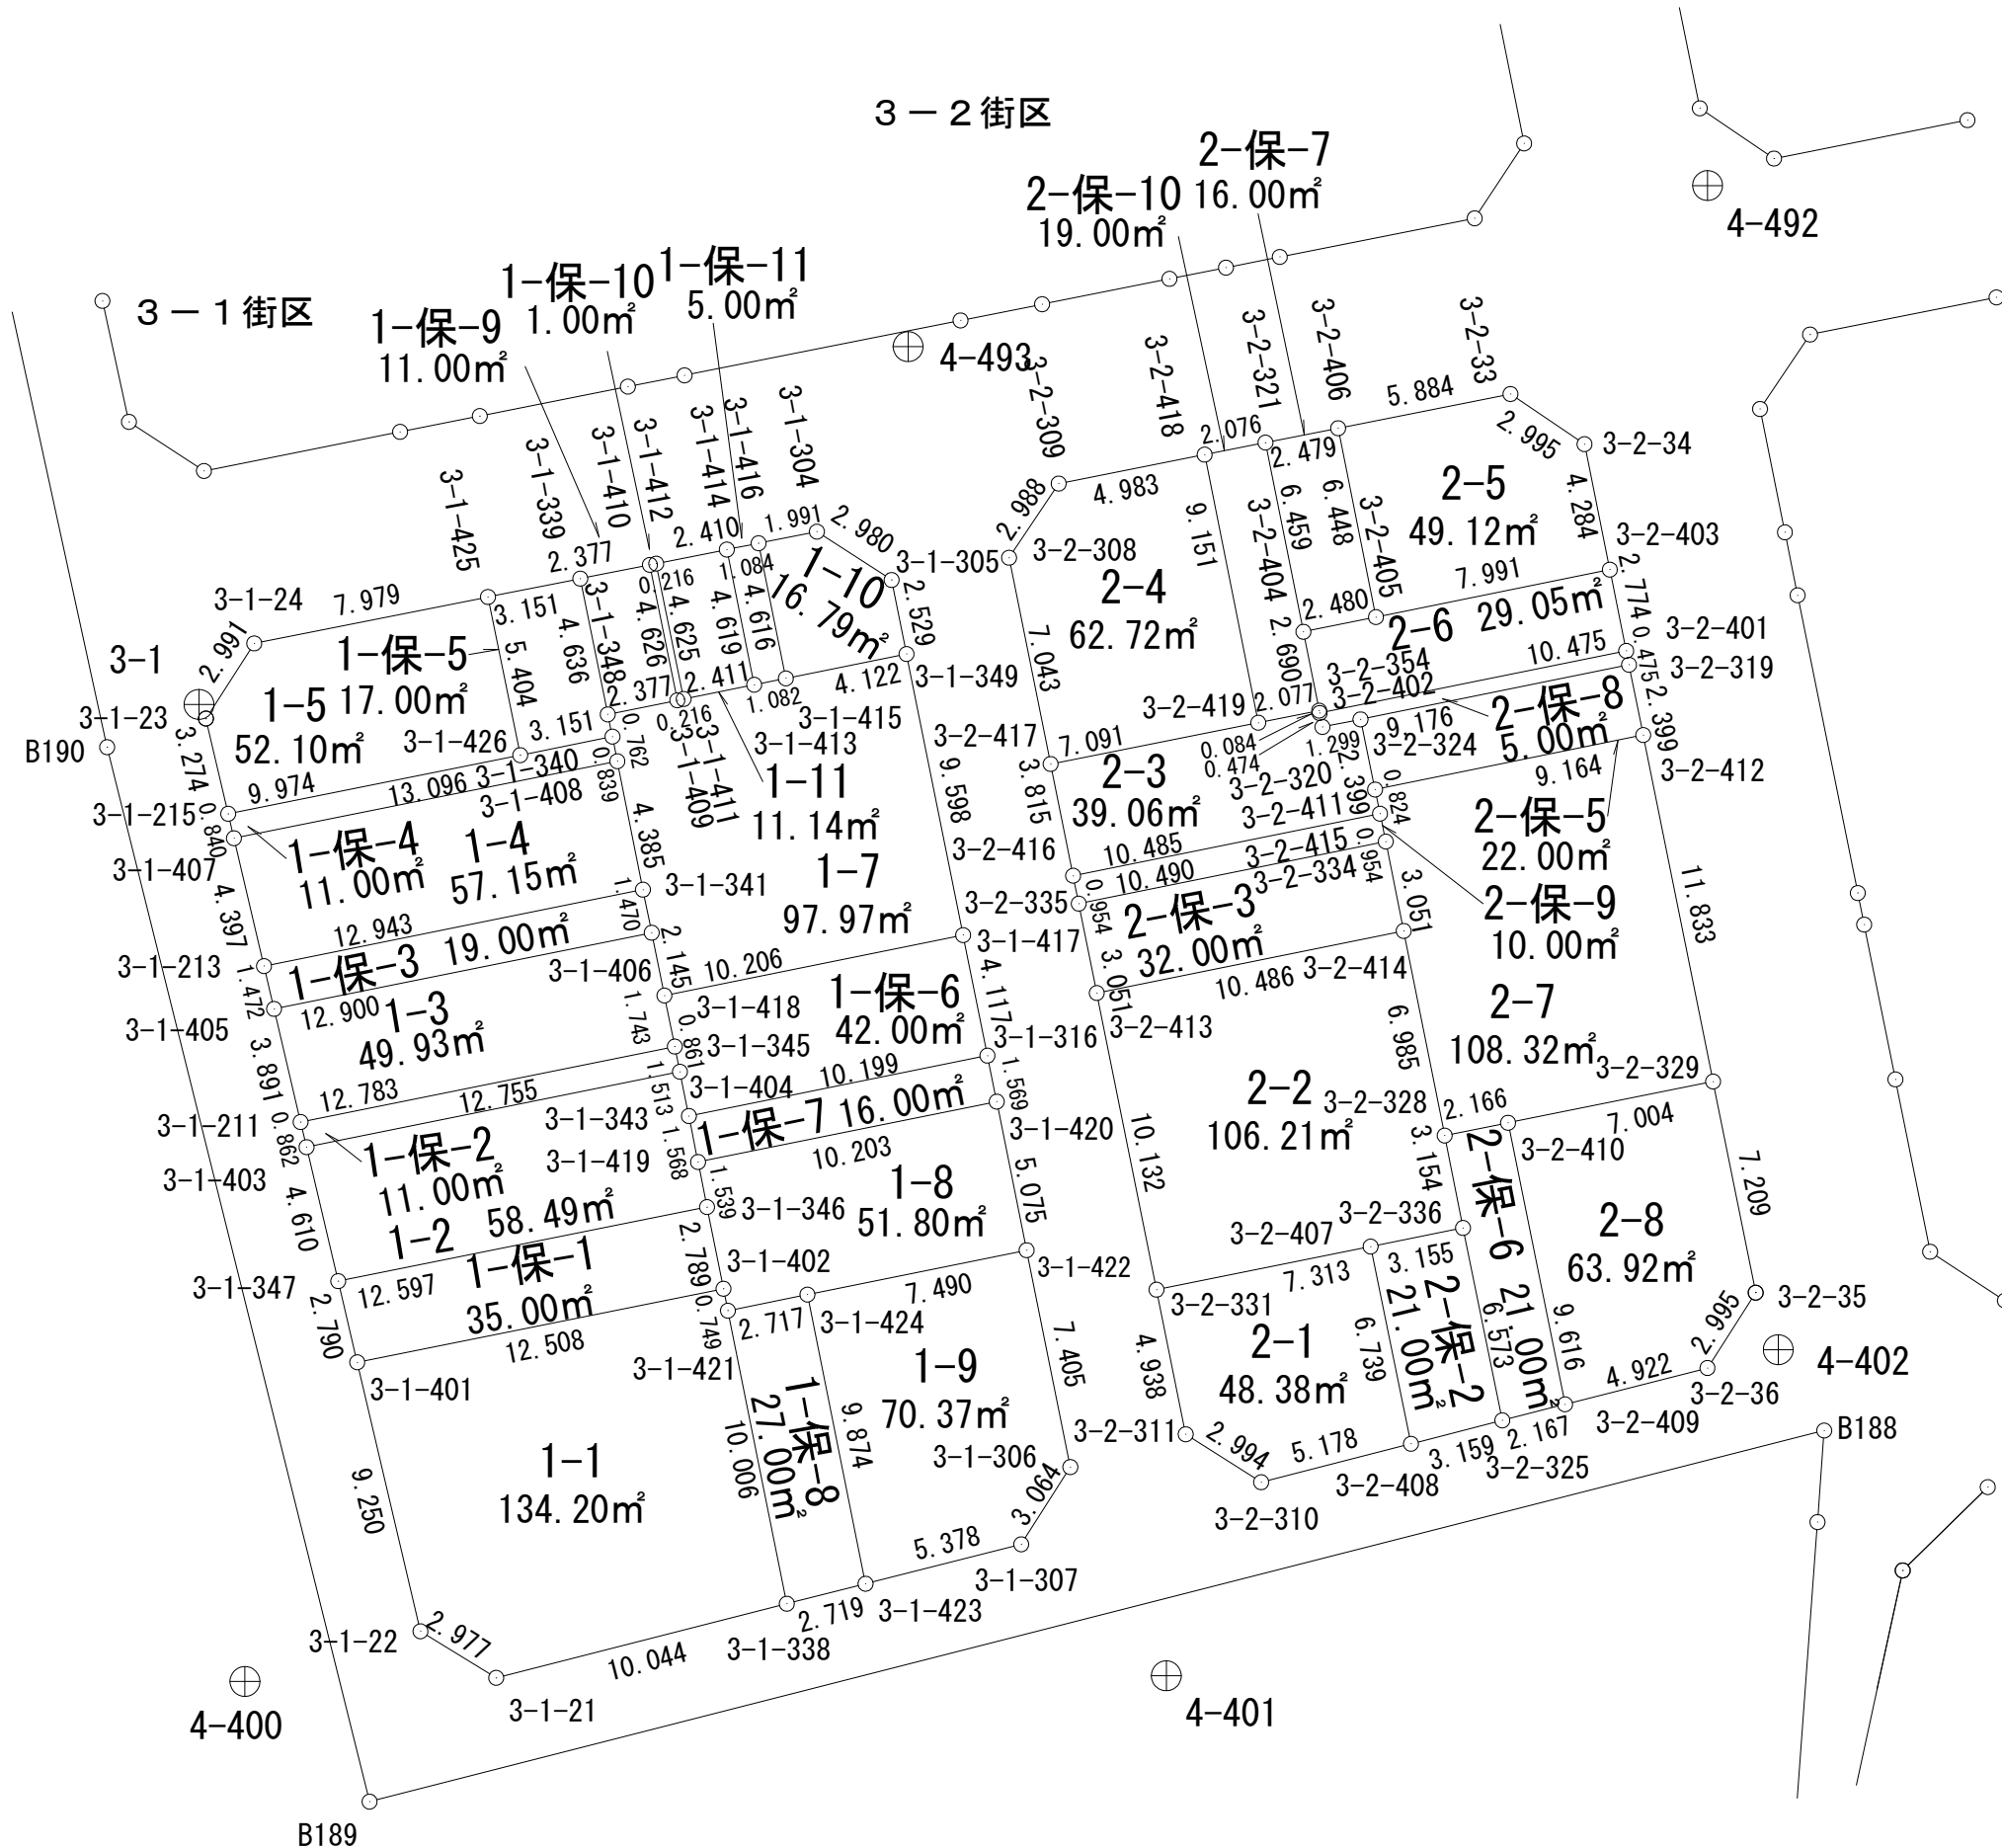


# 面積計算書 (座標法)

世界測地系 (測地成果2011)

所在	地番	公簿地目	現況地目	地積	所有者
前橋市六供町一丁目	3-1-1			134.20 m <sup>2</sup>	

点名	X座標	Y座標	辺長	方向角	測角	DX	倍積 (Y×DX)
3-1-401	41894.052	-68514.051	9.250	256-46-09	88-07-01	10.146	-695143.561446
3-1-22	41891.935	-68523.055	2.977	211-36-27	134-50-18	-4.652	318769.251860
3-1-21	41889.400	-68524.615	10.044	165-41-38	134-05-11	-12.268	840659.976820
3-1-338	41879.667	-68522.133	10.006	78-37-18	92-55-40	-7.759	531663.229947
3-1-421	41881.641	-68512.324	0.749	78-36-00	179-58-42	2.122	-145383.151528
3-1-402	41881.789	-68511.590	12.508	348-39-08	90-03-08	12.411	-850297.343490
						倍面積	268.402163
						面積	134.2010815

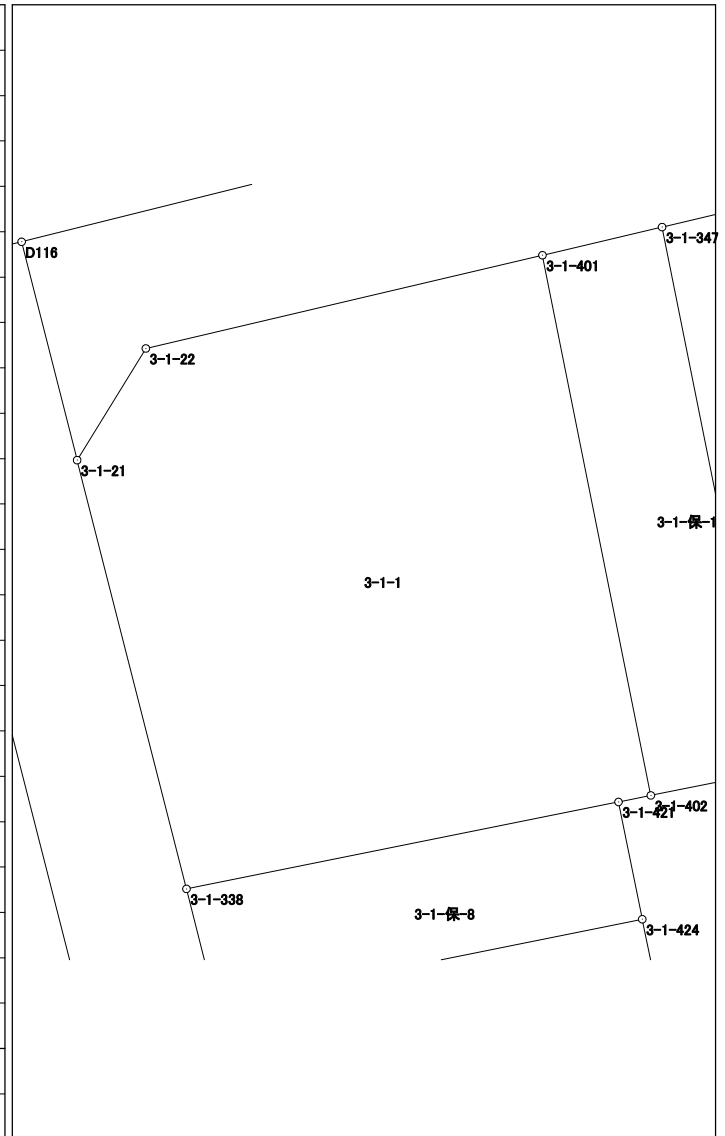


# 面積計算書 (座標法)

世界測地系 (測地成果2011)

所 在	地 番	公簿地目	現況地目	地 積	所 有 者
前橋市六供町一丁目	3-1-2			58.49 m <sup>2</sup>	

点 名	X 座標	Y 座標	辺 長	方 向 角	測 角	DX	倍 積 (Y×DX)
3-1-403	41895.751	-68506.849	4.610	256-41-36	88-06-07	11.442	-783855.366258
3-1-347	41894.690	-68511.335	12.597	168-39-03	91-57-27	-13.412	918874.025020
3-1-346	41882.339	-68508.856	1.539	78-43-09	90-04-06	-12.050	825531.714800
3-1-419	41882.640	-68507.347	1.568	78-42-42	179-59-33	0.608	-41652.466976
3-1-343	41882.947	-68505.809	1.513	78-31-36	179-48-54	0.608	-41651.531872
3-1-404	41883.248	-68504.326	12.755	348-35-29	90-03-53	12.804	-877129.390104
						倍面積	116.984610
						面 積	58.4923050

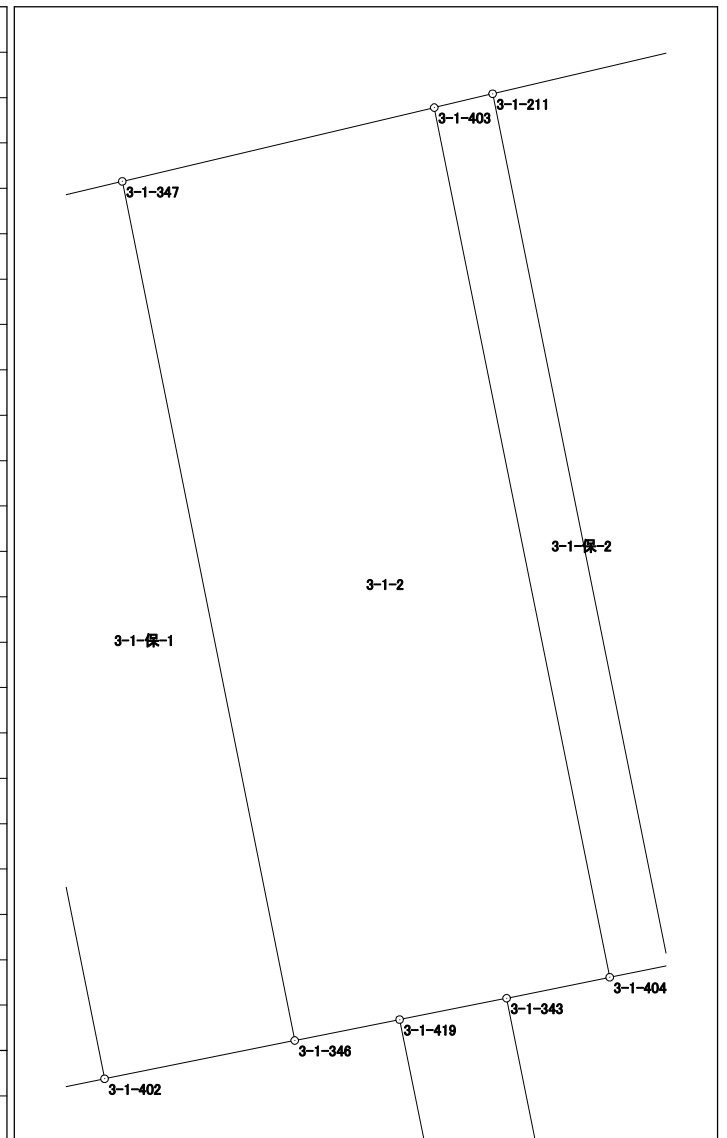


# 面積計算書 (座標法)

世界測地系 (測地成果2011)

所在	地番	公簿地目	現況地目	地積	所有者
前橋市六供町一丁目	3-1-3			49.93 m <sup>2</sup>	

点名	X座標	Y座標	辺長	方向角	測角	DX	倍積 (Y×DX)
3-1-405	41896.838	-68502.222	3.891	256-48-24	88-12-29	11.757	-805380.624054
3-1-211	41895.950	-68506.010	12.783	168-35-39	91-47-15	-13.419	919282.148190
3-1-345	41883.419	-68503.482	1.743	78-30-58	89-55-19	-12.184	834646.424688
3-1-418	41883.766	-68501.774	2.145	78-31-02	180-00-04	0.774	-53020.373076
3-1-406	41884.193	-68499.672	12.900	348-35-55	90-04-53	13.072	-895427.712384
						倍面積	99.863364
						面積	49.9316820

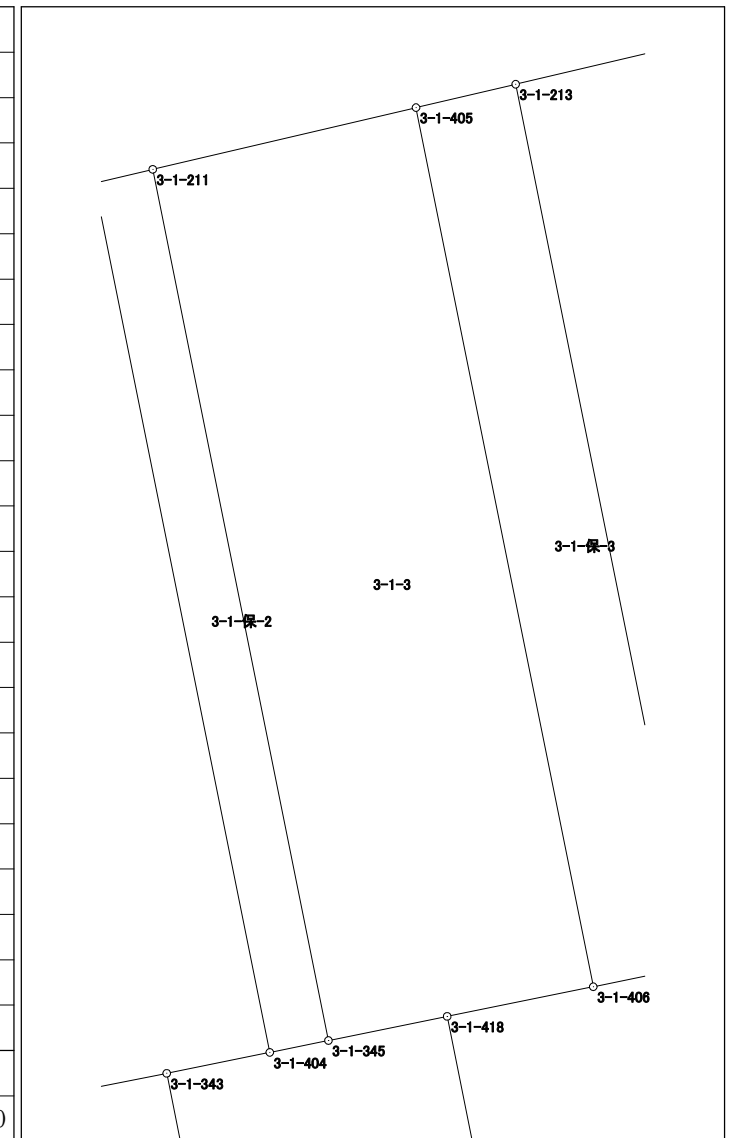


# 面積計算書 (座標法)

世界測地系 (測地成果2011)

所在	地番	公簿地目	現況地目	地積	所有者
前橋市六供町一丁目	3-1-4			57.15 m <sup>2</sup>	

点名	X座標	Y座標	辺長	方向角	測角	DX	倍積 (Y×DX)
3-1-407	41898.182	-68496.509	4.397	256-44-51	88-06-17	11.832	-810450.694488
3-1-213	41897.174	-68500.789	12.943	168-36-05	91-51-14	-13.696	938186.806144
3-1-341	41884.486	-68498.231	4.385	78-44-38	90-08-33	-11.832	810471.069192
3-1-408	41885.342	-68493.930	13.096	348-38-34	89-53-56	13.696	-938092.865280
倍面積						114.315568	
面積						57.1577840	

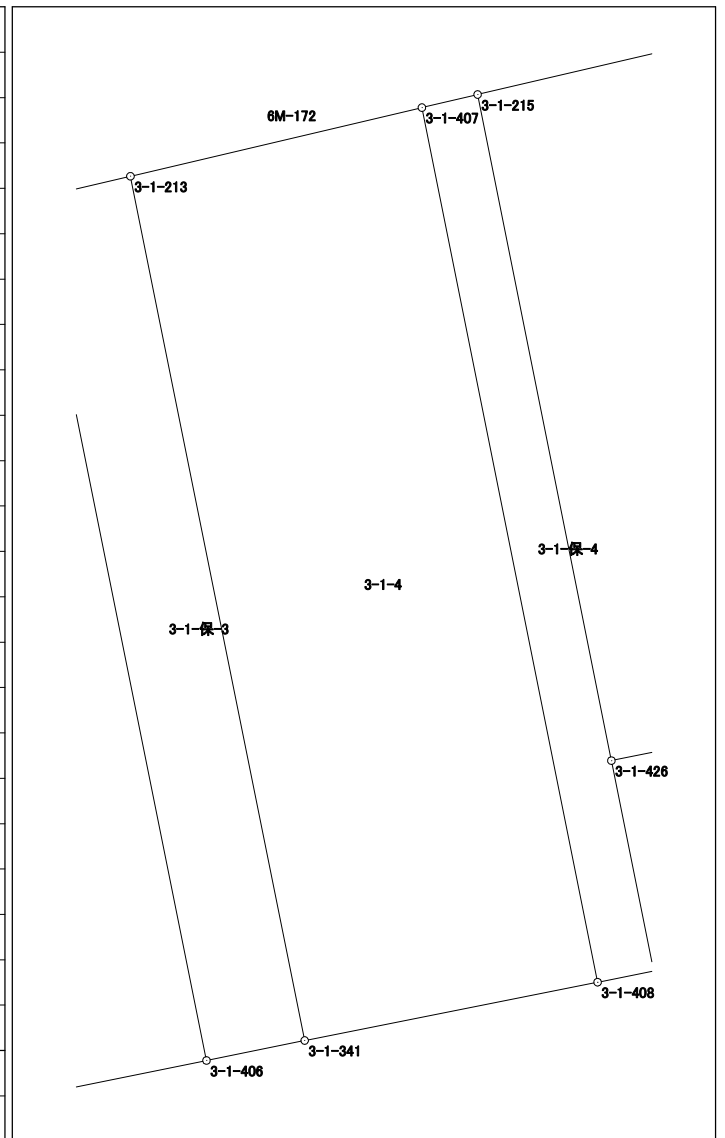


# 面積計算書 (座標法)

世界測地系 (測地成果2011)

所在	地番	公簿地目	現況地目	地積	所有者
前橋市六供町一丁目	3-1-5			52.10 m <sup>2</sup>	

点名	X座標	Y座標	辺長	方向角	測角	DX	倍積 (Y×DX)
3-1-425	41889.676	-68488.432	7.979	348-45-43	90-18-02	8.907	-610026.463824
3-1-24	41897.502	-68489.987	2.991	302-43-42	133-57-59	9.443	-646750.947241
3-1-23	41899.119	-68492.503	3.274	256-50-48	134-07-06	0.872	-59725.462616
3-1-215	41898.374	-68495.691	9.974	168-38-38	91-47-50	-10.524	720848.652084
3-1-426	41888.595	-68493.727	5.404	78-27-41	89-49-03	-8.698	595758.437446

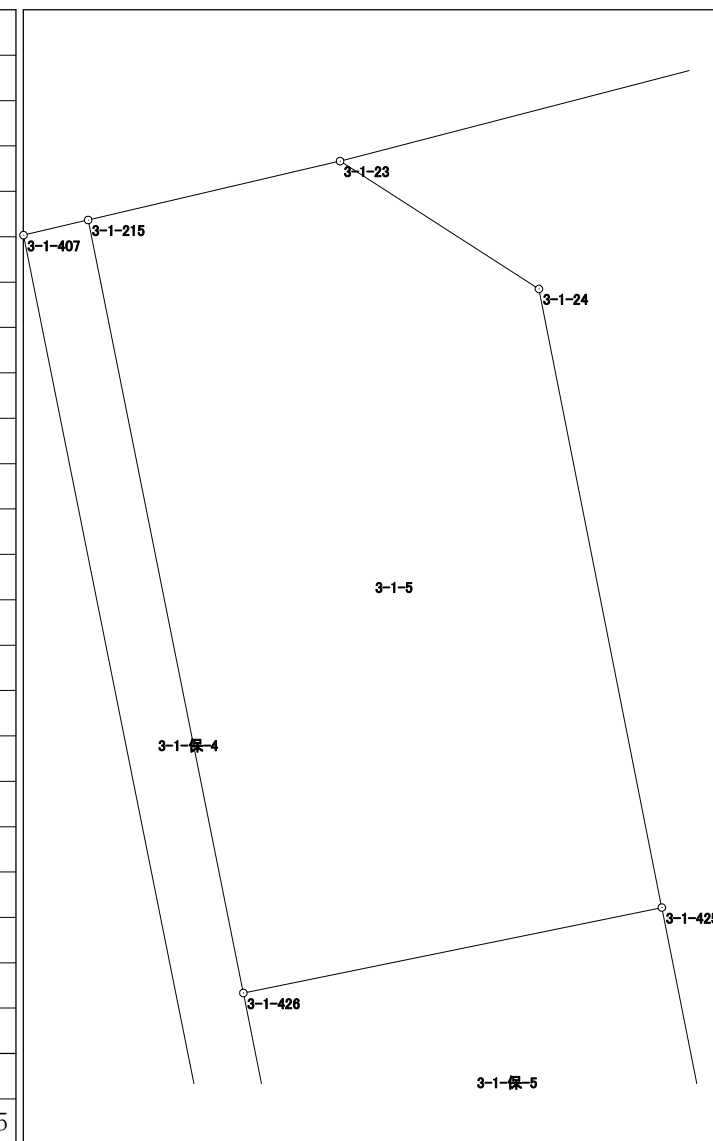


倍面積	104.215849
面積	52.1079245

# 面積計算書（座標法）

世界測地系（測地成果2011）

所在	地番	公簿地目	現況地目	地積	所有者
前橋市六供町一丁目	3-1-7			97.97 m <sup>2</sup>	

点名	X座標	Y座標	辺長	方向角	測角	D <sub>X</sub>	倍積 (Y×DX)
3-1-417	41873.763	-68499.751	9.598	78-36-25	90-02-25	-8.107	555327.481357
3-1-349	41875.659	-68490.342	4.122	348-34-52	89-58-27	5.936	-406558.670112
3-1-415	41879.699	-68491.158	1.082	348-35-48	180-00-56	5.101	-349373.396958
3-1-413	41880.760	-68491.372	2.411	348-35-15	179-59-27	3.424	-234514.457728
3-1-411	41883.123	-68491.849	0.216	348-32-03	179-56-48	2.575	-176366.511175
3-1-409	41883.335	-68491.892	2.377	348-35-44	180-03-41	2.542	-174106.389464
3-1-348	41885.665	-68492.362	0.762	257-57-09	89-21-25	2.171	-148696.917902
3-1-340	41885.506	-68493.107	0.839	258-43-49	180-46-40	-0.323	22123.273561
3-1-408	41885.342	-68493.930	4.385	258-44-38	180-00-49	-1.020	69863.808600
3-1-341	41884.486	-68498.231	1.470	258-30-24	179-45-46	-1.149	78704.467419
3-1-406	41884.193	-68499.672	2.145	258-31-02	180-00-38	-0.720	49319.763840
3-1-418	41883.766	-68501.774	10.206	168-34-00	90-02-58	-10.430	714473.502820
						倍面積	195.954258
						面積	97.9771290

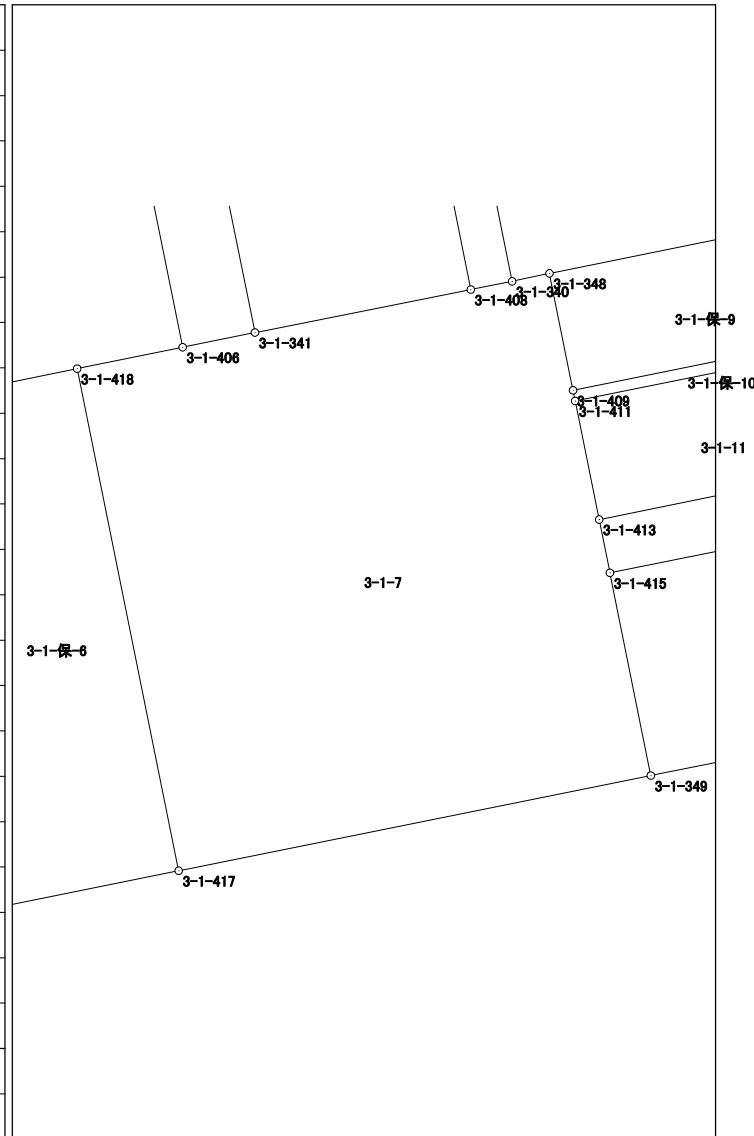


# 面積計算書（座標法）

世界測地系（測地成果2011）

所 在	地 番	公簿地目	現況地目	地 積	所 有 者
前橋市六供町一丁目	3-1-8			51.80 m <sup>2</sup>	

点 名	X 座標	Y 座標	辺 長	方 向 角	測 角	DX	倍 積 (Y×DX)
3-1-420	41872.639	-68505.325	10.203	348-34-12	89-57-27	11.003	-753764.090975
3-1-419	41882.640	-68507.347	1.539	258-43-09	90-08-57	9.700	-664521.265900
3-1-346	41882.339	-68508.856	2.789	258-37-32	179-54-23	-0.851	58301.036456
3-1-402	41881.789	-68511.590	0.749	258-36-00	179-58-28	-0.698	47821.089820
3-1-421	41881.641	-68512.324	2.717	168-33-28	89-57-28	-2.811	192588.142764
3-1-424	41878.978	-68511.785	7.490	168-33-51	180-00-23	-10.004	685391.897140
3-1-422	41871.637	-68510.300	5.075	78-36-45	90-02-54	-6.339	434286.791700
						倍面積	103.601005
						面 積	51.8005025

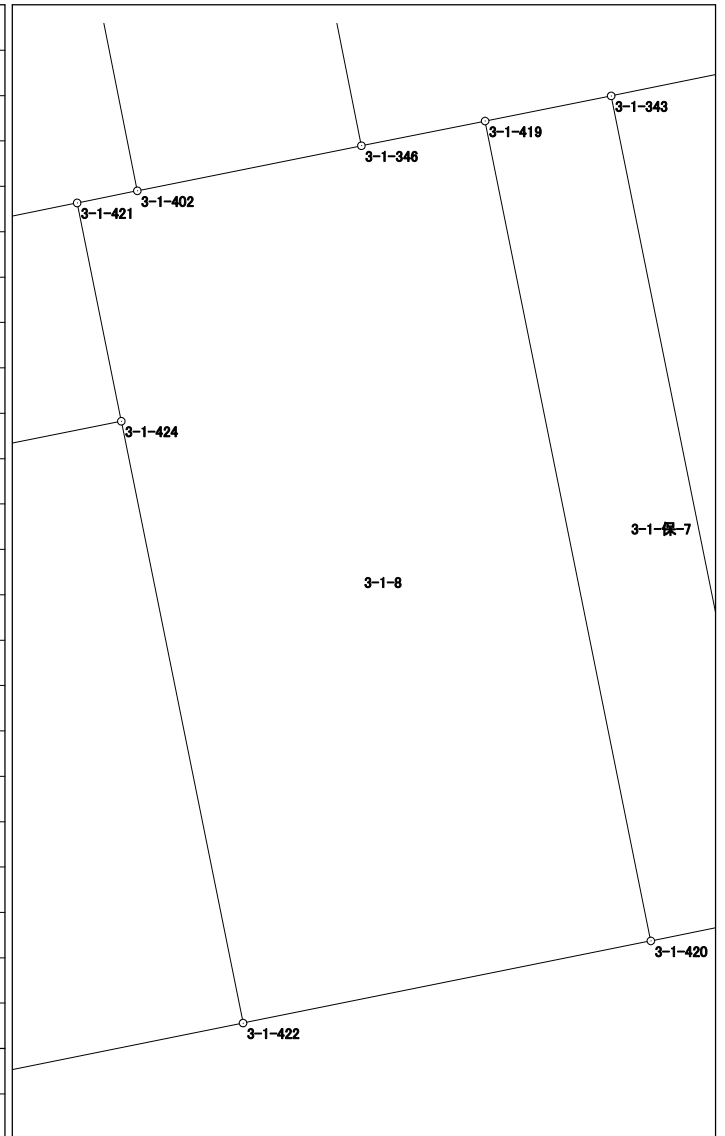




# 面積計算書 (座標法)

世界測地系 (測地成果2011)

所在	地番	公簿地目	現況地目	地積	所有者
前橋市六供町一丁目	3-1-9			70.37 m <sup>2</sup>	

点名	X座標	Y座標	辺長	方向角	測角	DX	倍積 (Y×DX)
3-1-423	41877.031	-68521.465	5.378	165-46-49	87-09-10	-7.160	490613.689400
3-1-307	41871.818	-68520.144	3.064	122-28-16	136-41-27	-6.858	469911.147552
3-1-306	41870.173	-68517.559	7.405	78-35-51	136-07-35	-0.181	12401.678179
3-1-422	41871.637	-68510.300	7.490	348-33-51	89-58-00	8.805	-603233.191500
3-1-424	41878.978	-68511.785	9.874	258-37-39	90-03-48	5.394	-369552.568290
						倍面積	140.755341
						面積	70.3776705

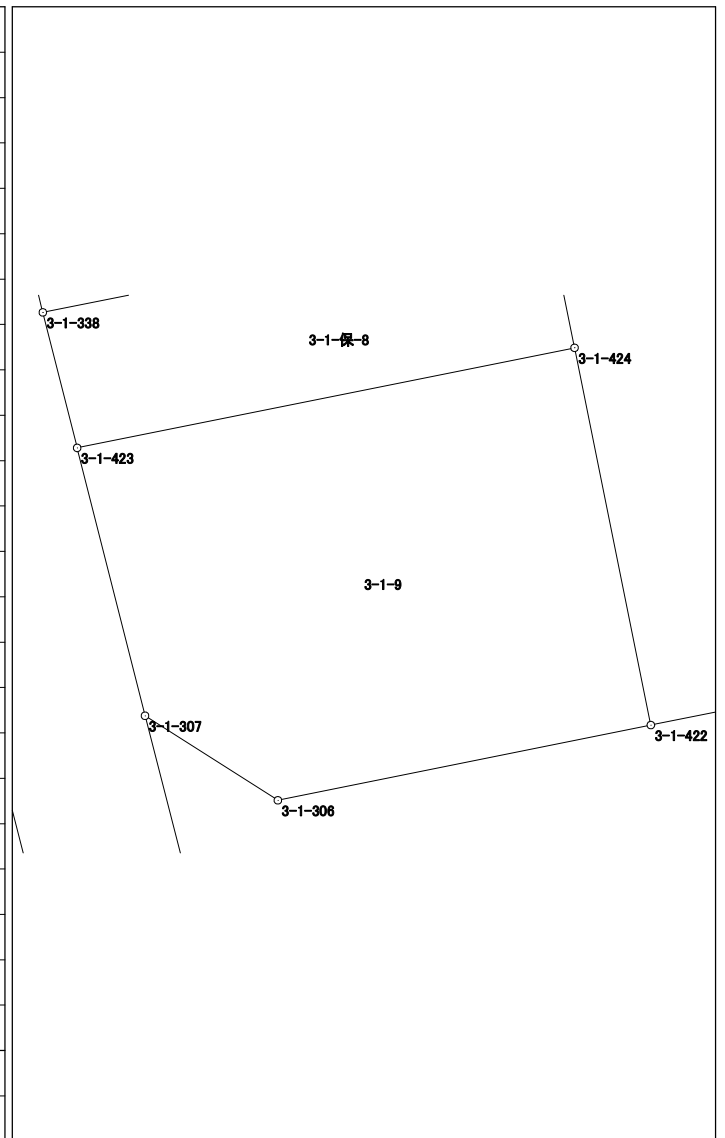




# 面積計算書 (座標法)

世界測地系 (測地成果2011)

所在	地番	公簿地目	現況地目	地積	所有者
前橋市六供町一丁目	3-1-11			11.14 m <sup>2</sup>	

点名	X座標	Y座標	辺長	方向角	測角	DX	倍積 (Y×DX)
3-1-412	41884.041	-68487.316	4.625	258-33-06	89-49-11	1.446	-99032.658936
3-1-411	41883.123	-68491.849	2.411	168-35-15	90-02-09	-3.281	224721.756569
3-1-413	41880.760	-68491.372	4.619	78-32-56	89-57-41	-1.446	99038.523912
3-1-414	41881.677	-68486.845	2.410	348-43-55	90-10-59	3.281	-224705.338445

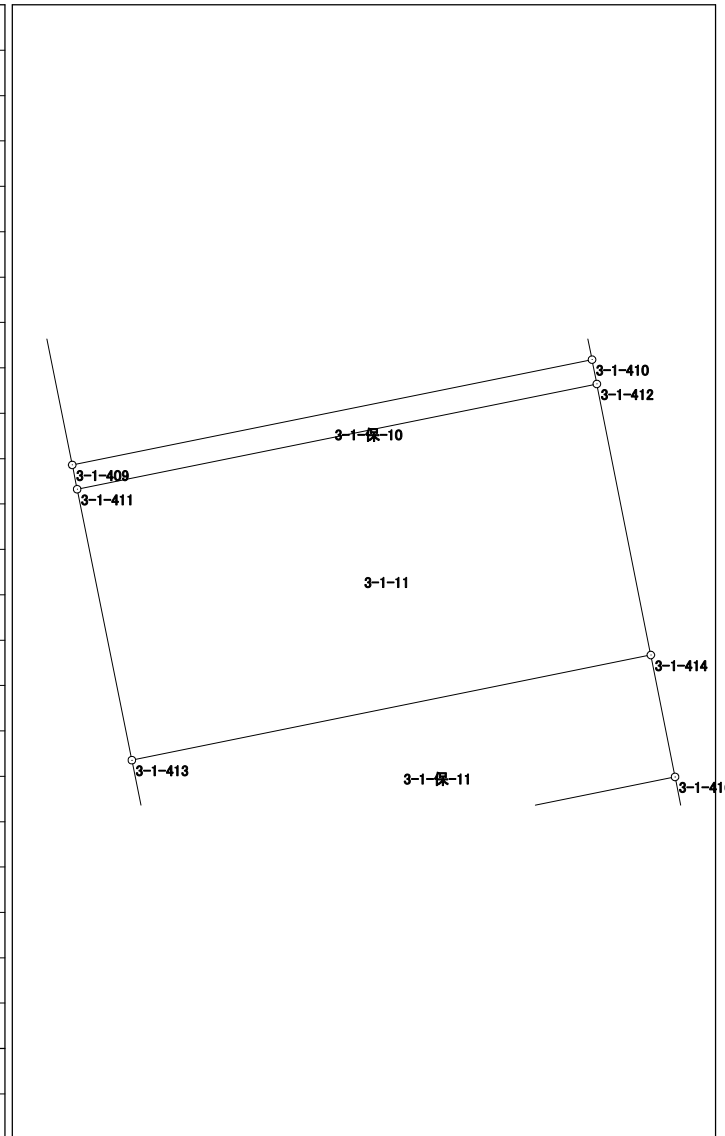


倍面積	22.283100
面積	11.141500

# 面積計算書 (座標法)

世界測地系 (測地成果2011)

所 在	地 番	公簿地目	現況地目	地 積	所 有 者
前橋市六供町一丁目	3-1-保-1			35.00 m <sup>2</sup>	

点 名	X 座標	Y 座標	辺 長	方 向 角	測 角	DX	倍 積 (Y×DX)
3-1-346	41882.339	-68508.856	12.597	348-39-03	90-01-31	12.901	-883832.751256
3-1-347	41894.690	-68511.335	2.790	256-46-50	88-07-47	11.713	-802473.266855
3-1-401	41894.052	-68514.051	12.508	168-39-08	91-52-18	-12.901	883899.771951
3-1-402	41881.789	-68511.590	2.789	78-37-32	89-58-24	-11.713	802476.253670
倍面積						70.007510	
面 積						35.0037550	

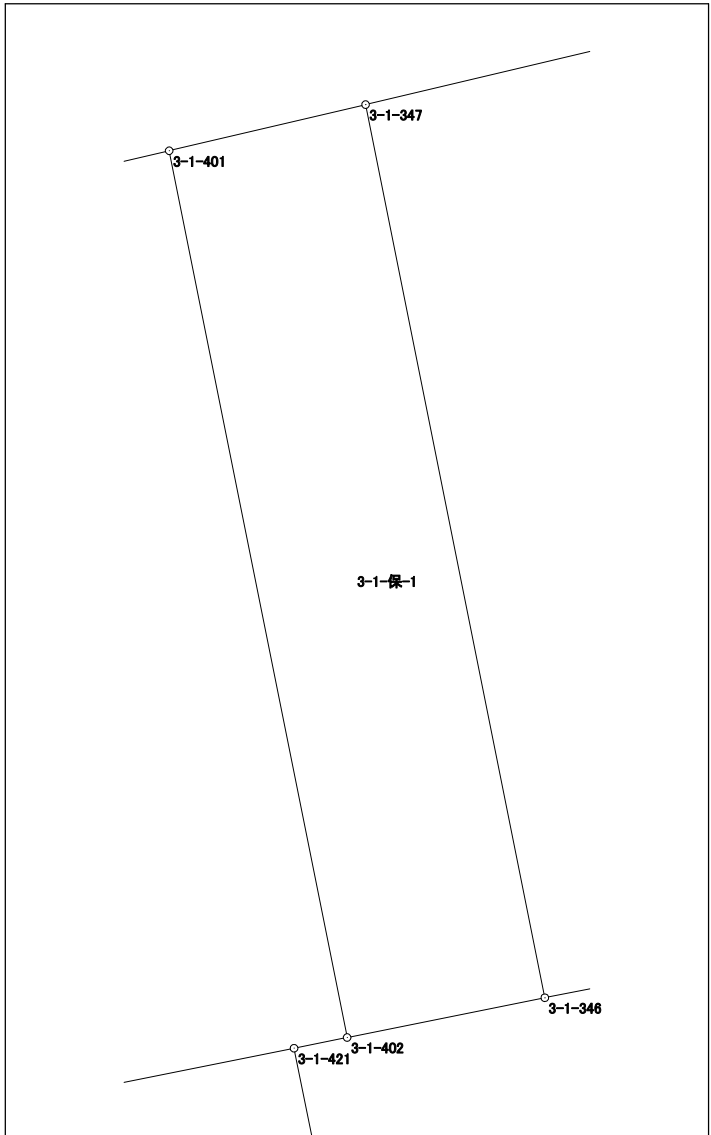




# 面積計算書 (座標法)

世界測地系 (測地成果2011)

所在	地番	公簿地目	現況地目	地積	所有者
前橋市六供町一丁目	3-1-保-3			19.00 m <sup>2</sup>	

点名	X座標	Y座標	辺長	方向角	測角	DX	倍積 (Y×DX)
3-1-341	41884.486	-68498.231	12.943	348-36-05	90-05-41	12.981	-889175.536611
3-1-213	41897.174	-68500.789	1.472	256-48-15	88-12-10	12.352	-846121.745728
3-1-405	41896.838	-68502.222	12.900	168-35-55	91-47-40	-12.981	889227.343782
3-1-406	41884.193	-68499.672	1.470	78-30-24	89-54-29	-12.352	846107.948544
倍面積							38.009987
面積							19.0049935

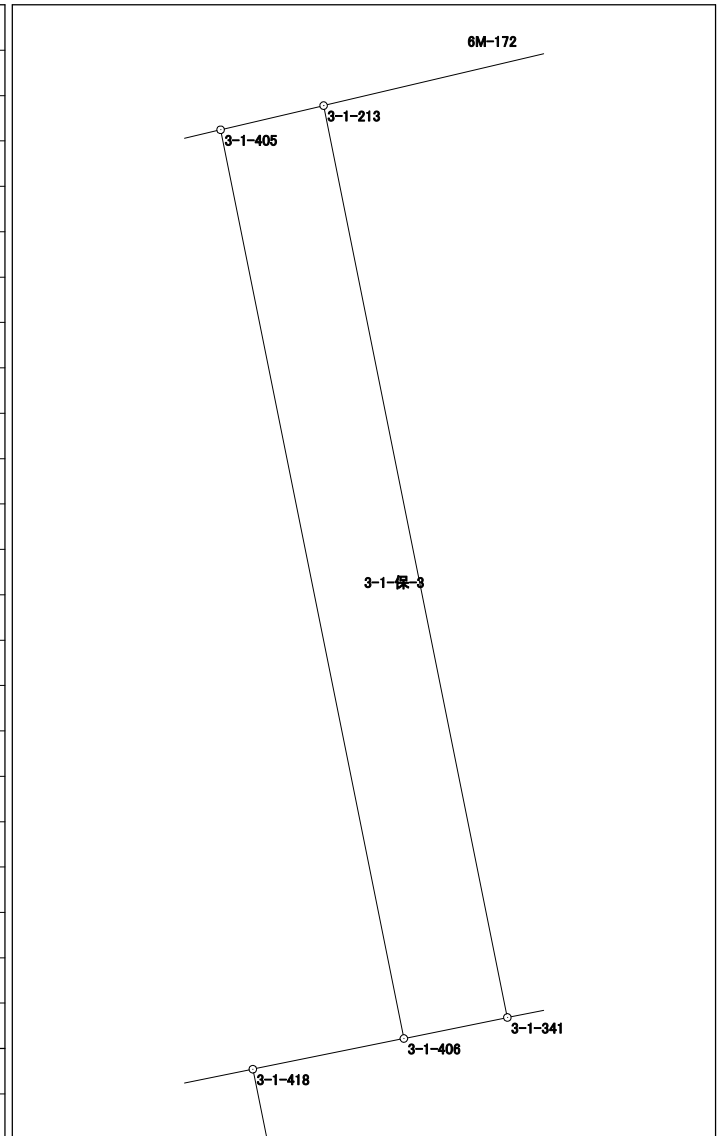


# 面積計算書（座標法）

世界測地系（測地成果2011）

所 在	地 番	公簿地目	現況地目	地 積	所 有 者
前橋市六供町一丁目	3-1-保-4			11.00 m <sup>2</sup>	

点 名	X 座標	Y 座標	辺 長	方 向 角	測 角	DX	倍 積 (Y×DX)
3-1-340	41885.506	-68493.107	3.151	348-39-03	89-55-14	3.253	-222808.077071
3-1-426	41888.595	-68493.727	9.974	348-38-38	179-59-35	12.868	-881377.279036
3-1-215	41898.374	-68495.691	0.840	256-47-27	88-08-49	9.587	-656668.189617
3-1-407	41898.182	-68496.509	13.096	168-38-34	91-51-07	-13.032	892646.505288
3-1-408	41885.342	-68493.930	0.839	78-43-49	90-05-15	-12.676	868229.056680
倍面積							22.016244
面 積							11.0081220

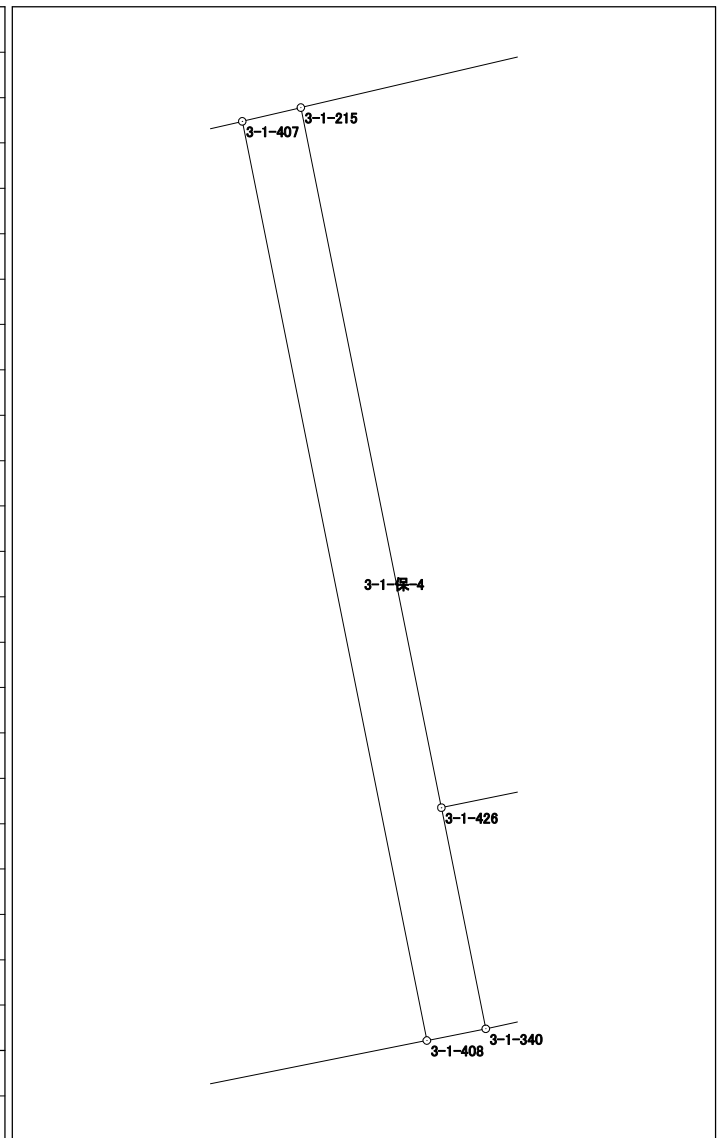


# 面積計算書（座標法）

世界測地系（測地成果2011）

所在	地番	公簿地目	現況地目	地積	所有者
前橋市六供町一丁目	3-1-保-5			17.00 m <sup>2</sup>	

点名	X座標	Y座標	辺長	方向角	測角	DX	倍積 (Y×DX)
3-1-340	41885.506	-68493.107	0.762	77-57-09	89-18-06	-2.930	200684.803510
3-1-348	41885.665	-68492.362	4.636	78-33-16	180-36-07	1.079	-73903.258598
3-1-339	41886.585	-68487.818	3.151	348-45-54	90-12-38	4.011	-274704.637998
3-1-425	41889.676	-68488.432	5.404	258-27-41	89-41-47	2.010	-137661.748320
3-1-426	41888.595	-68493.727	3.151	168-39-03	90-11-22	-4.170	285618.841590
						倍面積	34.000184
						面積	17.0000920

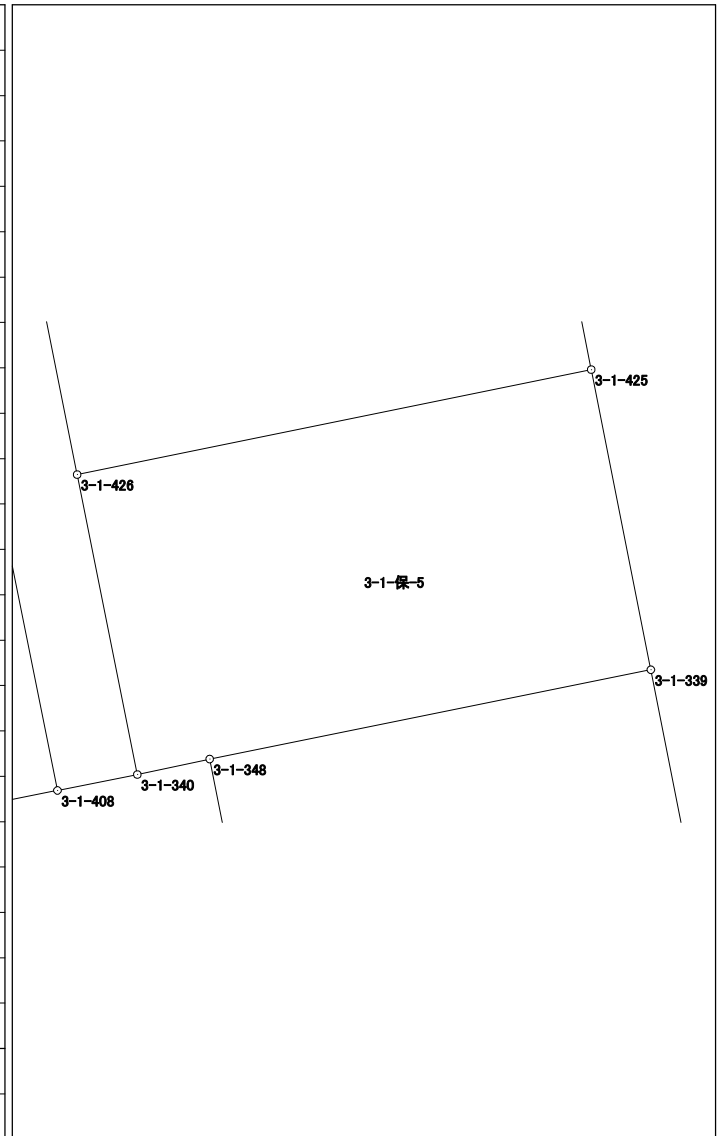






# 面積計算書（座標法）

世界測地系（測地成果2011）

所 在	地 番	公簿地目	現況地目	地 積	所 有 者
前橋市六供町一丁目	3-1-保-7			16.00 m <sup>2</sup>	

点 名	X 座 標	Y 座 標	辺 長	方 向 角	測 角	DX	倍 積 (Y×DX)
3-1-343	41882.947	-68505.809	1.568	258-42-42	90-08-46	9.690	-663821.289210
3-1-419	41882.640	-68507.347	10.203	168-34-12	89-51-30	-10.308	706173.732876
3-1-420	41872.639	-68505.325	1.569	78-34-06	89-59-54	-9.690	663816.599250
3-1-316	41872.950	-68503.787	10.199	348-33-56	89-59-50	10.308	-706137.036396
						倍面積	32.006520
						面 積	16.0032600

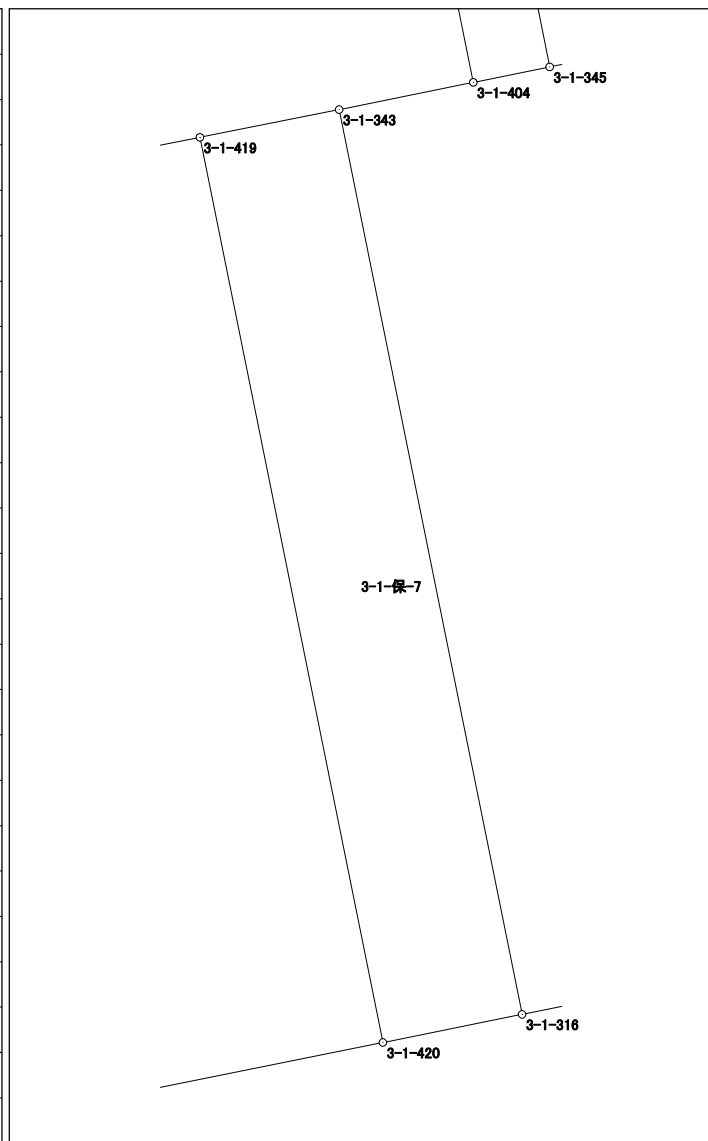



## 面積計算書 (座標法)

世界測地系 (測地成果2011)

所在	地番	公簿地目	現況地目	地積	所有者
前橋市六供町一丁目	3-1-保-9			11.00 m <sup>2</sup>	

点名	X座標	Y座標	辺長	方向角	測角	DX	倍積 (Y×DX)	
3-1-348	41885.665	-68492.362	2.377	168-35-44	90-02-28	-3.250	222600.176500	
3-1-409	41883.335	-68491.892	4.626	78-33-15	89-57-31	-1.412	96710.551504	
3-1-410	41884.253	-68487.358	2.377	348-50-29	90-17-14	3.250	-222583.913500	
3-1-339	41886.585	-68487.818	4.636	258-33-16	89-42-47	1.412	-96704.799016	
						倍面積	22.015488	
						面積	11.0077440	

# 面積計算書 (座標法)

世界測地系 (測地成果2011)

所在	地番	公簿地目	現況地目	地積	所有者
前橋市六供町一丁目	3-1-保-10			1.00 m <sup>2</sup>	

点名	X座標	Y座標	辺長	方向角	測角	DX	倍積 (Y×DX)
3-1-409	41883.335	-68491.892	0.216	168-32-03	89-58-48	-1.130	77395.837960
3-1-411	41883.123	-68491.849	4.625	78-33-06	90-01-03	0.706	-48355.245394
3-1-412	41884.041	-68487.316	0.216	348-47-39	90-14-33	1.130	-77390.667080
3-1-410	41884.253	-68487.358	4.626	258-33-15	89-45-36	-0.706	48352.074748

倍面積	2.000234
面積	1.0001170

