



40街区 画地出来形確認図 (4622.07m²)

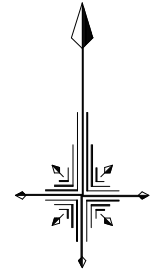

S=1/500

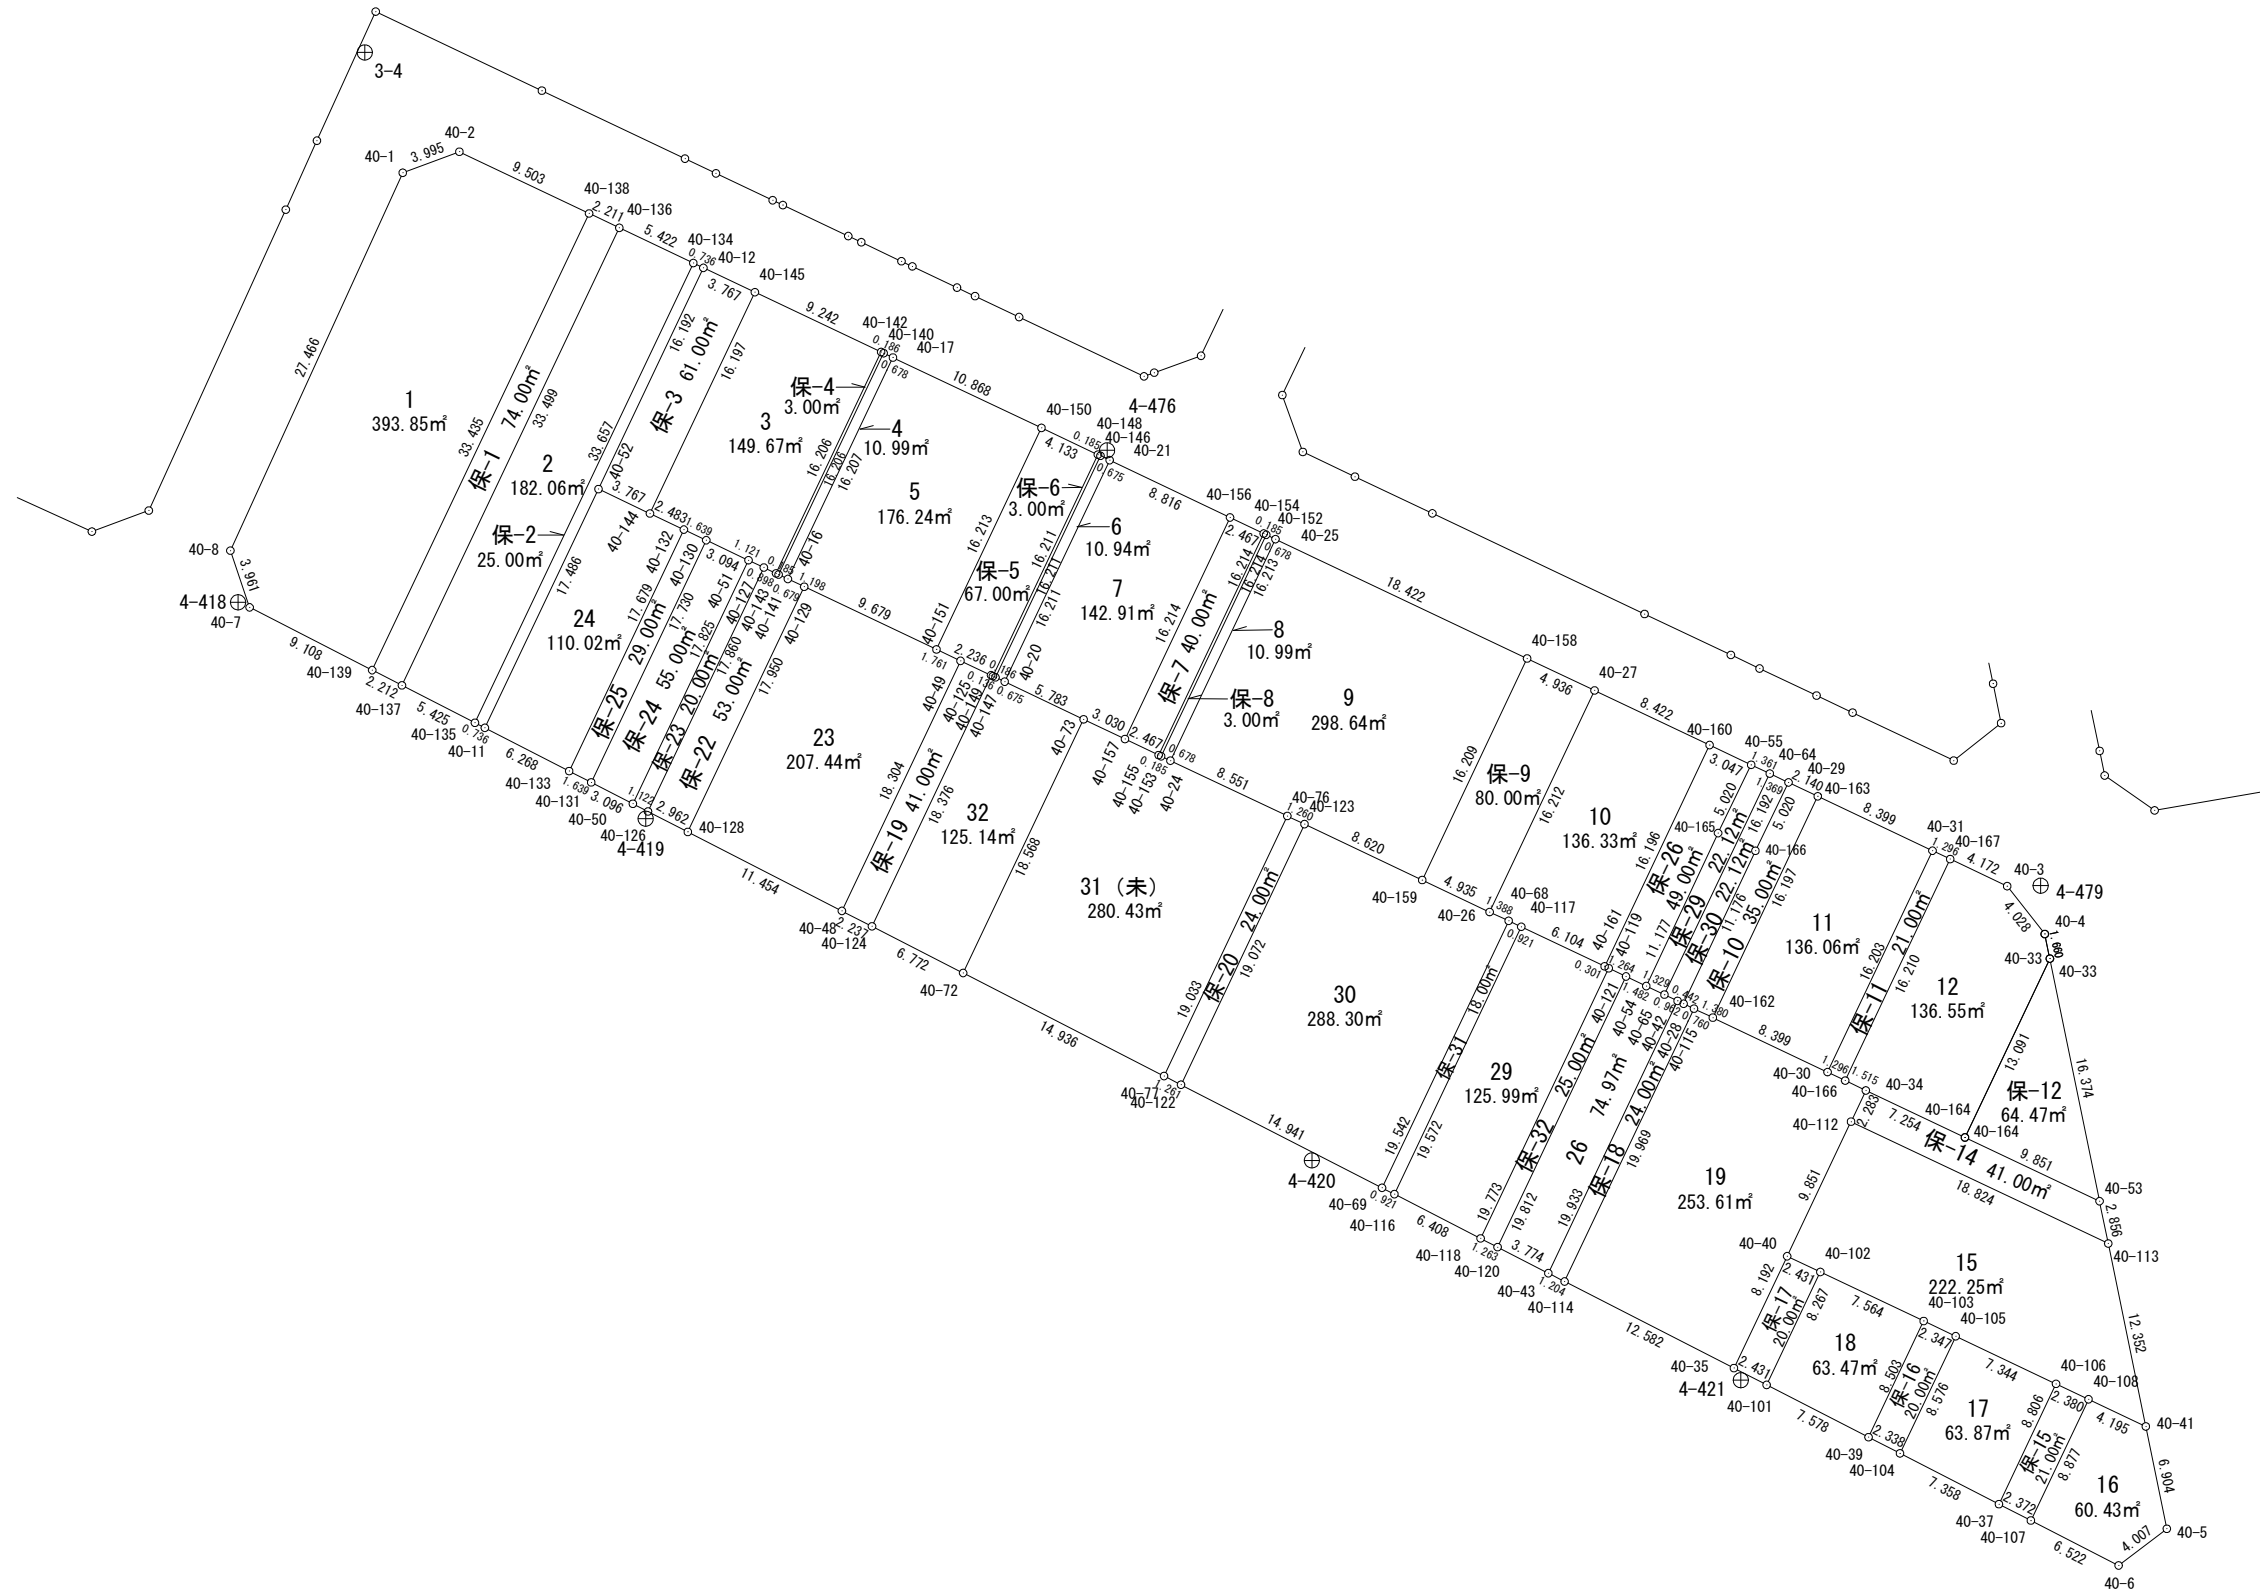


4-422

面積計算書 (座標法)

世界測地系 (測地成果2011)

所在	地番	公簿地目	現況地目	地積	所有者
前橋市六供町二丁目	40-3			149.67 m ²	

点名	X座標	Y座標	辺長	方向角	測角	DX	倍積 (Y×DX)
40-144	41502.096	-68535.543	2.483	115-22-41	90-00-38	-15.699	1075939.489557
40-132	41501.032	-68533.300	1.639	115-21-40	179-58-59	-1.766	121029.807800
40-130	41500.330	-68531.819	3.094	115-22-50	180-01-10	-2.028	138982.528932
40-51	41499.004	-68529.024	1.121	115-23-59	180-01-09	-1.807	123831.946368
40-127	41498.523	-68528.011	0.898	115-27-09	180-03-10	-0.867	59413.785537
40-143	41498.137	-68527.200	16.206	25-23-42	89-56-33	14.254	-976786.708800
40-142	41512.777	-68520.250	9.242	295-19-43	89-56-01	18.594	-1274065.528500
40-145	41516.731	-68528.604	16.197	205-22-03	90-02-20	-10.681	731954.019324
倍面積						299.340218	
面積						149.6701090	

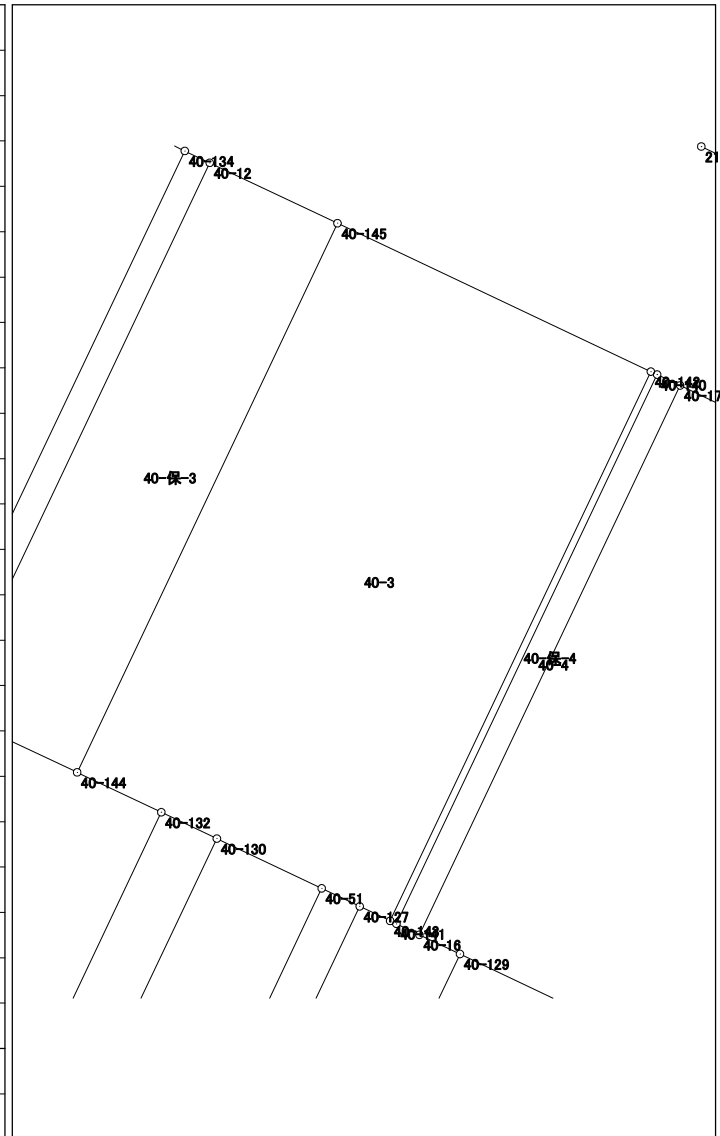


面積計算書（座標法）

世界測地系（測地成果2011）

所 在	地 番	公簿地目	現況地目	地 積	所 有 者
前橋市六供町二丁目	40-6			10.94 m ²	

点 名	X 座標	Y 座標	辺 長	方 向 角	測 角	DX	倍 積 (Y×DX)
40-20	41490.974	-68512.077	16.211	25-21-49	90-00-48	14.359	-983764.913643
40-21	41505.622	-68505.133	0.675	295-21-01	89-59-12	14.937	-1023261.171621
40-146	41505.911	-68505.743	16.211	205-21-49	90-00-48	-14.359	983673.963737
40-147	41491.263	-68512.687	0.675	115-21-01	89-59-12	-14.937	1023374.005719

倍面積	21.884192
面 積	10.9420960

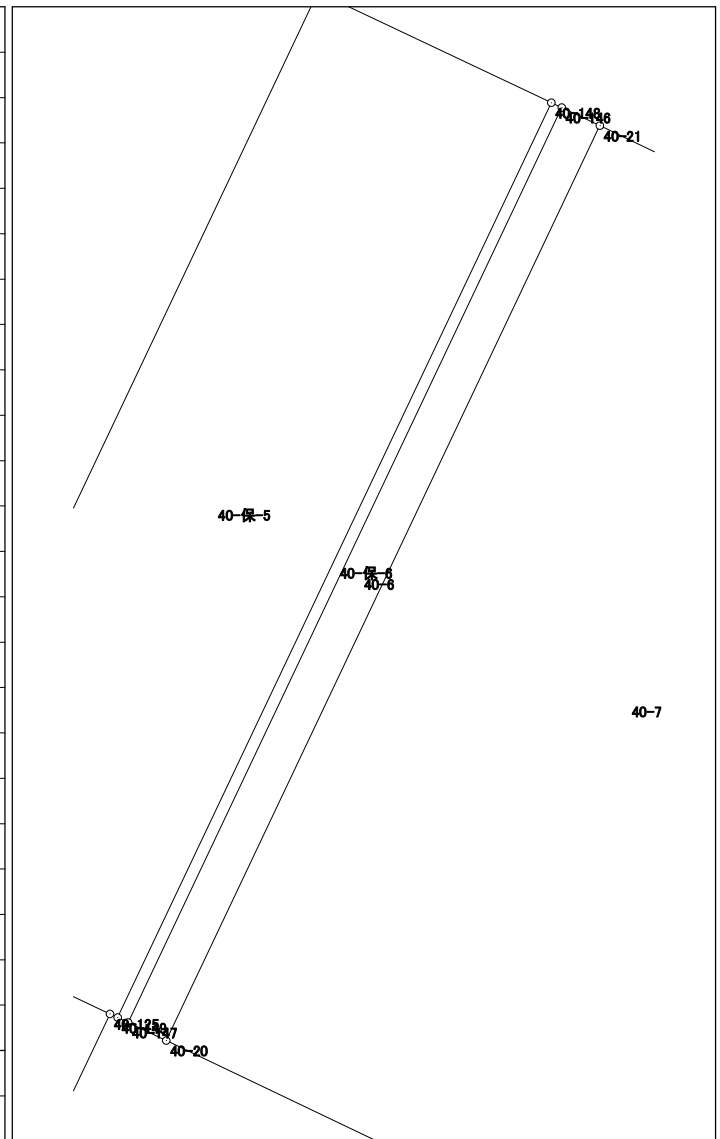


面積計算書 (座標法)

世界測地系 (測地成果2011)

所在	地番	公簿地目	現況地目	地積	所有者
前橋市六供町二丁目	40-7			142.91 m ²	


点名	X座標	Y座標	辺長	方向角	測角	Dx	倍積 (Y×Dx)
40-156	41501.832	-68497.173	8.816	295-27-38	90-05-14	18.440	-1263087.870120
40-21	41505.622	-68505.133	16.211	205-21-49	89-54-11	-10.858	743828.734114
40-20	41490.974	-68512.077	5.783	115-30-06	90-08-17	-17.138	1174159.975626
40-73	41488.484	-68506.857	3.030	115-26-55	179-56-49	-3.792	259778.001744
40-157	41487.182	-68504.121	16.214	25-22-24	89-55-29	13.348	-914393.007108
倍面積						285.834256	
面積						142.9171280	

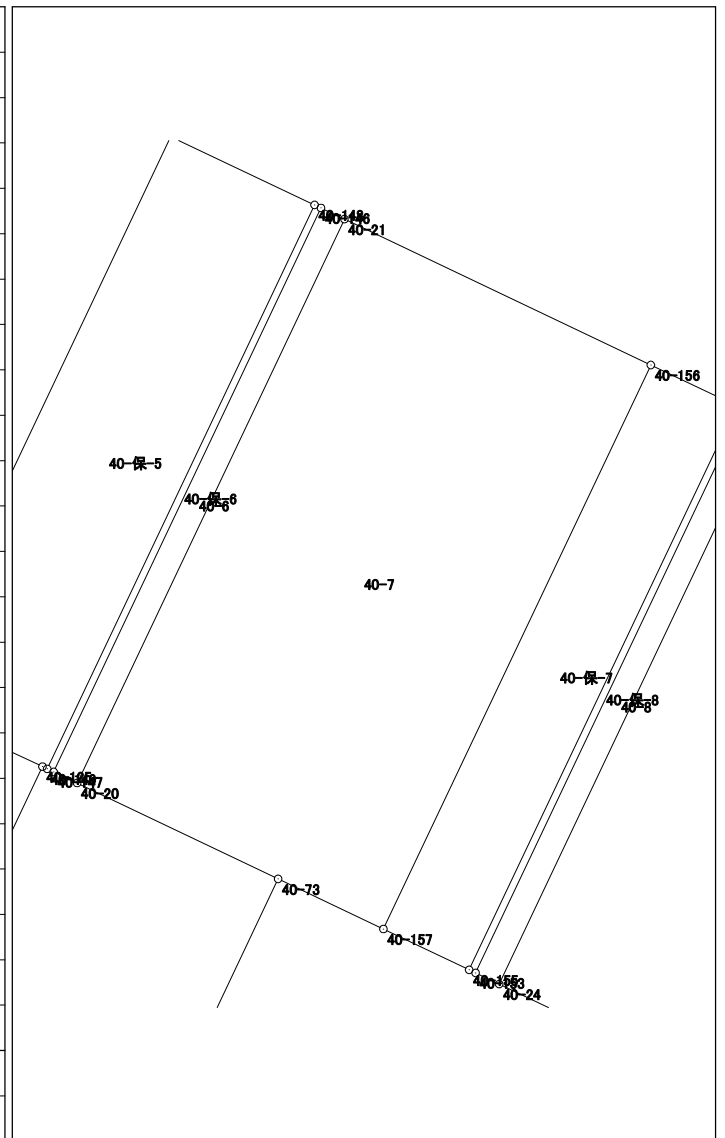

面積計算書 (座標法)

所在	地番	公簿地目	現況地目	地積	所有者
前橋市六供町二丁目	40-8			10.99 m ²	

点名	X座標	Y座標	辺長	方向角	測角	Dx	倍積 (Y×Dx)
40-24	41485.751	-68501.114	16.213	25-22-30	89-56-40	14.358	-983538.994812
40-25	41500.400	-68494.166	0.678	295-30-25	90-07-55	14.941	-1023371.334206
40-152	41500.692	-68494.778	16.214	205-22-24	89-51-59	-14.358	983448.022524
40-153	41486.042	-68501.726	0.678	115-25-50	90-03-26	-14.941	1023484.288166

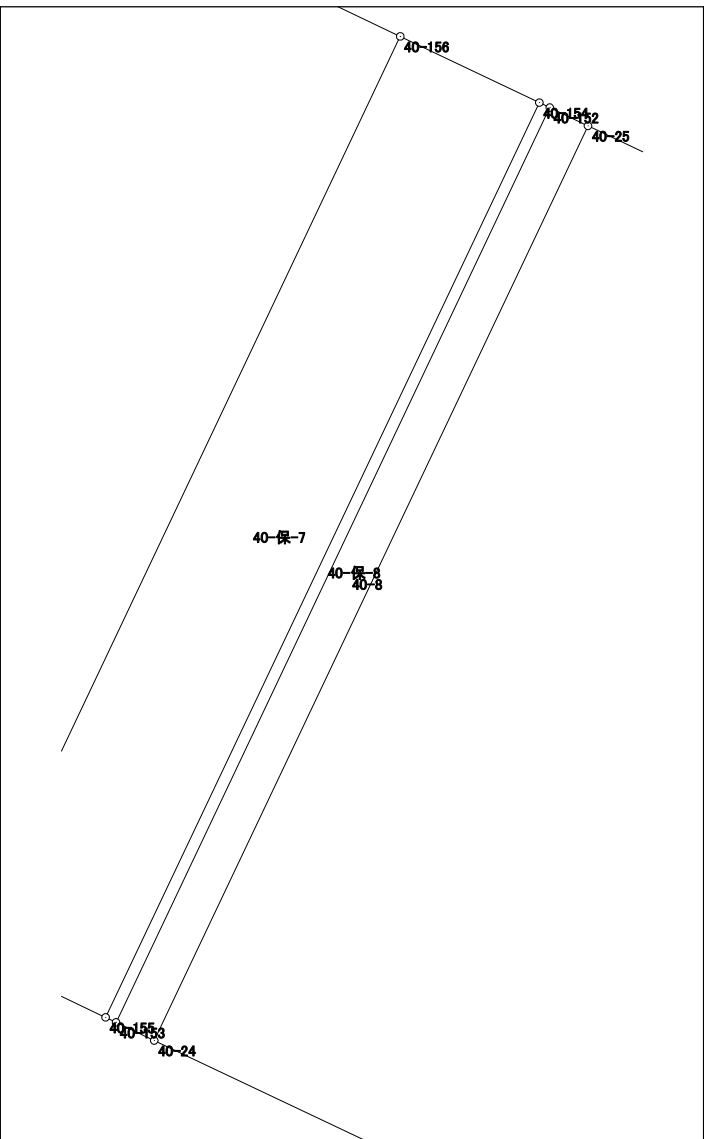


倍面積	21.981672
面積	10.9908360

面積計算書（座標法）

所 在	地 番	公簿地目	現況地目	地 積	所 有 者
前橋市六供町二丁目	40-9			298.64 m ²	

点 名	X 座標	Y 座標	辺 長	方 向 角	測 角	DX	倍 積 (Y×DX)
40-158	41492.508	-68477.520	18.422	295-21-58	90-01-23	22.541	-1543551.778320
40-25	41500.400	-68494.166	16.213	205-22-30	90-00-32	-6.757	462815.079662
40-24	41485.751	-68501.114	8.551	115-18-12	89-55-42	-18.304	1253844.390656
40-76	41482.096	-68493.383	1.260	115-23-06	180-04-54	-4.195	287329.741685
40-123	41481.556	-68492.245	8.620	115-23-48	180-00-42	-4.237	290201.642065
40-159	41477.859	-68484.458	16.209	25-20-35	89-56-47	10.952	-750041.784016
倍面積							597.291732
面 積							298.6458660

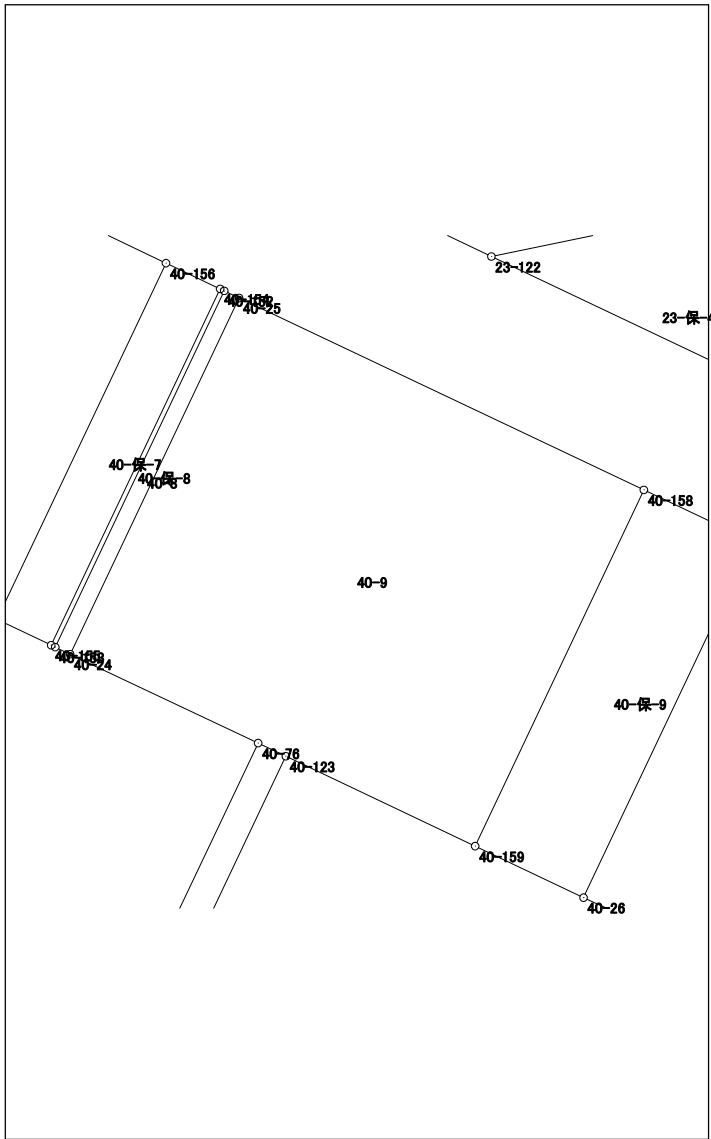


面積計算書（座標法）

世界測地系（測地成果2011）

所 在	地 番	公簿地目	現況地目	地 積	所 有 者
前橋市六供町二丁目	40-10			136.33 m ²	

点 名	X 座標	Y 座標	辺 長	方 向 角	測 角	DX	倍 積 (Y×DX)
40-160	41486.785	-68465.451	8.422	295-22-31	89-59-43	18.242	-1248946.757142
40-27	41490.394	-68473.060	16.212	205-20-41	89-58-10	-11.043	756148.001580
40-26	41475.742	-68480.000	1.388	114-45-18	89-24-37	-15.233	1043155.840000
40-68	41475.161	-68478.740	0.921	115-20-25	180-35-07	-0.975	66766.771500
40-117	41474.767	-68477.908	6.104	115-22-07	180-01-42	-3.009	206050.025172
40-161	41472.152	-68472.393	16.196	25-22-48	90-00-41	12.018	-822901.219074
						倍面積	272.662036
						面 積	136.3310180

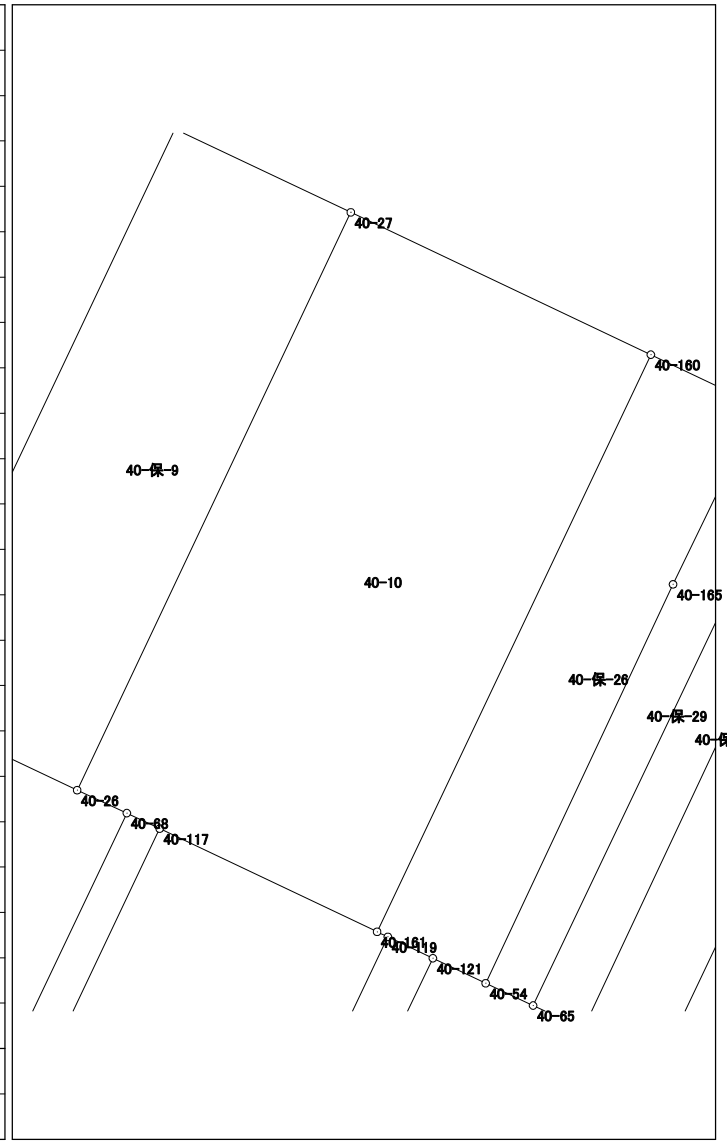


面積計算書（座標法）

世界測地系（測地成果2011）

所 在	地 番	公簿地目	現況地目	地 積	所 有 者
前橋市六供町二丁目	40-11			136.06 m ²	

点 名	X 座標	Y 座標	辺 長	方 向 角	測 角	DX	倍 積 (Y×DX)
40-162	41468.760	-68465.235	8.399	115-24-09	90-02-06	-18.238	1248668.955930
40-30	41465.157	-68457.648	16.203	25-22-04	89-57-55	11.038	-755635.518624
40-31	41479.798	-68450.706	8.399	295-21-25	89-59-21	18.238	-1248403.976028
40-163	41483.395	-68458.296	16.197	205-22-03	90-00-38	-11.038	755642.671248

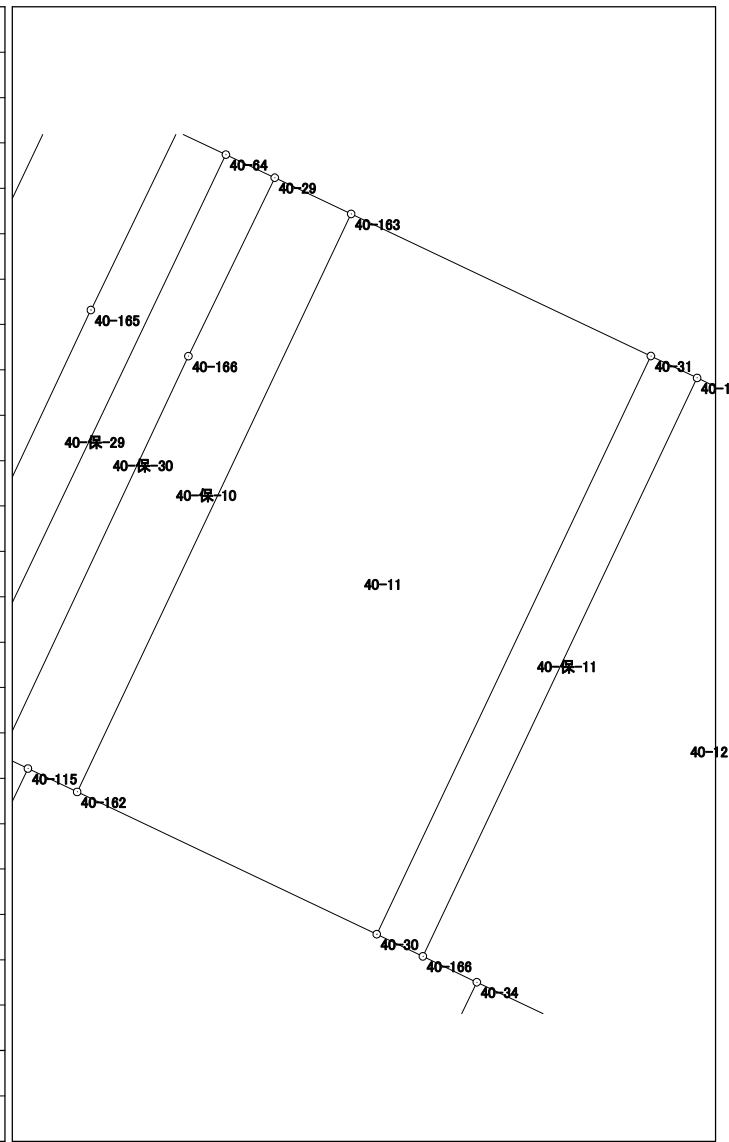


倍面積	272.132526
面積	136.0662630

面積計算書（座標法）

世界測地系（測地成果2011）

所 在	地 番	公簿地目	現況地目	地 積	所 有 者
前橋市六供町二丁目	40-12			136.55 m ²	

点 名	X 座標	Y 座標	辺 長	方 向 角	測 角	DX	倍 積 (Y×DX)
40-33	41472.661	-68442.942	1.660	348-17-02	142-52-47	13.450	-920557.569900
40-4	41474.286	-68443.279	4.028	321-52-00	153-34-58	4.793	-328048.636247
40-3	41477.454	-68445.766	4.172	295-23-31	153-31-31	4.957	-339285.662062
40-167	41479.243	-68449.535	16.210	205-22-06	89-58-35	-12.858	880124.121030
40-166	41464.596	-68456.480	1.515	115-37-04	90-14-58	-15.302	1047521.056960
40-34	41463.941	-68455.114	7.254	115-20-34	179-43-30	-3.760	257391.228640
40-164	41460.836	-68448.558	13.091	25-24-15	90-03-41	8.720	-596871.425760
						倍面積	273.112661
						面 積	136.5563305

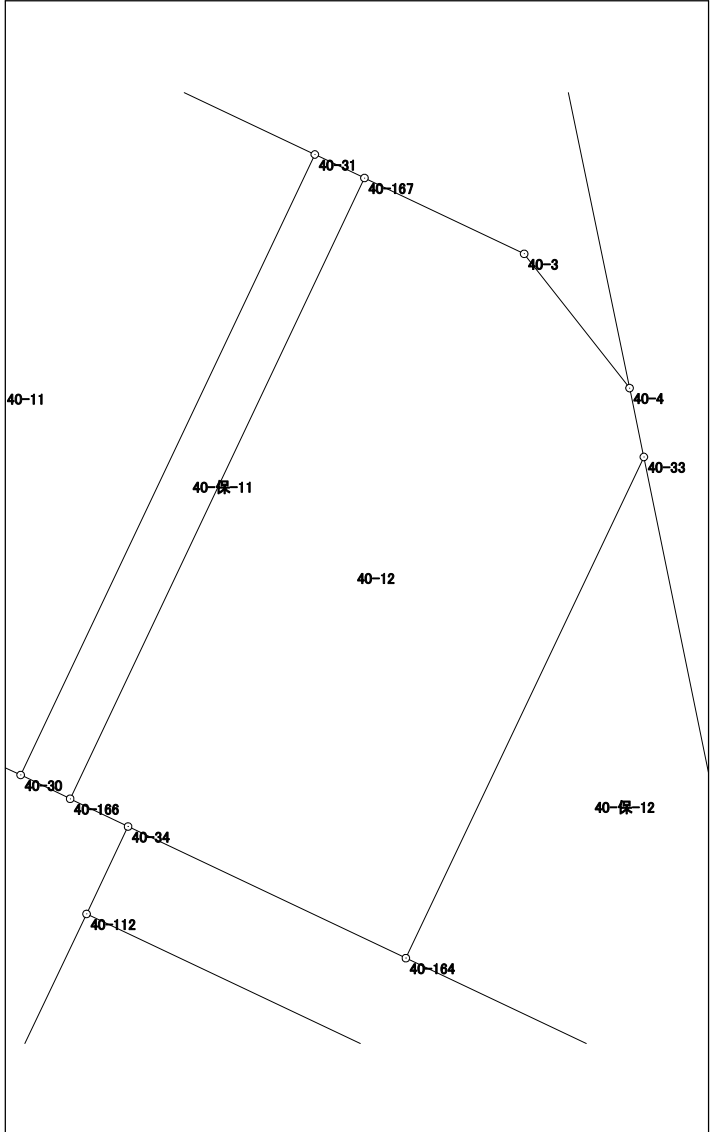


面積計算書 (座標法)

世界測地系 (測地成果2011)

所在	地番	公簿地目	現況地目	地積	所有者
前橋市六供町二丁目	40-16			60.43 m ²	

点名	X座標	Y座標	辺長	方向角	測角	DX	倍積 (Y×DX)
40-107	41435.505	-68444.198	6.522	117-07-37	91-40-55	-10.990	752201.736020
40-6	41432.531	-68438.393	4.007	52-41-13	115-33-36	-0.545	37298.924185
40-5	41434.960	-68435.206	6.904	348-24-07	115-42-54	9.192	-629056.413552
40-41	41441.723	-68436.594	4.195	295-22-48	126-58-41	8.561	-585885.681234
40-108	41443.521	-68440.384	8.877	205-26-42	90-03-54	-6.218	425562.307712
						倍面積	120.873131
						面積	60.4365655

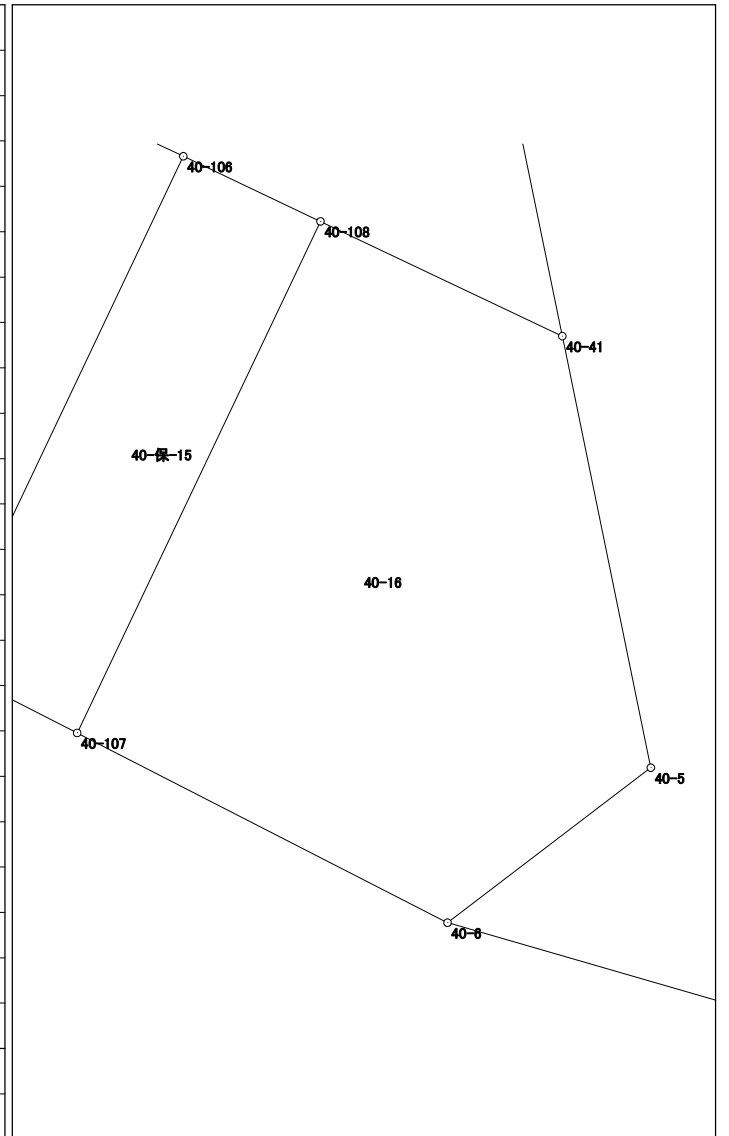

面積計算書（座標法）

世界測地系（測地成果2011）

所在	地番	公簿地目	現況地目	地積	所有者
前橋市六供町二丁目	40-17			63.87 m ²	


点名	X座標	Y座標	辺長	方向角	測角	DX	倍積 (Y×DX)	
40-37	41436.586	-68446.309	8.806	25-23-01	88-12-45	4.596	-314579.236164	
40-106	41444.542	-68442.534	7.344	295-22-56	89-59-55	11.104	-759985.897536	
40-105	41447.690	-68449.169	8.576	205-27-13	90-04-17	-4.596	314592.380724	
40-104	41439.946	-68452.855	7.358	117-10-16	91-43-03	-11.104	760100.501920	
倍面積							127.748944	
面積							63.8744720	

面積計算書（座標法）

世界測地系（測地成果2011）

所在	地番	公簿地目	現況地目	地積	所有者
前橋市六供町二丁目	40-18			63.47 m ²	

点名	X座標	Y座標	辺長	方向角	測角	DX	倍積 (Y×DX)
40-39	41441.014	-68454.935	8.503	25-23-01	88-13-00	4.222	-289016.735570
40-103	41448.696	-68451.290	7.564	295-23-10	90-00-09	10.925	-747830.343250
40-102	41451.939	-68458.124	8.267	205-27-08	90-03-58	-4.222	289030.199528
40-101	41444.474	-68461.677	7.578	117-10-01	91-42-53	-10.925	747943.821225
						倍面積	126.941933
						面積	63.4709665

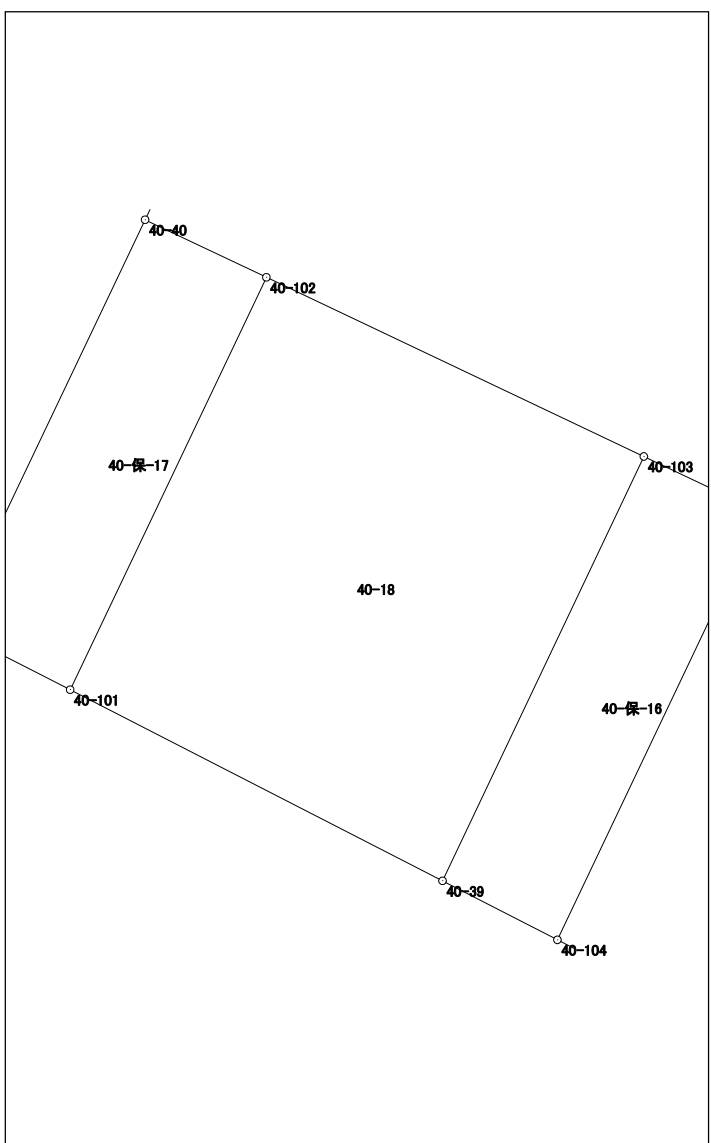


面積計算書 (座標法)

世界測地系 (測地成果2011)

所 在	地 番	公簿地目	現況地目	地 積	所 有 者
前橋市六供町二丁目	40-19			253.61 m ²	

点 名	X 座標	Y 座標	辺 長	方 向 角	測 角	DX	倍 積 (Y×DX)
40-114	41451.311	-68475.043	12.582	117-04-34	91-41-25	-23.768	1627514.822024
40-35	41445.584	-68463.840	8.192	25-26-54	88-22-20	1.670	-114334.612800
40-40	41452.981	-68460.320	9.851	25-24-36	179-57-42	16.295	-1115560.914400
40-112	41461.879	-68456.093	2.283	25-23-51	179-59-15	10.960	-750278.779280
40-34	41463.941	-68455.114	1.515	295-37-04	90-13-13	2.717	-185992.544738
40-166	41464.596	-68456.480	1.296	295-39-19	180-02-15	1.216	-83243.079680
40-30	41465.157	-68457.648	8.399	295-24-09	179-44-50	4.164	-285057.646272
40-162	41468.760	-68465.235	1.380	295-23-44	179-59-35	4.195	-287211.660825
40-115	41469.352	-68466.482	19.969	205-23-09	89-59-25	-17.449	1194671.644418

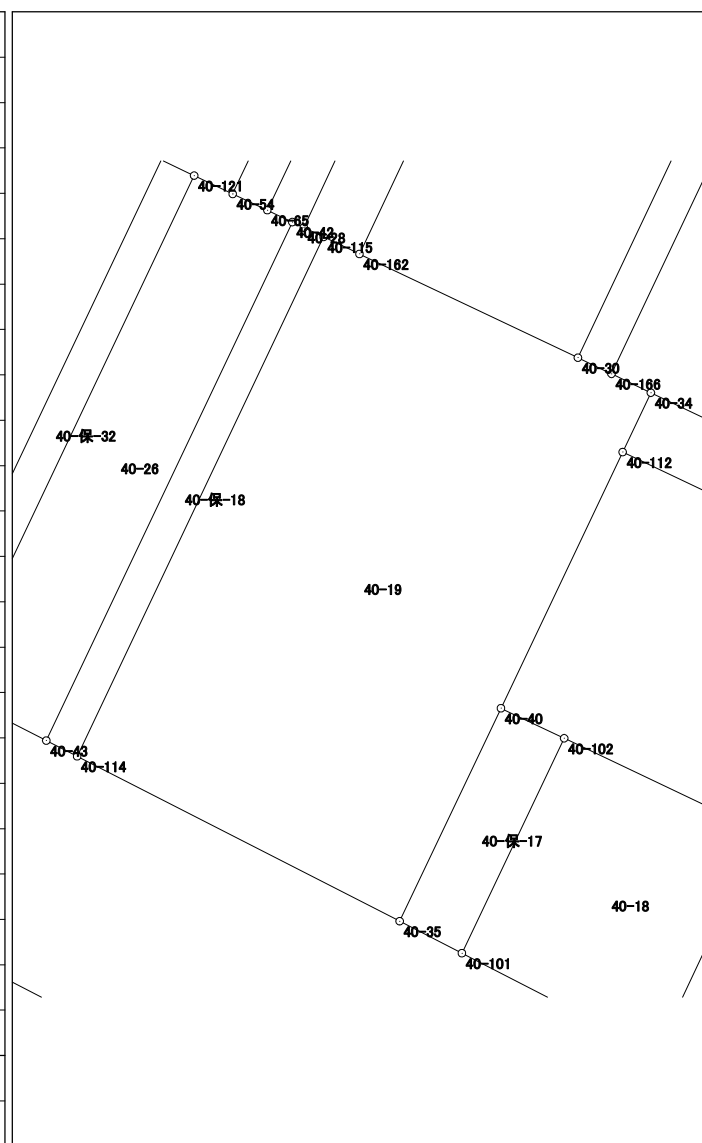


倍面積	507.228447
面積	253.6142235

面積計算書（座標法）

世界測地系（測地成果2011）

所在	地番	公簿地目	現況地目	地積	所有者
前橋市六供町二丁目	40-23			207.44 m ²	


点名	X座標	Y座標	辺長	方向角	測角	DX	倍積 (Y×DX)	
40-128	41481.040	-68533.038	11.454	117-08-08	91-43-47	-21.438	1469211.268644	
40-48	41475.816	-68522.845	18.304	25-22-40	88-14-32	11.314	-775267.468330	
40-49	41492.354	-68515.000	1.761	295-21-25	89-58-45	17.292	-1184761.380000	
40-151	41493.108	-68516.591	9.679	295-21-47	180-00-22	4.900	-335731.295900	
40-129	41497.254	-68525.337	17.950	205-24-21	90-02-34	-12.068	826963.766916	
							倍面積	414.891330
							面積	207.4456650

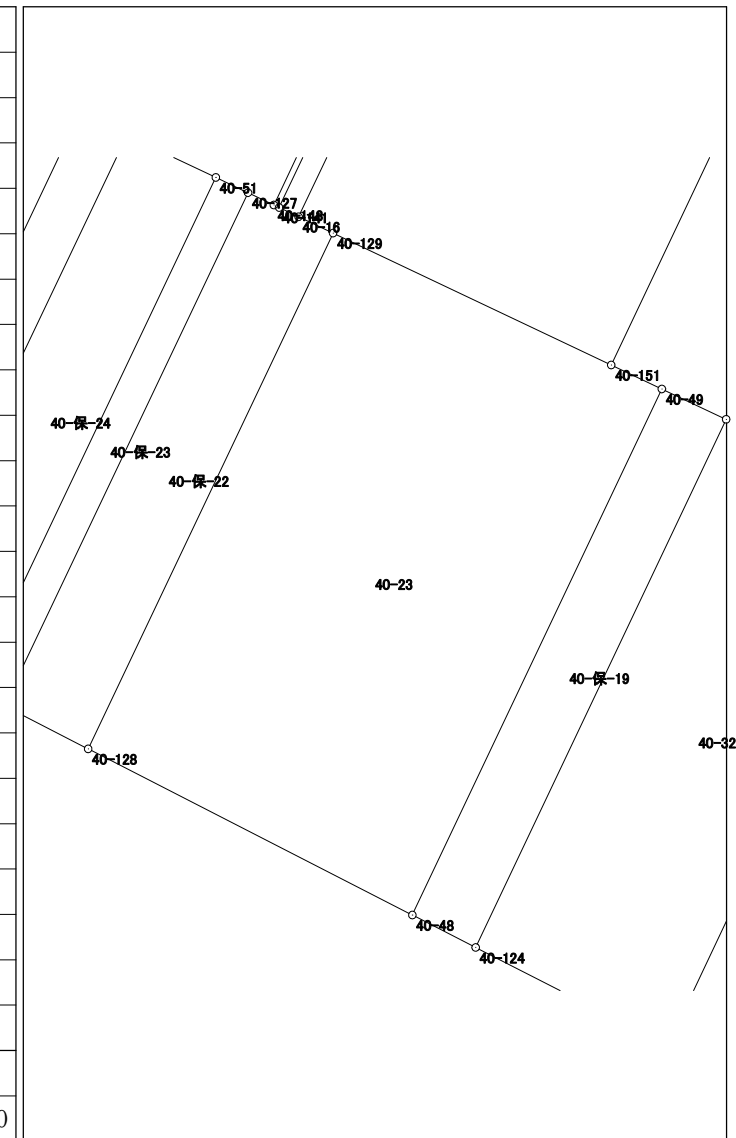

面積計算書 (座標法)

世界測地系 (測地成果2011)

所 在	地 番	公簿地目	現況地目	地 積	所 有 者
前橋市六供町二丁目	40-24			110.02 m ²	

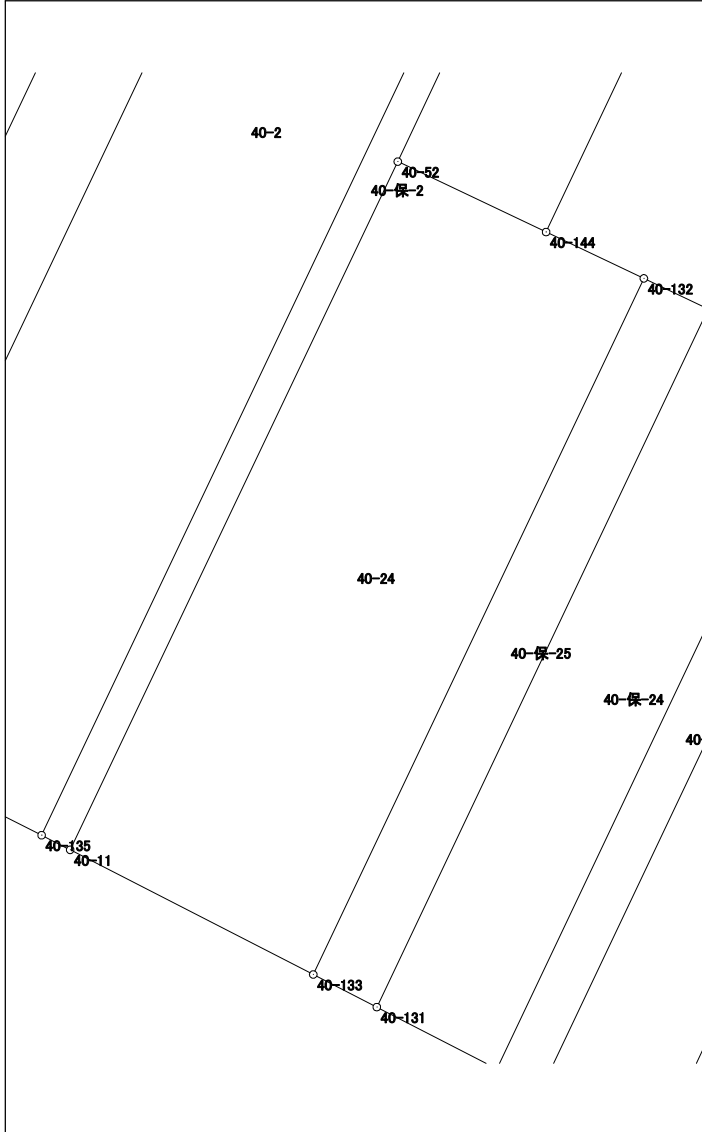
点 名	X 座標	Y 座標	辺 長	方 向 角	測 角	DX	倍 積 (Y×DX)	
40-132	41501.032	-68533.300	2.483	295-22-41	89-58-16	17.033	-1167327.698900	
40-144	41502.096	-68535.543	3.767	295-23-17	180-00-36	2.679	-183606.719697	
40-52	41503.711	-68538.946	17.486	205-27-36	90-04-19	-14.173	971402.481658	
40-11	41487.923	-68546.463	6.268	117-08-44	91-41-08	-18.648	1278254.442024	
40-133	41485.063	-68540.885	17.679	25-24-25	88-15-41	13.109	-898502.461465	
							倍面積	220.043620
							面 積	110.0218100

面積計算書（座標法）

世界測地系（測地成果2011）

所在	地番	公簿地目	現況地目	地積	所有者
前橋市六供町二丁目	40-26			74.97 m ²	

点名	X座標	Y座標	辺長	方向角	測角	DX	倍積 (Y×DX)
40-120	41453.582	-68479.473	3.774	117-09-45	91-46-33	-19.622	1343704.219206
40-43	41451.859	-68476.115	19.933	25-23-15	88-13-30	16.285	-1115133.532775
40-42	41469.867	-68467.569	0.962	295-33-11	90-09-56	18.423	-1261378.023687
40-65	41470.282	-68468.437	1.329	295-07-07	179-33-56	0.979	-67030.599823
40-54	41470.846	-68469.640	1.482	295-22-19	180-15-12	1.199	-82095.098360
40-121	41471.481	-68470.979	19.812	205-23-12	90-00-53	-17.264	1182082.981456
						倍面積	149.946017
						面積	74.9730085

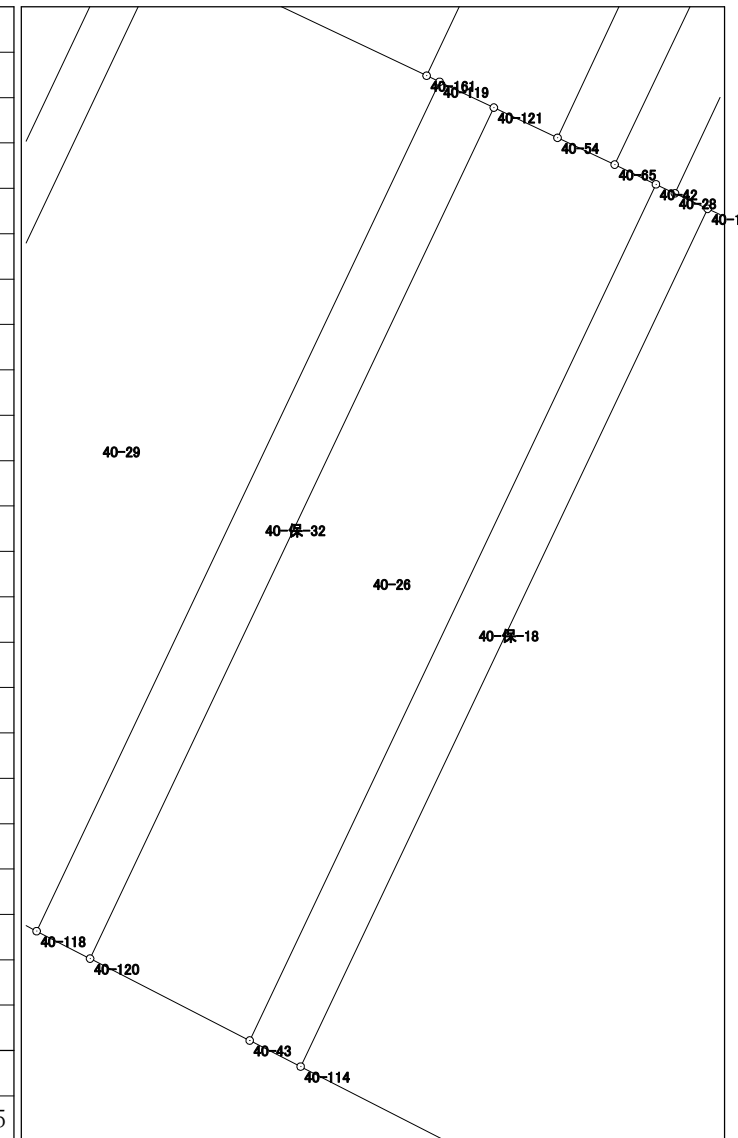


面積計算書（座標法）

世界測地系（測地成果2011）

所 在	地 番	公簿地目	現況地目	地 積	所 有 者
前橋市六供町二丁目	40-31 (未)			280.43 m ²	

点 名	X 座標	Y 座標	辺 長	方 向 角	測 角	DX	倍 積 (Y×DX)
40-73	41488.484	-68506.857	18.568	205-24-46	89-57-51	-15.469	1059732.570933
40-72	41471.713	-68514.825	14.936	117-09-06	91-44-20	-23.587	1616059.177275
40-77	41464.897	-68501.535	19.033	25-21-36	88-12-30	10.383	-711251.437905
40-76	41482.096	-68493.383	8.551	295-18-12	89-56-36	20.854	-1428361.009082
40-24	41485.751	-68501.114	0.678	295-25-50	180-07-38	3.946	-270305.395844
40-153	41486.042	-68501.726	0.185	295-35-47	180-09-57	0.371	-25414.140346
40-155	41486.122	-68501.893	2.467	295-26-36	179-50-49	1.140	-78092.158020
40-157	41487.182	-68504.121	3.030	295-26-55	180-00-19	2.362	-161806.733802

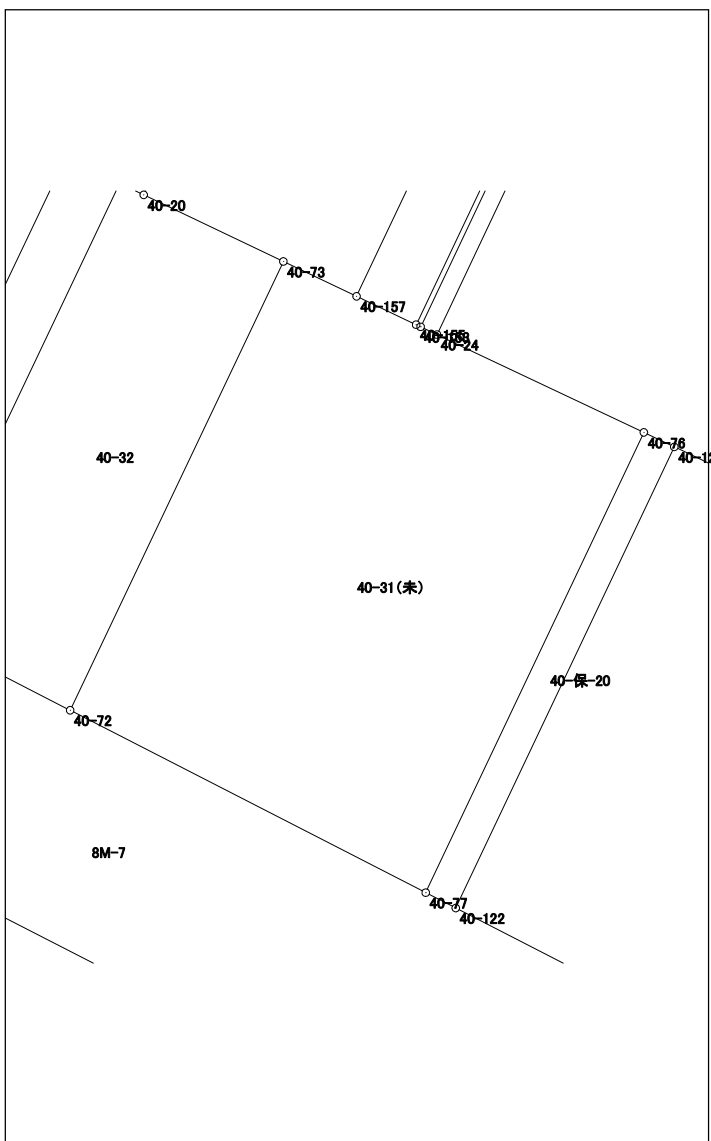


倍面積	560.873209
面 積	280.4366045

面積計算書（座標法）

世界測地系（測地成果2011）

所 在	地 番	公簿地目	現況地目	地 積	所 有 者
前橋市六供町二丁目	40-32			125.14 m ²	

点 名	X 座標	Y 座標	辺 長	方 向 角	測 角	DX	倍 積 (Y×DX)
40-124	41474.797	-68520.854	6.772	117-05-28	91-42-46	-19.687	1348970.052698
40-72	41471.713	-68514.825	18.568	25-24-46	88-19-18	13.687	-937762.409775
40-73	41488.484	-68506.857	5.783	295-30-06	90-05-20	19.261	-1319510.572677
40-20	41490.974	-68512.077	0.675	295-21-01	179-50-55	2.779	-190395.061983
40-147	41491.263	-68512.687	0.186	295-11-05	179-50-04	0.368	-25212.668816
40-149	41491.342	-68512.855	0.136	295-14-46	180-03-41	0.137	-9386.261135
40-125	41491.400	-68512.978	18.376	205-22-42	90-07-56	-16.545	1133547.221010
						倍面積	250.299322
						面 積	125.1496610

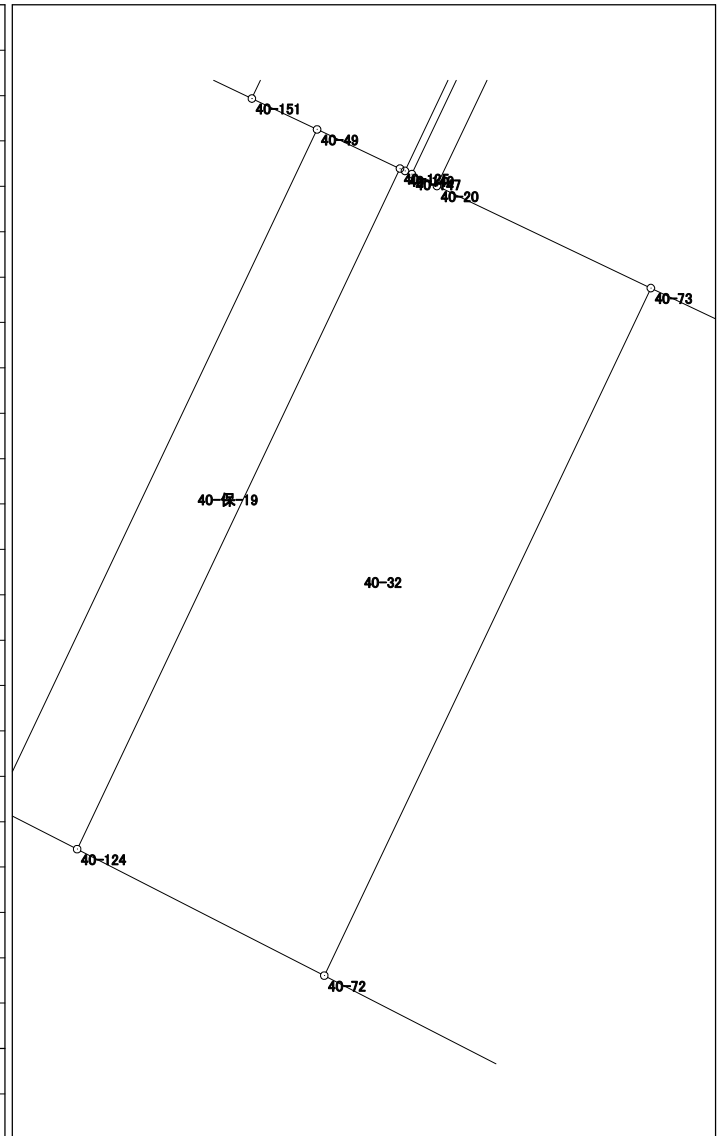


面積計算書 (座標法)

世界測地系 (測地成果2011)

所在	地番	公簿地目	現況地目	地積	所有者
前橋市六供町二丁目	40-保-1			74.00 m ²	

点名	X座標	Y座標	辺長	方向角	測角	DX	倍積 (Y×DX)
40-137	41490.730	-68551.947	33.499	25-24-55	88-18-21	29.249	-2005075.897803
40-136	41520.987	-68537.570	2.211	295-26-28	90-01-33	31.207	-2138851.946990
40-138	41521.937	-68539.567	33.435	205-24-53	89-58-25	-29.249	2004713.795183
40-139	41491.738	-68553.916	2.212	117-06-34	91-41-41	-31.207	2139362.056612

倍面積	148.007002
面積	74.0035010

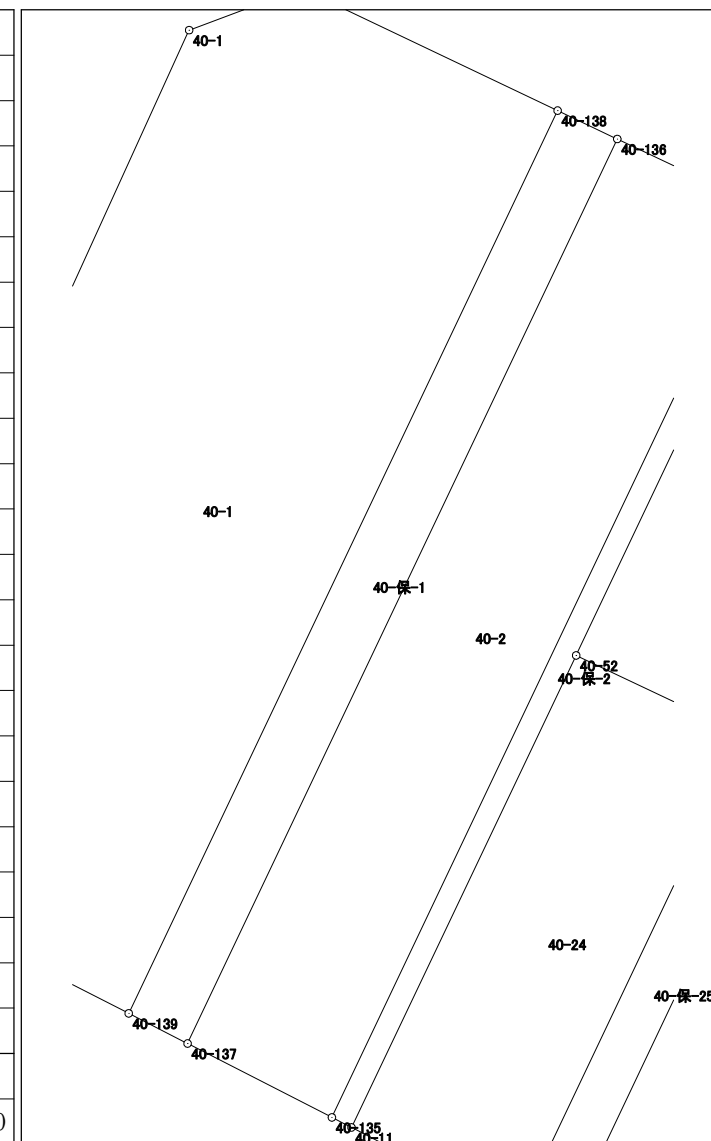


面積計算書 (座標法)

世界測地系 (測地成果2011)

所在	地番	公簿地目	現況地目	地積	所有者
前橋市六供町二丁目	40-保-2			25.00 m ²	

点名	X座標	Y座標	辺長	方向角	測角	DX	倍積 (Y×DX)
40-52	41503.711	-68538.946	16.192	25-22-01	179-54-25	30.419	-2084886.198374
40-12	41518.342	-68532.009	0.736	295-24-59	90-02-58	14.947	-1024347.938523
40-134	41518.658	-68532.674	33.657	205-24-50	89-59-51	-30.084	2061736.964616
40-135	41488.258	-68547.118	0.736	117-05-15	91-40-25	-30.735	2106795.671730
40-11	41487.923	-68546.463	17.486	25-27-36	88-22-21	15.453	-1059248.492739
						倍面積	50.006710
						面積	25.0033550

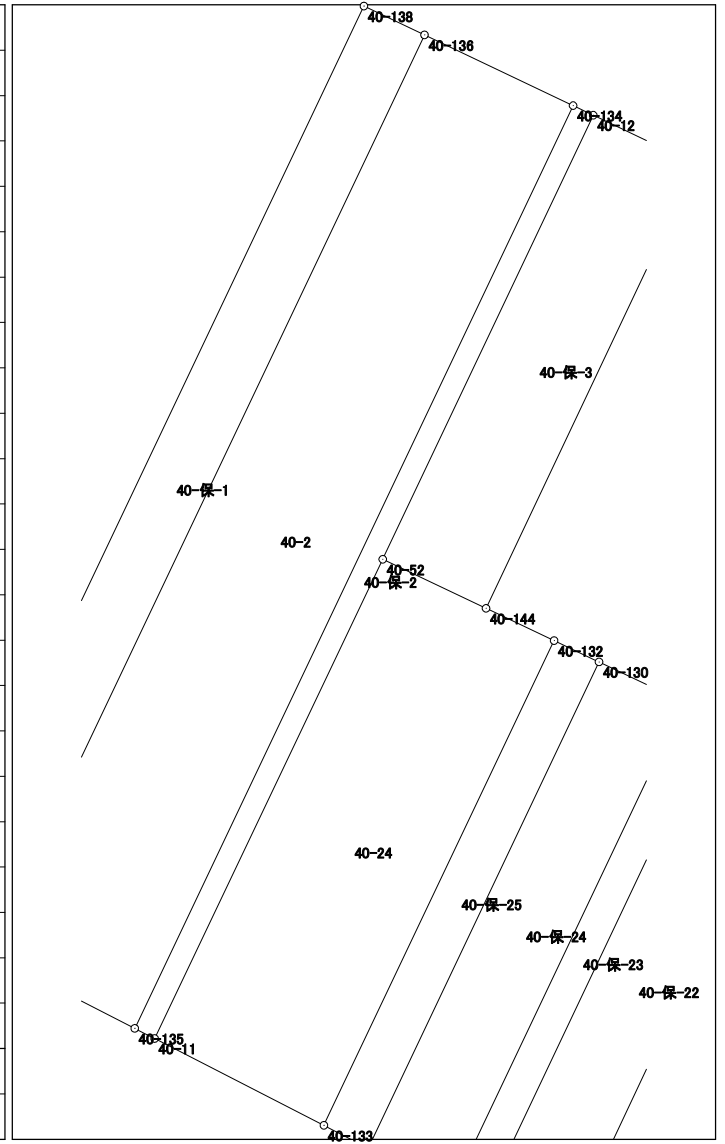


面積計算書（座標法）

世界測地系（測地成果2011）

所 在	地 番	公簿地目	現況地目	地 積	所 有 者
前橋市六供町二丁目	40-保-3			61.00 m ²	

点 名	X 座 標	Y 座 標	辺 長	方 向 角	測 角	DX	倍 積 (Y×DX)
40-12	41518.342	-68532.009	16.192	205-22-01	90-02-49	-13.020	892286.757180
40-52	41503.711	-68538.946	3.767	115-23-17	90-01-16	-16.246	1113483.716716
40-144	41502.096	-68535.543	16.197	25-22-03	89-58-46	13.020	-892332.769860
40-145	41516.731	-68528.604	3.767	295-19-12	89-57-09	16.246	-1113315.700584
						倍面積	122.003452
						面 積	61.0017260

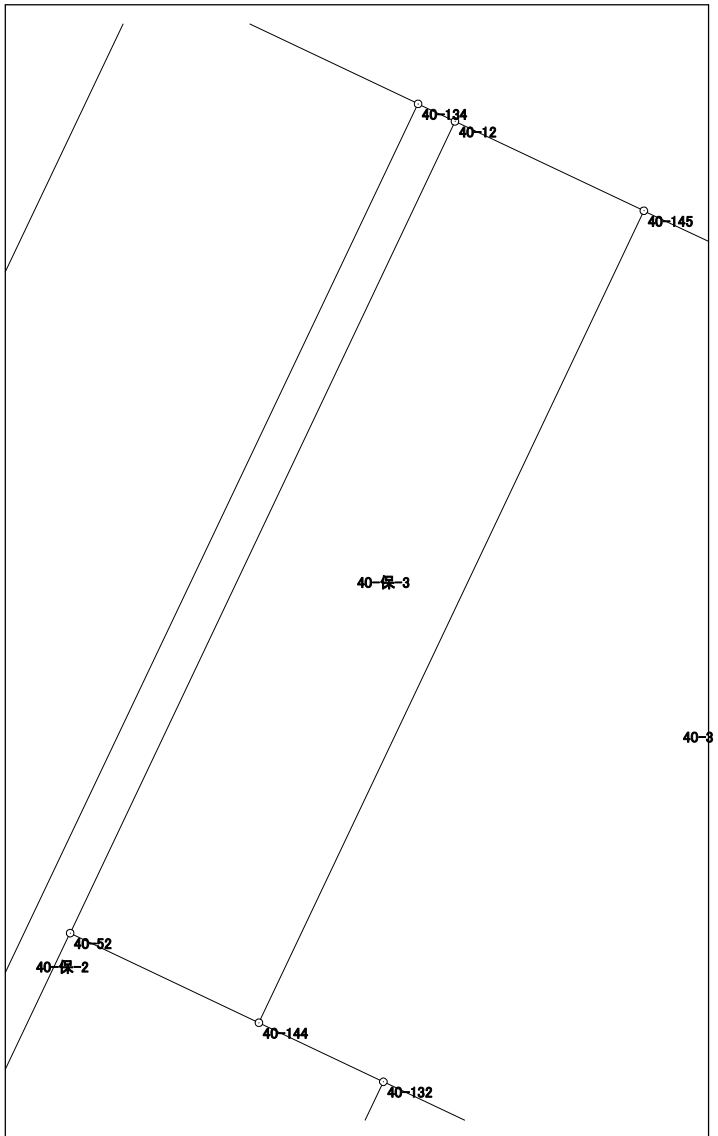


面積計算書 (座標法)

世界測地系 (測地成果2011)

所在	地番	公簿地目	現況地目	地積	所有者
前橋市六供町二丁目	40-保-4			3.00 m ²	

点名	X座標	Y座標	辺長	方向角	測角	DX	倍積 (Y×DX)
40-140	41512.698	-68520.082	0.186	295-11-05	89-47-12	14.719	-1008547.086958
40-142	41512.777	-68520.250	16.206	205-23-42	90-12-37	-14.561	997723.360250
40-143	41498.137	-68527.200	0.185	115-19-00	89-55-18	-14.719	1008651.856800
40-141	41498.058	-68527.033	16.206	25-23-53	90-04-53	14.561	-997822.127513
倍面積							6.002579
面積							3.0012895

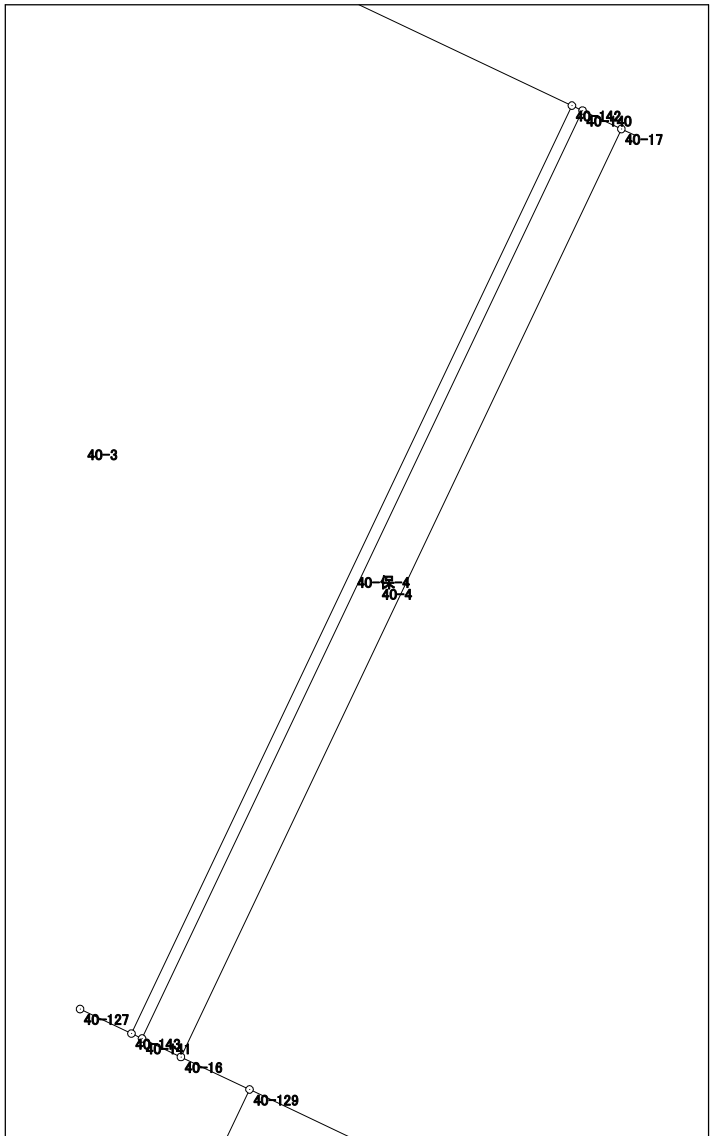


面積計算書 (座標法)

世界測地系 (測地成果2011)

所在	地番	公簿地目	現況地目	地積	所有者
前橋市六供町二丁目	40-保-5			67.00 m ²	

点名	X座標	Y座標	辺長	方向角	測角	DX	倍積 (Y×DX)
40-148	41505.990	-68505.910	4.133	295-19-30	89-57-29	16.416	-1124593.018560
40-150	41507.758	-68509.646	16.213	205-21-50	90-02-20	-12.882	882541.259772
40-151	41493.108	-68516.591	1.761	115-21-25	89-59-35	-15.404	1055429.567764
40-49	41492.354	-68515.000	2.236	115-15-30	179-54-05	-1.708	117023.620000
40-125	41491.400	-68512.978	0.136	115-14-46	179-59-16	-1.012	69335.133736
40-149	41491.342	-68512.855	16.211	25-22-01	90-07-15	14.590	-999602.554450

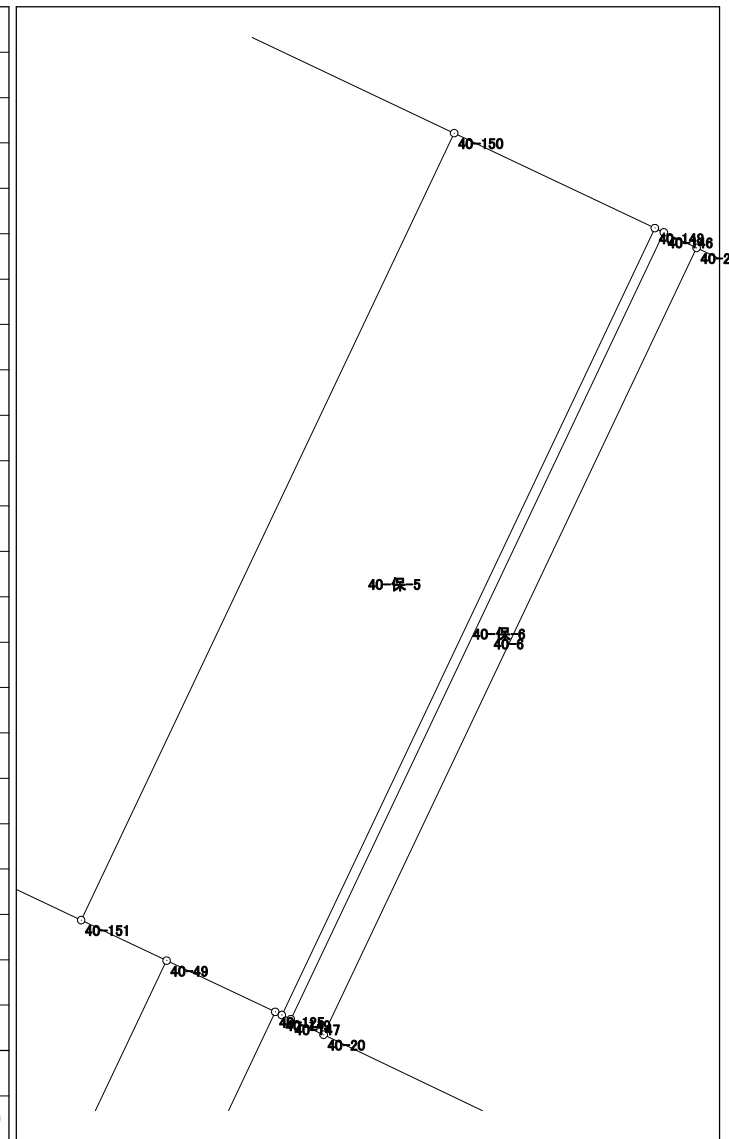


倍面積	134.008262
面積	67.0041310

面積計算書（座標法）

世界測地系（測地成果2011）

所在	地番	公簿地目	現況地目	地積	所有者
前橋市六供町二丁目	40-保-6			3.00 m ²	


点名	X座標	Y座標	辺長	方向角	測角	Dx	倍積 (Y×Dx)
40-147	41491.263	-68512.687	16.211	25-21-49	90-10-44	14.569	-998161.336903
40-146	41505.911	-68505.743	0.185	295-19-00	89-57-11	14.727	-1008884.077161
40-148	41505.990	-68505.910	16.211	205-22-01	90-03-01	-14.569	998062.602790
40-149	41491.342	-68512.855	0.186	115-11-05	89-49-04	-14.727	1008988.815585
						倍面積	6.004311
						面積	3.0021555

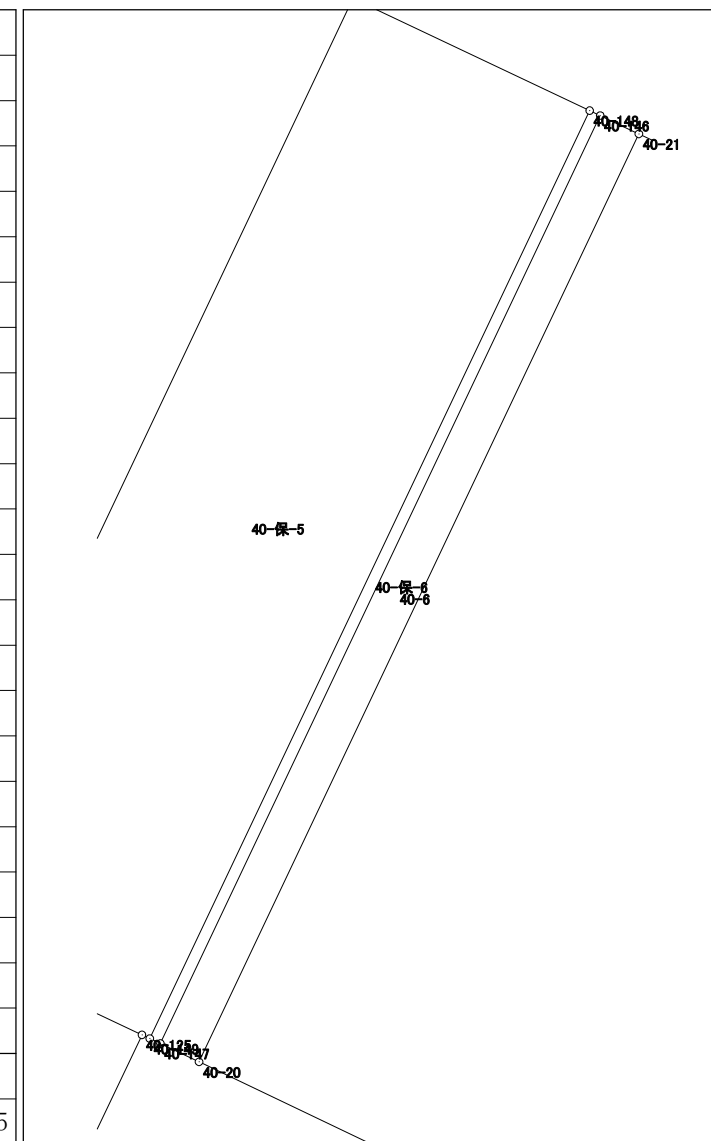

面積計算書（座標法）

所 在	地 番	公簿地目	現況地目	地 積	所 有 者
前橋市六供町二丁目	40-保-8			3.00 m ²	

点 名	X 座 標	Y 座 標	辺 長	方 向 角	測 角	DX	倍 積 (Y×DX)
40-153	41486.042	-68501.726	16.214	25-22-24	89-46-37	14.570	-998070.147820
40-152	41500.692	-68494.778	0.185	295-35-47	90-13-23	14.730	-1008928.079940
40-154	41500.772	-68494.945	16.214	205-22-24	89-46-37	-14.570	997971.348650
40-155	41486.122	-68501.893	0.185	115-35-47	90-13-23	-14.730	1009032.883890
倍面積							6.004780
面 積							3.0023900

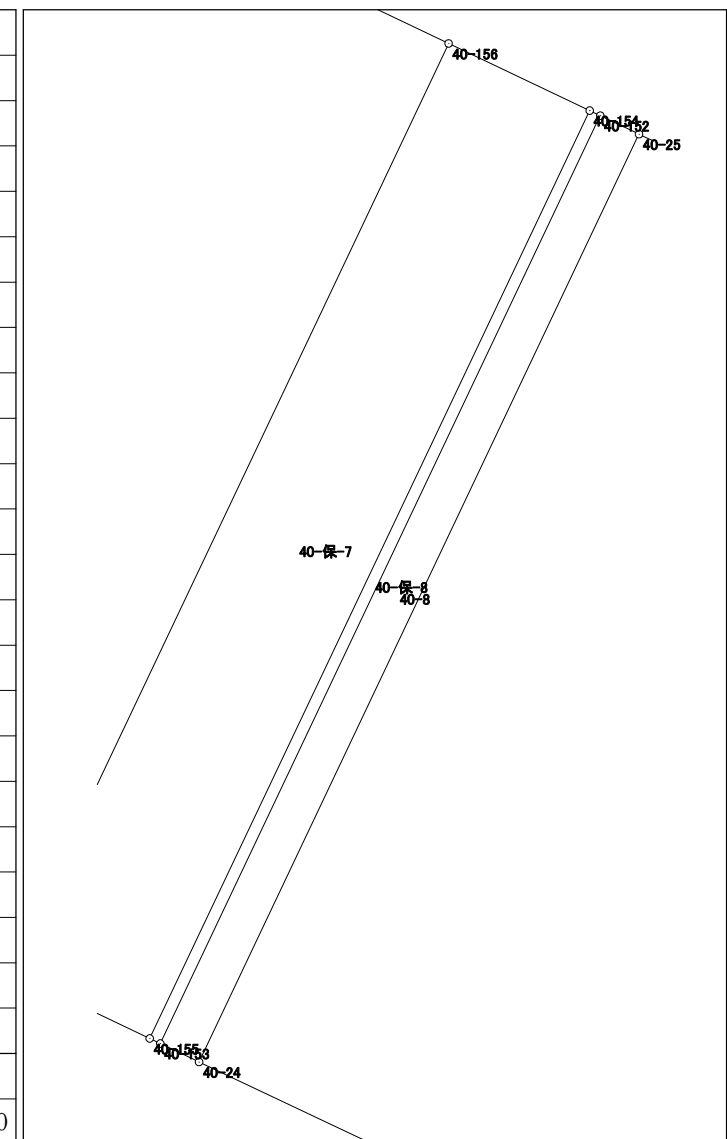


面積計算書（座標法）

世界測地系（測地成果2011）

所在	地番	公簿地目	現況地目	地積	所有者
前橋市六供町二丁目	40-保-9			80.00 m ²	

点名	X座標	Y座標	辺長	方向角	測角	DX	倍積 (Y×DX)
40-26	41475.742	-68480.000	16.212	25-20-41	89-56-34	12.535	-858396.800000
40-27	41490.394	-68473.060	4.936	295-21-38	90-00-57	16.766	-1148019.323960
40-158	41492.508	-68477.520	16.209	205-20-35	89-58-57	-12.535	858365.713200
40-159	41477.859	-68484.458	4.935	115-24-07	90-03-32	-16.766	1148210.422828
倍面積							160.012068
面積							80.0060340

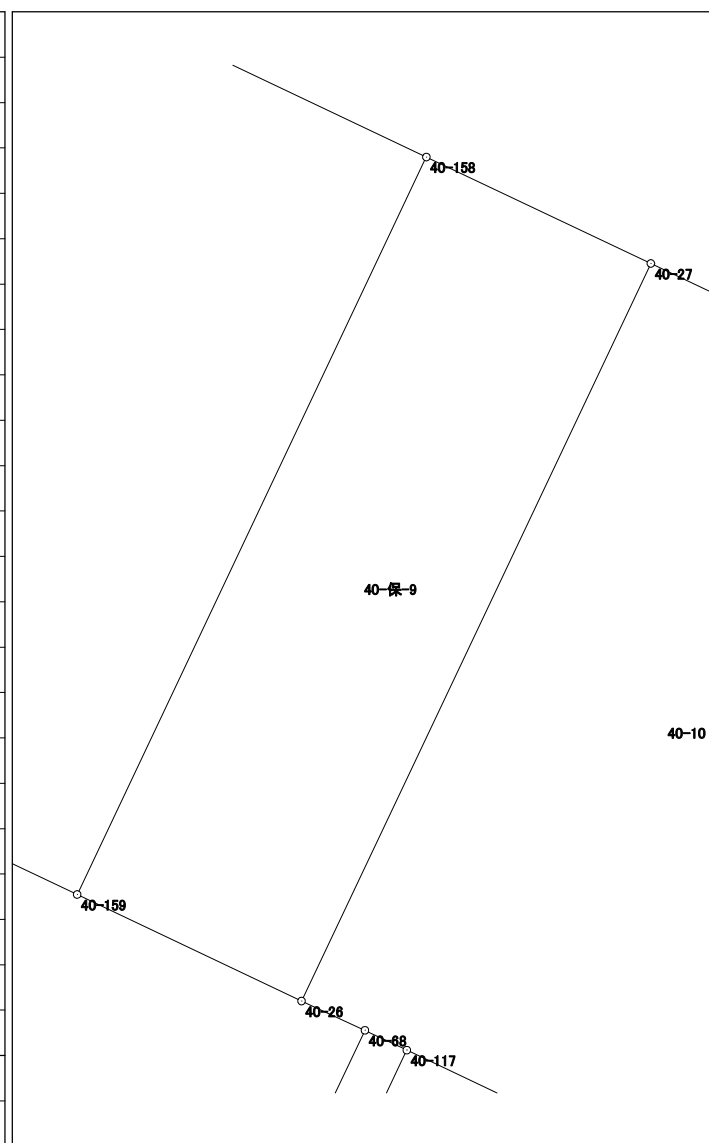


面積計算書（座標法）

世界測地系（測地成果2011）

所在	地番	公簿地目	現況地目	地積	所有者
前橋市六供町二丁目	40-保-10			35.00 m ²	

点名	X座標	Y座標	辺長	方向角	測角	DX	倍積 (Y×DX)
40-29	41484.312	-68460.230	5.020	205-50-25	90-28-21	-3.601	246525.288230
40-166	41479.794	-68462.418	11.176	205-09-26	179-19-01	-14.634	1001879.025012
40-28	41469.678	-68467.169	0.760	115-23-08	90-13-42	-10.442	714934.178698
40-115	41469.352	-68466.482	1.380	115-23-44	180-00-36	-0.918	62852.230476
40-162	41468.760	-68465.235	16.197	25-22-03	89-58-19	14.043	-961457.295105
40-163	41483.395	-68458.296	2.140	295-22-04	90-00-01	15.552	-1064663.419392
倍面積						70.007919	
面積						35.0039595	

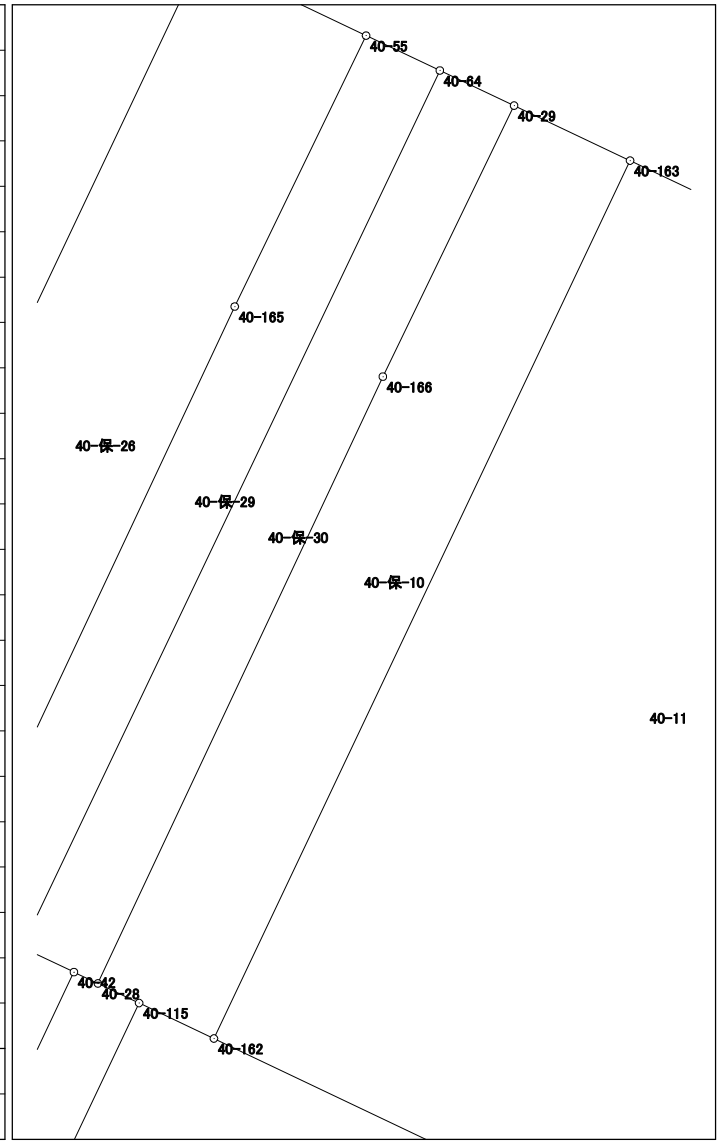


面積計算書 (座標法)

世界測地系 (測地成果2011)

所在	地番	公簿地目	現況地目	地積	所有者
前橋市六供町二丁目	40-保-11			21.00 m ²	

点名	X座標	Y座標	辺長	方向角	測角	Dx	倍積 (Y×Dx)
40-31	41479.798	-68450.706	16.203	205-22-04	90-00-32	-14.086	964196.644716
40-30	41465.157	-68457.648	1.296	115-39-19	90-17-15	-15.202	1040693.164896
40-166	41464.596	-68456.480	16.210	25-22-06	89-42-47	14.086	-964277.977280
40-167	41479.243	-68449.535	1.296	295-21-32	89-59-26	15.202	-1040569.831070
						倍面積	42.001262
						面積	21.0006310

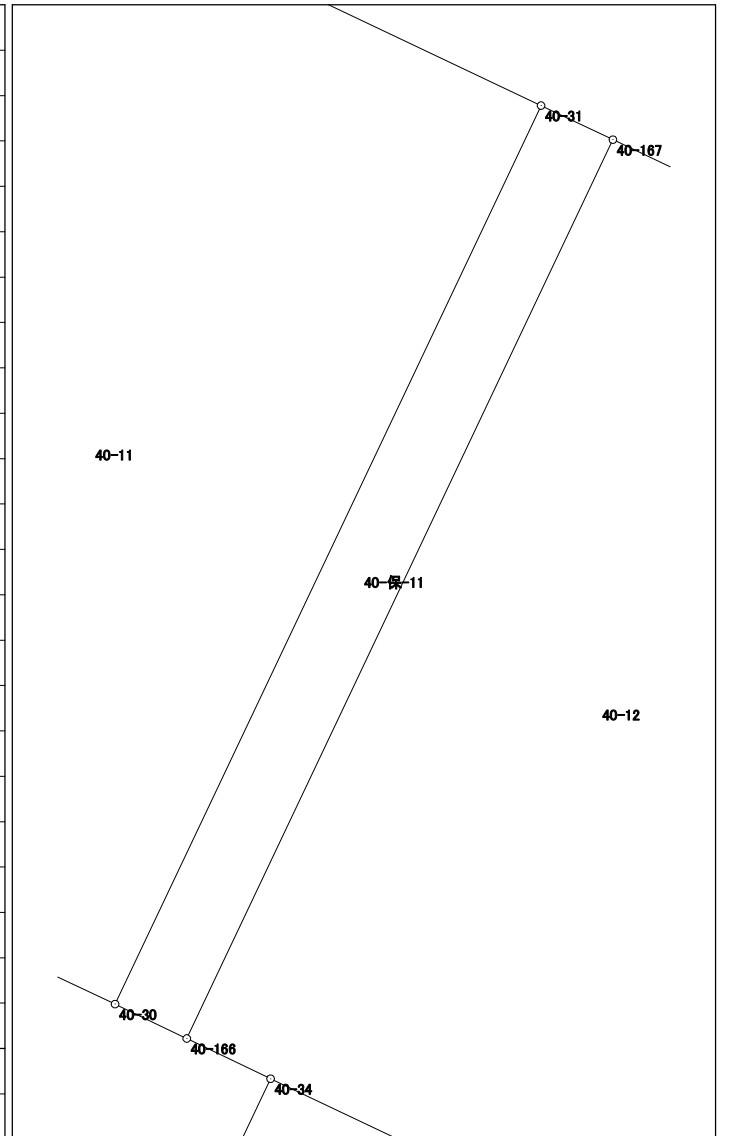


面積計算書（座標法）

世界測地系（測地成果2011）

所 在	地 番	公簿地目	現況地目	地 積	所 有 者
前橋市六供町二丁目	40-保-14			41.00 m ²	

点 名	X 座標	Y 座標	辺 長	方 向 角	測 角	DX	倍 積 (Y×DX)
40-34	41463.941	-68455.114	2.283	205-23-51	90-03-17	1.043	-71398.683902
40-112	41461.879	-68456.093	18.824	115-20-29	89-56-38	-10.119	692707.205067
40-113	41453.822	-68439.080	2.856	348-23-14	53-02-45	-5.259	359921.121720
40-53	41456.620	-68439.655	9.851	295-20-23	126-57-09	7.014	-480035.740170
40-164	41460.836	-68448.558	7.254	295-20-34	180-00-11	7.321	-501111.893118
						倍面積	82.009597
						面 積	41.0047985

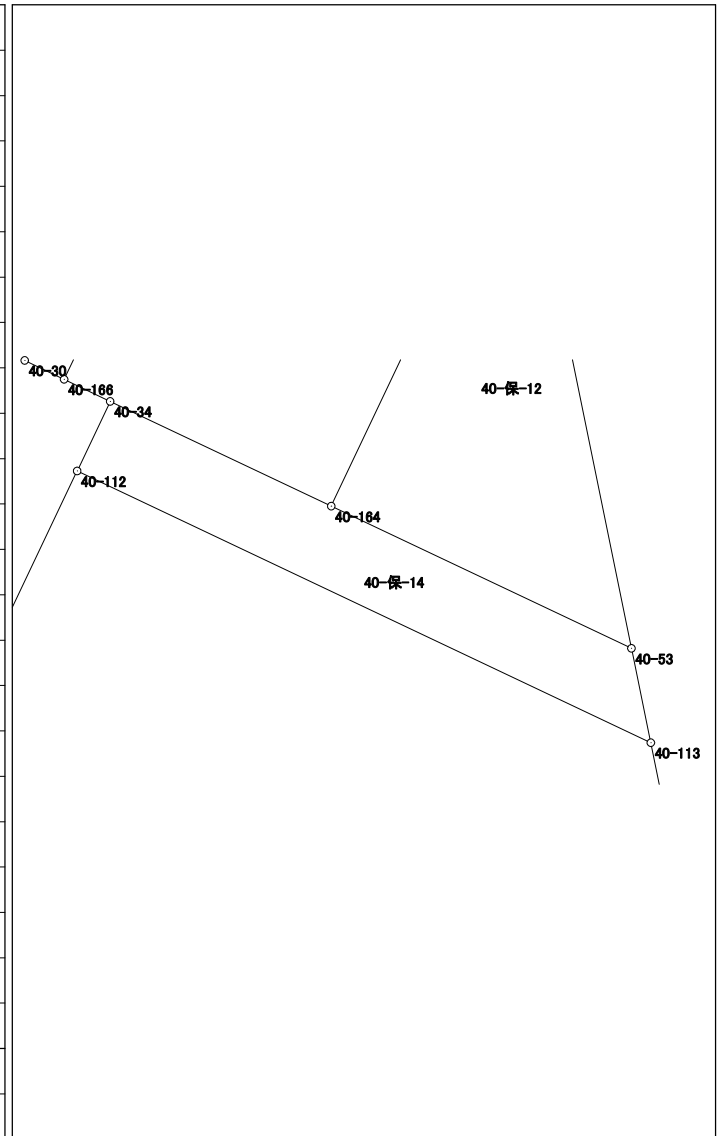


面積計算書 (座標法)

世界測地系 (測地成果2011)

所在	地番	公簿地目	現況地目	地積	所有者
前橋市六供町二丁目	40-保-15			21.00 m ²	

点名	X座標	Y座標	辺長	方向角	測角	DX	倍積 (Y×DX)
40-106	41444.542	-68442.534	8.806	205-23-01	89-58-53	-6.935	474648.973290
40-37	41436.586	-68446.309	2.372	117-06-58	91-43-57	-9.037	618549.294433
40-107	41435.505	-68444.198	8.877	25-26-42	88-19-44	6.935	-474660.513130
40-108	41443.521	-68440.384	2.380	295-24-08	89-57-26	9.037	-618495.750208
						倍面積	42.004385
						面積	21.0021925

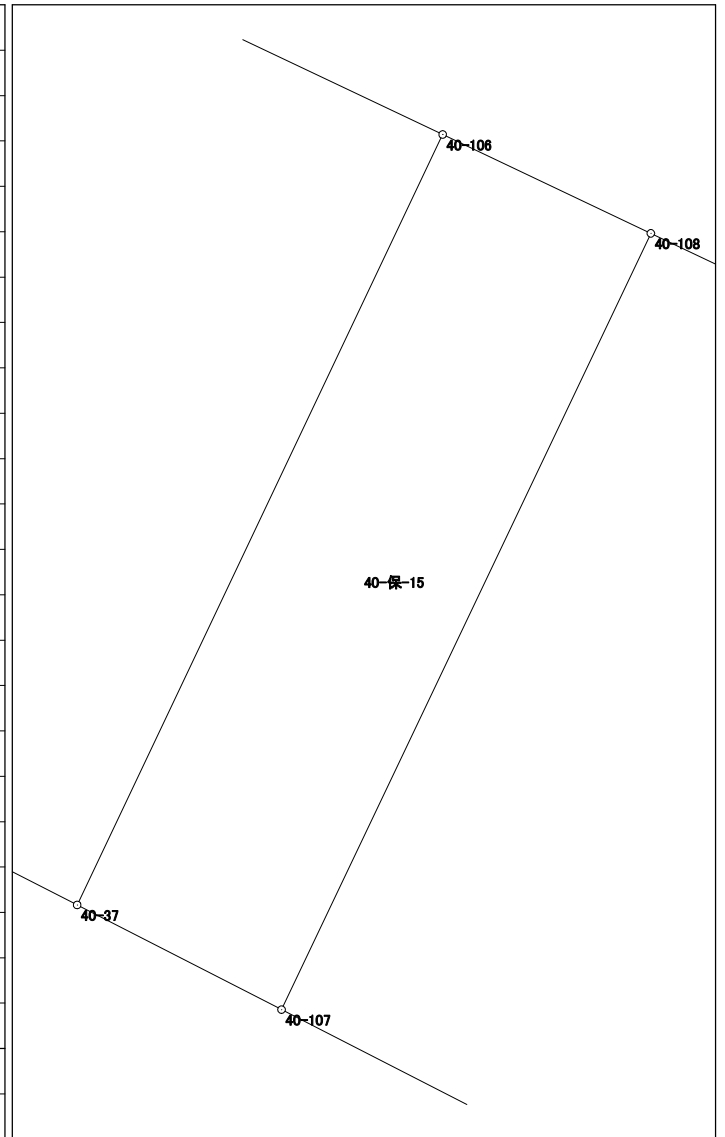


面積計算書 (座標法)

世界測地系 (測地成果2011)

所 在	地 番	公簿地目	現況地目	地 積	所 有 者
前橋市六供町二丁目	40-保-16			20.00 m ²	

点 名	X 座標	Y 座標	辺 長	方 向 角	測 角	DX	倍 積 (Y×DX)
40-103	41448.696	-68451.290	8.503	205-23-01	90-00-30	-6.676	456980.812040
40-39	41441.014	-68454.935	2.338	117-10-44	91-47-43	-8.750	598980.681250
40-104	41439.946	-68452.855	8.576	25-27-13	88-16-29	6.676	-456991.259980
40-105	41447.690	-68449.169	2.347	295-22-31	89-55-18	8.750	-598930.228750
倍面積							40.004560
面 積							20.0022800

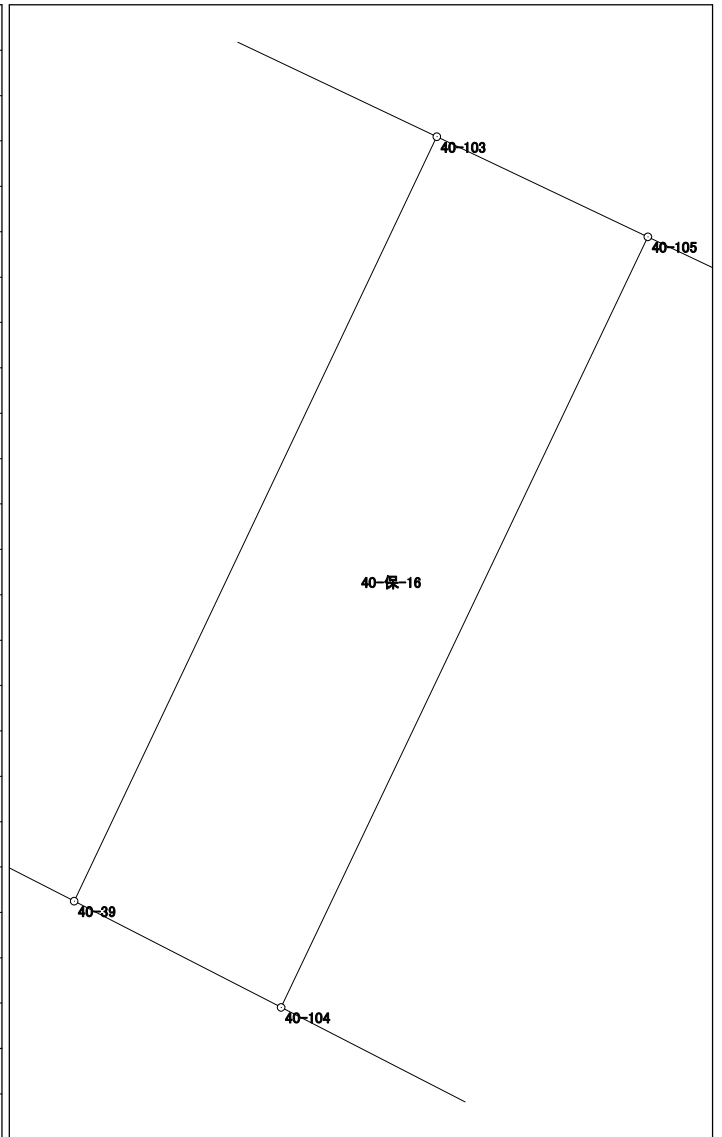


面積計算書 (座標法)

世界測地系 (測地成果2011)

所在	地番	公簿地目	現況地目	地積	所有者
前橋市六供町二丁目	40-保-29			22.12 m ²	

点名	X座標	Y座標	辺長	方向角	測角	DX	倍積 (Y×DX)
40-55	41485.479	-68462.698	5.020	205-51-57	90-32-37	-3.935	269400.716630
40-165	41480.962	-68464.888	11.177	205-09-43	179-17-46	-14.633	1001846.706104
40-54	41470.846	-68469.640	1.329	115-07-07	89-57-24	-10.680	731255.755200
40-65	41470.282	-68468.437	16.192	25-29-37	90-22-30	14.051	-962050.008287
40-64	41484.897	-68461.468	1.361	295-19-20	89-49-43	15.197	-1040408.929196

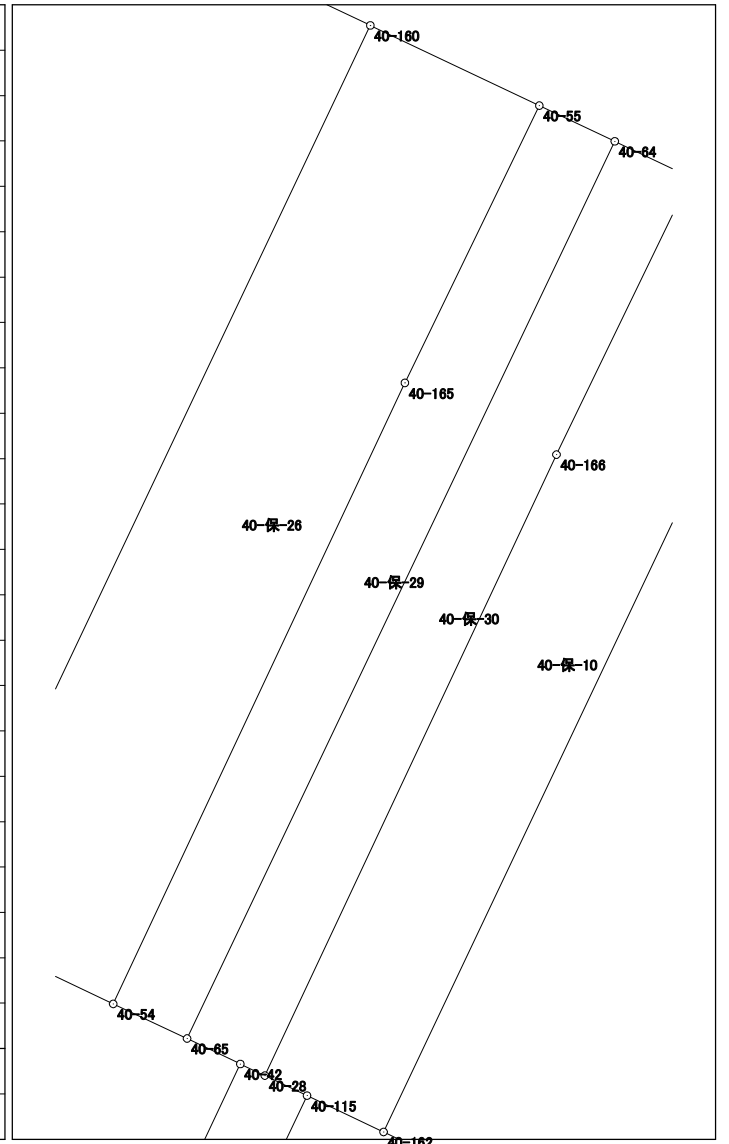


倍面積	44.240451
面積	22.1202255

面積計算書 (座標法)

世界測地系 (測地成果2011)

所 在	地 番	公簿地目	現況地目	地 積	所 有 者
前橋市六供町二丁目	40-保-30			22.12 m ²	

点 名	X 座標	Y 座標	辺 長	方 向 角	測 角	DX	倍 積 (Y×DX)
40-64	41484.897	-68461.468	16.192	205-29-37	90-12-04	-14.030	960514.396040
40-65	41470.282	-68468.437	0.962	115-33-11	90-03-34	-15.030	1029080.608110
40-42	41469.867	-68467.569	0.442	115-17-27	179-44-16	-0.604	41354.411676
40-28	41469.678	-68467.169	11.176	25-09-26	89-51-59	9.927	-679673.586663
40-166	41479.794	-68462.418	5.020	25-50-25	180-40-59	14.634	-1001879.025012
40-29	41484.312	-68460.230	1.369	295-17-33	89-27-08	5.103	-349352.553690
倍面積						44.250461	
面 積						22.1252305	

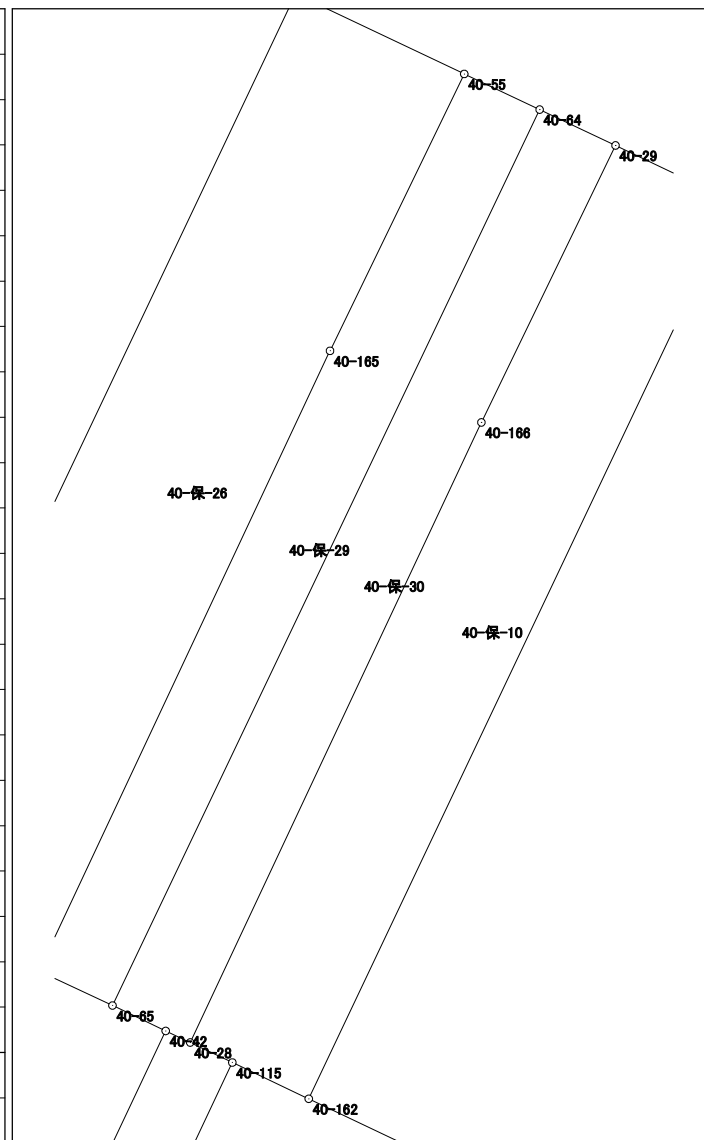


面積計算書 (座標法)

世界測地系 (測地成果2011)

所在	地番	公簿地目	現況地目	地積	所有者
前橋市六供町二丁目	40-保-31			18.00 m ²	

点名	X座標	Y座標	辺長	方向角	測角	D _X	倍積 (Y×D _X)
40-68	41475.161	-68478.740	19.542	205-23-01	90-02-36	-17.261	1182011.531140
40-69	41457.506	-68487.117	0.921	117-12-18	91-49-17	-18.076	1237973.126892
40-116	41457.085	-68486.298	19.572	25-23-03	88-10-45	17.261	-1182141.989778
40-117	41474.767	-68477.908	0.921	295-20-25	89-57-22	18.076	-1237806.665008
						倍面積	36.003246
						面積	18.0016230

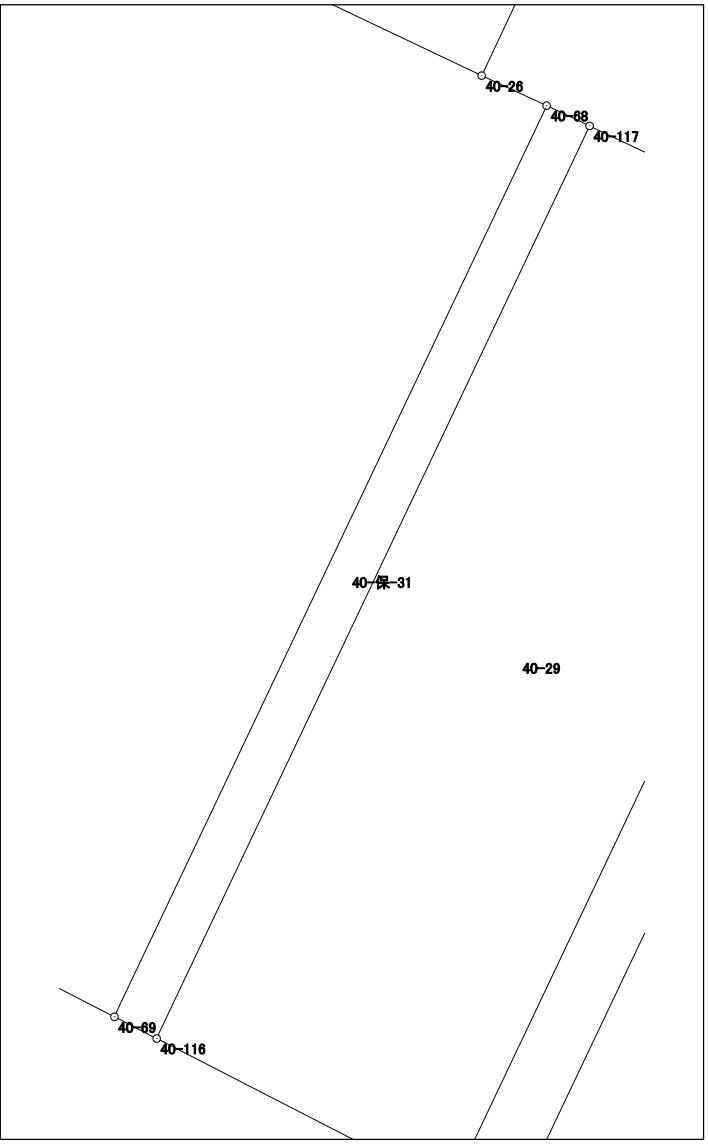

面積計算書 (座標法)

世界測地系 (測地成果2011)

所在	地番	公簿地目	現況地目	地積	所有者
前橋市六供町二丁目	40-保-32			25.00 m ²	

点名	X座標	Y座標	辺長	方向角	測角	D _X	倍積 (Y×DX)
40-119	41472.023	-68472.121	19.773	205-22-59	89-59-38	-17.322	1186074.079962
40-118	41454.159	-68480.597	1.263	117-10-25	91-47-26	-18.441	1262850.689277
40-120	41453.582	-68479.473	19.812	25-23-12	88-12-47	17.322	-1186201.431306
40-121	41471.481	-68470.979	1.264	295-23-21	90-00-09	18.441	-1262673.323739

倍面積	50.014194
面積	25.0070970

