



46-1街区 画地出来形確認図 (3116.12m²)

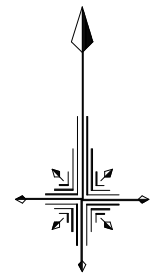


S=1/500

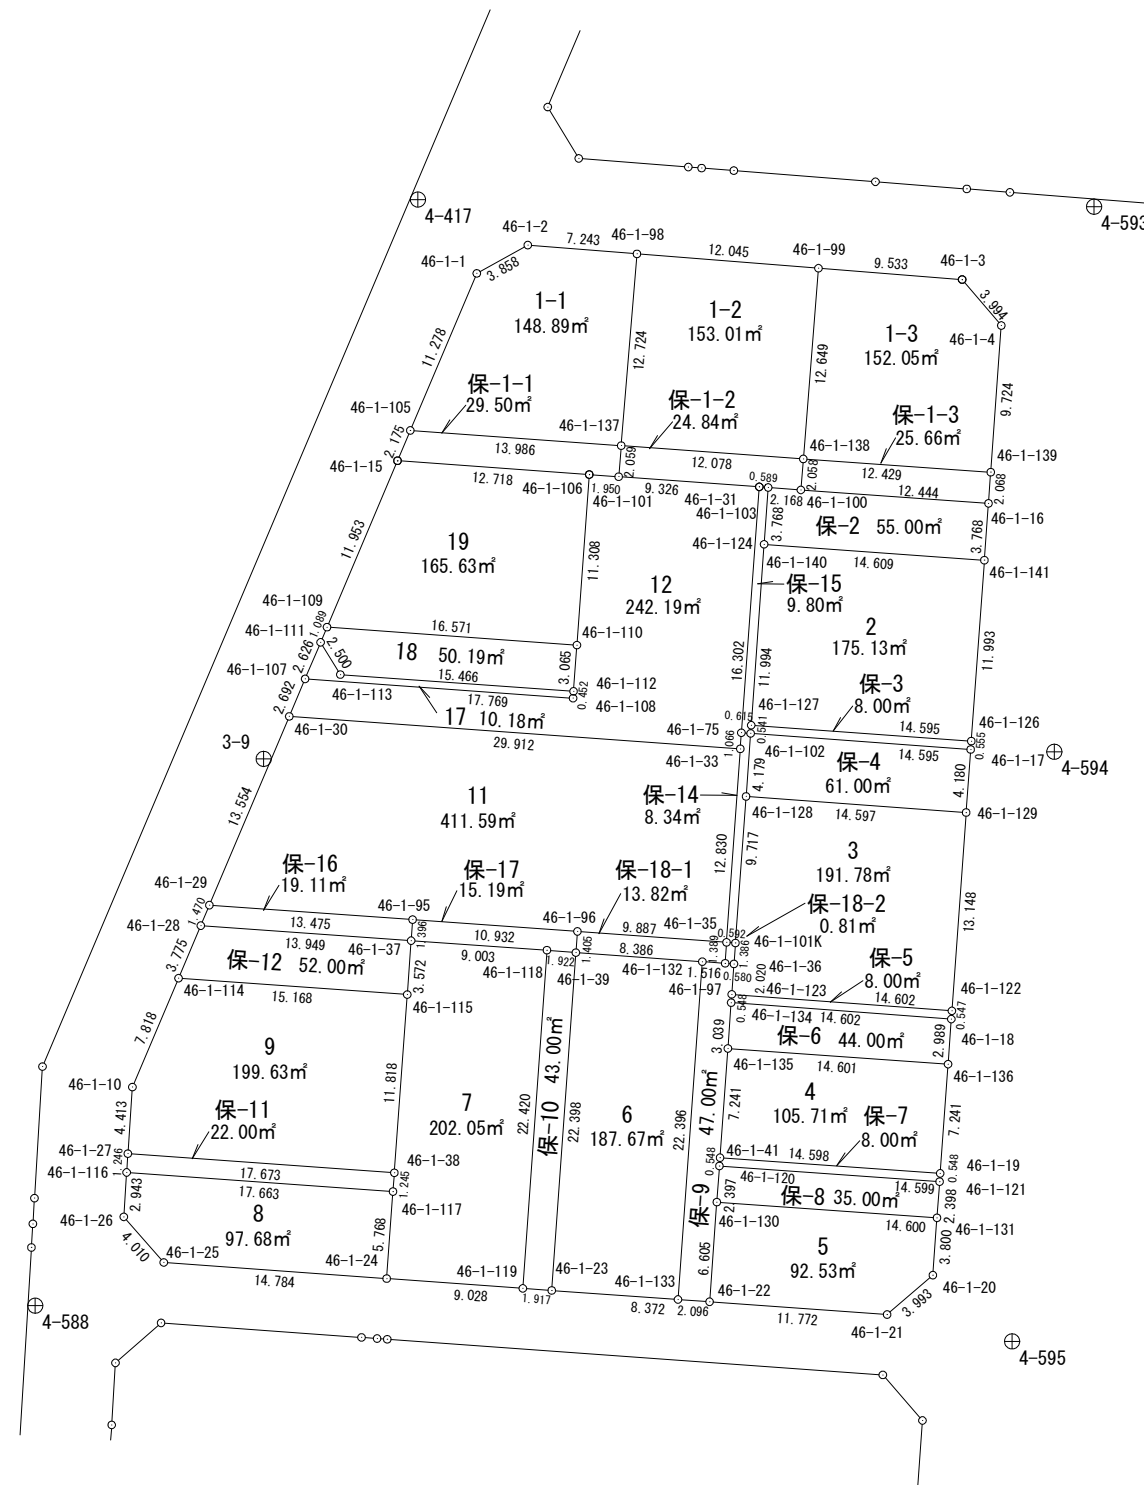

面積計算書 (座標法)

所在	地番	公簿地目	現況地目	地積	所有者
前橋市六供町二丁目	46-1-1-1			148.89 m ²	

点名	X座標	Y座標	辺長	方向角	測角	Dx	倍積 (Y×Dx)
46-1-1	41421.650	-68640.006	11.278	202-56-28	141-57-04	-12.257	841320.553542
46-1-105	41411.264	-68644.402	13.986	94-07-29	71-11-01	-11.392	781997.027584
46-1-137	41410.258	-68630.452	12.724	4-41-19	90-33-50	11.675	-801260.527100
46-1-98	41422.939	-68629.412	7.243	274-36-31	89-55-12	13.263	-910231.891356
46-1-2	41423.521	-68636.632	3.858	240-59-24	146-22-53	-1.289	88472.618648

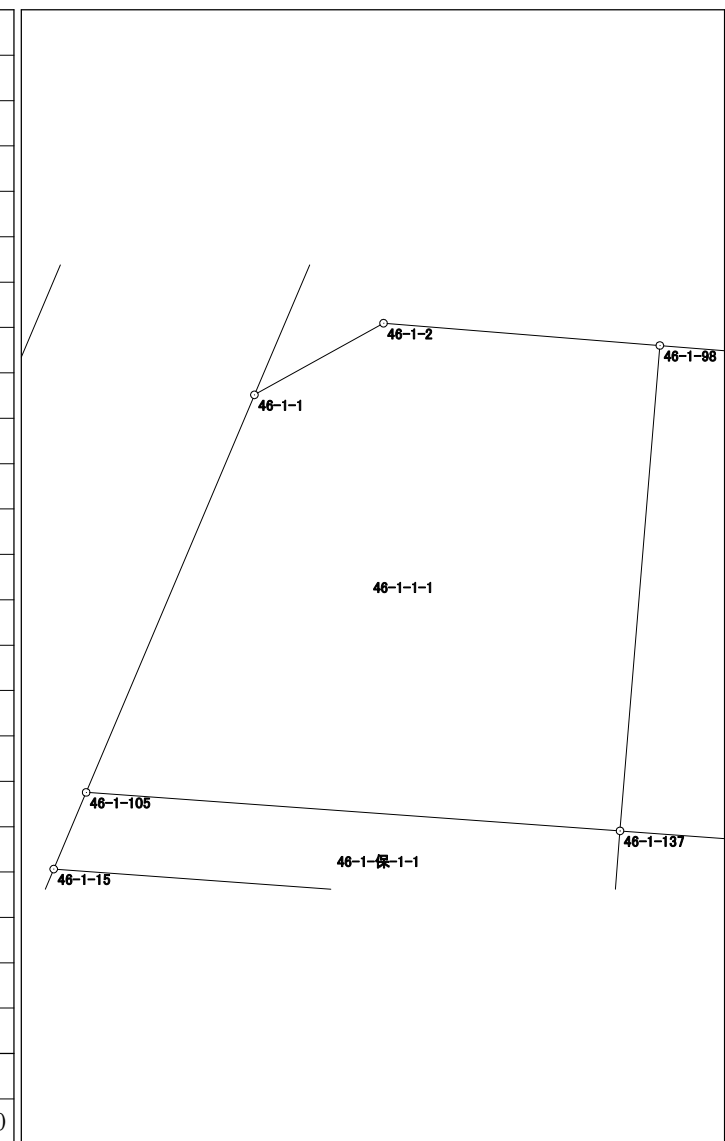


倍面積	297.781318
面積	148.8906590

面積計算書（座標法）

世界測地系（測地成果2011）

所在	地番	公簿地目	現況地目	地積	所有者
前橋市六供町二丁目	46-1-1-2			153.01 m ²	

点名	X座標	Y座標	辺長	方向角	測角	DX	倍積 (Y×DX)
46-1-137	41410.258	-68630.452	12.078	94-09-51	89-28-32	-13.558	930491.668216
46-1-138	41409.381	-68618.406	12.649	4-32-37	90-22-46	11.732	-805031.139192
46-1-99	41421.990	-68617.404	12.045	274-31-07	89-58-30	13.558	-930314.763432
46-1-98	41422.939	-68629.412	12.724	184-41-19	90-10-12	-11.732	805160.261584
						倍面積	306.027176
						面積	153.0135880

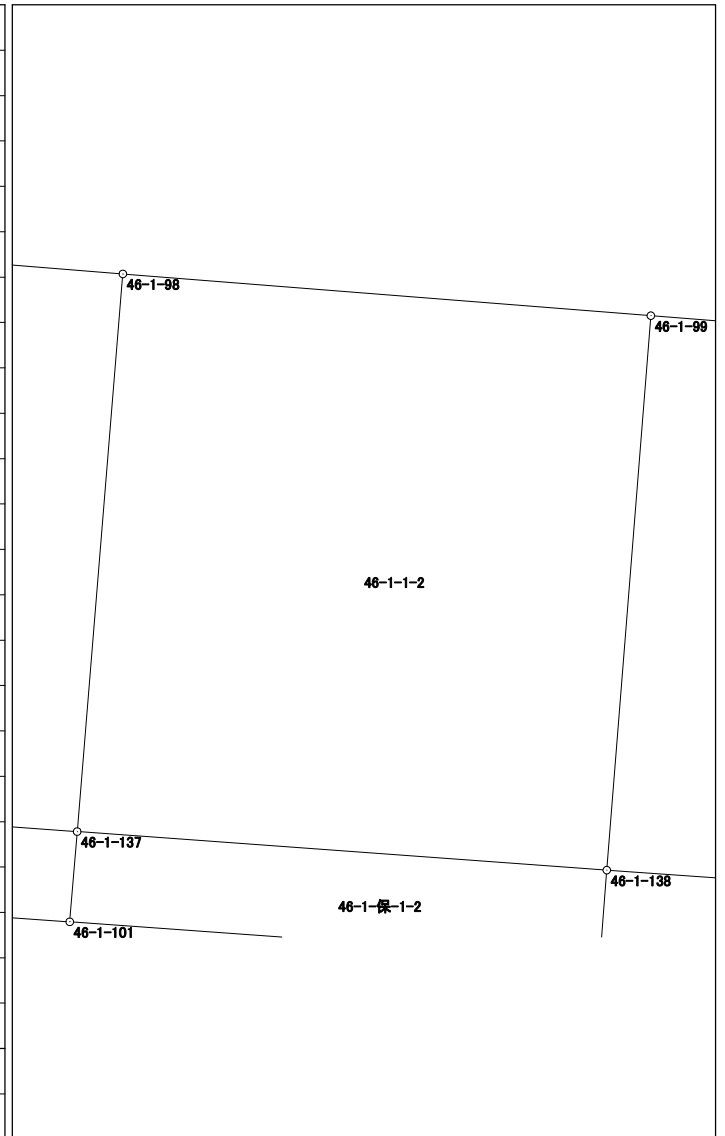

面積計算書（座標法）

世界測地系（測地成果2011）

所 在	地 番	公簿地目	現況地目	地 積	所 有 者
前橋市六供町二丁目	46-1-1-3			152.05 m ²	


点 名	X 座標	Y 座標	辺 長	方 向 角	測 角	DX	倍 積 (Y×DX)						
46-1-138	41409.381	-68618.406	12.429	94-03-03	89-30-26	-13.487	925456.441722						
46-1-139	41408.503	-68606.008	9.724	4-06-59	90-03-56	8.821	-605173.596568						
46-1-4	41418.202	-68605.310	3.994	319-34-45	135-27-46	12.740	-874031.649400						
46-1-3	41421.243	-68607.900	9.533	274-29-39	134-54-54	3.788	-259886.725200						
46-1-99	41421.990	-68617.404	12.649	184-32-37	90-02-58	-11.862	813939.646248						
							倍面積				304.116802		
							面 積	152.0584010					

面積計算書 (座標法)

世界測地系 (測地成果2011)

所在	地番	公簿地目	現況地目	地積	所有者
前橋市六供町二丁目	46-1-2			175.13 m ²	

点名	X座標	Y座標	辺長	方向角	測角	DX	倍積 (Y×DX)
46-1-140	41403.733	-68621.000	11.994	184-04-24	89-56-52	-10.913	748860.973000
46-1-127	41391.769	-68621.852	14.595	94-07-18	90-02-54	-13.013	892976.160076
46-1-126	41390.720	-68607.295	11.993	4-08-27	90-01-09	10.913	-748711.410335
46-1-141	41402.682	-68606.429	14.609	274-07-32	89-59-05	13.013	-892775.460577

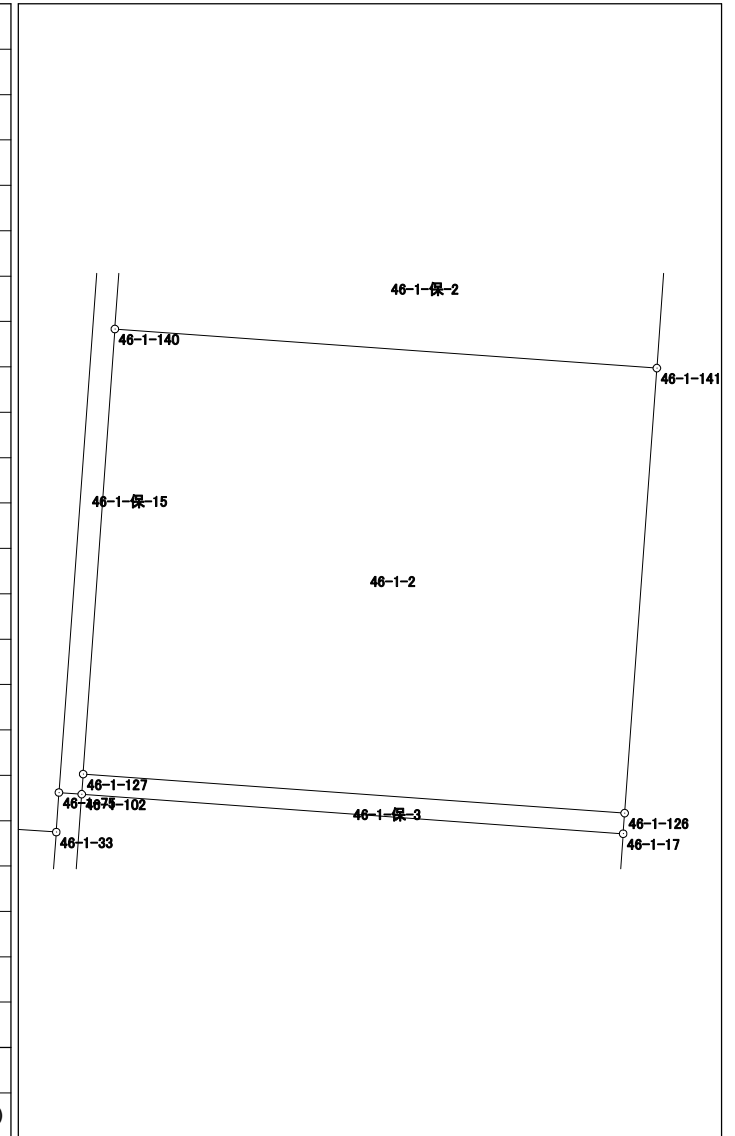

倍面積	350.262164
面積	175.1310820

面積計算書（座標法）

世界測地系（測地成果2011）

所 在	地 番	公簿地目	現況地目	地 積	所 有 者
前橋市六供町二丁目	46-1-4			105.71 m ²	

点 名	X 座標	Y 座標	辺 長	方 向 角	測 角	DX	倍 積 (Y×DX)	
46-1-135	41370.394	-68623.396	7.241	184-06-38	90-02-02	-6.184	424367.080864	
46-1-41	41363.172	-68623.915	14.598	94-04-39	89-58-01	-8.260	566833.537900	
46-1-19	41362.134	-68609.354	7.241	4-08-03	90-03-24	6.184	-424280.245136	
46-1-136	41369.356	-68608.832	14.601	274-04-36	89-56-33	8.260	-566708.952320	
						倍面積	211.421308	
						面 積	105.7106540	


面積計算書 (座標法)

世界測地系 (測地成果2011)

所在	地番	公簿地目	現況地目	地積	所有者
前橋市六供町二丁目	46-1-5			92.53 m ²	

点名	X座標	Y座標	辺長	方向角	測角	DX	倍積 (Y×DX)
46-1-130	41360.234	-68624.128	6.605	184-09-00	90-04-09	-5.549	380795.286272
46-1-22	41353.646	-68624.606	11.772	94-06-58	89-57-58	-7.433	510086.696398
46-1-21	41352.801	-68612.864	3.993	49-17-46	135-10-48	1.759	-120690.027776
46-1-20	41355.405	-68609.837	3.800	4-06-18	134-48-32	6.394	-438691.297778
46-1-131	41359.195	-68609.565	14.600	274-04-51	89-58-33	4.829	-331315.589385

倍面積	185.067731
面積	92.5338655

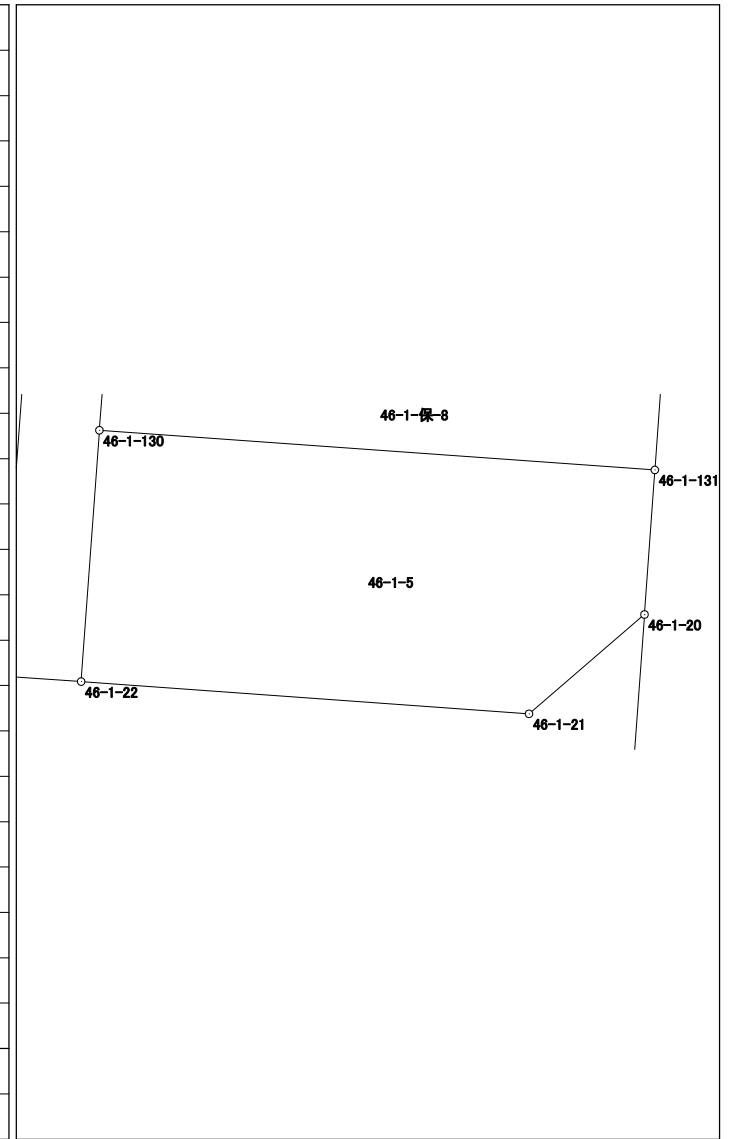


面積計算書 (座標法)

世界測地系 (測地成果2011)

所 在	地 番	公簿地目	現況地目	地 積	所 有 者
前橋市六供町二丁目	46-1-7			202.05 m ²	

点 名	X 座標	Y 座標	辺 長	方 向 角	測 角	DX	倍 積 (Y×DX)
46-1-118	41376.893	-68635.366	9.003	274-00-45	89-56-08	22.993	-1578132.970438
46-1-37	41377.523	-68644.347	3.572	184-08-30	90-07-45	-2.933	201333.869751
46-1-115	41373.960	-68644.605	11.818	184-08-21	179-59-51	-15.350	1053694.686750
46-1-38	41362.173	-68645.458	1.245	184-08-41	180-00-20	-13.029	894381.672282
46-1-117	41360.931	-68645.548	5.768	184-08-45	180-00-04	-6.995	480175.608260
46-1-24	41355.178	-68645.965	9.028	94-06-57	89-58-12	-6.401	439402.821965
46-1-119	41354.530	-68636.960	22.420	4-04-37	89-57-40	21.715	-1490451.586400
						倍面積	404.102170
						面 積	202.0510850

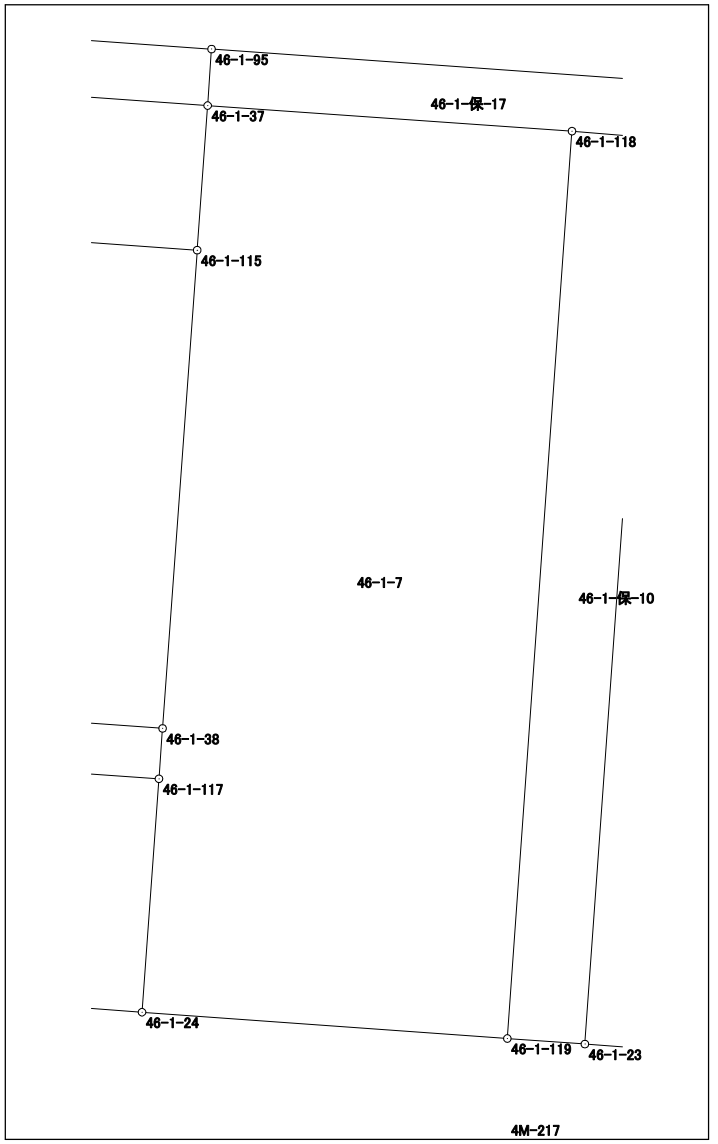


面積計算書 (座標法)

世界測地系 (測地成果2011)

所在	地番	公簿地目	現況地目	地積	所有者
前橋市六供町二丁目	46-1-8			97.68 m ²	

点名	X座標	Y座標	辺長	方向角	測角	DX	倍積 (Y×DX)
46-1-116	41362.197	-68663.166	2.943	183-39-45	89-33-09	-1.671	114736.150386
46-1-26	41359.260	-68663.354	4.010	138-46-16	135-06-31	-5.953	408752.946362
46-1-25	41356.244	-68660.711	14.784	94-08-05	135-21-49	-4.082	280273.022302
46-1-24	41355.178	-68645.965	5.768	4-08-45	90-00-40	4.687	-321743.637955
46-1-117	41360.931	-68645.548	17.663	274-06-36	89-57-51	7.019	-481823.101412

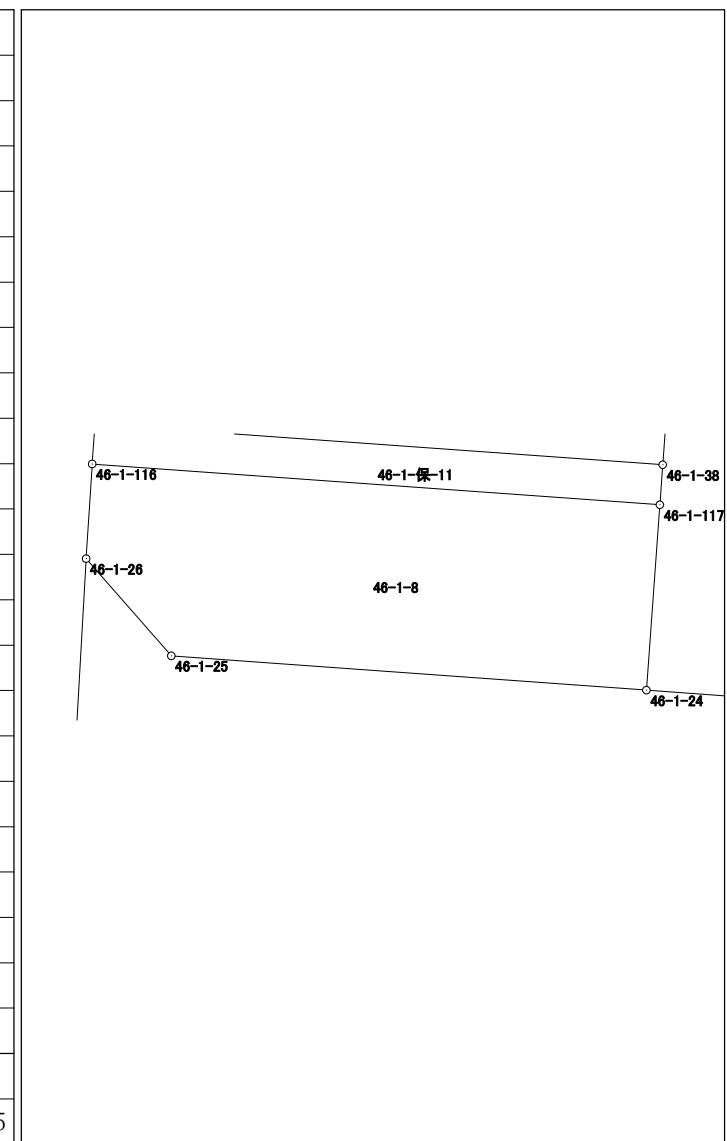


倍面積	195.379683
面積	97.6898415

面積計算書 (座標法)

世界測地系 (測地成果2011)

所 在	地 番	公簿地目	現況地目	地 積	所 有 者
前橋市六供町二丁目	46-1-9			199.63 m ²	

点 名	X 座標	Y 座標	辺 長	方 向 角	測 角	D _X	倍 積 (Y×DX)
46-1-114	41375.041	-68659.734	7.818	202-58-14	108-53-01	-6.117	419991.592878
46-1-10	41367.843	-68662.785	4.413	183-54-39	160-56-25	-11.601	796556.968785
46-1-27	41363.440	-68663.086	17.673	94-06-40	90-12-01	-5.670	389319.697620
46-1-38	41362.173	-68645.458	11.818	4-08-21	90-01-41	10.520	-722150.218160
46-1-115	41373.960	-68644.605	15.168	274-05-13	89-56-52	12.868	-883318.777140
						倍面積	399.263983
						面 積	199.6319915

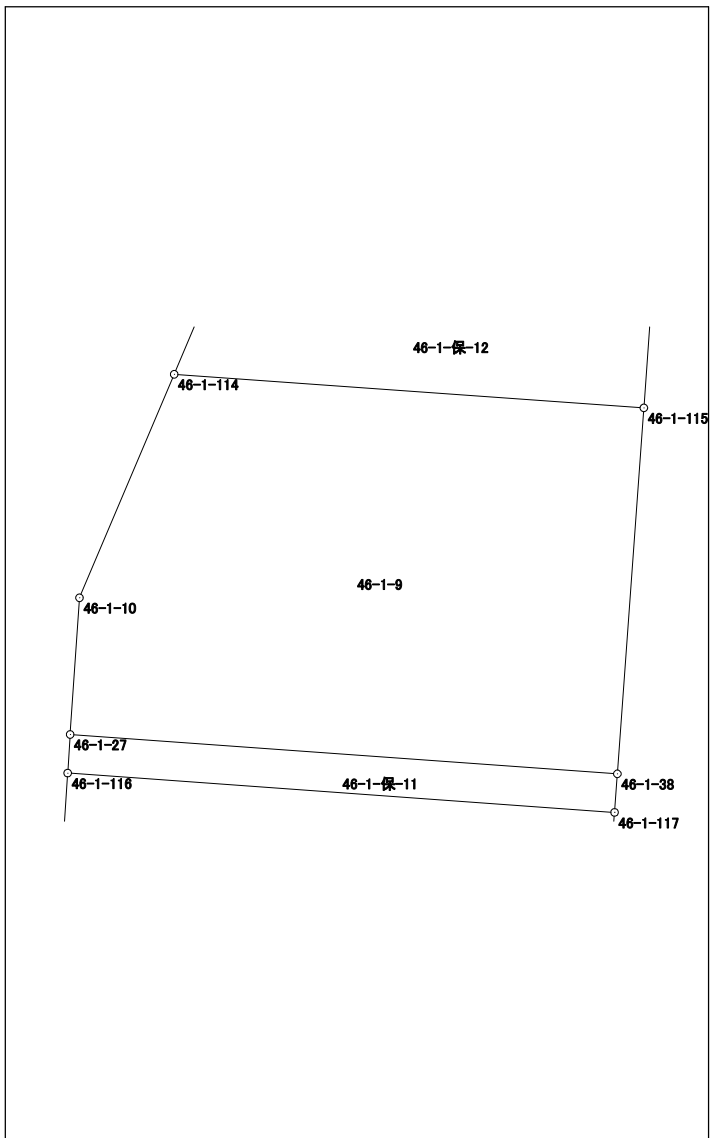

面積計算書（座標法）

世界測地系（測地成果2011）

所在	地番	公簿地目	現況地目	地積	所有者
前橋市六供町二丁目	46-1-11			411.59 m ²	


点名	X座標	Y座標	辺長	方向角	測角	DX	倍積 (Y×DX)	
46-1-29	41379.872	-68657.692	13.475	94-04-06	71-07-40	-13.438	922622.065096	
46-1-95	41378.916	-68644.251	10.932	94-05-49	180-01-43	-1.737	119235.063987	
46-1-96	41378.135	-68633.347	9.887	94-11-36	180-05-47	-1.504	103224.553888	
46-1-35	41377.412	-68623.486	12.830	4-04-34	89-52-58	12.075	-828628.593450	
46-1-33	41390.210	-68622.574	29.912	274-06-37	90-02-03	14.942	-1025358.500708	
46-1-30	41392.354	-68652.409	13.554	202-56-26	108-49-49	-10.338	709728.604242	
						倍面積	823.193055	
						面積	411.5965275	

面積計算書（座標法）

世界測地系（測地成果2011）

所在	地番	公簿地目	現況地目	地積	所有者
前橋市六供町二丁目	46-1-12			242.19 m ²	

点名	X座標	Y座標	辺長	方向角	測角	DX	倍積 (Y×DX)
46-1-107	41394.833	-68651.360	2.692	202-56-09	108-49-27	-1.205	82724.888800
46-1-30	41392.354	-68652.409	29.912	94-06-37	71-10-28	-4.623	317380.086807
46-1-33	41390.210	-68622.574	1.066	3-45-51	89-39-14	-1.080	74112.379920
46-1-75	41391.274	-68622.504	16.302	4-10-19	180-24-28	17.323	-1188747.636792
46-1-31	41407.533	-68621.318	9.326	274-08-17	89-57-58	16.932	-1161896.156376
46-1-101	41408.206	-68630.620	1.950	274-05-16	179-56-59	0.812	-55728.063440
46-1-106	41408.345	-68632.565	11.308	184-08-54	90-03-38	-11.139	764498.141535
46-1-110	41397.067	-68633.383	3.065	184-08-06	179-59-12	-14.335	983859.545305
46-1-112	41394.010	-68633.604	0.452	184-11-06	180-03-00	-3.508	240766.682832
46-1-108	41393.559	-68633.637	17.769	274-06-42	269-55-36	0.823	-56485.483251

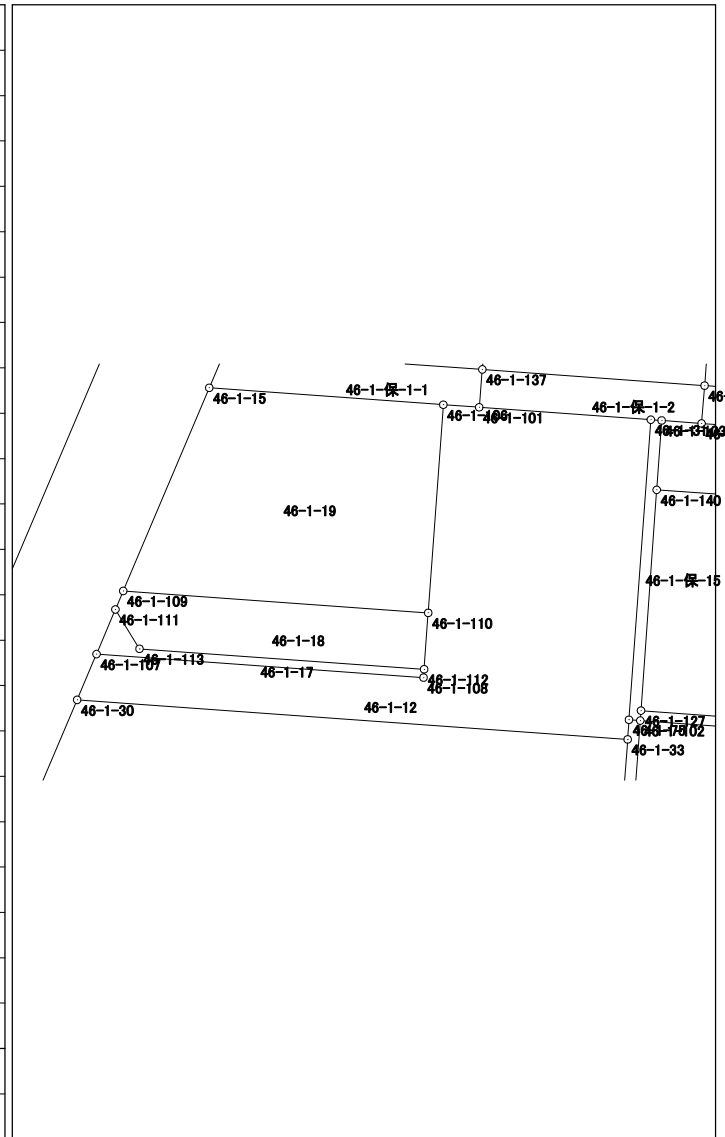


倍面積	484.385340
面積	242.1926700

面積計算書（座標法）

世界測地系（測地成果2011）

所 在	地 番	公簿地目	現況地目	地 積	所 有 者
前橋市六供町二丁目	46-1-17			10.18 m ²	

点 名	X 座標	Y 座標	辺 長	方 向 角	測 角	Dx	倍 積 (Y×Dx)
46-1-111	41397.251	-68650.336	2.626	202-57-08	54-26-33	-0.286	19633.996096
46-1-107	41394.833	-68651.360	17.769	94-06-42	71-09-34	-3.692	253460.821120
46-1-108	41393.559	-68633.637	0.452	4-11-06	90-04-24	-0.823	56485.483251
46-1-112	41394.010	-68633.604	15.466	274-06-43	89-55-37	1.560	-107068.422240
46-1-113	41395.119	-68649.030	2.500	328-30-35	234-23-52	3.241	-222491.506230
						倍面積	20.371997
						面 積	10.1859985

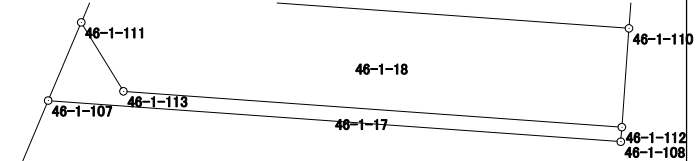


	倍面積	20.371997
	面 積	10.1859985

面積計算書 (座標法)

世界測地系 (測地成果2011)

所在	地番	公簿地目	現況地目	地積	所有者
前橋市六供町二丁目	46-1-18			50.19 m ²	

点名	X座標	Y座標	辺長	方向角	測角	DX	倍積 (Y×DX)
46-1-109	41398.254	-68649.911	1.089	202-57-50	108-51-22	0.184	-12631.583624
46-1-111	41397.251	-68650.336	2.500	148-30-35	125-32-45	-3.135	215218.803360
46-1-113	41395.119	-68649.030	15.466	94-06-43	125-36-08	-3.241	222491.506230
46-1-112	41394.010	-68633.604	3.065	4-08-06	90-01-23	1.948	-133698.260592
46-1-110	41397.067	-68633.383	16.571	274-06-28	89-58-22	4.244	-291280.077452

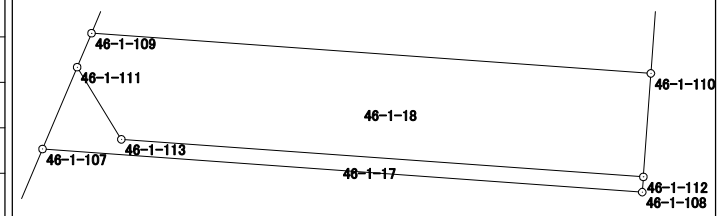


倍面積	100.387922
面積	50.1939610

面積計算書 (座標法)

世界測地系 (測地成果2011)

所在	地番	公簿地目	現況地目	地積	所有者
前橋市六供町二丁目	46-1-19			165.63 m ²	

点名	X座標	Y座標	辺長	方向角	測角	DX	倍積 (Y×DX)
46-1-15	41409.261	-68645.250	11.953	202-57-02	108-49-13	-10.091	692699.217750
46-1-109	41398.254	-68649.911	16.571	94-06-28	71-09-26	-12.194	837117.014734
46-1-110	41397.067	-68633.383	11.308	4-08-54	90-02-26	10.091	-692579.467853
46-1-106	41408.345	-68632.565	12.718	274-07-49	89-58-55	12.194	-836905.497610

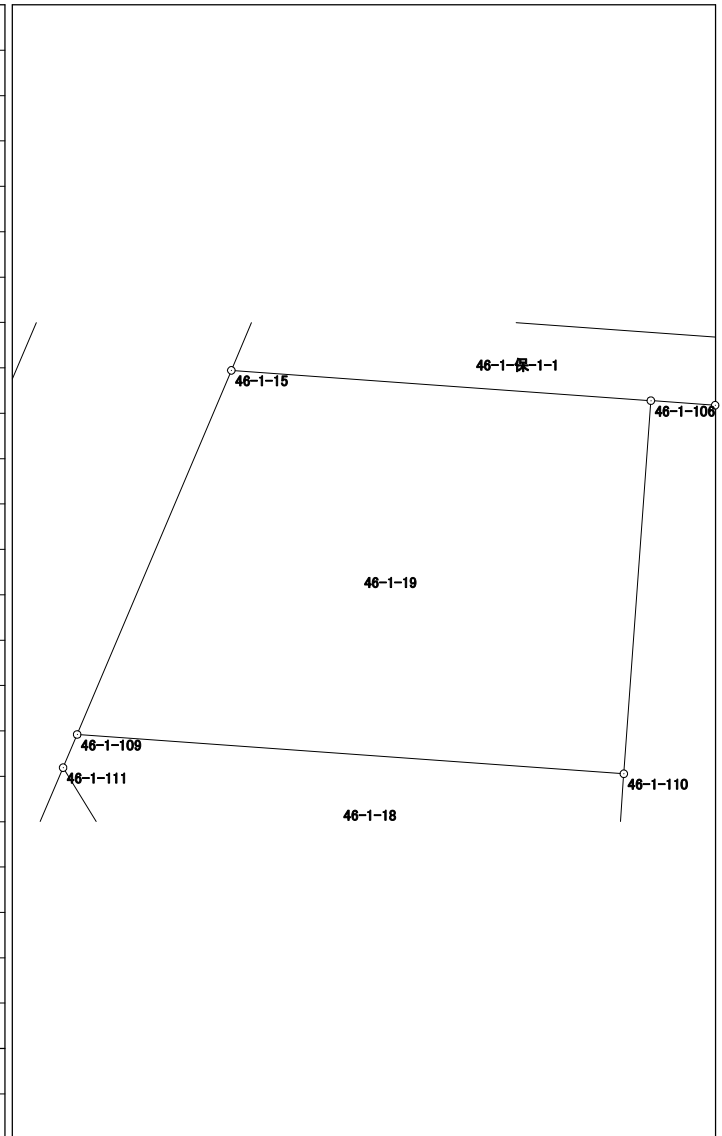


倍面積	331.267021
面積	165.6335105

面積計算書（座標法）

世界測地系（測地成果2011）

所 在	地 番	公簿地目	現況地目	地 積	所 有 者
前橋市六供町二丁目	46-1-保-1-1			29.50 m ²	


点 名	X 座標	Y 座標	辺 長	方 向 角	測 角	DX	倍 積 (Y×DX)
46-1-105	41411.264	-68644.402	2.175	202-56-46	108-49-17	-0.997	68438.468794
46-1-15	41409.261	-68645.250	12.718	94-07-49	71-11-03	-2.919	200375.484750
46-1-106	41408.345	-68632.565	1.950	94-05-16	179-57-27	-1.055	72407.356075
46-1-101	41408.206	-68630.620	2.059	4-40-50	90-35-34	1.913	-131290.376060
46-1-137	41410.258	-68630.452	13.986	274-07-29	89-26-39	3.058	-209871.922216
						倍面積	59.011343
						面 積	29.5056715

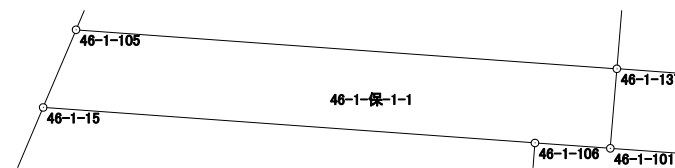

面積計算書（座標法）

世界測地系（測地成果2011）

所 在	地 番	公簿地目	現況地目	地 積	所 有 者
前橋市六供町二丁目	46-1-保-1-2			24.84 m ²	

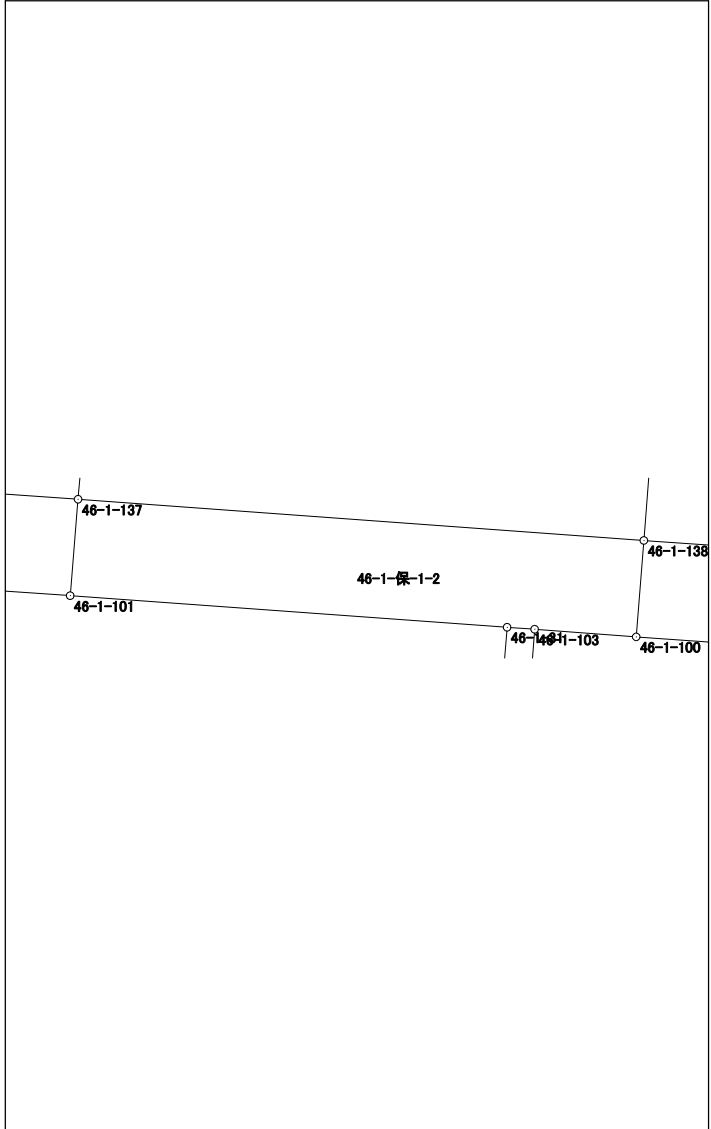点 名	X 座標	Y 座標	辺 長	方 向 角	測 角	DX	倍 積 (Y×DX)		
46-1-137	41410.258	-68630.452	2.059	184-40-50	90-30-59	-1.175	80640.781100		
46-1-101	41408.206	-68630.620	9.326	94-08-17	89-27-27	-2.725	187018.439500		
46-1-31	41407.533	-68621.318	0.589	94-05-33	179-57-16	-0.715	49064.242370		
46-1-103	41407.491	-68620.731	2.168	94-17-07	180-11-34	-0.204	13998.629124		
46-1-100	41407.329	-68618.569	2.058	4-32-30	90-15-23	1.890	-129689.095410		
46-1-138	41409.381	-68618.406	12.078	274-09-51	89-37-21	2.929	-200983.311174		
							倍面積		49.685510
							面 積		24.8427550

面積計算書 (座標法)

世界測地系 (測地成果2011)

所 在	地 番	公簿地目	現況地目	地 積	所 有 者
前橋市六供町二丁目	46-1-保-1-3			25.66 m ²	

点 名	X 座標	Y 座標	辺 長	方 向 角	測 角	DX	倍 積 (Y×DX)	
46-1-138	41409.381	-68618.406	2.058	184-32-30	90-29-27	-1.174	80558.008644	
46-1-100	41407.329	-68618.569	12.444	94-05-48	89-33-18	-2.941	201807.211429	
46-1-16	41406.440	-68606.157	2.068	4-07-52	90-02-04	1.174	-80543.628318	
46-1-139	41408.503	-68606.008	12.429	274-03-03	89-55-11	2.941	-201770.269528	
							倍面積	
							面 積	25.6611135

面積計算書（座標法）

世界測地系（測地成果2011）

所 在	地 番	公簿地目	現況地目	地 積	所 有 者
前橋市六供町二丁目	46-1-保-3			8.00 m ²	


点 名	X 座標	Y 座標	辺 長	方 向 角	測 角	DX	倍 積 (Y×DX)	
46-1-17	41390.166	-68607.335	0.555	4-07-47	89-57-11	-0.509	34921.133515	
46-1-126	41390.720	-68607.295	14.595	274-07-18	89-59-31	1.603	-109977.493885	
46-1-127	41391.769	-68621.852	0.541	184-07-51	90-00-33	0.509	-34928.522668	
46-1-102	41391.229	-68621.891	14.595	94-10-36	90-02-45	-1.603	110000.891273	
							倍面積	16.008235
							面 積	8.0041175

面積計算書（座標法）

世界測地系（測地成果2011）

所 在	地 番	公簿地目	現況地目	地 積	所 有 者
前橋市六供町二丁目	46-1-保-4			61.00 m ²	

点 名	X 座標	Y 座標	辺 長	方 向 角	測 角	DX	倍 積 (Y×DX)
46-1-102	41391.229	-68621.891	4.179	184-08-39	89-58-03	-3.105	213070.971555
46-1-128	41387.061	-68622.193	14.597	94-10-49	90-02-10	-5.232	359031.313776
46-1-129	41385.997	-68607.635	4.180	4-06-57	89-56-08	3.105	-213026.706675
46-1-17	41390.166	-68607.335	14.595	274-10-36	90-03-39	5.232	-358953.576720

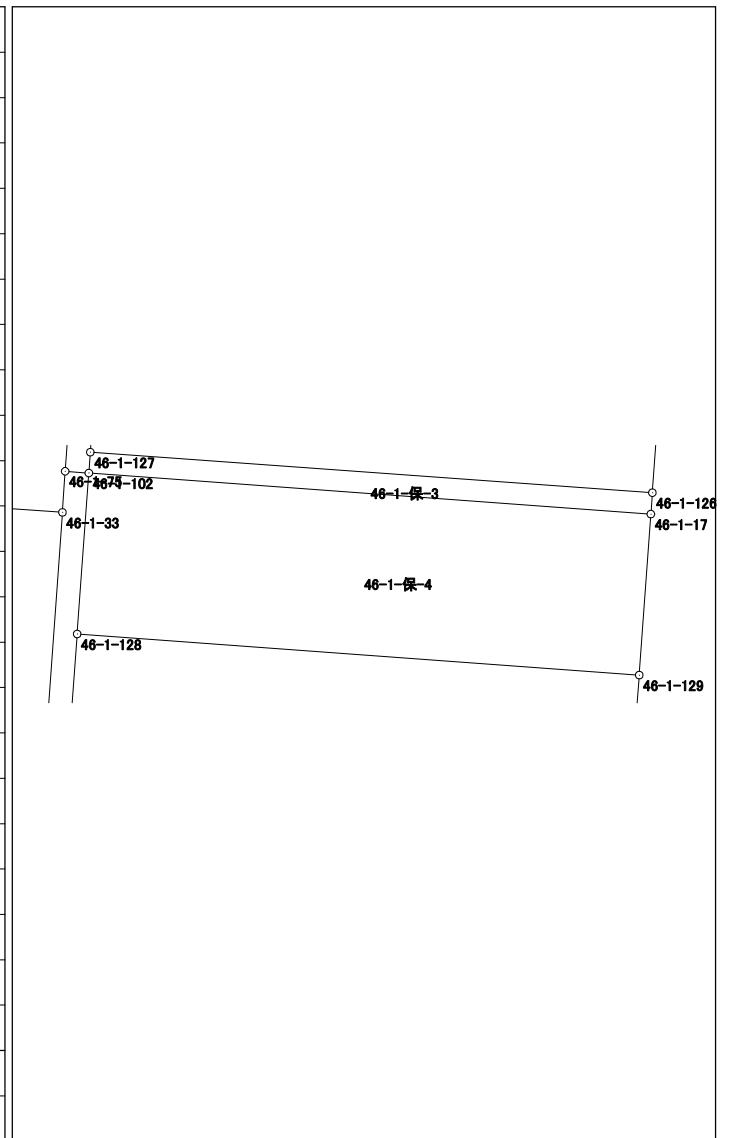


倍面積	122.001936
面 積	61.0009680

面積計算書（座標法）

世界測地系（測地成果2011）

所 在	地 番	公簿地目	現況地目	地 積	所 有 者
前橋市六供町二丁目	46-1-保-6			44.00 m ²	

点 名	X 座標	Y 座標	辺 長	方 向 角	測 角	DX	倍 積 (Y×DX)
46-1-134	41373.425	-68623.178	3.039	184-06-50	89-50-26	-1.943	133334.834854
46-1-135	41370.394	-68623.396	14.601	94-04-36	89-57-46	-4.069	279228.598324
46-1-136	41369.356	-68608.832	2.989	4-07-31	90-02-55	1.943	-133306.960576
46-1-18	41372.337	-68608.617	14.602	274-16-24	90-08-53	4.069	-279168.462573

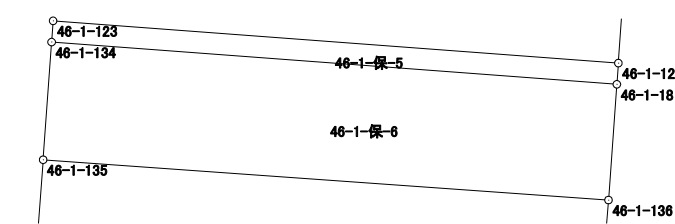


倍面積	88.010029
面 積	44.0050145

面積計算書（座標法）

世界測地系（測地成果2011）

所在	地番	公簿地目	現況地目	地積	所有者
前橋市六供町二丁目	46-1-保-7			8.00 m ²	

点名	X座標	Y座標	辺長	方向角	測角	DX	倍積 (Y×DX)
46-1-41	41363.172	-68623.915	0.548	184-10-57	90-06-18	0.491	-33694.342265
46-1-120	41362.625	-68623.955	14.599	94-04-38	89-53-41	-1.585	108768.968675
46-1-121	41361.587	-68609.393	0.548	4-04-41	90-00-03	-0.491	33687.211963
46-1-19	41362.134	-68609.354	14.598	274-04-39	89-59-58	1.585	-108745.826090
倍面積						16.012283	
面積						8.0061415	

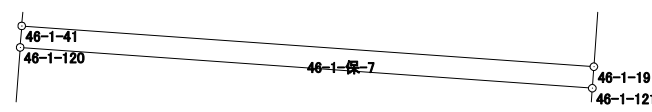


面積計算書 (座標法)

世界測地系 (測地成果2011)

所在	地番	公簿地目	現況地目	地積	所有者
前橋市六供町二丁目	46-1-保-8			35.00 m ²	

点名	X座標	Y座標	辺長	方向角	測角	DX	倍積 (Y×DX)
46-1-120	41362.625	-68623.955	2.397	184-08-18	90-03-40	-1.353	92848.211115
46-1-130	41360.234	-68624.128	14.600	94-04-51	89-56-33	-3.430	235380.759040
46-1-131	41359.195	-68609.565	2.398	4-06-46	90-01-55	1.353	-92828.741445
46-1-121	41361.587	-68609.393	14.599	274-04-38	89-57-52	3.430	-235330.217990
						倍面積	70.010720
						面積	35.0053600

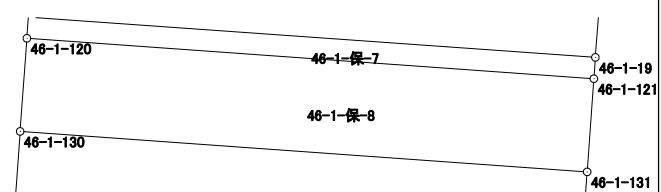


面積計算書 (座標法)

世界測地系 (測地成果2011)

所在	地番	公簿地目	現況地目	地積	所有者
前橋市六供町二丁目	46-1-保-9			47.00 m ²	

点名	X座標	Y座標	辺長	方向角	測角	DX	倍積 (Y×DX)
46-1-41	41363.172	-68623.915	7.241	4-06-38	179-55-41	7.769	-533139.195635
46-1-135	41370.394	-68623.396	3.039	4-06-50	180-00-12	10.253	-703595.679188
46-1-134	41373.425	-68623.178	0.548	4-04-41	179-57-51	3.578	-245533.730884
46-1-123	41373.972	-68623.139	2.020	4-05-15	180-00-34	2.562	-175812.482118
46-1-36	41375.987	-68622.995	0.580	273-51-13	89-45-58	2.054	-140951.631730
46-1-97	41376.026	-68623.574	1.516	274-05-08	180-13-55	0.147	-10087.665378
46-1-132	41376.134	-68625.086	22.396	184-07-30	90-02-22	-22.230	1525535.661780
46-1-133	41353.796	-68626.697	2.096	94-06-11	89-58-41	-22.488	1543277.162136
46-1-22	41353.646	-68624.606	6.605	4-09-00	90-02-49	6.438	-441805.213428
46-1-130	41360.234	-68624.128	2.397	4-08-18	179-59-18	8.979	-616176.045312
46-1-120	41362.625	-68623.955	0.548	4-10-57	180-02-39	2.938	-201617.179790

倍面積	94.000453
面積	47.0002265

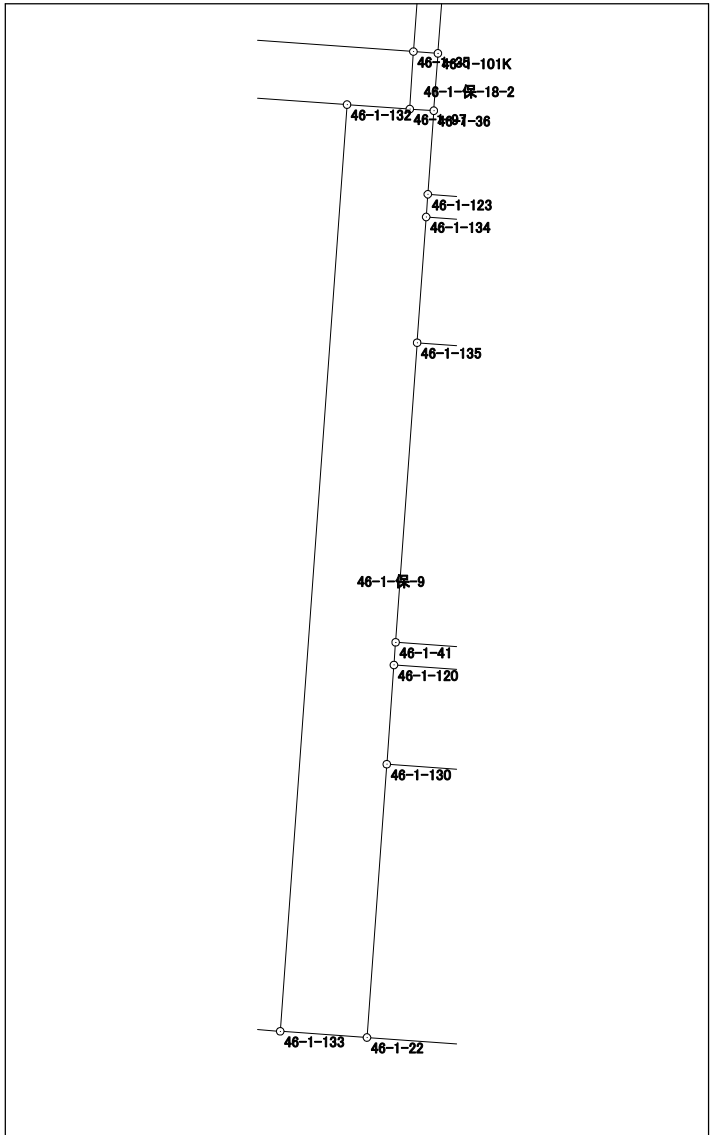


面積計算書（座標法）

世界測地系（測地成果2011）

所在	地番	公簿地目	現況地目	地積	所有者
前橋市六供町二丁目	46-1-保-10			43.00 m ²	

点名	X座標	Y座標	辺長	方向角	測角	DX	倍積 (Y×DX)
46-1-118	41376.893	-68635.366	22.420	184-04-37	89-19-50	-22.204	1523979.666664
46-1-119	41354.530	-68636.960	1.917	94-05-54	90-01-17	-22.500	1544331.600000
46-1-23	41354.393	-68635.048	22.398	4-05-19	89-59-25	22.204	-1523972.605792
46-1-39	41376.734	-68633.451	1.922	274-44-47	90-39-28	22.500	-1544252.647500
倍面積						86.013372	
面積						43.0066860	

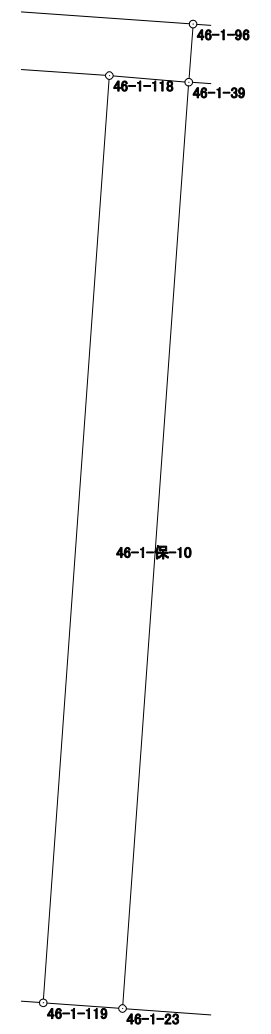


面積計算書（座標法）

世界測地系（測地成果2011）

所在	地番	公簿地目	現況地目	地積	所有者
前橋市六供町二丁目	46-1-保-12			52.00 m ²	

点名	X座標	Y座標	辺長	方向角	測角	DX	倍積 (Y×DX)
46-1-28	41378.517	-68658.261	3.775	202-57-56	108-52-46	-2.482	170409.803802
46-1-114	41375.041	-68659.734	15.168	94-05-13	71-07-17	-4.557	312882.407838
46-1-115	41373.960	-68644.605	3.572	4-08-30	90-03-17	2.482	-170375.909610
46-1-37	41377.523	-68644.347	13.949	274-05-10	89-56-40	4.557	-312812.289279
						倍面積	104.012751
						面積	52.0063755

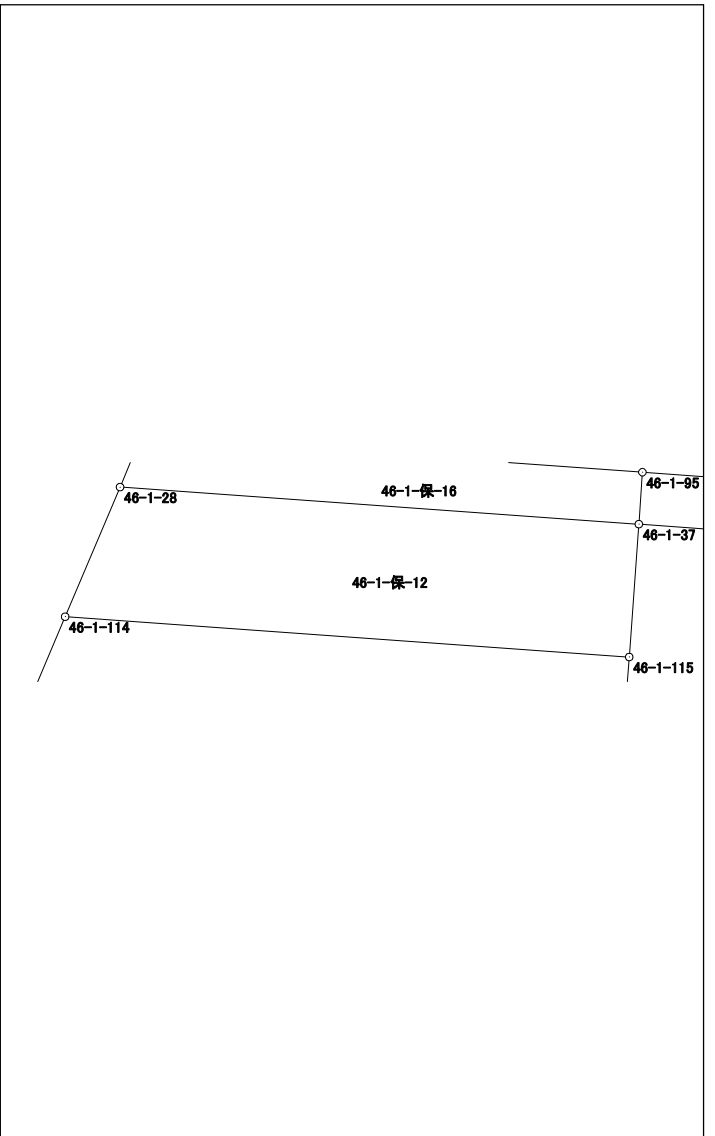


面積計算書 (座標法)

世界測地系 (測地成果2011)

所 在	地 番	公簿地目	現況地目	地 積	所 有 者
前橋市六供町二丁目	46-1-保-14			8.34 m ²	

点 名	X 座標	Y 座標	辺 長	方 向 角	測 角	DX	倍 積 (Y×DX)
46-1-101K	41377.369	-68622.896	9.717	4-08-55	89-58-49	9.649	-662142.323504
46-1-128	41387.061	-68622.193	4.179	4-08-39	179-59-44	13.860	-951103.594980
46-1-102	41391.229	-68621.891	0.615	274-11-55	90-03-16	4.213	-289104.026783
46-1-75	41391.274	-68622.504	1.066	183-45-51	89-33-56	-1.019	69926.331576
46-1-33	41390.210	-68622.574	12.830	184-04-34	180-18-43	-13.862	951246.120788
46-1-35	41377.412	-68623.486	0.592	94-10-06	90-05-32	-12.841	881194.183726
倍面積						16.690823	
面 積						8.3454115	

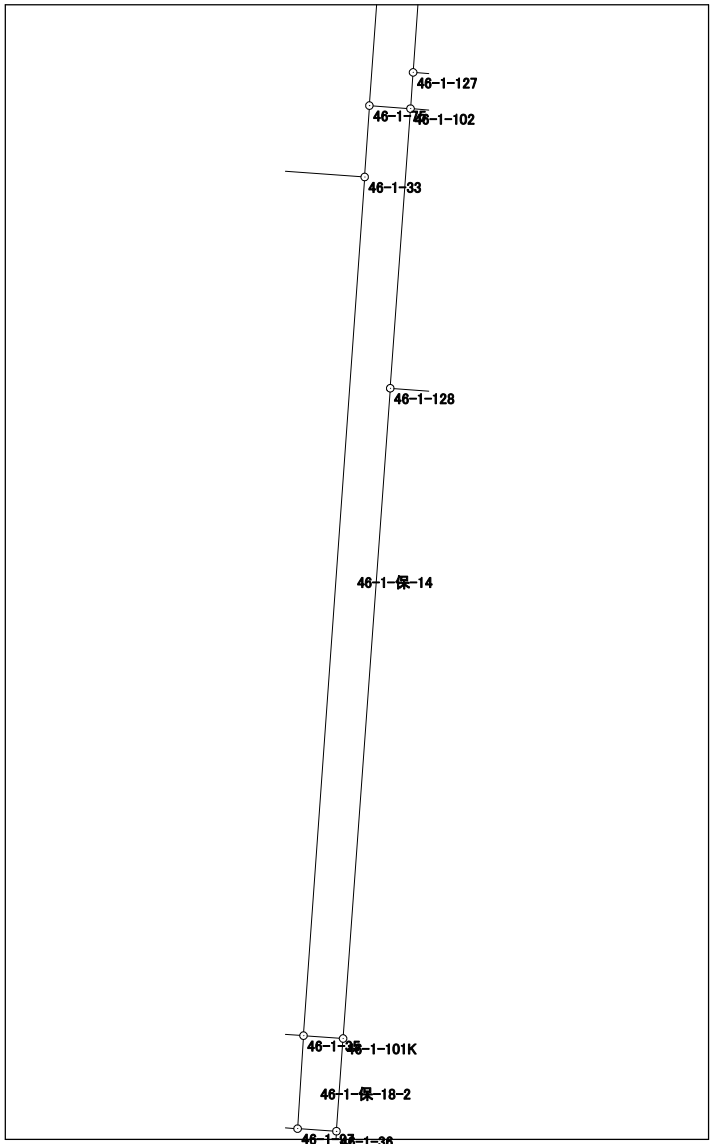


面積計算書（座標法）

世界測地系（測地成果2011）

所 在	地 番	公簿地目	現況地目	地 積	所 有 者
前橋市六供町二丁目	46-1-保-16			19.11 m ²	

点 名	X 座標	Y 座標	辺 長	方 向 角	測 角	DX	倍 積 (Y×DX)
46-1-29	41379.872	-68657.692	1.470	202-46-44	108-42-38	-0.399	27394.419108
46-1-28	41378.517	-68658.261	13.949	94-05-10	71-18-26	-2.349	161278.255089
46-1-37	41377.523	-68644.347	1.396	3-56-33	89-51-23	0.399	-27389.094453
46-1-95	41378.916	-68644.251	13.475	274-04-06	90-07-33	2.349	-161245.345599
						倍面積	38.234145
						面 積	19.1170725

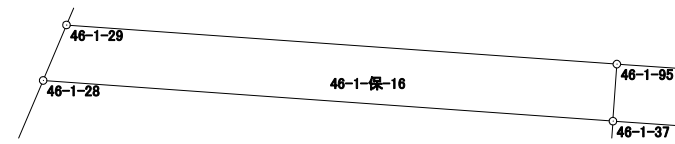

面積計算書 (座標法)

世界測地系 (測地成果2011)

所在	地番	公簿地目	現況地目	地積	所有者
前橋市六供町二丁目	46-1-保-17			15.19 m ²	

点名	X座標	Y座標	辺長	方向角	測角	DX	倍積 (Y×DX)
46-1-95	41378.916	-68644.251	1.396	183-56-33	89-50-44	-0.612	42010.281612
46-1-37	41377.523	-68644.347	9.003	94-00-45	90-04-12	-2.023	138867.513981
46-1-118	41376.893	-68635.366	1.922	94-44-47	180-44-02	-0.789	54153.303774
46-1-39	41376.734	-68633.451	1.405	4-14-44	89-29-57	1.242	-85242.746142
46-1-96	41378.135	-68633.347	10.932	274-05-49	89-51-05	2.182	-149757.963154
						倍面積	30.390071
						面積	15.1950355

