



48-1街区 画地出来形確認図 (1516.66㎡)  
48-2街区 (1286.30㎡)

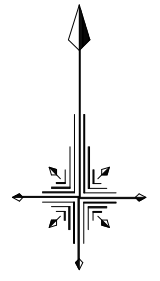


S=1/500

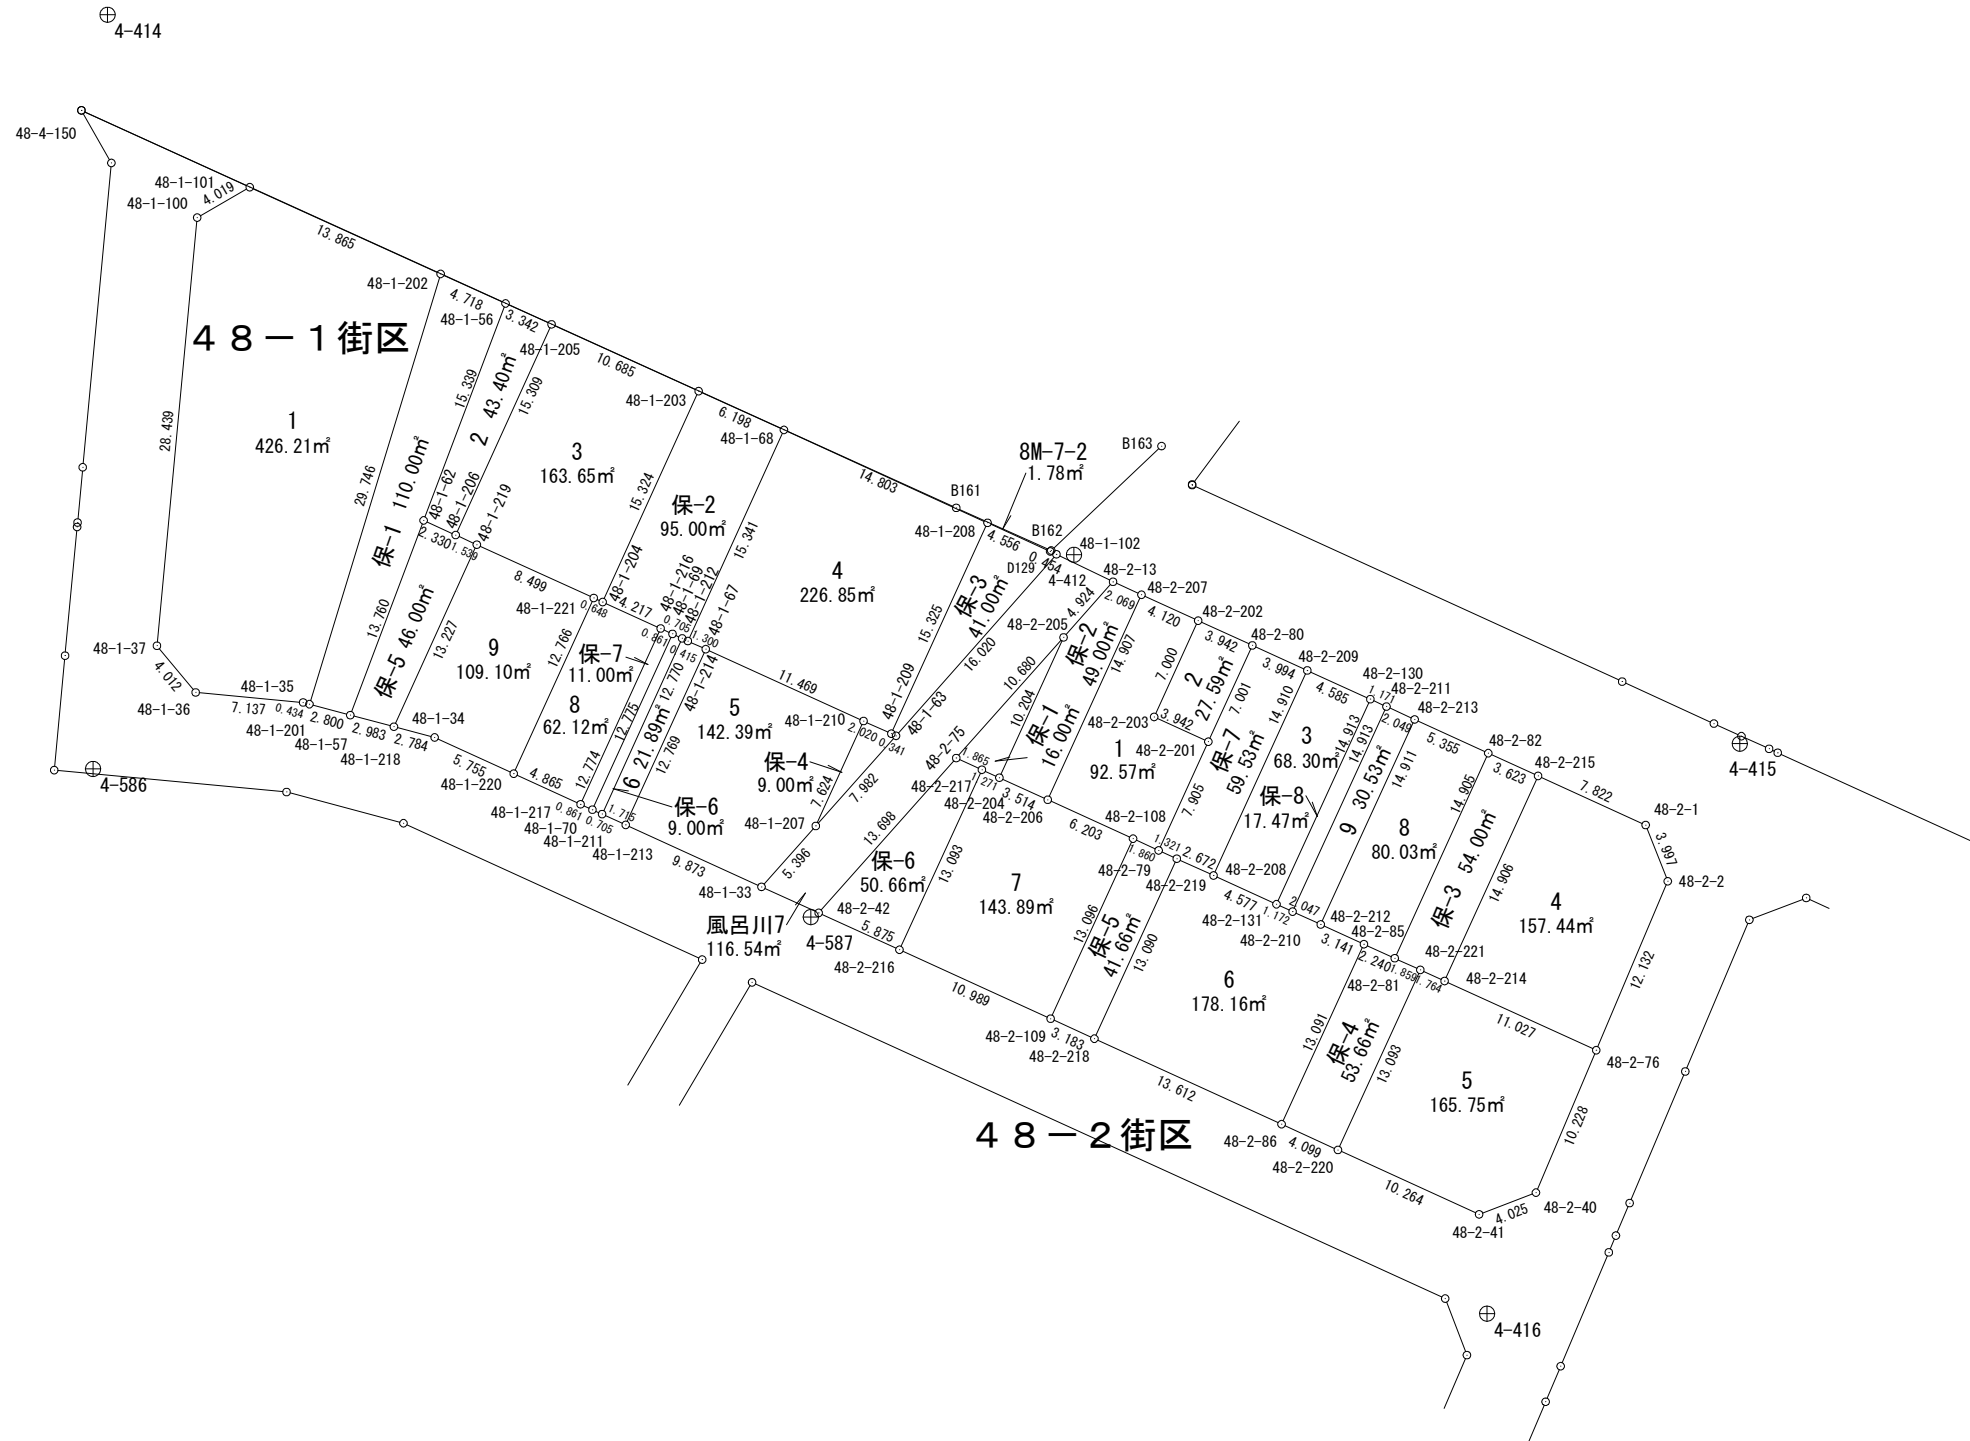

# 面積計算書 (座標法)

所在	地番	公簿地目	現況地目	地積	所有者
前橋市南町二丁目	48-1-1			426.21 m <sup>2</sup>	

点名	X座標	Y座標	辺長	方向角	測角	DX	倍積 (Y×DX)
48-1-201	41518.198	-68700.410	29.746	16-57-43	91-52-08	28.339	-1946900.918990
48-1-202	41546.650	-68691.732	13.865	294-26-01	97-28-18	34.187	-2348364.241884
48-1-101	41552.385	-68704.355	4.019	239-59-24	125-33-23	3.725	-255923.722375
48-1-100	41550.375	-68707.835	28.439	185-22-16	125-22-52	-30.324	2083496.388540
48-1-37	41522.061	-68710.497	4.012	140-18-35	134-56-19	-31.401	2157578.316297
48-1-36	41518.974	-68707.935	7.137	95-19-49	135-01-14	-3.750	257654.756250
48-1-35	41518.311	-68700.829	0.434	105-05-35	189-45-46	-0.776	53311.843304
倍面積							852.421142
面積							426.2105710

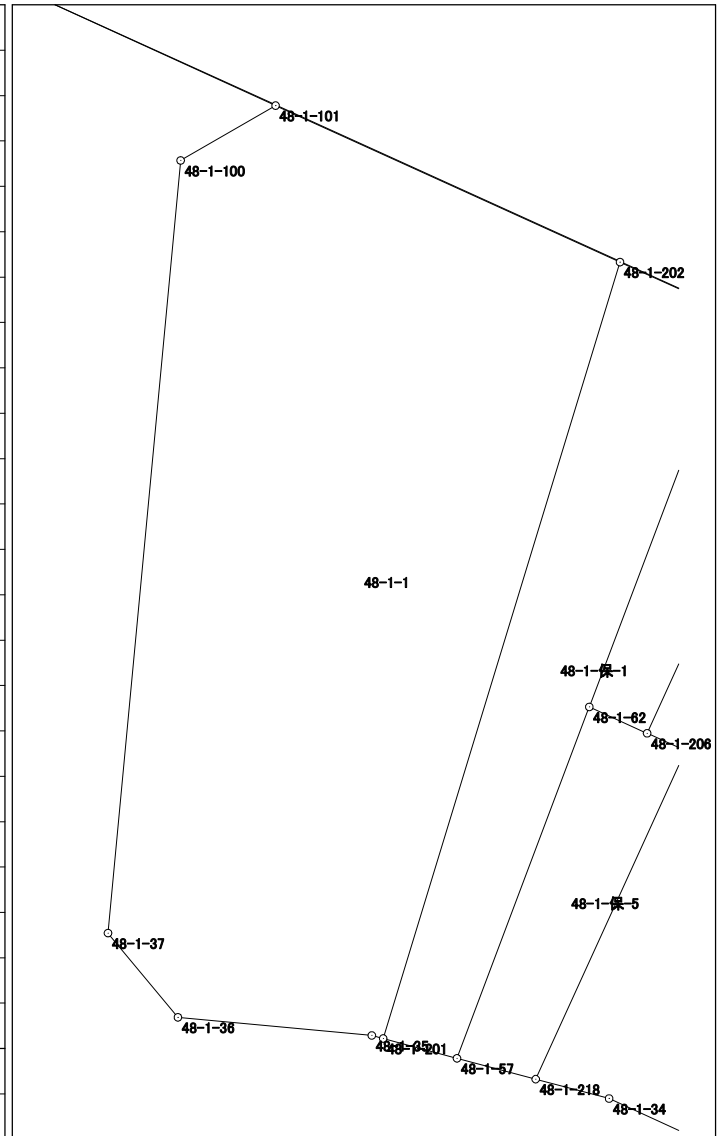


# 面積計算書 (座標法)

世界測地系 (測地成果2011)

所 在	地 番	公簿地目	現況地目	地 積	所 有 者
前橋市南町二丁目	48-1-2			43.40 m <sup>2</sup>	

点 名	X 座標	Y 座標	辺 長	方 向 角	測 角	DX	倍 積 (Y×DX)
48-1-205	41543.316	-68684.394	3.342	294-25-32	89-56-53	15.315	-1051901.494110
48-1-56	41544.698	-68687.437	15.339	200-41-34	86-16-02	-12.967	890669.995579
48-1-62	41530.349	-68692.857	2.330	114-29-49	93-48-15	-15.315	1052031.104955
48-1-206	41529.383	-68690.737	15.309	24-28-39	89-58-50	12.967	-890712.786679
						倍面積	86.819745
						面 積	43.4098725

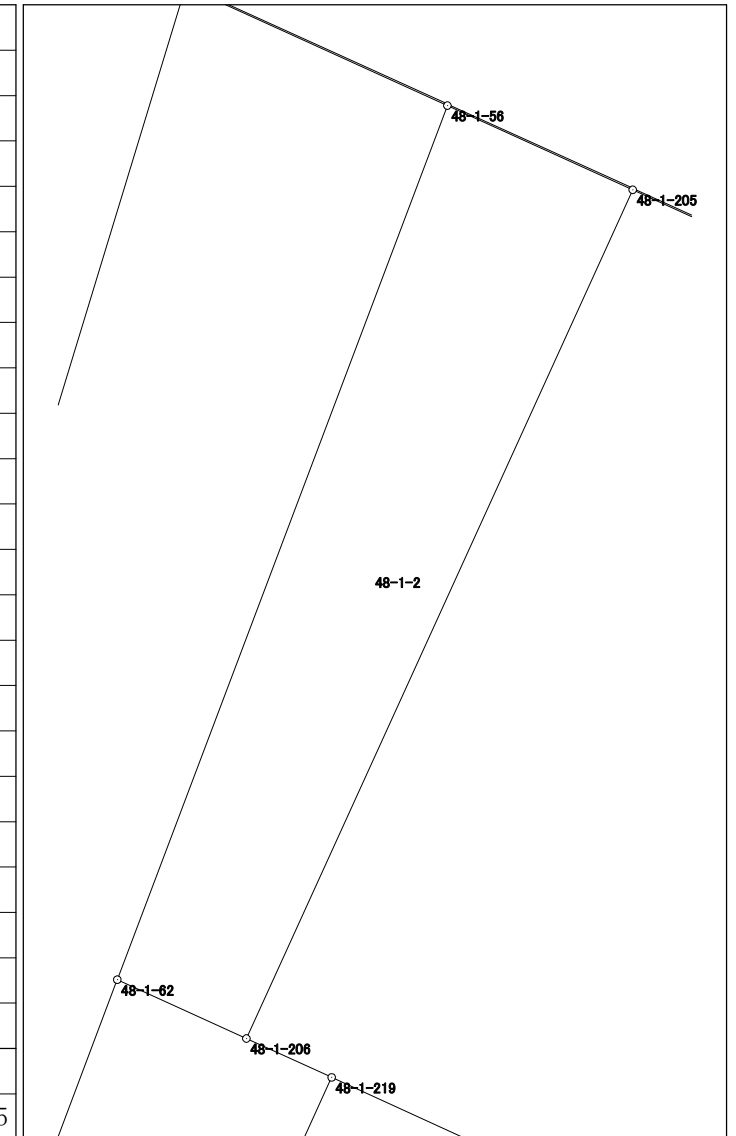

面積計算書 (座標法)

世界測地系 (測地成果2011)

所在	地番	公簿地目	現況地目	地積	所有者
前橋市南町二丁目	48-1-3			163.65 m <sup>2</sup>	


点名	X座標	Y座標	辺長	方向角	測角	DX	倍積 (Y×DX)	Diagram	
48-1-204	41524.951	-68681.014	15.324	24-28-34	89-55-47	13.678	-939418.909492		
48-1-203	41538.898	-68674.665	10.685	294-25-23	89-56-49	18.365	-1261210.222725		
48-1-205	41543.316	-68684.394	15.309	204-28-39	90-03-16	-9.515	653532.008910		
48-1-206	41529.383	-68690.737	1.539	114-29-58	90-01-19	-14.571	1000892.728827		
48-1-219	41528.745	-68689.337	8.499	114-30-09	180-00-11	-4.163	285953.709931		
48-1-221	41525.220	-68681.603	0.648	114-32-47	180-02-38	-3.794	260578.001782		
						倍面積	327.317233		
						面積	163.6586165		

# 面積計算書（座標法）

世界測地系（測地成果2011）

所在	地番	公簿地目	現況地目	地積	所有者
前橋市南町二丁目	48-1-4			226.85 m <sup>2</sup>	


点名	X座標	Y座標	辺長	方向角	測角	DX	倍積 (Y×DX)
48-1-208	41530.189	-68655.555	14.803	294-31-51	89-59-58	20.088	-1379152.788840
48-1-68	41536.335	-68669.022	15.341	204-28-36	89-56-45	-7.816	536717.075952
48-1-67	41522.373	-68675.378	1.300	114-27-18	89-58-42	-14.500	995792.981000
48-1-214	41521.835	-68674.195	11.469	114-28-16	180-00-58	-5.289	363217.817355
48-1-210	41517.084	-68663.756	2.020	114-29-02	180-00-46	-5.588	383693.068528
48-1-209	41516.247	-68661.918	15.325	24-31-53	90-02-51	13.105	-899814.435390
						倍面積	453.718605
						面積	226.8593025

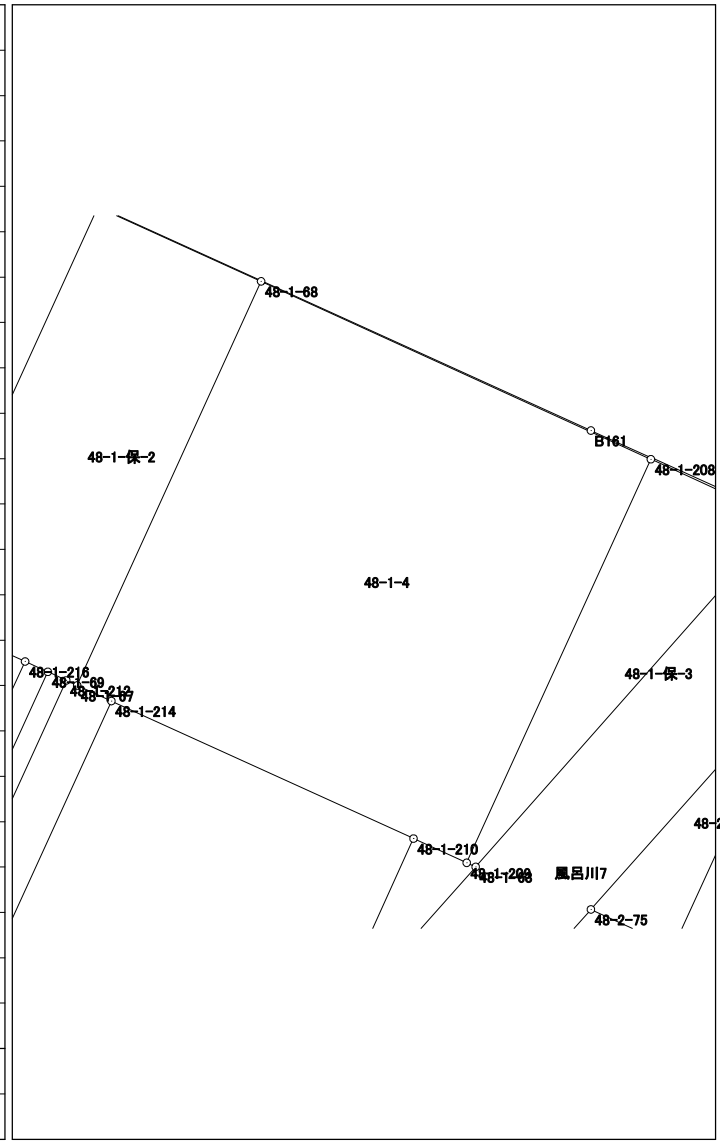

# 面積計算書 (座標法)

所在	地番	公簿地目	現況地目	地積	所有者
前橋市南町二丁目	48-1-5			142.39 m <sup>2</sup>	

点名	X座標	Y座標	辺長	方向角	測角	Dx	倍積 (Y×Dx)
48-1-210	41517.084	-68663.756	11.469	294-28-16	89-58-36	11.689	-802610.643884
48-1-214	41521.835	-68674.195	12.769	204-29-37	90-01-21	-6.869	471723.045455
48-1-213	41510.215	-68679.489	9.873	114-31-29	90-01-52	-15.718	1079504.208102
48-1-33	41506.117	-68670.507	5.396	41-42-08	107-10-39	-0.069	4738.264983
48-1-207	41510.146	-68666.917	7.624	24-29-40	162-47-32	10.967	-753070.078739
						倍面積	284.795917
						面積	142.3979585

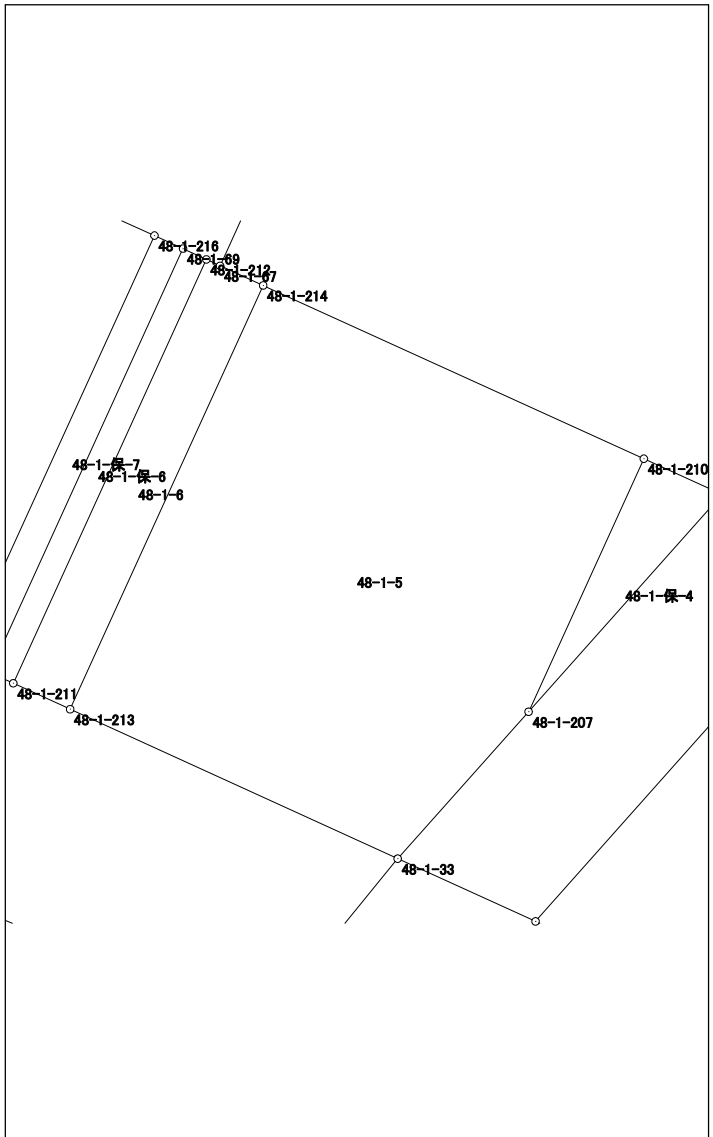


# 面積計算書（座標法）

世界測地系（測地成果2011）

所 在	地 番	公簿地目	現況地目	地 積	所 有 者
前橋市南町二丁目	48-1-6			21.89 m <sup>2</sup>	

点 名	X 座標	Y 座標	辺 長	方 向 角	測 角	DX	倍 積 (Y×DX)
48-1-212	41522.548	-68675.754	12.770	204-29-45	89-32-15	-11.446	786062.680284
48-1-211	41510.927	-68681.049	1.715	114-31-57	90-02-12	-12.333	847043.377317
48-1-213	41510.215	-68679.489	12.769	24-29-37	89-57-40	10.908	-749155.866012
48-1-214	41521.835	-68674.195	1.300	294-27-18	89-57-41	12.158	-834940.862810
48-1-67	41522.373	-68675.378	0.415	294-57-30	180-30-12	0.713	-48965.544514

倍面積	43.784265
面 積	21.8921325

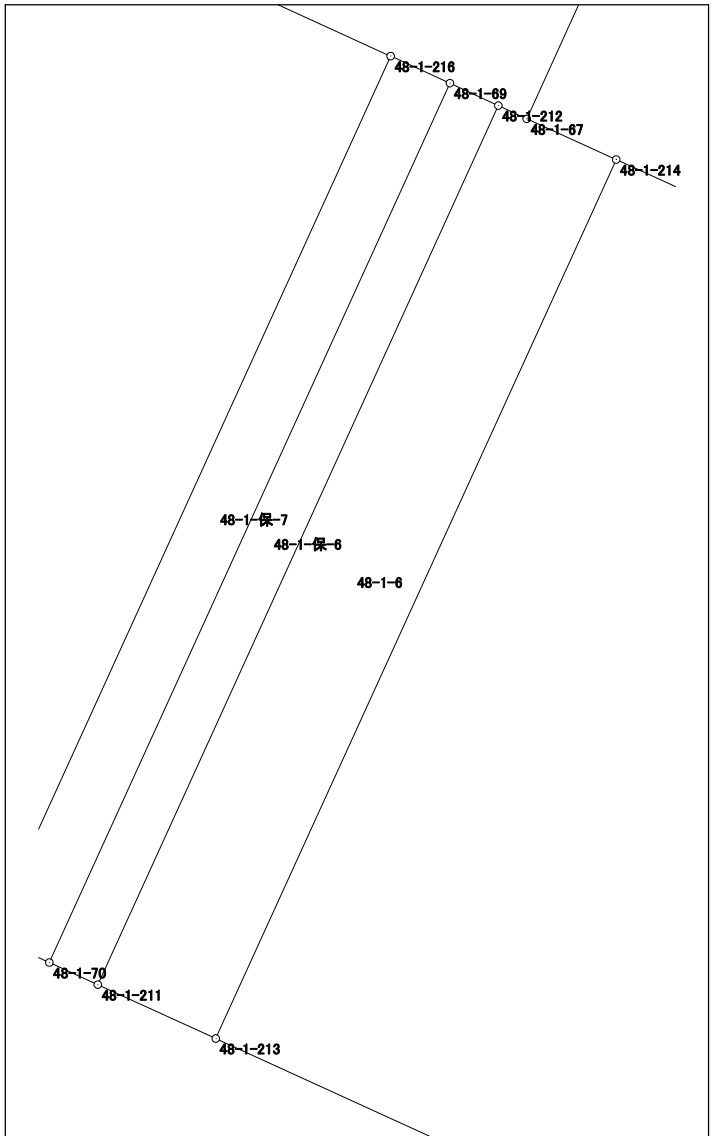






# 面積計算書 (座標法)

世界測地系 (測地成果2011)

所在	地番	公簿地目	現況地目	地積	所有者
前橋市南町二丁目	48-1-9			109.10 m <sup>2</sup>	

点名	X座標	Y座標	辺長	方向角	測角	DX	倍積 (Y×DX)
48-1-218	41516.709	-68694.822	2.784	104-47-42	80-17-44	-12.747	875652.896034
48-1-34	41515.998	-68692.130	5.755	114-35-32	189-47-50	-3.106	213357.755780
48-1-220	41513.603	-68686.897	12.766	24-29-57	89-54-25	9.222	-633430.564134
48-1-221	41525.220	-68681.603	8.499	294-30-09	90-00-12	15.142	-1039976.832626
48-1-219	41528.745	-68689.337	13.227	204-29-58	89-59-49	-8.511	584614.947207

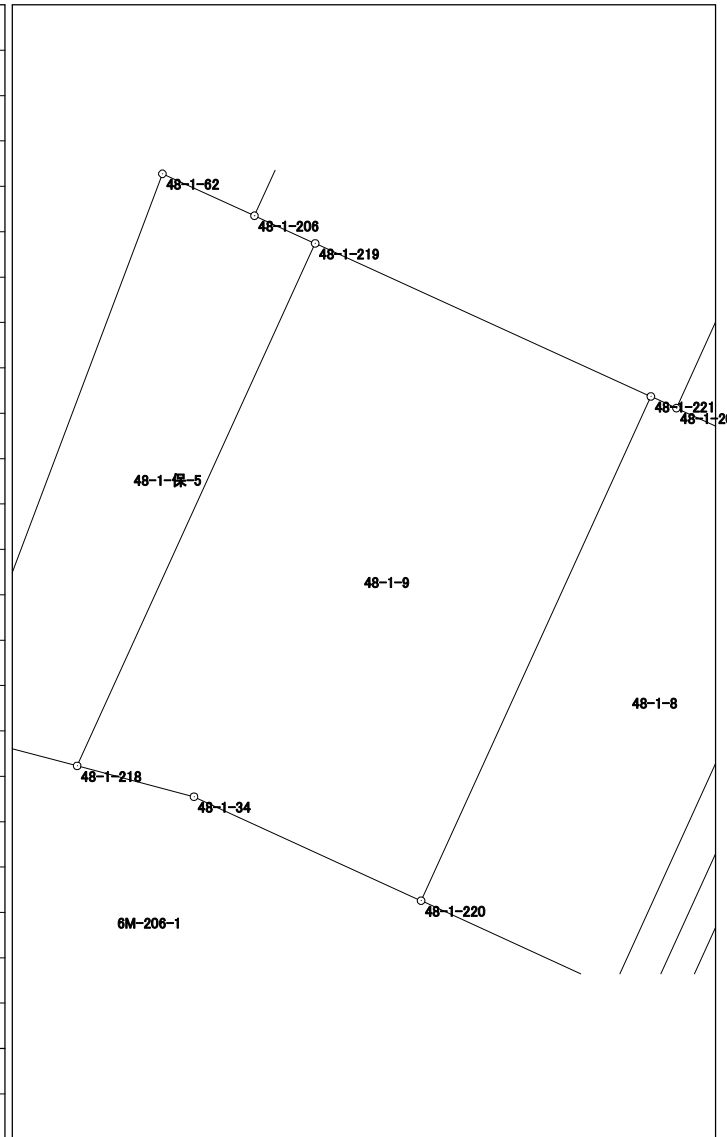


倍面積	218.202261
面積	109.1011305

# 面積計算書（座標法）

世界測地系（測地成果2011）

所 在	地 番	公簿地目	現況地目	地 積	所 有 者
前橋市南町二丁目	48-1-保-1			110.00 m <sup>2</sup>	

点 名	X 座標	Y 座標	辺 長	方 向 角	測 角	DX	倍 積 (Y×DX)
48-1-201	41518.198	-68700.410	2.800	105-01-44	88-04-01	-29.178	2004540.562980
48-1-57	41517.472	-68697.706	13.760	20-38-04	95-36-20	12.151	-834745.825606
48-1-62	41530.349	-68692.857	15.339	20-41-34	180-03-30	27.226	-1870231.724682
48-1-56	41544.698	-68687.437	4.718	294-26-27	93-44-53	16.301	-1119673.910537
48-1-202	41546.650	-68691.732	29.746	196-57-43	82-31-16	-26.500	1820330.898000
						倍面積	220.000155
						面積	110.0000775

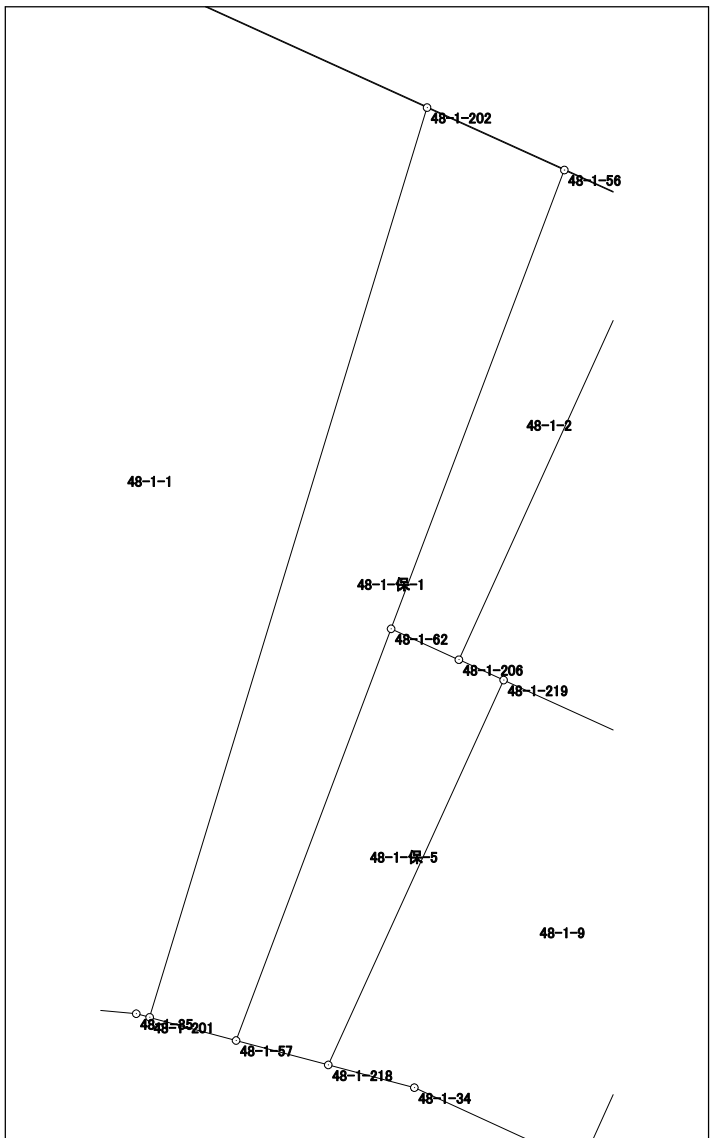


# 面積計算書（座標法）

世界測地系（測地成果2011）

所 在	地 番	公簿地目	現況地目	地 積	所 有 者
前橋市南町二丁目	48-1-保-2			95.00 m <sup>2</sup>	

点 名	X 座標	Y 座標	辺 長	方 向 角	測 角	DX	倍 積 (Y×DX)
48-1-67	41522.373	-68675.378	15.341	24-28-36	89-31-06	13.787	-946827.436486
48-1-68	41536.335	-68669.022	6.198	294-25-38	89-57-02	16.525	-1134755.588550
48-1-203	41538.898	-68674.665	15.324	204-28-34	90-02-56	-11.384	781792.386360
48-1-204	41524.951	-68681.014	4.217	114-30-17	90-01-43	-15.696	1078017.195744
48-1-216	41523.202	-68677.177	0.861	114-28-57	179-58-40	-2.106	144634.134762
48-1-69	41522.845	-68676.393	0.705	114-55-43	180-26-46	-0.654	44914.361022
48-1-212	41522.548	-68675.754	0.415	114-57-30	180-01-47	-0.472	32414.955888
倍面積						190.008740	
面 積						95.0043700	

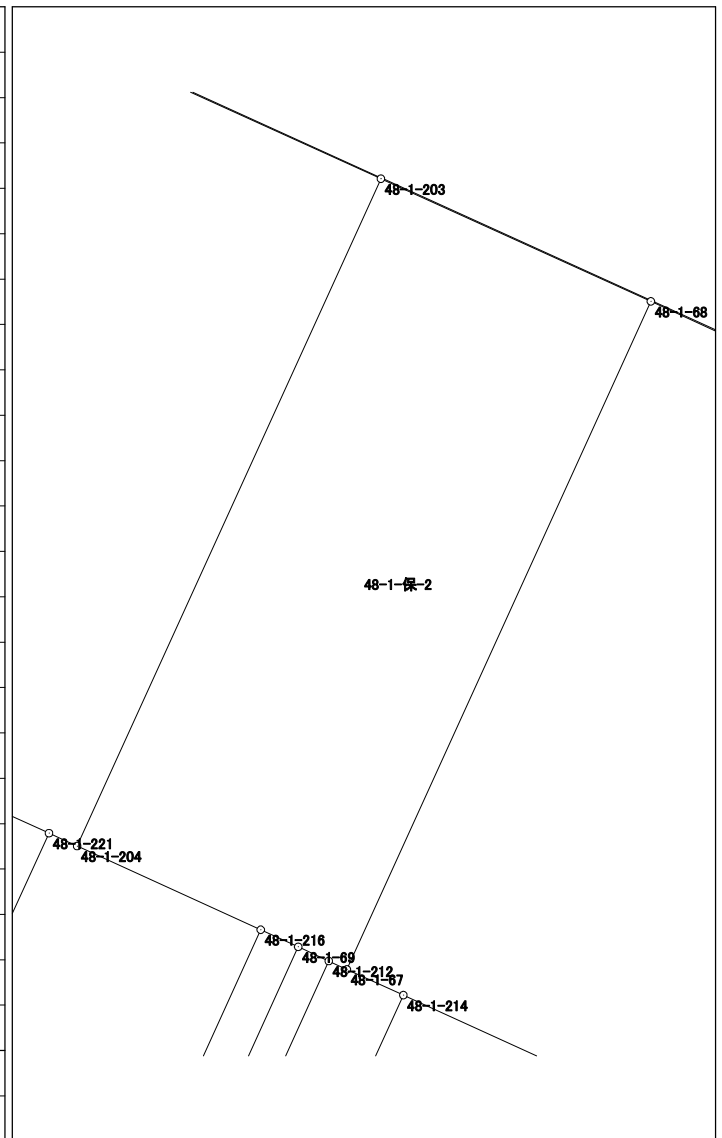


# 面積計算書 (座標法)

世界測地系 (測地成果2011)

所 在	地 番	公簿地目	現況地目	地 積	所 有 者
前橋市南町二丁目	48-1-保-3			41.00 m <sup>2</sup>	

点 名	X 座 標	Y 座 標	辺 長	方 向 角	測 角	DX	倍 積 (Y×DX)
48-1-102	41528.109	-68650.997	0.454	294-35-24	73-06-54	12.192	-836992.955424
D129	41528.298	-68651.410	4.556	294-31-23	179-55-59	2.080	-142794.932800
48-1-208	41530.189	-68655.555	15.325	204-31-53	90-00-30	-12.051	827368.093305
48-1-209	41516.247	-68661.918	0.341	114-23-18	89-51-25	-14.083	966965.791194
48-1-63	41516.106	-68661.607	16.020	41-28-30	107-05-12	11.862	-814463.982234
						倍面積	82.014041
						面 積	41.0070205

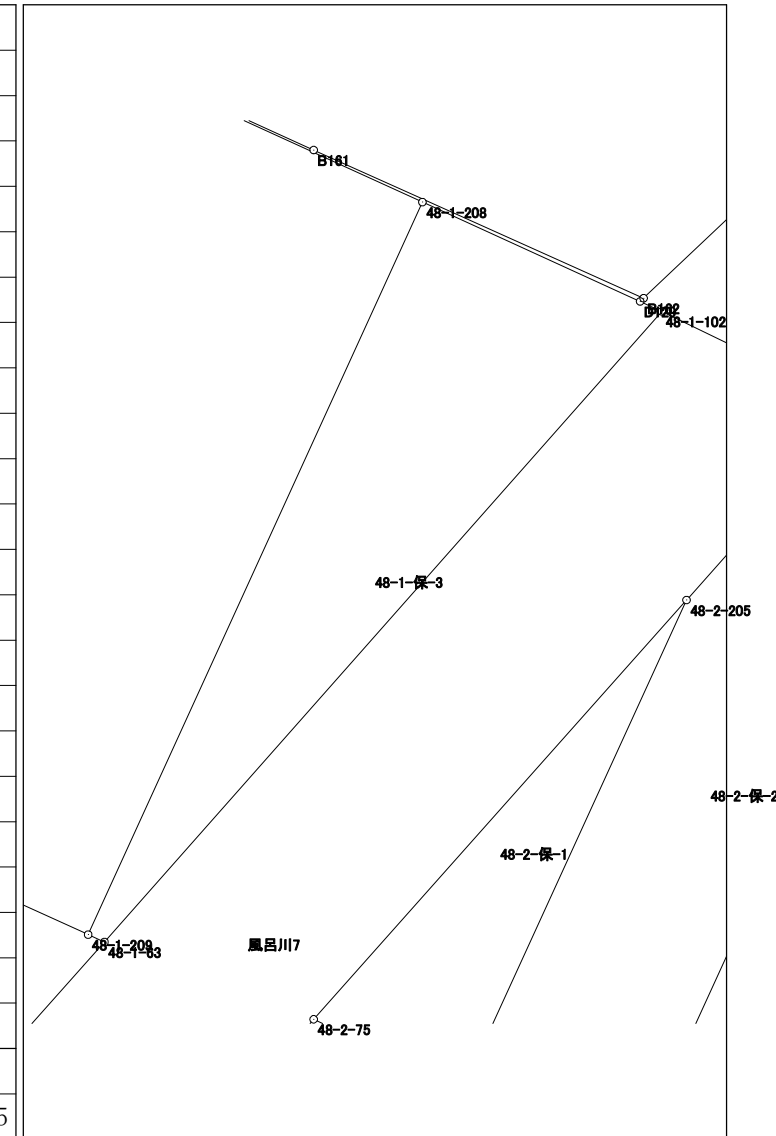


# 面積計算書 (座標法)

世界測地系 (測地成果2011)

所在	地番	公簿地目	現況地目	地積	所有者
前橋市南町二丁目	48-1-保-4			9.00 m <sup>2</sup>	

点名	X座標	Y座標	辺長	方向角	測角	DX	倍積 (Y×DX)
48-1-63	41516.106	-68661.607	0.341	294-23-18	72-41-21	6.101	-418904.464307
48-1-209	41516.247	-68661.918	2.020	294-29-02	180-05-44	0.978	-67151.355804
48-1-210	41517.084	-68663.756	7.624	204-29-40	90-00-38	-6.101	418917.575356
48-1-207	41510.146	-68666.917	7.982	41-41-57	17-12-17	-0.978	67156.244826

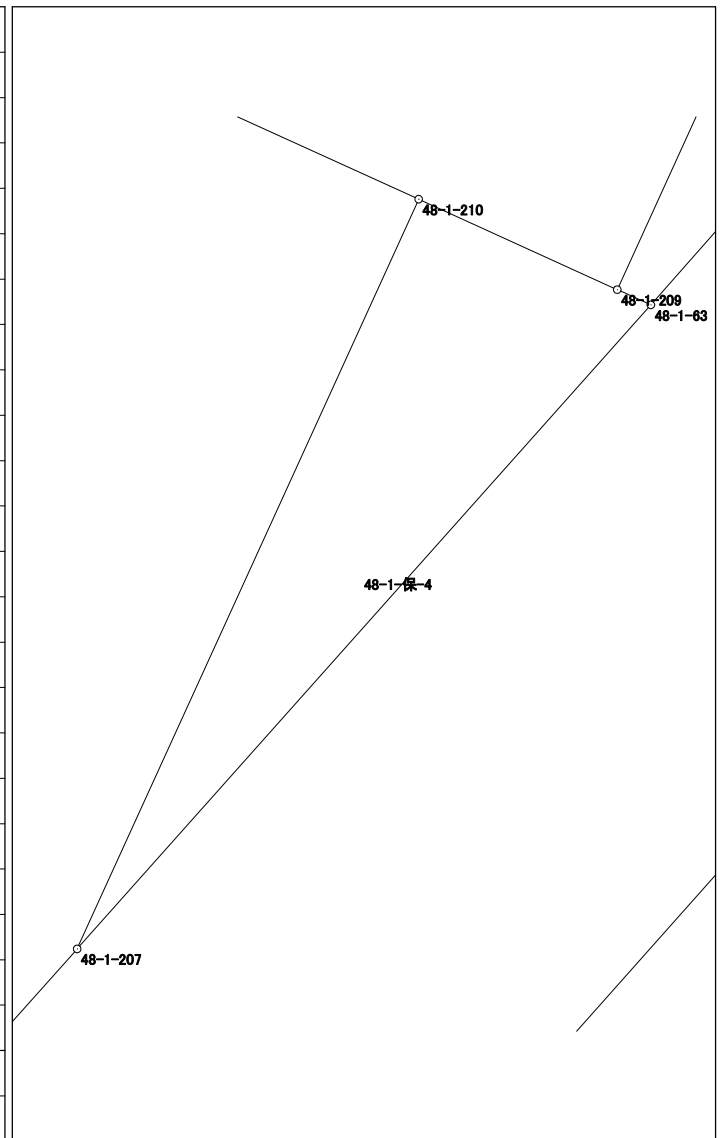

倍面積	18.000071
面積	9.0000355

# 面積計算書（座標法）

世界測地系（測地成果2011）

所在	地番	公簿地目	現況地目	地積	所有者
前橋市南町二丁目	48-1-保-5			46.00 m <sup>2</sup>	

点名	X座標	Y座標	辺長	方向角	測角	DX	倍積 (Y×DX)	
48-1-62	41530.349	-68692.857	13.760	200-38-04	86-08-15	-11.911	818200.619727	
48-1-57	41517.472	-68697.706	2.983	104-49-08	84-11-04	-13.640	937036.709840	
48-1-218	41516.709	-68694.822	13.227	24-29-58	99-40-50	11.273	-774396.728406	
48-1-219	41528.745	-68689.337	1.539	294-29-58	90-00-00	12.674	-870568.657138	
48-1-206	41529.383	-68690.737	2.330	294-29-49	179-59-51	1.604	-110179.942148	
						倍面積	92.001875	48-1-保-5 48-1-62 48-1-57 48-1-218 48-1-219 48-1-206 48-1-34 48-1-218
						面積	46.0009375	

## 面積計算書（座標法）

世界測地系（測地成果2011）

所 在	地 番	公簿地目	現況地目	地 積	所 有 者
前橋市南町二丁目	48-1-保-6			9.00 m <sup>2</sup>	

点 名	X 座標	Y 座標	辺 長	方 向 角	測 角	DX	倍 積 (Y×DX)
48-1-69	41522.845	-68676.393	12.775	204-29-48	89-34-05	-11.328	777966.179904
48-1-70	41511.220	-68681.690	0.705	114-33-54	90-04-06	-11.918	818548.381420
48-1-211	41510.927	-68681.049	12.770	24-29-45	89-55-51	11.328	-778018.923072
48-1-212	41522.548	-68675.754	0.705	294-55-43	90-25-58	11.918	-818477.636172
倍面積						18.002080	
面 積						9.0010400	

