




48-3 (1/2) 街区 画地出来形確認図 (9556.24m²)
 48-4 街区 (7033.26m²)

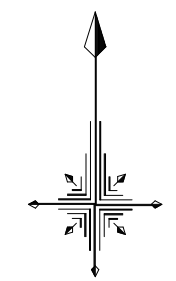


S=1/1000

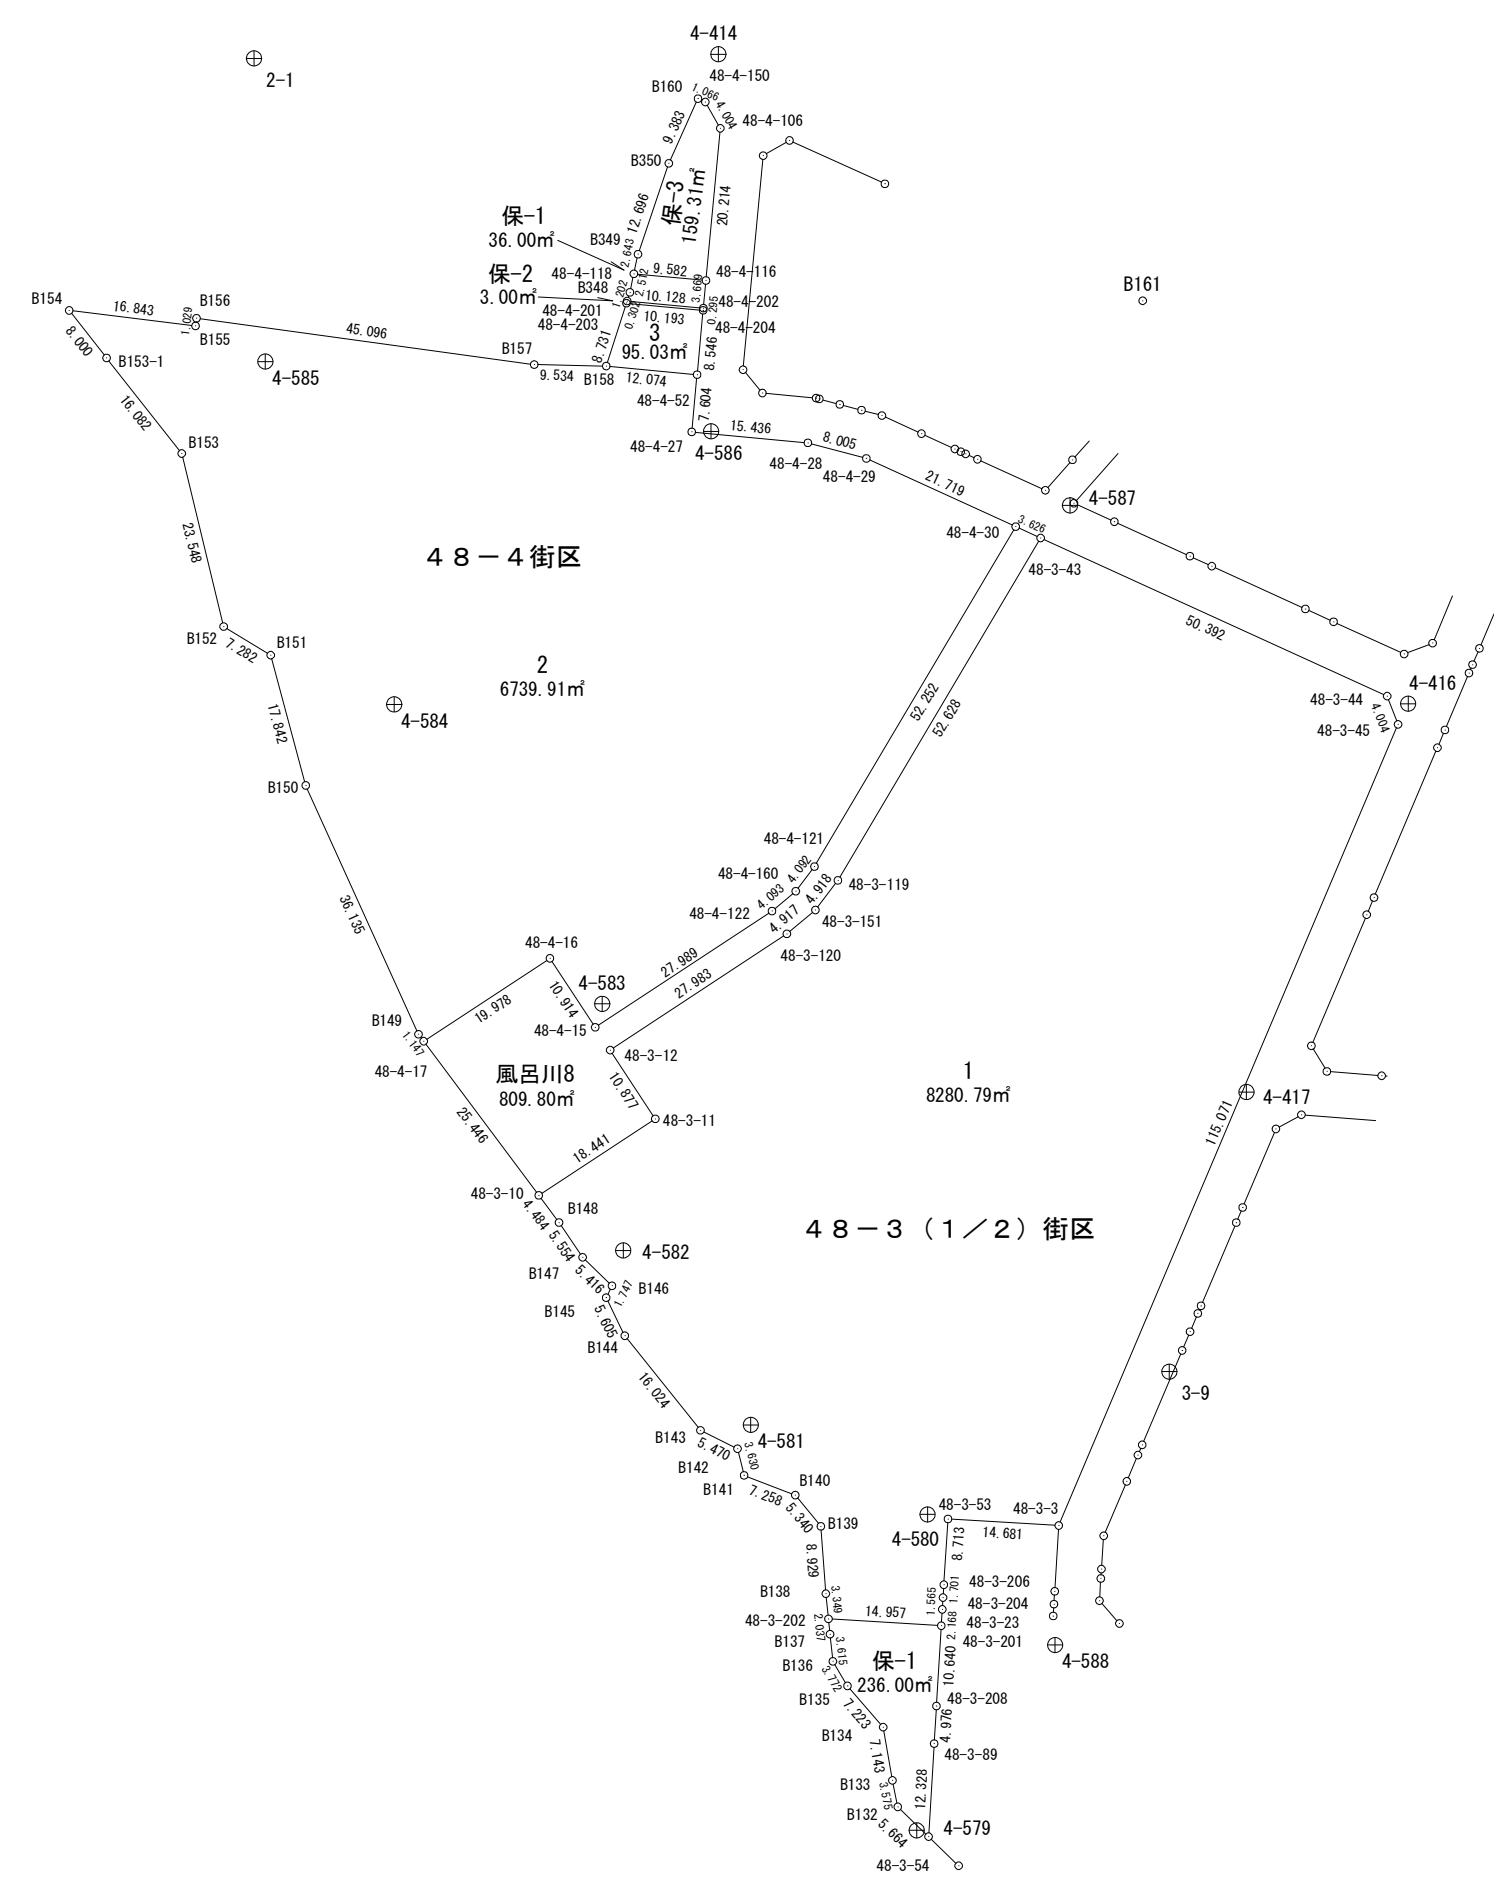

48-3 (2/2) 街区 画地出来形確認図 (9556.24m²)

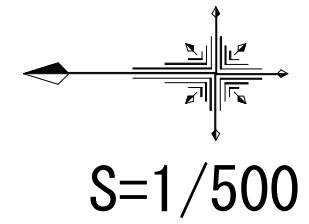

⊕
3-9

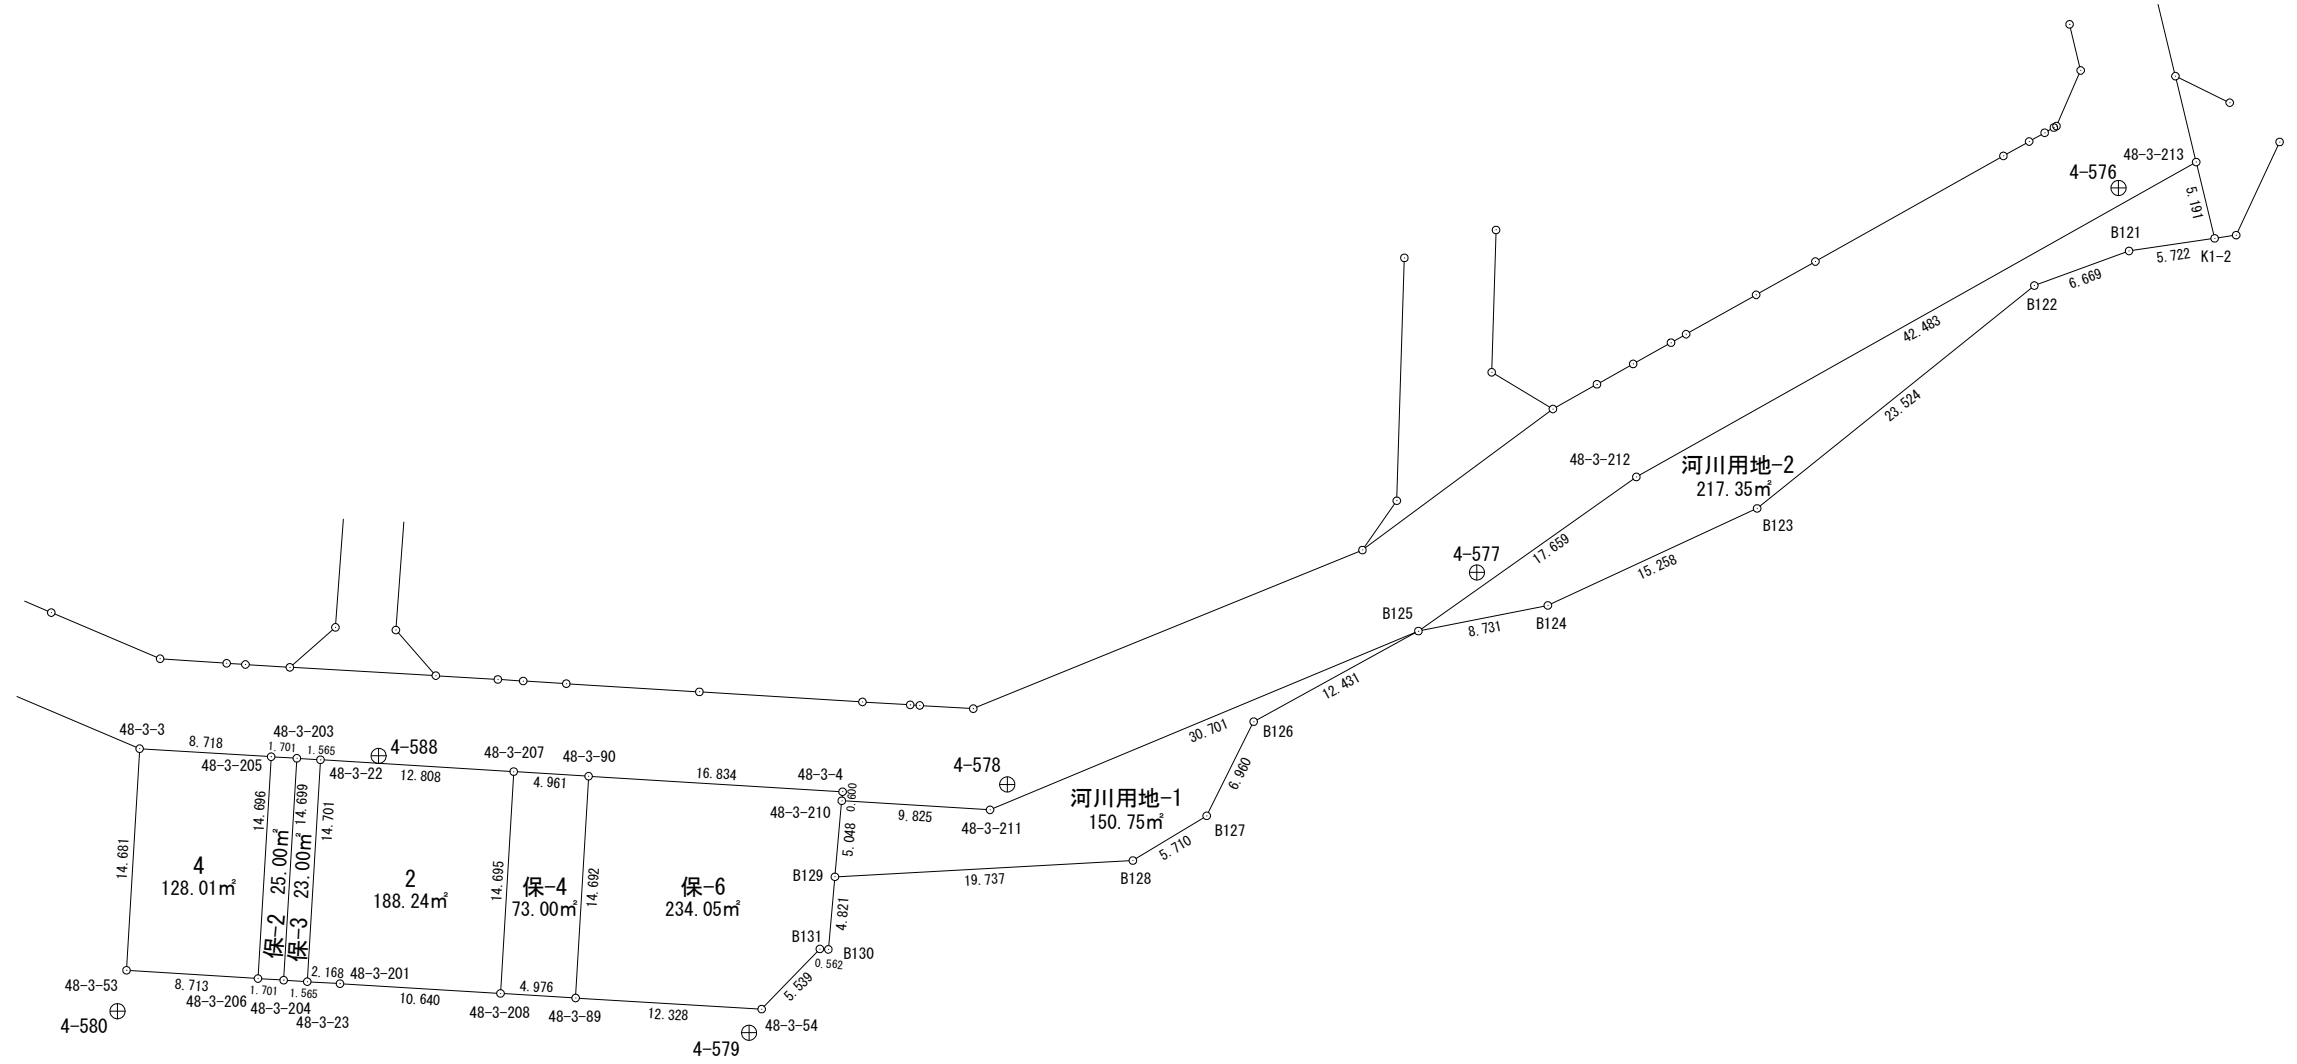

⊕
4-581


面積計算書 (座標法)

世界測地系 (測地成果2011)

所在	地番	公簿地目	現況地目	地積	所有者
前橋市南町二丁目	48-3-1			8280.79 m ²	

点名	X座標	Y座標	辺長	方向角	測角	DX	倍積 (Y×DX)
48-3-201	41355.944	-68684.272	2.168	3-29-26	90-00-36	1.256	-86267.445632
48-3-23	41358.108	-68684.140	1.565	3-35-24	180-05-58	3.726	-255917.105640
48-3-204	41359.670	-68684.042	1.701	3-36-21	180-00-57	3.260	-223909.976920
48-3-206	41361.368	-68683.935	8.713	3-36-21	180-00-00	10.394	-713900.820390
48-3-53	41370.064	-68683.387	14.681	93-22-55	269-46-34	7.830	-537790.920210
48-3-3	41369.198	-68668.732	115.071	22-57-32	109-34-37	105.090	-7216397.045880
48-3-45	41475.154	-68623.846	4.004	338-58-00	136-00-28	109.693	-7527555.539278
48-3-44	41478.891	-68625.283	50.392	294-31-07	135-33-07	24.649	-1691544.600667
48-3-43	41499.803	-68671.131	52.628	210-38-21	96-07-14	-24.369	1673446.791339
48-3-119	41454.522	-68697.952	4.918	217-11-29	186-33-08	-49.199	3379870.540448
48-3-151	41450.604	-68700.925	4.917	230-08-53	192-57-24	-7.069	485646.838825
48-3-120	41447.453	-68704.700	27.983	236-39-51	186-30-58	-18.529	1273029.386300
48-3-12	41432.075	-68728.079	10.877	146-42-37	90-02-46	-24.470	1681776.093130
48-3-11	41422.983	-68722.109	18.441	236-42-51	270-00-14	-19.213	1320357.880217
48-3-10	41412.862	-68737.525	4.484	143-15-01	86-32-10	-13.714	942666.417850
B148	41409.269	-68734.842	5.554	145-49-55	182-34-54	-8.188	562800.886296
B147	41404.674	-68731.723	5.416	134-09-17	168-19-22	-8.368	575147.058064
B146	41400.901	-68727.837	1.747	206-11-02	252-01-45	-5.341	367075.377417
B145	41399.333	-68728.608	5.605	153-54-37	127-43-35	-6.602	453746.270016
B144	41394.299	-68726.143	16.024	141-20-29	167-25-52	-17.547	1205937.631221
B143	41381.786	-68716.133	5.470	116-21-49	155-01-20	-14.942	1026756.459286
B142	41379.357	-68711.232	3.630	166-10-00	229-48-11	-5.954	409106.675328

倍面積	
面積	

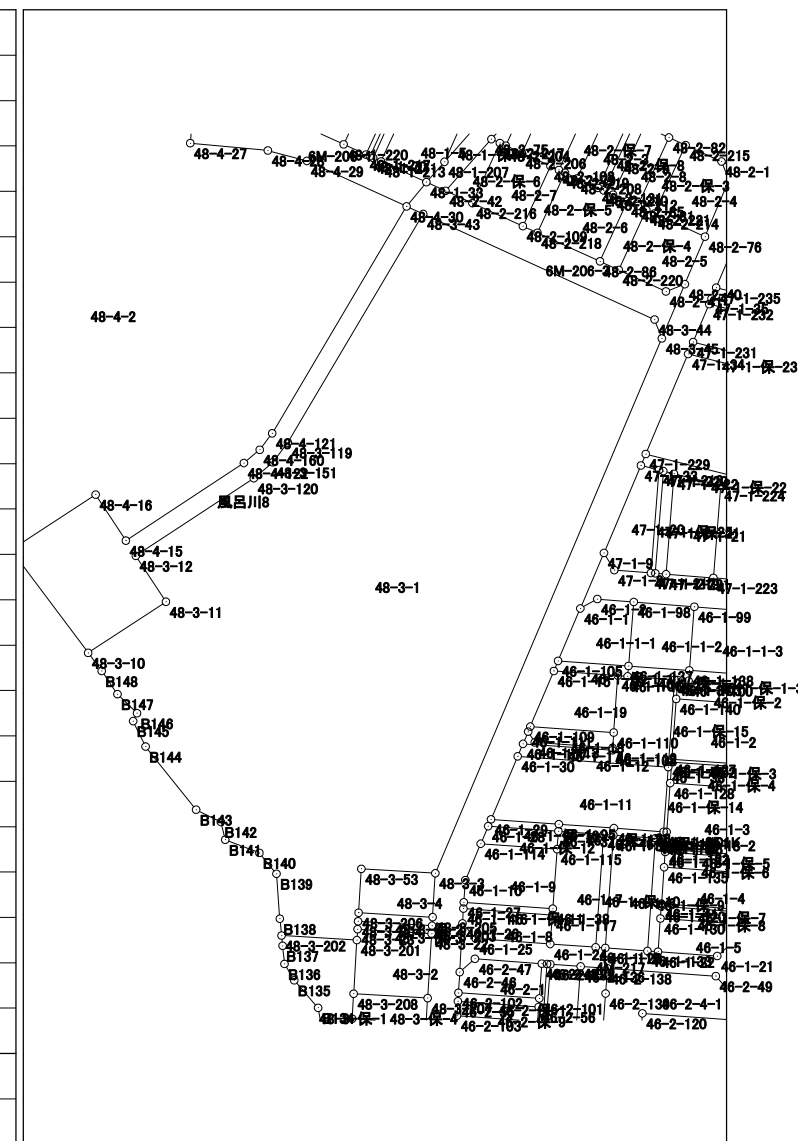


面積計算書（座標法）

世界測地系（測地成果2011）

所在	地番	公簿地目	現況地目	地積	所有者
前橋市南町二丁目	48-3-2			188.24 m ²	

点名	X座標	Y座標	辺長	方向角	測角	DX	倍積 (Y×DX)
48-3-207	41344.452	-68670.249	12.808	3-30-34	90-06-27	11.912	-818000.006088
48-3-22	41357.236	-68669.465	14.701	273-24-02	89-53-28	13.656	-937750.214040
48-3-23	41358.108	-68684.140	2.168	183-29-26	90-05-24	-1.292	88739.908880
48-3-201	41355.944	-68684.272	10.640	183-28-51	179-59-25	-12.784	878059.733248
48-3-208	41345.324	-68684.918	14.695	93-24-07	89-55-16	-11.492	789327.077656
						倍面積	376.499656
						面積	188.2498280

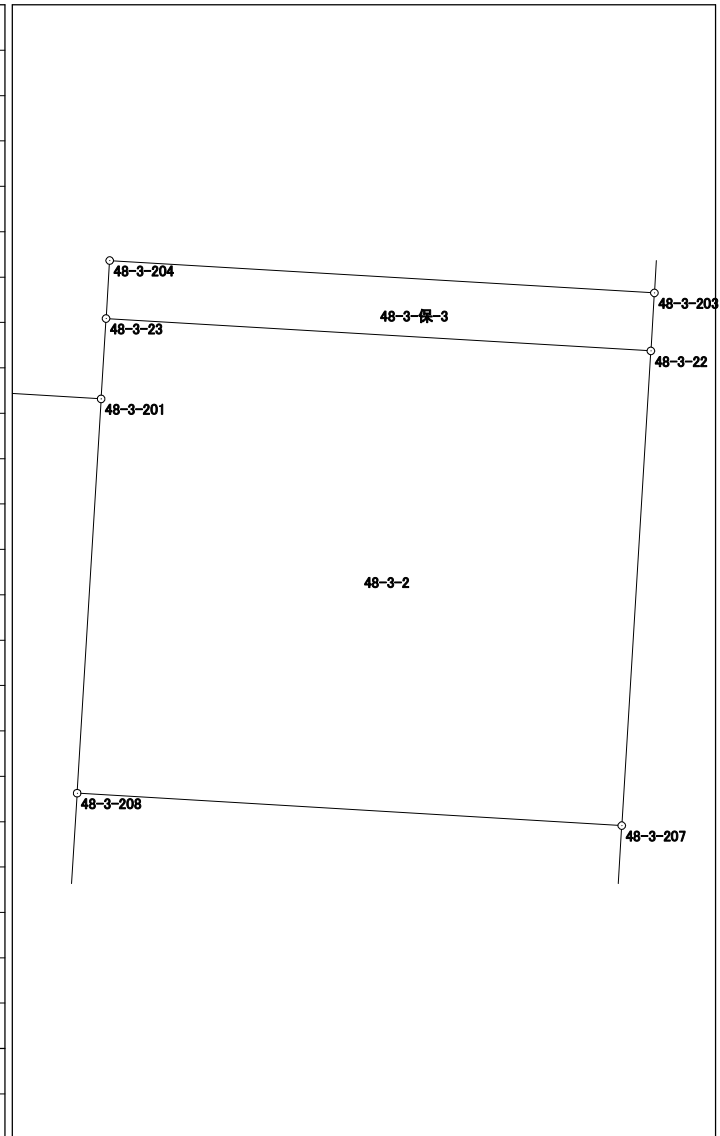


面積計算書 (座標法)

世界測地系 (測地成果2011)

所在	地番	公簿地目	現況地目	地積	所有者
前橋市南町二丁目	48-3-4			128.01 m ²	

点名	X座標	Y座標	辺長	方向角	測角	Dx	倍積 (Y×Dx)
48-3-205	41360.496	-68669.265	8.718	3-30-18	90-06-12	7.830	-537680.344950
48-3-3	41369.198	-68668.732	14.681	273-22-55	89-52-37	9.568	-657022.427776
48-3-53	41370.064	-68683.387	8.713	183-36-21	90-13-26	-7.830	537790.920210
48-3-206	41361.368	-68683.935	14.696	93-24-06	89-47-45	-9.568	657167.890080

倍面積	256.037564
面積	128.0187820

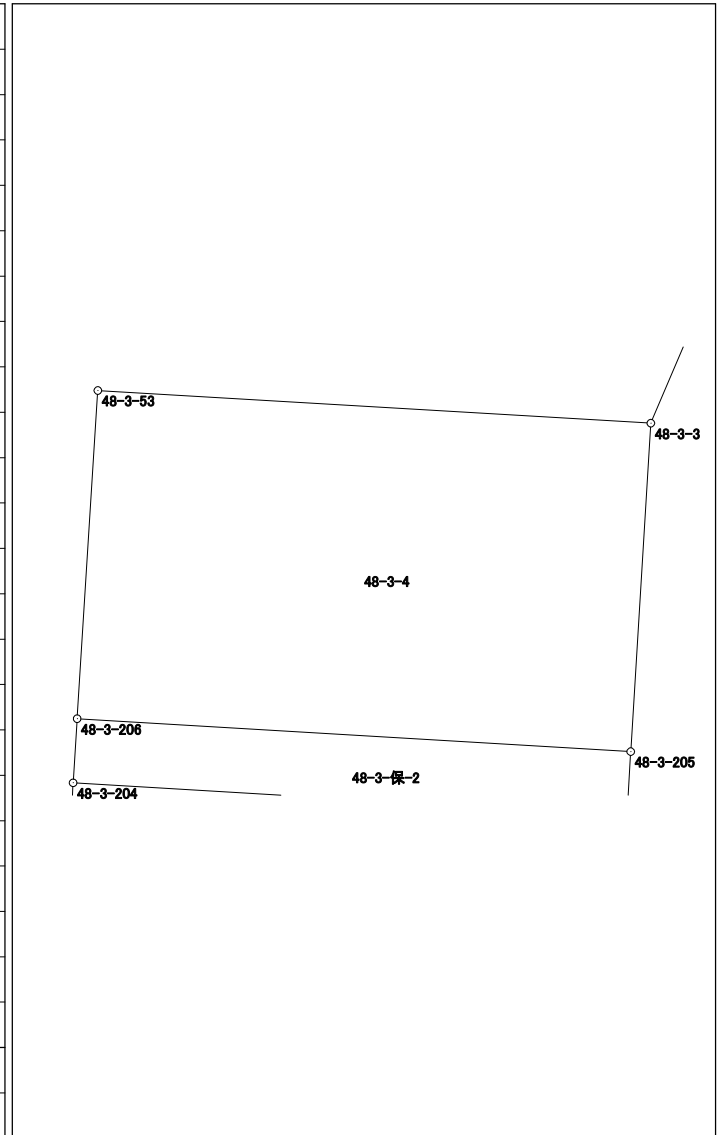


面積計算書 (座標法)

世界測地系 (測地成果2011)

所在	地番	公簿地目	現況地目	地積	所有者
前橋市南町二丁目	48-3-保-1			236.00 m ²	

点名	X座標	Y座標	辺長	方向角	測角	DX	倍積 (Y×DX)
48-3-54	41328.051	-68685.957	12.328	3-25-38	49-23-34	8.369	-574832.774133
48-3-89	41340.357	-68685.220	4.976	3-28-46	180-03-08	17.273	-1186399.805060
48-3-208	41345.324	-68684.918	10.640	3-28-51	180-00-05	15.587	-1070591.816866
48-3-201	41355.944	-68684.272	14.957	273-28-50	89-59-59	11.528	-791792.287616
48-3-202	41356.852	-68699.201	2.037	174-03-15	80-34-25	-1.118	76805.706718
B137	41354.826	-68698.990	3.615	174-05-38	180-02-23	-5.622	386225.721780
B136	41351.230	-68698.618	3.772	149-11-33	155-05-55	-6.836	469623.752648
B135	41347.990	-68696.686	7.223	139-06-35	169-55-02	-8.700	597661.168200
B134	41342.530	-68691.958	7.143	170-09-00	211-02-25	-12.498	858512.091084
B133	41335.492	-68690.736	3.575	168-35-33	178-26-33	-10.542	724137.738912
B132	41331.988	-68690.029	5.664	134-02-04	145-26-31	-7.441	511122.505789


倍面積	472.001456
面積	236.0007280

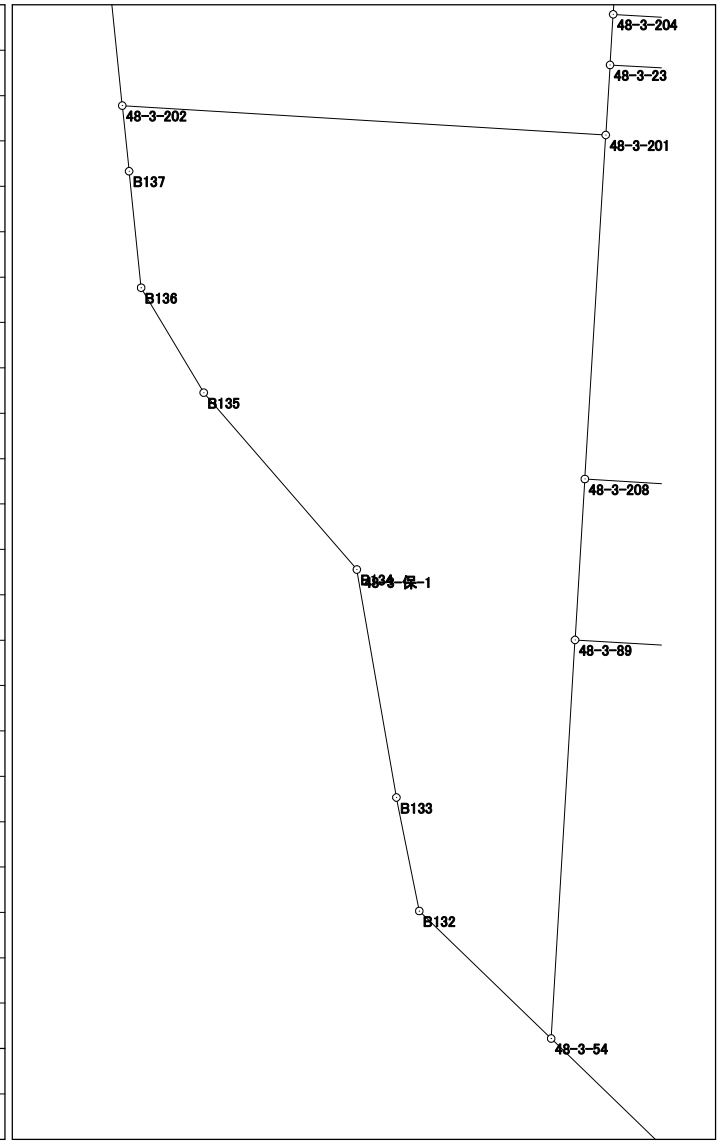

面積計算書（座標法）

所在	地番	公簿地目	現況地目	地積	所有者
前橋市南町二丁目	48-3-保-2			25.00 m ²	

点名	X座標	Y座標	辺長	方向角	測角	Dx	倍積 (Y×Dx)
48-3-203	41358.798	-68669.369	1.701	3-30-18	90-06-14	0.826	-56720.898794
48-3-205	41360.496	-68669.265	14.696	273-24-06	89-53-48	2.570	-176480.011050
48-3-206	41361.368	-68683.935	1.701	183-36-21	90-12-15	-0.826	56732.930310
48-3-204	41359.670	-68684.042	14.699	93-24-04	89-47-43	-2.570	176517.987940

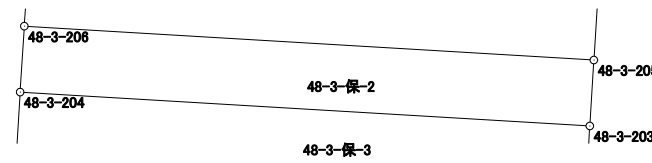


倍面積	50.008406
面積	25.0042030

面積計算書（座標法）

世界測地系（測地成果2011）

所 在	地 番	公簿地目	現況地目	地 積	所 有 者
前橋市南町二丁目	48-3-保-3			23.00 m ²	

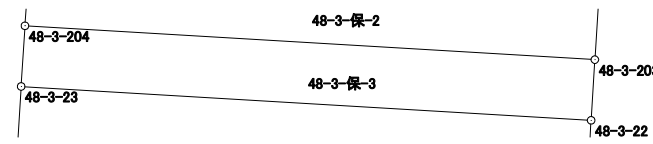
点 名	X 座標	Y 座標	辺 長	方 向 角	測 角	DX	倍 積 (Y×DX)	
48-3-23	41358.108	-68684.140	14.701	93-24-02	89-48-38	-2.434	167177.196760	
48-3-22	41357.236	-68669.465	1.565	3-31-01	90-06-59	0.690	-47381.930850	
48-3-203	41358.798	-68669.369	14.699	273-24-04	89-53-03	2.434	-167141.244146	
48-3-204	41359.670	-68684.042	1.565	183-35-24	90-11-20	-0.690	47391.988980	
						倍面積	46.010744	
						面 積	23.0053720	

面積計算書 (座標法)

世界測地系 (測地成果2011)

所在	地番	公簿地目	現況地目	地積	所有者
前橋市南町二丁目	48-3-保-4			73.00 m ²	

点名	X座標	Y座標	辺長	方向角	測角	Dx	倍積 (Y×Dx)
48-3-89	41340.357	-68685.220	14.692	93-20-38	89-51-52	-5.824	400022.721280
48-3-90	41339.500	-68670.553	4.961	3-30-47	90-10-09	4.095	-281205.914535
48-3-207	41344.452	-68670.249	14.695	273-24-07	89-53-20	5.824	-399935.530176
48-3-208	41345.324	-68684.918	4.976	183-28-46	90-04-39	-4.095	281264.739210

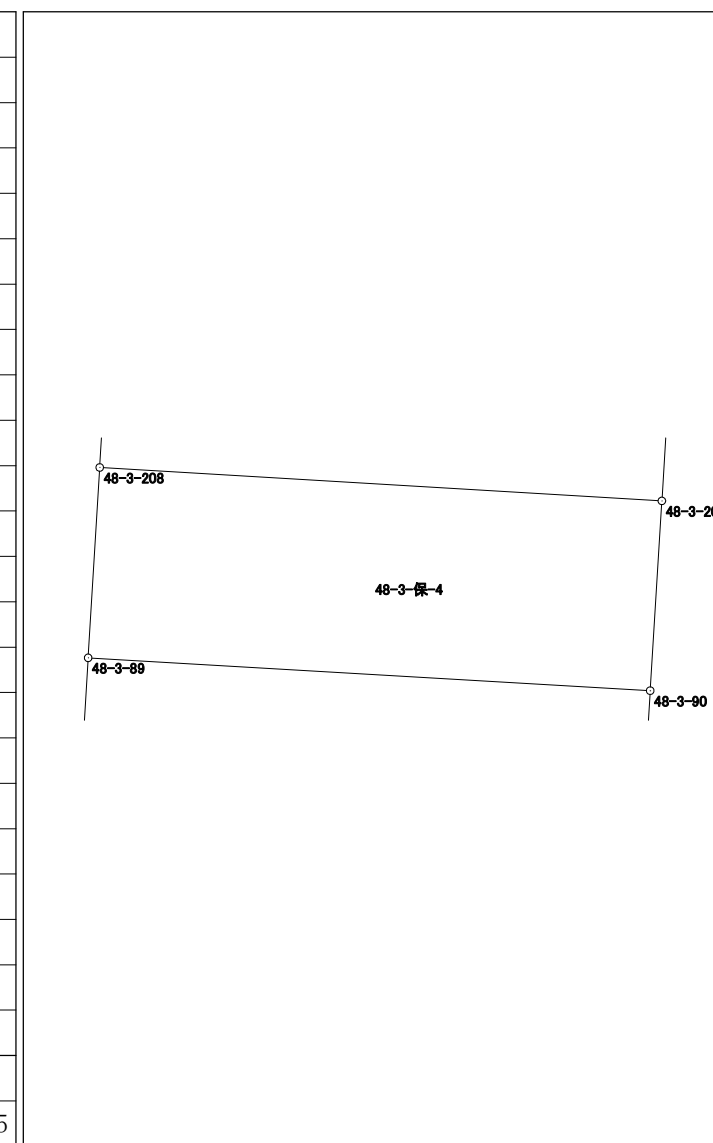


倍面積	146.015779
面積	73.0078895

面積計算書 (座標法)

世界測地系 (測地成果2011)

所在	地番	公簿地目	現況地目	地積	所有者
前橋市南町二丁目	48-3-保-6			234.05 m ²	

点名	X座標	Y座標	辺長	方向角	測角	DX	倍積 (Y×DX)
48-3-89	41340.357	-68685.220	12.328	183-25-38	90-05-00	-11.449	786377.083780
48-3-54	41328.051	-68685.957	5.539	134-02-04	130-36-26	-16.156	1109690.321292
B131	41324.201	-68681.975	0.562	183-21-59	229-19-55	-4.411	302956.191725
B130	41323.640	-68682.008	4.821	95-10-38	91-48-39	-0.996	68407.279968
B129	41323.205	-68677.207	5.048	95-09-34	179-58-56	-0.889	61054.037023
48-3-210	41322.751	-68672.179	0.600	95-09-36	180-00-02	-0.508	34885.466932
48-3-4	41322.697	-68671.581	16.834	3-30-03	88-20-27	16.749	-1150180.310169
48-3-90	41339.500	-68670.553	14.692	273-20-38	89-50-35	17.660	-1212721.965980

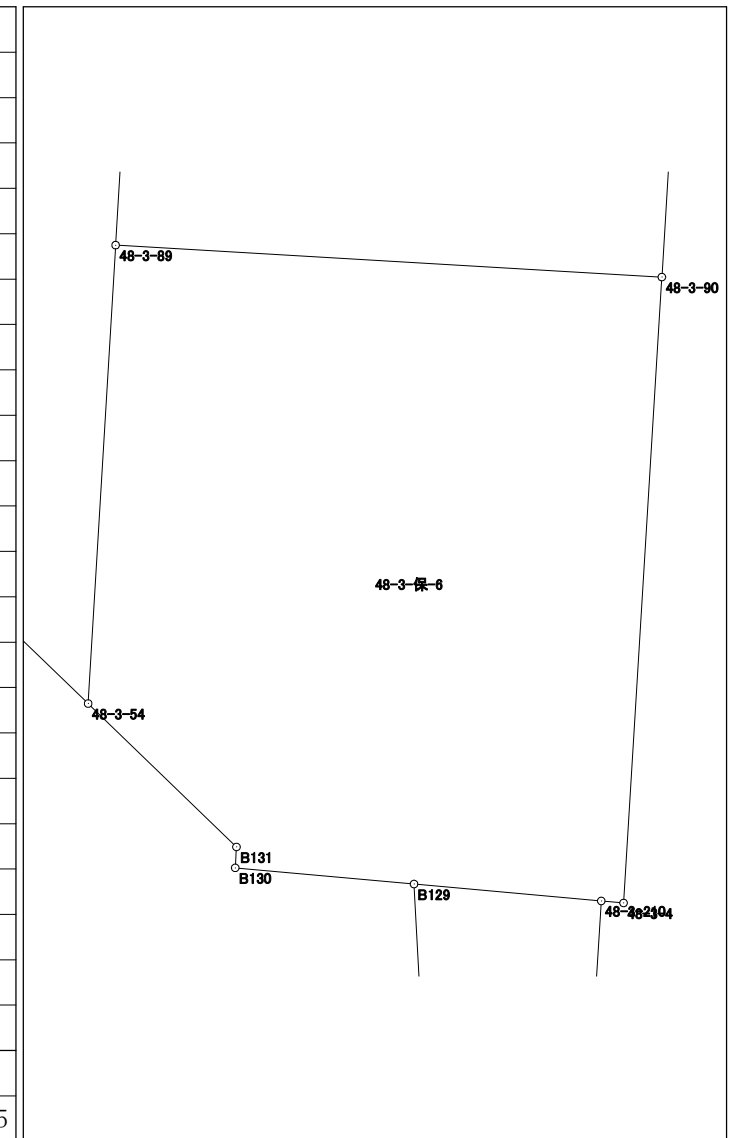

倍面積	468.104571
面積	234.0522855