



49-2街区 画地出来形確認図 (5299.54㎡)

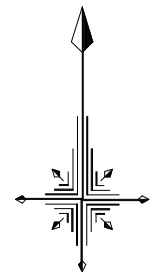

S=1/500

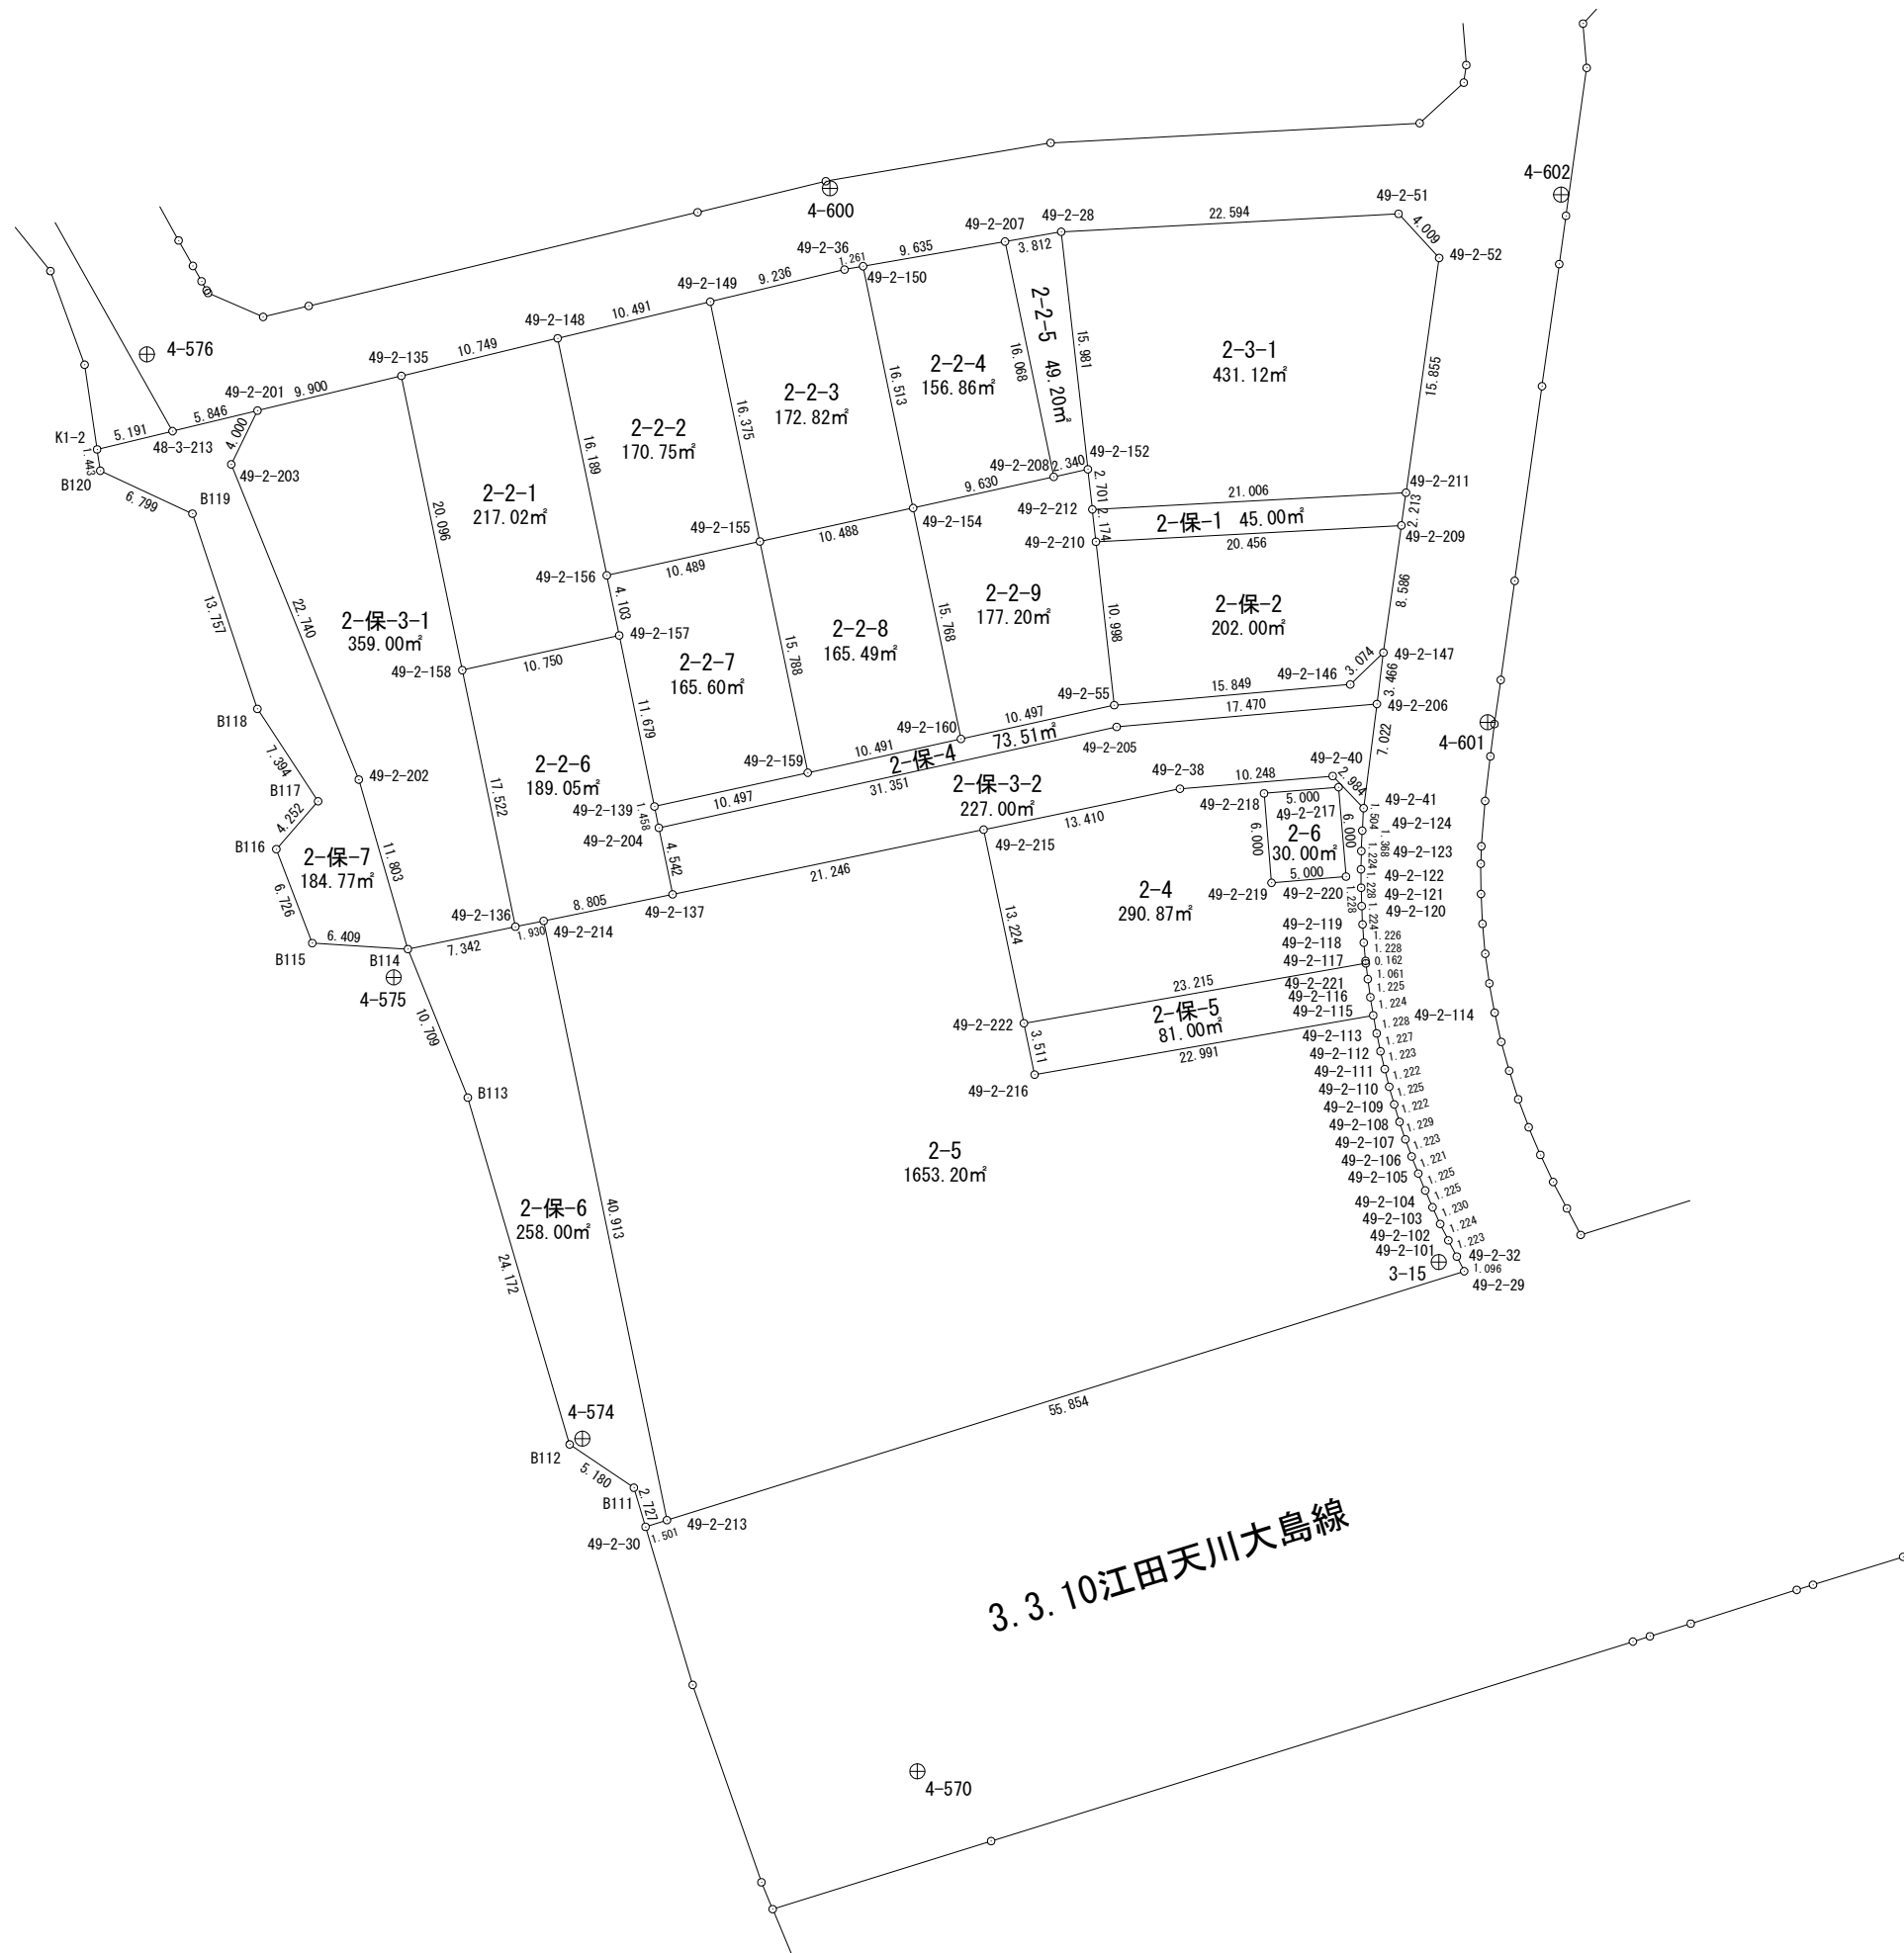


面積計算書 (座標法)

世界測地系 (測地成果2011)

所在	地番	公簿地目	現況地目	地積	所有者
前橋市六供町二丁目	49-2-2-1			217.02 m ²	

点名	X座標	Y座標	辺長	方向角	測角	DX	倍積 (Y×DX)
49-2-135	41236.859	-68614.637	20.096	168-18-56	91-49-09	-22.190	1522558.795030
49-2-158	41217.179	-68610.567	10.750	77-32-14	89-13-18	-17.360	1191079.443120
49-2-157	41219.499	-68600.070	4.103	348-18-54	90-46-40	6.338	-434787.243660
49-2-156	41223.517	-68600.901	16.189	348-17-45	179-58-51	19.870	-1363099.902870
49-2-148	41239.369	-68604.185	10.749	256-29-47	88-12-02	13.342	-915317.036270


倍面積	434.055350
面積	217.0276750

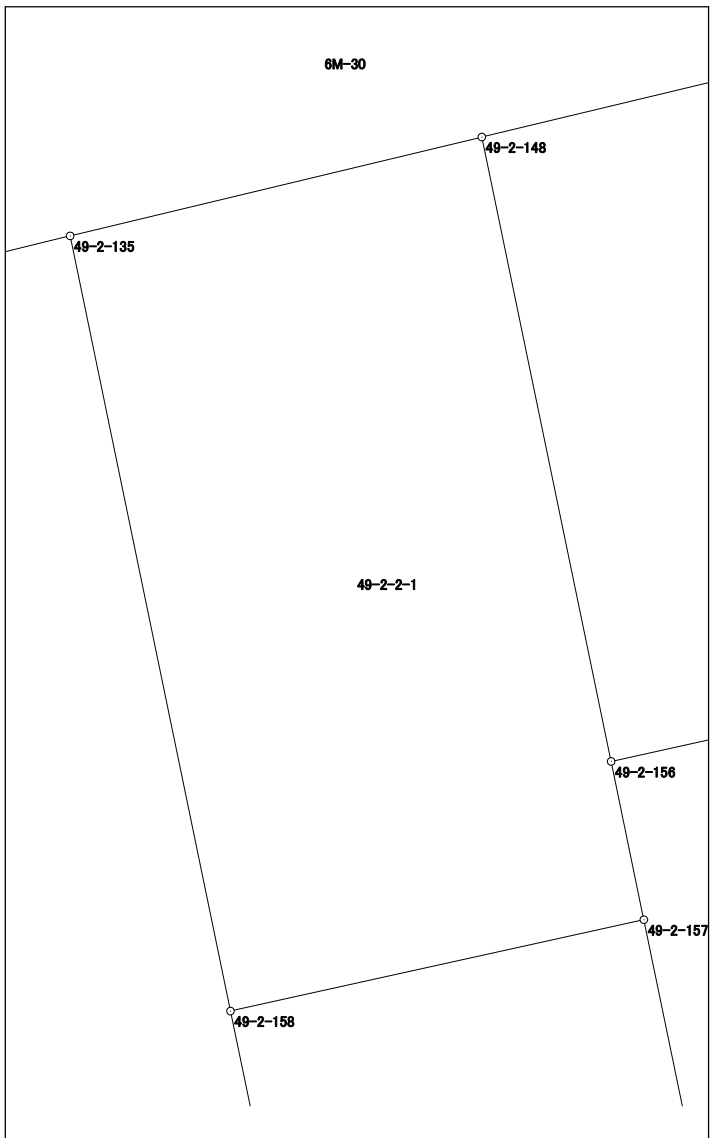

面積計算書 (座標法)

所在	地番	公簿地目	現況地目	地積	所有者
前橋市六供町二丁目	49-2-2-2			170.75 m ²	

点名	X座標	Y座標	辺長	方向角	測角	DX	倍積 (Y×DX)
49-2-148	41239.369	-68604.185	16.189	168-17-45	91-46-42	-18.298	1255319.377130
49-2-156	41223.517	-68600.901	10.489	77-32-07	89-14-22	-13.588	932149.042788
49-2-155	41225.781	-68590.659	16.375	348-17-17	90-45-10	18.298	-1255071.878382
49-2-149	41241.815	-68593.983	10.491	256-31-03	88-13-46	13.588	-932055.041004

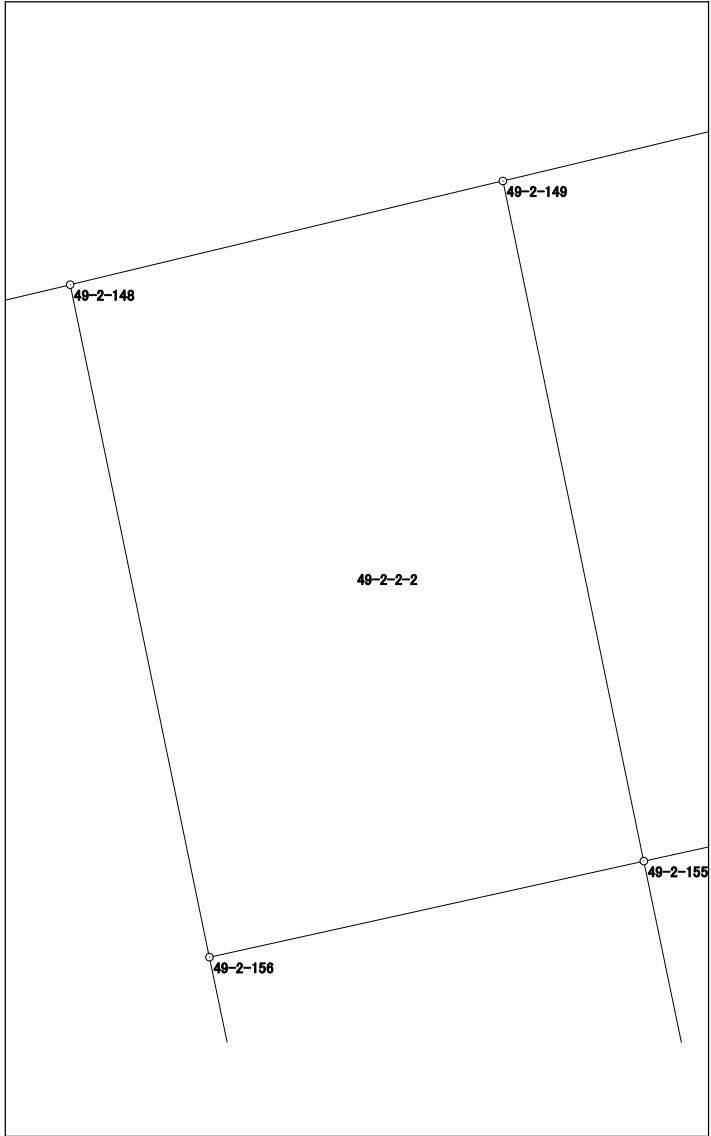


倍面積	341.500532
面積	170.7502660

面積計算書（座標法）

世界測地系（測地成果2011）

所在	地番	公簿地目	現況地目	地積	所有者
前橋市六供町二丁目	49-2-2-3			172.82 m ²	

点名	X座標	Y座標	辺長	方向角	測角	DX	倍積 (Y×DX)
49-2-149	41241.815	-68593.983	16.375	168-17-17	91-45-20	-18.185	1247381.580855
49-2-155	41225.781	-68590.659	10.488	77-40-43	89-23-26	-13.796	946276.731564
49-2-154	41228.019	-68580.413	16.513	348-18-20	90-37-37	18.408	-1262428.242504
49-2-150	41244.189	-68583.760	1.261	259-48-47	91-30-27	15.947	-1093705.220720
49-2-36	41243.966	-68585.001	9.236	256-31-57	176-43-10	-2.374	162820.792374
						倍面積	345.641569
						面積	172.8207845

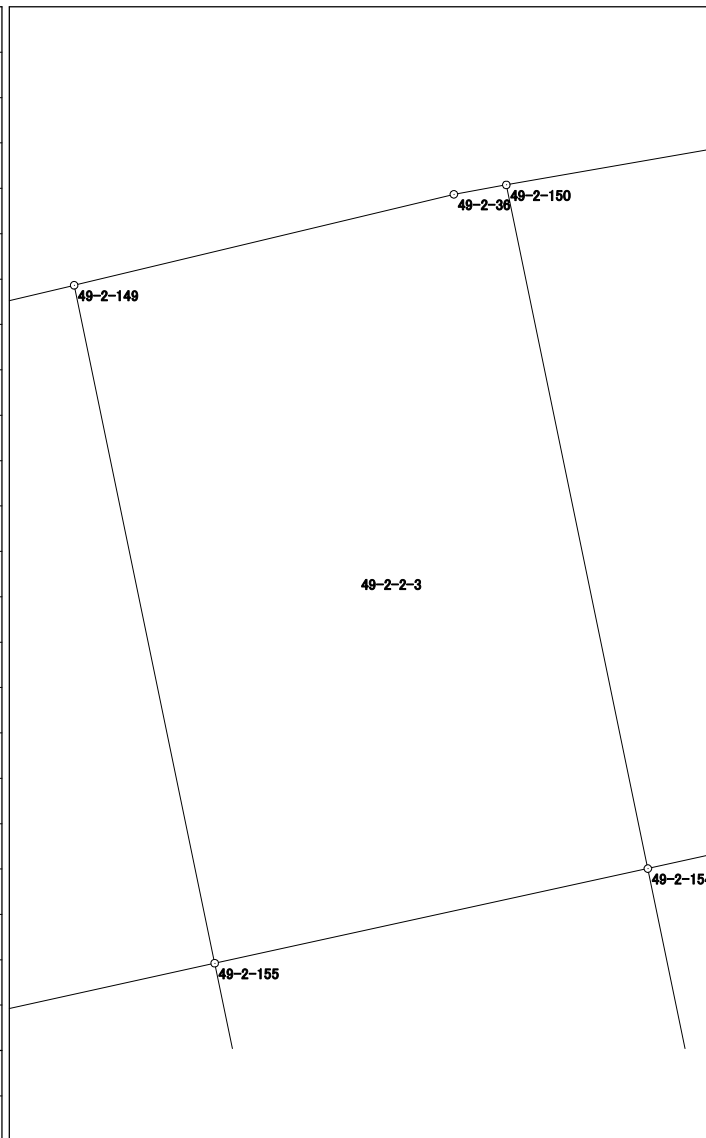


面積計算書 (座標法)

世界測地系 (測地成果2011)

所 在	地 番	公簿地目	現況地目	地 積	所 有 者
前橋市六供町二丁目	49-2-2-4			156.86 m ²	

点 名	X 座標	Y 座標	辺 長	方 向 角	測 角	DX	倍 積 (Y×DX)
49-2-207	41245.840	-68574.268	9.635	260-07-59	91-49-27	14.084	-965799.990512
49-2-150	41244.189	-68583.760	16.513	168-18-20	88-10-21	-17.821	1222231.186960
49-2-154	41228.019	-68580.413	9.630	77-29-21	89-11-01	-14.084	965886.536692
49-2-208	41230.105	-68571.012	16.068	348-18-32	90-49-11	17.821	-1222004.004852
						倍面積	313.728288
						面 積	156.8641440

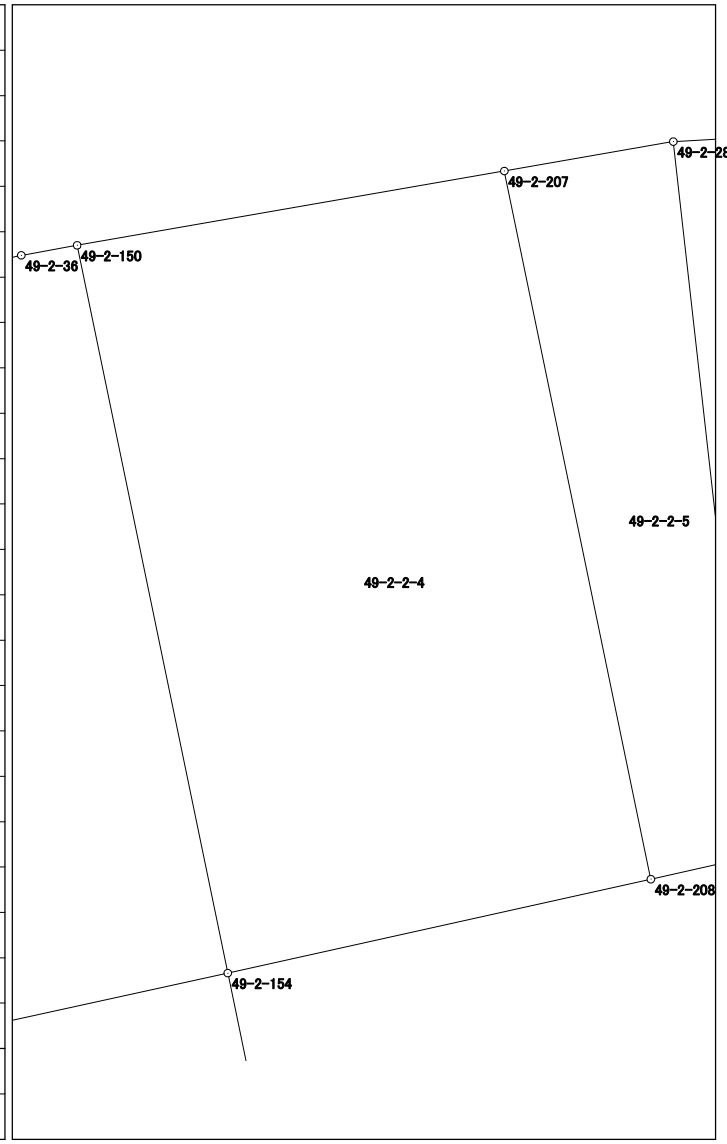


面積計算書 (座標法)

世界測地系 (測地成果2011)

所在	地番	公簿地目	現況地目	地積	所有者
前橋市六供町二丁目	49-2-2-5			49.20 m ²	

点名	X座標	Y座標	辺長	方向角	測角	DX	倍積 (Y×DX)
49-2-28	41246.493	-68570.512	3.812	260-08-15	86-32-49	15.228	-1044191.756736
49-2-207	41245.840	-68574.268	16.068	168-18-32	88-10-17	-16.388	1123795.103984
49-2-208	41230.105	-68571.012	2.340	77-29-04	89-10-32	-15.228	1044199.370736
49-2-152	41230.612	-68568.728	15.981	353-35-26	96-06-22	16.388	-1123704.314464

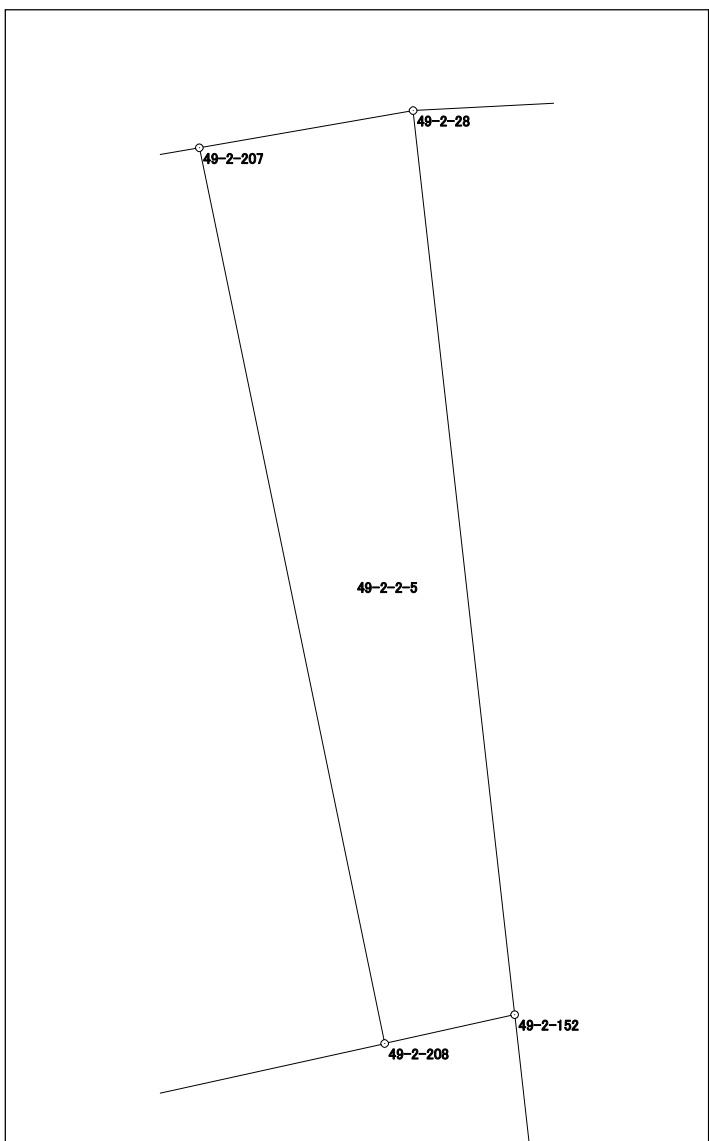


倍面積	98.403520
面積	49.2017600

面積計算書（座標法）

世界測地系（測地成果2011）

所在	地番	公簿地目	現況地目	地積	所有者
前橋市六供町二丁目	49-2-2-6			189.05 m ²	

点名	X座標	Y座標	辺長	方向角	測角	DX	倍積 (Y×DX)
49-2-158	41217.179	-68610.567	17.522	168-17-51	90-45-37	-19.478	1336396.624026
49-2-136	41200.021	-68607.013	1.930	78-22-11	90-04-20	-16.769	1150471.000997
49-2-214	41200.410	-68605.123	8.805	78-22-11	180-00-00	2.164	-148461.486172
49-2-137	41202.185	-68596.499	4.542	348-20-19	89-58-08	6.223	-426876.013277
49-2-204	41206.633	-68597.417	1.458	348-19-40	179-59-21	5.876	-403078.422292
49-2-139	41208.061	-68597.712	11.679	348-21-05	180-01-25	12.866	-882578.162592
49-2-157	41219.499	-68600.070	10.750	257-32-14	89-11-09	9.118	-625495.438260

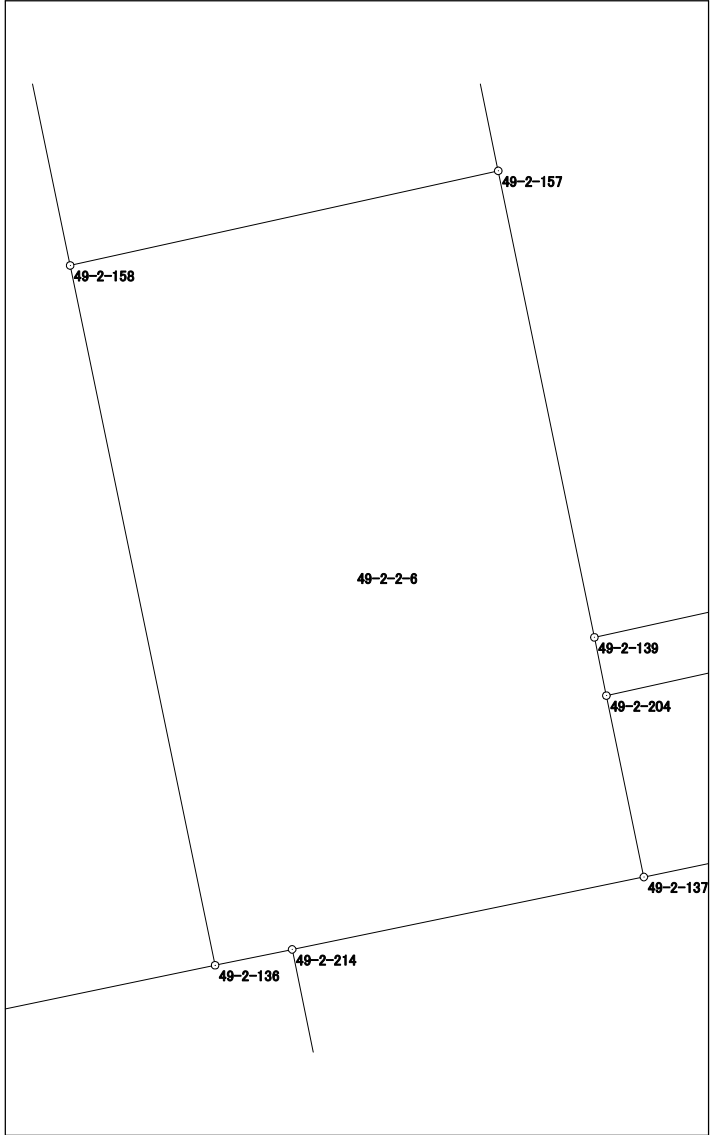


倍面積	378.102430
面積	189.0512150

面積計算書 (座標法)

世界測地系 (測地成果2011)

所在	地番	公簿地目	現況地目	地積	所有者
前橋市六供町二丁目	49-2-3-1			431.12 m ²	

点名	X座標	Y座標	辺長	方向角	測角	DX	倍積 (Y×DX)
49-2-211	41229.045	-68547.451	15.855	8-02-04	101-04-58	16.816	-1152693.936016
49-2-52	41244.744	-68545.235	4.009	317-22-32	129-20-28	18.649	-1278300.087515
49-2-51	41247.694	-68547.950	22.594	266-57-11	129-34-39	1.749	-119890.364550
49-2-28	41246.493	-68570.512	15.981	173-35-26	86-38-15	-17.082	1171321.485984
49-2-152	41230.612	-68568.728	2.701	173-36-04	180-00-38	-18.565	1272978.435320
49-2-212	41227.928	-68568.427	21.006	86-57-06	93-21-02	-1.567	107446.725109

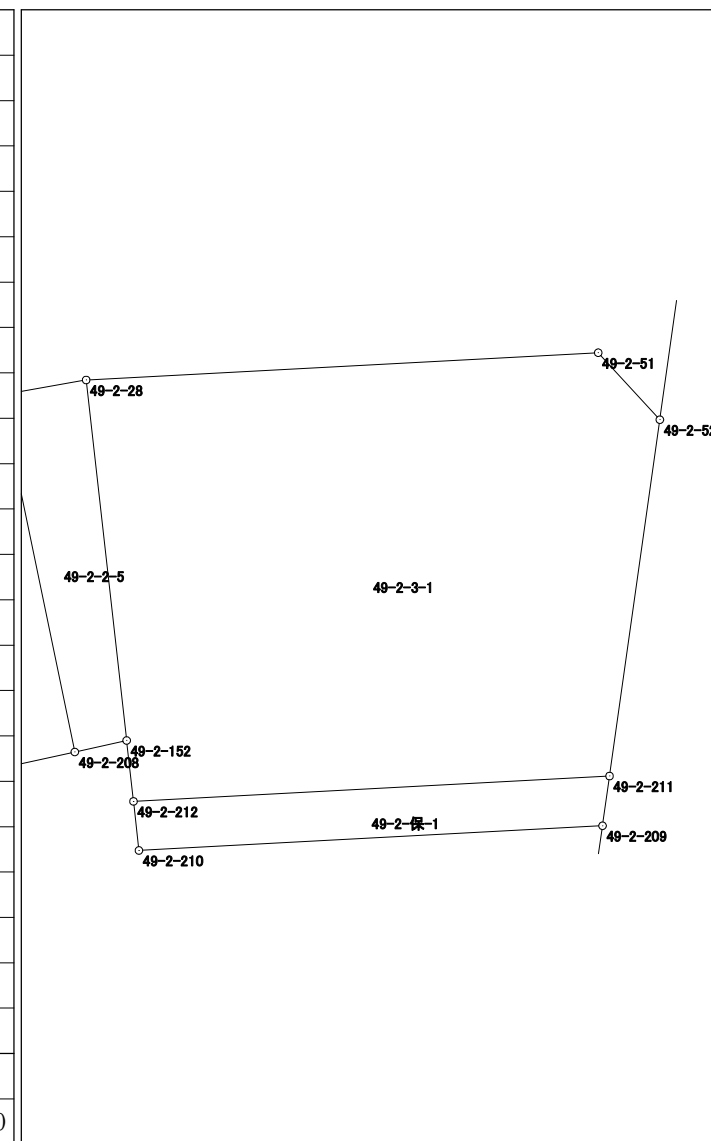


倍面積	862.258332
面積	431.1291660

面積計算書（座標法）

世界測地系（測地成果2011）

所在	地番	公簿地目	現況地目	地積	所有者
前橋市六供町二丁目	49-2-4			290.87 m ²	

点名	X座標	Y座標	辺長	方向角	測角	Dx	倍積 (Y×Dx)
49-2-221	41197.571	-68550.137	0.162	352-55-08	92-51-11	4.166	-285579.870742
49-2-117	41197.732	-68550.157	1.228	354-29-04	181-33-56	1.383	-94804.867131
49-2-118	41198.954	-68550.275	1.226	356-09-51	181-40-47	2.445	-167605.422375
49-2-119	41200.177	-68550.357	1.224	357-11-29	181-01-38	2.446	-167674.173222
49-2-120	41201.400	-68550.417	1.228	358-24-51	181-13-22	2.451	-168017.072067
49-2-121	41202.628	-68550.451	1.228	359-23-36	180-58-45	2.456	-168359.907656
49-2-122	41203.856	-68550.464	1.224	1-07-24	181-43-48	2.452	-168085.737728
49-2-123	41205.080	-68550.440	1.368	2-35-49	181-28-25	2.591	-177614.190040
49-2-124	41206.447	-68550.378	1.504	3-30-27	180-54-38	2.868	-196602.484104
49-2-41	41207.948	-68550.286	2.984	316-04-22	132-33-55	3.650	-250208.543900
49-2-40	41210.097	-68552.356	0.843	152-04-03	15-59-41	1.404	-96247.507824
49-2-217	41209.352	-68551.961	6.000	175-13-45	203-09-42	-6.724	460943.385764
49-2-220	41203.373	-68551.462	5.000	265-13-40	269-59-55	-6.395	438386.599490
49-2-219	41202.957	-68556.445	6.000	355-13-45	270-00-05	5.563	-381379.503535
49-2-218	41208.936	-68556.944	5.000	85-13-40	269-59-55	6.395	-438421.656880
49-2-217	41209.352	-68551.961	0.843	332-04-03	66-50-23	1.161	-79588.826721
49-2-40	41210.097	-68552.356	10.248	265-13-53	113-09-50	-0.107	7335.102092
49-2-38	41209.245	-68562.569	13.410	258-14-42	173-00-49	-3.584	245728.247296
49-2-215	41206.513	-68575.698	13.224	168-14-44	90-00-02	-15.679	1075198.368942
49-2-222	41193.566	-68573.004	23.215	80-03-57	91-49-13	-8.942	613179.801768

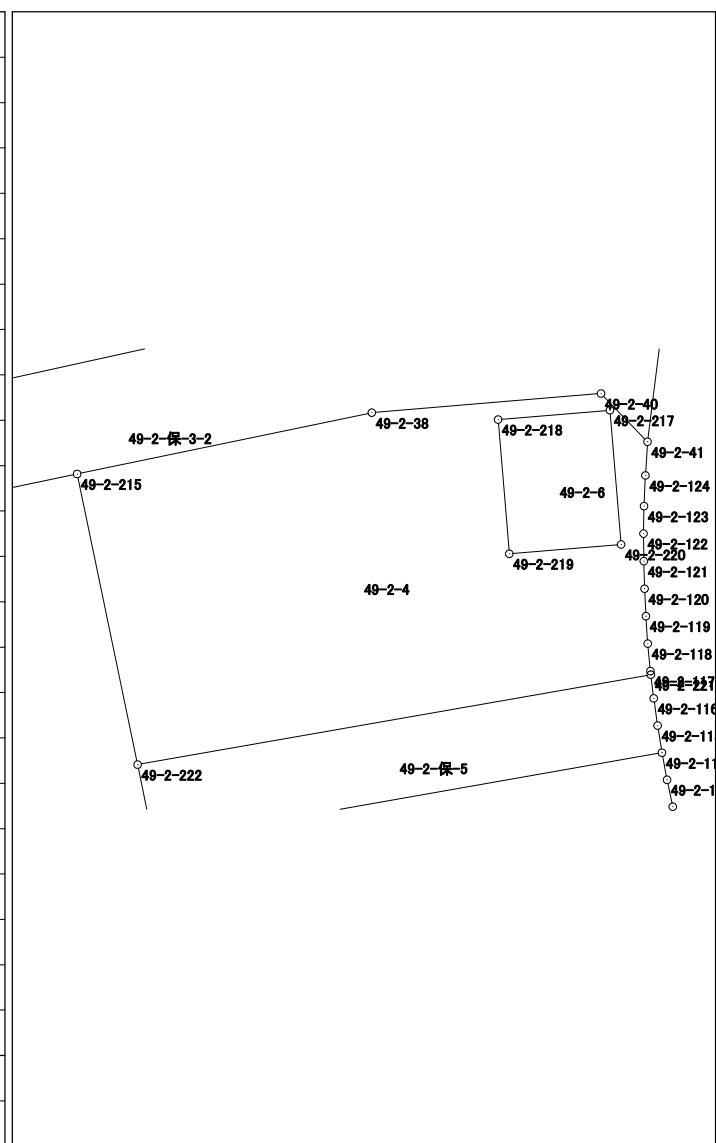

倍面積	581.741427
面積	290.8707135


面積計算書 (座標法)

世界測地系 (測地成果2011)

所在	地番	公簿地目	現況地目	地積	所有者
前橋市六供町二丁目	49-2-5			1653.20 m ²	

点名	X座標	Y座標	辺長	方向角	測角	DX	倍積 (Y×DX)
49-2-214	41200.410	-68605.123	40.913	168-22-15	90-00-04	-41.848	2870987.187304
49-2-213	41160.337	-68596.876	55.854	72-39-39	84-17-24	-23.427	1607019.014052
49-2-29	41176.983	-68543.560	1.096	333-19-05	80-39-26	17.625	-1208080.245000
49-2-32	41177.962	-68544.052	1.223	332-25-45	179-06-40	2.063	-141406.379276
49-2-101	41179.046	-68544.618	1.224	333-29-52	181-04-07	2.179	-149358.722622
49-2-102	41180.141	-68545.164	1.230	335-18-34	181-48-42	2.213	-151690.447932
49-2-103	41181.259	-68545.678	1.225	336-31-53	181-13-19	2.242	-153679.410076
49-2-104	41182.383	-68546.166	1.225	337-44-49	181-12-56	2.258	-154777.242828
49-2-105	41183.517	-68546.630	1.221	338-43-48	180-58-59	2.272	-155737.943360
49-2-106	41184.655	-68547.073	1.223	339-49-00	181-05-12	2.286	-156698.608878
49-2-107	41185.803	-68547.495	1.229	341-38-20	181-49-20	2.314	-158618.903430
49-2-108	41186.969	-68547.882	1.222	342-54-52	181-16-32	2.334	-159990.756588
49-2-109	41188.137	-68548.241	1.225	344-13-41	181-18-49	2.347	-160882.721627
49-2-110	41189.316	-68548.574	1.222	345-53-03	181-39-22	2.364	-162048.828936
49-2-111	41190.501	-68548.872	1.223	346-19-39	180-26-36	2.373	-162666.473256
49-2-112	41191.689	-68549.161	1.227	348-06-15	181-46-36	2.389	-163763.945629
49-2-113	41192.890	-68549.414	1.228	349-14-54	181-08-39	2.407	-164998.439498
49-2-114	41194.096	-68549.643	22.991	260-03-51	90-48-57	-2.761	189265.564323
49-2-216	41190.129	-68572.289	3.511	348-14-54	268-11-03	-0.530	36343.313170
49-2-222	41193.566	-68573.004	13.224	348-14-44	179-59-50	16.384	-1123500.097536
49-2-215	41206.513	-68575.698	21.246	258-14-47	90-00-03	8.619	-591053.941062
49-2-137	41202.185	-68596.499	8.805	258-22-11	180-07-24	-6.103	418644.433397


倍面積	3306.404712
面積	1653.2023560

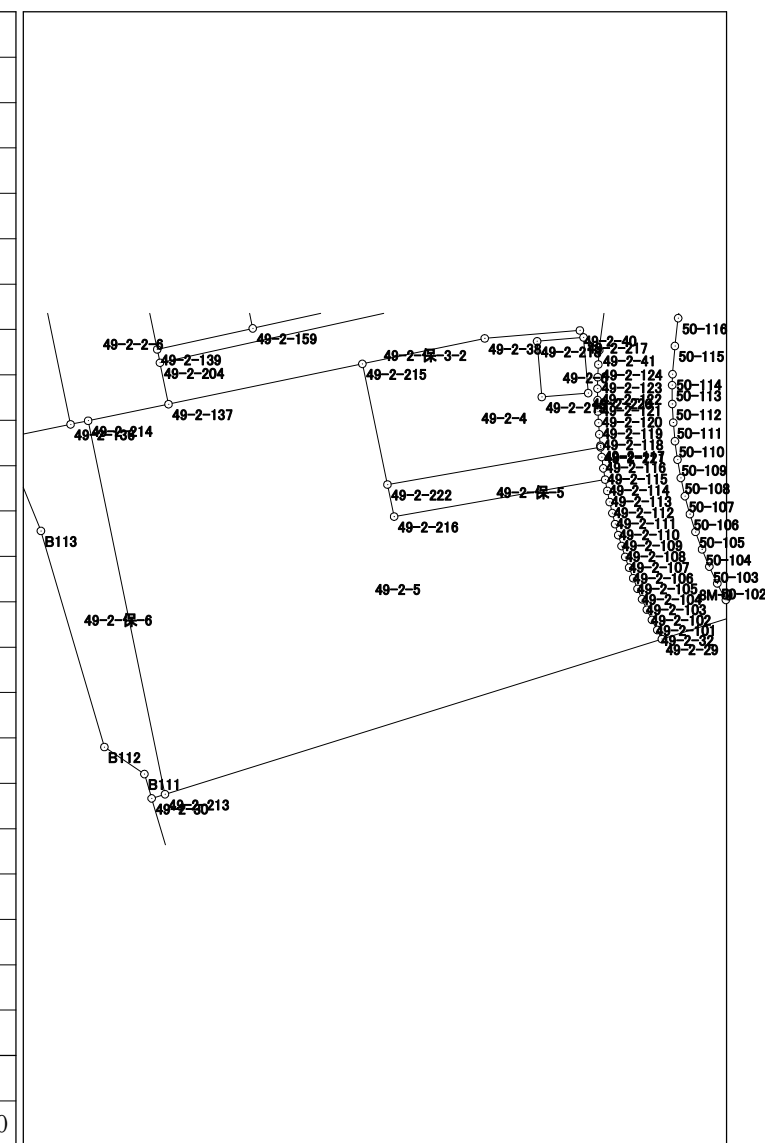

面積計算書（座標法）

世界測地系（測地成果2011）

所在	地番	公簿地目	現況地目	地積	所有者
前橋市六供町二丁目	49-2-6			30.00 m ²	

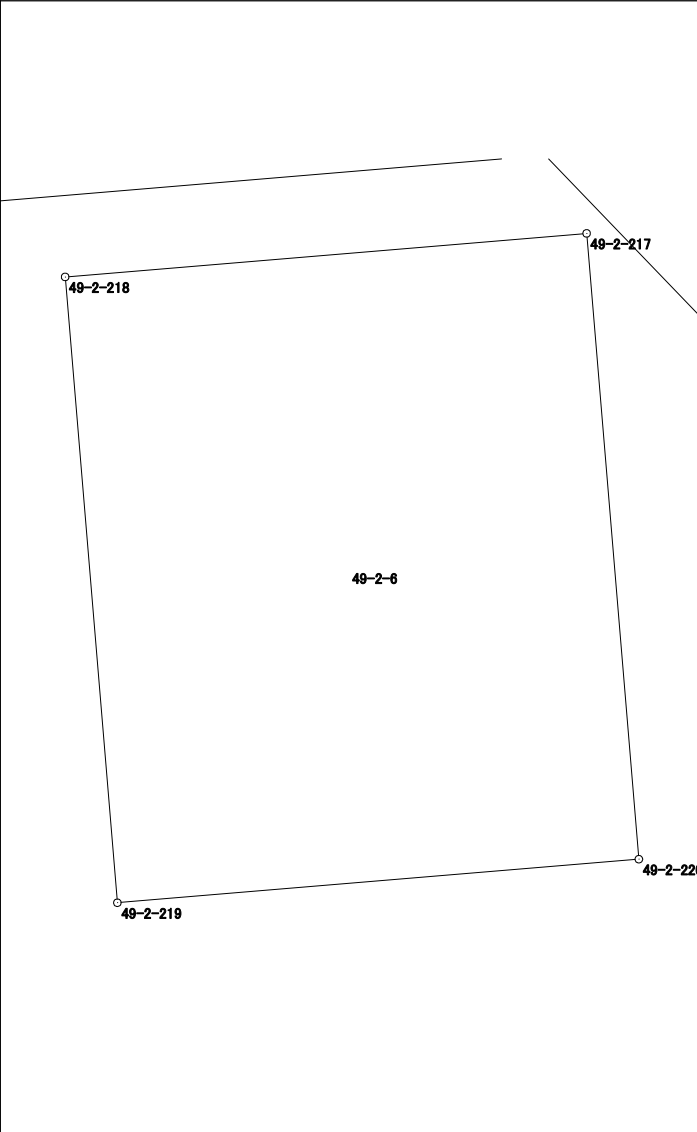
点名	X座標	Y座標	辺長	方向角	測角	DX	倍積 (Y×DX)	
49-2-218	41208.936	-68556.944	6.000	175-13-45	90-00-05	-6.395	438421.656880	
49-2-219	41202.957	-68556.445	5.000	85-13-40	89-59-55	-5.563	381379.503535	
49-2-220	41203.373	-68551.462	6.000	355-13-45	90-00-05	6.395	-438386.599490	
49-2-217	41209.352	-68551.961	5.000	265-13-40	89-59-55	5.563	-381354.559043	
倍面積							60.001882	
面積							30.0009410	

面積計算書 (座標法)

世界測地系 (測地成果2011)

所在	地番	公簿地目	現況地目	地積	所有者
前橋市六供町二丁目	49-2-保-1			45.00 m ²	

点名	X座標	Y座標	辺長	方向角	測角	DX	倍積 (Y×DX)
49-2-209	41226.854	-68547.760	2.213	8-01-39	101-04-25	3.278	-224699.557280
49-2-211	41229.045	-68547.451	21.006	266-57-06	78-55-27	1.074	-73619.962374
49-2-212	41227.928	-68568.427	2.174	173-39-46	86-42-40	-3.278	224767.303706
49-2-210	41225.767	-68568.187	20.456	86-57-14	93-17-28	-1.074	73642.232838
倍面積						90.016890	
面積						45.0084450	

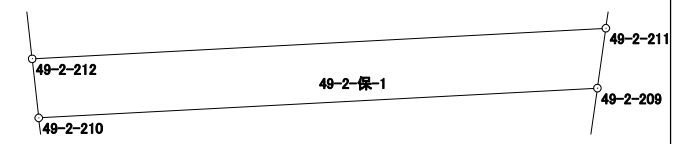


面積計算書 (座標法)

世界測地系 (測地成果2011)

所在	地番	公簿地目	現況地目	地積	所有者
前橋市六供町二丁目	49-2-保-3-1			359.00 m ²	

点名	X座標	Y座標	辺長	方向角	測角	DX	倍積 (Y×DX)
49-2-201	41234.534	-68624.260	4.000	206-02-23	129-37-21	-5.919	406186.994940
49-2-203	41230.940	-68626.016	22.740	157-58-26	131-56-03	-24.674	1693278.318784
49-2-202	41209.860	-68617.488	11.803	163-49-48	185-51-22	-32.416	2224304.491008
B114	41198.524	-68614.201	7.342	78-14-08	94-24-20	-9.839	675095.123639
49-2-136	41200.021	-68607.013	17.522	348-17-51	90-03-43	18.655	-1279863.827515
49-2-158	41217.179	-68610.567	20.096	348-18-56	180-01-05	36.838	-2527476.067146
49-2-135	41236.859	-68614.637	9.900	256-25-02	88-06-06	17.355	-1190807.025135
						倍面積	718.008575
						面積	359.0042875

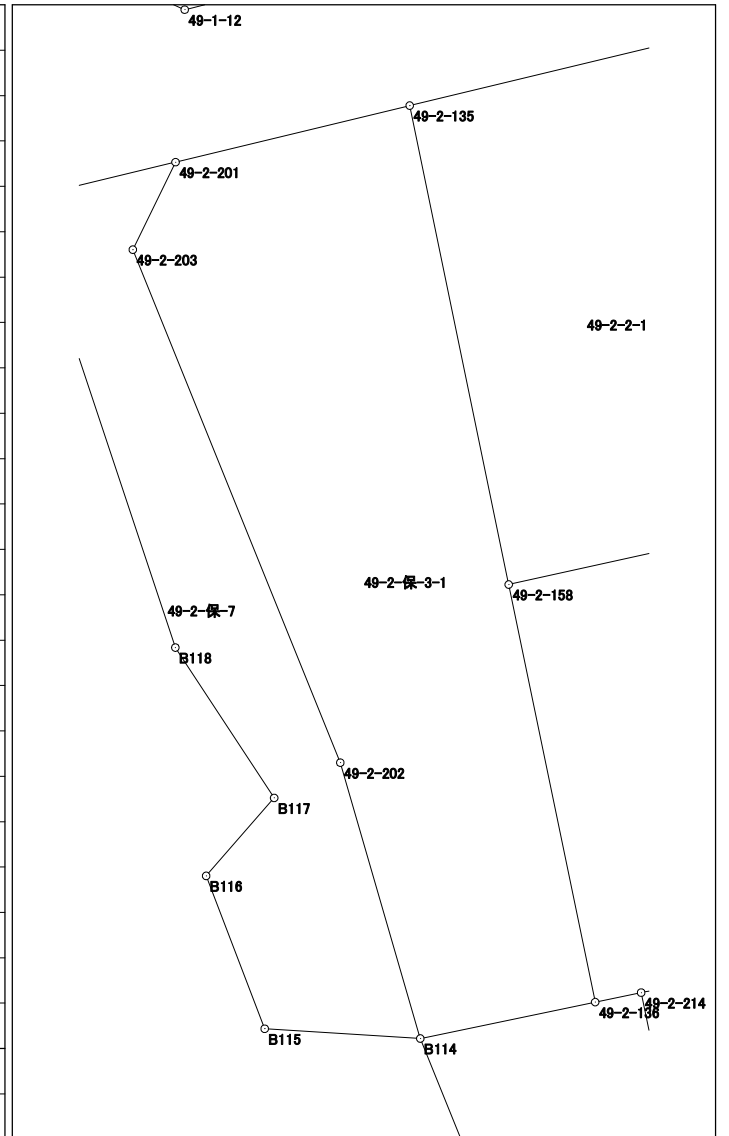


面積計算書 (座標法)

世界測地系 (測地成果2011)

所在	地番	公簿地目	現況地目	地積	所有者
前橋市六供町二丁目	49-2-保-4			73.51 m ²	

点名	X座標	Y座標	辺長	方向角	測角	DX	倍積 (Y×DX)
49-2-139	41208.061	-68597.712	1.458	168-19-40	90-45-19	-3.687	252919.764144
49-2-204	41206.633	-68597.417	31.351	77-34-20	89-14-40	5.319	-364869.661023
49-2-205	41213.380	-68566.801	17.470	84-57-46	187-23-26	8.281	-567801.679081
49-2-206	41214.914	-68549.398	3.466	7-15-37	102-17-51	4.972	-340827.606856
49-2-147	41218.352	-68548.960	3.074	226-08-48	38-53-11	1.308	-89662.039680
49-2-146	41216.222	-68551.177	15.849	264-59-12	218-50-24	-3.515	240957.387155
49-2-55	41214.837	-68566.965	10.497	257-34-21	172-35-09	-3.644	249858.020460
49-2-160	41212.578	-68577.216	10.491	257-34-15	179-59-54	-4.517	309763.284672
49-2-159	41210.320	-68587.461	10.497	257-34-21	180-00-06	-4.517	309809.561337

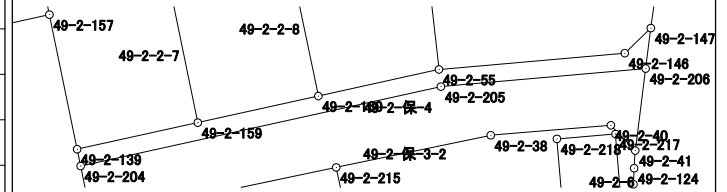


倍面積	147.031128
面積	73.5155640

面積計算書（座標法）

世界測地系（測地成果2011）

所在	地番	公簿地目	現況地目	地積	所有者
前橋市六供町二丁目	49-2-保-6			258.00 m ²	

点名	X座標	Y座標	辺長	方向角	測角	DX	倍積 (Y×DX)
B114	41198.524	-68614.201	10.709	158-01-36	79-47-28	-11.428	784123.089028
B113	41188.593	-68610.194	24.172	163-37-53	185-36-17	-33.123	2272575.455862
B112	41165.401	-68603.382	5.180	124-01-17	140-23-24	-26.090	1789862.236380
B111	41162.503	-68599.089	2.727	163-22-45	219-21-28	-5.511	378049.579479
49-2-30	41159.890	-68598.309	1.501	72-40-32	89-17-47	-2.166	148583.937294
49-2-213	41160.337	-68596.876	40.913	348-22-15	95-41-43	40.520	-2779545.415520
49-2-214	41200.410	-68605.123	1.930	258-22-11	89-59-56	39.684	-2722525.701132
49-2-136	41200.021	-68607.013	7.342	258-14-08	179-51-57	-1.886	129392.826518
倍面積							516.007909
面積							258.0039545

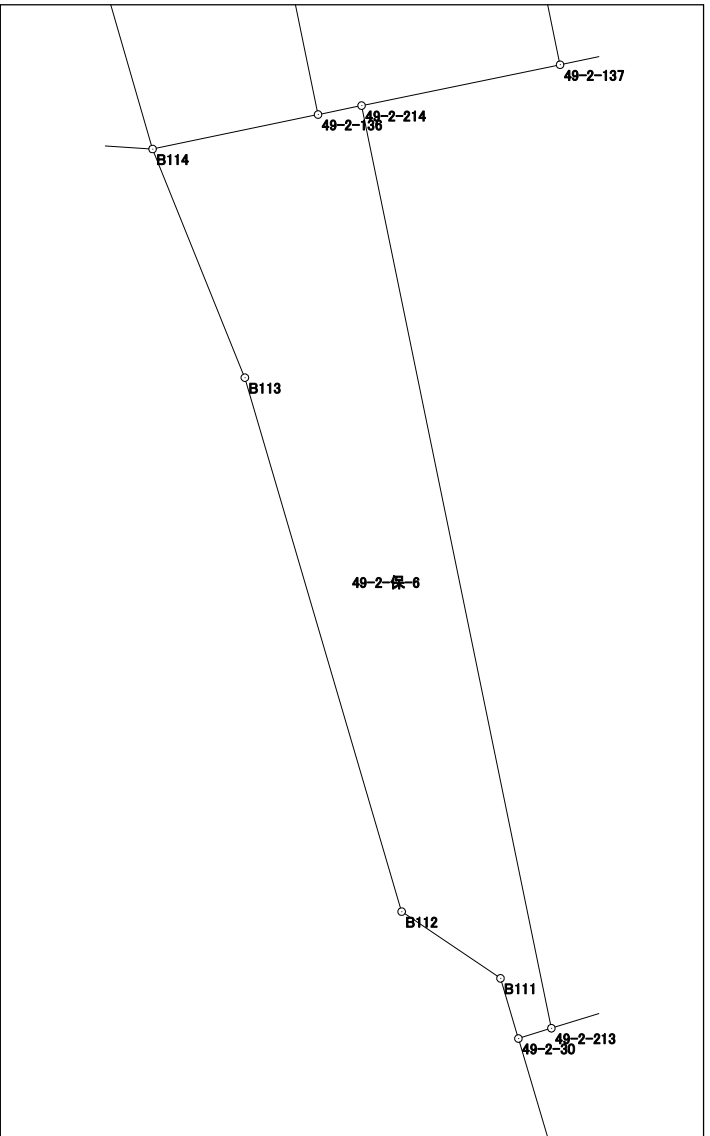

面積計算書 (座標法)

世界測地系 (測地成果2011)

所在	地番	公簿地目	現況地目	地積	所有者
前橋市六供町二丁目	49-2-保-7			184.77 m ²	

点名	X座標	Y座標	辺長	方向角	測角	DX	倍積(Y×DX)
K1-2	41231.940	-68634.987	1.443	171-35-21	95-11-40	-2.648	181745.445576
B120	41230.513	-68634.776	6.799	114-58-42	123-23-21	-4.298	294992.267248
B119	41227.642	-68628.613	13.757	161-35-20	226-36-38	-15.924	1092842.033412
B118	41214.589	-68624.268	7.394	146-40-31	165-05-11	-19.231	1319713.297908
B117	41208.411	-68620.206	4.252	221-05-59	254-25-28	-9.382	643794.772692
B116	41205.207	-68623.001	6.726	159-03-33	117-57-34	-9.486	650957.787486
B115	41198.925	-68620.597	6.409	93-35-15	114-31-42	-6.683	458591.449751
B114	41198.524	-68614.201	11.803	343-49-48	70-14-33	10.935	-750296.287935
49-2-202	41209.860	-68617.488	22.740	337-58-26	174-08-38	32.416	-2224304.491008
49-2-203	41230.940	-68626.016	4.000	26-02-23	228-03-57	24.674	-1693278.318784
49-2-201	41234.534	-68624.260	5.846	256-24-56	50-22-33	2.221	-152414.481460
48-3-213	41233.161	-68629.942	5.191	256-23-41	179-58-45	-2.594	178026.069548
						倍面積	369.544434
						面積	184.7722170

