


4-1街区
4-2街区
4-3街区


画地出来形確認図

(656.76m)
(665.78m)
(468.41m)

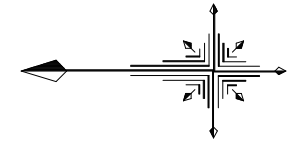

S=1/500

3. 3. 2 前橋長瀬線

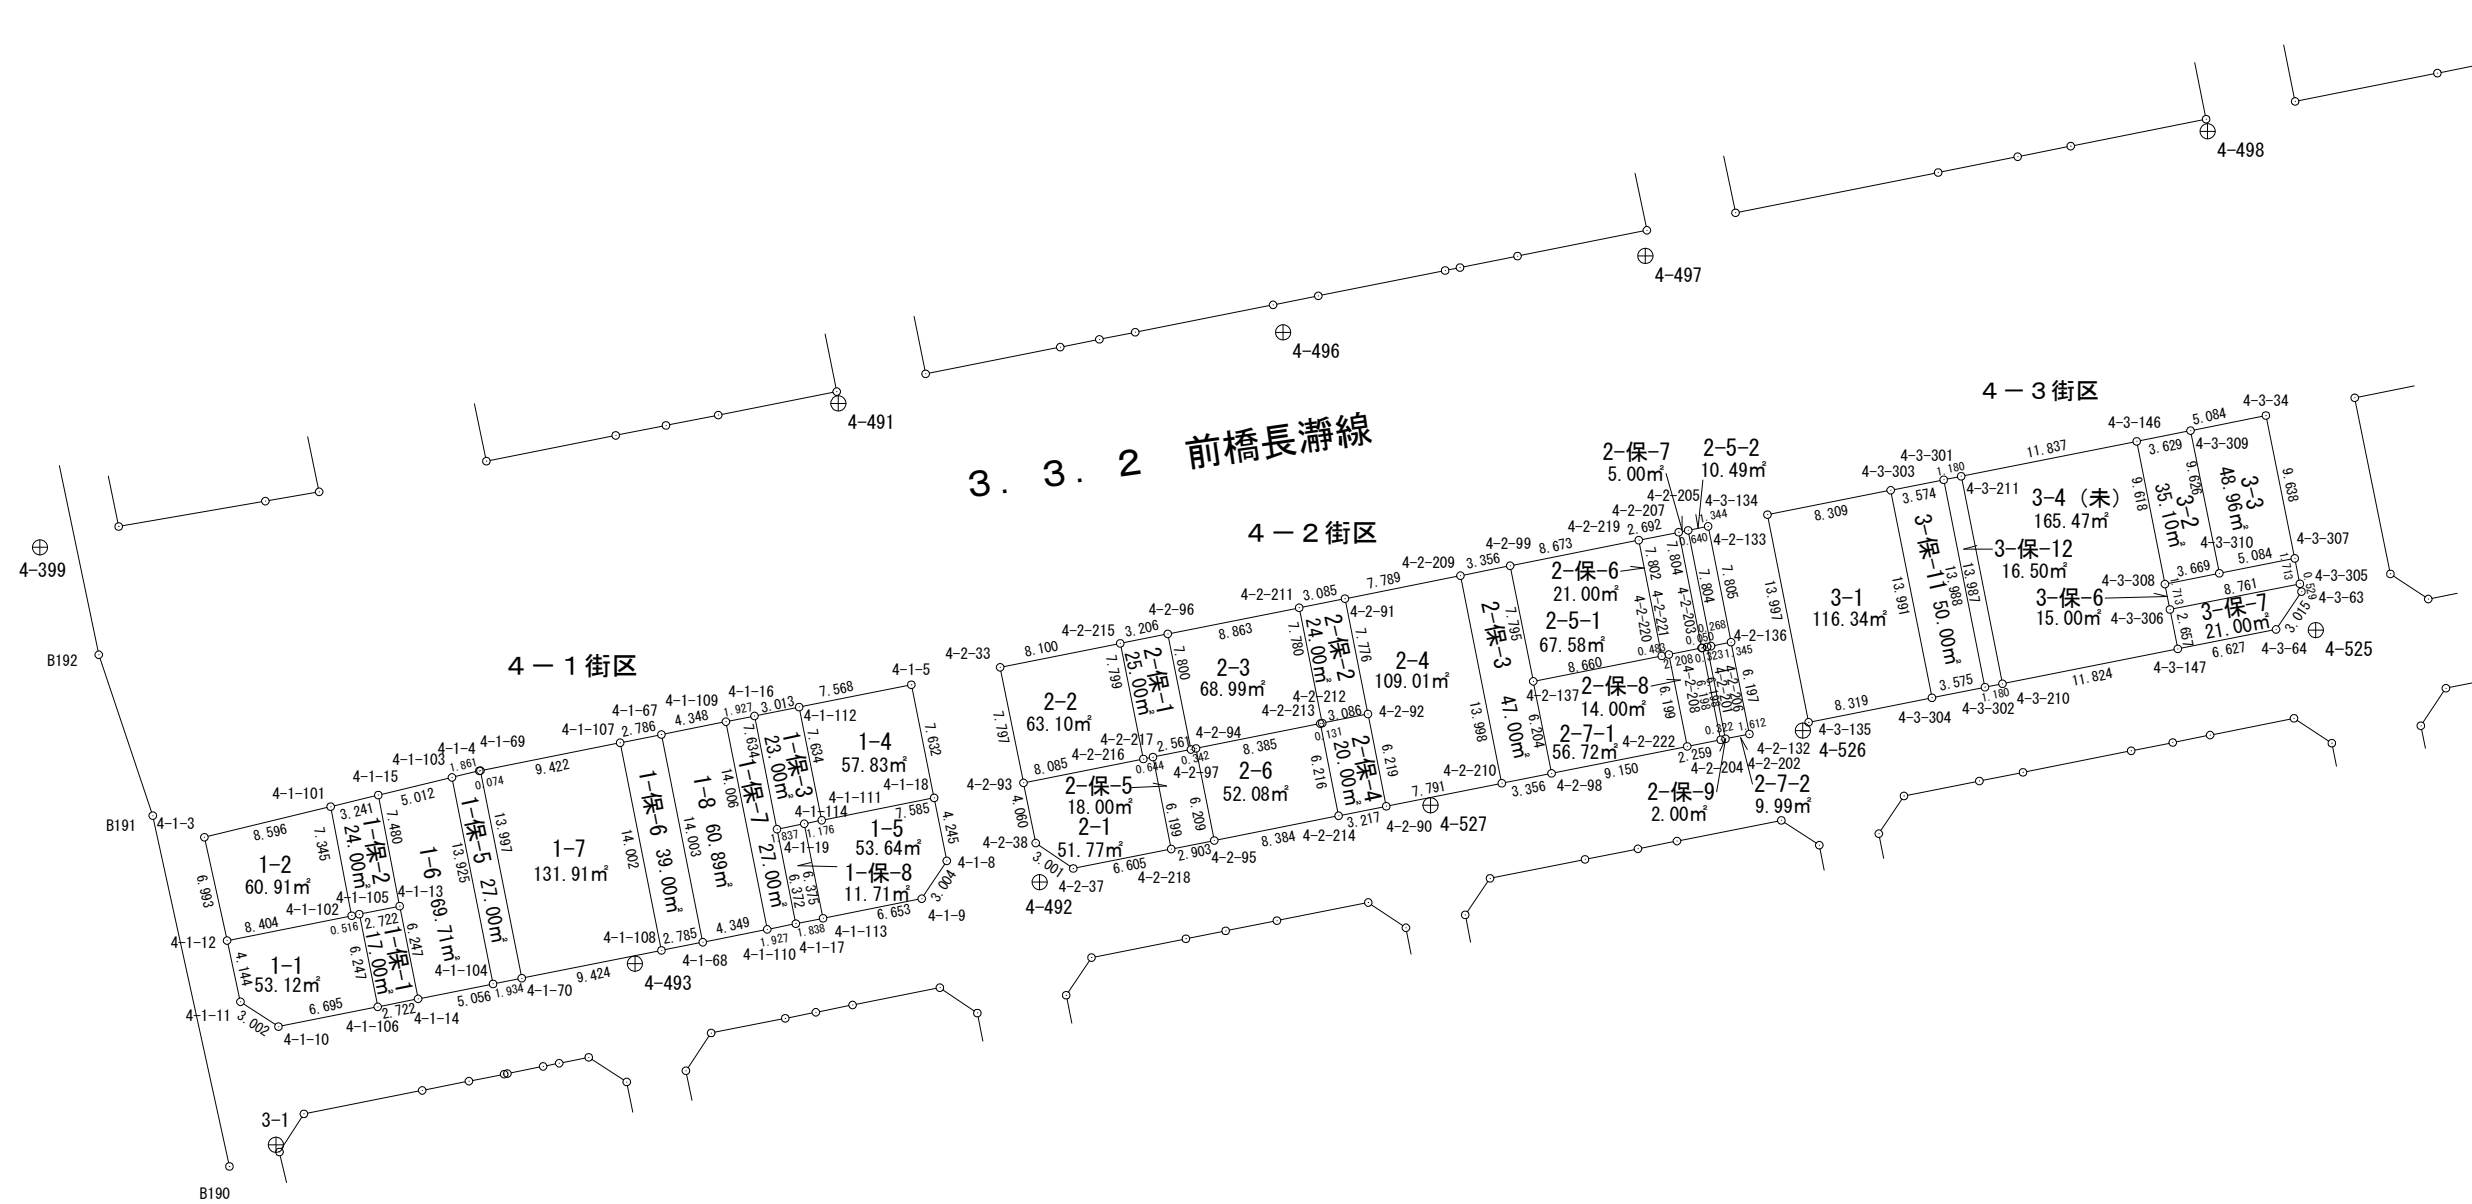


面積計算書（座標法）

世界測地系（測地成果2011）

所在	地番	公簿地目	現況地目	地積	所有者
前橋市六供町一丁目	4-1-1			53.12 m ²	

点名	X座標	Y座標	辺長	方向角	測角	DX	倍積 (Y×DX)
4-1-105	41893.837	-68476.779	0.516	348-42-43	89-57-19	1.724	-118053.966996
4-1-102	41894.343	-68476.880	8.404	348-43-58	180-01-15	8.748	-599035.746240
4-1-12	41902.585	-68478.522	4.144	257-38-26	88-54-28	7.355	-503659.529310
4-1-11	41901.698	-68482.570	3.002	213-10-36	135-32-10	-3.400	232840.738000
4-1-10	41899.185	-68484.213	6.695	168-44-32	135-33-56	-9.079	621768.169827
4-1-106	41892.619	-68482.906	6.247	78-45-24	90-00-52	-5.348	366246.581288

倍面積	106.246569
面積	53.1232845

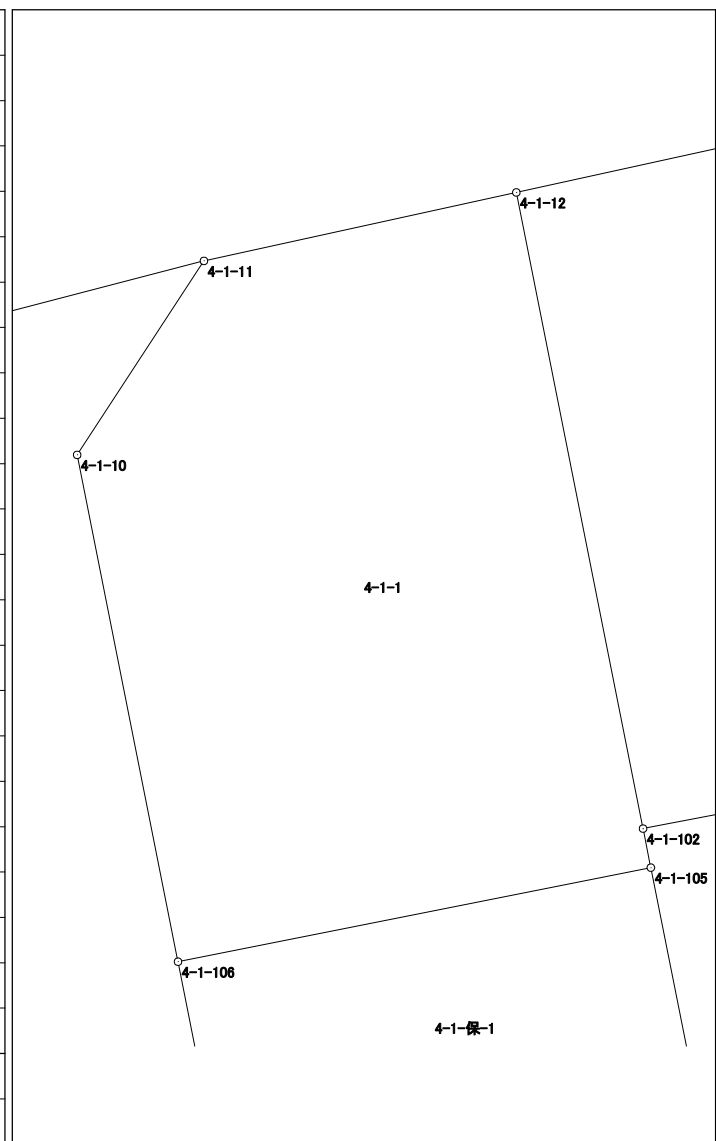


面積計算書（座標法）

世界測地系（測地成果2011）

所在	地番	公簿地目	現況地目	地積	所有者
前橋市六供町一丁目	4-1-2			60.91 m ²	

点名	X座標	Y座標	辺長	方向角	測角	DX	倍積 (Y×DX)
4-1-101	41895.731	-68469.667	8.596	346-22-28	87-16-00	9.742	-667031.495914
4-1-3	41904.085	-68471.692	6.993	257-36-48	91-14-20	6.854	-469304.976968
4-1-12	41902.585	-68478.522	8.404	168-43-58	91-07-10	-9.742	667117.761324
4-1-102	41894.343	-68476.880	7.345	79-06-28	90-22-30	-6.854	469340.535520
						倍面積	121.823962
						面積	60.9119810

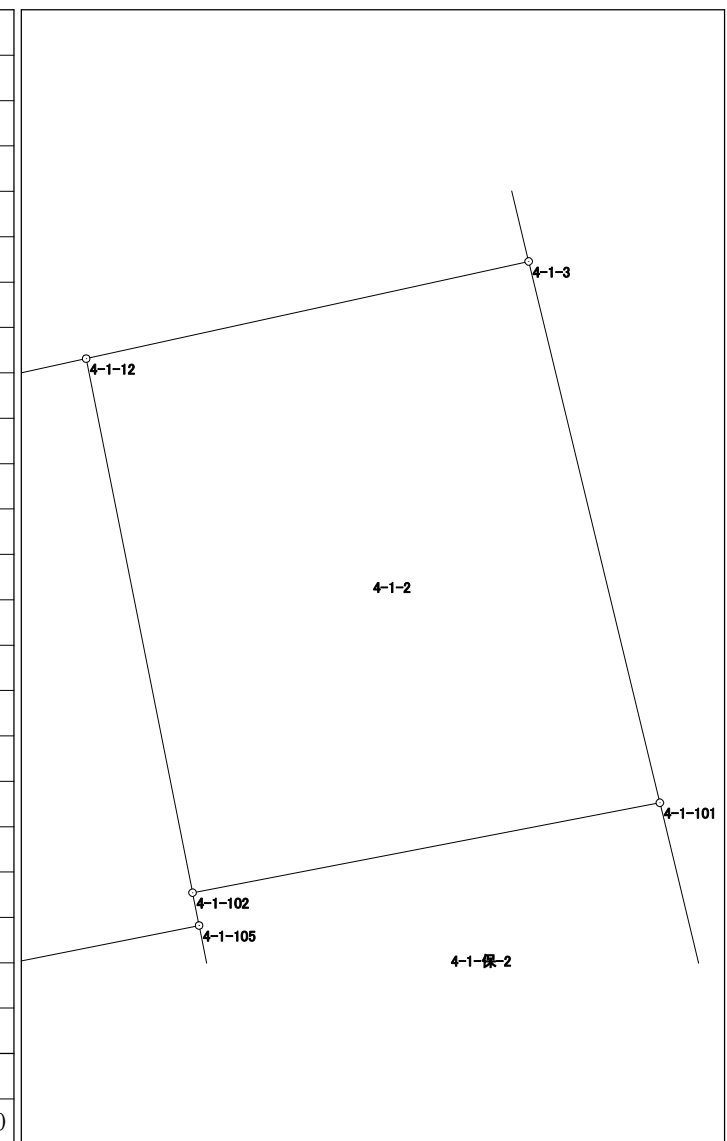


面積計算書（座標法）

世界測地系（測地成果2011）

所在	地番	公簿地目	現況地目	地積	所有者
前橋市六供町一丁目	4-1-4			57.83 m ²	

点名	X座標	Y座標	辺長	方向角	測角	DX	倍積 (Y×DX)
4-1-111	41863.251	-68470.569	7.585	168-44-26	90-00-39	-8.931	611510.651739
4-1-18	41855.812	-68469.088	7.632	78-36-17	89-51-51	-5.931	406090.160928
4-1-5	41857.320	-68461.606	7.568	348-45-14	90-08-57	8.931	-611430.603186
4-1-112	41864.743	-68463.082	7.634	258-43-47	89-58-33	5.931	-406054.539342

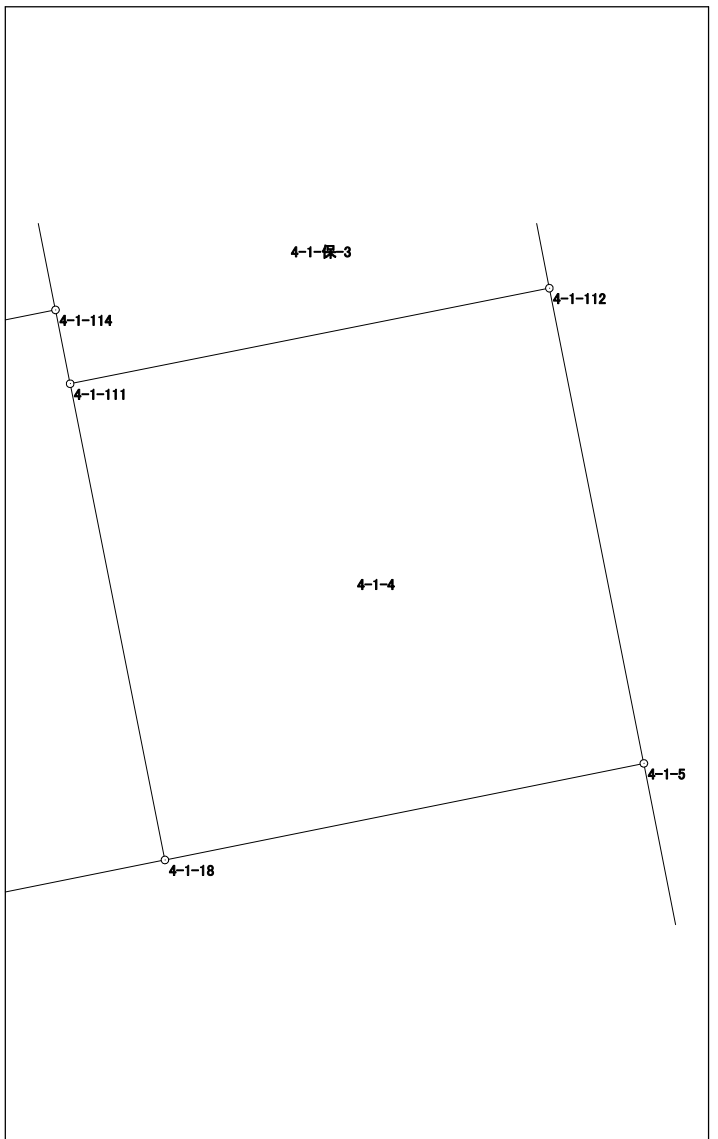


倍面積	115.670139
面積	57.8350695

面積計算書 (座標法)

世界測地系 (測地成果2011)

所在	地番	公簿地目	現況地目	地積	所有者
前橋市六供町一丁目	4-1-5			53.64 m ²	

点名	X座標	Y座標	辺長	方向角	測角	DX	倍積 (Y×DX)
4-1-113	41863.160	-68477.050	6.653	168-47-05	90-02-18	-7.770	532066.678500
4-1-9	41856.634	-68475.756	3.004	123-28-24	134-41-19	-8.183	560337.111348
4-1-8	41854.977	-68473.250	4.245	78-39-20	135-10-56	-0.822	56285.011500
4-1-18	41855.812	-68469.088	7.585	348-44-26	90-05-06	8.274	-566513.234112
4-1-111	41863.251	-68470.569	1.176	348-46-00	180-01-34	8.592	-588299.128848
4-1-114	41864.404	-68470.798	6.375	258-44-47	89-58-47	-0.091	6230.842618
						倍面積	107.281006
						面積	53.6405030

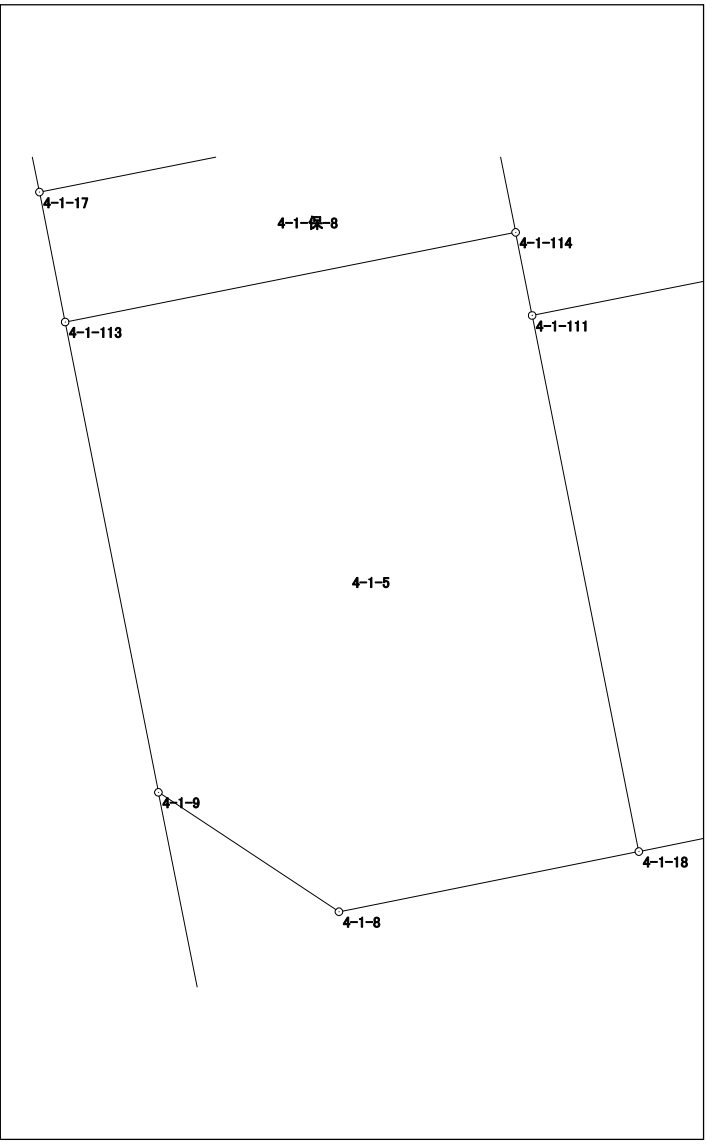


面積計算書 (座標法)

世界測地系 (測地成果2011)

所 在	地 番	公簿地目	現況地目	地 積	所 有 者
前橋市六供町一丁目	4-1-6			69.71 m ²	

点 名	X 座標	Y 座標	辺 長	方 向 角	測 角	DX	倍 積 (Y×DX)
4-1-14	41889.949	-68482.375	5.056	168-46-36	90-01-12	-6.177	423015.630375
4-1-104	41884.990	-68481.391	13.925	78-44-53	89-58-17	-2.242	153535.278622
4-1-103	41887.707	-68467.734	5.012	346-30-46	87-45-53	7.591	-519738.568794
4-1-15	41892.581	-68468.903	7.480	259-06-11	92-35-25	3.460	-236902.404380
4-1-13	41891.167	-68476.248	6.247	258-45-24	179-39-13	-2.632	180229.484736
倍面積						139.420559	
面 積						69.7102795	

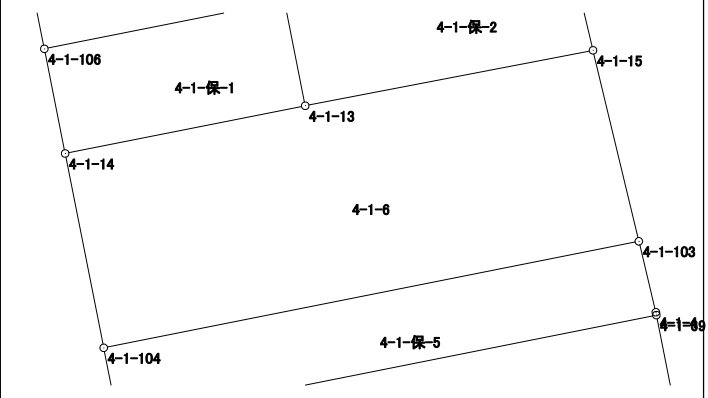


面積計算書（座標法）

世界測地系（測地成果2011）

所 在	地 番	公簿地目	現況地目	地 積	所 有 者
前橋市六供町一丁目	4-1-7			131.91 m ²	

点 名	X 座標	Y 座標	辺 長	方 向 角	測 角	DX	倍 積 (Y×DX)
4-1-107	41876.584	-68465.443	9.422	348-43-12	89-58-49	11.974	-819805.214482
4-1-69	41885.824	-68467.286	13.997	258-44-55	90-01-43	6.509	-445653.564574
4-1-70	41883.093	-68481.014	9.424	168-44-50	89-59-55	-11.974	819991.661636
4-1-108	41873.850	-68479.175	14.002	78-44-23	89-59-33	-6.509	445730.950075

倍面積	263.832655
面 積	131.9163275

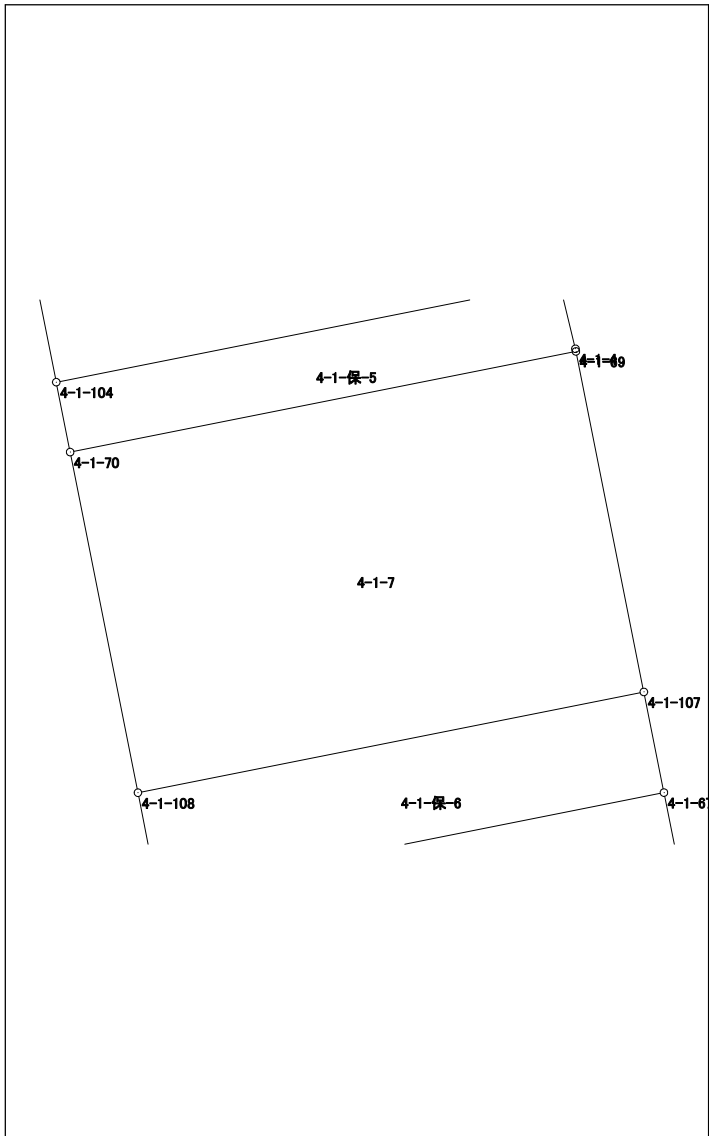


面積計算書 (座標法)

世界測地系 (測地成果2011)

所在	地番	公簿地目	現況地目	地積	所有者
前橋市六供町一丁目	4-1-8			60.89 m ²	

点名	X座標	Y座標	辺長	方向角	測角	DX	倍積 (Y×DX)
4-1-109	41869.588	-68464.047	4.348	348-42-48	89-58-28	6.999	-479179.864953
4-1-67	41873.852	-68464.898	14.003	258-44-29	90-01-41	1.530	-104751.293940
4-1-68	41871.118	-68478.632	4.349	168-44-30	90-00-01	-6.999	479281.945368
4-1-110	41866.853	-68477.783	14.006	78-44-20	89-59-50	-1.530	104771.007990
						倍面積	121.794465
						面積	60.8972325

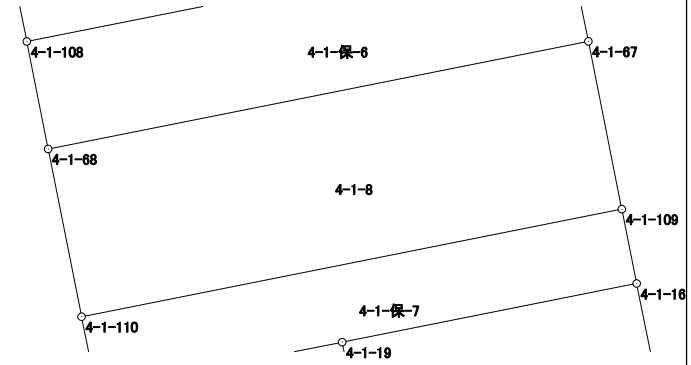

面積計算書 (座標法)

世界測地系 (測地成果2011)

所 在	地 番	公簿地目	現況地目	地 積	所 有 者
前橋市六供町一丁目	4-1-保-1			17.00 m ²	

点 名	X 座標	Y 座標	辺 長	方 向 角	測 角	DX	倍 積 (Y×DX)
4-1-14	41889.949	-68482.375	6.247	78-45-24	90-00-17	-1.452	99436.408500
4-1-13	41891.167	-68476.248	2.722	348-45-07	89-59-43	3.888	-266235.652224
4-1-105	41893.837	-68476.779	6.247	258-45-24	90-00-17	1.452	-99428.283108
4-1-106	41892.619	-68482.906	2.722	168-45-07	89-59-43	-3.888	266261.538528
						倍面積	34.011696
						面 積	17.0058480

