



# 50街区 画地出来形確認図 (11381.19m<sup>2</sup>)

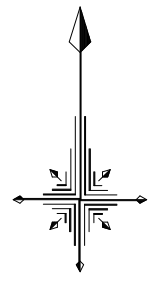

S=1/500

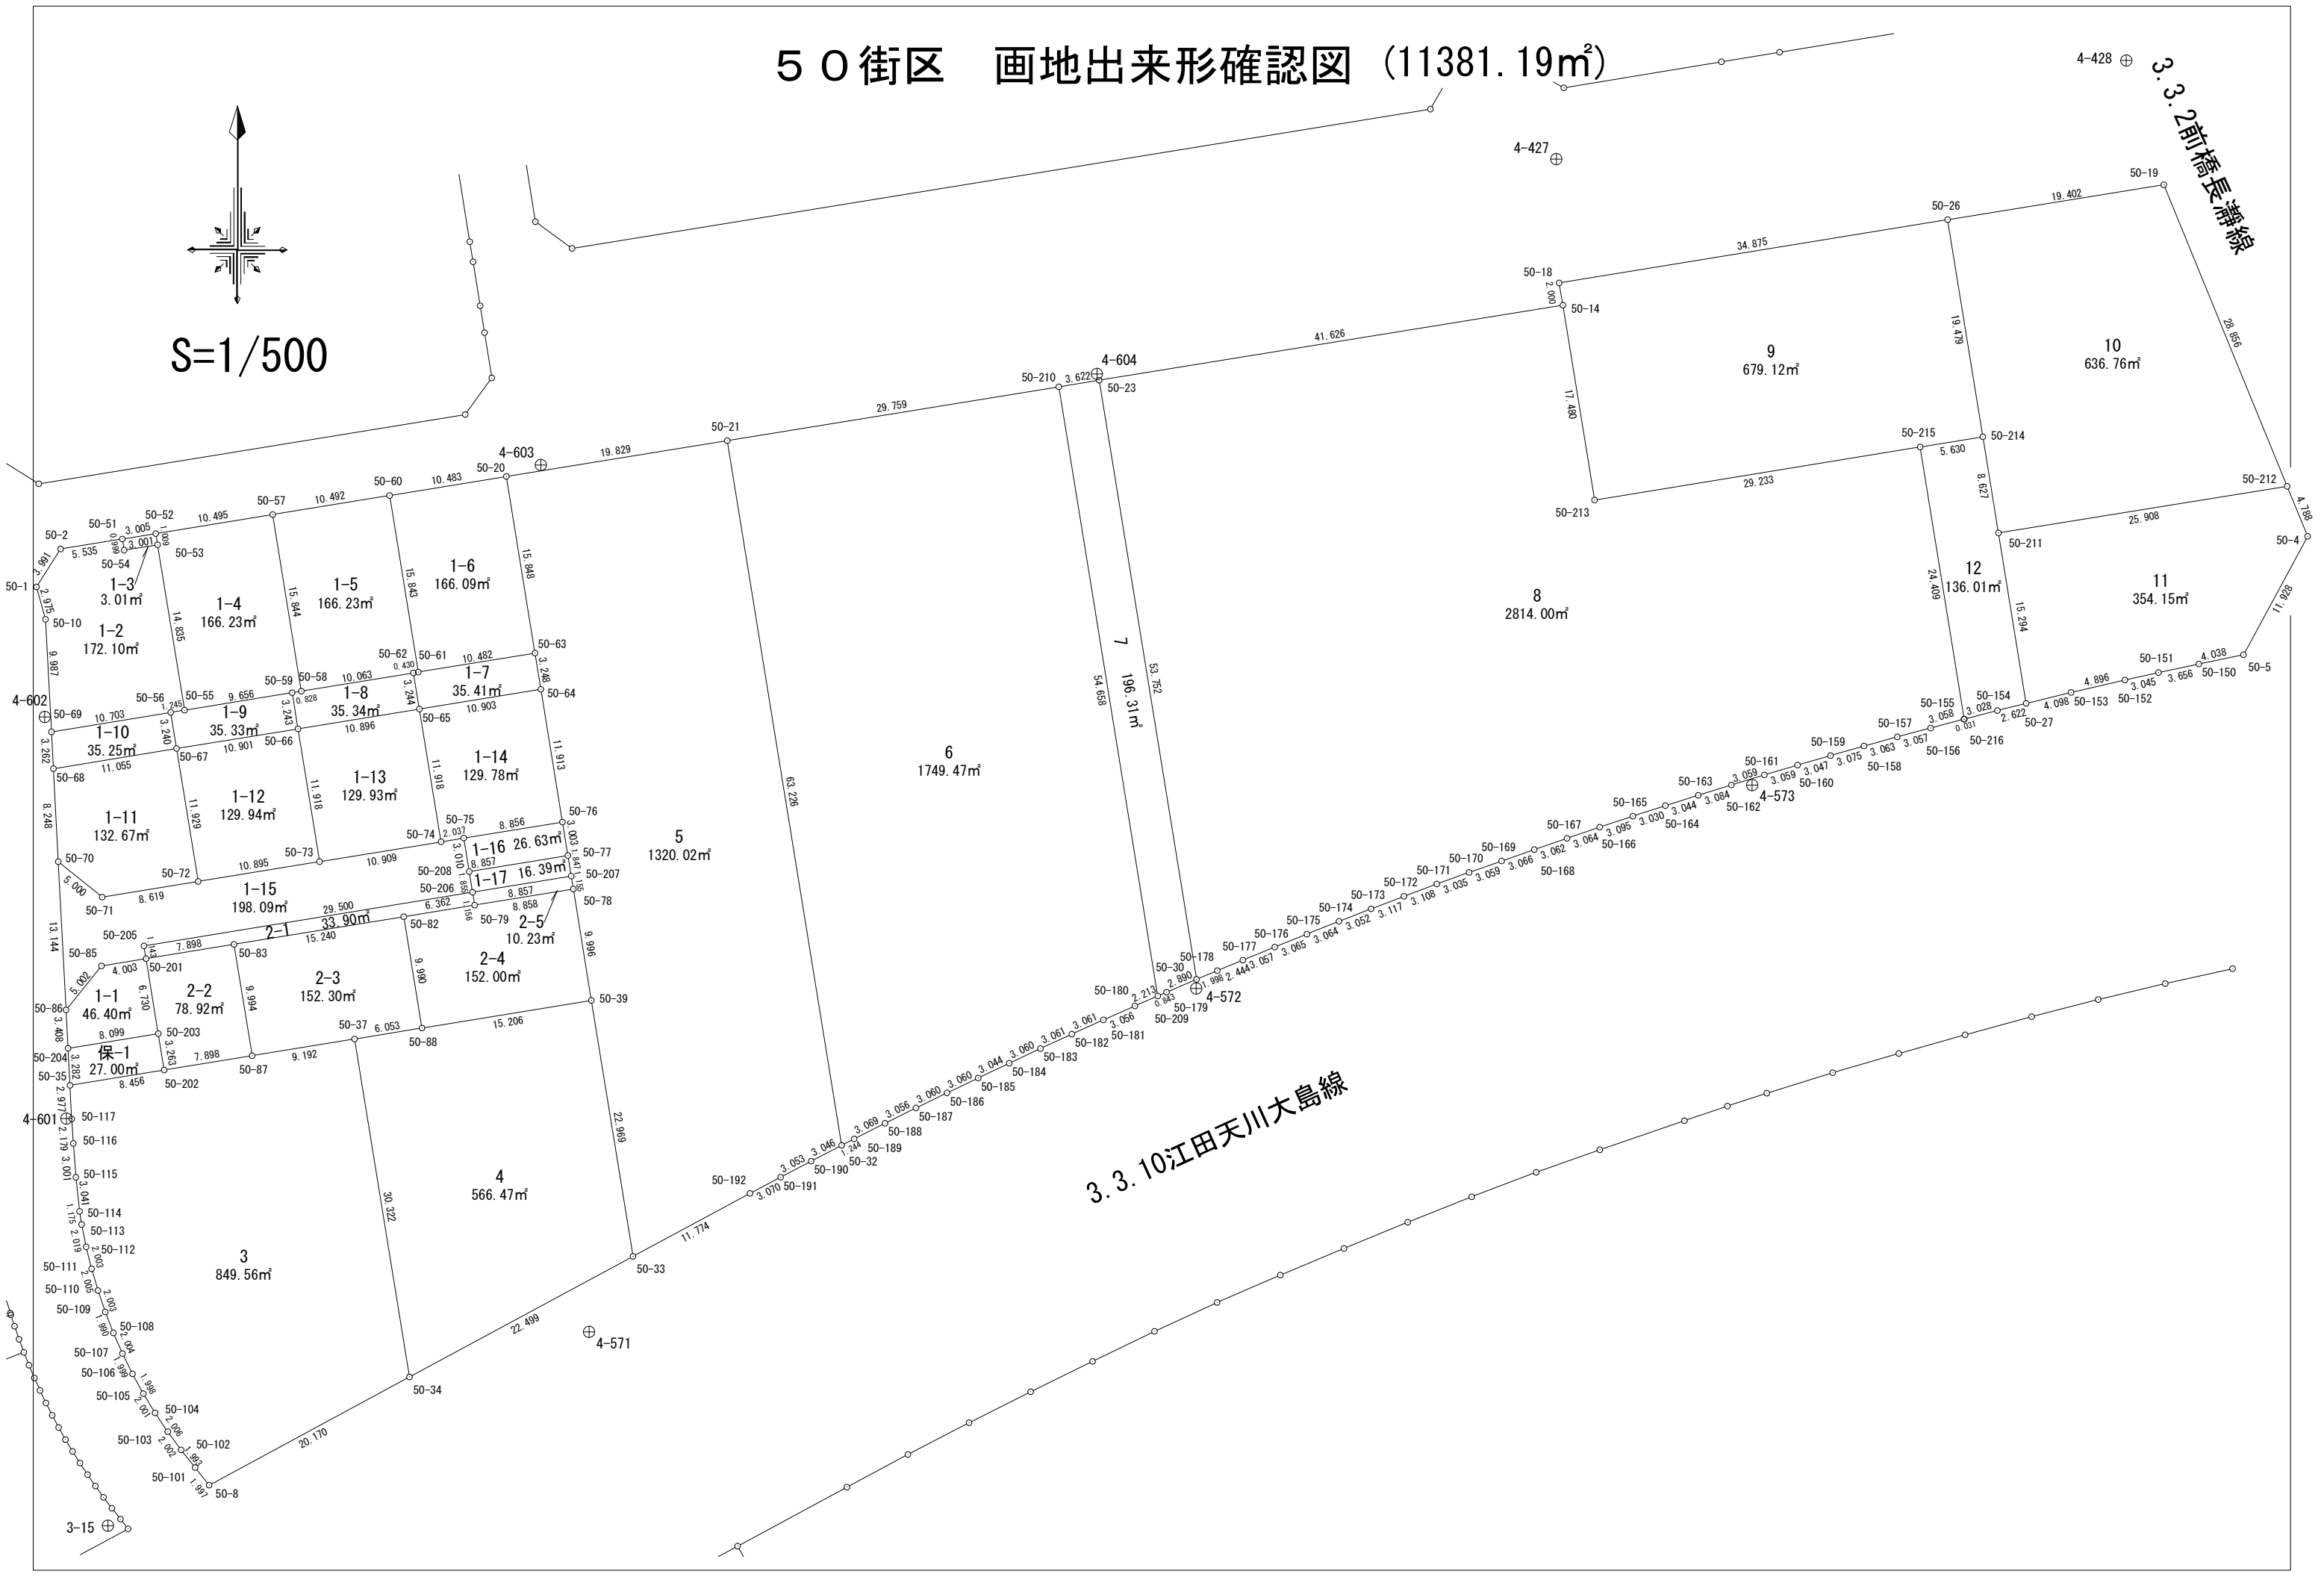

3-15 ⊕

4-571 ⊕

3.3.10 江田天川大島線

3.3.2 前橋長瀬線

4-427 ⊕

4-428 ⊕

4-572 ⊕

4-604 ⊕

4-603 ⊕

4-602 ⊕

4-601 ⊕

4-188 ⊕




# 面積計算書（座標法）

世界測地系（測地成果2011）

所 在	地 番	公簿地目	現況地目	地 積	所 有 者
前橋市六供町二丁目	50-1-2			172.10 m <sup>2</sup>	

点 名	X 座標	Y 座標	辺 長	方 向 角	測 角	DX	倍 積 (Y×DX)
50-2	41263.311	-68532.864	3.991	223-31-04	131-42-21	-2.719	186340.857216
50-1	41260.417	-68535.612	2.975	175-18-53	131-47-49	-5.859	401550.150708
50-10	41257.452	-68535.369	9.987	187-57-35	192-38-42	-12.856	881090.703864
50-69	41247.561	-68536.752	10.703	91-42-29	83-44-54	-10.210	699760.237920
50-56	41247.242	-68526.054	1.245	91-44-59	180-02-30	-0.357	24463.801278
50-55	41247.204	-68524.810	14.835	1-43-36	89-58-37	14.790	-1013481.939900
50-53	41262.032	-68524.363	3.001	272-00-19	90-16-43	14.933	-1023274.312679
50-54	41262.137	-68527.362	0.999	1-43-12	269-42-53	1.104	-75654.207648
50-51	41263.136	-68527.332	5.535	271-48-43	90-05-31	1.174	-80451.087768

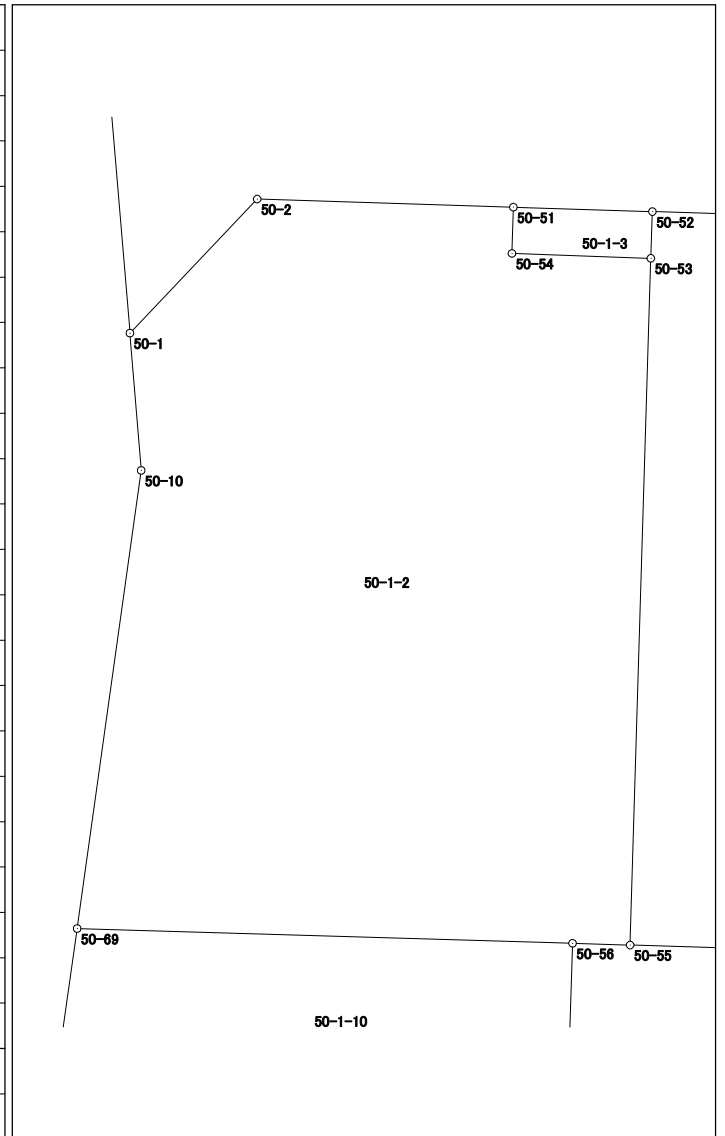


倍面積	344.202991
面 積	172.1014955

# 面積計算書 (座標法)

世界測地系 (測地成果2011)

所在	地番	公簿地目	現況地目	地積	所有者
前橋市六供町二丁目	50-1-3			3.01 m <sup>2</sup>	

点名	X座標	Y座標	辺長	方向角	測角	DX	倍積 (Y×DX)
50-51	41263.136	-68527.332	0.999	181-43-12	89-53-20	-0.903	61880.180796
50-54	41262.137	-68527.362	3.001	92-00-19	90-17-07	-1.104	75654.207648
50-53	41262.032	-68524.363	1.009	1-55-55	89-55-36	0.903	-61877.499789
50-52	41263.040	-68524.329	3.005	271-49-52	89-53-57	1.104	-75650.859216

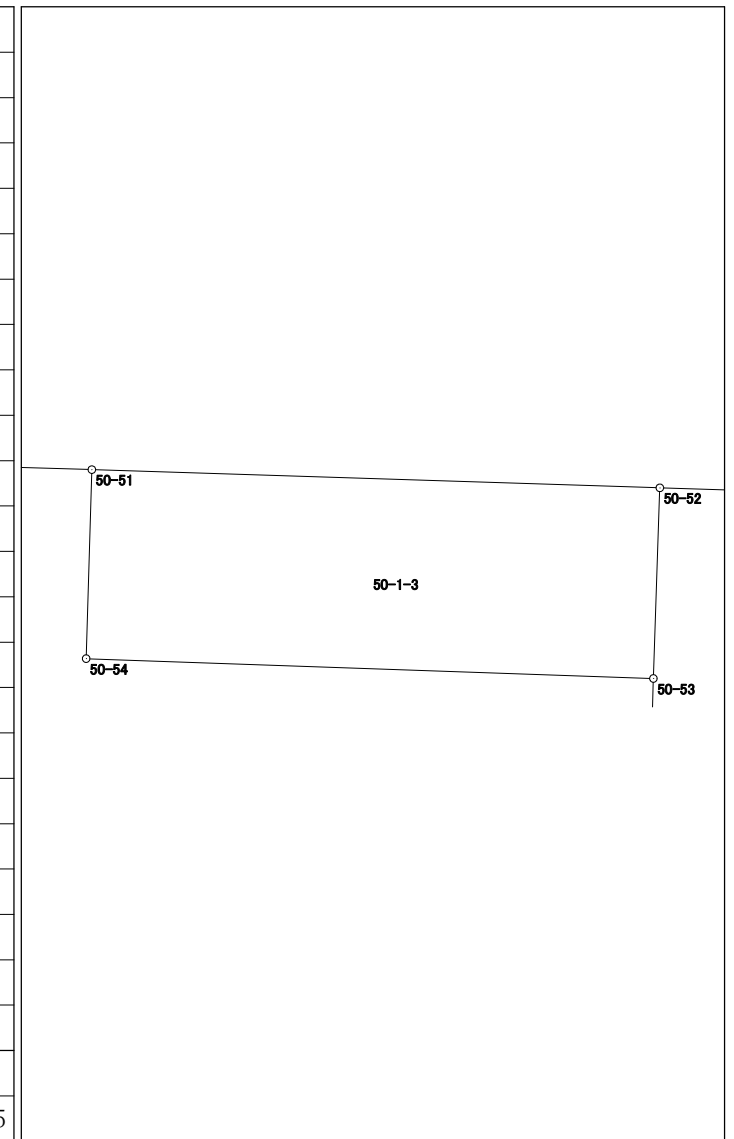


倍面積	6.029439
面積	3.0147195

# 面積計算書（座標法）

世界測地系（測地成果2011）

所在	地番	公簿地目	現況地目	地積	所有者
前橋市六供町二丁目	50-1-4			166.23 m <sup>2</sup>	

点名	X座標	Y座標	辺長	方向角	測角	DX	倍積 (Y×DX)
50-52	41263.040	-68524.329	1.009	181-55-55	90-09-07	-0.682	46733.592378
50-53	41262.032	-68524.363	14.835	181-43-36	179-47-41	-15.836	1085151.812468
50-55	41247.204	-68524.810	9.656	91-47-54	90-04-18	-15.131	1036848.900110
50-59	41246.901	-68515.159	0.828	91-35-28	179-47-34	-0.326	22335.941834
50-58	41246.878	-68514.331	15.844	1-46-46	90-11-18	15.813	-1083417.116103
50-57	41262.714	-68513.839	10.495	271-46-48	90-00-02	16.162	-1107320.665918
						倍面積	332.464769
						面積	166.2323845

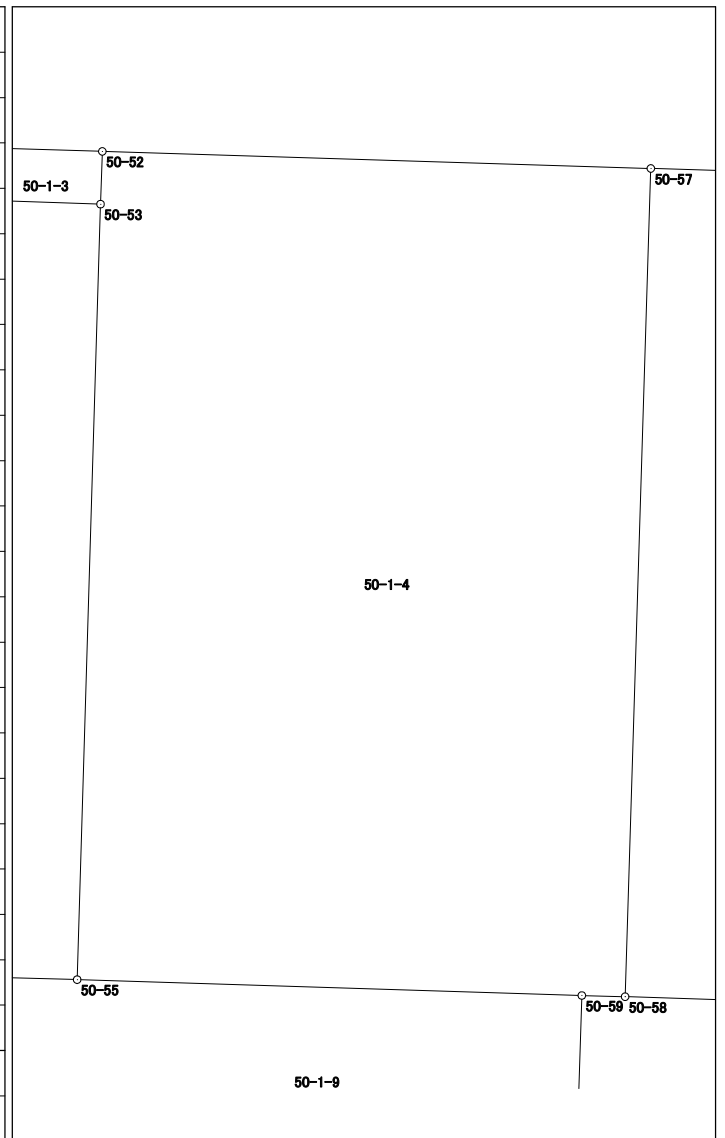


# 面積計算書（座標法）

世界測地系（測地成果2011）

所 在	地 番	公簿地目	現況地目	地 積	所 有 者
前橋市六供町二丁目	50-1-5			166.23 m <sup>2</sup>	

点 名	X 座標	Y 座標	辺 長	方 向 角	測 角	DX	倍 積 (Y×DX)
50-57	41262.714	-68513.839	15.844	181-46-46	90-02-14	-15.517	1063129.239763
50-58	41246.878	-68514.331	10.063	91-44-33	89-57-47	-16.142	1105958.331002
50-62	41246.572	-68504.273	0.430	91-35-55	179-51-22	-0.318	21784.358814
50-61	41246.560	-68503.843	15.843	1-46-34	90-10-39	15.823	-1083936.307789
50-60	41262.395	-68503.352	10.492	271-44-32	89-57-58	16.154	-1106603.148208

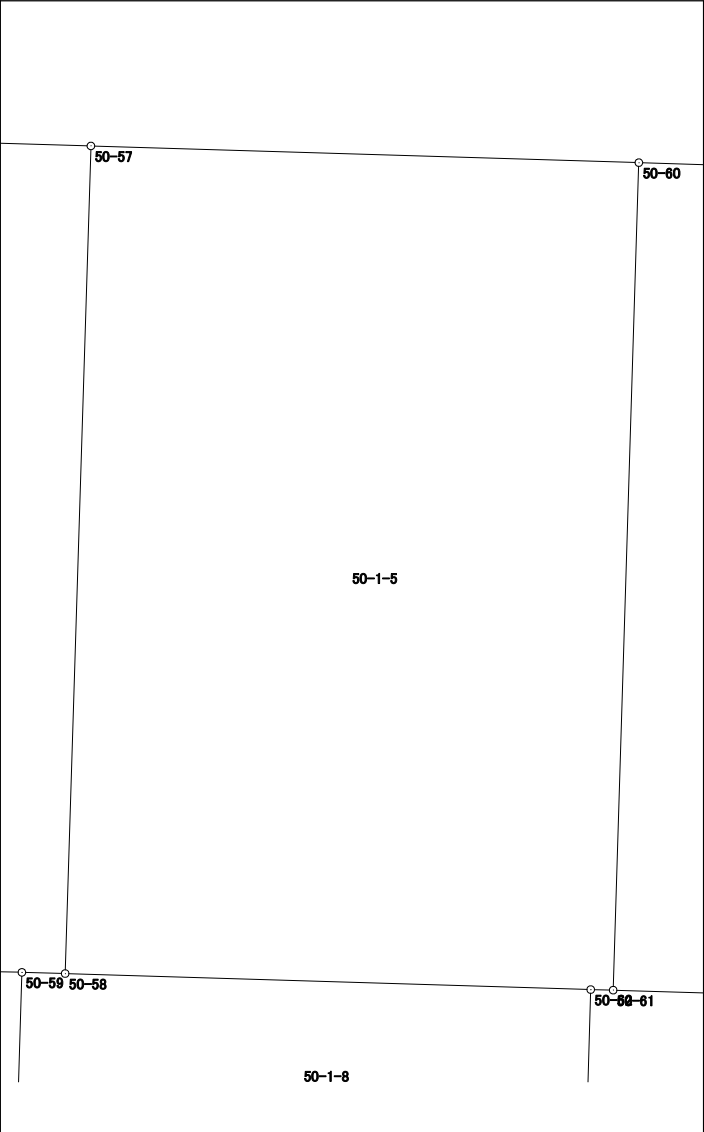

倍面積	332.473582
面 積	166.2367910



# 面積計算書 (座標法)

世界測地系 (測地成果2011)

所 在	地 番	公簿地目	現況地目	地 積	所 有 者
前橋市六供町二丁目	50-1-7			35.41 m <sup>2</sup>	

点 名	X 座標	Y 座標	辺 長	方 向 角	測 角	DX	倍 積 (Y×DX)	
50-62	41246.572	-68504.273	3.244	181-40-41	90-04-46	-3.231	221337.306063	
50-65	41243.329	-68504.368	10.903	91-45-38	90-04-57	-3.578	245108.628704	
50-64	41242.994	-68493.470	3.248	1-50-06	90-04-28	2.911	-199384.491170	
50-63	41246.240	-68493.366	10.482	271-44-58	89-54-52	3.566	-244247.343156	
50-61	41246.560	-68503.843	0.430	271-35-55	179-50-57	0.332	-22743.275876	
							倍面積	
							面 積	35.4122825



# 面積計算書（座標法）

世界測地系（測地成果2011）

所 在	地 番	公簿地目	現況地目	地 積	所 有 者
前橋市六供町二丁目	50-1-8			35.34 m <sup>2</sup>	


点 名	X 座標	Y 座標	辺 長	方 向 角	測 角	DX	倍 積 (Y×DX)	
50-59	41246.901	-68515.159	3.243	181-46-02	90-10-34	-3.218	220481.781662	
50-66	41243.660	-68515.259	10.896	91-44-27	89-58-25	-3.572	244736.505148	
50-65	41243.329	-68504.368	3.244	1-40-41	89-56-14	2.912	-199484.719616	
50-62	41246.572	-68504.273	10.063	271-44-33	90-03-52	3.549	-243121.664877	
50-58	41246.878	-68514.331	0.828	271-35-28	179-50-55	0.329	-22541.214899	
						倍面積	70.687418	
						面 積	35.3437090	

# 面積計算書 (座標法)

世界測地系 (測地成果2011)

所在	地番	公簿地目	現況地目	地積	所有者
前橋市六供町二丁目	50-1-9			35.33 m <sup>2</sup>	


点名	X座標	Y座標	辺長	方向角	測角	Dx	倍積 (Y×Dx)	
50-56	41247.242	-68526.054	3.240	181-47-12	90-02-13	-3.200	219283.372800	
50-67	41244.004	-68526.155	10.901	91-48-30	90-01-18	-3.582	245460.687210	
50-66	41243.660	-68515.259	3.243	1-46-02	89-57-32	2.897	-198488.705323	
50-59	41246.901	-68515.159	9.656	271-47-54	90-01-52	3.544	-242817.723496	
50-55	41247.204	-68524.810	1.245	271-44-59	179-57-05	0.341	-23366.960210	
							倍面積	70.670981
							面積	35.3354905

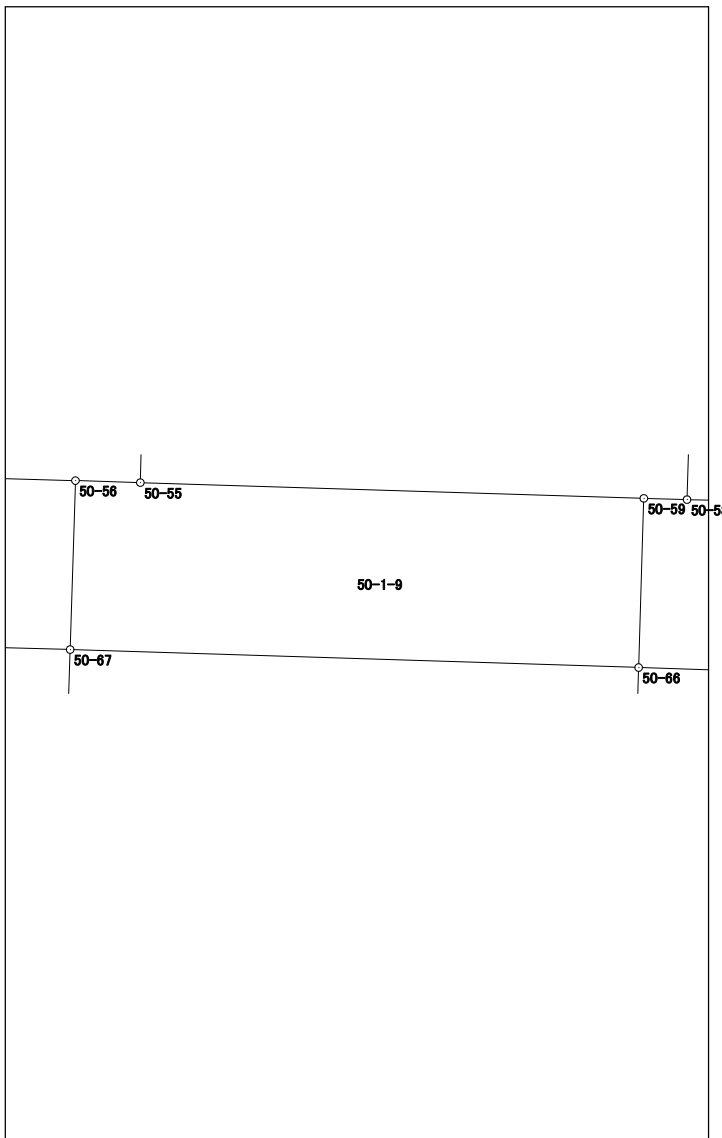

# 面積計算書 (座標法)

所 在	地 番	公簿地目	現況地目	地 積	所 有 者
前橋市六供町二丁目	50-1-10			35.25 m <sup>2</sup>	

点 名	X 座標	Y 座標	辺 長	方 向 角	測 角	DX	倍 積 (Y×DX)
50-69	41247.561	-68536.752	3.262	187-59-01	96-16-32	-2.911	199510.485072
50-68	41244.331	-68537.205	11.055	91-41-42	83-42-41	-3.557	243786.838185
50-67	41244.004	-68526.155	3.240	1-47-12	90-05-30	2.911	-199479.637205
50-56	41247.242	-68526.054	10.703	271-42-29	89-55-17	3.557	-243747.174078
						倍面積	70.511974
						面 積	35.2559870

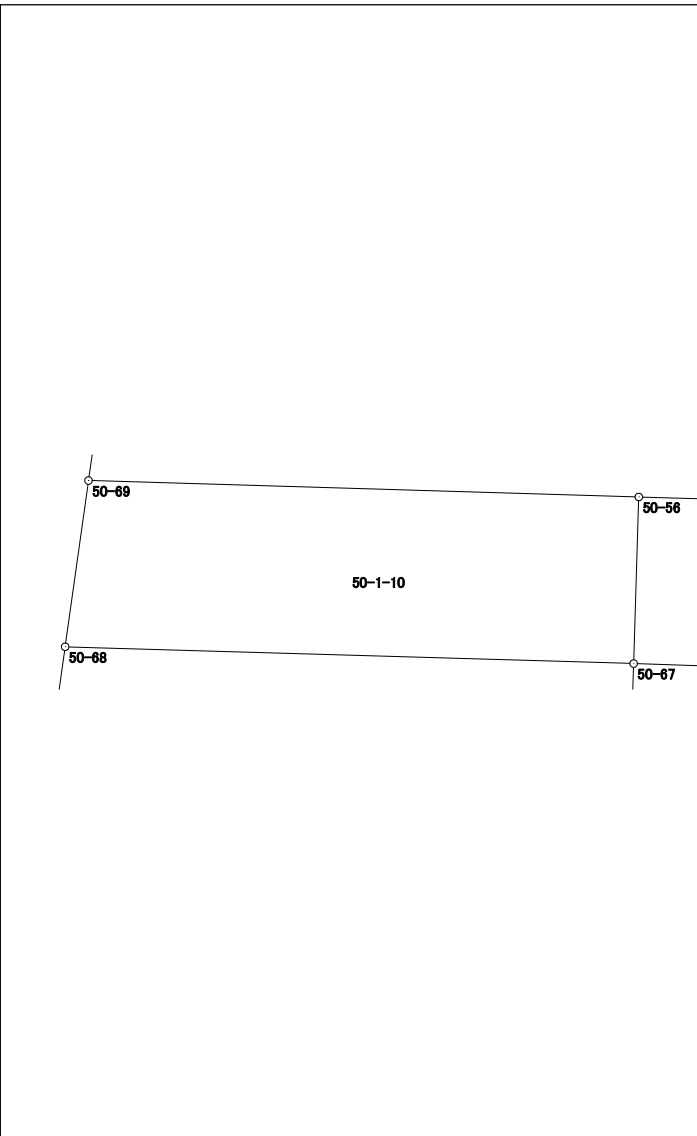



# 面積計算書 (座標法)

世界測地系 (測地成果2011)

所在	地番	公簿地目	現況地目	地積	所有者
前橋市六供町二丁目	50-1-12			129.94 m <sup>2</sup>	

点名	X座標	Y座標	辺長	方向角	測角	DX	倍積 (Y×DX)
50-67	41244.004	-68526.155	11.929	181-44-38	89-56-08	-11.579	793464.348745
50-72	41232.081	-68526.518	10.895	91-45-05	90-00-27	-12.256	839861.004608
50-73	41231.748	-68515.628	11.918	1-46-27	90-01-22	11.579	-793342.456612
50-66	41243.660	-68515.259	10.901	271-48-30	90-02-03	12.256	-839723.014304
倍面積							259.882437
面積							129.9412185

# 面積計算書 (座標法)

世界測地系 (測地成果2011)

所在	地番	公簿地目	現況地目	地積	所有者
前橋市六供町二丁目	50-1-13			129.93 m <sup>2</sup>	


点名	X座標	Y座標	辺長	方向角	測角	Dx	倍積 (Y×Dx)		
50-66	41243.660	-68515.259	11.918	181-46-27	90-02-00	-11.581	793475.214479		
50-73	41231.748	-68515.628	10.909	91-44-38	89-58-11	-12.244	838905.349232		
50-74	41231.416	-68504.724	11.918	1-42-42	89-58-04	11.581	-793353.208644		
50-65	41243.329	-68504.368	10.896	271-44-27	90-01-45	12.244	-838767.481792		
							倍面積		259.873275
							面積		129.9366375

# 面積計算書（座標法）

世界測地系（測地成果2011）

所 在	地 番	公簿地目	現況地目	地 積	所 有 者
前橋市六供町二丁目	50-1-14			129.78 m <sup>2</sup>	

点 名	X 座標	Y 座標	辺 長	方 向 角	測 角	DX	倍 積 (Y×DX)
50-65	41243.329	-68504.368	11.918	181-42-42	89-57-04	-11.578	793143.572704
50-74	41231.416	-68504.724	2.037	91-22-43	89-40-01	-11.962	819453.508488
50-75	41231.367	-68502.688	8.856	91-48-42	180-25-59	-0.329	22537.384352
50-76	41231.087	-68493.836	11.913	1-45-38	89-56-56	11.627	-796377.831172
50-64	41242.994	-68493.470	10.903	271-45-38	90-00-00	12.242	-838497.059740
						倍面積	259.574632
						面 積	129.7873160

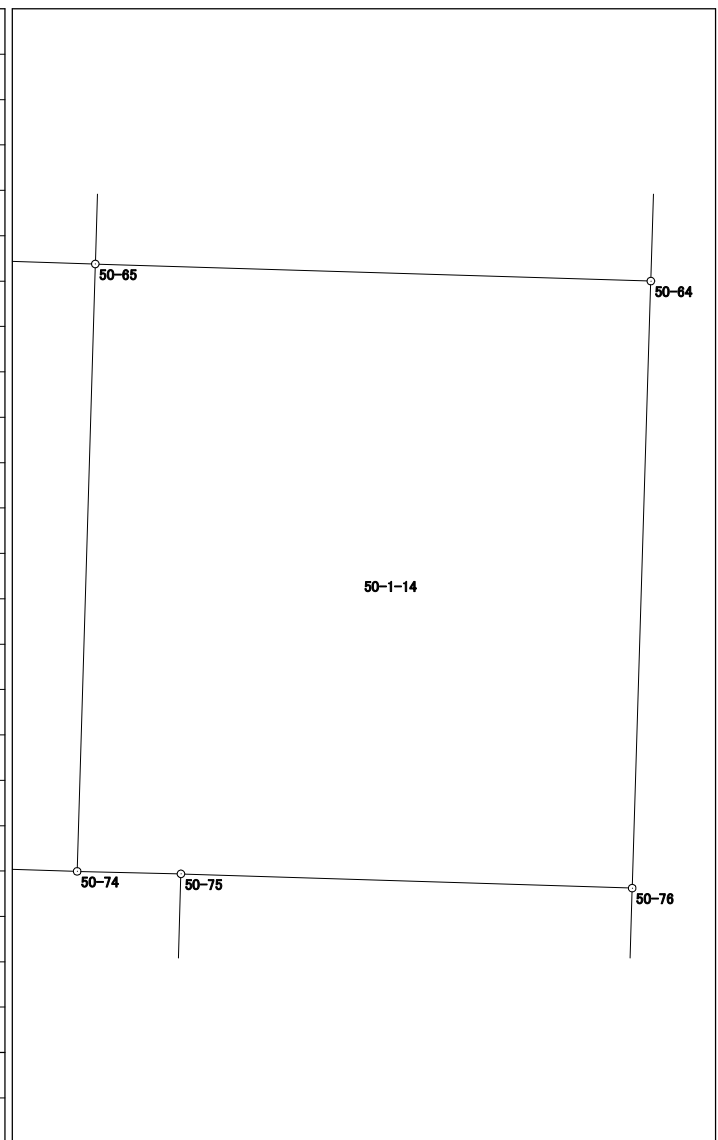


# 面積計算書 (座標法)

世界測地系 (測地成果2011)

所在	地番	公簿地目	現況地目	地積	所有者
前橋市六供町二丁目	50-1-15			198.09 m <sup>2</sup>	

点名	X座標	Y座標	辺長	方向角	測角	DX	倍積 (Y×DX)
50-70	41236.164	-68538.356	13.144	187-59-56	48-07-54	-9.193	630073.106708
50-86	41223.148	-68540.185	5.002	49-51-26	41-51-30	-9.791	671076.951335
50-85	41226.373	-68536.361	4.003	91-44-48	221-53-22	3.103	-212668.328183
50-201	41226.251	-68532.360	1.143	1-45-20	90-00-32	1.020	-69903.007200
50-205	41227.393	-68532.325	29.500	91-43-37	269-58-17	0.253	-17338.678225
50-206	41226.504	-68502.838	1.855	1-45-39	90-02-02	0.965	-66105.238670
50-208	41228.358	-68502.781	3.010	1-46-13	180-00-34	4.863	-333129.024003
50-75	41231.367	-68502.688	2.037	271-22-43	89-36-30	3.058	-209481.219904
50-74	41231.416	-68504.724	10.909	271-44-38	180-21-55	0.381	-26100.299844
50-73	41231.748	-68515.628	10.895	271-45-05	180-00-27	0.665	-45562.892620
50-72	41232.081	-68526.518	8.619	271-43-43	179-58-38	0.593	-40636.225174
50-71	41232.341	-68535.133	5.000	319-52-02	228-08-19	4.083	-279828.948039

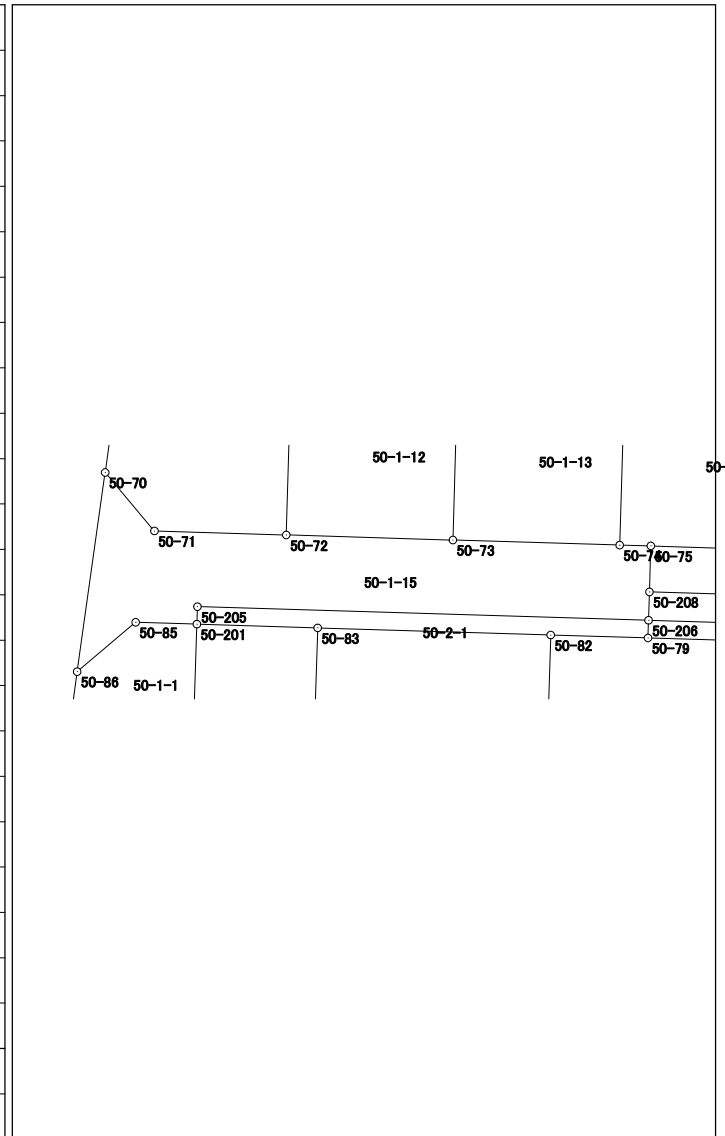

倍面積	396.196181
面積	198.0980905




# 面積計算書 (座標法)

世界測地系 (測地成果2011)

所在	地番	公簿地目	現況地目	地積	所有者
前橋市六供町二丁目	50-1-16			26.63 m <sup>2</sup>	

点名	X座標	Y座標	辺長	方向角	測角	DX	倍積 (Y×DX)
50-75	41231.367	-68502.688	3.010	181-46-13	89-57-31	-2.729	186943.835552
50-208	41228.358	-68502.781	8.857	91-45-59	89-59-46	-3.282	224826.127242
50-77	41228.085	-68493.928	3.003	1-45-19	89-59-20	2.729	-186919.929512
50-76	41231.087	-68493.836	8.856	271-48-42	90-03-23	3.282	-224796.769752

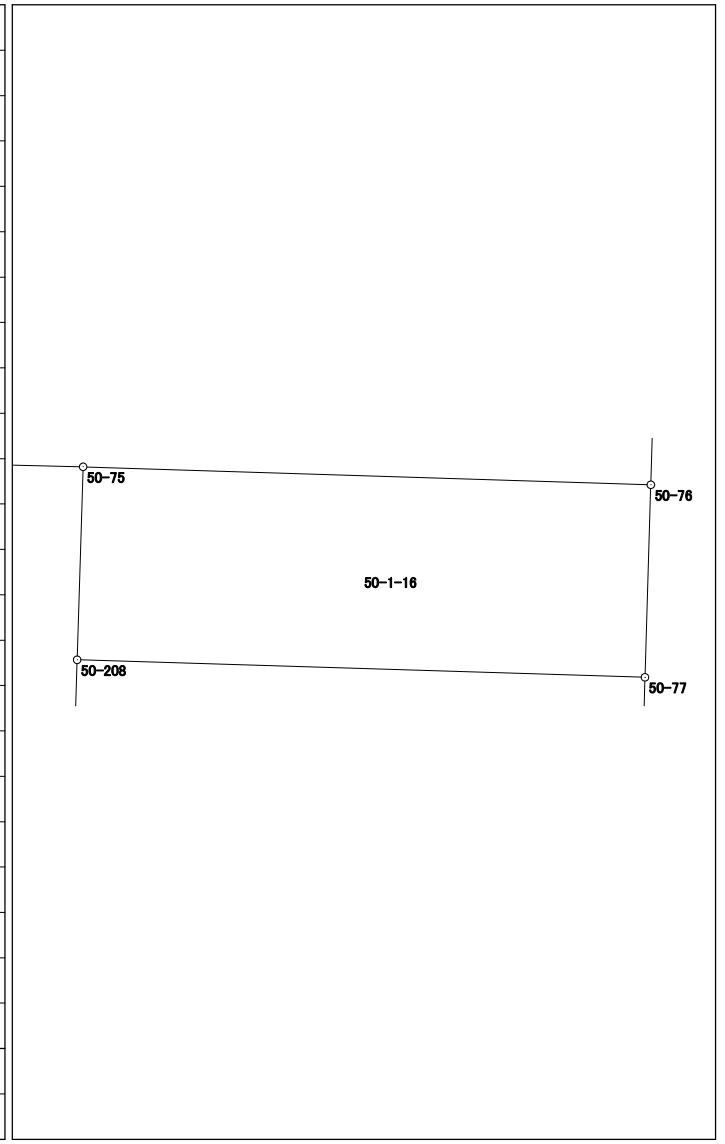

倍面積	53.263530
面積	26.6317650




# 面積計算書 (座標法)

世界測地系 (測地成果2011)

所在	地番	公簿地目	現況地目	地積	所有者
前橋市六供町二丁目	50-2-1			33.90 m <sup>2</sup>	

点名	X座標	Y座標	辺長	方向角	測角	DX	倍積 (Y×DX)
50-206	41226.504	-68502.838	29.500	271-43-37	89-56-30	2.044	-140019.800872
50-205	41227.393	-68532.325	1.143	181-45-20	90-01-43	-0.253	17338.678225
50-201	41226.251	-68532.360	7.898	91-45-21	90-00-01	-1.384	94848.786240
50-83	41226.009	-68524.466	15.240	91-45-08	179-59-47	-0.708	48515.321928
50-82	41225.543	-68509.233	6.362	91-44-51	179-59-43	-0.660	45216.093780
50-79	41225.349	-68502.874	1.156	1-47-07	90-02-16	0.961	-65831.261914

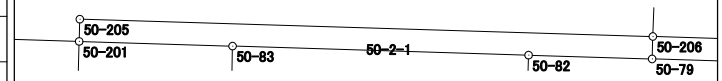


倍面積	67.817387
面積	33.9086935

# 面積計算書（座標法）

世界測地系（測地成果2011）

所在	地番	公簿地目	現況地目	地積	所有者
前橋市六供町二丁目	50-2-2			78.92 m <sup>2</sup>	

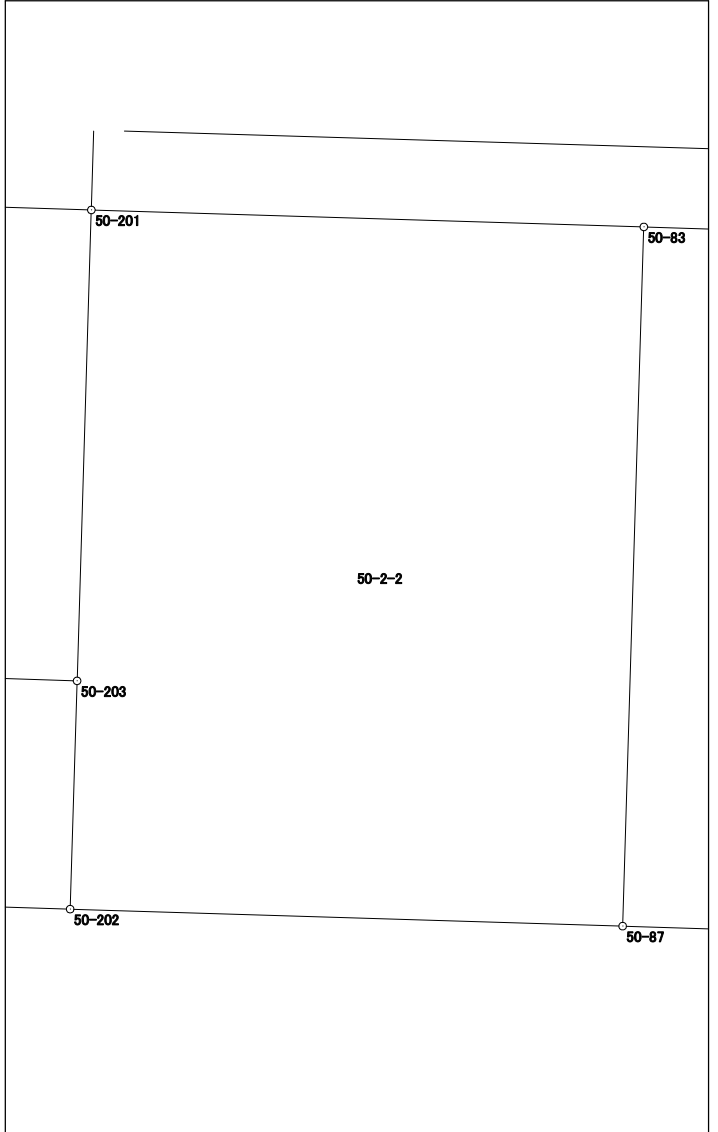点名	X座標	Y座標	辺長	方向角	測角	DX	倍積 (Y×DX)		
50-87	41216.020	-68524.769	9.994	1-44-15	89-58-28	9.746	-667842.398674		
50-83	41226.009	-68524.466	7.898	271-45-21	90-01-06	10.231	-701073.811646		
50-201	41226.251	-68532.360	6.730	181-44-13	89-58-52	-6.485	444432.354600		
50-203	41219.524	-68532.564	3.263	181-44-20	180-00-07	-9.988	684503.249232		
50-202	41216.263	-68532.663	7.898	91-45-47	90-01-27	-3.504	240138.451152		
倍面積							157.844664		
面積							78.9223320		


## 面積計算書 (座標法)

世界測地系 (測地成果2011)

所在	地番	公簿地目	現況地目	地積	所有者
前橋市六供町二丁目	50-2-3			152.30 m <sup>2</sup>	

点名	X座標	Y座標	辺長	方向角	測角	DX	倍積 (Y×DX)
50-83	41226.009	-68524.466	9.994	181-44-15	89-59-07	-9.523	652558.489718
50-87	41216.020	-68524.769	9.192	91-44-21	90-00-06	-10.268	703612.328092
50-37	41215.741	-68515.581	6.053	91-44-31	180-00-10	-0.463	31722.714003
50-88	41215.557	-68509.531	9.990	1-42-33	89-58-02	9.802	-671530.422862
50-82	41225.543	-68509.233	15.240	271-45-08	90-02-35	10.452	-716058.503316

倍面積	304.605635
面積	152.3028175

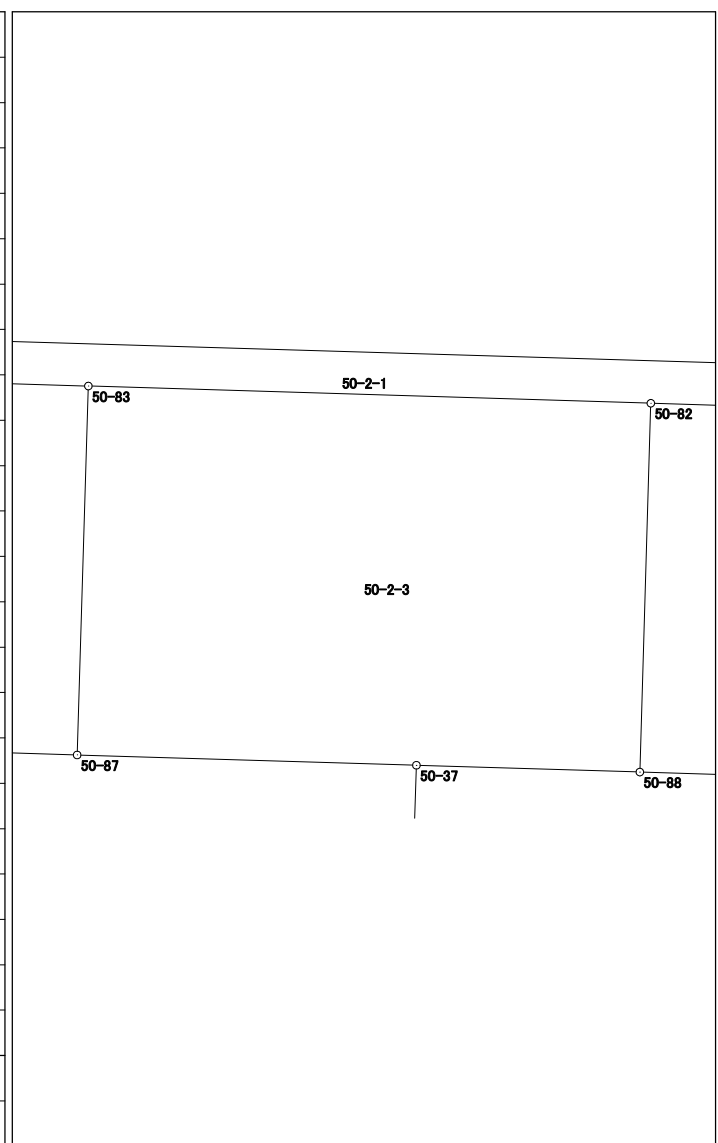


## 面積計算書（座標法）

世界測地系（測地成果2011）

所 在	地 番	公簿地目	現況地目	地 積	所 有 者
前橋市六供町二丁目	50-2-4			152.00 m <sup>2</sup>	

点 名	X 座標	Y 座標	辺 長	方 向 角	測 角	DX	倍 積 (Y×DX)
50-82	41225.543	-68509.233	9.990	181-42-33	89-57-42	-9.792	670842.409536
50-88	41215.557	-68509.531	15.206	91-44-41	90-02-08	-10.449	715856.089419
50-39	41215.094	-68494.332	9.996	1-47-19	90-02-38	9.528	-652613.995296
50-78	41225.085	-68494.020	8.858	271-42-28	89-55-09	10.255	-702406.175100
50-79	41225.349	-68502.874	6.362	271-44-51	180-02-23	0.458	-31374.316292
						倍面積	304.012267
						面 積	152.0061335

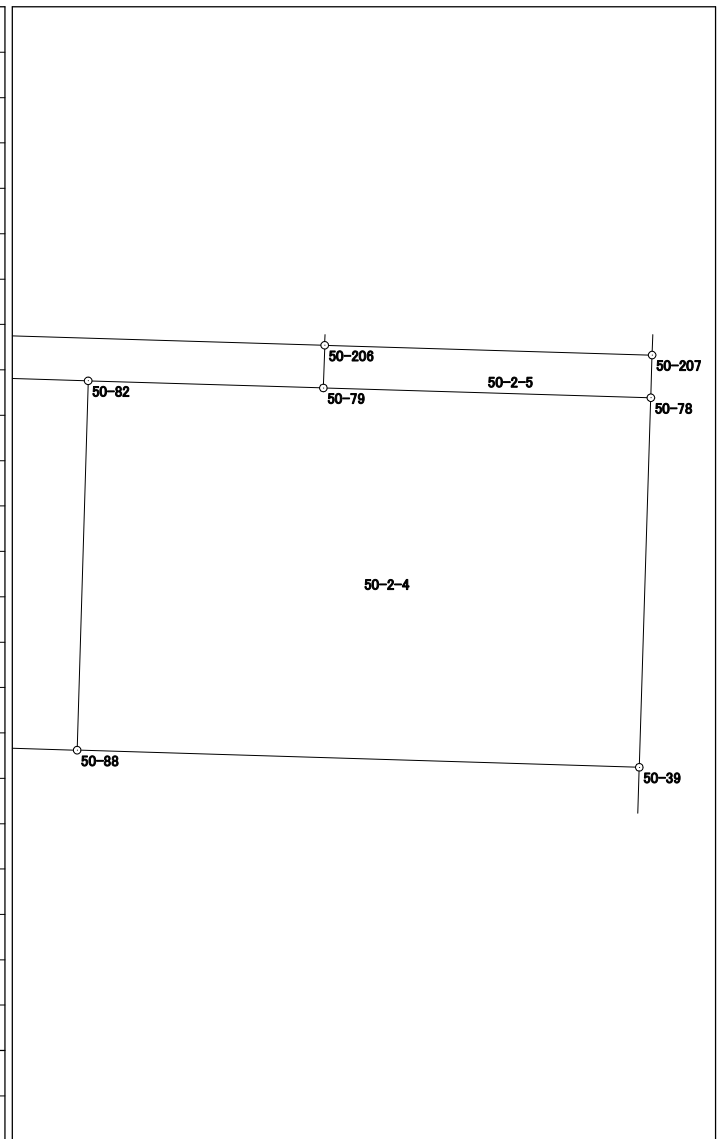

# 面積計算書（座標法）

世界測地系（測地成果2011）

所 在	地 番	公簿地目	現況地目	地 積	所 有 者
前橋市六供町二丁目	50-2-5			10.23 m <sup>2</sup>	

点 名	X 座標	Y 座標	辺 長	方 向 角	測 角	DX	倍 積 (Y×DX)		
50-206	41226.504	-68502.838	1.156	181-47-07	90-04-15	-0.890	60967.525820		
50-79	41225.349	-68502.874	8.858	91-42-28	89-55-21	-1.419	97205.578206		
50-78	41225.085	-68494.020	1.155	1-44-14	90-01-46	0.890	-60959.677800		
50-207	41226.239	-68493.985	8.857	271-42-52	89-58-38	1.419	-97192.964715		
							倍面積		20.461511
							面 積		10.2307555


# 面積計算書（座標法）

世界測地系（測地成果2011）

所 在	地 番	公簿地目	現況地目	地 積	所 有 者
前橋市六供町二丁目	50-3			849.56 m <sup>2</sup>	

点 名	X 座標	Y 座標	辺 長	方 向 角	測 角	D X	倍 積 (Y×DX)
50-35	41216.523	-68541.115	2.977	188-05-31	96-19-48	-2.687	184169.976005
50-117	41213.576	-68541.534	2.179	187-14-56	179-09-25	-5.109	350178.697206
50-116	41211.414	-68541.809	3.001	186-41-47	179-26-51	-5.143	352510.523687
50-115	41208.433	-68542.159	3.041	184-46-23	178-04-36	-6.011	412006.917749
50-114	41205.403	-68542.412	1.175	181-57-05	177-10-42	-4.204	288152.300048
50-113	41204.229	-68542.452	2.019	179-37-52	177-40-47	-3.193	218856.049236
50-112	41202.210	-68542.439	2.003	177-03-07	177-25-15	-4.019	275472.062341
50-111	41200.210	-68542.336	2.005	174-44-09	177-41-02	-3.997	273963.716992
50-110	41198.213	-68542.152	2.003	172-09-55	177-25-46	-3.981	272866.307112
50-109	41196.229	-68541.879	1.990	169-41-43	177-31-48	-3.942	270192.087018
50-108	41194.271	-68541.523	2.004	167-17-18	177-35-35	-3.913	268202.979499
50-107	41192.316	-68541.082	1.999	164-33-59	177-16-41	-3.882	266076.480324
50-106	41190.389	-68540.550	1.998	162-24-30	177-50-31	-3.832	262647.387600
50-105	41188.484	-68539.946	2.001	159-33-16	177-08-46	-3.780	259080.995880
50-104	41186.609	-68539.247	2.006	157-05-25	177-32-09	-3.723	255171.616581
50-103	41184.761	-68538.466	2.002	154-42-54	177-37-29	-3.658	250713.708628
50-102	41182.951	-68537.611	1.993	152-28-14	177-45-20	-3.577	245159.034547
50-101	41181.184	-68536.690	1.997	152-32-12	180-03-58	-3.539	242551.345910
50-8	41179.412	-68535.769	20.170	72-37-43	100-05-31	4.250	-291277.018250
50-34	41185.434	-68516.519	30.322	1-46-22	109-08-39	36.329	-2489136.618751
50-37	41215.741	-68515.581	9.192	271-44-21	89-57-59	30.586	-2095617.560466
50-87	41216.020	-68524.769	7.898	271-45-47	180-01-26	0.522	-35769.929418

倍面積	
面 積	

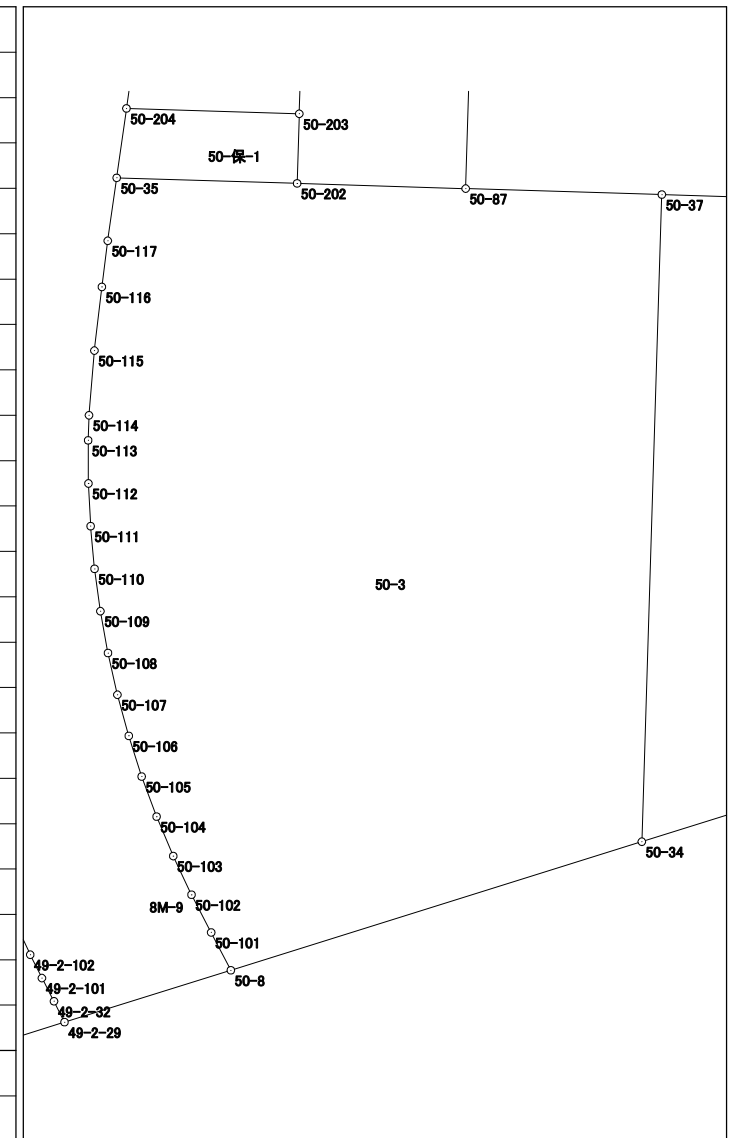




# 面積計算書 (座標法)

世界測地系 (測地成果2011)

所在	地番	公簿地目	現況地目	地積	所有者
前橋市六供町二丁目	50-3			849.56 m <sup>2</sup>	

点名	X座標	Y座標	辺長	方向角	測角	DX	倍積 (Y×DX)
50-202	41216.263	-68532.663	8.456	271-45-43	179-59-56	0.503	-34471.929489
							倍面積
							面積

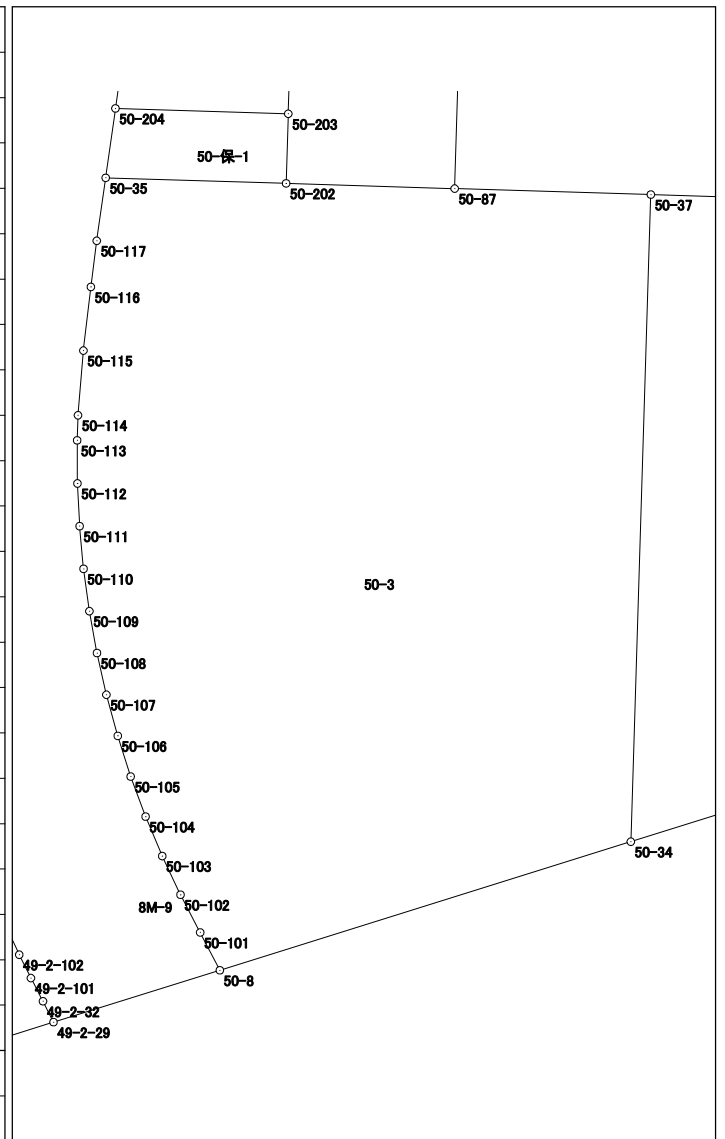

倍面積 1699.129989  
 面積 849.5649945




# 面積計算書（座標法）

世界測地系（測地成果2011）

所在	地番	公簿地目	現況地目	地積	所有者
前橋市六供町二丁目	50-5			1320.02 m <sup>2</sup>	

点名	X座標	Y座標	辺長	方向角	測角	DX	倍積 (Y×DX)
50-20	41262.080	-68492.874	15.848	181-46-45	89-59-04	-15.219	1042393.049406
50-63	41246.240	-68493.366	3.248	181-50-06	180-03-21	-19.086	1307264.383476
50-64	41242.994	-68493.470	11.913	181-45-38	179-55-32	-15.153	1037881.550910
50-76	41231.087	-68493.836	3.003	181-45-19	179-59-41	-14.909	1021174.600924
50-77	41228.085	-68493.928	1.847	181-46-07	180-00-48	-4.848	332058.562944
50-207	41226.239	-68493.985	1.155	181-44-14	179-58-07	-3.000	205481.955000
50-78	41225.085	-68494.020	9.996	181-47-19	180-03-05	-11.145	763365.852900
50-39	41215.094	-68494.332	22.969	181-46-08	179-58-49	-32.949	2256819.745068
50-33	41192.136	-68495.041	11.774	72-42-42	70-56-34	-19.459	1332845.002819
50-192	41195.635	-68483.799	3.070	73-07-45	180-25-03	4.390	-300643.877610
50-191	41196.526	-68480.861	3.053	73-20-44	180-12-59	1.766	-120937.200526
50-190	41197.401	-68477.936	3.046	73-33-50	180-13-06	1.737	-118946.174832
50-32	41198.263	-68475.014	63.226	1-46-32	108-12-42	64.058	-4386372.446812
50-21	41261.459	-68473.055	19.829	271-47-41	90-01-09	63.817	-4369744.950935

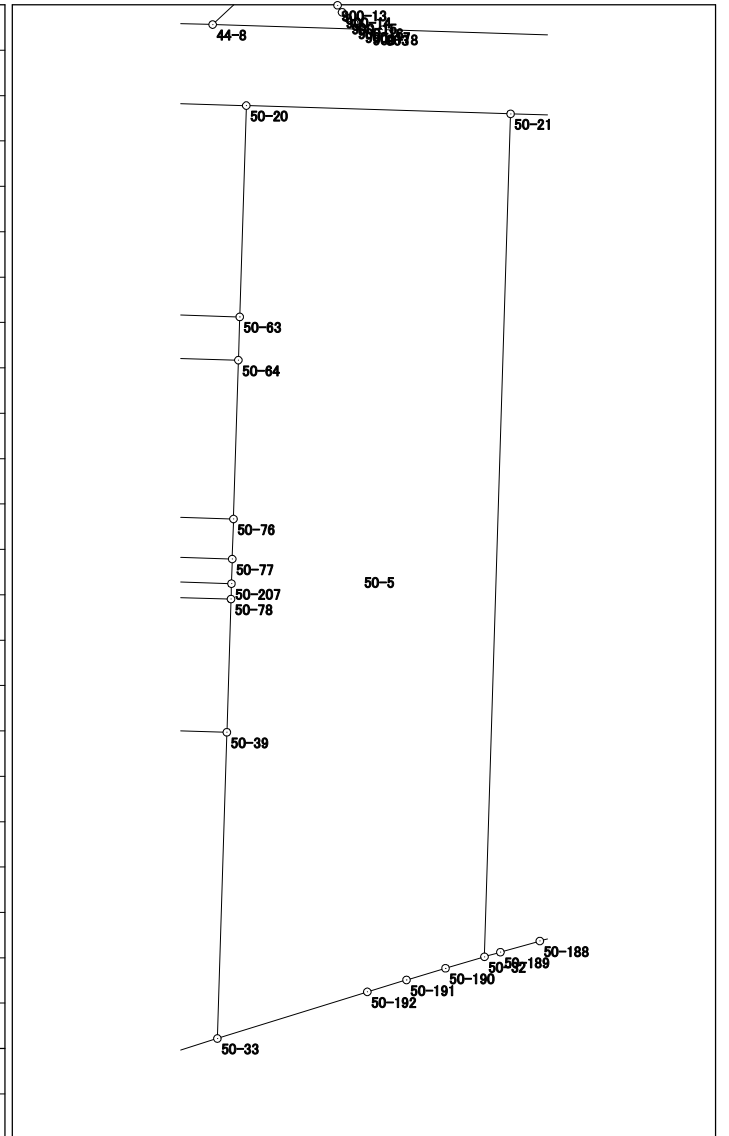


倍面積	2640.052732
面積	1320.0263660

# 面積計算書（座標法）

世界測地系（測地成果2011）

所在	地番	公簿地目	現況地目	地積	所有者
前橋市六供町二丁目	50-6			1749.47 m <sup>2</sup>	

点名	X座標	Y座標	辺長	方向角	測角	DX	倍積 (Y×DX)
50-32	41198.263	-68475.014	1.244	73-53-47	72-07-15	-62.851	4303723.104914
50-189	41198.608	-68473.819	3.069	74-11-35	180-17-48	1.181	-80867.580239
50-188	41199.444	-68470.866	3.056	74-37-53	180-26-18	1.646	-112703.045436
50-187	41200.254	-68467.919	3.060	75-06-52	180-28-59	1.596	-109274.798724
50-186	41201.040	-68464.962	3.060	75-26-46	180-19-54	1.555	-106463.015910
50-185	41201.809	-68462.000	3.044	75-37-17	180-10-31	1.525	-104404.550000
50-184	41202.565	-68459.051	3.060	75-47-28	180-10-11	1.507	-103167.789857
50-183	41203.316	-68456.085	3.061	76-20-10	180-32-42	1.474	-100904.269290
50-182	41204.039	-68453.111	3.061	76-45-46	180-25-36	1.424	-97477.230064
50-181	41204.740	-68450.131	3.056	77-07-24	180-21-38	1.382	-94598.081042
50-180	41205.421	-68447.152	2.213	77-30-07	180-22-43	1.160	-79398.696320
50-209	41205.900	-68444.991	54.658	1-45-45	104-15-38	55.111	-3772071.899001
50-210	41260.532	-68443.310	29.759	271-47-06	90-01-21	55.559	-3802641.860290
50-21	41261.459	-68473.055	63.226	181-46-32	89-59-26	-62.269	4263748.661795
						倍面積	3498.950536
						面積	1749.4752680

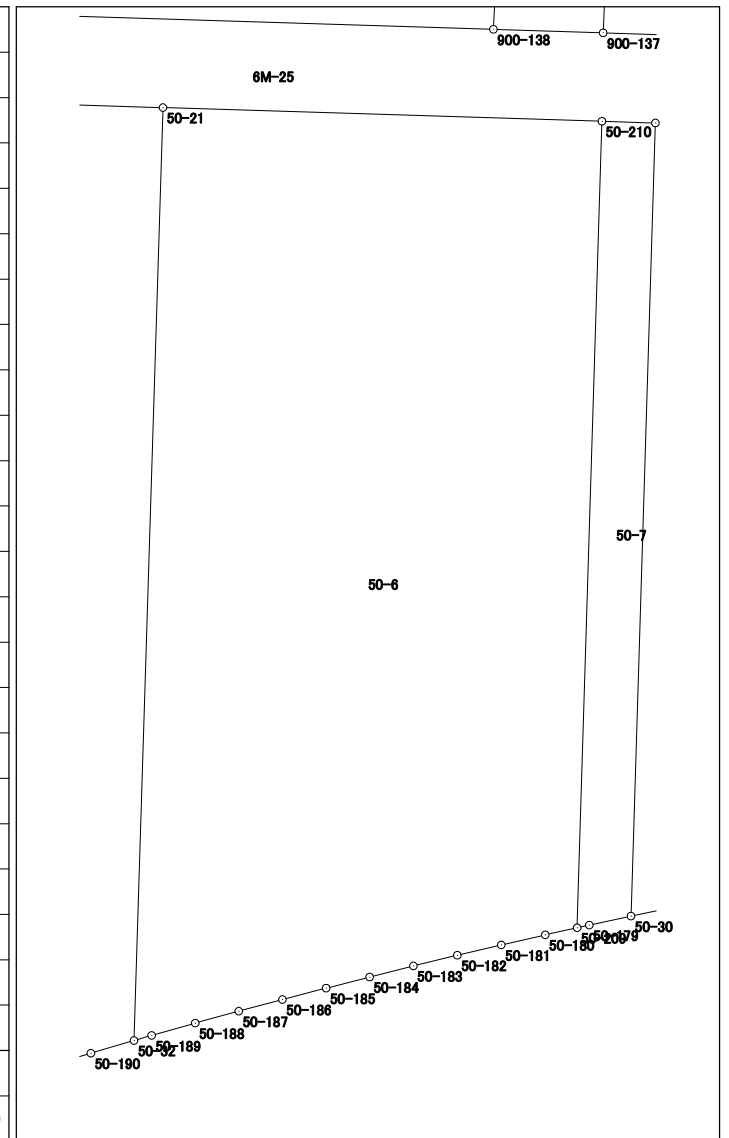


# 面積計算書（座標法）

世界測地系（測地成果2011）

所 在	地 番	公簿地目	現況地目	地 積	所 有 者
前橋市六供町二丁目	50-7			196.31 m <sup>2</sup>	

点 名	X 座標	Y 座標	辺 長	方 向 角	測 角	DX	倍 積 (Y×DX)
50-209	41205.900	-68444.991	0.843	77-31-49	75-46-04	-54.450	3726829.759950
50-179	41206.082	-68444.168	2.890	77-48-55	180-17-06	0.792	-54207.781056
50-30	41206.692	-68441.343	53.752	1-45-44	103-56-49	54.337	-3718897.254591
50-23	41260.419	-68439.690	3.622	271-47-17	90-01-33	53.840	-3684792.909600
50-210	41260.532	-68443.310	54.658	181-45-45	89-58-28	-54.519	3731460.817890
倍面積							392.632593
面 積							196.3162965

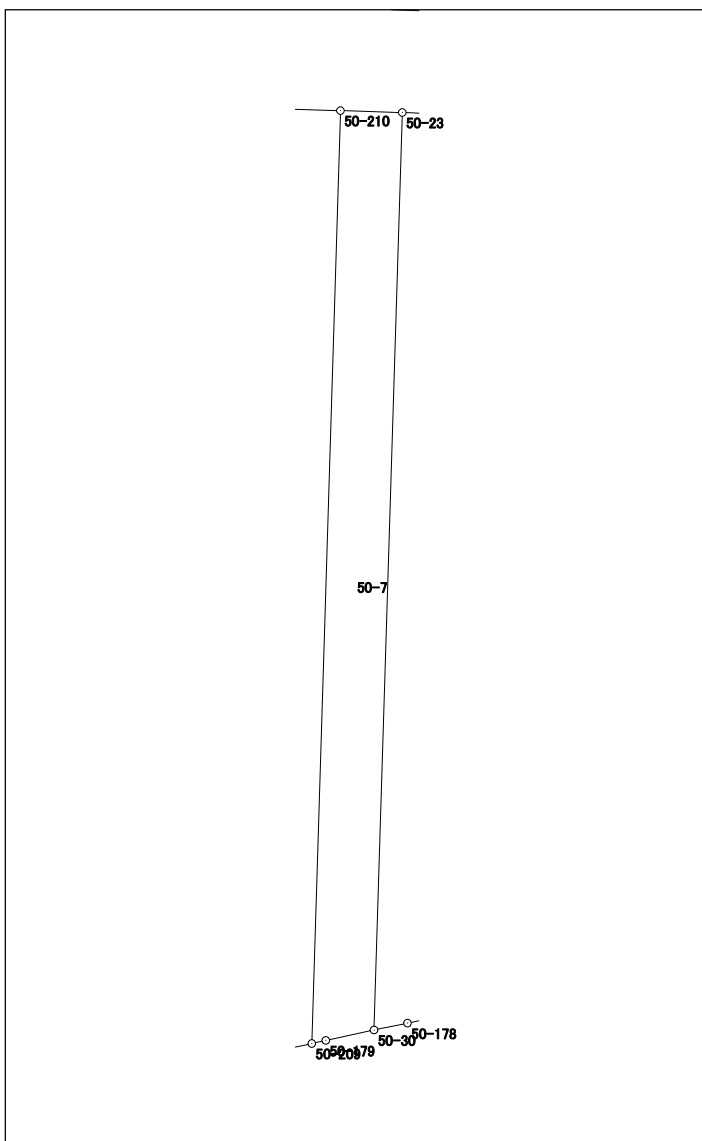


# 面積計算書 (座標法)

世界測地系 (測地成果2011)

所在	地番	公簿地目	現況地目	地積	所有者
前橋市六供町二丁目	50-8			2814.00 m <sup>2</sup>	

点名	X座標	Y座標	辺長	方向角	測角	Dx	倍積 (Y×Dx)
50-215	41240.737	-68369.408	29.233	271-45-23	89-58-53	25.293	-1729267.436544
50-213	41241.633	-68398.627	17.480	1-46-37	270-01-14	18.368	-1256345.980736
50-14	41259.105	-68398.085	41.626	271-48-32	90-01-55	18.786	-1284926.424810
50-23	41260.419	-68439.690	53.752	181-45-44	89-57-12	-52.413	3587129.471970
50-30	41206.692	-68441.343	1.998	78-20-09	76-34-25	-53.323	3649497.732789
50-178	41207.096	-68439.386	2.444	78-34-47	180-14-38	0.888	-60774.174768
50-177	41207.580	-68436.990	3.057	78-46-42	180-11-55	1.079	-73843.512210
50-176	41208.175	-68433.991	3.065	79-06-42	180-20-00	1.174	-80341.505434
50-175	41208.754	-68430.981	3.064	79-12-12	180-05-30	1.153	-78900.921093
50-174	41209.328	-68427.971	3.052	79-45-02	180-32-50	1.117	-76434.043607
50-173	41209.871	-68424.968	3.117	80-09-14	180-24-12	1.076	-73625.265568
50-172	41210.404	-68421.897	3.108	80-23-10	180-13-56	1.052	-71979.835644
50-171	41210.923	-68418.833	3.035	81-19-12	180-56-02	0.977	-66845.199841
50-170	41211.381	-68415.833	3.059	81-40-26	180-21-14	0.901	-61642.665533
50-169	41211.824	-68412.806	3.066	81-46-01	180-05-35	0.882	-60340.094892
50-168	41212.263	-68409.772	3.062	82-03-37	180-17-36	0.862	-58969.223464
50-167	41212.686	-68406.739	3.064	82-09-29	180-05-52	0.841	-57530.067499
50-166	41213.104	-68403.704	3.095	82-36-39	180-27-10	0.816	-55817.422464
50-165	41213.502	-68400.635	3.030	83-07-08	180-30-29	0.761	-52052.883235
50-164	41213.865	-68397.627	3.044	83-31-51	180-24-43	0.706	-48288.724662
50-163	41214.208	-68394.602	3.084	83-36-53	180-05-02	0.686	-46918.696972
50-162	41214.551	-68391.537	3.059	84-07-38	180-30-45	0.656	-44864.848272

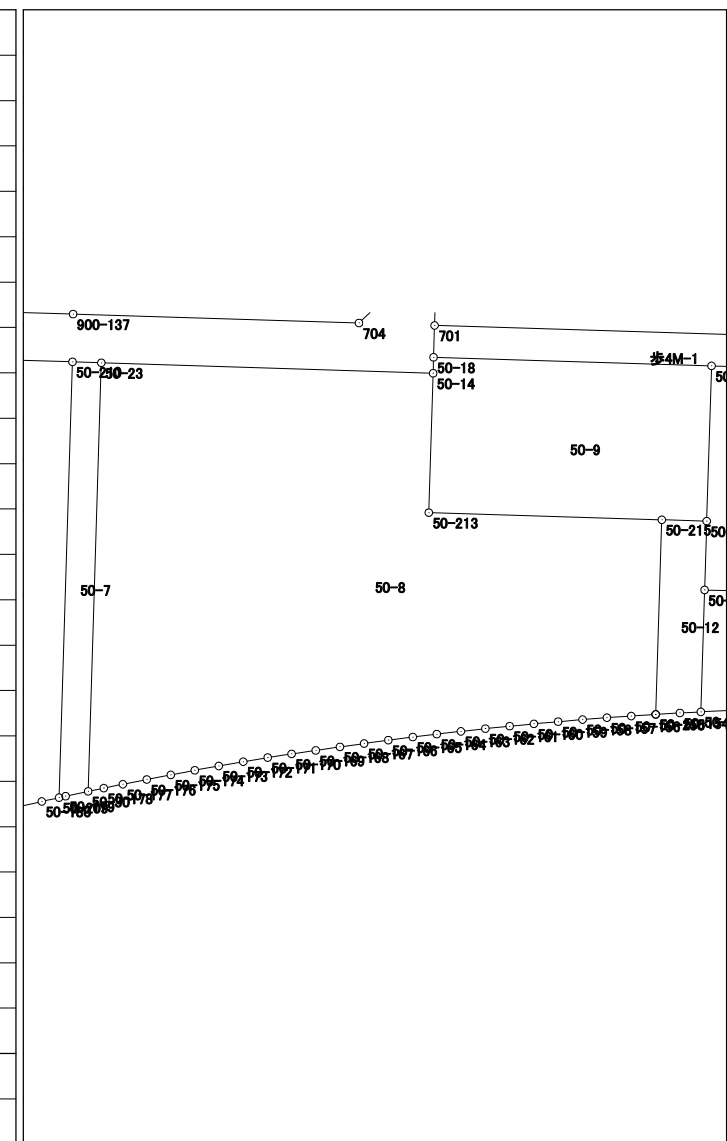


倍面積	
面積	

# 面積計算書（座標法）

世界測地系（測地成果2011）

所 在	地 番	公簿地目	現況地目	地 積	所 有 者
前橋市六供町二丁目	50-8			2814.00 m <sup>2</sup>	

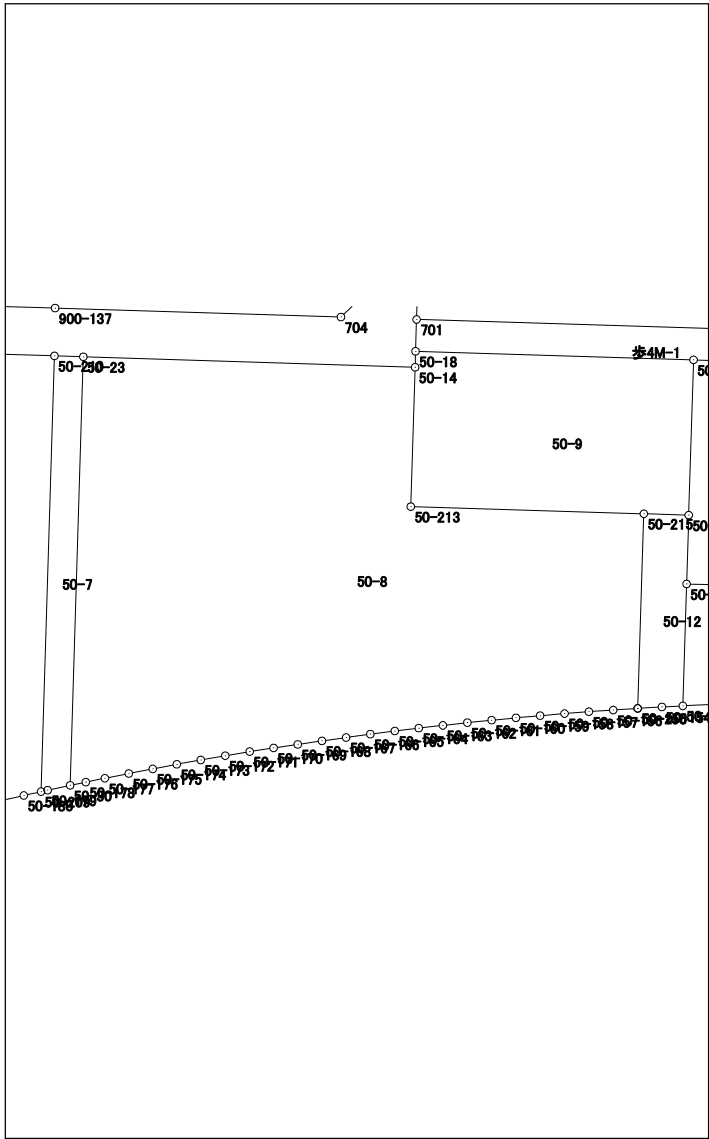
点 名	X 座標	Y 座標	辺 長	方 向 角	測 角	DX	倍 積 (Y×DX)	
50-161	41214.864	-68388.494	3.059	84-33-35	180-25-57	0.603	-41238.261882	
50-160	41215.154	-68385.449	3.047	84-50-29	180-16-54	0.564	-38569.393236	
50-159	41215.428	-68382.414	3.075	85-04-32	180-14-03	0.538	-36789.738732	
50-158	41215.692	-68379.350	3.063	85-38-14	180-33-42	0.497	-33984.536950	
50-157	41215.925	-68376.296	3.057	86-11-32	180-33-18	0.436	-29812.065056	
50-156	41216.128	-68373.246	3.058	86-03-45	179-52-13	0.413	-28238.150598	
50-155	41216.338	-68370.195	0.031	86-18-31	180-14-46	0.212	-14494.481340	
50-216	41216.340	-68370.164	24.409	1-46-30	95-27-59	24.399	-1668163.631436	
						倍面積	5628.018281	
						面 積	2814.0091405	

# 面積計算書 (座標法)

世界測地系 (測地成果2011)

所在	地番	公簿地目	現況地目	地積	所有者
前橋市六供町二丁目	50-9			679.12 m <sup>2</sup>	

点名	X座標	Y座標	辺長	方向角	測角	DX	倍積 (Y×DX)
50-18	41261.104	-68398.036	2.000	181-24-15	89-38-52	-0.930	63610.173480
50-14	41259.105	-68398.085	17.480	181-46-37	180-22-22	-19.471	1331779.113035
50-213	41241.633	-68398.627	29.233	91-45-23	89-58-46	-18.368	1256345.980736
50-215	41240.737	-68369.408	5.630	91-45-03	179-59-40	-1.068	73018.527744
50-214	41240.565	-68363.781	19.479	1-46-37	90-01-34	19.298	-1319284.245738
50-26	41260.035	-68363.177	34.875	271-45-23	89-58-46	20.539	-1404111.292403
						倍面積	1358.256854
						面積	679.1284270

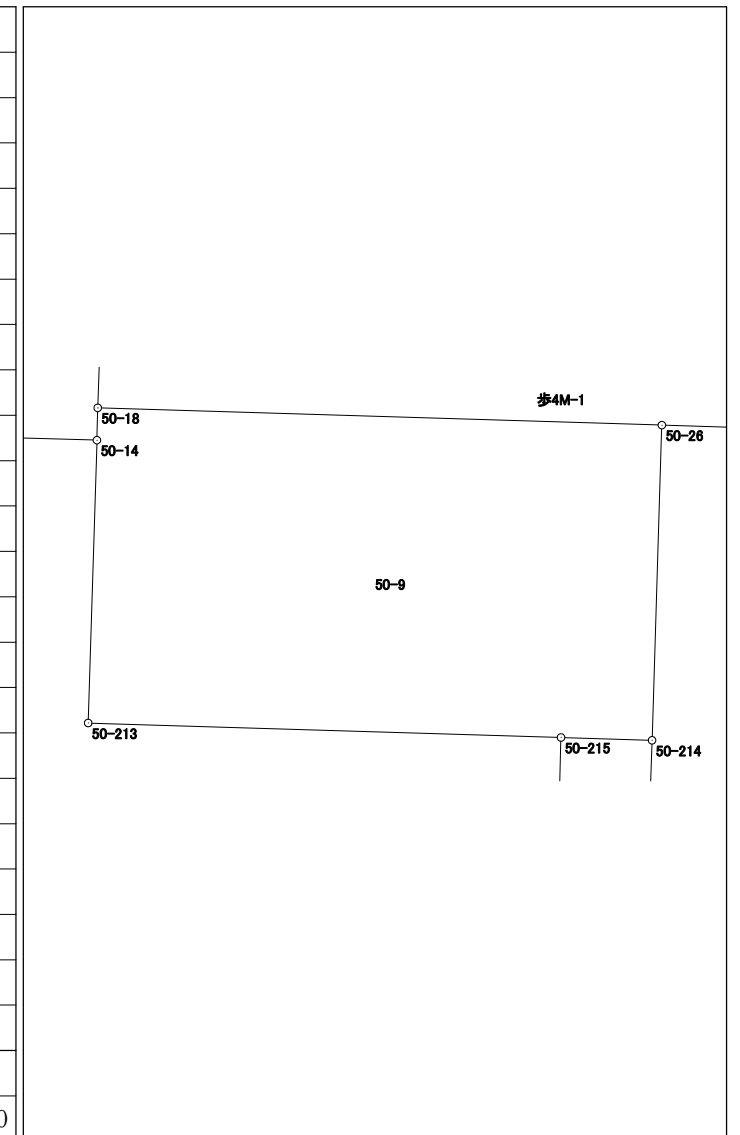





# 面積計算書（座標法）

世界測地系（測地成果2011）

所 在	地 番	公簿地目	現況地目	地 積	所 有 者
前橋市六供町二丁目	50-11			354.15 m <sup>2</sup>	

点 名	X 座標	Y 座標	辺 長	方 向 角	測 角	DX	倍 積 (Y×DX)	
50-211	41231.942	-68364.048	15.294	181-46-34	89-56-49	-14.460	988544.134080	
50-27	41216.655	-68364.522	4.098	87-20-34	85-34-00	-15.097	1032099.188634	
50-153	41216.845	-68360.428	4.896	87-57-06	180-36-32	0.365	-24951.556220	
50-152	41217.020	-68355.535	3.045	88-27-25	180-30-19	0.257	-17567.372495	
50-151	41217.102	-68352.491	3.656	89-09-14	180-41-49	0.136	-9295.938776	
50-150	41217.156	-68348.835	4.038	89-16-35	180-07-21	0.105	-7176.627675	
50-5	41217.207	-68344.797	11.928	39-26-29	130-09-54	9.263	-633077.854611	
50-4	41226.419	-68337.219	4.788	348-45-04	129-18-35	13.908	-950434.041852	
50-212	41231.115	-68338.153	25.908	271-49-45	103-04-41	5.523	-377431.619019	
							倍面積	708.312066
							面 積	354.1560330

# 面積計算書 (座標法)

世界測地系 (測地成果2011)

所 在	地 番	公簿地目	現況地目	地 積	所 有 者
前橋市六供町二丁目	50-12			136.01 m <sup>2</sup>	

点 名	X 座標	Y 座標	辺 長	方 向 角	測 角	DX	倍 積 (Y×DX)
50-211	41231.942	-68364.048	8.627	1-46-25	179-59-51	23.910	-1634584.387680
50-214	41240.565	-68363.781	5.630	271-45-03	89-58-38	8.795	-601259.453895
50-215	41240.737	-68369.408	24.409	181-46-30	90-01-27	-24.225	1656248.908800
50-216	41216.340	-68370.164	3.028	86-35-33	84-49-03	-24.217	1655720.261588
50-154	41216.520	-68367.141	2.622	87-02-57	180-27-24	0.315	-21535.649415
50-27	41216.655	-68364.522	15.294	1-46-34	94-43-37	15.422	-1054317.658284
						倍面積	272.021114
						面 積	136.0105570

