



51街区 画地出来形確認図 (4972.53m²)

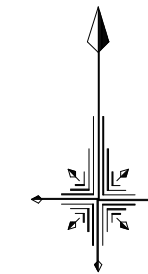

S=1/500

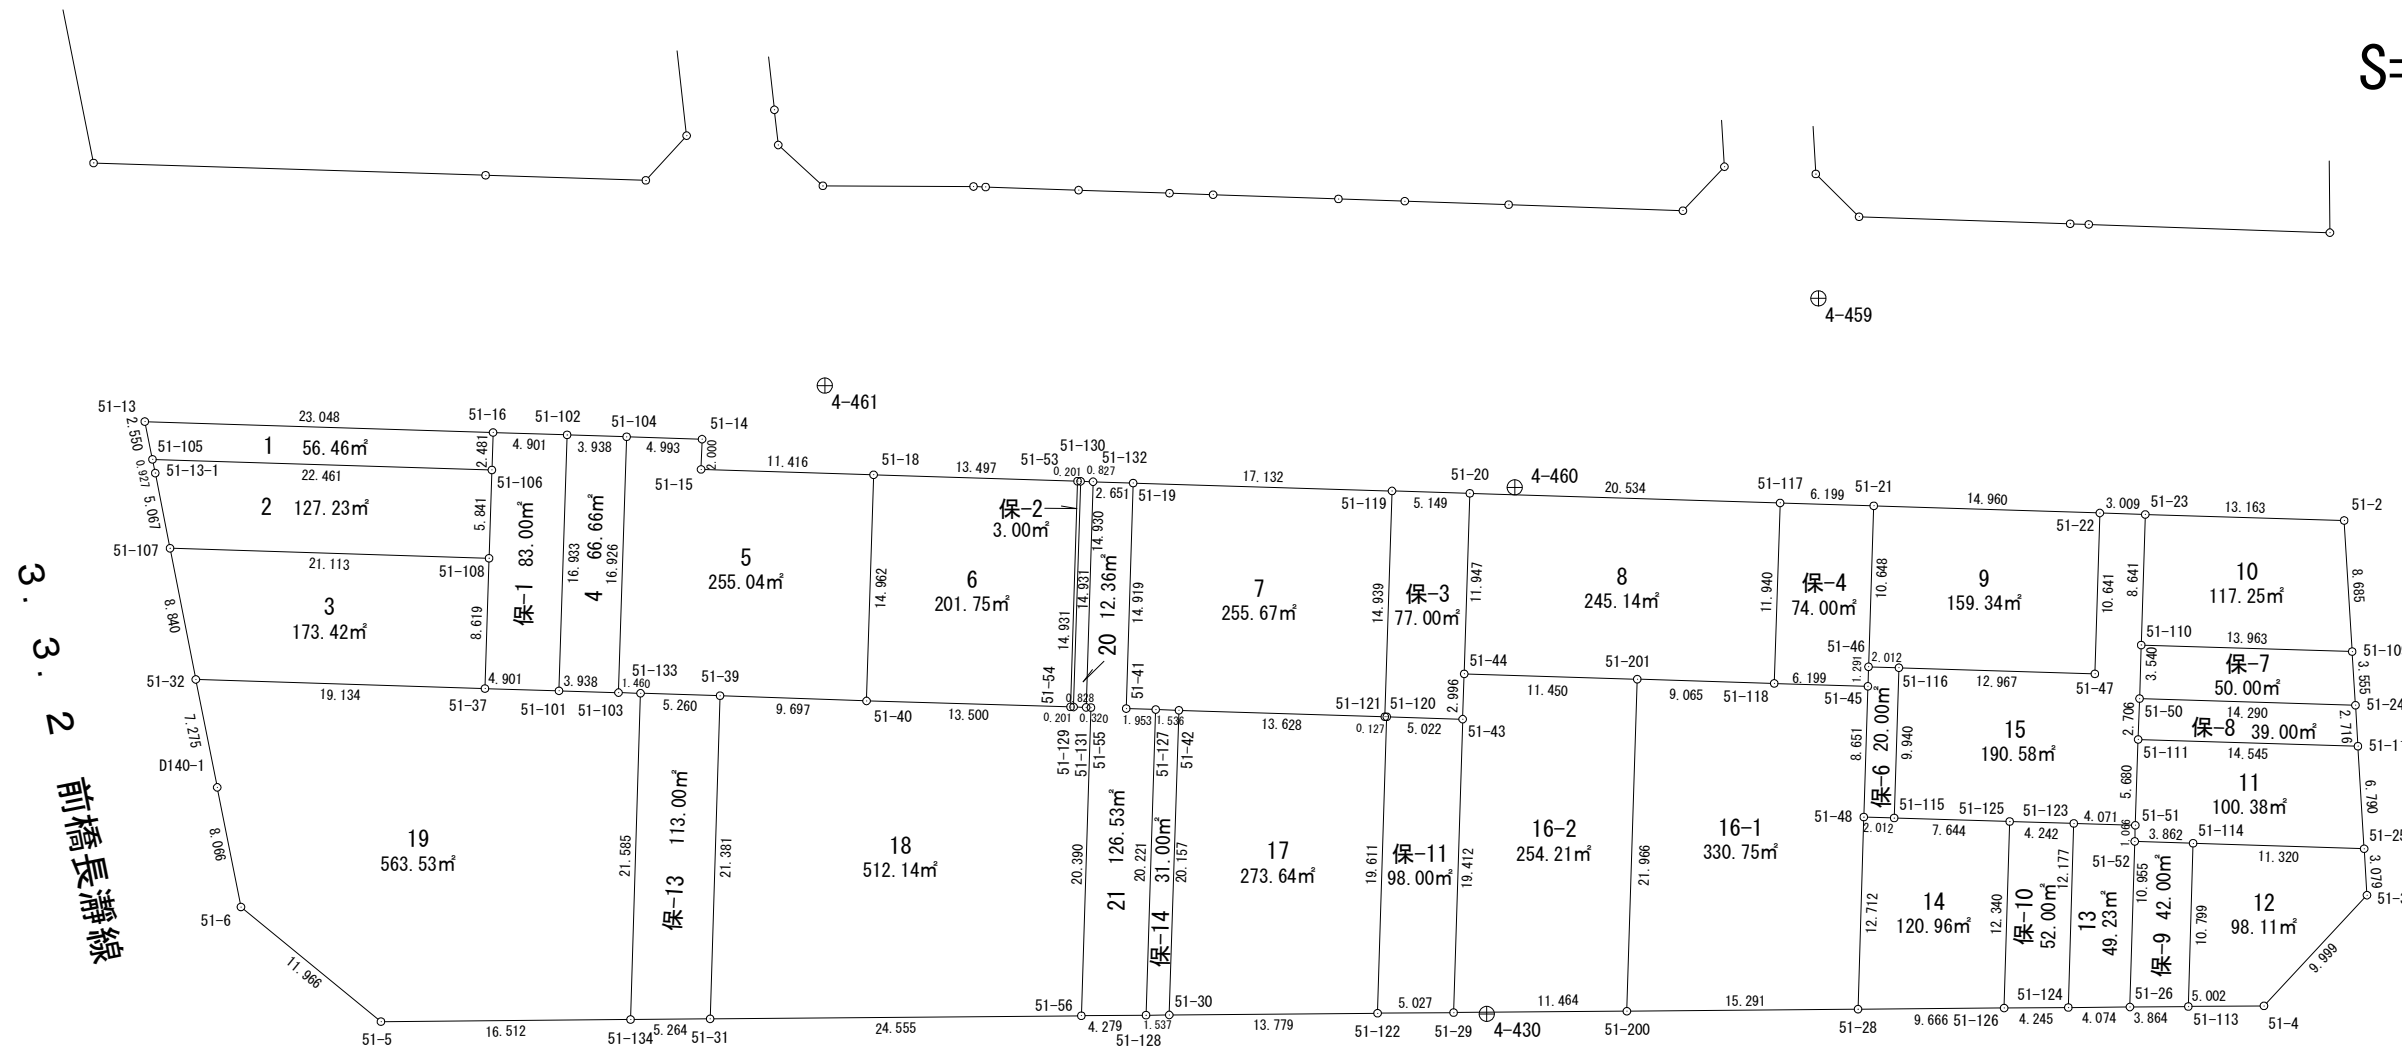

⊕ 4-428

⊕ 4-459

⊕ 4-431

⊕ 4-461

⊕ 4-460

⊕ 3-16

⊕ 4-429

⊕ 3-17


3. 3. 10 江田天川大島線

面積計算書（座標法）

世界測地系（測地成果2011）

所 在	地 番	公簿地目	現況地目	地 積	所 有 者
前橋市六供町二丁目	51-1			56.46 m ²	

点 名	X 座標	Y 座標	辺 長	方 向 角	測 角	DX	倍 積 (Y×DX)
51-13	41258.724	-68321.234	2.550	168-30-34	76-42-52	-1.777	121406.832818
51-105	41256.225	-68320.726	22.461	91-47-37	103-17-03	-3.202	218762.964652
51-106	41255.522	-68298.276	2.481	1-49-28	90-01-51	1.777	-121366.036452
51-16	41258.002	-68298.197	23.048	271-47-42	89-58-14	3.202	-218690.826794
倍面積						112.934224	
面 積						56.4671120	

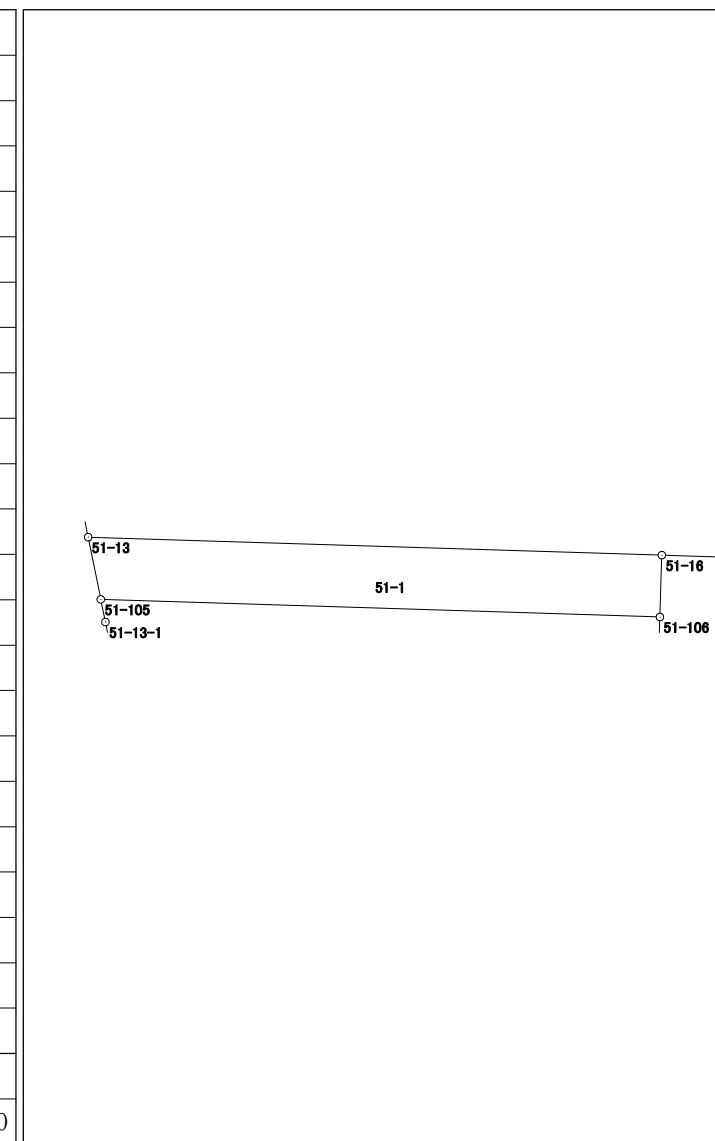


面積計算書 (座標法)

世界測地系 (測地成果2011)

所在	地番	公簿地目	現況地目	地積	所有者
前橋市六供町二丁目	51-2			127.23 m ²	

点名	X座標	Y座標	辺長	方向角	測角	DX	倍積 (Y×DX)
51-106	41255.522	-68298.276	22.461	271-47-37	89-58-43	6.541	-446739.023316
51-105	41256.225	-68320.726	0.927	168-29-02	76-41-25	-0.205	14005.748830
51-13-1	41255.317	-68320.541	5.067	168-52-59	180-23-57	-5.880	401724.781080
51-107	41250.345	-68319.564	21.113	91-47-39	102-54-40	-5.633	384844.104012
51-108	41249.684	-68298.461	5.841	1-48-54	90-01-15	5.177	-353581.132597
						倍面積	254.478009
						面積	127.2390045

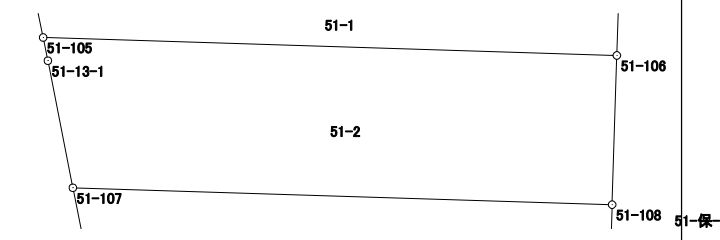


面積計算書 (座標法)

世界測地系 (測地成果2011)

所在	地番	公簿地目	現況地目	地積	所有者
前橋市六供町二丁目	51-4			66.66 m ²	

点名	X座標	Y座標	辺長	方向角	測角	DX	倍積 (Y×DX)
51-102	41257.845	-68293.299	16.933	181-49-03	89-59-02	-16.798	1147190.836602
51-101	41240.921	-68293.836	3.938	91-43-54	89-54-51	-17.043	1163931.846948
51-103	41240.802	-68289.900	16.926	1-49-05	90-05-11	16.798	-1147133.740200
51-104	41257.719	-68289.363	3.938	271-50-01	90-00-56	17.043	-1163855.613609

倍面積	133.329741
面積	66.6648705

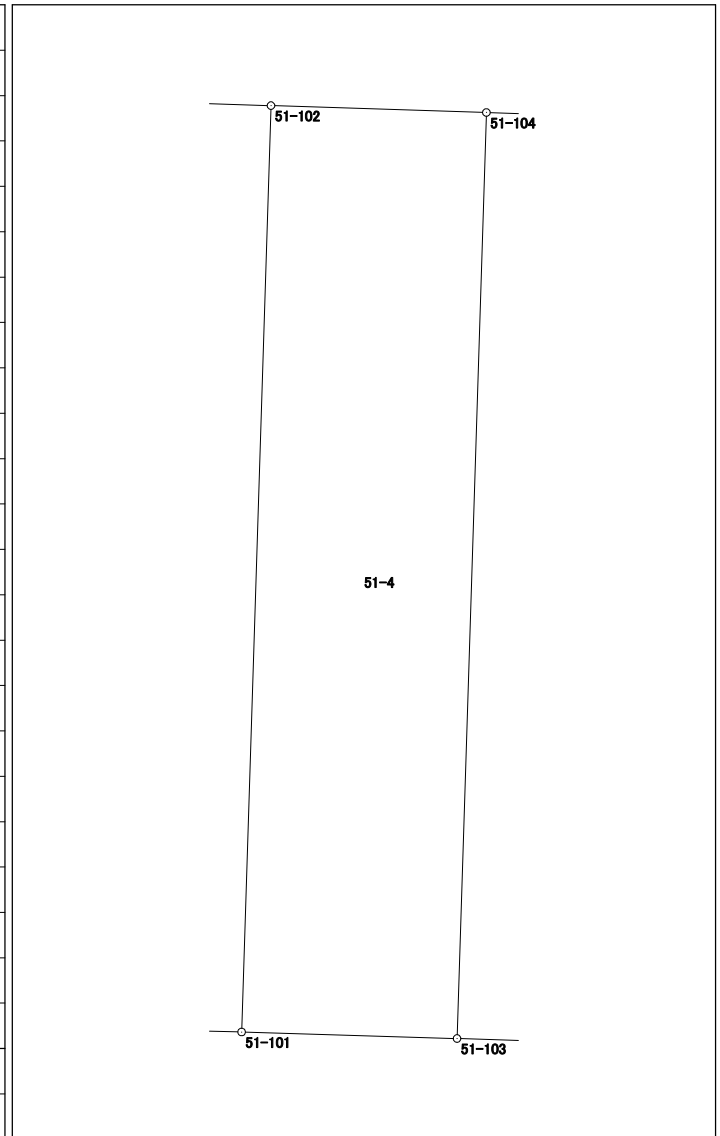


面積計算書（座標法）

世界測地系（測地成果2011）

所 在	地 番	公簿地目	現況地目	地 積	所 有 者
前橋市六供町二丁目	51-5			255.04 m ²	

点 名	X 座 標	Y 座 標	辺 長	方 向 角	測 角	DX	倍 積 (Y×DX)
51-103	41240.802	-68289.900	1.460	91-43-39	89-54-34	-16.961	1158264.993900
51-133	41240.758	-68288.441	5.260	91-44-35	180-00-56	-0.204	13930.841964
51-39	41240.598	-68283.183	9.697	92-03-02	180-18-27	-0.507	34619.573781
51-40	41240.251	-68273.492	14.962	1-47-05	89-44-03	14.608	-997339.171136
51-18	41255.206	-68273.026	11.416	271-46-37	89-59-32	15.309	-1045191.755034
51-15	41255.560	-68284.437	2.000	1-50-02	270-03-25	2.353	-160673.280261
51-14	41257.559	-68284.373	4.993	271-50-11	90-00-09	2.159	-147425.961307
51-104	41257.719	-68289.363	16.926	181-49-05	89-58-54	-16.757	1144324.855791
						倍面積	510.097698
						面 積	255.0488490

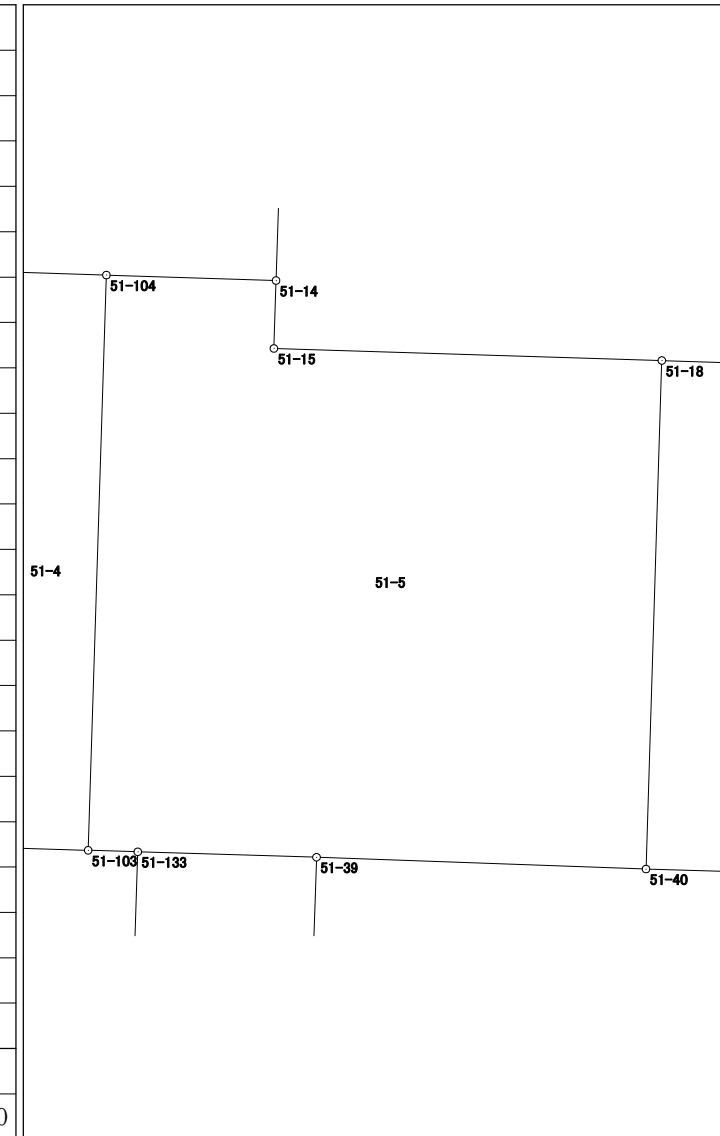

面積計算書 (座標法)

世界測地系 (測地成果2011)

所 在	地 番	公簿地目	現況地目	地 積	所 有 者
前橋市六供町二丁目	51-7			255.67 m ²	


点 名	X 座標	Y 座標	辺 長	方 向 角	測 角	DX	倍 積 (Y×DX)	
51-119	41254.137	-68238.734	17.132	271-44-34	89-55-28	15.452	-1054424.917768	
51-19	41254.658	-68255.858	14.919	181-45-33	90-00-59	-14.391	982270.052478	
51-41	41239.746	-68256.316	1.953	91-52-40	90-07-07	-14.976	1022206.588416	
51-127	41239.682	-68254.364	1.536	91-51-56	179-59-16	-0.114	7780.997496	
51-42	41239.632	-68252.829	13.628	91-47-29	179-55-33	-0.476	32488.346604	
51-120	41239.206	-68239.208	14.939	1-49-06	90-01-37	14.505	-989809.712040	
倍面積							511.355186	
面 積							255.6775930	

面積計算書 (座標法)

世界測地系 (測地成果2011)

所在	地番	公簿地目	現況地目	地積	所有者
前橋市六供町二丁目	51-8			245.14 m ²	

点名	X座標	Y座標	辺長	方向角	測角	DX	倍積 (Y×DX)
51-117	41253.343	-68213.063	20.534	271-46-40	89-54-56	12.571	-857506.414973
51-20	41253.980	-68233.587	11.947	181-46-29	89-59-49	-11.304	771312.467448
51-44	41242.039	-68233.957	11.450	91-45-42	89-59-13	-12.293	838800.033401
51-201	41241.687	-68222.512	9.065	91-45-26	179-59-44	-0.630	42980.182560
51-118	41241.409	-68213.451	11.940	1-51-44	90-06-18	11.656	-795095.984856

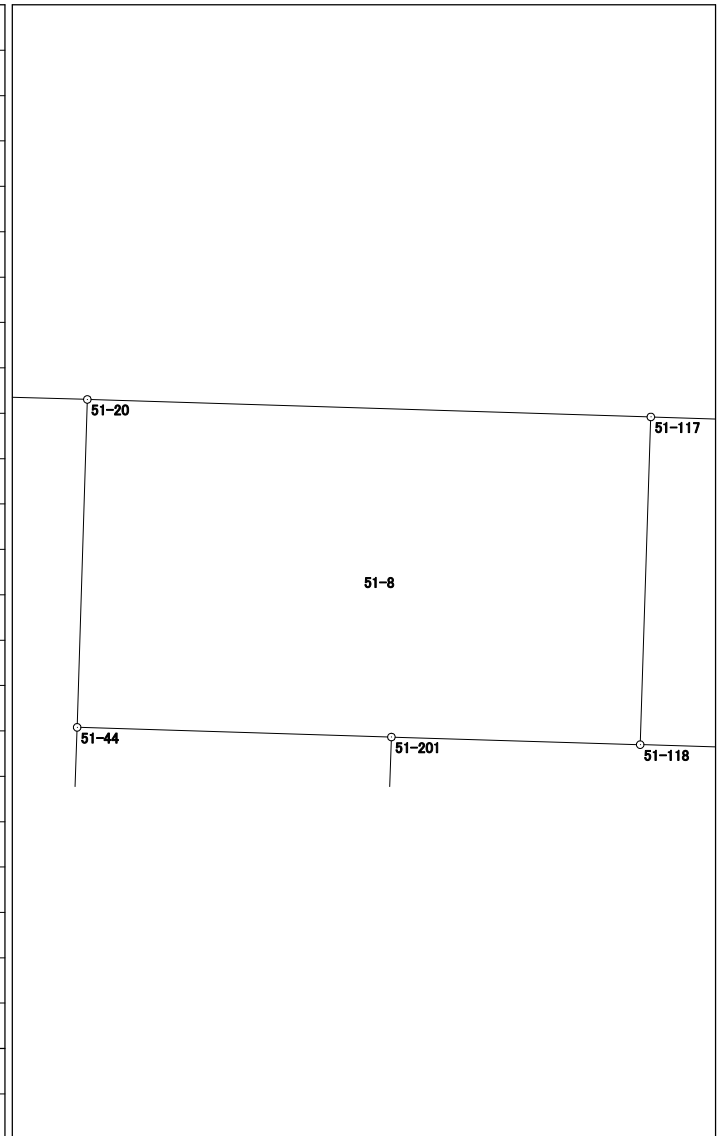


倍面積	490.283580
面積	245.1417900

面積計算書 (座標法)

世界測地系 (測地成果2011)

所在	地番	公簿地目	現況地目	地積	所有者
前橋市六供町二丁目	51-9			159.34 m ²	

点名	X座標	Y座標	辺長	方向角	測角	DX	倍積 (Y×DX)
51-21	41253.151	-68206.867	10.648	181-52-03	90-03-21	-10.169	693595.630523
51-46	41242.509	-68207.214	2.012	91-47-40	89-55-37	-10.705	730158.225870
51-116	41242.446	-68205.203	12.967	91-47-07	179-59-27	-0.467	31851.829801
51-47	41242.042	-68192.242	10.641	1-45-59	89-58-52	10.232	-697743.020144
51-22	41252.678	-68191.914	14.960	271-48-42	90-02-43	11.109	-757543.972626
						倍面積	318.693424
						面積	159.3467120

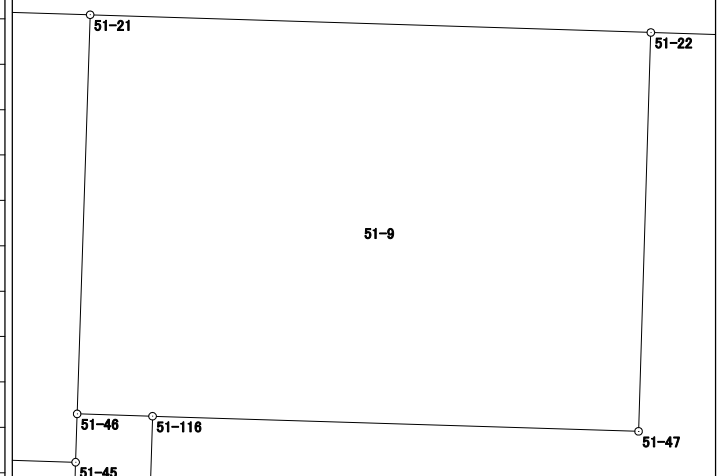


面積計算書 (座標法)

世界測地系 (測地成果2011)

所在	地番	公簿地目	現況地目	地積	所有者
前橋市六供町二丁目	51-10			117.25 m ²	

点名	X座標	Y座標	辺長	方向角	測角	DX	倍積 (Y×DX)
51-109	41243.514	-68175.221	8.685	356-30-29	84-44-21	8.238	-561627.470598
51-2	41252.183	-68175.750	13.163	271-44-13	95-13-44	9.068	-618217.701000
51-23	41252.582	-68188.907	8.641	181-47-26	90-03-13	-8.238	561740.215866
51-110	41243.945	-68189.177	13.963	91-46-08	89-58-42	-9.068	618339.457036

倍面積	234.501304
面積	117.2506520

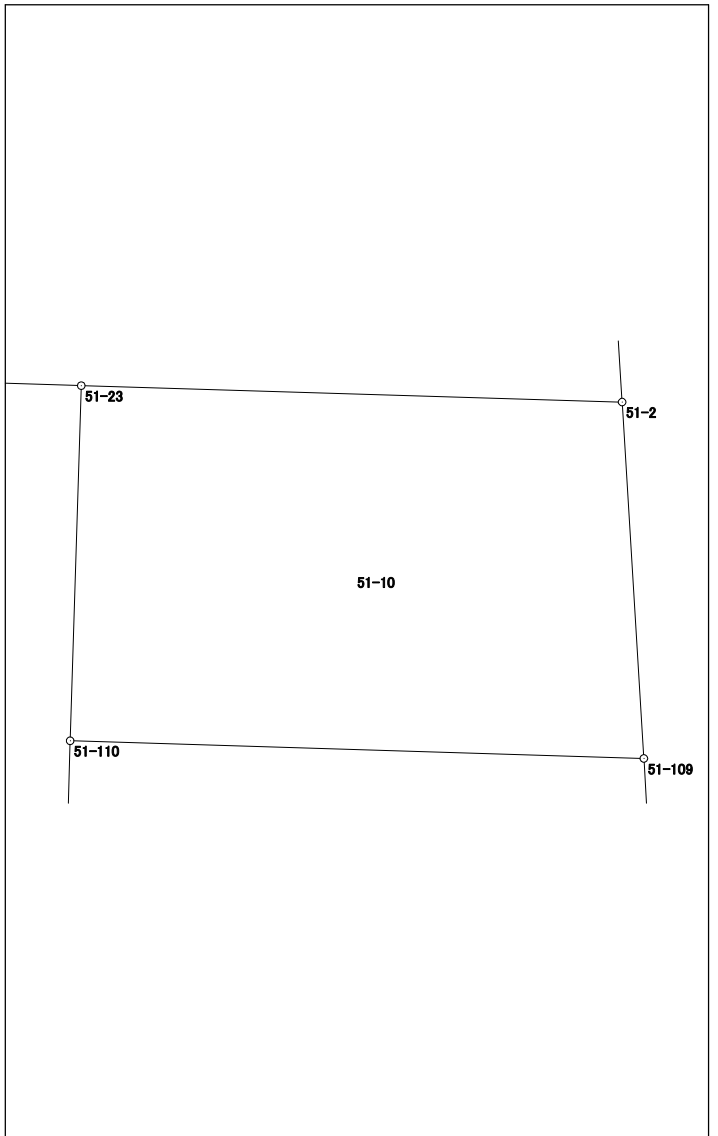

面積計算書（座標法）

世界測地系（測地成果2011）

所在	地番	公簿地目	現況地目	地積	所有者
前橋市六供町二丁目	51-11			100.38 m ²	


点名	X座標	Y座標	辺長	方向角	測角	DX	倍積 (Y×DX)	
51-111	41237.703	-68189.378	5.680	181-55-01	90-09-07	-5.229	356562.257562	
51-51	41232.026	-68189.568	1.066	181-52-56	179-57-55	-6.742	459734.067456	
51-52	41230.961	-68189.603	3.862	91-49-30	89-56-34	-1.188	81009.248364	
51-114	41230.838	-68185.743	11.320	91-49-39	180-00-09	-0.484	33001.899612	
51-25	41230.477	-68174.429	6.790	356-31-48	84-42-09	6.417	-437475.310893	
51-112	41237.255	-68174.840	14.545	271-45-54	95-14-06	7.226	-492631.393840	
							倍面積	200.768261
							面積	100.3841305

面積計算書（座標法）

世界測地系（測地成果2011）

所在	地番	公簿地目	現況地目	地積	所有者
前橋市六供町二丁目	51-12			98.11 m ²	

点名	X座標	Y座標	辺長	方向角	測角	DX	倍積 (Y×DX)
51-113	41220.044	-68186.059	5.002	89-31-08	87-50-31	-10.752	733136.506368
51-4	41220.086	-68181.057	9.999	42-57-27	133-26-19	7.360	-501812.579520
51-3	41227.404	-68174.243	3.079	356-32-11	133-34-44	10.391	-708398.559013
51-25	41230.477	-68174.429	11.320	271-49-39	95-17-28	3.434	-234110.989186
51-114	41230.838	-68185.743	10.799	181-40-37	89-50-58	-10.433	711381.856719

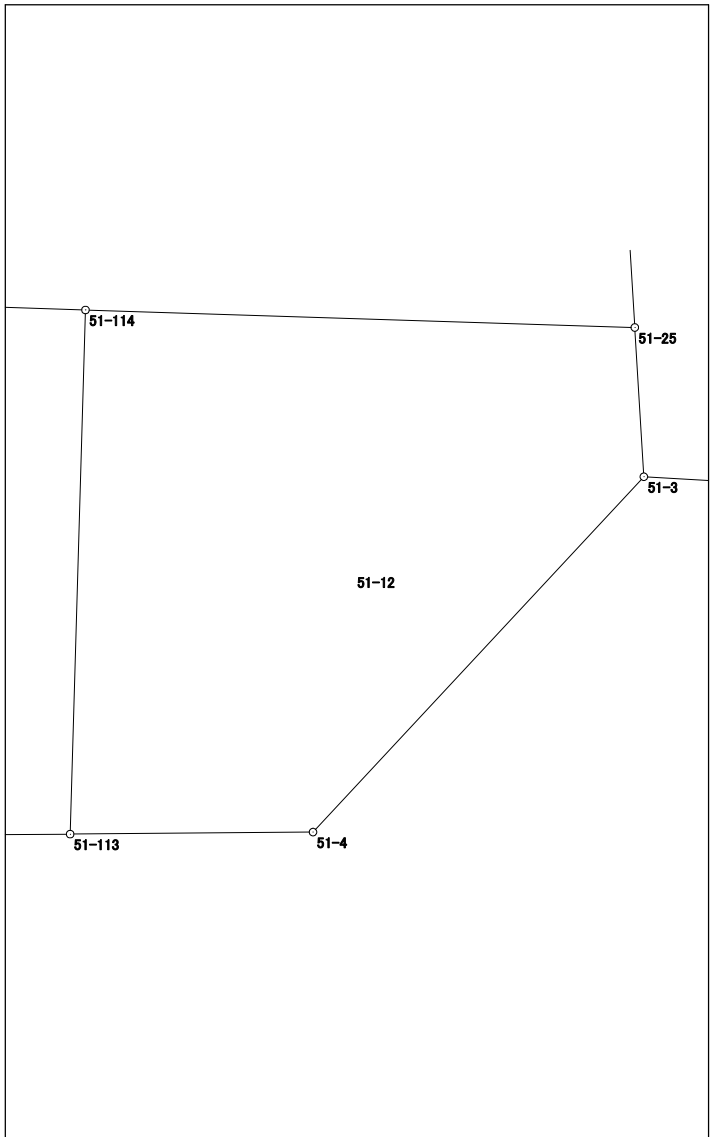


面積計算書（座標法）

世界測地系（測地成果2011）

所在	地番	公簿地目	現況地目	地積	所有者
前橋市六供町二丁目	51-13			49.23 m ²	

点名	X 座標	Y 座標	辺長	方向角	測角	DX	倍積 (Y×DX)
51-26	41220.011	-68189.923	10.955	1-40-26	92-08-17	10.983	-748929.924309
51-52	41230.961	-68189.603	1.066	1-52-56	180-12-30	12.015	-819298.080045
51-51	41232.026	-68189.568	4.071	271-44-44	89-51-48	1.189	-81077.396352
51-123	41232.150	-68193.637	12.177	181-41-39	89-56-55	-12.048	821596.938576
51-124	41219.978	-68193.997	4.074	89-32-09	87-50-30	-12.139	827806.929583

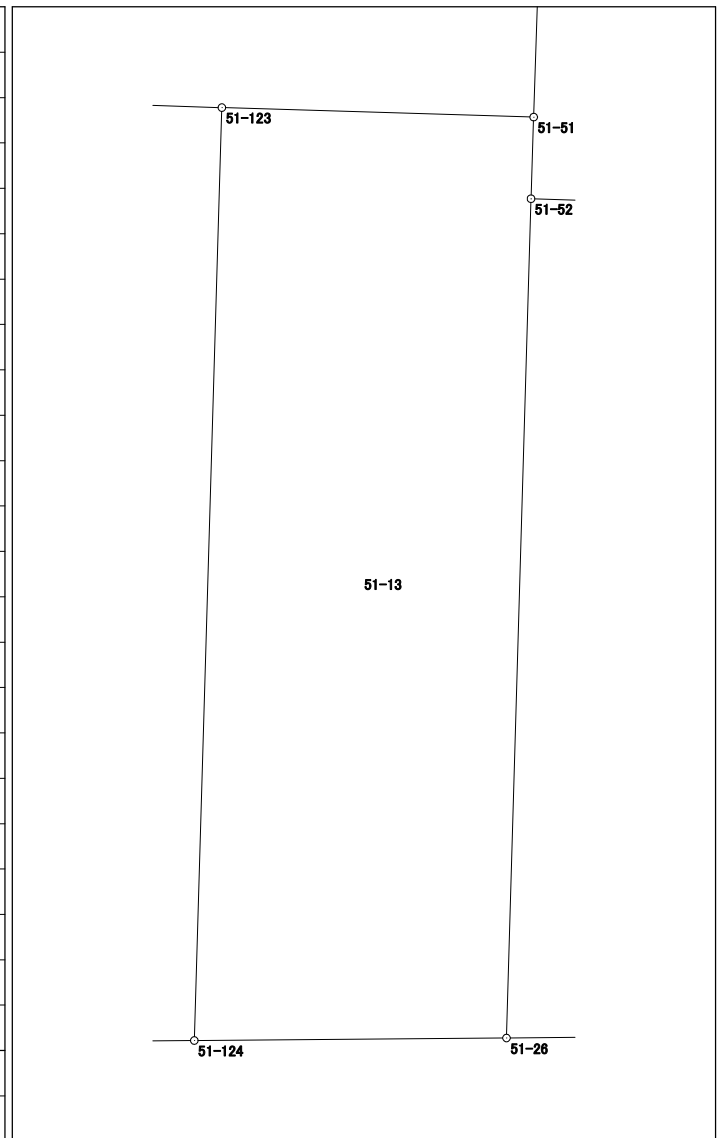


倍面積	98.467453
面積	49.2337265

面積計算書（座標法）

世界測地系（測地成果2011）

所 在	地 番	公簿地目	現況地目	地 積	所 有 者
前橋市六供町二丁目	51-14			120.96 m ²	

点 名	X 座標	Y 座標	辺 長	方 向 角	測 角	DX	倍 積 (Y×DX)
51-125	41232.279	-68197.877	7.644	271-44-22	90-02-40	12.567	-857042.720259
51-115	41232.511	-68205.517	2.012	271-44-15	179-59-53	0.293	-19984.216481
51-48	41232.572	-68207.528	12.712	181-42-47	89-58-32	-12.645	862484.191560
51-28	41219.866	-68207.908	9.666	89-32-16	87-49-29	-12.628	861329.462224
51-126	41219.944	-68198.242	12.340	1-41-42	92-09-26	12.413	-846544.777946
						倍面積	241.939098
						面 積	120.9695490

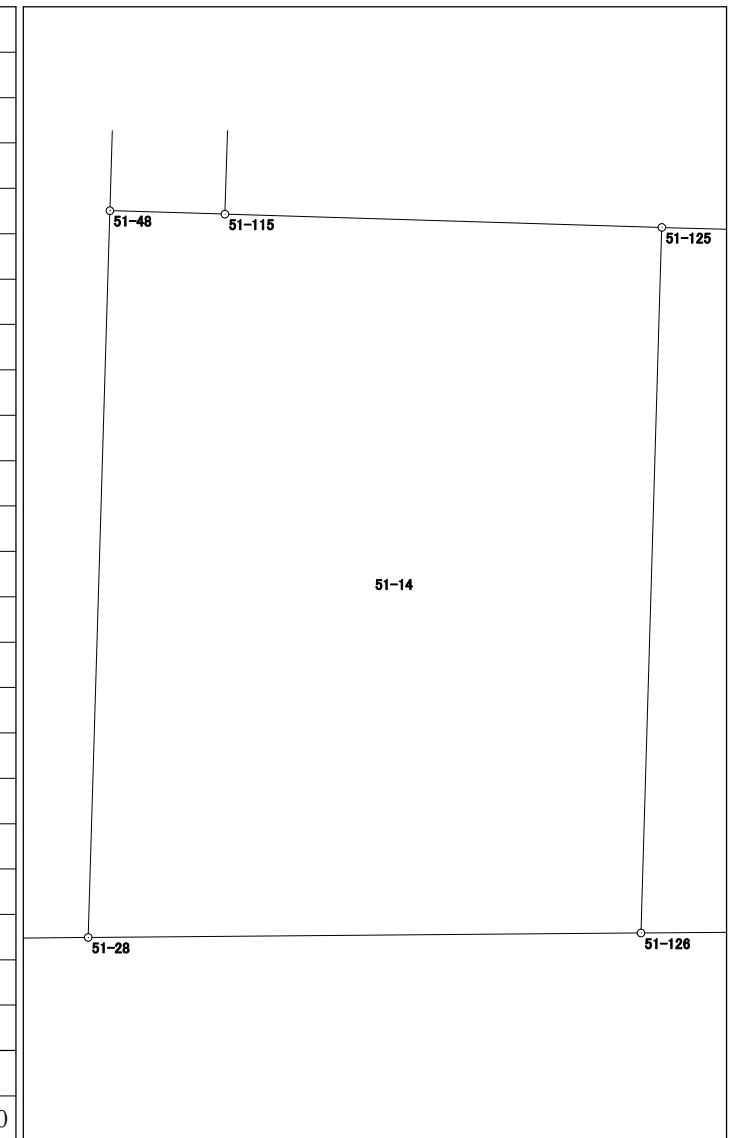


面積計算書 (座標法)

世界測地系 (測地成果2011)

所在	地番	公簿地目	現況地目	地積	所有者
前橋市六供町二丁目	51-16-1			330.75 m ²	

点名	X座標	Y座標	辺長	方向角	測角	DX	倍積 (Y×DX)
51-201	41241.687	-68222.512	21.966	181-47-23	90-01-57	-21.677	1478859.392624
51-200	41219.732	-68223.198	15.291	89-29-52	87-42-29	-21.821	1488698.403558
51-28	41219.866	-68207.908	12.712	1-42-47	92-12-55	12.840	-875789.538720
51-48	41232.572	-68207.528	8.651	1-48-30	180-05-43	21.353	-1456435.345384
51-45	41241.219	-68207.255	6.199	271-45-23	89-56-53	8.837	-602747.512435
51-118	41241.409	-68213.451	9.065	271-45-26	180-00-03	0.468	-31923.895068

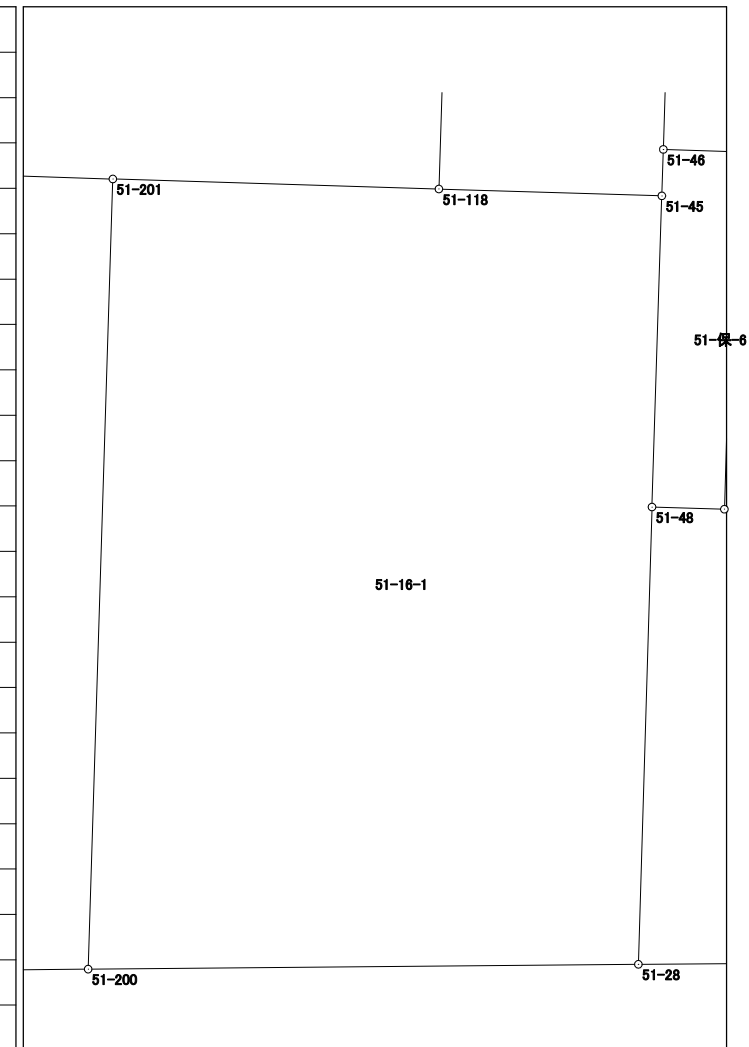


倍面積	661.504575
面積	330.7522875

面積計算書（座標法）

世界測地系（測地成果2011）

所 在	地 番	公簿地目	現況地目	地 積	所 有 者
前橋市六供町二丁目	51-16-2			254.21 m ²	

点 名	X 座標	Y 座標	辺 長	方 向 角	測 角	DX	倍 積 (Y×DX)
51-44	41242.039	-68233.957	2.996	181-59-22	90-13-40	-2.642	180274.114394
51-43	41239.045	-68234.061	19.412	181-46-27	179-47-05	-22.397	1528238.264217
51-29	41219.642	-68234.662	11.464	89-33-01	87-46-34	-19.313	1317816.027206
51-200	41219.732	-68223.198	21.966	1-47-23	92-14-22	22.045	-1503980.399910
51-201	41241.687	-68222.512	11.450	271-45-42	89-58-19	22.307	-1521839.575184
倍面積						508.430723	
面 積						254.2153615	

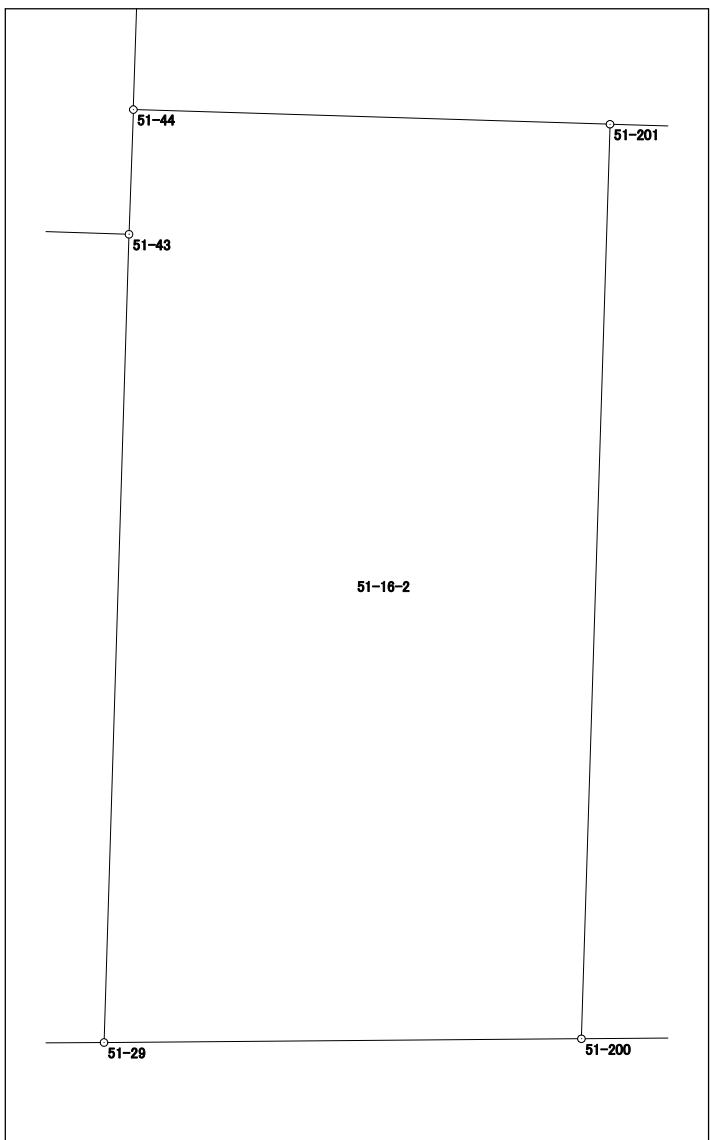


面積計算書（座標法）

世界測地系（測地成果2011）

所 在	地 番	公簿地目	現況地目	地 積	所 有 者
前橋市六供町二丁目	51-18			512.14 m ²	

点 名	X 座標	Y 座標	辺 長	方 向 角	測 角	DX	倍 積 (Y×DX)
51-39	41240.598	-68283.183	21.381	181-45-20	89-42-18	-21.024	1435585.639392
51-31	41219.227	-68283.838	24.555	89-31-18	87-45-58	-21.166	1445295.715108
51-56	41219.432	-68259.284	20.390	1-47-05	92-15-47	20.585	-1405117.361140
51-55	41239.812	-68258.649	0.320	271-58-08	90-11-03	20.391	-1391862.111759
51-131	41239.823	-68258.969	0.828	271-52-04	179-53-56	0.038	-2593.840822
51-129	41239.850	-68259.797	0.201	271-59-40	180-07-36	0.034	-2320.833098
51-54	41239.857	-68259.998	13.500	271-40-21	179-40-41	0.401	-27372.259198
51-40	41240.251	-68273.492	9.697	272-03-02	180-22-41	0.741	-50590.657572
						倍面積	1024.290911
						面 積	512.1454555

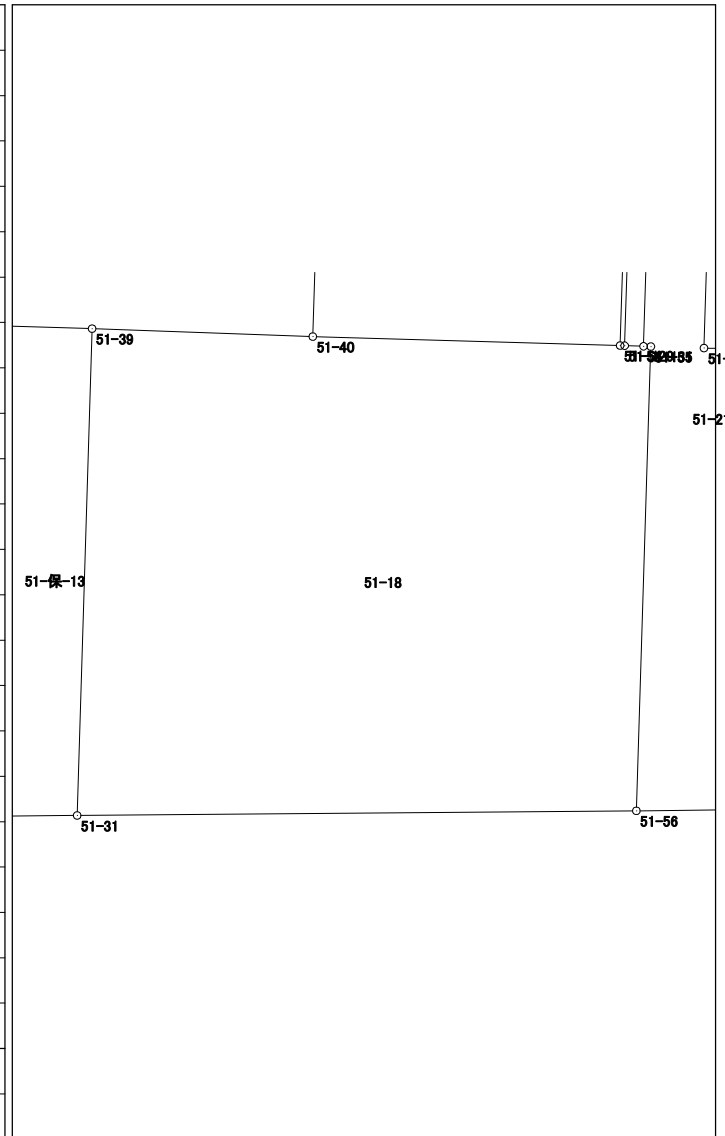

面積計算書（座標法）

世界測地系（測地成果2011）

所 在	地 番	公簿地目	現況地目	地 積	所 有 者
前橋市六供町二丁目	51-19			563.53 m ²	


点 名	X 座標	Y 座標	辺 長	方 向 角	測 角	DX	倍 積 (Y×DX)	
51-133	41240.758	-68288.441	1.460	271-43-39	89-58-22	21.619	-1476327.805979	
51-103	41240.802	-68289.900	3.938	271-43-54	180-00-15	0.163	-11131.253700	
51-101	41240.921	-68293.836	4.901	271-43-49	179-59-55	0.267	-18234.454212	
51-37	41241.069	-68298.735	19.134	271-48-10	180-04-21	0.750	-51224.051250	
51-32	41241.671	-68317.860	7.275	168-46-36	76-58-26	-6.534	446388.897240	
D140-1	41234.535	-68316.444	8.066	168-46-35	179-59-59	-15.048	1028025.849312	
51-6	41226.623	-68314.874	11.966	129-17-33	140-30-58	-15.490	1058197.398260	
51-5	41219.045	-68305.613	16.512	89-31-16	140-13-43	-7.440	508193.760720	
51-134	41219.183	-68289.102	21.585	1-45-17	92-14-01	21.713	-1482761.271726	
倍面積						1127.068665		
面 積						563.5343325		

面積計算書（座標法）

世界測地系（測地成果2011）

所在	地番	公簿地目	現況地目	地積	所有者
前橋市六供町二丁目	51-21			126.53 m ²	

点名	X座標	Y座標	辺長	方向角	測角	DX	倍積 (Y×DX)
51-131	41239.823	-68258.969	0.320	91-58-08	90-11-58	-14.934	1019379.443046
51-55	41239.812	-68258.649	20.390	181-47-05	269-48-57	-20.391	1391862.111759
51-56	41219.432	-68259.284	4.279	89-28-40	87-41-35	-20.341	1388462.095844
51-128	41219.471	-68255.005	20.221	1-49-00	92-20-20	20.250	-1382163.851250
51-127	41239.682	-68254.364	1.953	271-52-40	90-03-40	20.275	-1383857.230100
51-41	41239.746	-68256.316	14.919	1-45-33	269-52-53	14.976	-1022206.588416
51-19	41254.658	-68255.858	2.651	271-54-07	90-08-34	15.000	-1023837.870000
51-132	41254.746	-68258.508	14.930	181-46-10	89-52-03	-14.835	1012614.966180
						倍面積	253.077063
						面積	126.5385315

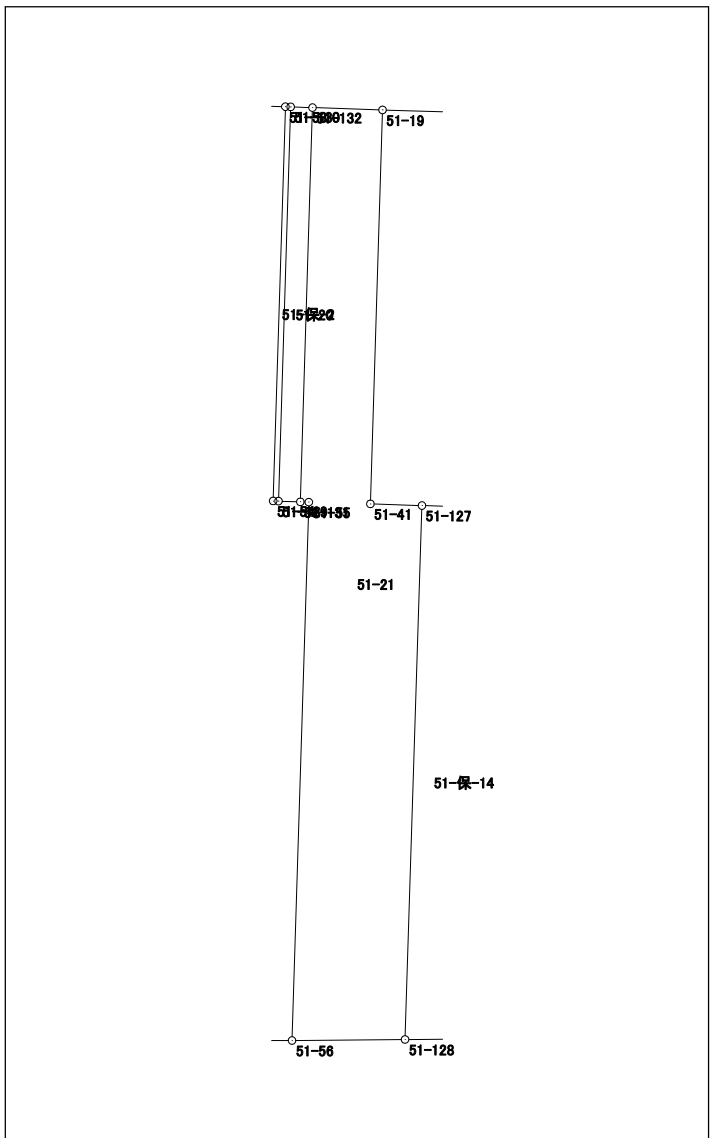


面積計算書（座標法）

世界測地系（測地成果2011）

所 在	地 番	公簿地目	現況地目	地 積	所 有 者
前橋市六供町二丁目	51-保-1			83.00 m ²	

点 名	X 座標	Y 座標	辺 長	方 向 角	測 角	DX	倍 積 (Y×DX)
51-16	41258.002	-68298.197	2.481	181-49-28	89-59-19	-2.323	158656.711631
51-106	41255.522	-68298.276	5.841	181-48-54	179-59-26	-8.318	568105.059768
51-108	41249.684	-68298.461	8.619	181-49-18	180-00-24	-14.453	987117.656833
51-37	41241.069	-68298.735	4.901	91-43-49	89-54-31	-8.763	598501.814805
51-101	41240.921	-68293.836	16.933	1-49-03	90-05-14	16.776	-1145697.392736
51-102	41257.845	-68293.299	4.901	271-50-09	90-01-06	17.081	-1166517.840219
						倍面積	166.010082
						面 積	83.0050410

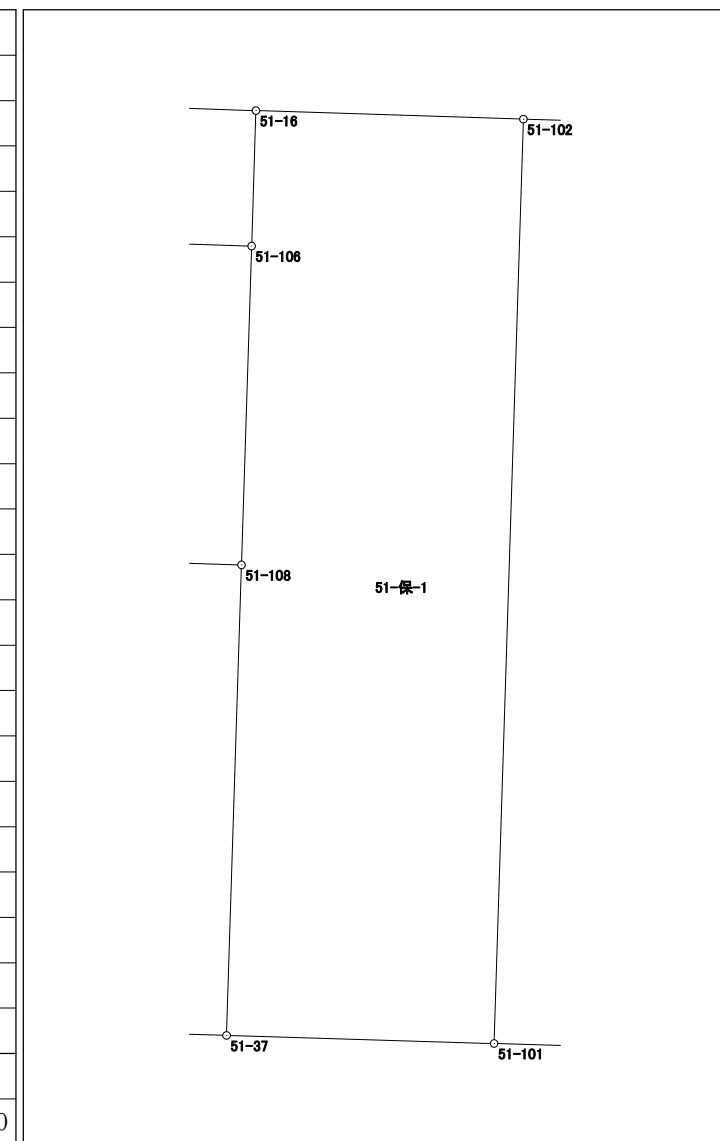


面積計算書（座標法）

世界測地系（測地成果2011）

所在	地番	公簿地目	現況地目	地積	所有者
前橋市六供町二丁目	51-保-3			77.00 m ²	

点名	X座標	Y座標	辺長	方向角	測角	DX	倍積 (Y×DX)
51-44	41242.039	-68233.957	11.947	1-46-29	179-47-07	14.935	-1019074.147795
51-20	41253.980	-68233.587	5.149	271-44-50	89-58-21	12.098	-825489.935526
51-119	41254.137	-68238.734	14.939	181-49-06	90-04-16	-14.774	1008159.056116
51-120	41239.206	-68239.208	0.127	91-48-14	89-59-08	-14.935	1019152.571480
51-121	41239.202	-68239.081	5.022	91-47-29	179-59-15	-0.161	10986.492041
51-43	41239.045	-68234.061	2.996	1-59-22	90-11-53	2.837	-193580.031057
						倍面積	154.005259
						面積	77.0026295

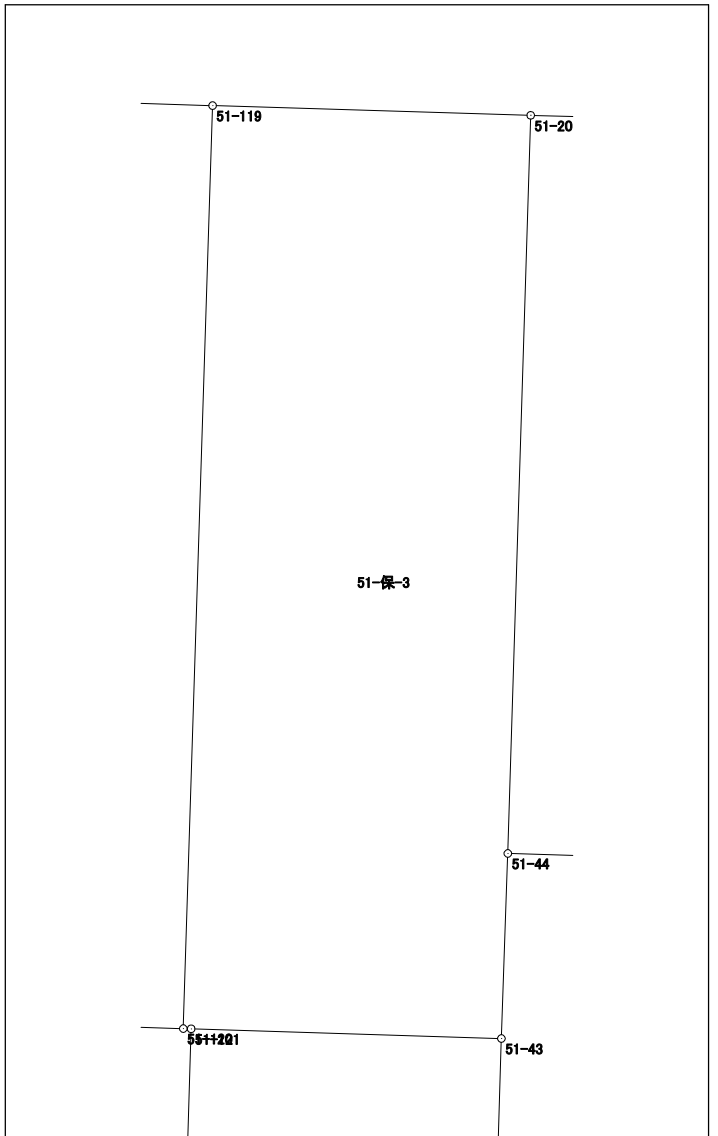


面積計算書 (座標法)

世界測地系 (測地成果2011)

所 在	地 番	公簿地目	現況地目	地 積	所 有 者
前橋市六供町二丁目	51-保-4			74.00 m ²	

点 名	X 座標	Y 座標	辺 長	方 向 角	測 角	DX	倍 積 (Y×DX)
51-45	41241.219	-68207.255	1.291	1-49-13	90-03-50	1.100	-75027.980500
51-46	41242.509	-68207.214	10.648	1-52-03	180-02-50	11.932	-813848.477448
51-21	41253.151	-68206.867	6.199	271-46-30	89-54-27	10.834	-738953.197078
51-117	41253.343	-68213.063	11.940	181-51-44	90-05-14	-11.742	800957.785746
51-118	41241.409	-68213.451	6.199	91-45-23	89-53-39	-12.124	827019.879924
						倍面積	148.010644
						面 積	74.0053220

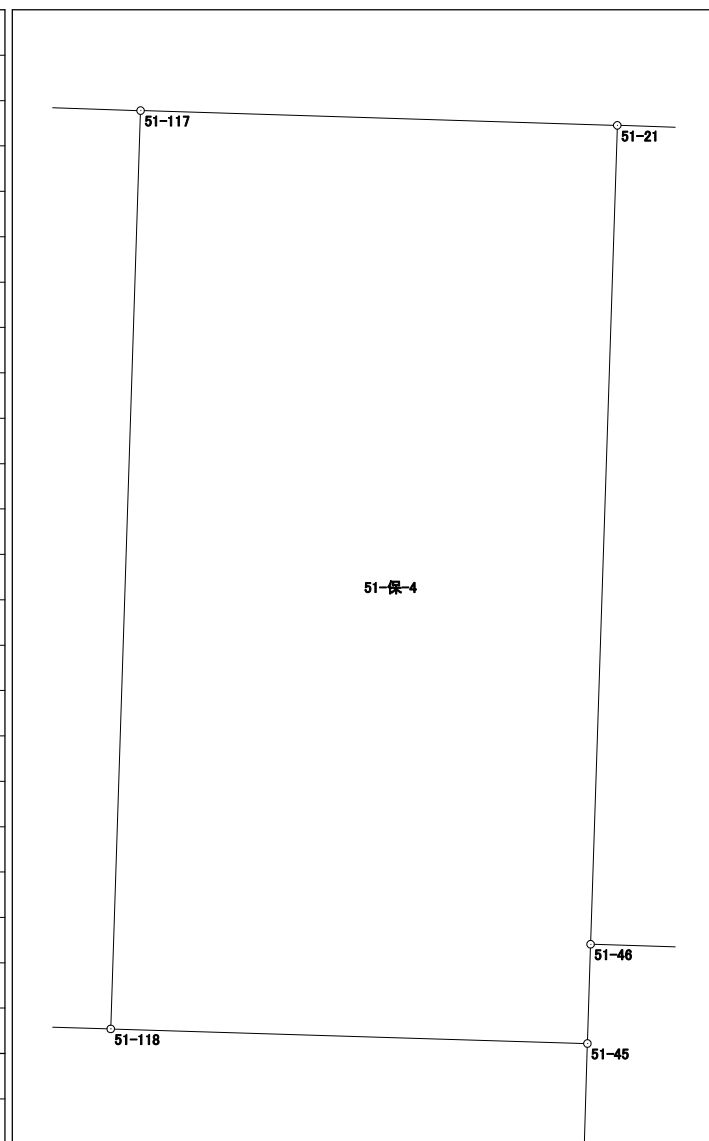


面積計算書 (座標法)

世界測地系 (測地成果2011)

所在	地番	公簿地目	現況地目	地積	所有者
前橋市六供町二丁目	51-保-6			20.00 m ²	

点名	X座標	Y座標	辺長	方向角	測角	DX	倍積 (Y×DX)
51-45	41241.219	-68207.255	8.651	181-48-30	179-59-17	-9.937	677775.492935
51-48	41232.572	-68207.528	2.012	91-44-15	89-55-45	-8.708	593951.153824
51-115	41232.511	-68205.517	9.940	1-48-37	90-04-22	9.874	-673461.274858
51-116	41242.446	-68205.203	2.012	271-47-40	89-59-03	9.998	-681915.619594
51-46	41242.509	-68207.214	1.291	181-49-13	90-01-33	-1.227	83690.251578
						倍面積	40.003885
						面積	20.0019425

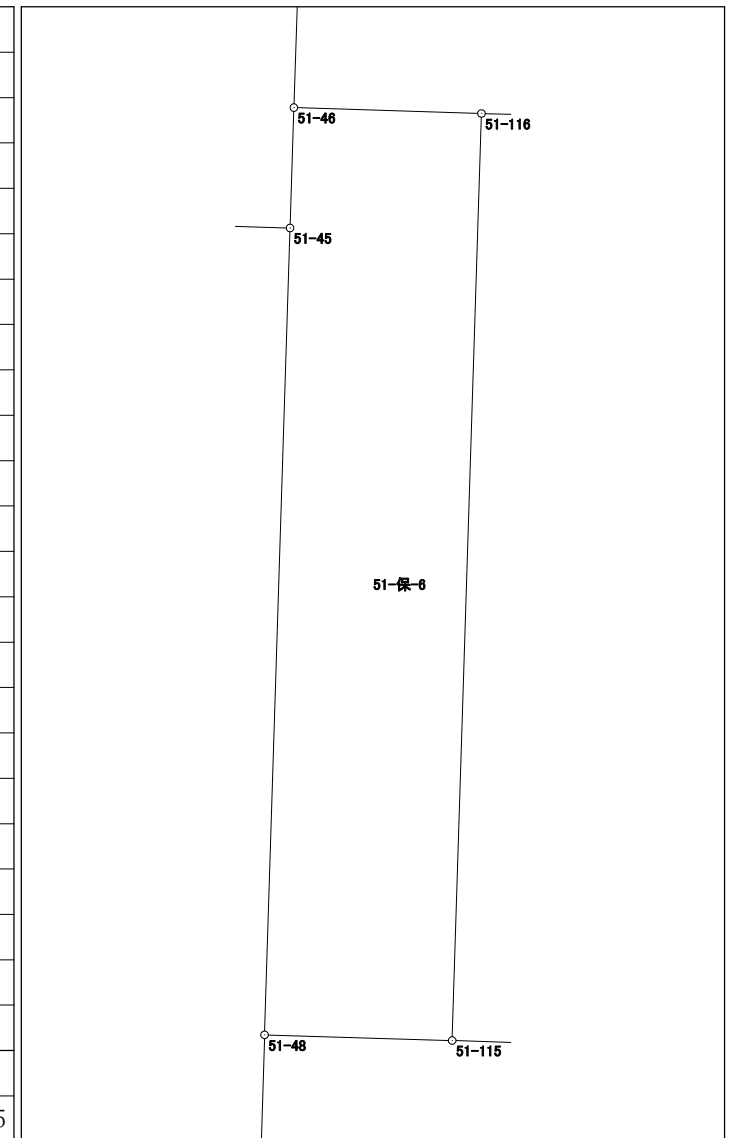


面積計算書（座標法）

世界測地系（測地成果2011）

所 在	地 番	公簿地目	現況地目	地 積	所 有 者
前橋市六供町二丁目	51-保-8			39.00 m ²	

点 名	X 座標	Y 座標	辺 長	方 向 角	測 角	DX	倍 積 (Y×DX)
51-50	41240.407	-68189.287	2.706	181-55-39	90-09-32	-2.263	154312.356481
51-111	41237.703	-68189.378	14.545	91-45-54	89-50-15	-3.152	214932.919456
51-112	41237.255	-68174.840	2.716	356-32-17	84-46-23	2.263	-154279.662920
51-24	41239.966	-68175.004	14.290	271-46-07	95-13-50	3.152	-214887.612608
						倍面積	78.000409
						面 積	39.0002045

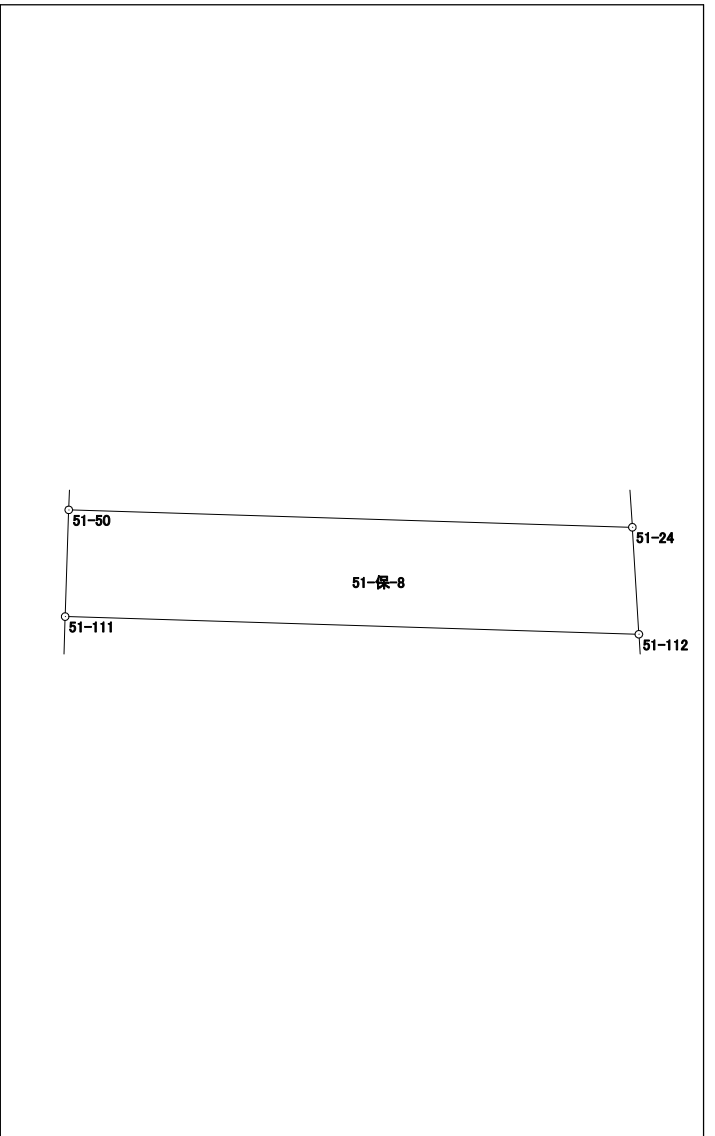


面積計算書（座標法）

世界測地系（測地成果2011）

所 在	地 番	公簿地目	現況地目	地 積	所 有 者
前橋市六供町二丁目	51-保-11			98.00 m ²	

点 名	X 座標	Y 座標	辺 長	方 向 角	測 角	DX	倍 積 (Y×DX)
51-29	41219.642	-68234.662	19.412	1-46-27	92-15-10	19.445	-1326823.002590
51-43	41239.045	-68234.061	5.022	271-47-29	90-01-02	19.560	-1334658.233160
51-121	41239.202	-68239.081	19.611	181-46-36	89-59-07	-19.445	1326908.930045
51-122	41219.600	-68239.689	5.027	89-31-17	87-44-41	-19.560	1334768.316840
						倍面積	196.011135
						面 積	98.0055675

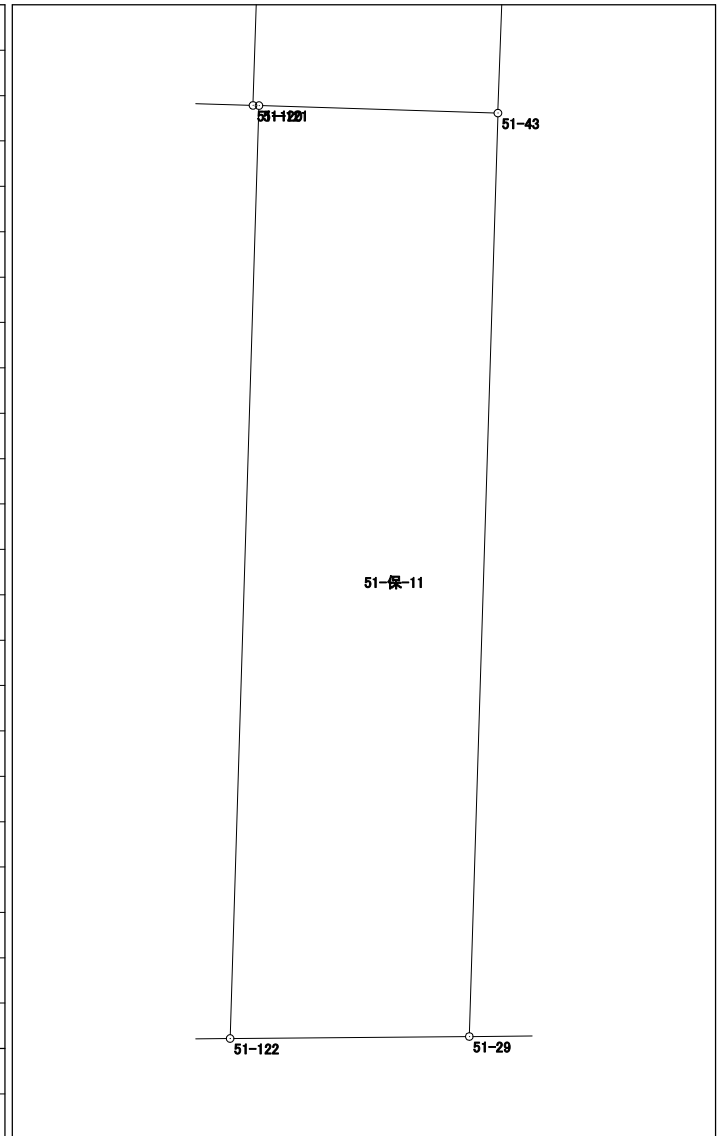


面積計算書（座標法）

世界測地系（測地成果2011）

所 在	地 番	公簿地目	現況地目	地 積	所 有 者
前橋市六供町二丁目	51-保-13			113.00 m ²	

点 名	X 座 標	Y 座 標	辺 長	方 向 角	測 角	DX	倍 積 (Y×DX)
51-31	41219.227	-68283.838	21.381	1-45-20	92-14-04	21.415	-1462298.390770
51-39	41240.598	-68283.183	5.260	271-44-35	89-59-15	21.531	-1470205.213173
51-133	41240.758	-68288.441	21.585	181-45-17	90-00-42	-21.415	1462396.964015
51-134	41219.183	-68289.102	5.264	89-31-16	87-45-59	-21.531	1470332.655162

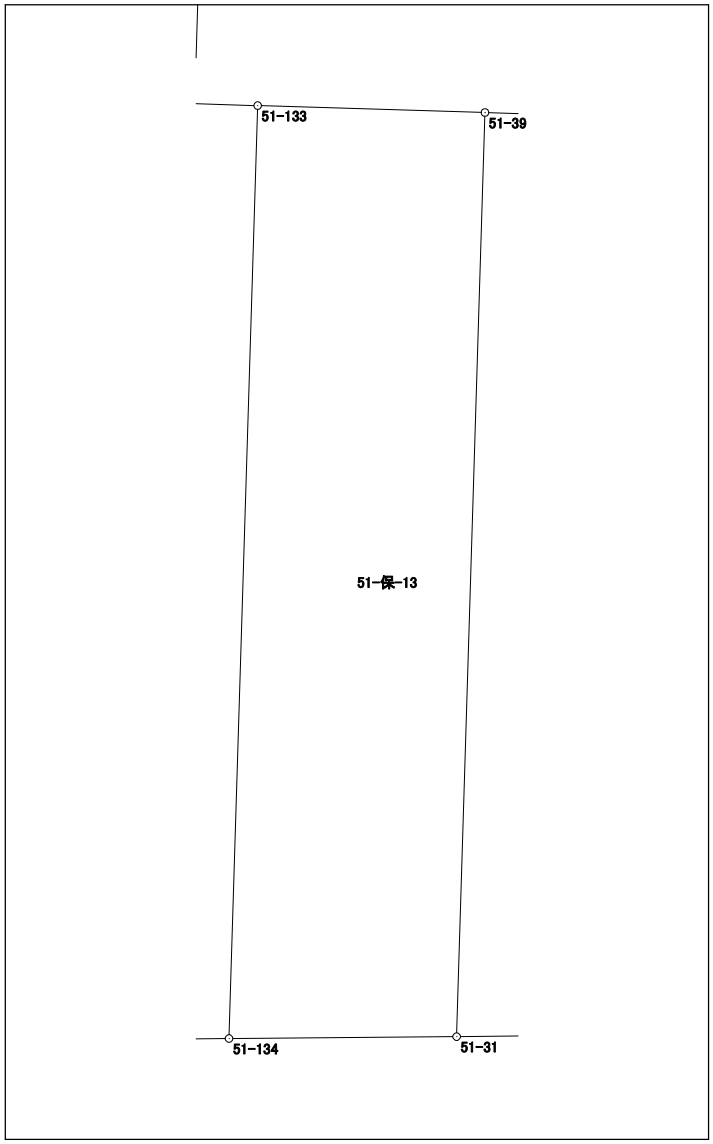


倍面積	226.015234
面 積	113.0076170

面積計算書（座標法）

世界測地系（測地成果2011）

所 在	地 番	公簿地目	現況地目	地 積	所 有 者
前橋市六供町二丁目	51-保-14			31.00 m ²	

点 名	X 座標	Y 座標	辺 長	方 向 角	測 角	DX	倍 積 (Y×DX)
51-30	41219.485	-68253.468	20.157	1-49-00	92-20-19	20.161	-1376058.168348
51-42	41239.632	-68252.829	1.536	271-51-56	90-02-56	20.197	-1378502.387313
51-127	41239.682	-68254.364	20.221	181-49-00	89-57-04	-20.161	1376076.232604
51-128	41219.471	-68255.005	1.537	89-28-41	87-39-41	-20.197	1378546.335985

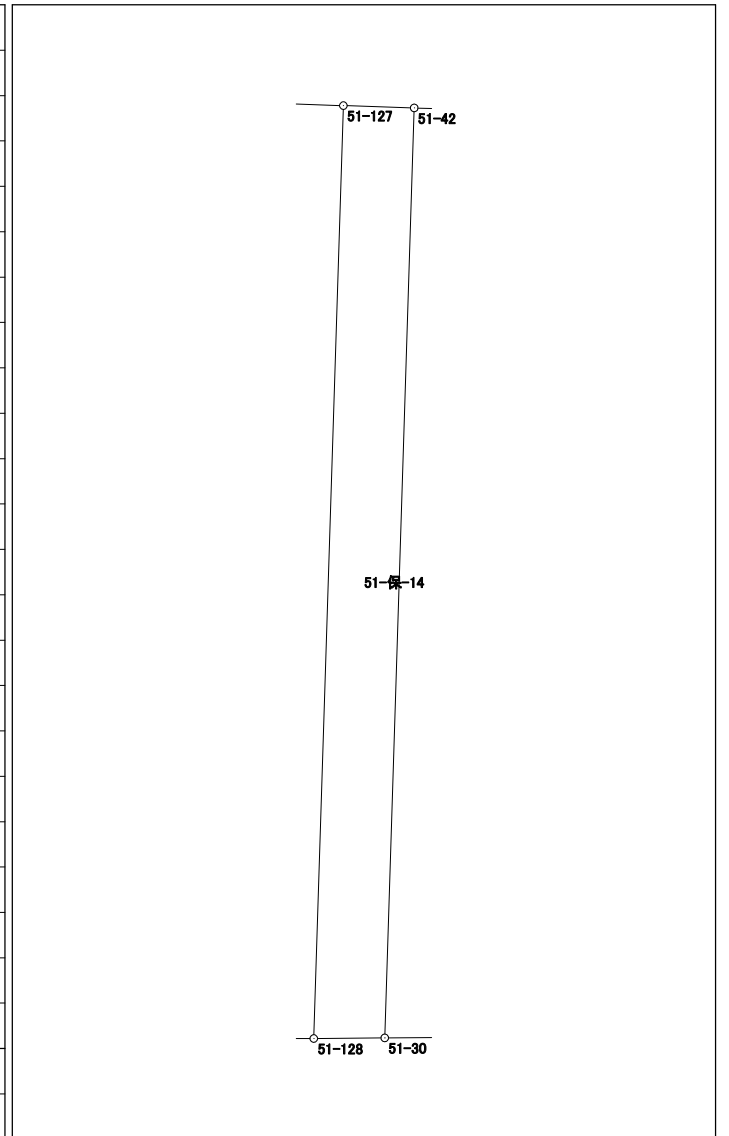

倍面積	62.012928
面 積	31.0064640