



# 5 2 街区 画地出来形確認図 (3054.84m<sup>2</sup>)

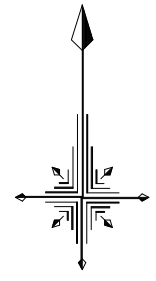

S=1/500

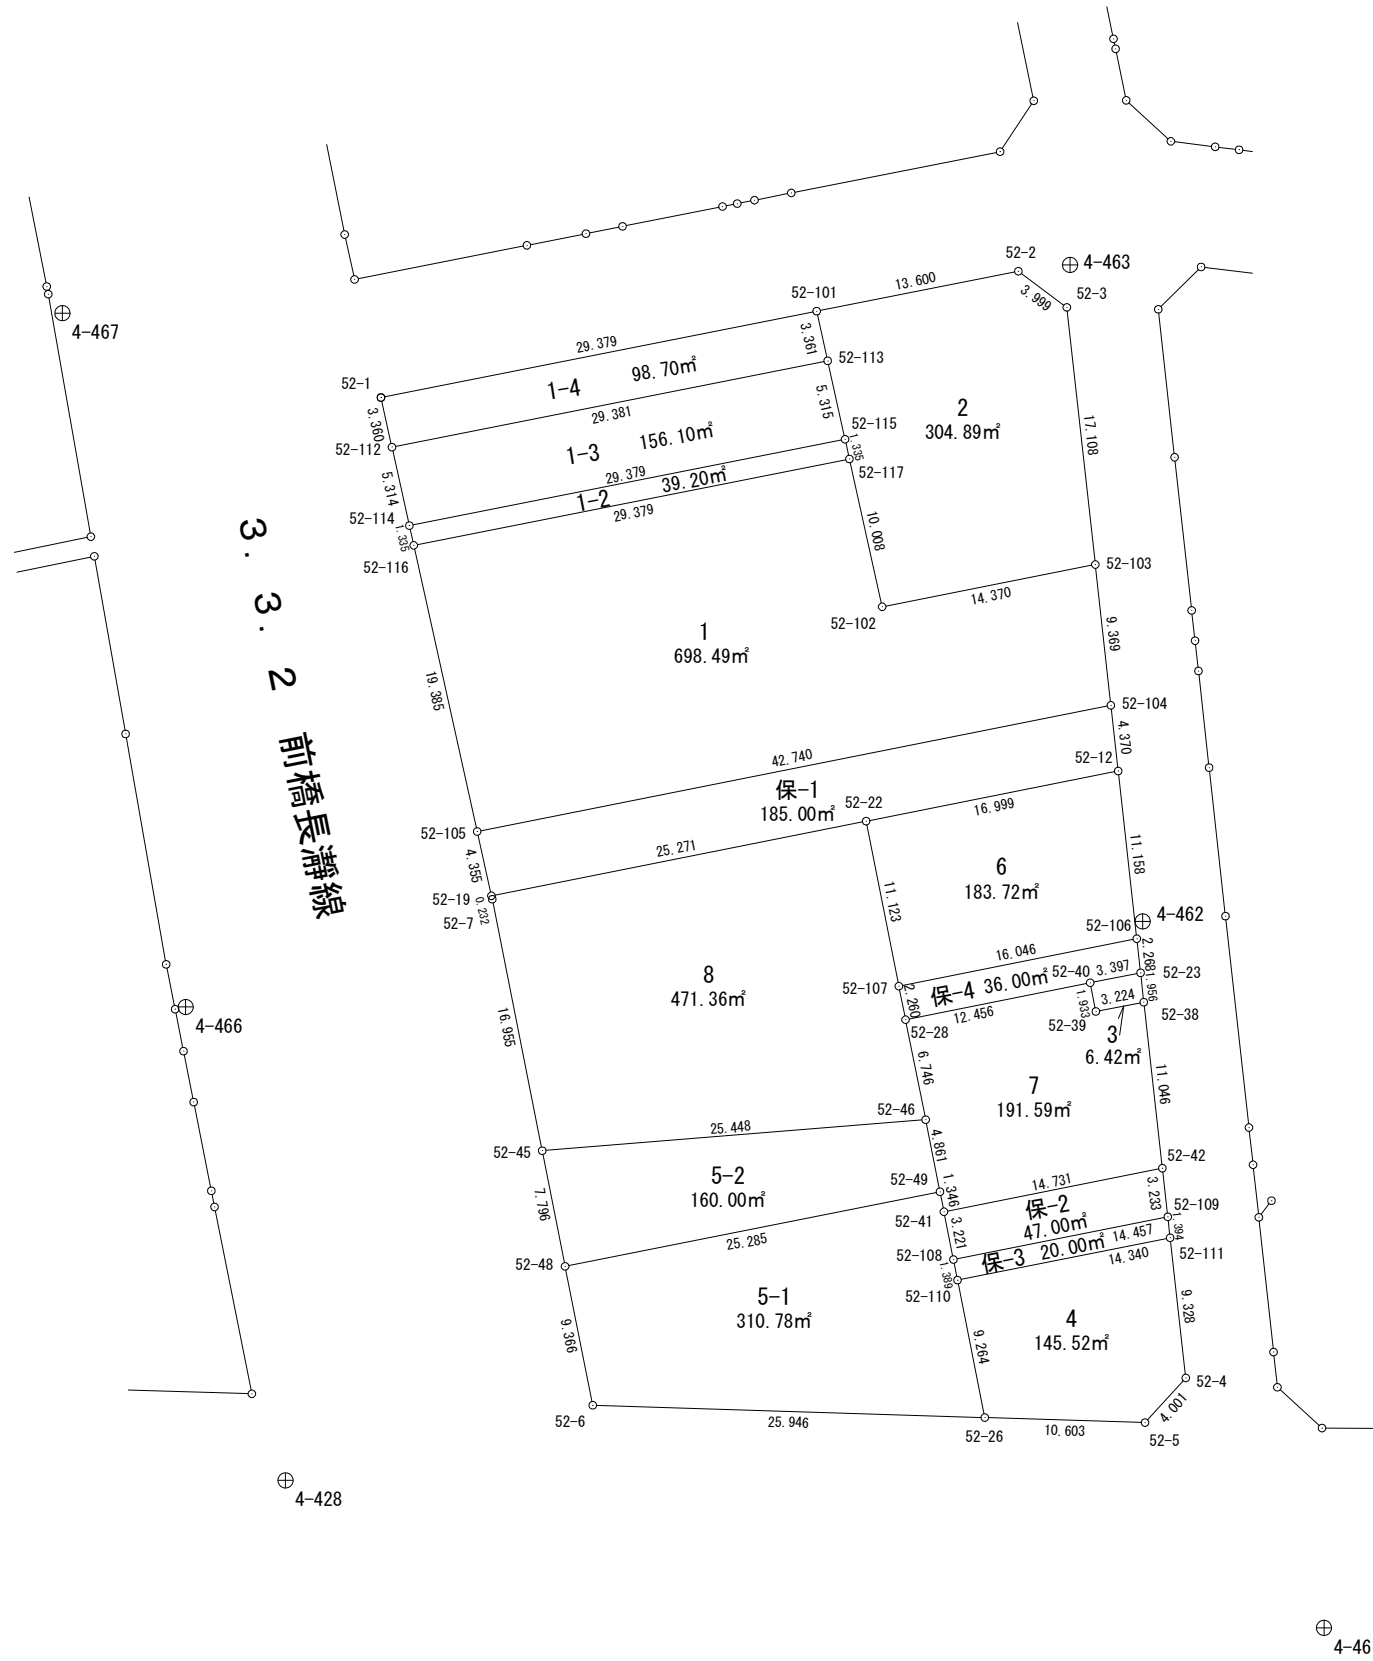


# 面積計算書（座標法）

世界測地系（測地成果2011）

所在	地番	公簿地目	現況地目	地積	所有者
前橋市六供町二丁目	52-1-1			698.49 m <sup>2</sup>	

点名	X座標	Y座標	辺長	方向角	測角	DX	倍積(Y×DX)
52-116	41332.690	-68336.462	19.385	167-29-56	88-42-14	-24.634	1683400.404908
52-105	41313.765	-68332.266	42.740	78-44-36	91-14-40	-10.582	723092.038812
52-104	41322.108	-68290.348	9.369	353-40-34	94-55-58	17.655	-1205666.093940
52-103	41331.420	-68291.380	14.370	258-47-47	85-07-13	6.520	-445259.797600
52-102	41328.628	-68305.476	10.008	347-29-43	268-41-56	6.979	-476703.917004
52-117	41338.399	-68307.643	29.379	258-47-42	91-17-59	4.062	-277465.645866

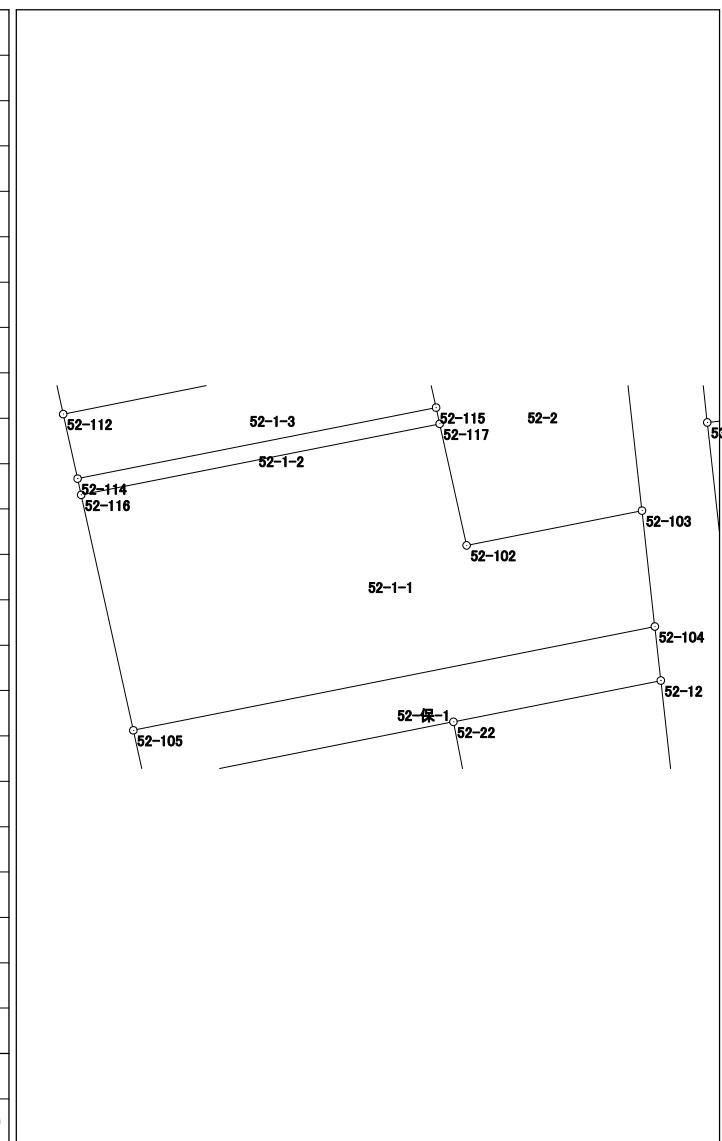


倍面積	1396.989310
面積	698.4946550

# 面積計算書（座標法）

世界測地系（測地成果2011）

所 在	地 番	公簿地目	現況地目	地 積	所 有 者
前橋市六供町二丁目	52-1-2			39.20 m <sup>2</sup>	

点 名	X 座標	Y 座標	辺 長	方 向 角	測 角	DX	倍 積 (Y×DX)
52-114	41333.993	-68336.751	1.335	167-29-40	88-41-58	-7.012	479177.298012
52-116	41332.690	-68336.462	29.379	78-47-42	91-18-02	4.406	-301090.451572
52-117	41338.399	-68307.643	1.335	347-29-40	88-41-58	7.012	-478973.192716
52-115	41339.702	-68307.932	29.379	258-47-42	91-18-02	-4.406	300964.748392
						倍面積	78.402116
						面 積	39.2010580

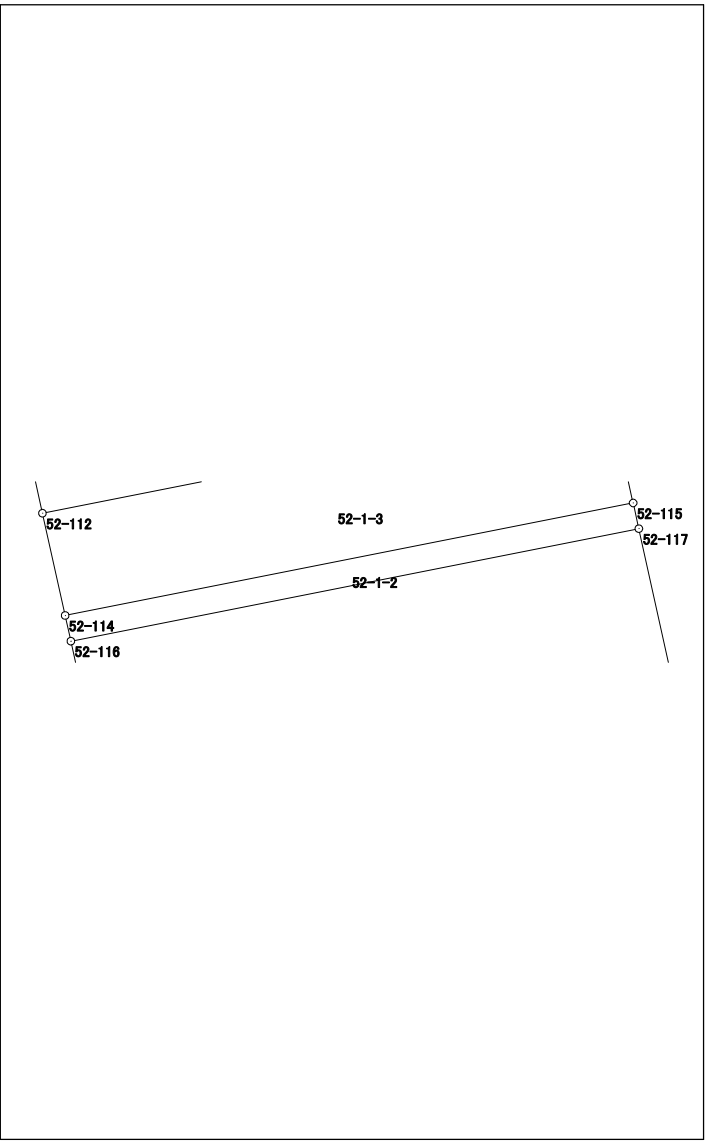


# 面積計算書（座標法）

世界測地系（測地成果2011）

所在	地番	公簿地目	現況地目	地積	所有者
前橋市六供町二丁目	52-1-3			156.10 m <sup>2</sup>	

点名	X座標	Y座標	辺長	方向角	測角	Dx	倍積(Y×Dx)
52-112	41339.181	-68337.903	5.314	167-28-50	88-41-13	-10.898	744746.466894
52-114	41333.993	-68336.751	29.379	78-47-42	91-18-52	0.521	-35603.447271
52-115	41339.702	-68307.932	5.315	347-30-14	88-42-32	10.898	-744419.842936
52-113	41344.891	-68309.082	29.381	258-47-37	91-17-23	-0.521	35589.031722

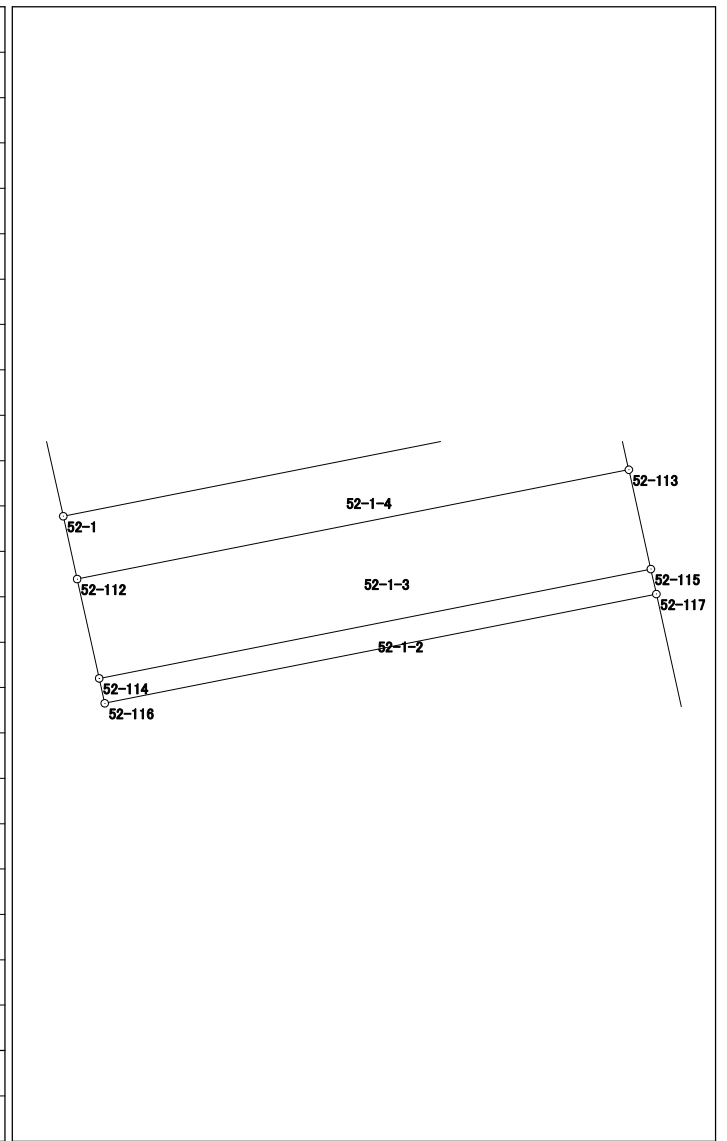


倍面積	312.208409
面積	156.1042045

## 面積計算書 (座標法)

世界測地系 (測地成果2011)

所 在	地 番	公簿地目	現況地目	地 積	所 有 者
前橋市六供町二丁目	52-1-4			98.70 m <sup>2</sup>	

点 名	X 座標	Y 座標	辺 長	方 向 角	測 角	DX	倍 積 (Y×DX)
52-1	41342.462	-68338.629	3.360	167-31-23	88-43-48	-8.991	614432.613339
52-112	41339.181	-68337.903	29.381	78-47-37	91-16-14	2.429	-165992.766387
52-113	41344.891	-68309.082	3.361	347-29-23	88-41-46	8.991	-614166.956262
52-101	41348.172	-68309.810	29.379	258-47-35	91-18-12	-2.429	165924.528490

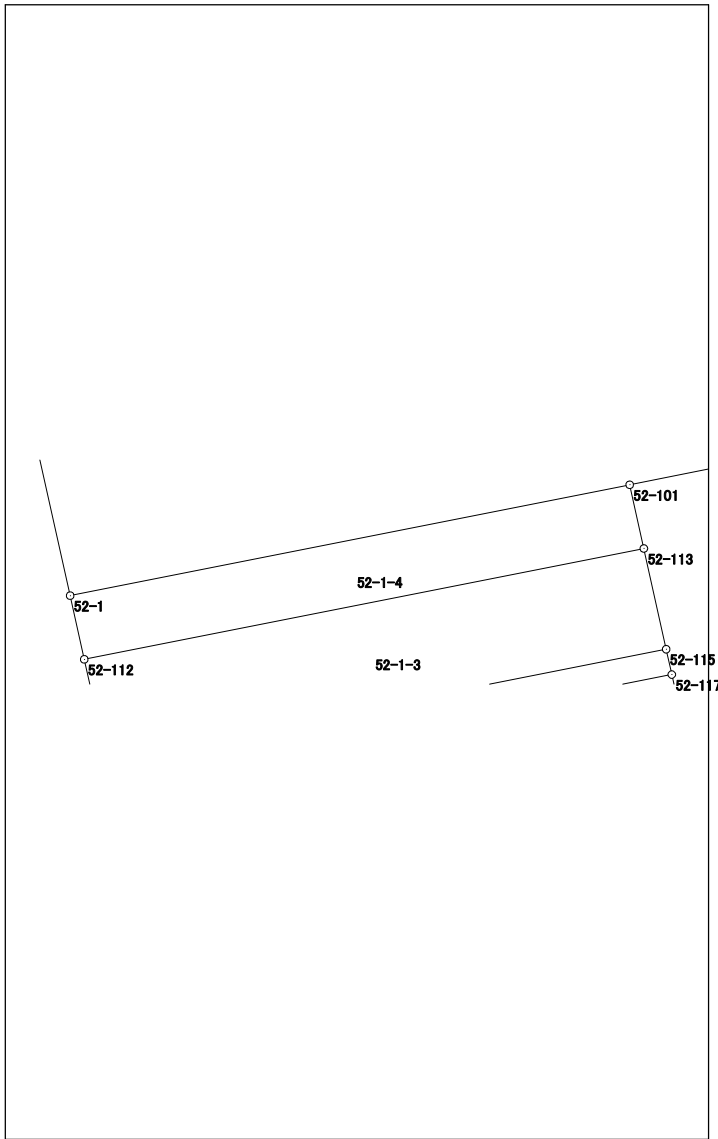


倍面積	197.419180
面 積	98.7095900

# 面積計算書（座標法）

世界測地系（測地成果2011）

所在	地番	公簿地目	現況地目	地積	所有者
前橋市六供町二丁目	52-2			304.89 m <sup>2</sup>	

点名	X座標	Y座標	辺長	方向角	測角	DX	倍積 (Y×DX)
52-2	41350.815	-68296.469	13.600	258-47-39	132-04-14	-0.252	17210.710188
52-101	41348.172	-68309.810	3.361	167-29-23	88-41-44	-5.924	404667.314440
52-113	41344.891	-68309.082	5.315	167-30-14	180-00-51	-8.470	578577.924540
52-115	41339.702	-68307.932	1.335	167-29-40	179-59-26	-6.492	443455.094544
52-117	41338.399	-68307.643	10.008	167-29-43	180-00-03	-11.074	756438.838582
52-102	41328.628	-68305.476	14.370	78-47-47	91-18-04	-6.979	476703.917004
52-103	41331.420	-68291.380	17.108	353-40-39	94-52-52	19.796	-1351896.158480
52-3	41348.424	-68293.264	3.999	306-43-25	133-02-46	19.395	-1324547.855280
						倍面積	609.785538
						面積	304.8927690

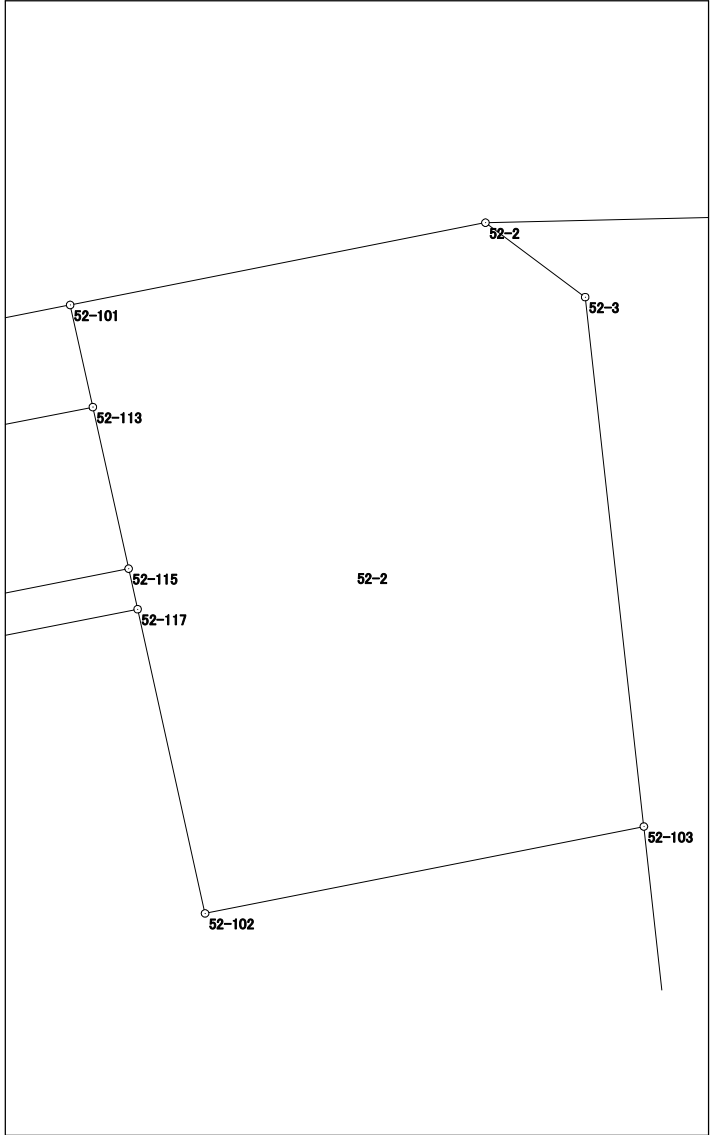


# 面積計算書 (座標法)

世界測地系 (測地成果2011)

所在	地番	公簿地目	現況地目	地積	所有者
前橋市六供町二丁目	52-3			6.42 m <sup>2</sup>	

点名	X座標	Y座標	辺長	方向角	測角	DX	倍積 (Y×DX)
52-40	41303.762	-68291.718	1.933	168-46-59	89-58-14	-2.555	174485.339490
52-39	41301.866	-68291.342	3.224	79-05-40	90-18-41	-1.286	87822.665812
52-38	41302.476	-68288.176	1.956	353-50-16	94-44-36	2.555	-174476.289680
52-23	41304.421	-68288.386	3.397	258-48-45	84-58-29	1.286	-87818.864396

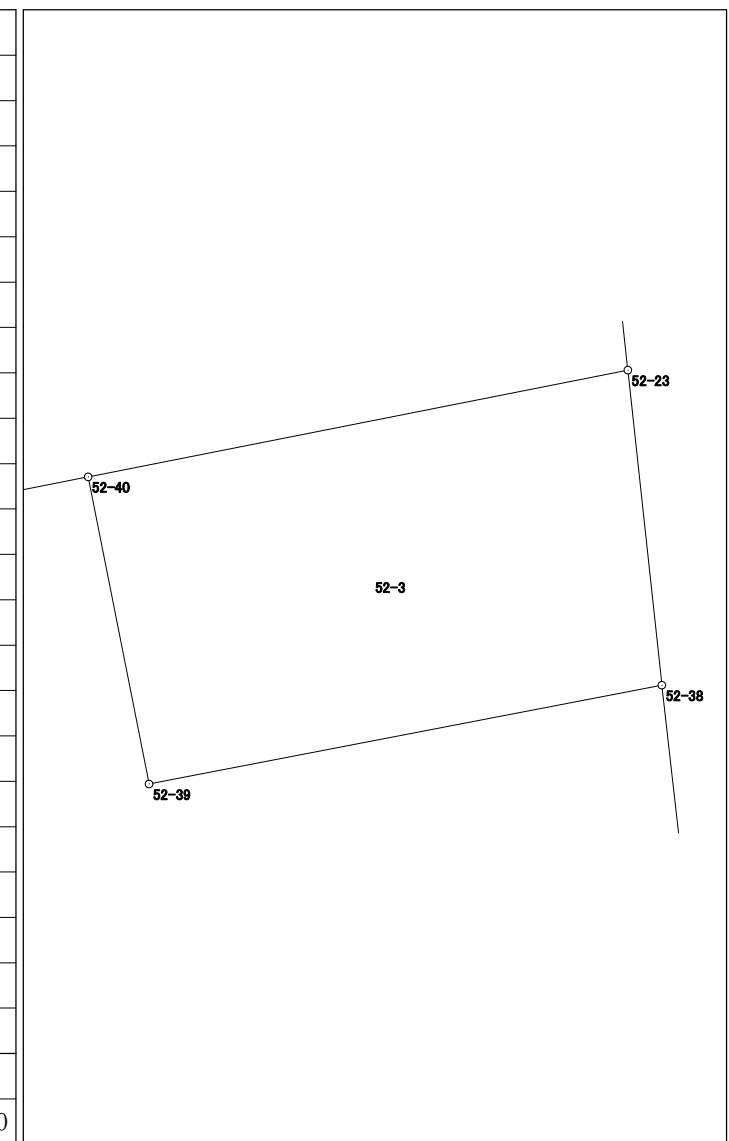


倍面積	12.851226
面積	6.4256130

# 面積計算書（座標法）

世界測地系（測地成果2011）

所在	地番	公簿地目	現況地目	地積	所有者
前橋市六供町二丁目	52-4			145.52 m <sup>2</sup>	

点名	X座標	Y座標	辺長	方向角	測角	D <sub>X</sub>	倍積 (Y×D <sub>X</sub> )
52-110	41284.099	-68300.494	9.264	168-46-17	90-02-20	-11.889	812024.573166
52-26	41275.012	-68298.690	10.603	91-48-57	103-02-40	-9.423	643578.555870
52-5	41274.676	-68288.092	4.001	42-23-49	130-34-52	2.619	-178846.512948
52-4	41277.631	-68285.394	9.328	353-37-23	131-13-34	12.225	-834788.941650
52-111	41286.901	-68286.430	14.340	258-43-57	85-06-34	6.468	-441676.629240

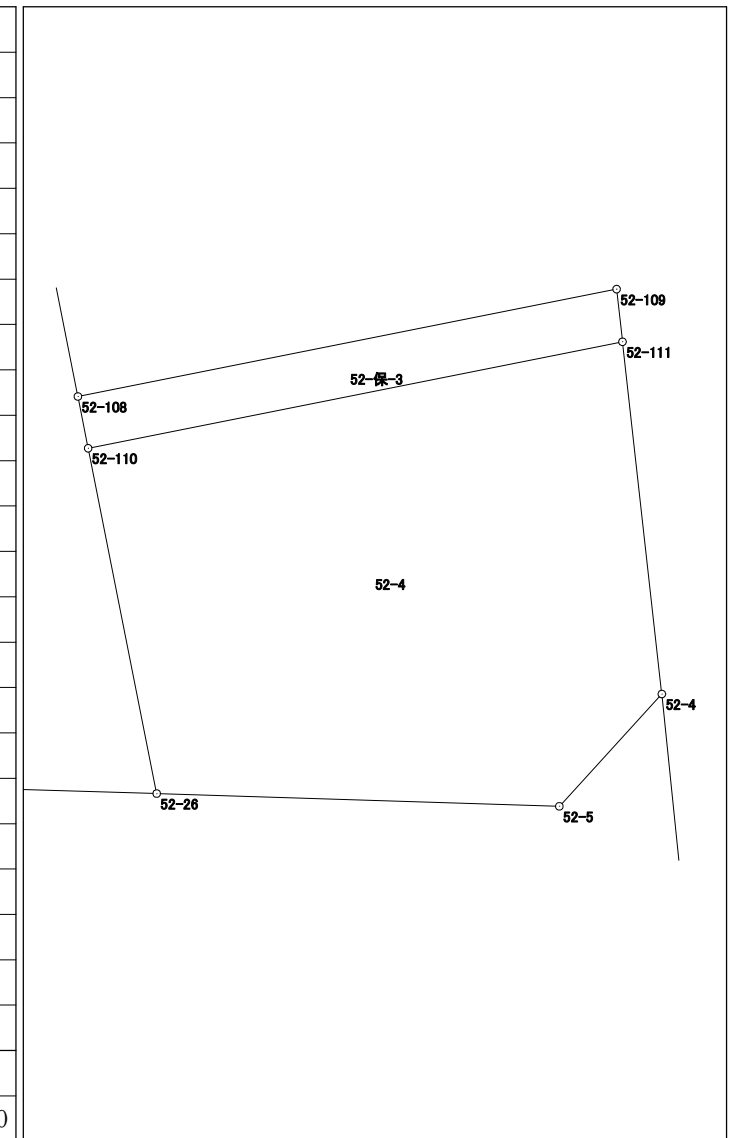

倍面積	291.045198
面積	145.5225990






# 面積計算書 (座標法)

世界測地系 (測地成果2011)

所在	地番	公簿地目	現況地目	地積	所有者
前橋市六供町二丁目	52-5-2			160.00 m <sup>2</sup>	

点名	X座標	Y座標	辺長	方向角	測角	DX	倍積 (Y×DX)
52-45	41292.657	-68327.965	7.796	168-48-35	83-26-05	-9.700	662781.260500
52-48	41285.009	-68326.452	25.285	78-45-07	89-56-32	-2.716	185574.643632
52-49	41289.941	-68301.653	4.861	348-45-59	90-00-52	9.700	-662526.034100
52-46	41294.709	-68302.600	25.448	265-22-30	96-36-31	2.716	-185509.861600

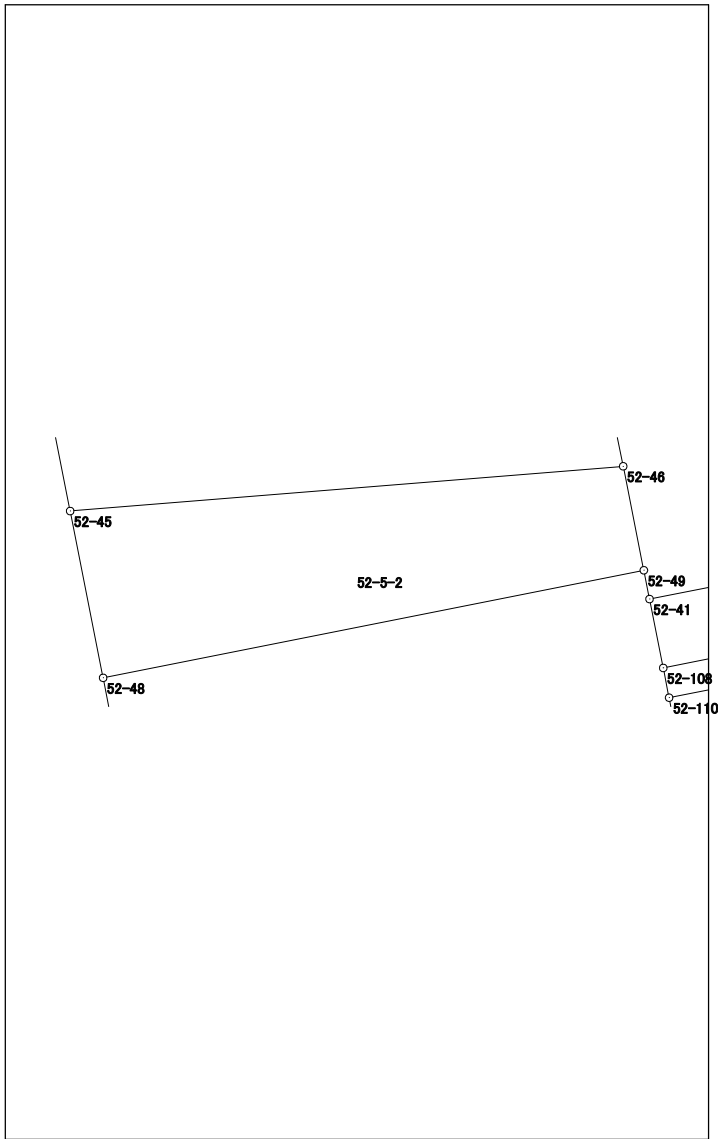

倍面積	320.008432
面積	160.0042160






# 面積計算書 (座標法)

世界測地系 (測地成果2011)

所 在	地 番	公簿地目	現況地目	地 積	所 有 者
前橋市六供町二丁目	52-8			471.36 m <sup>2</sup>	

点 名	X 座標	Y 座標	辺 長	方 向 角	測 角	DX	倍 積 (Y×DX)
52-19	41309.513	-68331.323	0.232	166-48-07	88-03-56	-5.162	352726.289326
52-7	41309.287	-68331.270	16.955	168-45-35	181-57-28	-16.856	1151791.887120
52-45	41292.657	-68327.965	25.448	85-22-30	96-36-55	-14.578	996085.073770
52-46	41294.709	-68302.600	6.746	348-36-12	83-13-42	8.665	-591842.029000
52-28	41301.322	-68303.933	2.260	348-46-28	180-10-16	8.830	-603123.728390
52-107	41303.539	-68304.373	11.123	348-46-15	179-59-47	13.127	-896631.504371
52-22	41314.449	-68306.539	25.271	258-44-11	89-57-56	5.974	-408063.263986
倍面積						942.724469	
面 積						471.3622345	

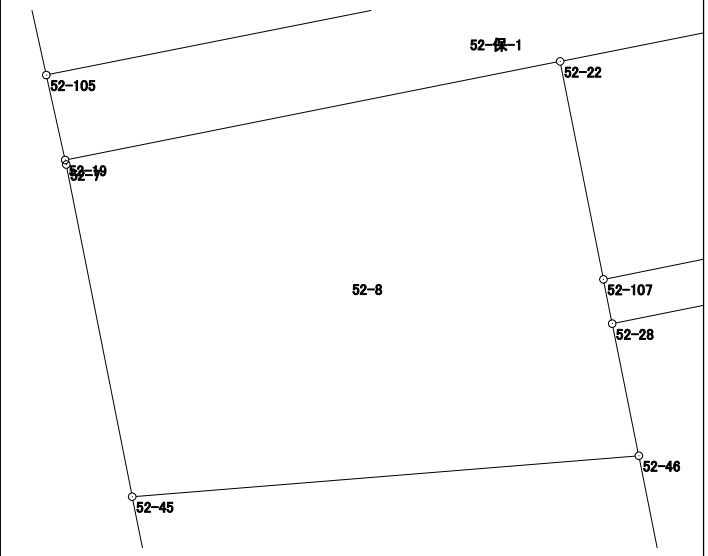


# 面積計算書（座標法）

世界測地系（測地成果2011）

所在	地番	公簿地目	現況地目	地積	所有者
前橋市六供町二丁目	52-保-1			185.00 m <sup>2</sup>	

点名	X座標	Y座標	辺長	方向角	測角	DX	倍積 (Y×DX)
52-19	41309.513	-68331.323	25.271	78-44-11	91-14-27	0.684	-46738.624932
52-22	41314.449	-68306.539	16.999	78-45-03	180-00-52	8.252	-563665.559828
52-12	41317.765	-68289.867	4.370	353-40-48	94-55-45	7.659	-523032.091353
52-104	41322.108	-68290.348	42.740	258-44-36	85-03-48	-4.000	273161.392000
52-105	41313.765	-68332.266	4.355	167-29-44	88-45-08	-12.595	860644.890270

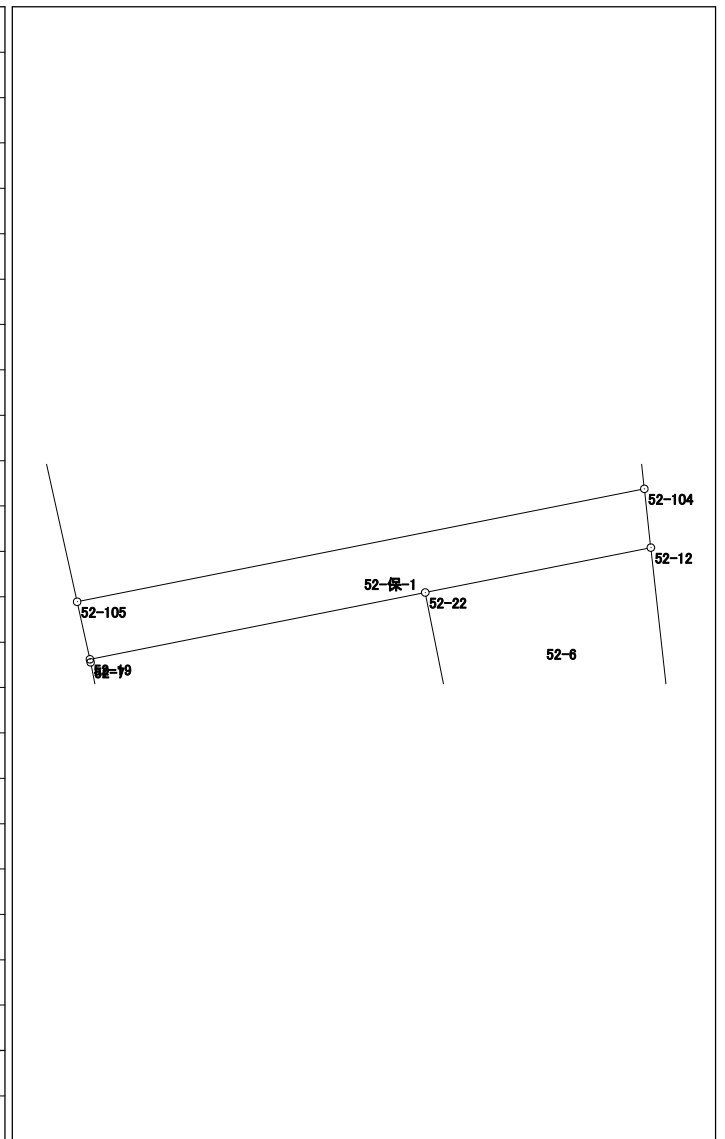

倍面積	370.006157
面積	185.0030785

# 面積計算書（座標法）

世界測地系（測地成果2011）

所 在	地 番	公簿地目	現況地目	地 積	所 有 者
前橋市六供町二丁目	52-保-2			47.00 m <sup>2</sup>	

点 名	X 座標	Y 座標	辺 長	方 向 角	測 角	DX	倍 積 (Y×DX)	
52-41	41288.621	-68301.391	3.221	168-46-26	90-02-25	-6.037	412335.497467	
52-108	41285.462	-68300.764	14.457	78-44-09	89-57-43	-0.335	22880.755940	
52-109	41288.286	-68286.585	3.233	353-37-28	94-53-19	6.037	-412246.113645	
52-42	41291.499	-68286.944	14.731	258-44-01	85-06-33	0.335	-22876.126240	
						倍面積	94.013522	
						面 積	47.0067610	






# 面積計算書 (座標法)

世界測地系 (測地成果2011)

所 在	地 番	公簿地目	現況地目	地 積	所 有 者
前橋市六供町二丁目	52-保-4			36.00 m <sup>2</sup>	

点 名	X 座標	Y 座標	辺 長	方 向 角	測 角	DX	倍 積 (Y×DX)
52-28	41301.322	-68303.933	12.456	78-42-13	89-55-45	0.223	-15231.777059
52-40	41303.762	-68291.718	3.397	78-48-45	180-06-32	3.099	-211636.034082
52-23	41304.421	-68288.386	2.268	353-40-15	94-51-30	2.913	-198924.068418
52-106	41306.675	-68288.636	16.046	258-43-48	85-03-33	-0.882	60230.576952
52-107	41303.539	-68304.373	2.260	168-46-28	90-02-40	-5.353	365633.308669

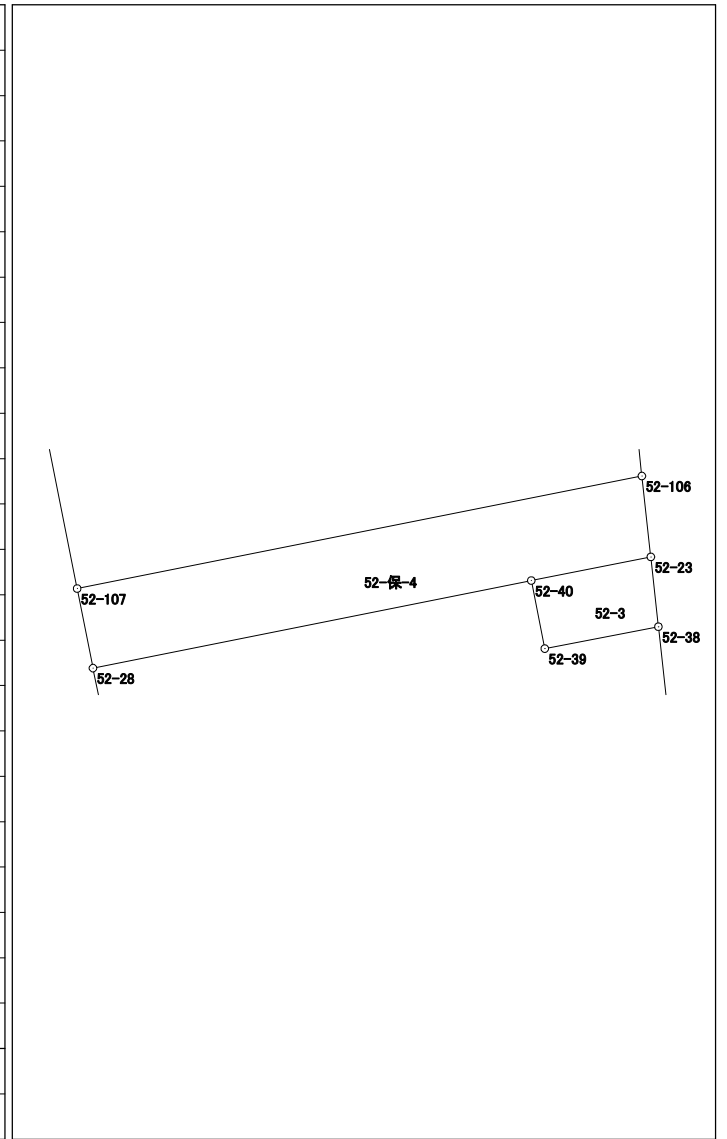

倍面積	72.006062
面 積	36.0030310