


53街区 画地出来形確認図 (4715.83m²)



S=1/500

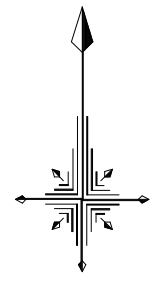

4-461

4-460


4-459

面積計算書 (座標法)

世界測地系 (測地成果2011)

所在	地番	公簿地目	現況地目	地積	所有者
前橋市六供町二丁目	53-1-1			230.46 m ²	

点名	X座標	Y座標	辺長	方向角	測角	DX	倍積 (Y×DX)
53-12	41347.806	-68257.925	16.058	176-33-43	79-27-56	-14.043	958546.040775
53-23	41331.777	-68256.962	15.805	86-30-38	89-56-55	-15.067	1028427.646454
53-57	41332.739	-68241.186	13.105	356-33-41	90-03-03	14.043	-958310.974998
53-56	41345.820	-68241.972	16.076	277-05-47	100-32-06	15.067	-1028201.792124
						倍面積	460.920107
						面積	230.4600535

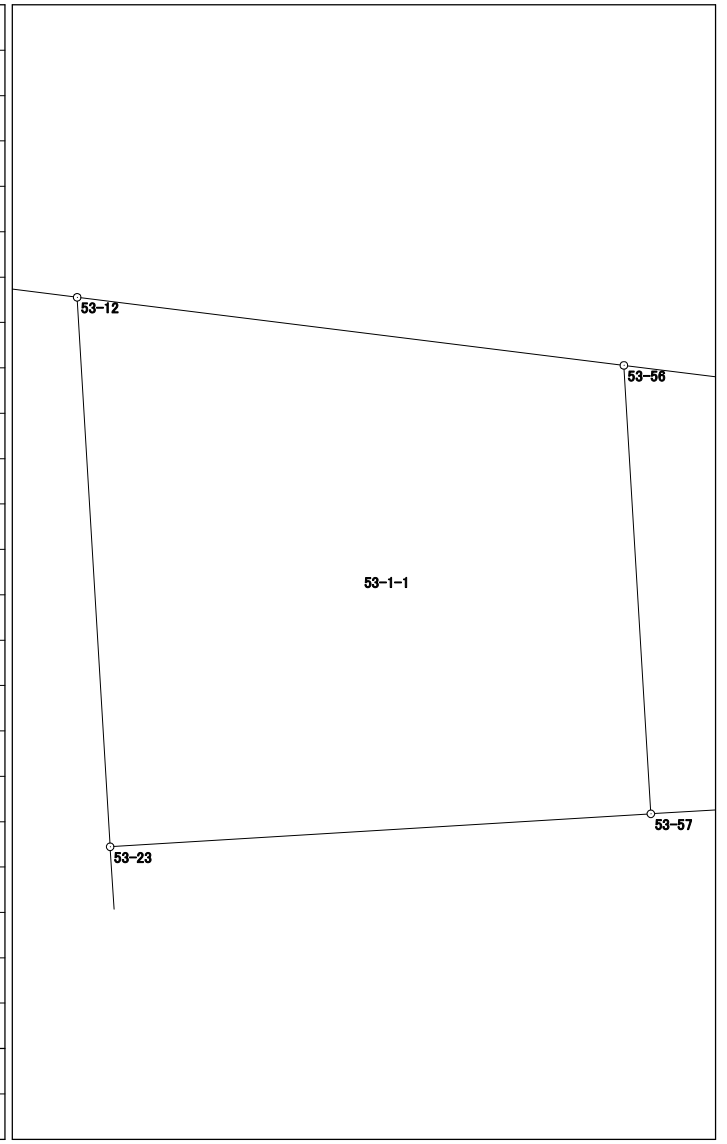

面積計算書 (座標法)

世界測地系 (測地成果2011)

所 在	地 番	公簿地目	現況地目	地 積	所 有 者
前橋市六供町二丁目	53-1-2			230.36 m ²	


点 名	X 座標	Y 座標	辺 長	方 向 角	測 角	DX	倍 積 (Y×DX)	
53-56	41345.820	-68241.972	13.105	176-33-41	79-29-58	-10.783	735853.184076	
53-57	41332.739	-68241.186	20.955	86-30-42	89-57-01	-11.806	805655.441916	
53-24	41334.014	-68220.270	6.605	356-32-12	90-01-30	7.868	-536757.084360	
53-4	41340.607	-68220.669	4.010	316-38-14	140-06-02	9.508	-648642.120852	
53-3	41343.522	-68223.422	18.692	277-03-43	140-25-29	5.213	-355648.698886	
							倍面積	
							面 積	230.3609470

面積計算書（座標法）

世界測地系（測地成果2011）

所在	地番	公簿地目	現況地目	地積	所有者
前橋市六供町二丁目	53-2			740.01 m ²	

点名	X 座標	Y 座標	辺長	方向角	測角	DX	倍積 (Y×DX)
53-23	41331.777	-68256.962	4.343	176-24-32	89-53-54	-5.296	361488.870752
53-17	41327.443	-68256.690	6.437	176-31-35	180-07-03	-10.759	734373.727710
53-112	41321.018	-68256.300	9.360	176-32-00	180-00-25	-15.768	1076265.338400
53-30	41311.675	-68255.734	36.743	86-30-18	89-58-18	-7.103	484820.478602
53-29	41313.915	-68219.059	20.135	356-33-07	90-02-49	22.339	-1523945.559001
53-24	41334.014	-68220.270	20.955	266-30-42	89-57-35	18.824	-1284178.362480
53-57	41332.739	-68241.186	15.805	266-30-38	179-59-56	-2.237	152655.533082

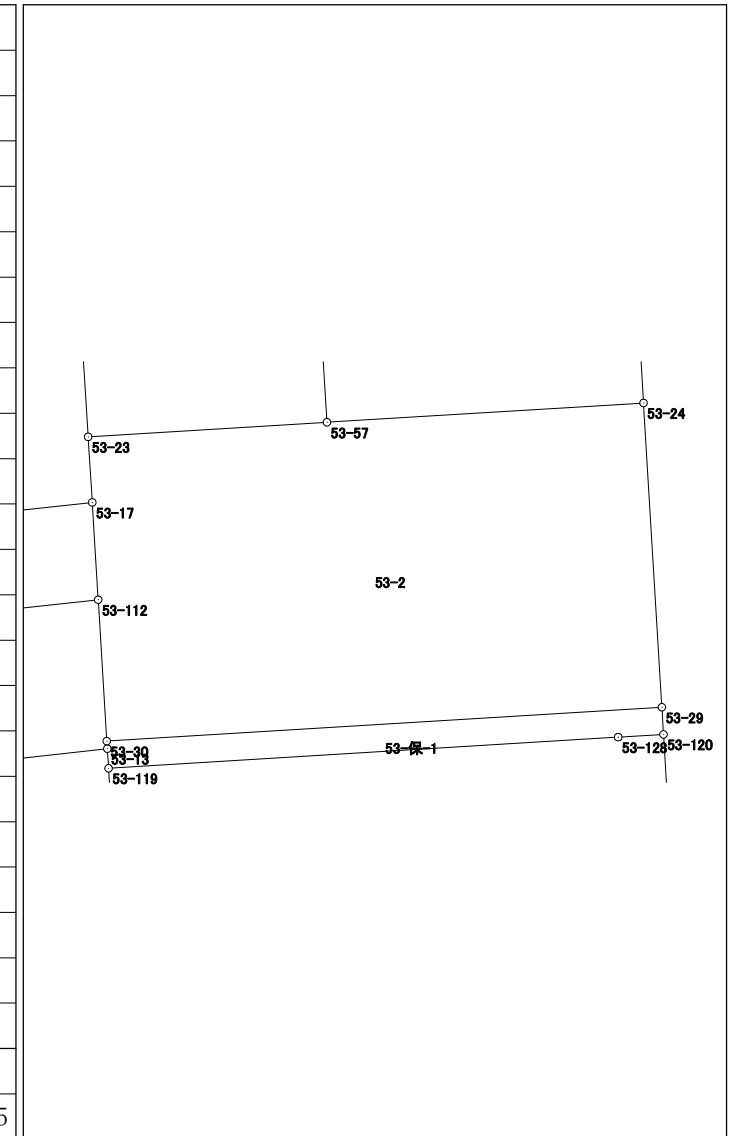


倍面積	1480.027065
面積	740.0135325

面積計算書 (座標法)

世界測地系 (測地成果2011)

所在	地番	公簿地目	現況地目	地積	所有者
前橋市六供町二丁目	53-3			253.08 m ²	

点名	X座標	Y座標	辺長	方向角	測角	DX	倍積 (Y×DX)
53-120	41312.121	-68218.950	3.000	266-31-17	89-57-59	6.695	-456725.870250
53-128	41311.939	-68221.944	33.734	266-30-15	179-58-58	-2.239	152748.932616
53-119	41309.882	-68255.615	6.890	176-31-48	90-01-33	-8.934	609795.664410
53-121	41303.005	-68255.198	36.730	86-30-19	89-58-31	-4.638	316567.608324
53-122	41305.244	-68218.536	6.889	356-33-18	90-02-59	9.116	-621880.174176
						倍面積	506.160924
						面積	253.0804620

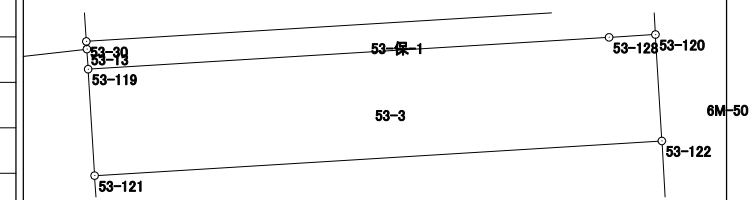


面積計算書 (座標法)

世界測地系 (測地成果2011)

所 在	地 番	公簿地目	現況地目	地 積	所 有 者
前橋市六供町二丁目	53-4			477.67 m ²	

点 名	X 座標	Y 座標	辺 長	方 向 角	測 角	DX	倍 積 (Y×DX)
53-121	41303.005	-68255.198	10.881	176-31-40	90-01-21	-13.100	894143.093800
53-71	41292.144	-68254.539	2.122	176-48-46	180-17-06	-12.980	885943.916220
53-26	41290.025	-68254.421	2.872	86-28-02	89-39-16	-1.942	132550.085582
53-116	41290.202	-68251.554	8.247	86-28-06	180-00-04	0.685	-46752.314490
53-32	41290.710	-68243.323	10.234	86-34-18	180-06-12	1.120	-76432.521760
53-101	41291.322	-68233.107	1.000	86-33-34	179-59-16	0.672	-45852.647904
53-34	41291.382	-68232.109	14.384	86-31-28	179-57-54	0.932	-63592.325588
53-25	41292.254	-68217.751	13.014	356-32-30	90-01-02	13.862	-945634.464362
53-122	41305.244	-68218.536	36.730	266-30-19	89-57-49	10.751	-733417.480536
						倍面積	955.340962
						面 積	477.6704810

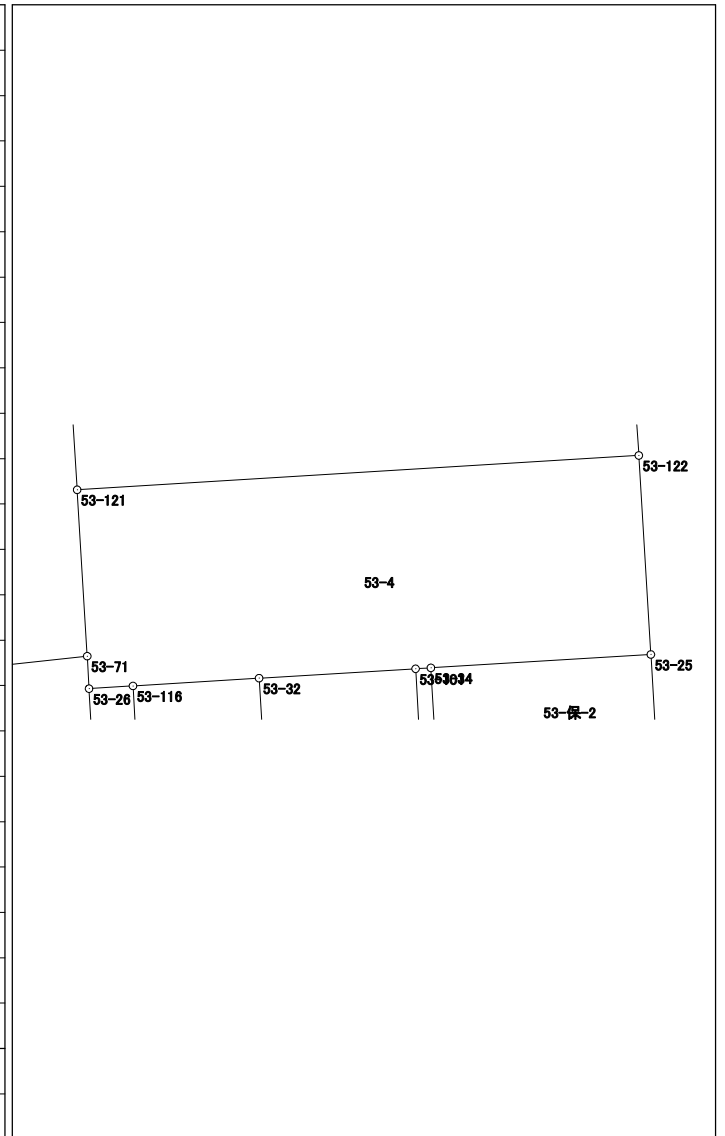


面積計算書 (座標法)

世界測地系 (測地成果2011)

所在	地番	公簿地目	現況地目	地積	所有者
前橋市六供町二丁目	53-5			192.56 m ²	

点名	X座標	Y座標	辺長	方向角	測角	DX	倍積 (Y×DX)
53-117	41286.039	-68231.792	12.996	176-35-56	90-04-23	-13.845	944669.160240
53-33	41273.066	-68231.021	11.536	91-58-56	95-23-00	-13.372	912385.212812
53-6	41272.667	-68219.492	4.002	43-18-33	131-19-37	2.513	-171435.583396
53-5	41275.579	-68216.747	11.353	356-33-21	133-14-48	14.244	-971679.344268
53-118	41286.911	-68217.429	14.389	266-31-33	89-58-12	10.460	-713554.307340
						倍面積	385.138048
						面積	192.5690240

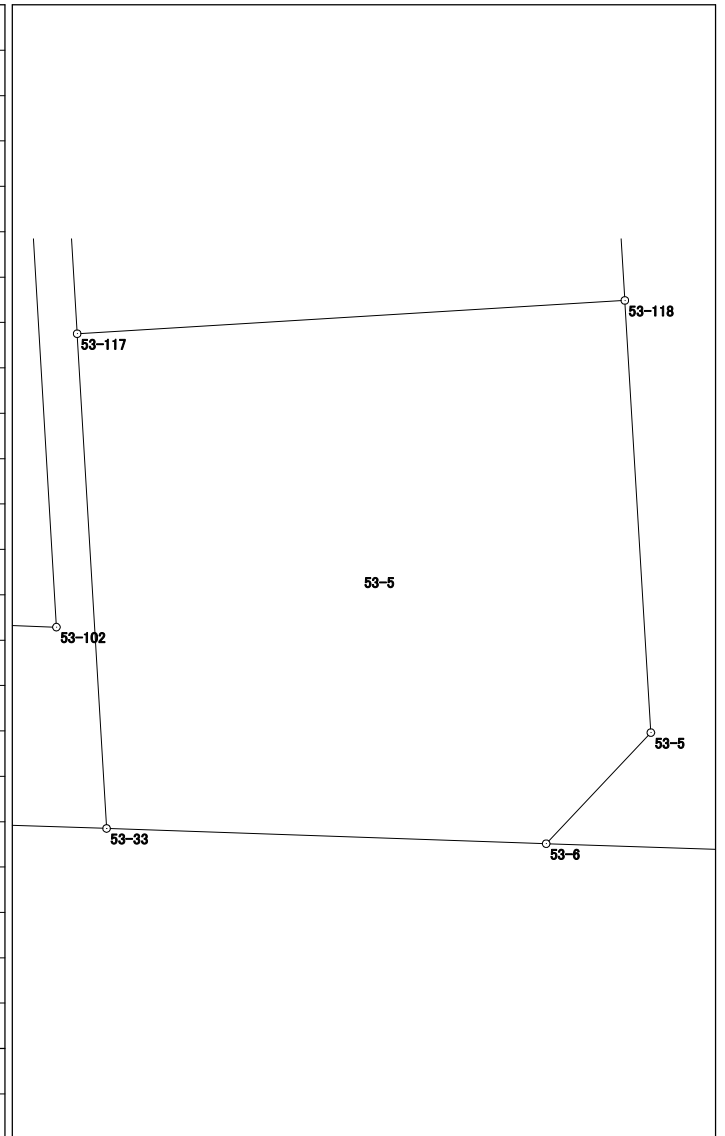


面積計算書 (座標法)

世界測地系 (測地成果2011)

所 在	地 番	公簿地目	現況地目	地 積	所 有 者
前橋市六供町二丁目	53-6			151.01 m ²	

点 名	X 座標	Y 座標	辺 長	方 向 角	測 角	DX	倍 積 (Y×DX)
53-102	41278.345	-68232.336	13.000	356-36-00	84-39-29	12.778	-871872.789408
53-101	41291.322	-68233.107	10.234	266-34-18	89-58-18	12.365	-843702.368055
53-32	41290.710	-68243.323	17.296	176-31-58	89-57-40	-17.876	1219917.641948
53-31	41273.446	-68242.277	4.391	91-55-53	95-23-55	-17.412	1188234.527124
53-124	41273.298	-68237.888	5.256	356-32-31	84-36-38	5.098	-347876.753024
53-123	41278.544	-68238.205	5.872	91-56-31	275-24-00	5.047	-344398.220635
倍面積						302.037950	
面 積						151.0189750	

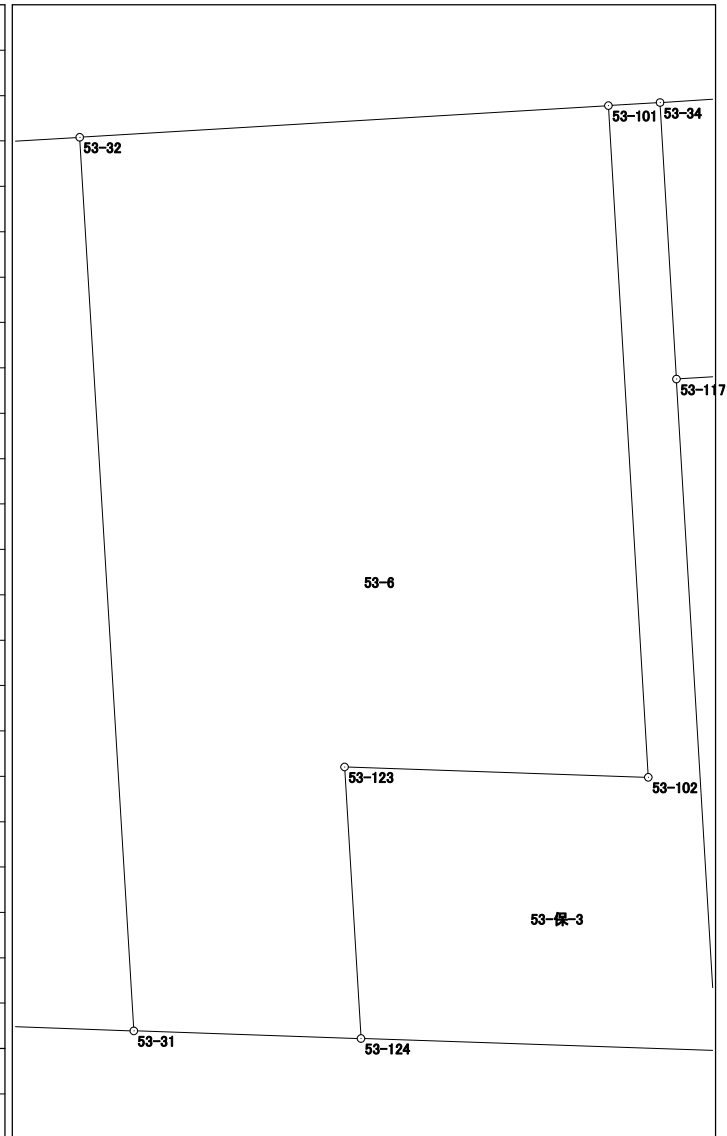


面積計算書 (座標法)

世界測地系 (測地成果2011)

所 在	地 番	公簿地目	現況地目	地 積	所 有 者
前橋市六供町二丁目	53-7			139.47 m ²	

点 名	X 座標	Y 座標	辺 長	方 向 角	測 角	DX	倍 積 (Y×DX)
53-115	41273.728	-68250.569	8.297	91-56-52	95-22-10	-16.756	1143606.534164
53-31	41273.446	-68242.277	17.296	356-31-58	84-35-06	16.982	-1158890.348014
53-32	41290.710	-68243.323	8.247	266-28-06	89-56-08	16.756	-1143485.120188
53-116	41290.202	-68251.554	16.503	176-34-42	90-06-36	-16.982	1159047.890028
						倍面積	278.955990
						面 積	139.4779950

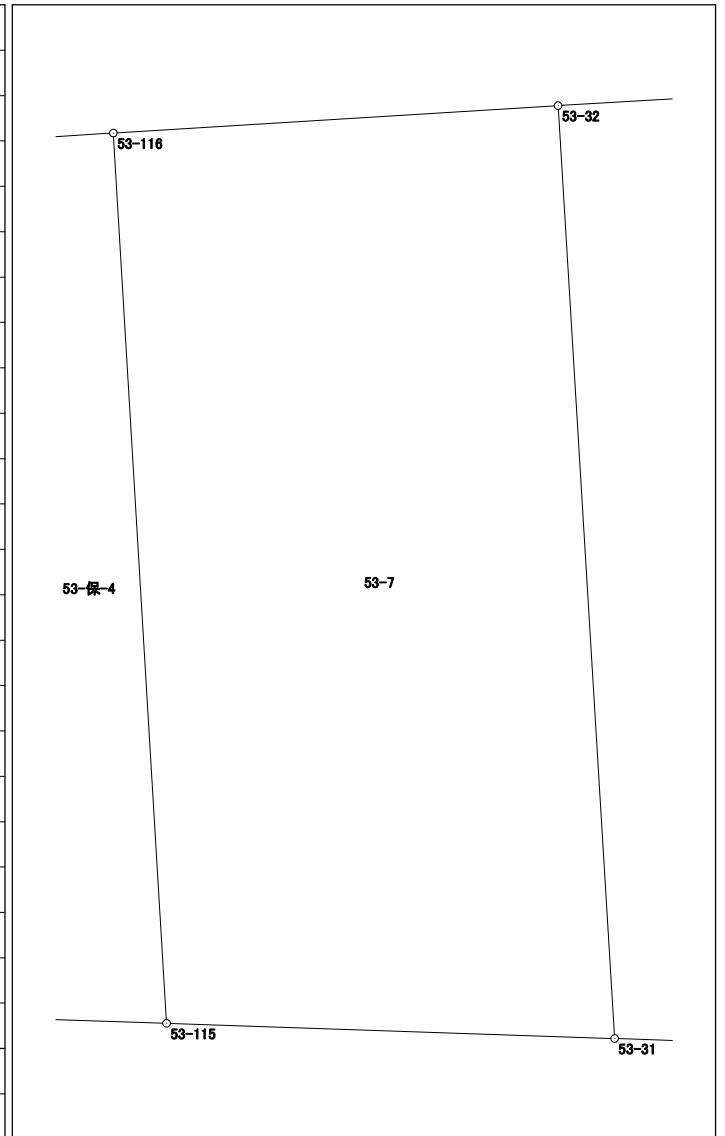


面積計算書（座標法）

世界測地系（測地成果2011）

所在	地番	公簿地目	現況地目	地積	所有者
前橋市六供町二丁目	53-8-1			130.22 m ²	

点名	X座標	Y座標	辺長	方向角	測角	DX	倍積 (Y×DX)
53-14	41308.168	-68282.768	14.064	173-39-37	89-55-33	-14.988	1023422.126784
53-63	41294.190	-68281.215	9.251	83-51-24	90-11-47	-12.988	886836.420420
53-66	41295.180	-68272.017	14.084	353-40-24	89-49-00	14.988	-1023260.990796
53-64	41309.178	-68273.569	9.254	263-44-04	90-03-40	12.988	-886737.114172

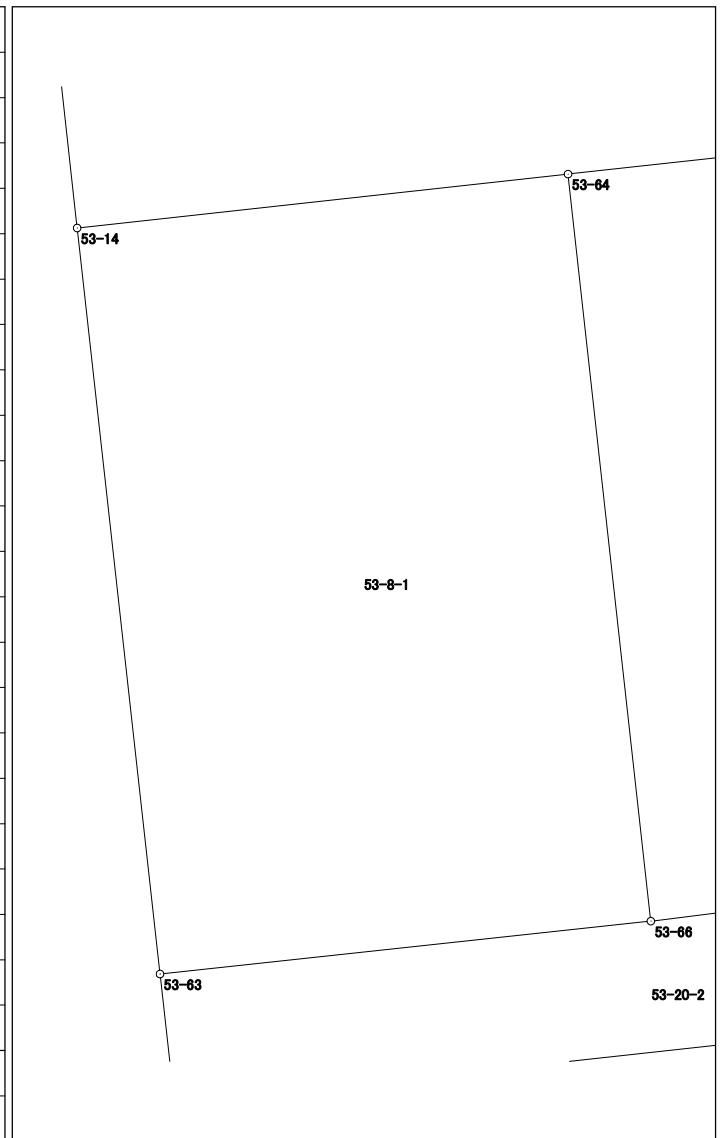


倍面積	260.442236
面積	130.221180

面積計算書 (座標法)

世界測地系 (測地成果2011)

所 在	地 番	公簿地目	現況地目	地 積	所 有 者
前橋市六供町二丁目	53-8-2			126.26 m ²	

点 名	X 座標	Y 座標	辺 長	方 向 角	測 角	DX	倍 積 (Y×DX)
53-64	41309.178	-68273.569	14.084	173-40-24	89-56-58	-14.982	1022874.610758
53-66	41295.180	-68272.017	8.999	83-02-13	89-21-49	-12.907	881186.923419
53-67	41296.271	-68263.084	13.976	353-40-55	90-38-42	14.982	-1022717.524488
53-65	41310.162	-68264.622	9.001	263-43-26	90-02-31	12.907	-881091.476154
						倍面積	252.533535
						面 積	126.2667675

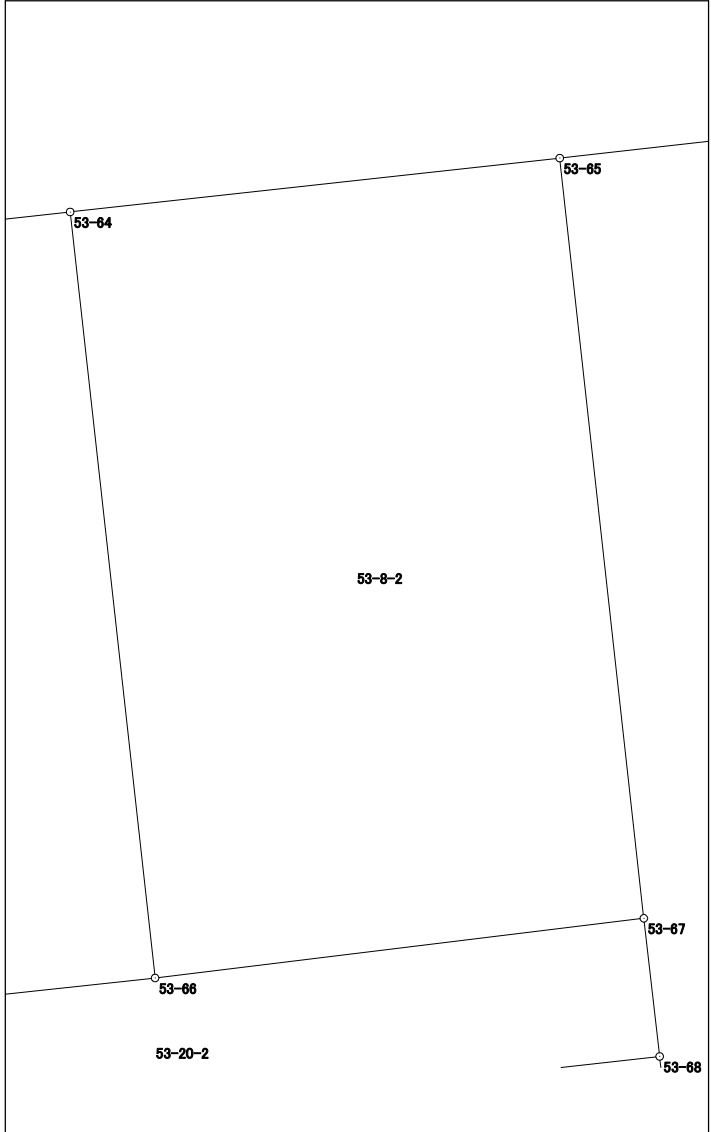


面積計算書 (座標法)

世界測地系 (測地成果2011)

所在	地番	公簿地目	現況地目	地積	所有者
前橋市六供町二丁目	53-9			271.33 m ²	

点名	X座標	Y座標	辺長	方向角	測角	Dx	倍積 (Y×Dx)
53-111	41317.990	-68283.851	9.882	173-42-28	89-58-47	-12.850	877447.485350
53-14	41308.168	-68282.768	9.254	83-44-04	90-01-36	-8.812	601707.751616
53-64	41309.178	-68273.569	9.001	83-43-26	179-59-22	1.994	-136137.496586
53-65	41310.162	-68264.622	8.986	83-30-05	179-46-39	2.001	-136597.508622
53-13	41311.179	-68255.694	0.498	355-23-22	91-53-17	1.513	-103270.865022
53-30	41311.675	-68255.734	9.360	356-32-00	181-08-38	9.839	-671568.166826
53-112	41321.018	-68256.300	27.717	263-43-41	87-11-41	6.315	-431038.534500

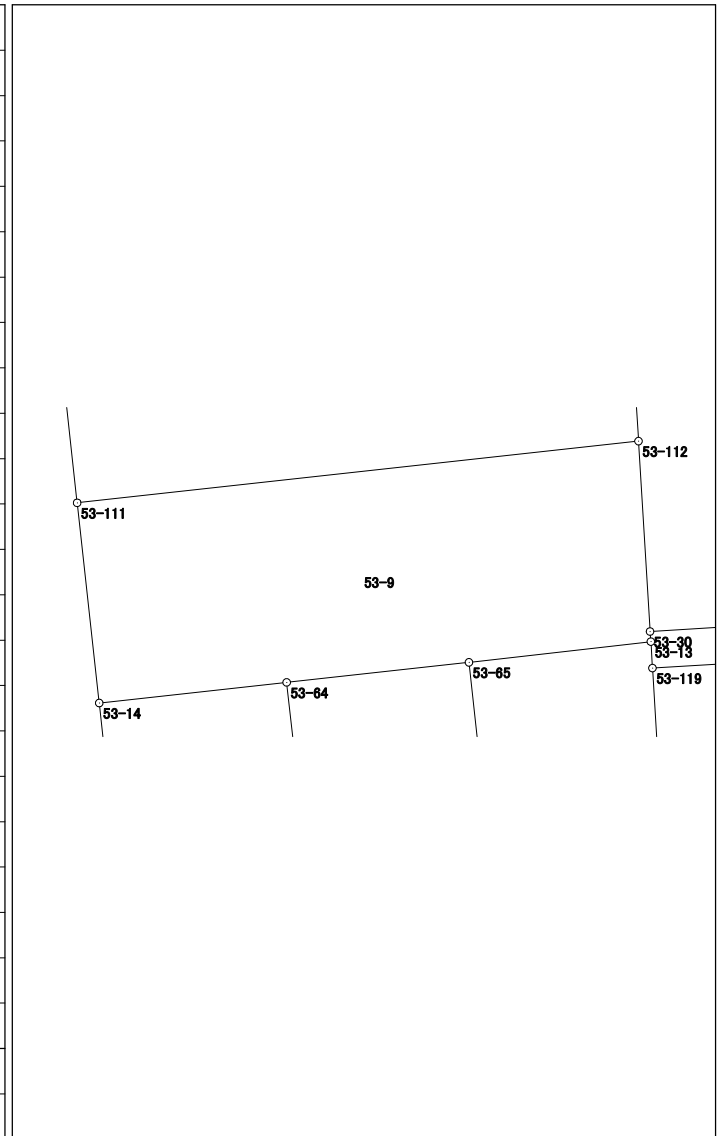


倍面積	542.665410
面積	271.3327050

面積計算書（座標法）

世界測地系（測地成果2011）

所在	地番	公簿地目	現況地目	地積	所有者
前橋市六供町二丁目	53-10			179.15 m ²	

点名	X座標	Y座標	辺長	方向角	測角	DX	倍積 (Y×DX)
53-18	41324.380	-68284.556	6.429	173-42-15	89-57-30	-7.687	524903.381972
53-111	41317.990	-68283.851	27.717	83-43-41	90-01-26	-3.362	229570.307062
53-112	41321.018	-68256.300	6.437	356-31-35	92-47-54	9.453	-645226.803900
53-17	41327.443	-68256.690	13.465	263-42-55	87-11-20	4.951	-337938.872190
53-127	41325.969	-68270.074	2.663	263-42-18	179-59-23	-1.766	120564.950684
53-19	41325.677	-68272.721	11.906	263-44-45	180-02-27	-1.589	108485.353669

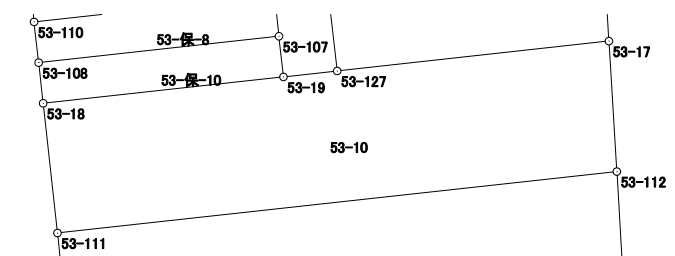


倍面積	358.317297
面積	179.1586485

面積計算書（座標法）

世界測地系（測地成果2011）

所 在	地 番	公簿地目	現況地目	地 積	所 有 者
前橋市六供町二丁目	53-11			121.53 m ²	

点 名	X 座標	Y 座標	辺 長	方 向 角	測 角	DX	倍 積 (Y×DX)
53-109	41329.684	-68273.165	9.180	353-41-00	89-56-24	10.422	-711542.925630
53-36	41338.808	-68274.175	1.034	353-20-08	179-39-08	10.151	-693051.150425
53-22	41339.835	-68274.295	0.681	263-35-41	90-15-33	0.951	-64928.854545
53-104	41339.759	-68274.972	11.232	263-37-13	180-01-32	-1.324	90396.062928
53-21	41338.511	-68286.134	10.188	173-37-55	90-00-42	-11.373	776618.201982
53-110	41328.386	-68285.004	11.910	83-44-36	90-06-41	-8.827	602751.730308

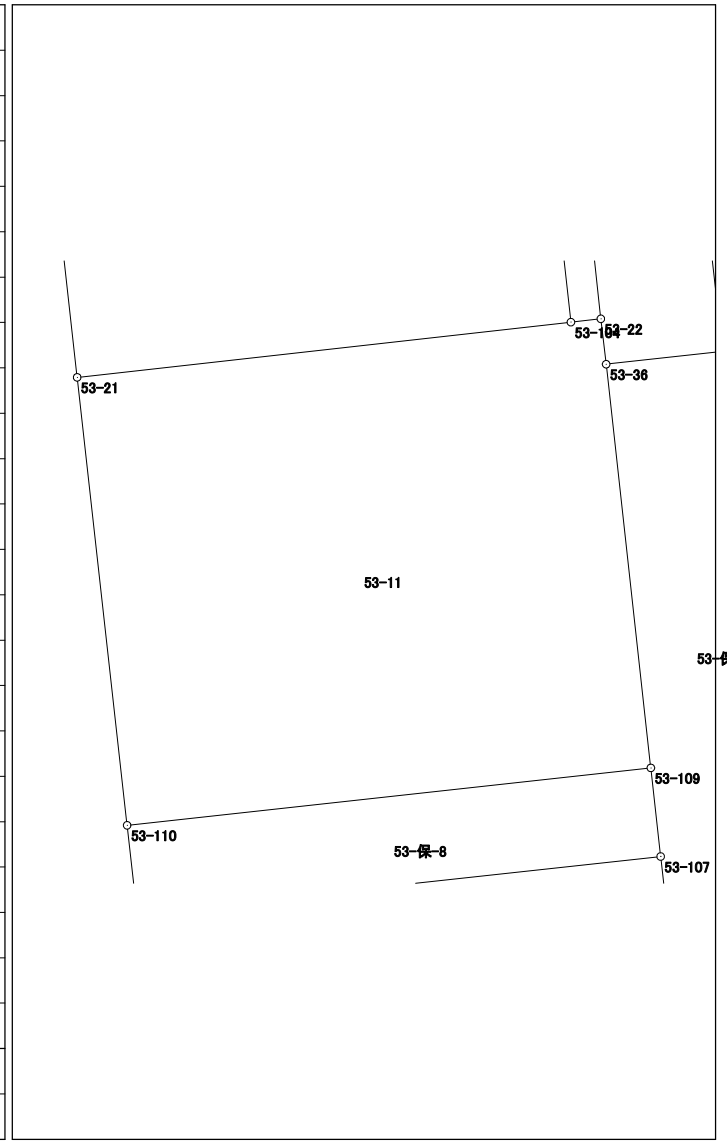


倍面積	243.064618
面 積	121.5323090

面積計算書（座標法）

世界測地系（測地成果2011）

所 在	地 番	公簿地目	現況地目	地 積	所 有 者
前橋市六供町二丁目	53-12			126.58 m ²	

点 名	X 座標	Y 座標	辺 長	方 向 角	測 角	DX	倍 積 (Y×DX)
53-103	41350.066	-68276.105	8.340	277-06-04	103-22-27	11.338	-774114.478490
53-2	41351.097	-68284.381	3.983	225-20-08	128-14-04	-1.769	120795.069989
53-1	41348.297	-68287.214	9.845	173-42-08	128-22-00	-12.586	859462.875404
53-21	41338.511	-68286.134	11.232	83-37-13	89-55-05	-8.538	583027.012092
53-104	41339.759	-68274.972	10.369	353-43-37	90-06-24	11.555	-788917.301460
						倍面積	253.177535
						面 積	126.5887675

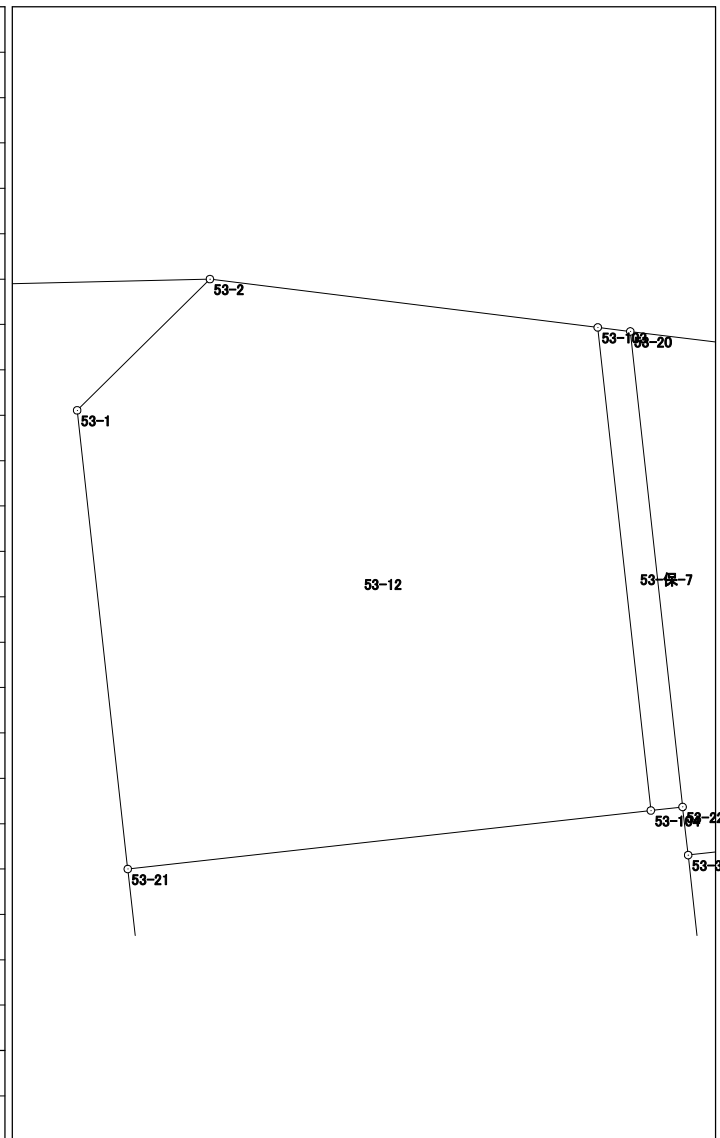


面積計算書（座標法）

世界測地系（測地成果2011）

所在	地番	公簿地目	現況地目	地積	所有者
前橋市六供町二丁目	53-15			115.20 m ²	

点名	X座標	Y座標	辺長	方向角	測角	DX	倍積 (Y×DX)
53-71	41292.144	-68254.539	6.902	263-46-41	86-57-55	1.371	-93576.972969
53-125	41291.396	-68261.400	17.475	173-38-46	89-52-05	-18.116	1236623.522400
53-126	41274.028	-68259.466	6.017	91-55-25	98-16-39	-17.570	1199318.817620
53-11	41273.826	-68253.452	16.228	356-34-36	84-39-11	15.997	-1091850.471644
53-26	41290.025	-68254.421	2.122	356-48-46	180-14-10	18.318	-1250284.483878
						倍面積	230.411529
						面積	115.2057645

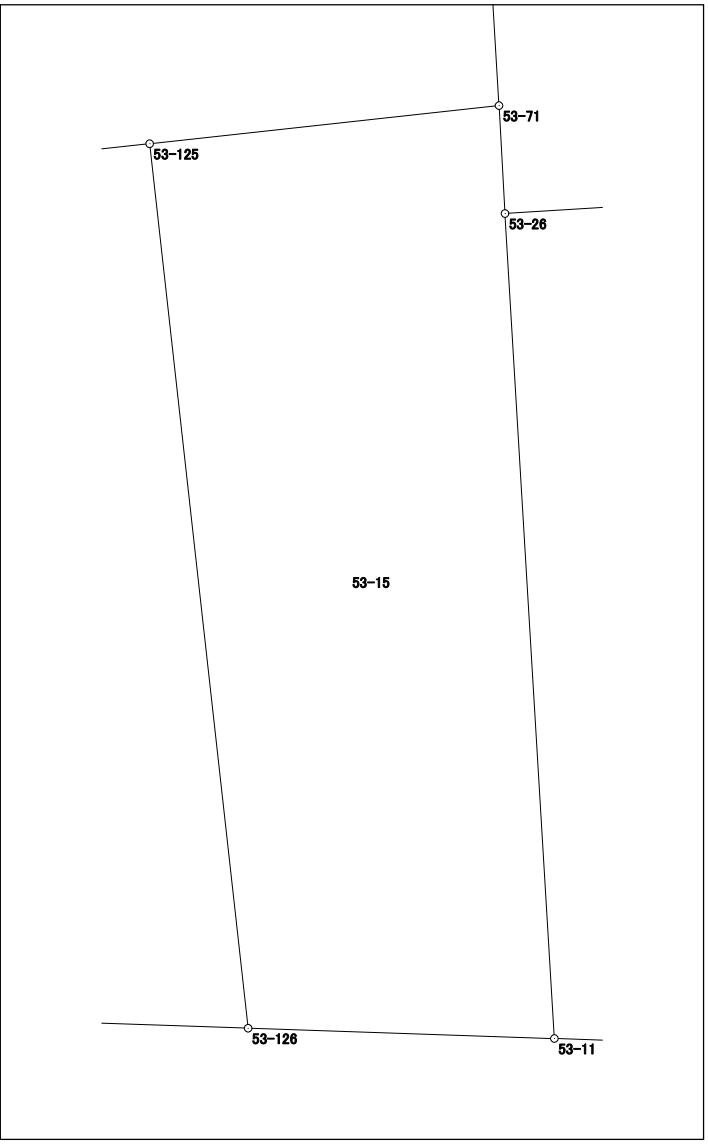


面積計算書（座標法）

世界測地系（測地成果2011）

所 在	地 番	公簿地目	現況地目	地 積	所 有 者
前橋市六供町二丁目	53-16			103.66 m ²	

点 名	X 座標	Y 座標	辺 長	方 向 角	測 角	DX	倍 積 (Y×DX)
53-125	41291.396	-68261.400	1.131	263-48-19	90-09-33	17.246	-1177236.104400
53-69	41291.274	-68262.524	4.956	263-34-14	179-45-55	-0.677	46213.728748
53-72	41290.719	-68267.449	9.962	173-38-36	90-04-22	-10.456	713804.446744
53-113	41280.818	-68266.346	6.624	173-38-47	180-00-11	-16.484	1125302.447464
53-59	41274.235	-68265.613	6.150	91-55-43	98-16-56	-6.790	463523.512270
53-126	41274.028	-68259.466	17.475	353-38-46	81-43-03	17.161	-1171400.696026
						倍面積	207.334800
						面 積	103.6674000

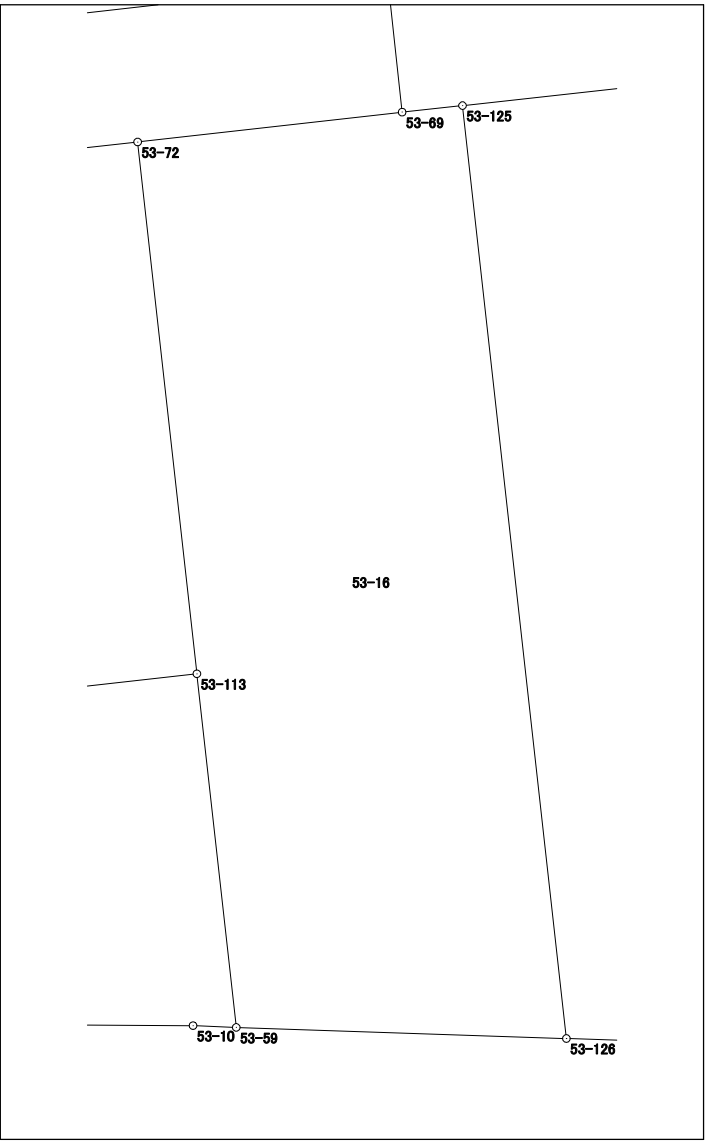


面積計算書 (座標法)

世界測地系 (測地成果2011)

所在	地番	公簿地目	現況地目	地積	所有者
前橋市六供町二丁目	53-17			132.17 m ²	

点名	X座標	Y座標	辺長	方向角	測角	DX	倍積 (Y×DX)
53-113	41280.818	-68266.346	9.962	353-38-36	90-00-26	11.378	-776734.484788
53-72	41290.719	-68267.449	12.354	263-38-16	89-59-40	8.532	-582457.874868
53-74	41289.350	-68279.727	1.380	217-20-36	133-42-20	-2.466	168377.806782
53-61	41288.253	-68280.564	8.965	173-45-23	136-24-47	-10.009	683420.165076
53-114	41279.341	-68279.589	13.325	83-38-10	89-52-47	-7.435	507658.744215
						倍面積	264.356417
						面積	132.1782085

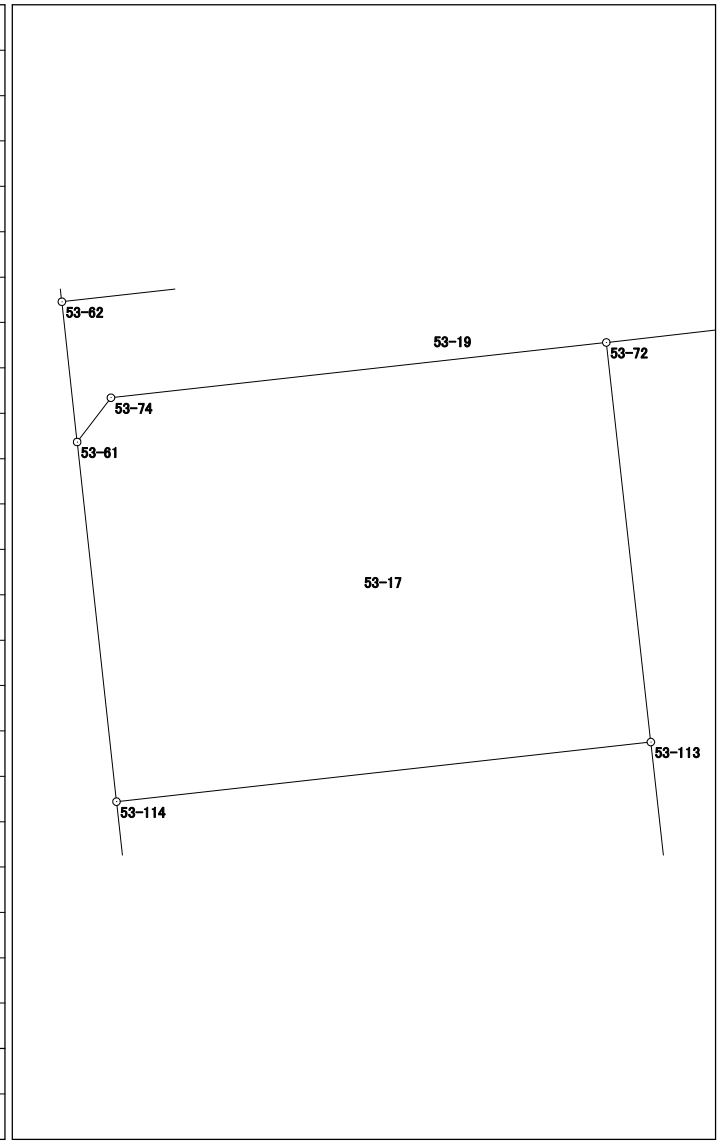

面積計算書 (座標法)

世界測地系 (測地成果2011)


所 在	地 番	公簿地目	現況地目	地 積	所 有 者
前橋市六供町二丁目	53-19			46.04 m ²	

点 名	X 座標	Y 座標	辺 長	方 向 角	測 角	DX	倍 積 (Y×DX)	
53-62	41291.729	-68280.943	3.497	173-46-39	90-07-21	-5.494	375135.500842	
53-61	41288.253	-68280.564	1.380	37-20-36	43-33-57	-2.379	162439.461756	
53-74	41289.350	-68279.727	12.354	83-38-16	226-17-40	2.466	-168377.806782	
53-72	41290.719	-68267.449	4.956	83-34-14	179-55-58	1.924	-131346.571876	
53-69	41291.274	-68262.524	2.488	353-44-47	90-10-33	3.028	-206698.922672	
53-68	41293.747	-68262.795	18.260	263-39-18	89-54-31	0.455	-31059.571725	
							倍面積	92.089543
							面 積	46.0447715

面積計算書（座標法）

所在	地番	公簿地目	現況地目	地積	所有者
前橋市六供町二丁目	53-20-1			161.91 m ²	

点名	X座標	Y座標	辺長	方向角	測角	DX	倍積 (Y×DX)
53-65	41310.162	-68264.622	13.976	173-40-55	90-10-50	-14.908	1017688.984776
53-67	41296.271	-68263.084	2.540	173-28-05	179-47-10	-16.415	1120538.523860
53-68	41293.747	-68262.795	2.488	173-44-47	180-16-42	-4.997	341109.186615
53-69	41291.274	-68262.524	1.131	83-48-19	90-03-32	-2.351	160485.193924
53-125	41291.396	-68261.400	6.902	83-46-41	179-58-22	0.870	-59387.418000
53-71	41292.144	-68254.539	10.881	356-31-40	92-44-59	11.609	-792366.943251
53-121	41303.005	-68255.198	6.890	356-31-48	180-00-08	17.738	-1210710.702124
53-119	41309.882	-68255.615	1.299	356-30-52	179-59-04	8.174	-557921.397010
53-13	41311.179	-68255.694	8.986	263-30-05	86-59-13	0.280	-191111.594320
						倍面積	323.834470
						面積	161.9172350

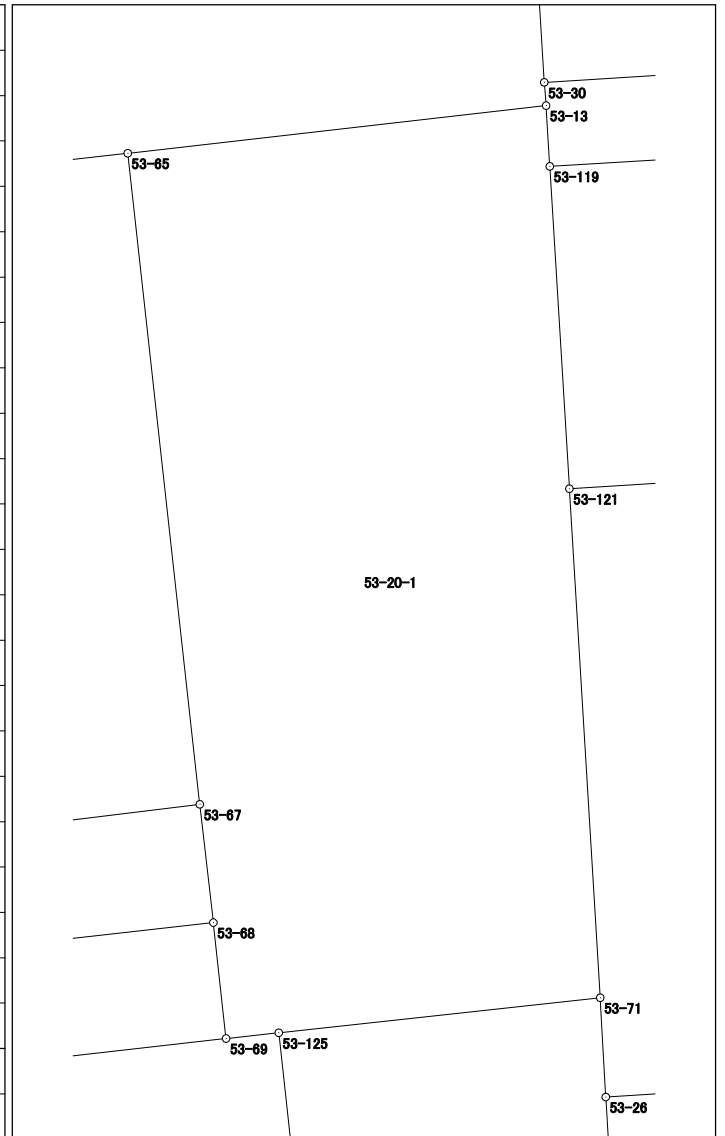

面積計算書（座標法）

世界測地系（測地成果2011）

所 在	地 番	公簿地目	現況地目	地 積	所 有 者
前橋市六供町二丁目	53-保-1			66.00 m ²	


点 名	X 座標	Y 座標	辺 長	方 向 角	測 角	DX	倍 積 (Y×DX)	
53-120	41312.121	-68218.950	1.797	356-31-23	90-00-06	1.976	-134800.645200	
53-29	41313.915	-68219.059	36.743	266-30-18	89-58-55	-0.446	30425.700314	
53-30	41311.675	-68255.734	0.498	175-23-22	88-53-04	-2.736	186747.688224	
53-13	41311.179	-68255.694	1.299	176-30-52	181-07-30	-1.793	122382.459342	
53-119	41309.882	-68255.615	33.734	86-30-15	89-59-23	0.760	-51874.267400	
53-128	41311.939	-68221.944	3.000	86-31-17	180-01-02	2.239	-152748.932616	
						倍面積	132.002664	
						面 積	66.0013320	

面積計算書（座標法）

世界測地系（測地成果2011）

所在	地番	公簿地目	現況地目	地積	所有者
前橋市六供町二丁目	53-保-2			77.00 m ²	

点名	X座標	Y座標	辺長	方向角	測角	D _X	倍積 (Y×D _X)
53-25	41292.254	-68217.751	14.384	266-31-28	89-58-24	4.471	-305001.564721
53-34	41291.382	-68232.109	5.352	176-36-17	90-04-49	-6.215	424062.557435
53-117	41286.039	-68231.792	14.389	86-31-33	89-55-16	-4.471	305064.342032
53-118	41286.911	-68217.429	5.353	356-33-04	90-01-31	6.215	-423971.321235

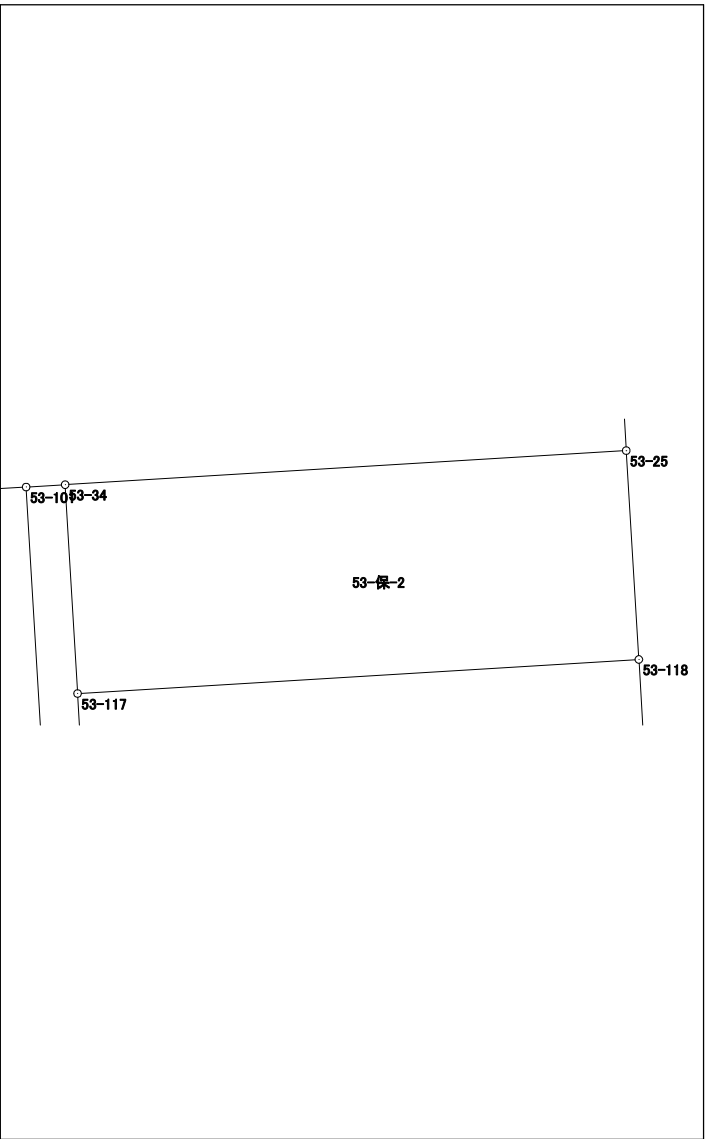


倍面積	154.013511
面積	77.0067555

面積計算書（座標法）

世界測地系（測地成果2011）

所 在	地 番	公簿地目	現況地目	地 積	所 有 者
前橋市六供町二丁目	53-保-3			49.00 m ²	

点 名	X 座 標	Y 座 標	辺 長	方 向 角	測 角	DX	倍 積 (Y×DX)
53-34	41291.382	-68232.109	1.000	266-33-34	89-57-17	5.283	-360470.231847
53-101	41291.322	-68233.107	13.000	176-36-00	90-02-26	-13.037	889555.015959
53-102	41278.345	-68232.336	5.872	271-56-31	275-20-31	-12.778	871872.789408
53-123	41278.544	-68238.205	5.256	176-32-31	84-36-00	-5.047	344398.220635
53-124	41273.298	-68237.888	6.871	91-56-06	95-23-35	-5.478	373807.150464
53-33	41273.066	-68231.021	12.996	356-35-56	84-39-50	12.741	-869331.438561
53-117	41286.039	-68231.792	5.352	356-36-17	180-00-21	18.316	-1249733.502272
						倍面積	98.003786
						面 積	49.0018930

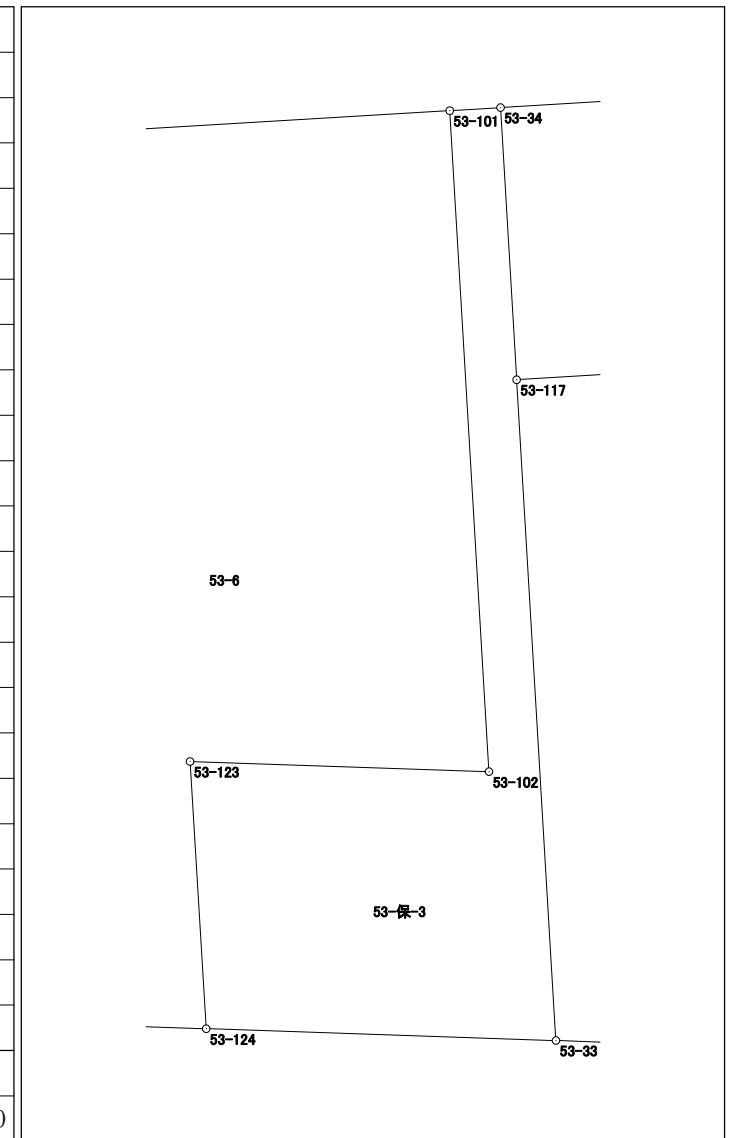


面積計算書 (座標法)

世界測地系 (測地成果2011)

所在	地番	公簿地目	現況地目	地積	所有者
前橋市六供町二丁目	53-保-4			47.00 m ²	

点名	X座標	Y座標	辺長	方向角	測角	DX	倍積 (Y×DX)
53-26	41290.025	-68254.421	16.228	176-34-36	90-06-34	-16.376	1117734.398296
53-11	41273.826	-68253.452	2.885	91-56-49	95-22-13	-16.297	1112326.507244
53-115	41273.728	-68250.569	16.503	356-34-42	84-37-53	16.376	-1117671.317944
53-116	41290.202	-68251.554	2.872	266-28-02	89-53-20	16.297	-1112295.575538

倍面積	94.012058
面積	47.0060290

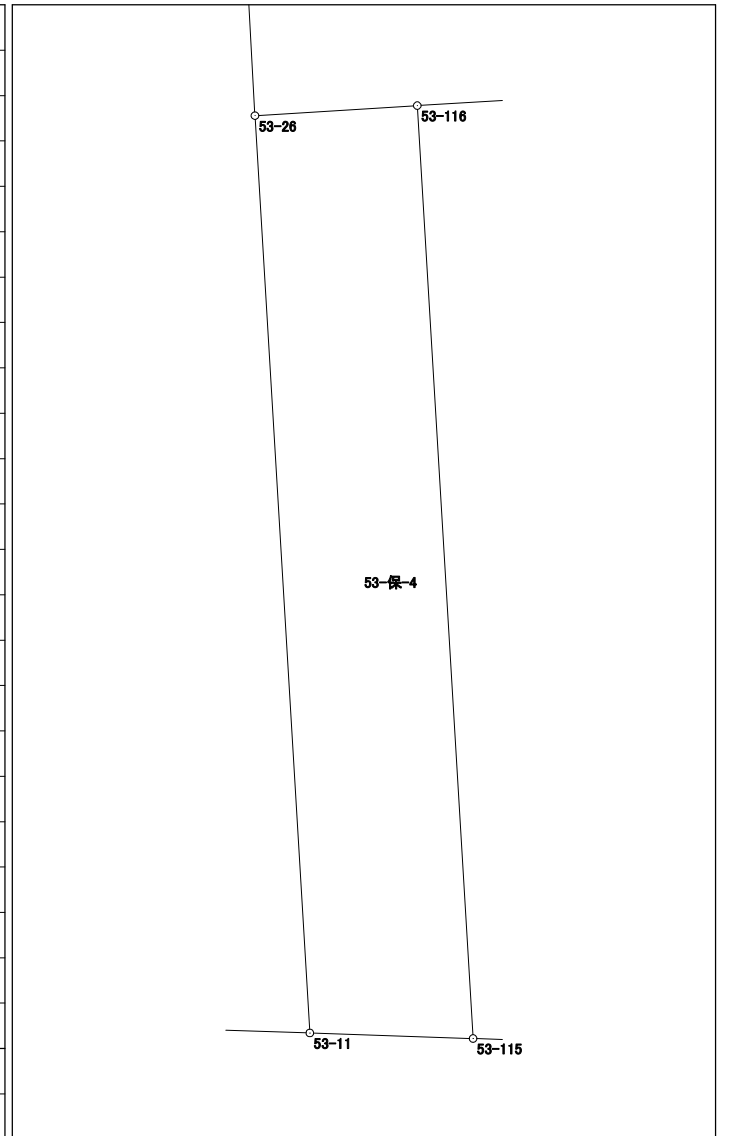


面積計算書（座標法）

世界測地系（測地成果2011）

所在	地番	公簿地目	現況地目	地積	所有者
前橋市六供町二丁目	53-保-5			74.00 m ²	

点名	X座標	Y座標	辺長	方向角	測角	Dx	倍積 (Y×Dx)
53-59	41274.235	-68265.613	6.624	353-38-47	81-17-46	6.550	-447139.765150
53-113	41280.818	-68266.346	13.325	263-38-10	89-59-23	5.106	-348567.962676
53-114	41279.341	-68279.589	2.340	173-44-37	90-06-27	-3.803	259667.276967
53-8	41277.015	-68279.334	3.999	132-26-46	138-42-09	-5.025	343103.653350
53-7	41274.316	-68276.383	9.966	90-16-33	137-49-47	-2.747	187555.224101
53-10	41274.268	-68266.417	0.805	92-21-01	182-04-28	-0.081	5529.579777

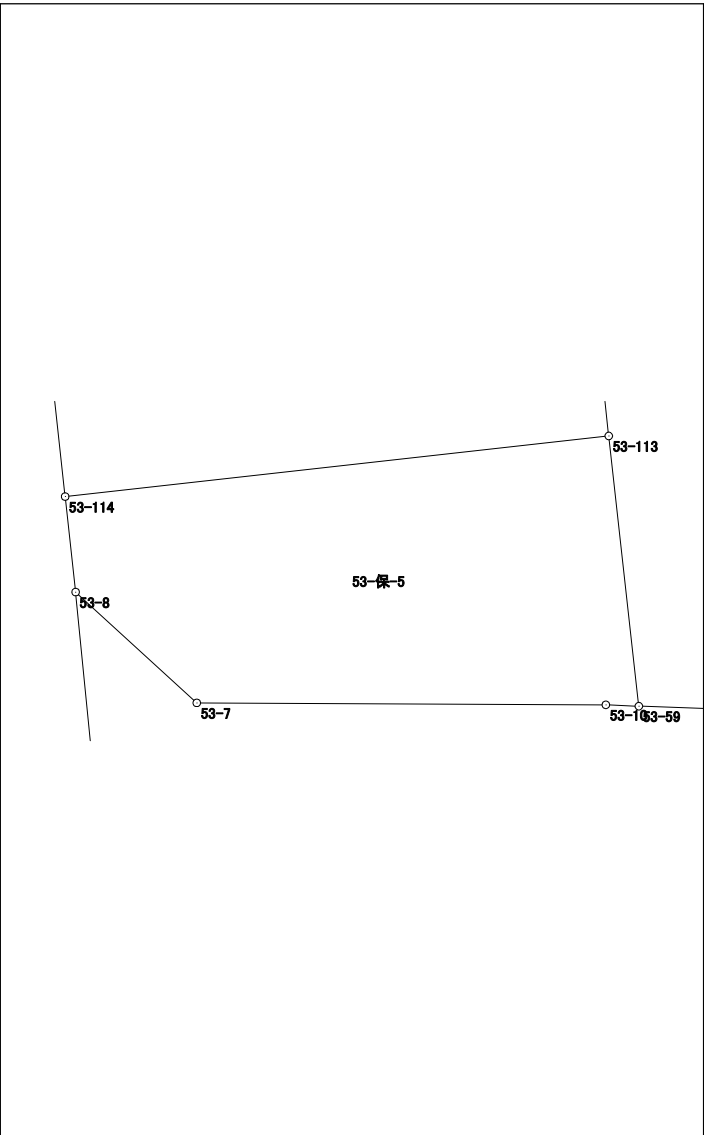


倍面積	148.006369
面積	74.0031845

面積計算書 (座標法)

世界測地系 (測地成果2011)

所在	地番	公簿地目	現況地目	地積	所有者
前橋市六供町二丁目	53-保-6			35.07 m ²	

点名	X座標	Y座標	辺長	方向角	測角	DX	倍積 (Y×DX)
53-105	41339.101	-68271.546	2.645	263-38-26	90-02-11	12.839	-876538.379094
53-36	41338.808	-68274.175	9.180	173-41-00	90-02-34	-9.417	642937.905975
53-109	41329.684	-68273.165	2.015	173-40-32	179-59-32	-11.127	759675.506955
53-107	41327.681	-68272.943	2.016	173-40-43	180-00-11	-4.007	273569.682601
53-19	41325.677	-68272.721	2.663	83-42-18	90-01-35	-1.712	116882.898352
53-127	41325.969	-68270.074	13.214	353-36-15	89-53-57	13.424	-916457.473376
						倍面積	70.141413
						面積	35.0707065

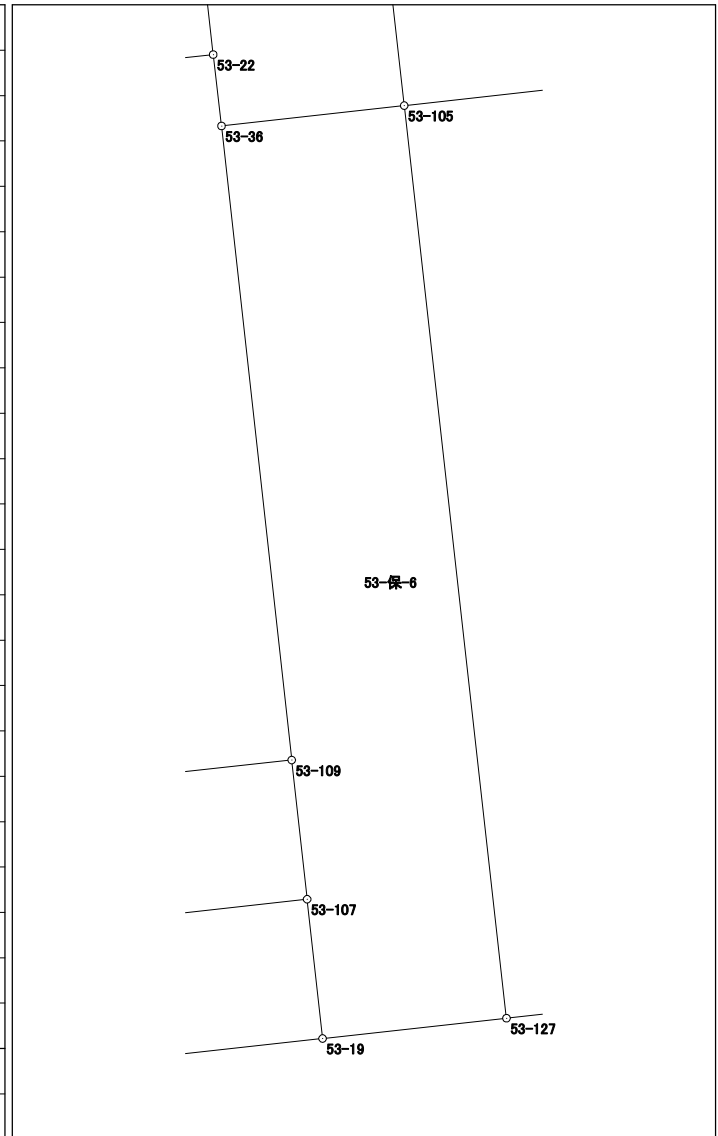


面積計算書 (座標法)

世界測地系 (測地成果2011)

所 在	地 番	公簿地目	現況地目	地 積	所 有 者
前橋市六供町二丁目	53-保-8			24.00 m ²	

点 名	X 座標	Y 座標	辺 長	方 向 角	測 角	DX	倍 積 (Y×DX)
53-108	41326.383	-68284.780	11.908	83-44-32	90-07-24	-0.705	48140.769900
53-107	41327.681	-68272.943	2.015	353-40-32	89-56-00	3.301	-225368.984843
53-109	41329.684	-68273.165	11.910	263-44-36	90-04-04	0.705	-48132.581325
53-110	41328.386	-68285.004	2.015	173-37-08	89-52-32	-3.301	225408.798204
						倍面積	48.001936
						面 積	24.0009680

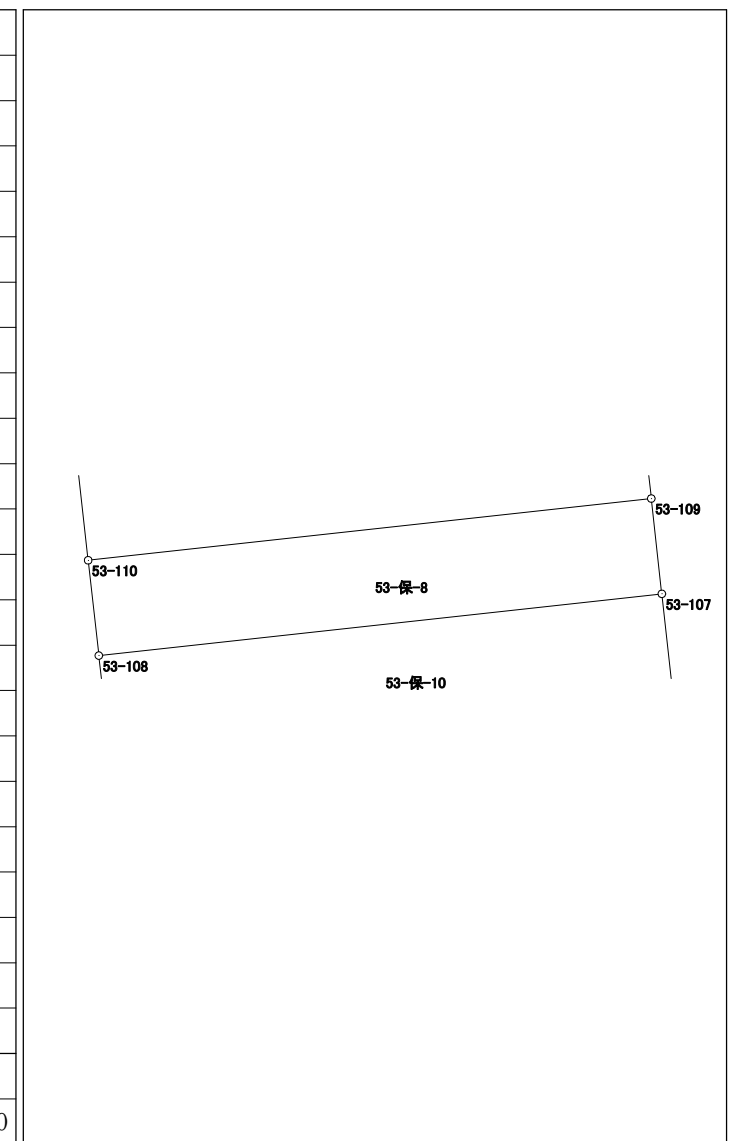

面積計算書 (座標法)

世界測地系 (測地成果2011)

所在	地番	公簿地目	現況地目	地積	所有者
前橋市六供町二丁目	53-保-10			24.00 m ²	

点名	X座標	Y座標	辺長	方向角	測角	DX	倍積 (Y×DX)
53-18	41324.380	-68284.556	11.906	83-44-45	90-07-37	-0.706	48208.896536
53-19	41325.677	-68272.721	2.016	353-40-43	89-55-58	3.301	-225368.252021
53-107	41327.681	-68272.943	11.908	263-44-32	90-03-49	0.706	-48200.697758
53-108	41326.383	-68284.780	2.015	173-37-08	89-52-36	-3.301	225408.058780
						倍面積	48.005537
						面積	24.0027685

