



55街区 画地出来形確認図 (4322.74m²)

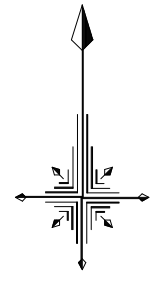

S=1/500

3.5.64六供八幡宮西線

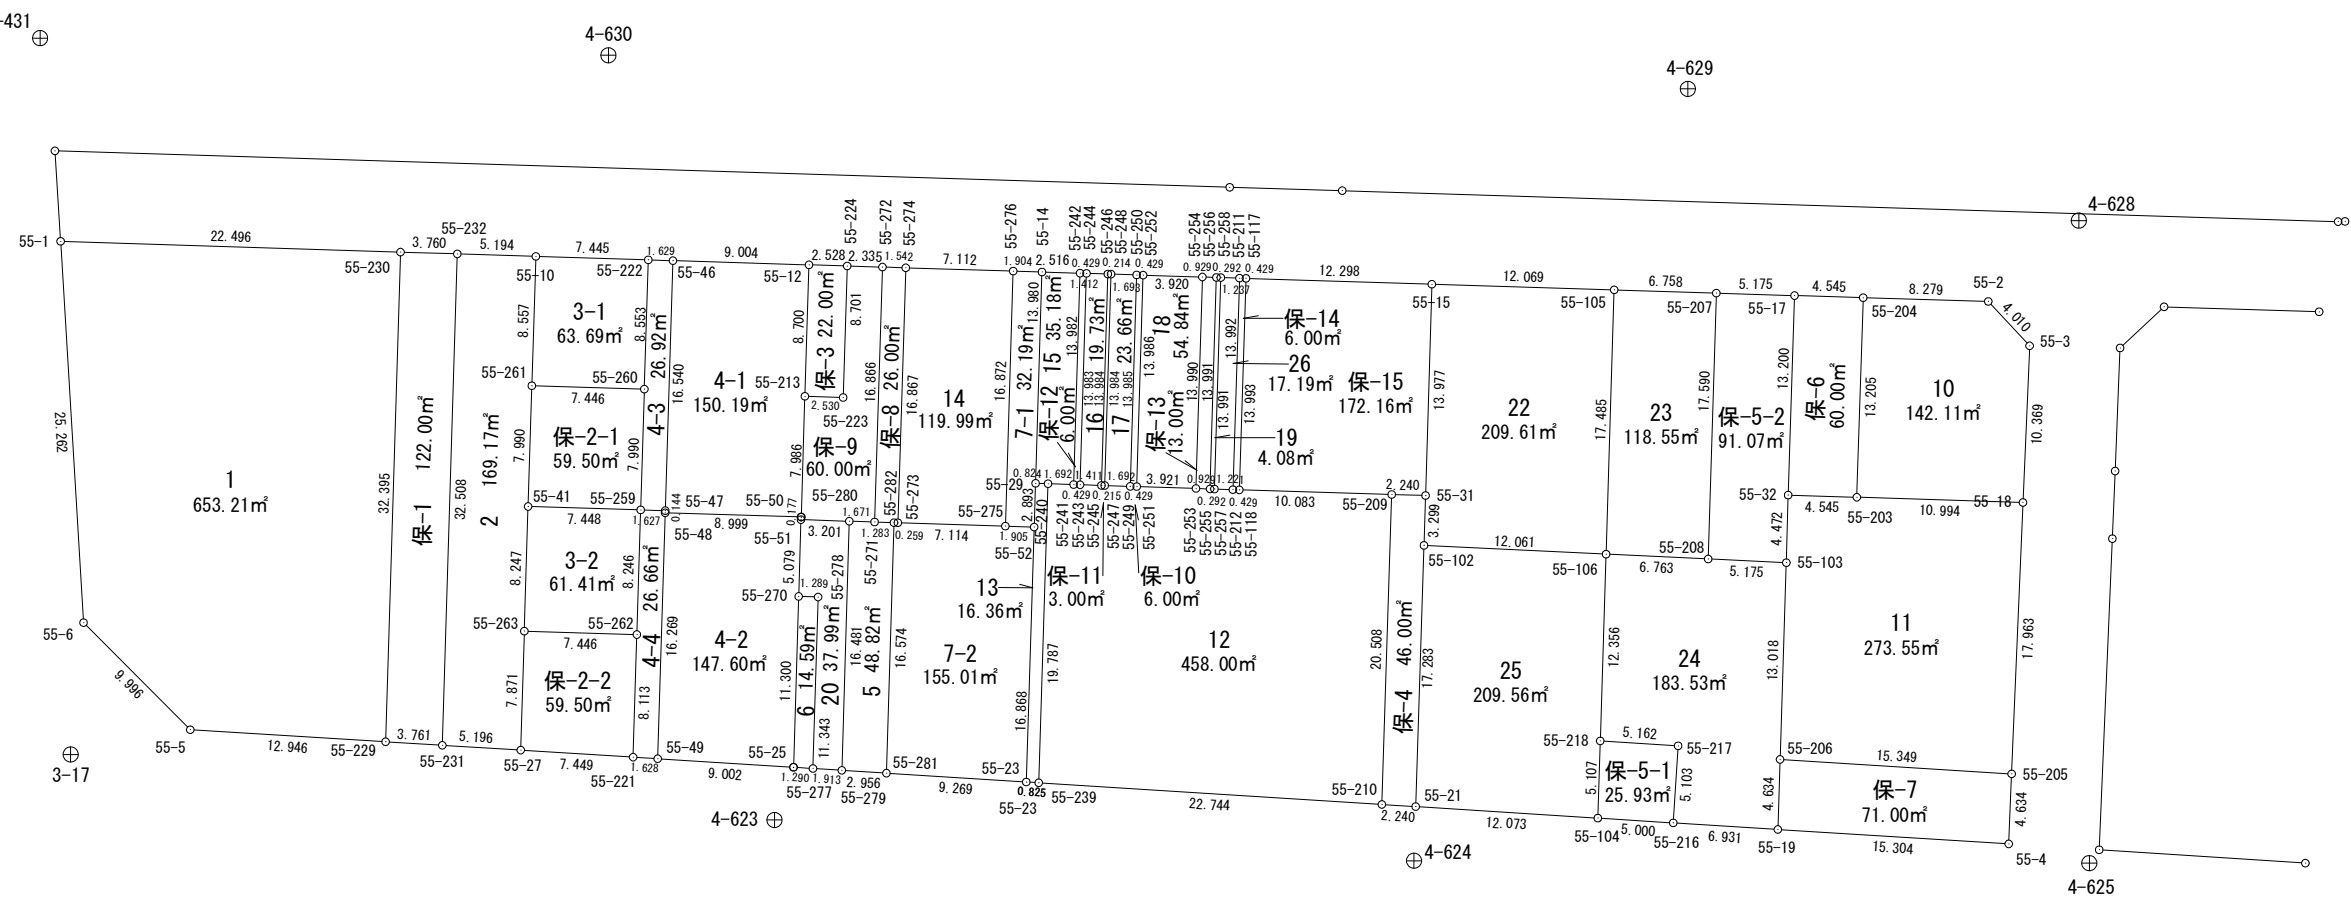

3.3.10江田天川大島線

4-198

4-197

4-196


4-195

面積計算書 (座標法)

世界測地系 (測地成果2011)

所在	地番	公簿地目	現況地目	地積	所有者
前橋市六供町二丁目	55-1			653.21 m ²	

点名	X座標	Y座標	辺長	方向角	測角	DX	倍積 (Y×DX)
55-1	41251.685	-68159.697	25.262	176-33-18	84-44-20	-24.503	1670117.055591
55-6	41226.469	-68158.179	9.996	135-05-06	138-31-48	-32.295	2201168.390805
55-5	41219.390	-68151.121	12.946	93-32-03	138-26-57	-7.877	536826.380117
55-229	41218.592	-68138.200	32.395	1-44-52	88-12-49	31.582	-2151940.632400
55-230	41250.972	-68137.212	22.496	271-48-58	90-04-06	33.093	-2254864.756716

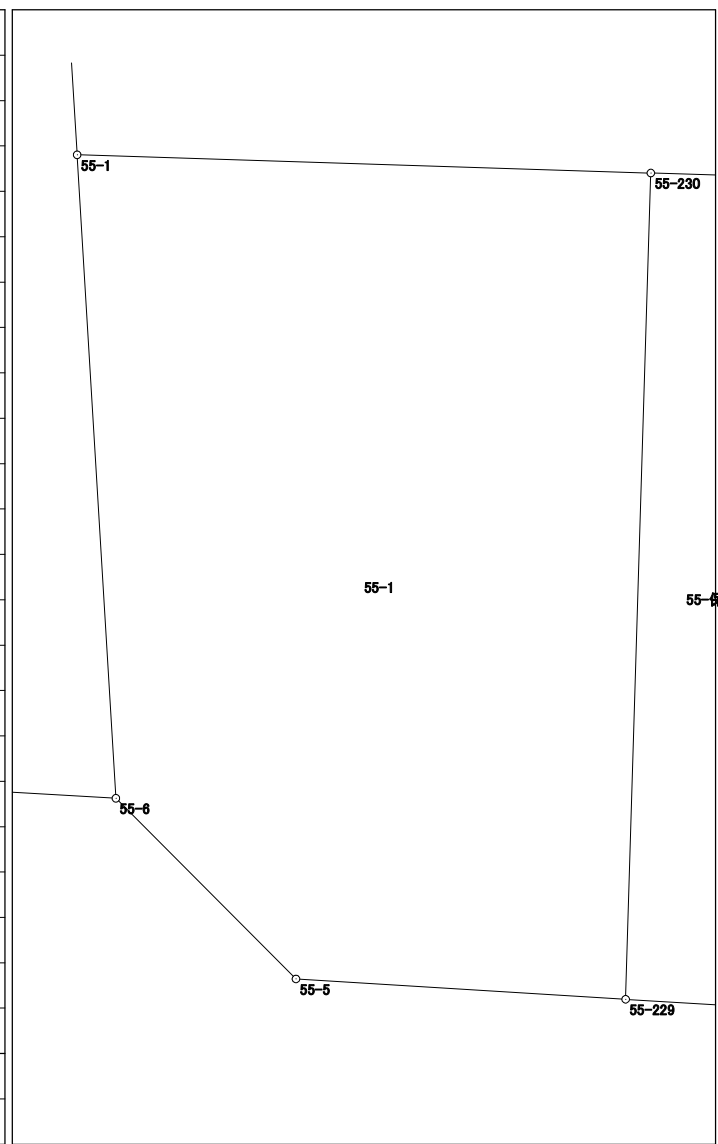


倍面積	1306.437397
面積	653.2186985

面積計算書 (座標法)

世界測地系 (測地成果2011)

所在	地番	公簿地目	現況地目	地積	所有者
前橋市六供町二丁目	55-2			169.17 m ²	

点名	X座標	Y座標	辺長	方向角	測角	DX	倍積 (Y×DX)
55-231	41218.360	-68134.446	5.196	93-32-31	91-47-36	-32.814	2235763.711044
55-27	41218.039	-68129.260	7.871	1-43-58	88-11-27	7.546	-514103.395960
55-263	41225.906	-68129.022	8.247	1-44-14	180-00-16	16.110	-1097558.544420
55-41	41234.149	-68128.772	7.990	1-45-52	180-01-38	16.229	-1105661.840788
55-261	41242.135	-68128.526	8.557	1-45-41	179-59-49	16.539	-1126777.691514
55-10	41250.688	-68128.263	5.194	271-49-14	90-03-33	8.718	-593942.196834
55-232	41250.853	-68133.454	32.508	181-44-55	89-55-41	-32.328	2202618.300912
						倍面積	338.342440
						面積	169.1712200

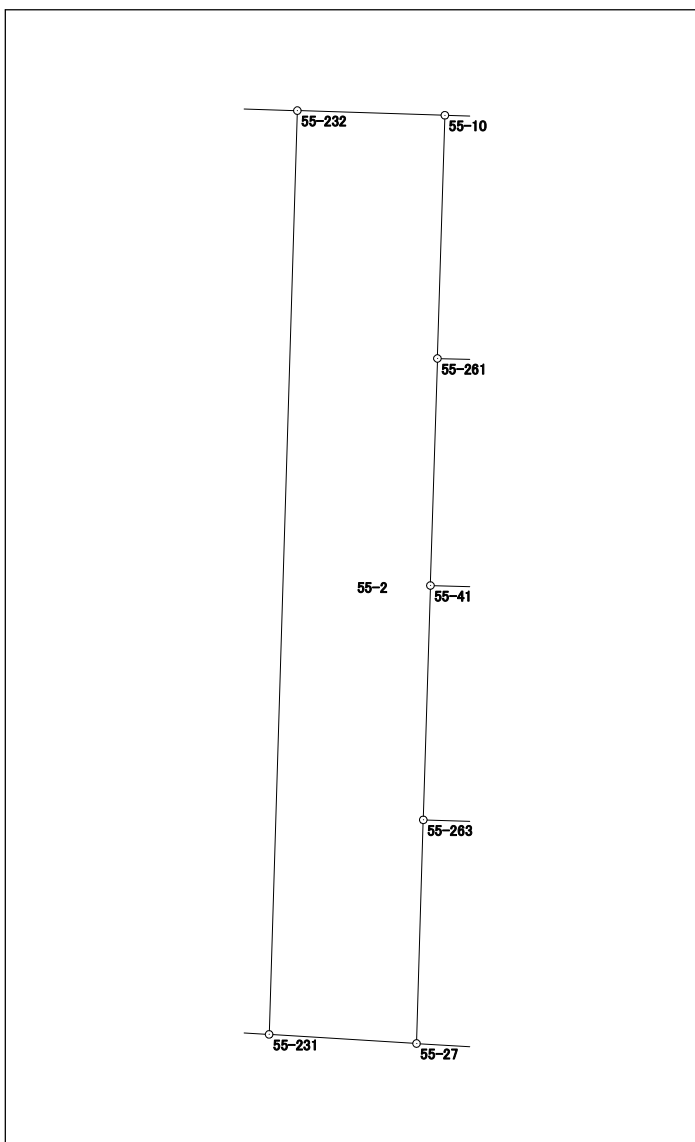


面積計算書 (座標法)

世界測地系 (測地成果2011)

所在	地番	公簿地目	現況地目	地積	所有者
前橋市六供町二丁目	55-3-1			63.69 m ²	

点名	X座標	Y座標	辺長	方向角	測角	DX	倍積 (Y×DX)
55-10	41250.688	-68128.263	8.557	181-45-41	89-59-55	-8.324	567099.661212
55-261	41242.135	-68128.526	7.446	91-43-53	89-58-12	-8.778	598032.201228
55-260	41241.910	-68121.083	8.553	1-44-55	90-01-02	8.324	-567039.894892
55-222	41250.459	-68120.822	7.445	271-45-46	90-00-51	8.778	-597964.575516

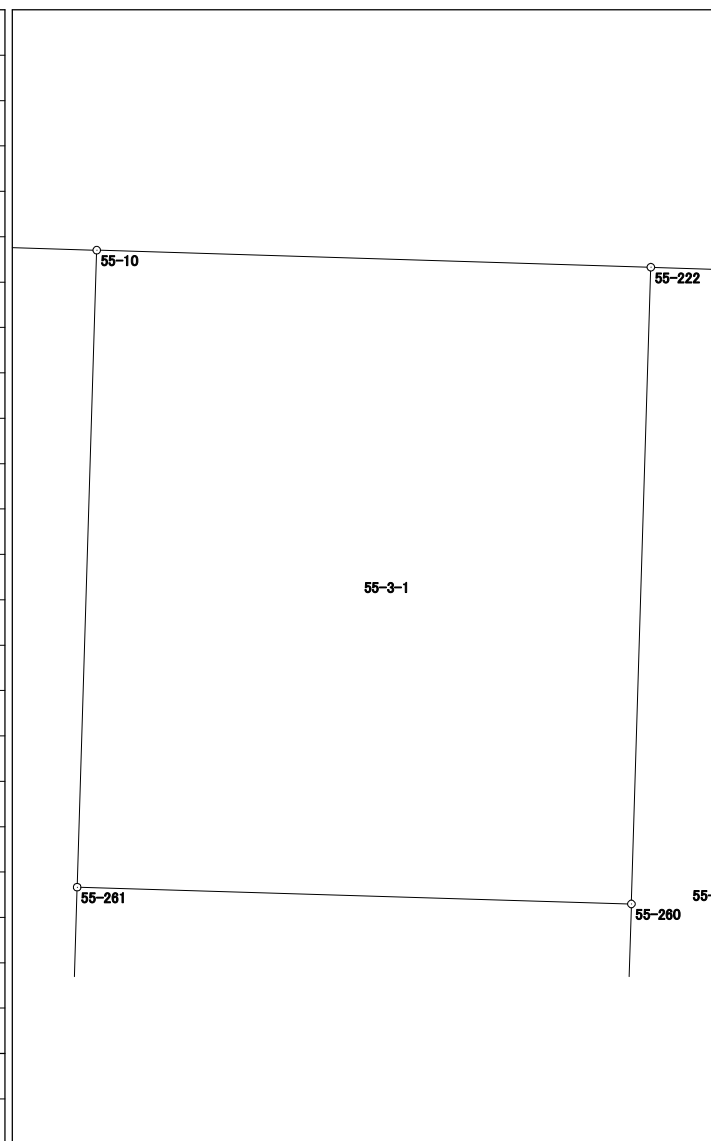


倍面積	127.392032
面積	63.6960160

面積計算書 (座標法)

世界測地系 (測地成果2011)

所在	地番	公簿地目	現況地目	地積	所有者
前橋市六供町二丁目	55-3-2			61.41 m ²	

点名	X座標	Y座標	辺長	方向角	測角	DX	倍積 (Y×DX)
55-41	41234.149	-68128.772	8.247	181-44-14	90-00-22	-8.018	546256.493896
55-263	41225.906	-68129.022	7.446	91-43-26	89-59-12	-8.467	576848.429274
55-262	41225.682	-68121.579	8.246	1-45-05	90-01-39	8.018	-546198.820422
55-259	41233.924	-68121.327	7.448	271-43-52	89-58-47	8.467	-576783.275709

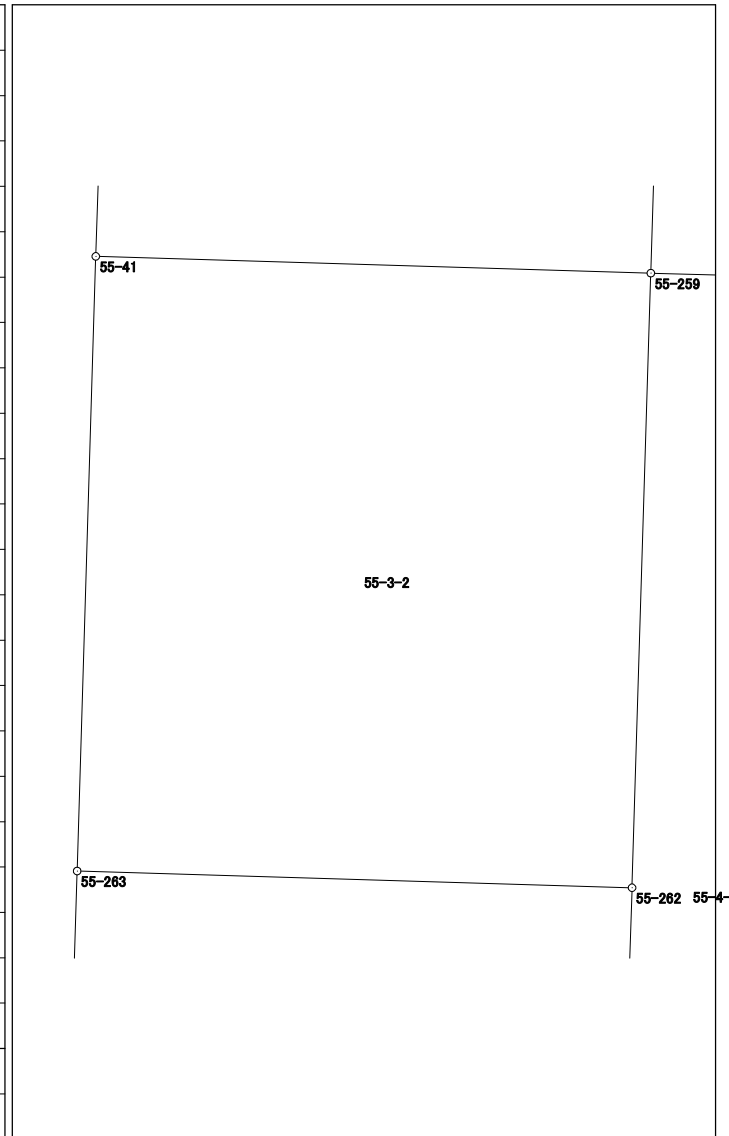


倍面積	122.827039
面積	61.4135195

面積計算書 (座標法)

世界測地系 (測地成果2011)

所在	地番	公簿地目	現況地目	地積	所有者
前橋市六供町二丁目	55-4-1			150.19 m ²	

点名	X座標	Y座標	辺長	方向角	測角	Dx	倍積 (Y×Dx)
55-46	41250.407	-68119.194	16.540	181-45-24	90-00-46	-16.258	1107481.856052
55-47	41233.875	-68119.701	0.144	181-35-28	179-50-04	-16.676	1135964.133876
55-48	41233.731	-68119.705	8.999	91-45-27	90-09-59	-0.420	28610.276100
55-50	41233.455	-68110.710	7.986	1-46-21	90-00-54	7.706	-524861.131260
55-213	41241.437	-68110.463	8.700	1-46-19	179-59-58	16.678	-1135946.301914
55-12	41250.133	-68110.194	9.004	271-44-38	89-58-19	8.970	-610948.440180
倍面積							300.392674
面積							150.1963370

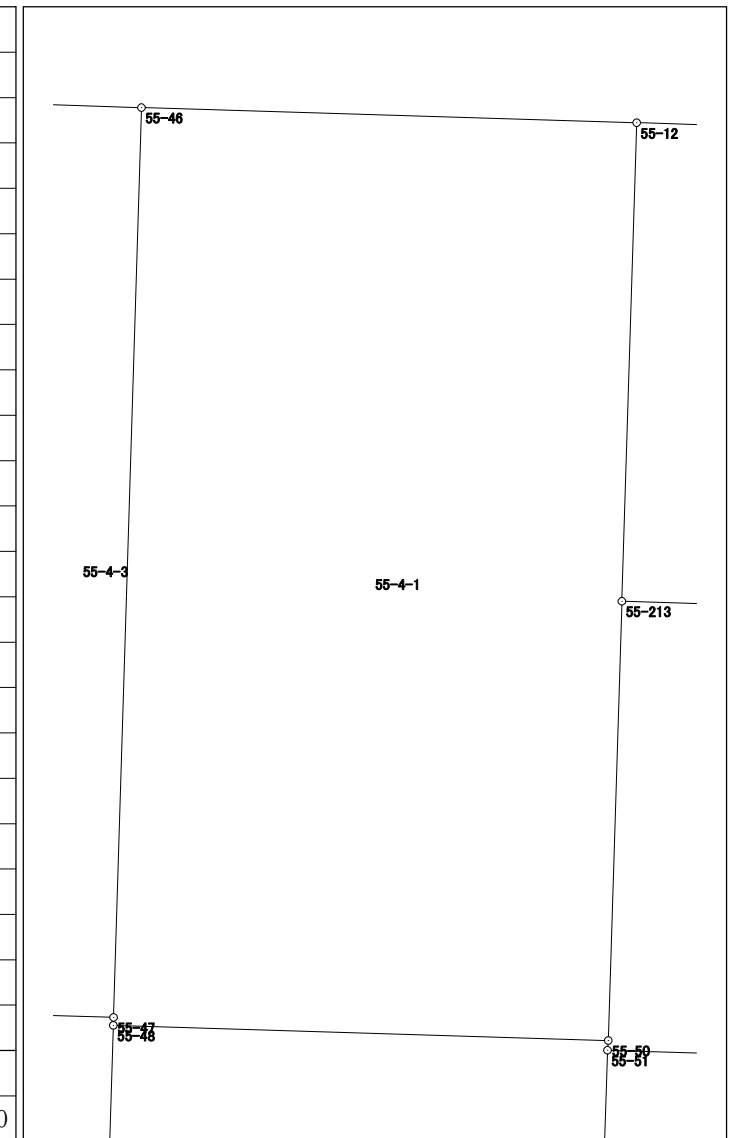


面積計算書 (座標法)

世界測地系 (測地成果2011)

所在	地番	公簿地目	現況地目	地積	所有者
前橋市六供町二丁目	55-4-2			147.60 m ²	

点名	X座標	Y座標	辺長	方向角	測角	DX	倍積 (Y×DX)
55-48	41233.731	-68119.705	16.269	181-44-50	89-59-23	-15.985	1088893.484425
55-49	41217.470	-68120.201	9.002	93-35-09	91-50-19	-16.824	1146054.261624
55-25	41216.907	-68111.217	11.300	1-43-27	88-08-18	10.732	-730969.580844
55-270	41228.202	-68110.877	5.079	1-43-34	180-00-07	16.372	-1115111.278244
55-51	41233.279	-68110.724	0.177	4-32-53	182-49-19	5.253	-357785.633172
55-50	41233.455	-68110.710	8.999	271-45-27	87-12-34	0.452	-30786.040920

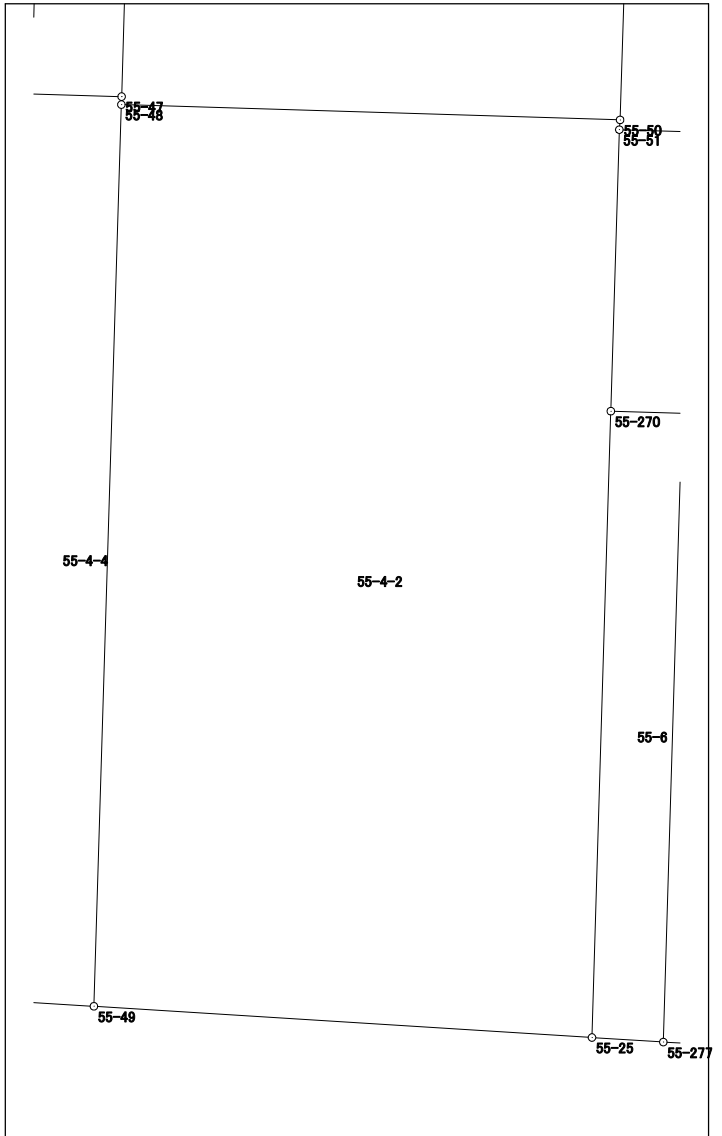

倍面積	295.212869
面積	147.6064345

面積計算書（座標法）

世界測地系（測地成果2011）

所在	地番	公簿地目	現況地目	地積	所有者
前橋市六供町二丁目	55-4-3			26.92 m ²	

点名	X座標	Y座標	辺長	方向角	測角	DX	倍積 (Y×DX)	
55-222	41250.459	-68120.822	8.553	181-44-55	89-55-09	-8.497	578822.624534	
55-260	41241.910	-68121.083	7.990	181-45-00	180-00-05	-16.535	1126382.107405	
55-259	41233.924	-68121.327	1.627	91-43-34	89-58-34	-8.035	547354.862445	
55-47	41233.875	-68119.701	16.540	1-45-24	90-01-50	16.483	-1122817.031583	
55-46	41250.407	-68119.194	1.629	271-49-46	90-04-22	16.584	-1129688.713296	
							倍面積	
							面積	26.9247525


面積計算書 (座標法)

世界測地系 (測地成果2011)

所在	地番	公簿地目	現況地目	地積	所有者
前橋市六供町二丁目	55-4-4			26.66 m ²	

点名	X座標	Y座標	辺長	方向角	測角	DX	倍積 (Y×DX)
55-259	41233.924	-68121.327	8.246	181-45-05	90-01-31	-8.193	558118.032111
55-262	41225.682	-68121.579	8.113	181-44-41	179-59-36	-16.351	1113855.938229
55-221	41217.573	-68121.826	1.628	93-37-37	91-52-56	-8.212	559416.435112
55-49	41217.470	-68120.201	16.269	1-44-50	88-07-13	16.158	-1100686.207758
55-48	41233.731	-68119.705	0.144	1-35-28	179-50-38	16.405	-1117503.760525
55-47	41233.875	-68119.701	1.627	271-43-34	90-08-06	0.193	-13147.102293

倍面積	53.334876
面積	26.6674380

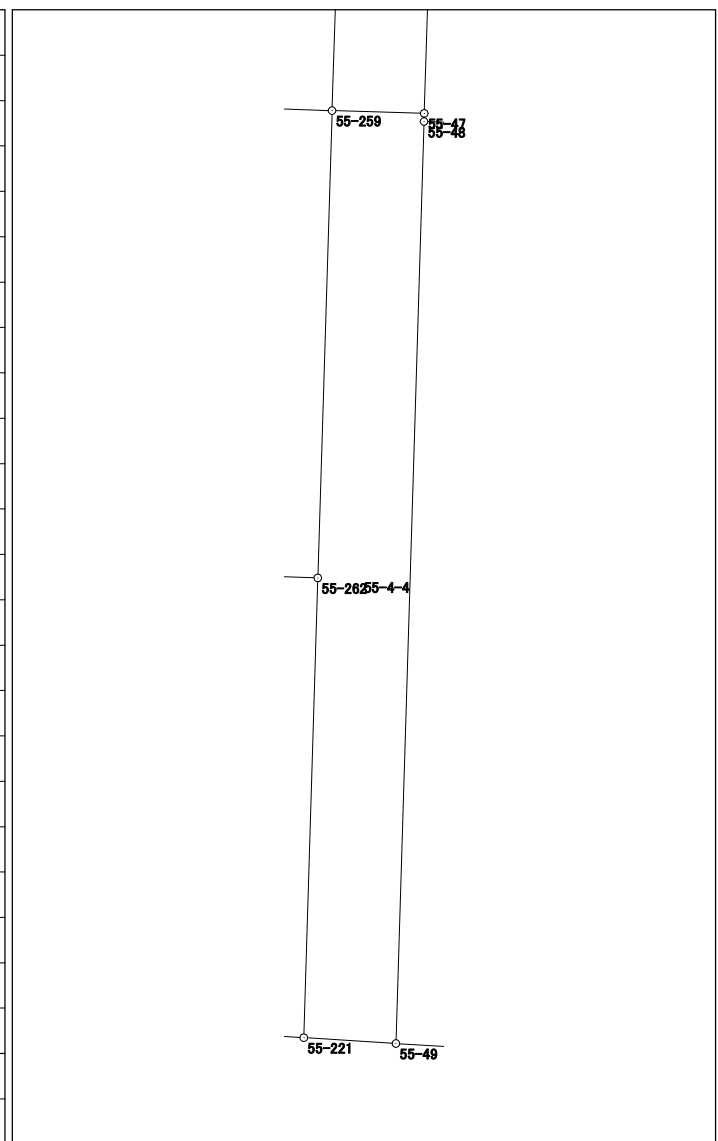


面積計算書 (座標法)

世界測地系 (測地成果2011)

所在	地番	公簿地目	現況地目	地積	所有者
前橋市六供町二丁目	55-5			48.82 m ²	

点名	X座標	Y座標	辺長	方向角	測角	D _X	倍積 (Y×D _X)
55-280	41233.178	-68107.525	16.481	181-43-28	89-54-24	-16.421	1118393.668025
55-279	41216.704	-68108.021	2.956	93-37-38	91-54-10	-16.661	1134747.737881
55-281	41216.517	-68105.071	16.574	1-43-18	88-05-40	16.380	-1115561.062980
55-282	41233.084	-68104.573	1.283	271-49-54	90-06-36	16.608	-1131080.748384
55-271	41233.125	-68105.855	1.671	271-49-04	179-59-10	0.094	-6401.950370

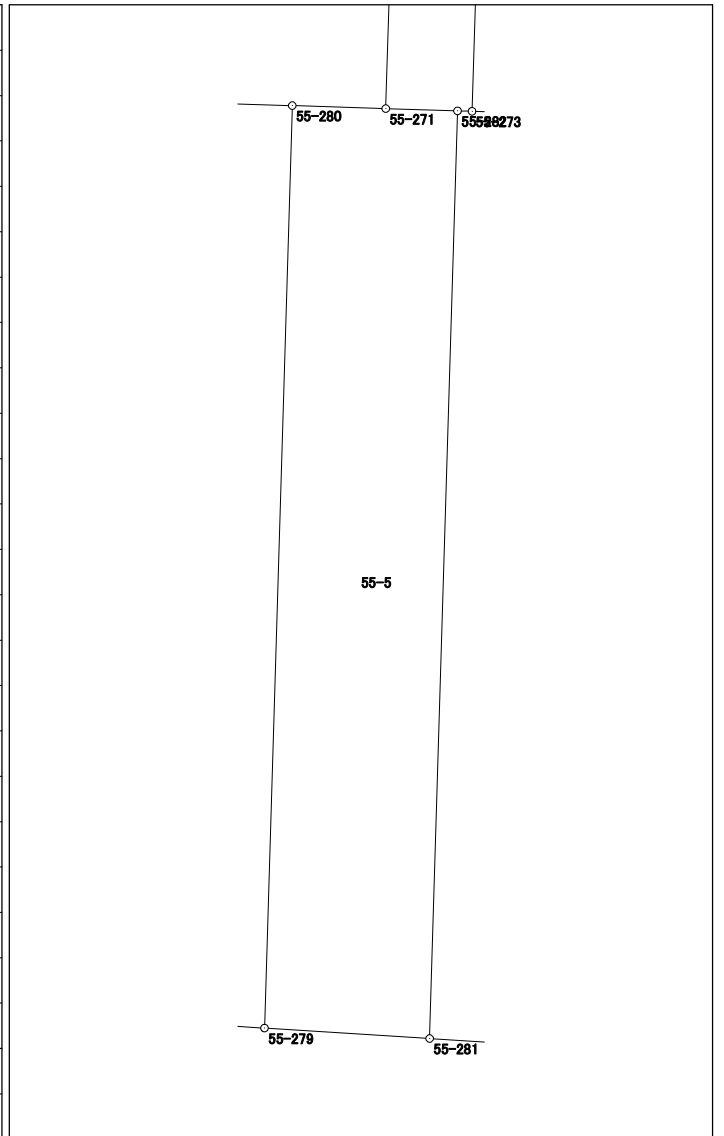


倍面積	97.644172
面積	48.8220860

面積計算書 (座標法)

世界測地系 (測地成果2011)

所 在	地 番	公簿地目	現況地目	地 積	所 有 者
前橋市六供町二丁目	55-6			14.59 m ²	

点 名	X 座標	Y 座標	辺 長	方 向 角	測 角	DX	倍 積 (Y×DX)
55-25	41216.907	-68111.217	1.290	93-38-44	91-55-17	-11.377	774901.315809
55-277	41216.825	-68109.930	11.343	1-43-22	88-04-38	11.256	-766645.372080
55-278	41228.163	-68109.589	1.289	271-44-04	90-00-42	11.377	-774882.794053
55-270	41228.202	-68110.877	11.300	181-43-27	89-59-23	-11.256	766656.031512
倍面積						29.181188	
面 積						14.5905940	

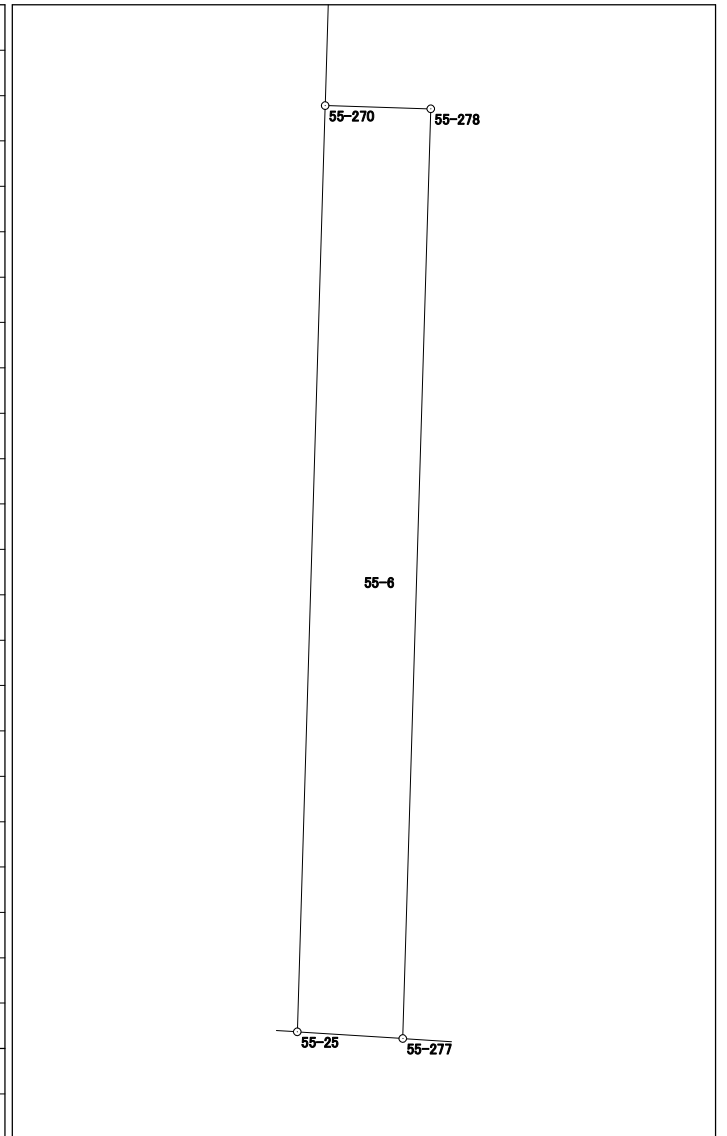


面積計算書 (座標法)

世界測地系 (測地成果2011)

所在	地番	公簿地目	現況地目	地積	所有者
前橋市六供町二丁目	55-7-2			155.01 m ²	


点名	X座標	Y座標	辺長	方向角	測角	Dx	倍積 (Y×Dx)
55-282	41233.084	-68104.573	16.574	181-43-18	89-57-09	-16.559	1127743.624307
55-281	41216.517	-68105.071	9.269	93-37-30	91-54-12	-17.153	1168206.282863
55-23	41215.931	-68095.821	16.868	1-46-12	88-08-42	16.274	-1108191.390954
55-52	41232.791	-68095.300	1.905	271-48-18	90-02-06	16.920	-1152172.476000
55-275	41232.851	-68097.204	7.114	271-48-45	180-00-27	0.285	-19407.703140
55-273	41233.076	-68104.314	0.259	271-46-09	179-57-24	0.233	-15868.305162
						倍面積	310.031914
						面積	155.0159570

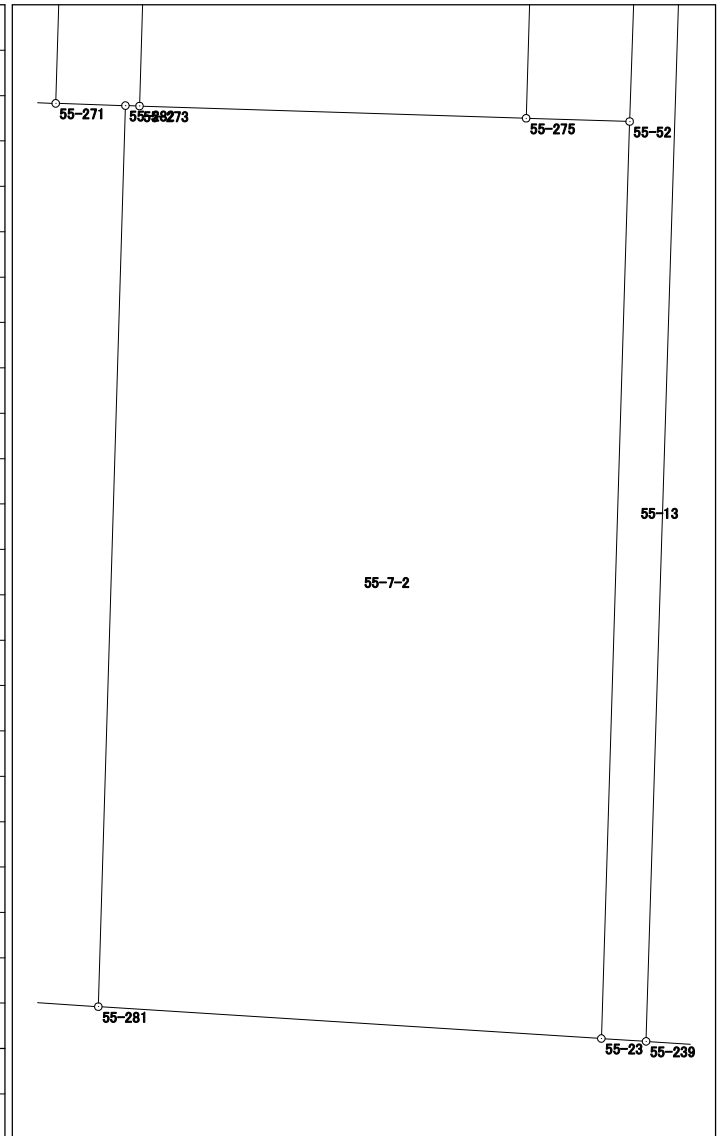

面積計算書（座標法）

世界測地系（測地成果2011）

所 在	地 番	公簿地目	現況地目	地 積	所 有 者
前橋市六供町二丁目	55-10			142.11 m ²	

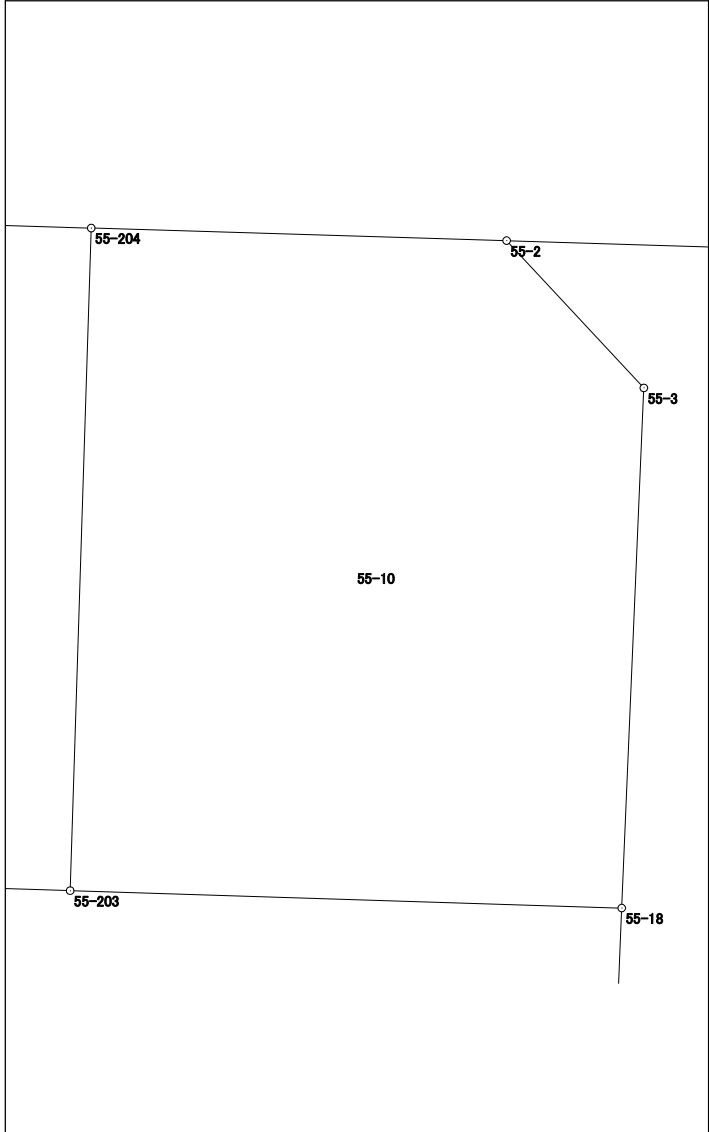
点 名	X 座標	Y 座標	辺 長	方 向 角	測 角	DX	倍 積 (Y×DX)			
55-203	41234.762	-68040.881	10.994	91-48-12	89-58-50	-13.544	921545.692264			
55-18	41234.416	-68029.892	10.369	2-25-55	90-37-43	10.014	-681251.338488			
55-3	41244.776	-68029.452	4.010	317-01-15	134-35-20	13.294	-904383.534888			
55-2	41247.710	-68032.186	8.279	271-43-50	134-42-35	3.184	-216614.480224			
55-204	41247.960	-68040.461	13.205	181-49-22	90-05-32	-12.948	880987.889028			
							倍面積	284.227692		
							面 積	142.1138460		

面積計算書（座標法）

世界測地系（測地成果2011）

所 在	地 番	公簿地目	現況地目	地 積	所 有 者
前橋市六供町二丁目	55-11			273.55 m ²	

点 名	X 座標	Y 座標	辺 長	方 向 角	測 角	DX	倍 積 (Y×DX)
55-205	41216.469	-68030.640	17.963	2-23-12	88-49-10	16.992	-1155976.634880
55-18	41234.416	-68029.892	10.994	271-48-12	89-25-00	18.293	-1244470.814356
55-203	41234.762	-68040.881	4.545	271-48-10	179-59-58	0.489	-33271.990809
55-32	41234.905	-68045.424	4.472	181-31-30	89-43-20	-4.327	294432.549648
55-103	41230.435	-68045.543	13.018	181-49-53	180-18-23	-17.481	1189504.137183
55-206	41217.424	-68045.959	15.349	93-34-02	91-44-09	-13.966	950329.863394
						倍面積	547.110180
						面 積	273.5550900

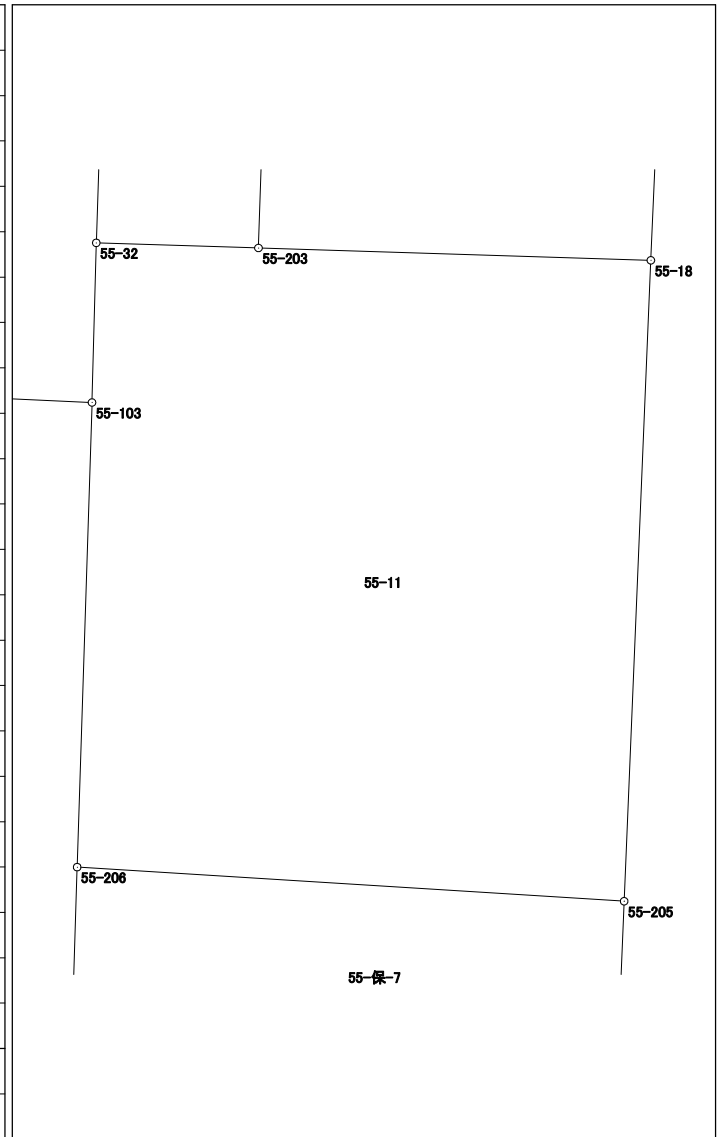


面積計算書（座標法）

世界測地系（測地成果2011）

所在	地番	公簿地目	現況地目	地積	所有者
前橋市六供町二丁目	55-12			458.00 m ²	

点名	X座標	Y座標	辺長	方向角	測角	DX	倍積(Y×DX)
55-239	41215.879	-68094.998	22.744	93-36-44	91-49-10	-21.210	1444294.907580
55-210	41214.446	-68072.299	20.508	1-49-19	88-12-35	19.065	-1297798.380435
55-209	41234.944	-68071.647	10.083	271-44-21	89-55-02	20.804	-1416162.544188
55-118	41235.250	-68081.725	0.429	271-52-09	180-07-48	0.320	-21786.152000
55-212	41235.264	-68082.154	1.221	271-49-51	179-57-42	0.053	-3608.354162
55-257	41235.303	-68083.374	0.292	271-45-55	179-56-04	0.048	-3268.001952
55-255	41235.312	-68083.666	0.929	271-50-59	180-05-04	0.039	-2655.262974
55-253	41235.342	-68084.595	3.921	271-50-29	179-59-30	0.156	-10621.196820
55-251	41235.468	-68088.514	0.429	271-52-09	180-01-40	0.140	-9532.391960
55-249	41235.482	-68088.943	1.692	271-49-45	179-57-36	0.068	-4630.048124
55-247	41235.536	-68090.634	0.215	271-51-53	180-02-08	0.061	-4153.528674
55-245	41235.543	-68090.849	1.411	271-49-41	179-57-48	0.052	-3540.724148
55-243	41235.588	-68092.259	0.429	271-52-09	180-02-28	0.059	-4017.443281
55-241	41235.602	-68092.688	1.692	271-49-45	179-57-36	0.068	-4630.302784
55-240	41235.656	-68094.379	19.787	181-47-34	89-57-49	-19.723	1343025.437017
						倍面積	916.013095
						面積	458.0065475

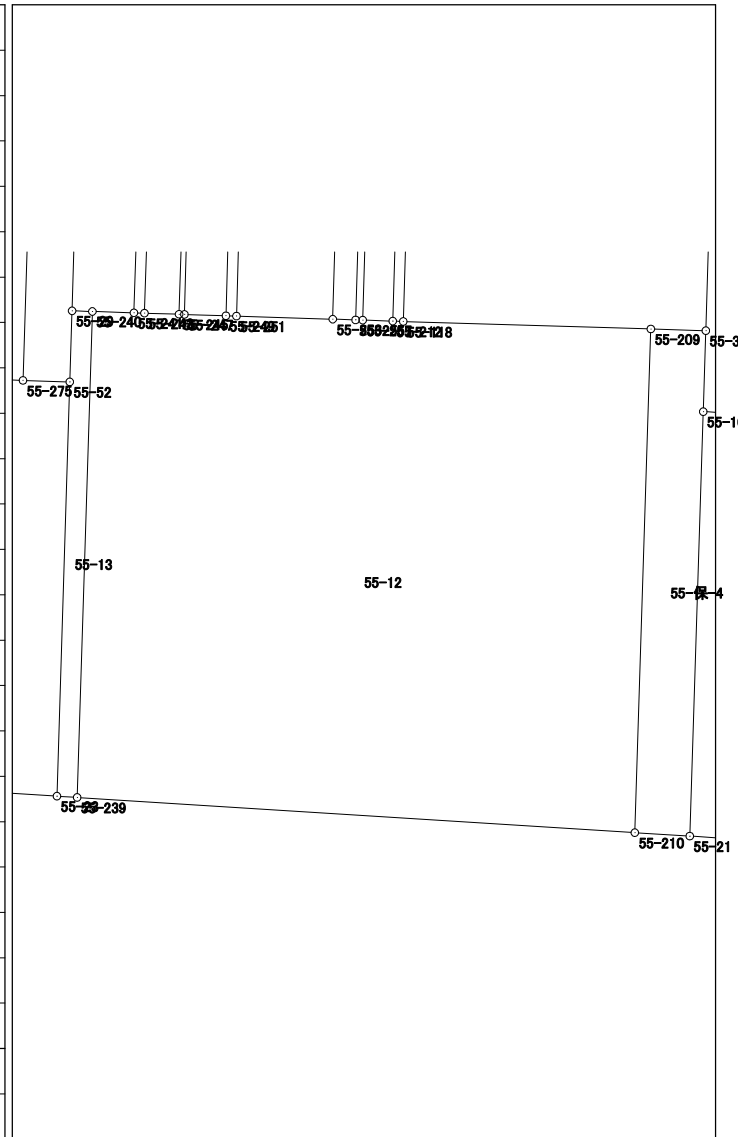


面積計算書（座標法）

世界測地系（測地成果2011）

所 在	地 番	公簿地目	現況地目	地 積	所 有 者
前橋市六供町二丁目	55-13			16.36 m ²	

点 名	X 座標	Y 座標	辺 長	方 向 角	測 角	DX	倍 積 (Y×DX)
55-23	41215.931	-68095.821	0.825	93-36-55	91-50-43	-16.912	1151636.524752
55-239	41215.879	-68094.998	19.787	1-47-34	88-10-39	19.725	-1343173.835550
55-240	41235.656	-68094.379	0.824	271-48-26	90-00-52	19.803	-1348472.987337
55-29	41235.682	-68095.203	2.893	181-55-18	90-06-52	-2.865	195092.756595
55-52	41232.791	-68095.300	16.868	181-46-12	179-50-54	-19.751	1344950.270300
						倍面積	32.728760
						面 積	16.3643800

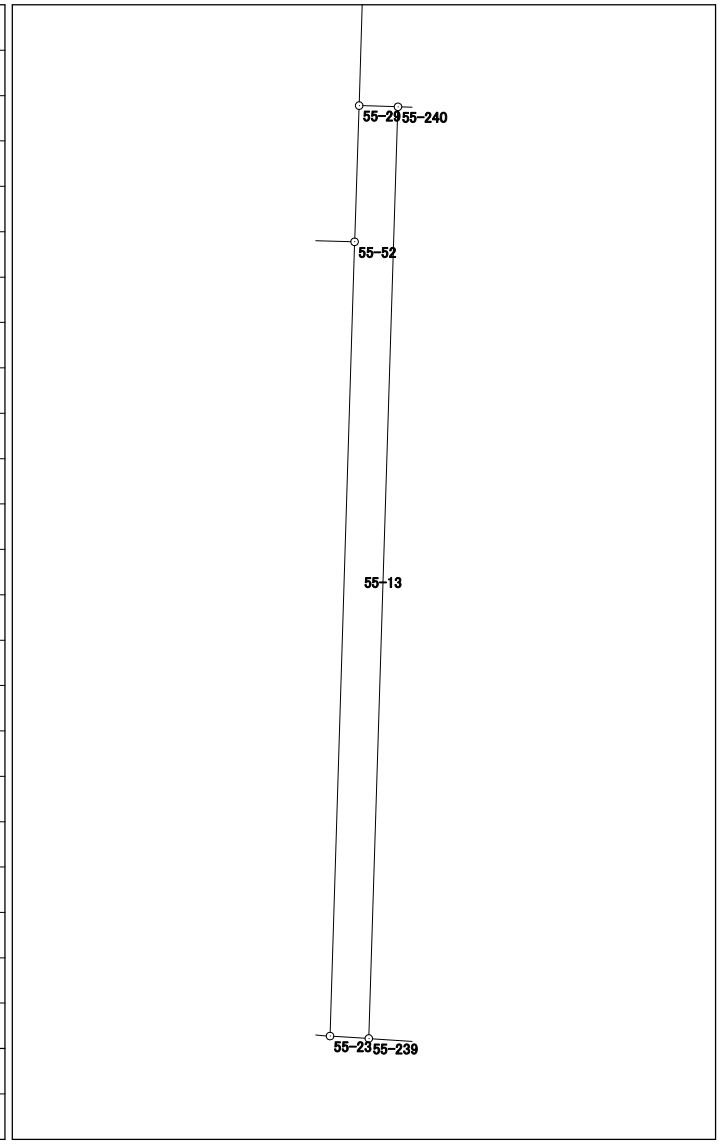


面積計算書 (座標法)

世界測地系 (測地成果2011)

所在	地番	公簿地目	現況地目	地積	所有者
前橋市六供町二丁目	55-14			119.99 m ²	

点名	X座標	Y座標	辺長	方向角	測角	DX	倍積 (Y×DX)
55-273	41233.076	-68104.314	7.114	91-48-45	90-02-21	-17.084	1163494.100376
55-275	41232.851	-68097.204	16.872	1-46-10	89-57-25	16.639	-1133069.377356
55-276	41249.715	-68096.683	7.112	271-46-21	90-00-11	17.084	-1163363.732372
55-274	41249.935	-68103.792	16.867	181-46-24	90-00-03	-16.639	1133178.995088
						倍面積	239.985736
						面積	119.9928680

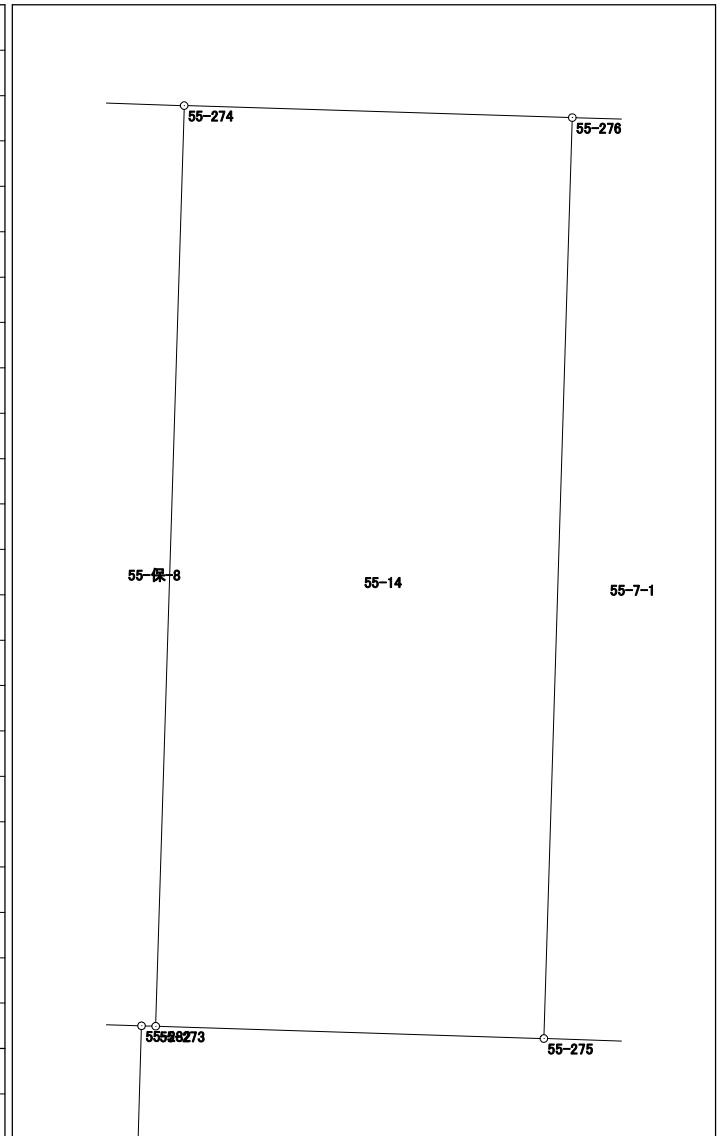


面積計算書（座標法）

世界測地系（測地成果2011）

所 在	地 番	公簿地目	現況地目	地 積	所 有 者
前橋市六供町二丁目	55-15			35.18 m ²	

点 名	X 座標	Y 座標	辺 長	方 向 角	測 角	DX	倍 積 (Y×DX)
55-14	41249.656	-68094.780	13.980	181-44-02	89-57-27	-13.896	946245.062880
55-29	41235.682	-68095.203	0.824	91-48-26	90-04-24	-14.000	953332.842000
55-240	41235.656	-68094.379	1.692	91-49-45	180-01-19	-0.080	5447.550320
55-241	41235.602	-68092.688	13.982	1-44-01	89-54-16	13.922	-947986.402336
55-242	41249.578	-68092.265	2.516	271-46-35	90-02-34	14.054	-956968.692310
						倍面積	70.360554
						面 積	35.1802770

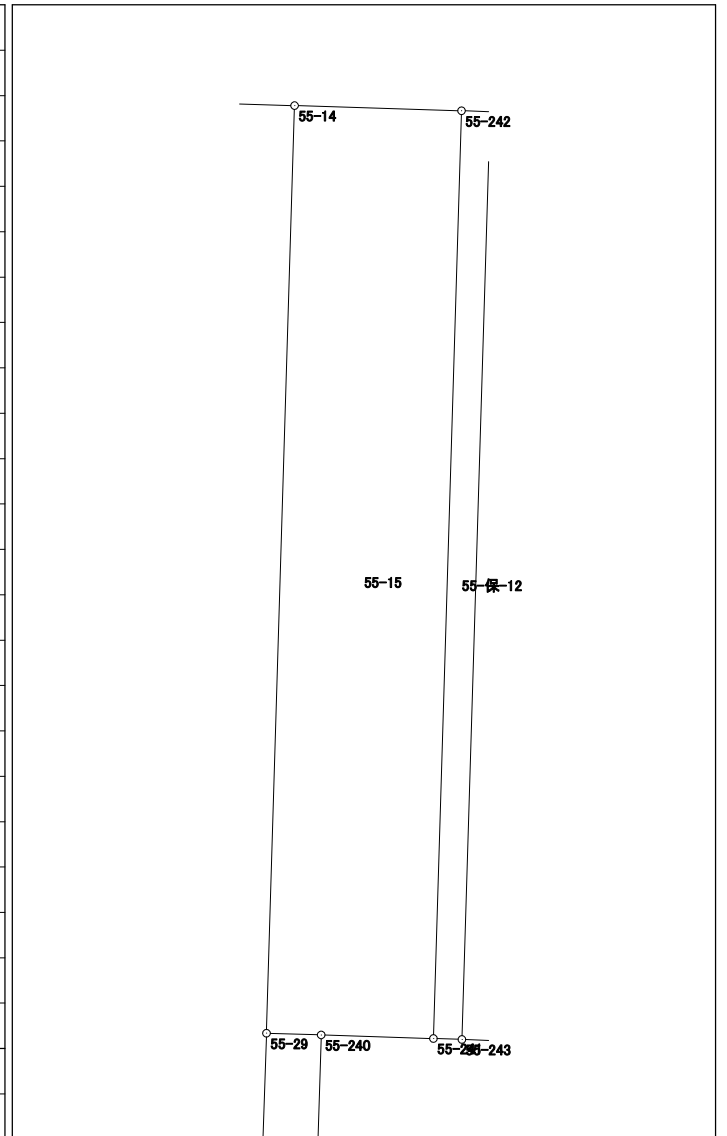


面積計算書（座標法）

世界測地系（測地成果2011）

所 在	地 番	公簿地目	現況地目	地 積	所 有 者
前橋市六供町二丁目	55-16			19.73 m ²	

点 名	X 座標	Y 座標	辺 長	方 向 角	測 角	DX	倍 積 (Y×DX)
55-244	41249.565	-68091.836	13.983	181-44-00	89-56-50	-13.933	948723.550988
55-243	41235.588	-68092.259	1.411	91-49-41	90-05-41	-14.022	954789.655698
55-245	41235.543	-68090.849	13.984	1-44-15	89-54-34	13.933	-948709.799117
55-246	41249.521	-68090.425	1.412	271-47-10	90-02-55	14.022	-954763.939350
倍面積						39.468219	
面 積						19.7341095	

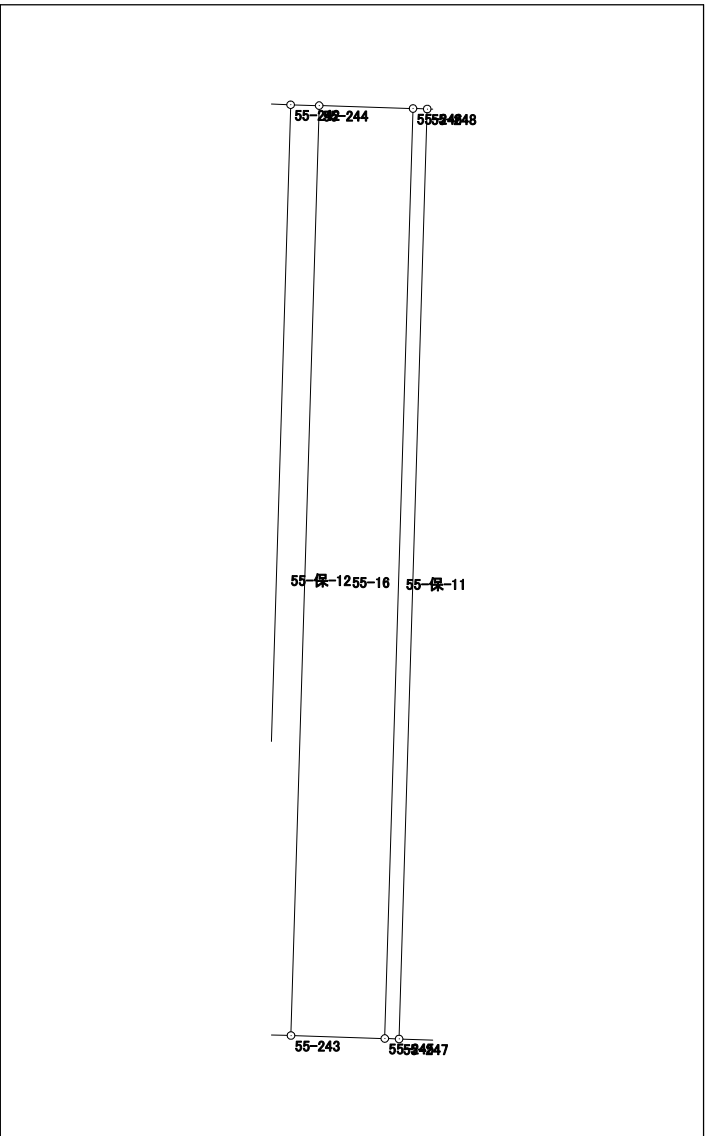


面積計算書 (座標法)

世界測地系 (測地成果2011)

所在	地番	公簿地目	現況地目	地積	所有者
前橋市六供町二丁目	55-17			23.66 m ²	

点名	X座標	Y座標	辺長	方向角	測角	DX	倍積 (Y×DX)
55-248	41249.514	-68090.211	13.984	181-44-00	89-56-21	-13.925	948156.188175
55-247	41235.536	-68090.634	1.692	91-49-45	90-05-45	-14.032	955447.776288
55-249	41235.482	-68088.943	13.985	1-44-14	89-54-29	13.925	-948138.531275
55-250	41249.461	-68088.519	1.693	271-47-39	90-03-25	14.032	-955418.098608

倍面積	47.334580
面積	23.6672900

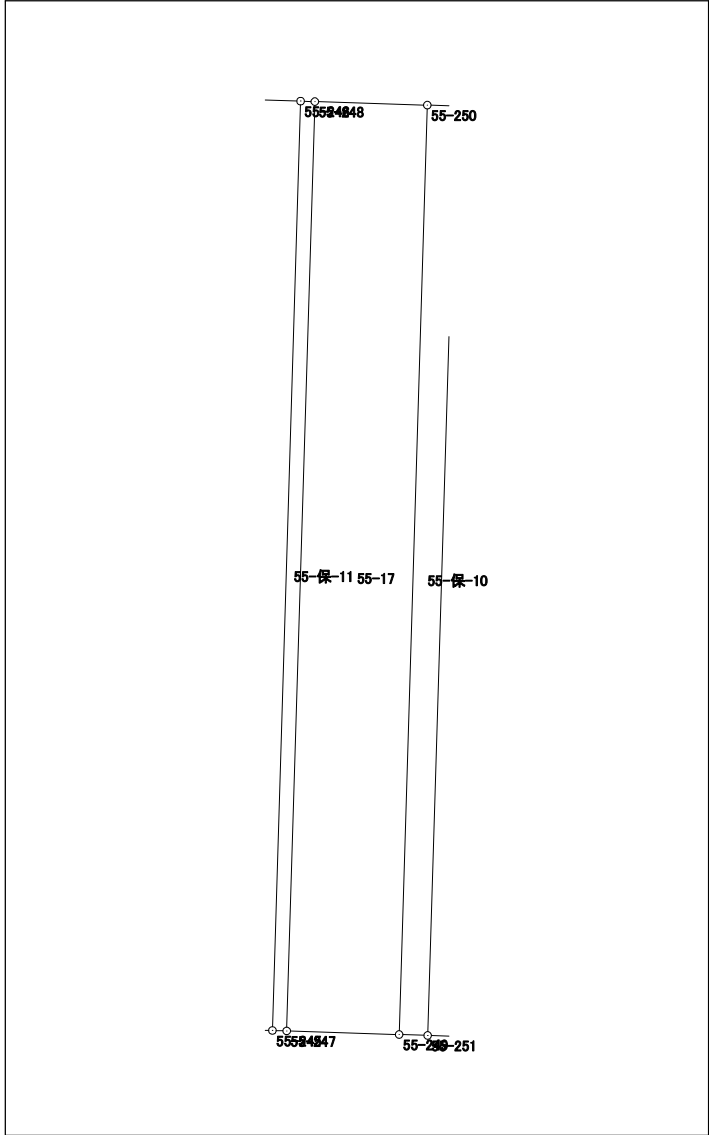


面積計算書（座標法）

世界測地系（測地成果2011）

所 在	地 番	公簿地目	現況地目	地 積	所 有 者
前橋市六供町二丁目	55-18			54.84 m ²	

点 名	X 座標	Y 座標	辺 長	方 向 角	測 角	DX	倍 積 (Y×DX)
55-251	41235.468	-68088.514	3.921	91-50-29	90-06-15	-14.106	960456.578484
55-253	41235.342	-68084.595	13.990	1-43-57	89-53-28	13.858	-943516.317510
55-254	41249.326	-68084.172	3.920	271-47-01	90-03-04	14.106	-960395.330232
55-252	41249.448	-68088.090	13.986	181-44-14	89-57-13	-13.858	943564.751220

倍面積	109.681962
面 積	54.8409810

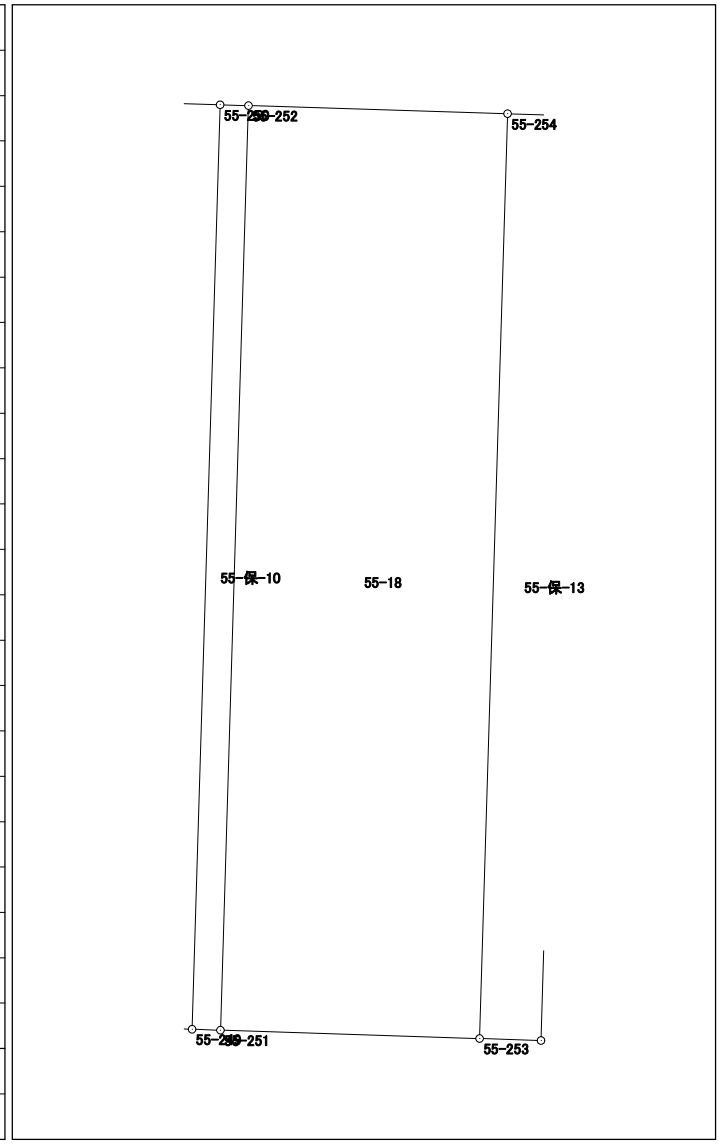


面積計算書（座標法）

世界測地系（測地成果2011）

所在	地番	公簿地目	現況地目	地積	所有者
前橋市六供町二丁目	55-20			37.99 m ²	

点名	X座標	Y座標	辺長	方向角	測角	DX	倍積(Y×DX)
55-270	41228.202	-68110.877	1.289	91-44-04	90-00-30	-5.116	348455.246732
55-278	41228.163	-68109.589	11.343	181-43-22	269-59-18	-11.377	774882.794053
55-277	41216.825	-68109.930	1.913	93-37-36	91-54-14	-11.459	780471.687870
55-279	41216.704	-68108.021	16.481	1-43-28	88-05-52	16.353	-1113770.467413
55-280	41233.178	-68107.525	3.201	271-48-30	90-05-02	16.575	-1128882.226875
55-51	41233.279	-68110.724	5.079	181-43-34	89-55-04	-4.976	338918.962624

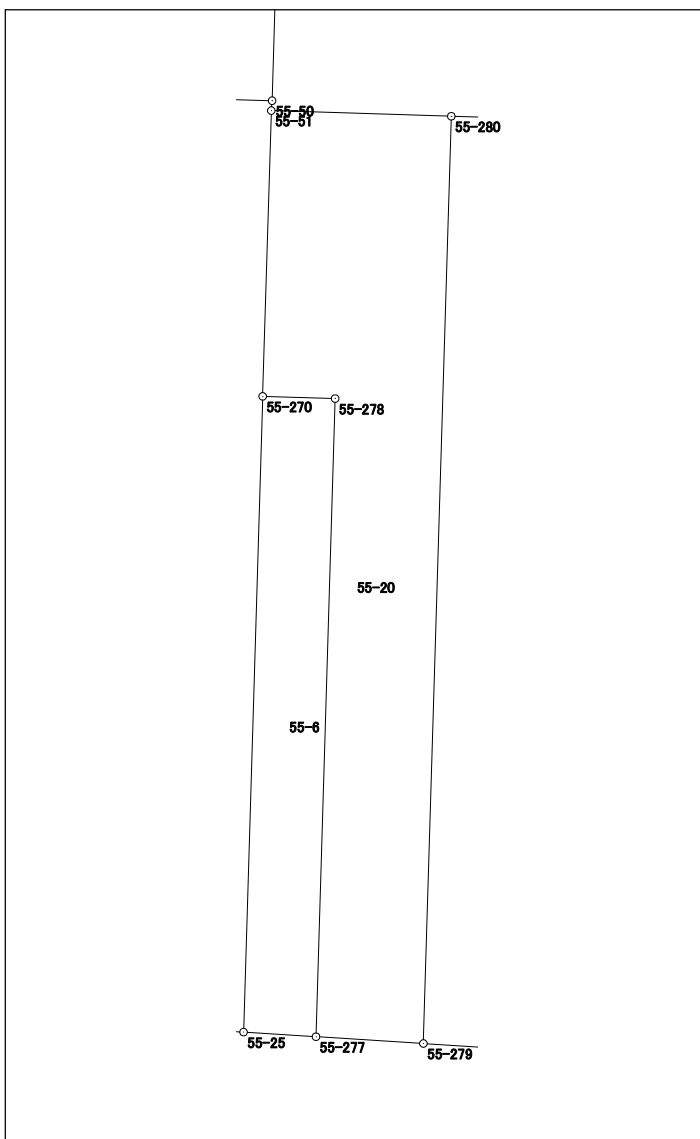


倍面積	75.996991
面積	37.9984955

面積計算書（座標法）

世界測地系（測地成果2011）

所 在	地 番	公簿地目	現況地目	地 積	所 有 者
前橋市六供町二丁目	55-23			118.55 m ²	

点 名	X 座標	Y 座標	辺 長	方 向 角	測 角	DX	倍 積 (Y×DX)
55-207	41248.261	-68050.176	6.758	271-48-52	90-04-06	17.796	-1211020.932096
55-105	41248.475	-68056.931	17.485	181-45-24	89-56-32	-17.263	1174866.799853
55-106	41230.998	-68057.467	6.763	92-42-13	90-56-49	-17.796	1211150.682732
55-208	41230.679	-68050.712	17.590	1-44-46	89-02-33	17.263	-1174759.441256
						倍面積	237.109233
						面 積	118.5546165

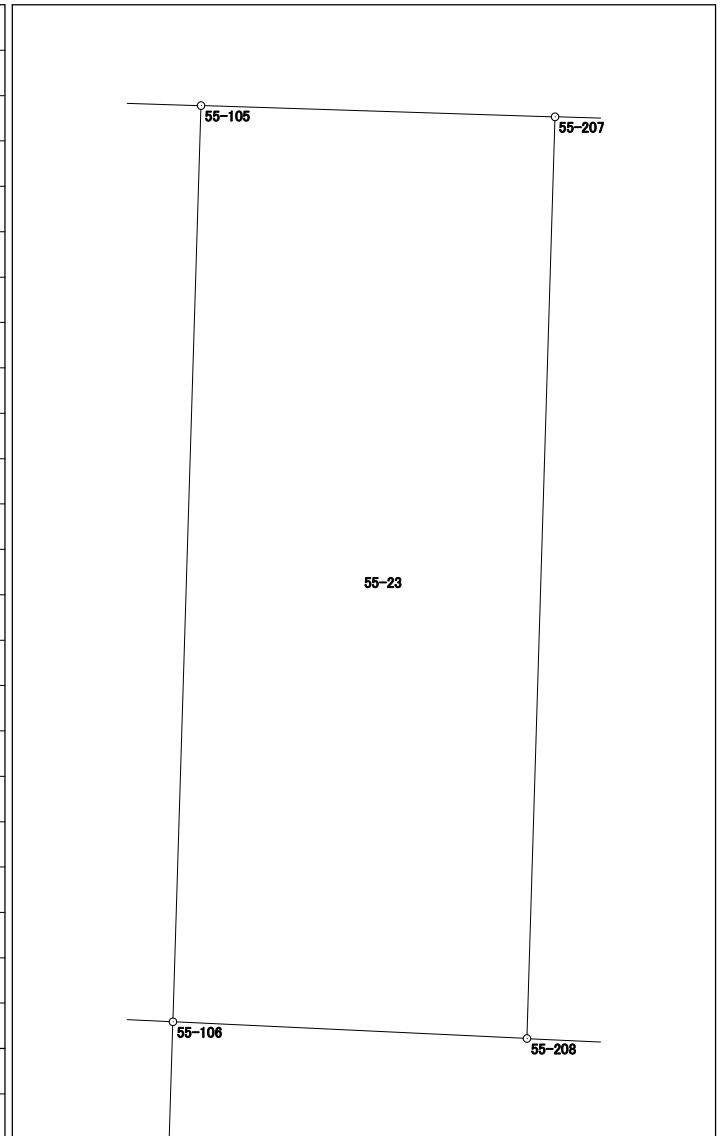


面積計算書（座標法）

世界測地系（測地成果2011）

所在	地番	公簿地目	現況地目	地積	所有者
前橋市六供町二丁目	55-24			183.53 m ²	

点名	X座標	Y座標	辺長	方向角	測角	DX	倍積 (Y×DX)
55-216	41213.229	-68053.024	6.931	93-36-54	89-59-50	-5.530	376333.222720
55-19	41212.792	-68046.107	4.634	1-49-48	88-12-54	4.195	-285453.418865
55-206	41217.424	-68045.959	13.018	1-49-53	180-00-05	17.643	-1200534.854637
55-103	41230.435	-68045.543	5.175	272-42-09	90-52-16	13.255	-901943.672465
55-208	41230.679	-68050.712	6.763	272-42-13	180-00-04	0.563	-38312.550856
55-106	41230.998	-68057.467	12.356	181-47-41	89-05-28	-12.031	818799.385477
55-218	41218.648	-68057.854	5.162	93-37-14	91-49-33	-12.676	862701.357304
55-217	41218.322	-68052.702	5.103	183-37-04	269-59-50	-5.419	368777.592138

倍面積	367.060816
面積	183.5304080

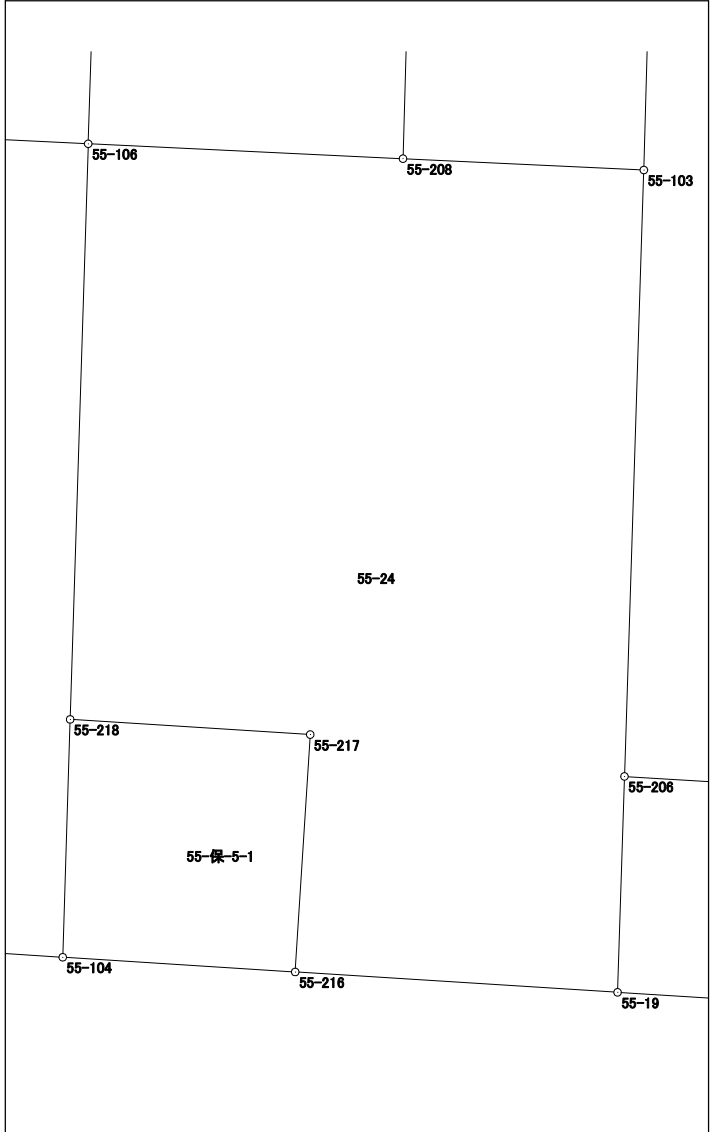


面積計算書（座標法）

世界測地系（測地成果2011）

所在	地番	公簿地目	現況地目	地積	所有者
前橋市六供町二丁目	55-25			209.56 m ²	

点名	X座標	Y座標	辺長	方向角	測角	D _X	倍積 (Y×D _X)
55-102	41231.579	-68069.514	17.283	181-49-13	89-03-33	-16.693	1136284.397202
55-21	41214.305	-68070.063	12.073	93-36-50	91-47-37	-18.035	1227643.586205
55-104	41213.544	-68058.014	5.107	1-47-44	88-10-54	4.343	-295575.954802
55-218	41218.648	-68057.854	12.356	1-47-41	179-59-57	17.454	-1187881.783716
55-106	41230.998	-68057.467	12.061	272-45-40	90-57-59	12.931	-880051.105777

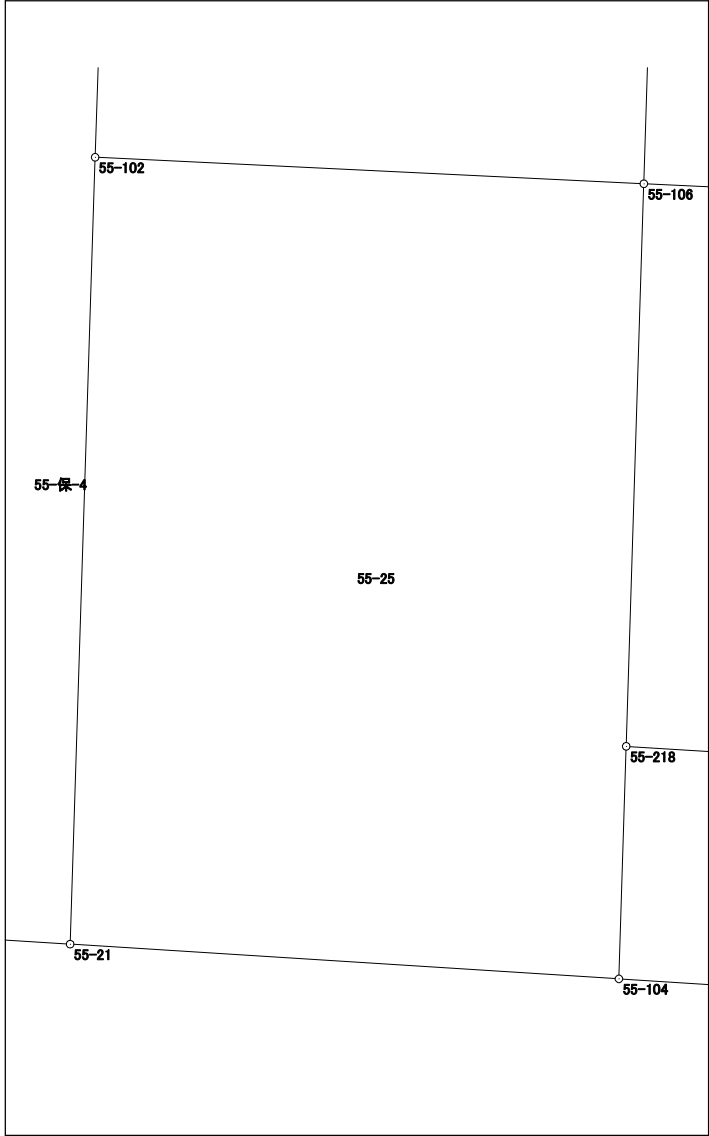


倍面積	419.139112
面積	209.5695560

面積計算書（座標法）

世界測地系（測地成果2011）

所在	地番	公簿地目	現況地目	地積	所有者
前橋市六供町二丁目	55-26			17.19 m ²	

点名	X座標	Y座標	辺長	方向角	測角	DX	倍積 (Y×DX)
55-257	41235.303	-68083.374	1.221	91-49-51	90-05-54	-14.024	954801.236976
55-212	41235.264	-68082.154	13.992	1-47-53	89-58-02	13.946	-949473.719684
55-211	41249.249	-68081.715	1.237	271-48-26	90-00-33	14.024	-954777.971160
55-258	41249.288	-68082.951	13.991	181-43-57	89-55-31	-13.946	949484.834646
倍面積							34.380778
面積							17.1903890

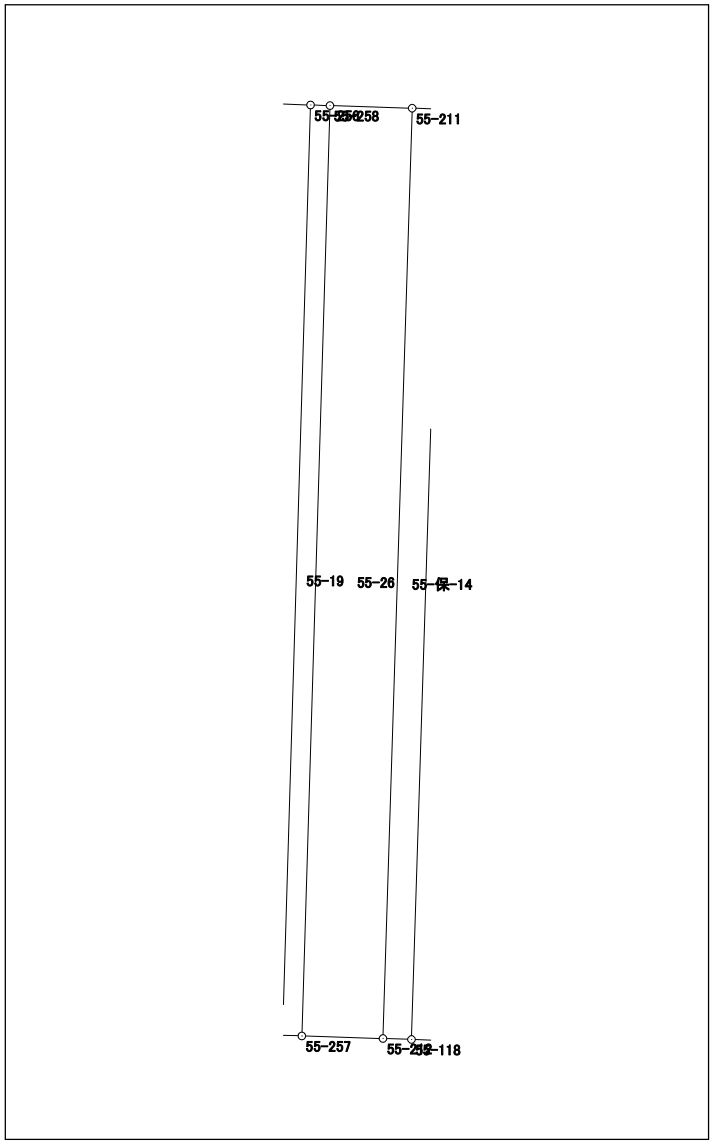


面積計算書 (座標法)

世界測地系 (測地成果2011)

所在	地番	公簿地目	現況地目	地積	所有者
前橋市六供町二丁目	55-保-1			122.00 m ²	

点名	X座標	Y座標	辺長	方向角	測角	DX	倍積 (Y×DX)
55-230	41250.972	-68137.212	32.395	181-44-52	89-56-03	-32.261	2198174.596332
55-229	41218.592	-68138.200	3.761	93-32-11	91-47-19	-32.612	2222122.978400
55-231	41218.360	-68134.446	32.508	1-44-55	88-12-44	32.261	-2198085.362406
55-232	41250.853	-68133.454	3.760	271-48-49	90-03-54	32.612	-2221968.201848
倍面積							244.010478
面積							122.0052390

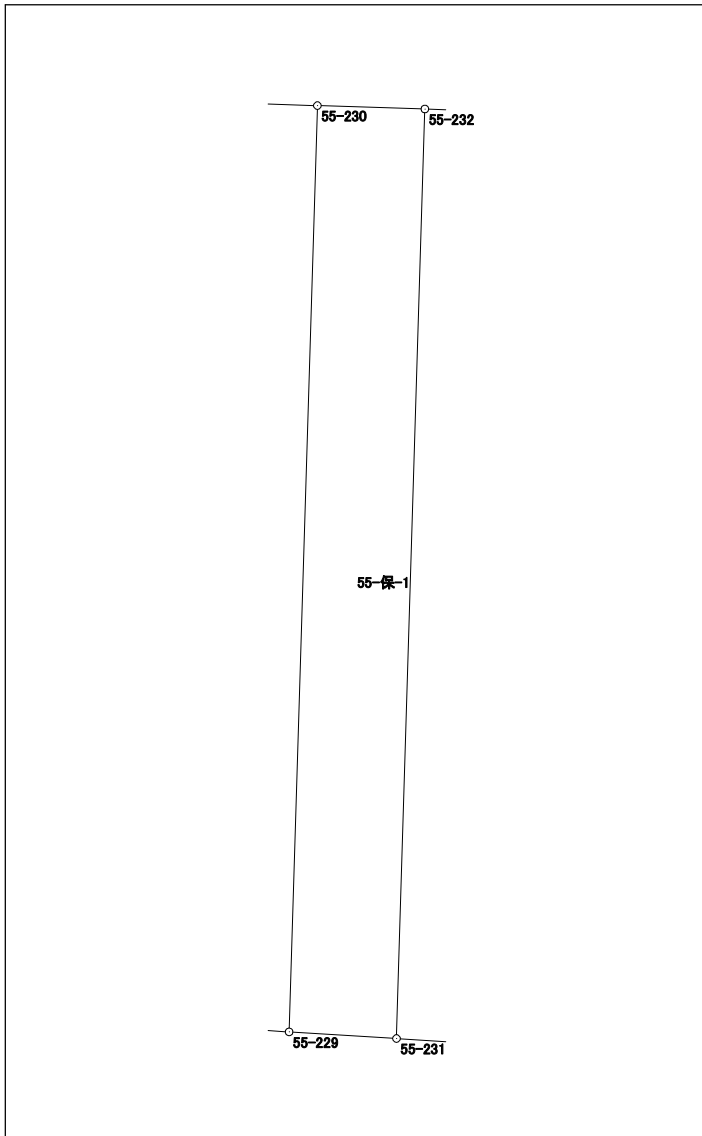


面積計算書 (座標法)

世界測地系 (測地成果2011)

所在	地番	公簿地目	現況地目	地積	所有者
前橋市六供町二丁目	55-保-2-1			59.50 m ²	

点名	X座標	Y座標	辺長	方向角	測角	DX	倍積 (Y×DX)
55-261	41242.135	-68128.526	7.990	181-45-52	90-01-59	-7.761	528745.490286
55-41	41234.149	-68128.772	7.448	91-43-52	89-58-00	-8.211	559405.346892
55-259	41233.924	-68121.327	7.990	1-45-00	90-01-08	7.761	-528689.618847
55-260	41241.910	-68121.083	7.446	271-43-53	89-58-53	8.211	-559342.212513

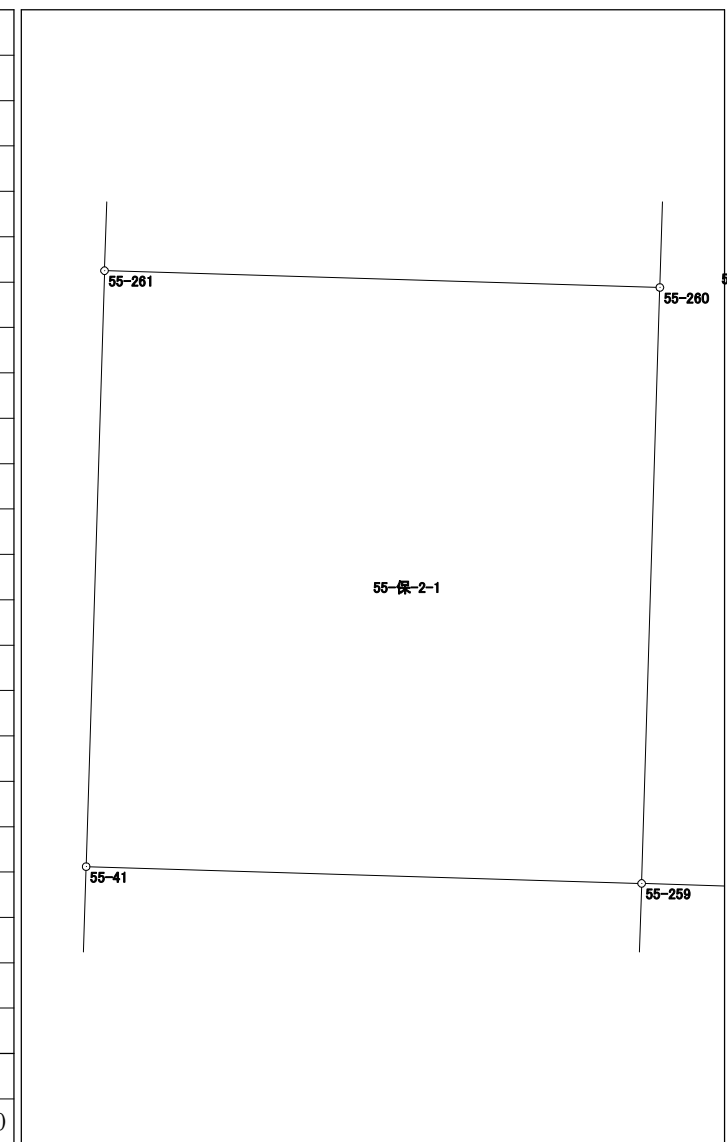


倍面積	119.005818
面積	59.5029090

面積計算書 (座標法)

世界測地系 (測地成果2011)

所 在	地 番	公簿地目	現況地目	地 積	所 有 者
前橋市六供町二丁目	55-保-2-2			59.50 m ²	

点 名	X 座標	Y 座標	辺 長	方 向 角	測 角	DX	倍 積 (Y×DX)
55-263	41225.906	-68129.022	7.871	181-43-58	90-00-32	-7.643	520710.115146
55-27	41218.039	-68129.260	7.449	93-35-13	91-51-15	-8.333	567721.123580
55-221	41217.573	-68121.826	8.113	1-44-41	88-09-28	7.643	-520655.116118
55-262	41225.682	-68121.579	7.446	271-43-26	89-58-45	8.333	-567657.117807

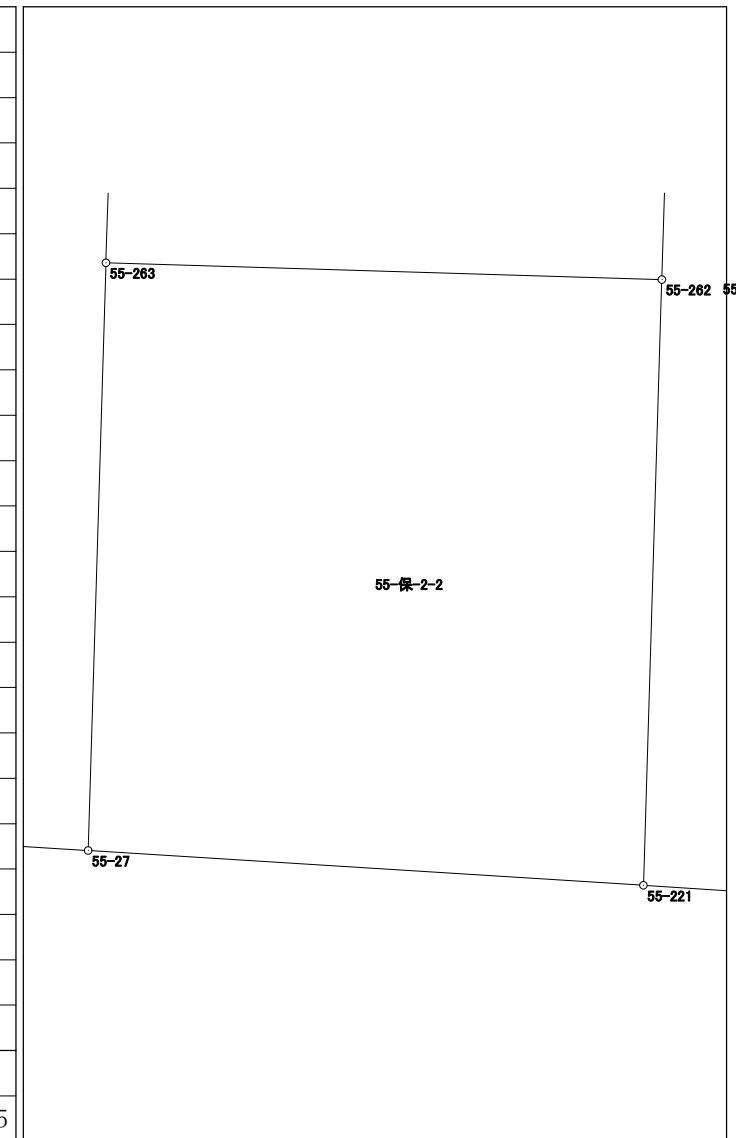


倍面積	119.004801
面 積	59.5024005

面積計算書（座標法）

世界測地系（測地成果2011）

所 在	地 番	公簿地目	現況地目	地 積	所 有 者
前橋市六供町二丁目	55-保-4			46.00 m ²	

点 名	X 座標	Y 座標	辺 長	方 向 角	測 角	DX	倍 積 (Y×DX)
55-21	41214.305	-68070.063	17.283	1-49-13	88-12-43	17.133	-1166244.389379
55-102	41231.579	-68069.514	3.299	1-50-29	180-01-16	20.571	-1400257.972494
55-31	41234.876	-68069.408	2.240	271-44-22	89-53-53	3.365	-229053.557920
55-209	41234.944	-68071.647	20.508	181-49-19	90-04-57	-20.430	1390703.748210
55-210	41214.446	-68072.299	2.240	93-36-30	91-47-11	-20.639	1404944.179061
倍面積							92.007478
面 積							46.0037390

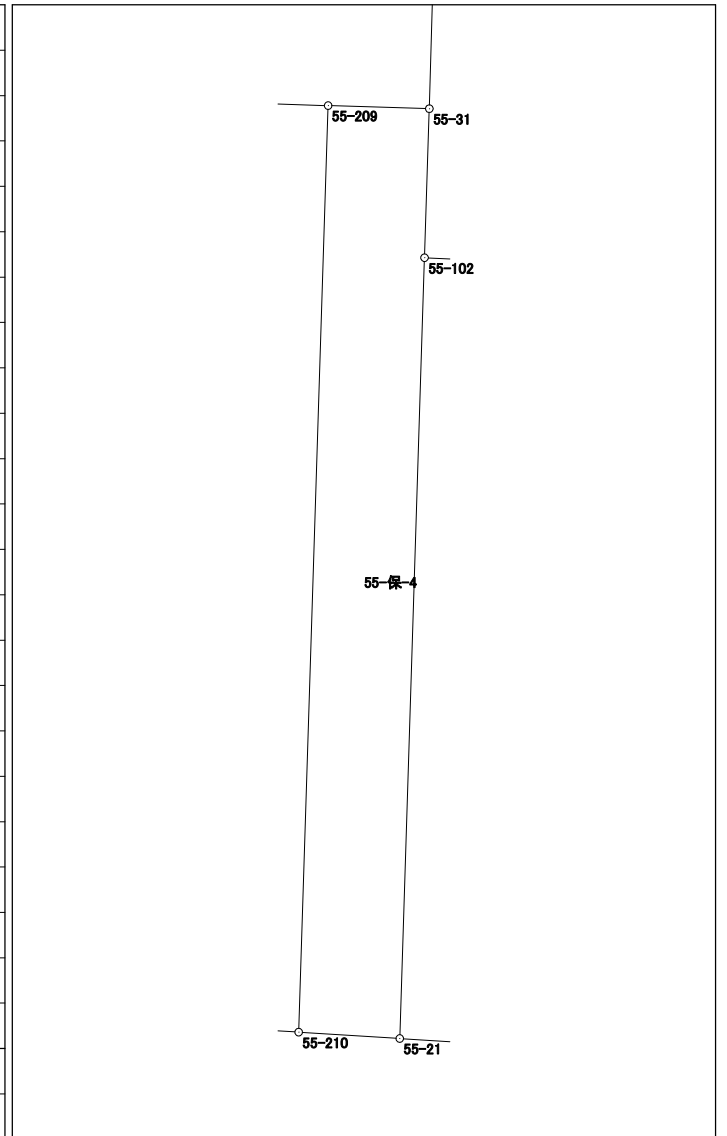


面積計算書 (座標法)

世界測地系 (測地成果2011)

所 在	地 番	公簿地目	現況地目	地 積	所 有 者
前橋市六供町二丁目	55-保-5-1			25.93 m ²	

点 名	X 座標	Y 座標	辺 長	方 向 角	測 角	DX	倍 積 (Y×DX)
55-216	41213.229	-68053.024	5.103	3-37-04	90-00-21	4.778	-325157.348672
55-217	41218.322	-68052.702	5.162	273-37-14	90-00-10	5.419	-368777.592138
55-218	41218.648	-68057.854	5.107	181-47-44	88-10-30	-4.778	325180.426412
55-104	41213.544	-68058.014	5.000	93-36-43	91-48-59	-5.419	368806.377866
						倍面積	51.863468
						面 積	25.9317340

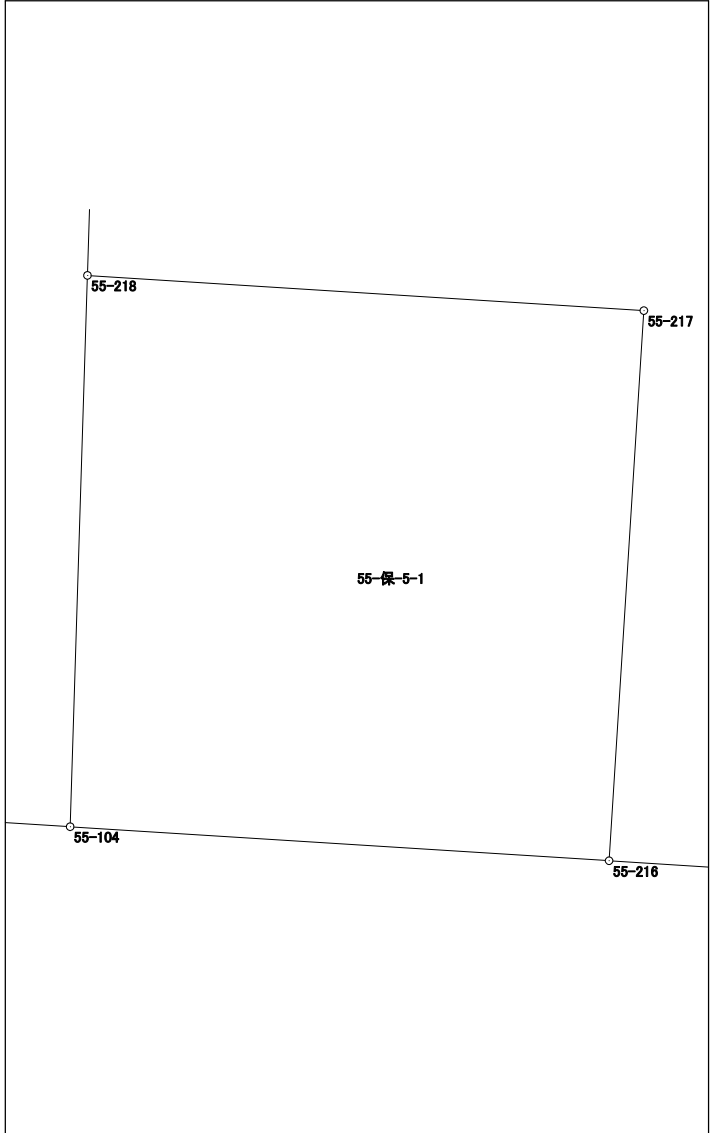


面積計算書 (座標法)

世界測地系 (測地成果2011)

所 在	地 番	公簿地目	現況地目	地 積	所 有 者
前橋市六供町二丁目	55-保-5-2			91.07 m ²	

点 名	X 座標	Y 座標	辺 長	方 向 角	測 角	DX	倍 積 (Y×DX)	
55-103	41230.435	-68045.543	4.472	1-31-30	88-49-21	4.226	-287560.464718	
55-32	41234.905	-68045.424	13.200	1-49-24	180-17-54	17.663	-1201886.324112	
55-17	41248.098	-68045.004	5.175	271-48-18	89-58-54	13.356	-908809.073424	
55-207	41248.261	-68050.176	17.590	181-44-46	89-56-28	-17.419	1185366.015744	
55-208	41230.679	-68050.712	5.175	92-42-09	90-57-23	-17.826	1213071.992112	
							倍面積	182.145602
							面 積	91.0728010

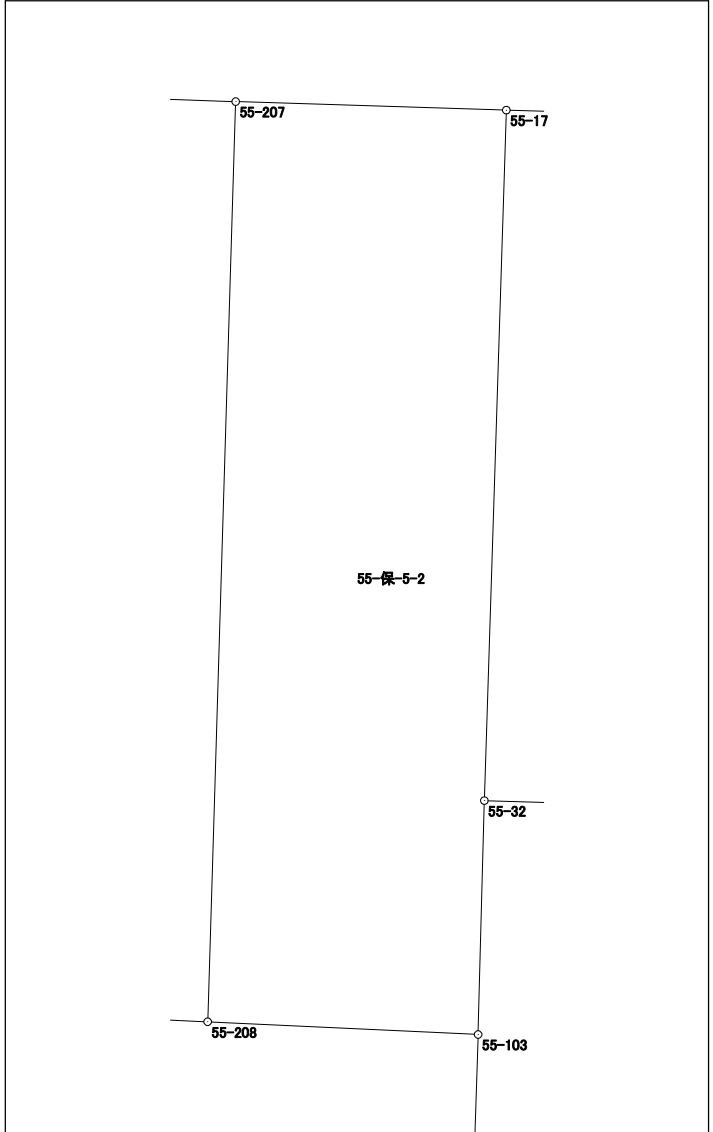


面積計算書（座標法）

世界測地系（測地成果2011）

所在	地番	公簿地目	現況地目	地積	所有者
前橋市六供町二丁目	55-保-6			60.00 m ²	

点名	X座標	Y座標	辺長	方向角	測角	DX	倍積(Y×DX)
55-17	41248.098	-68045.004	13.200	181-49-24	90-05-00	-13.055	888327.527220
55-32	41234.905	-68045.424	4.545	91-48-10	89-58-46	-13.336	907453.774464
55-203	41234.762	-68040.881	13.205	1-49-22	90-01-12	13.055	-888273.701455
55-204	41247.960	-68040.461	4.545	271-44-24	89-55-02	13.336	-907387.587896

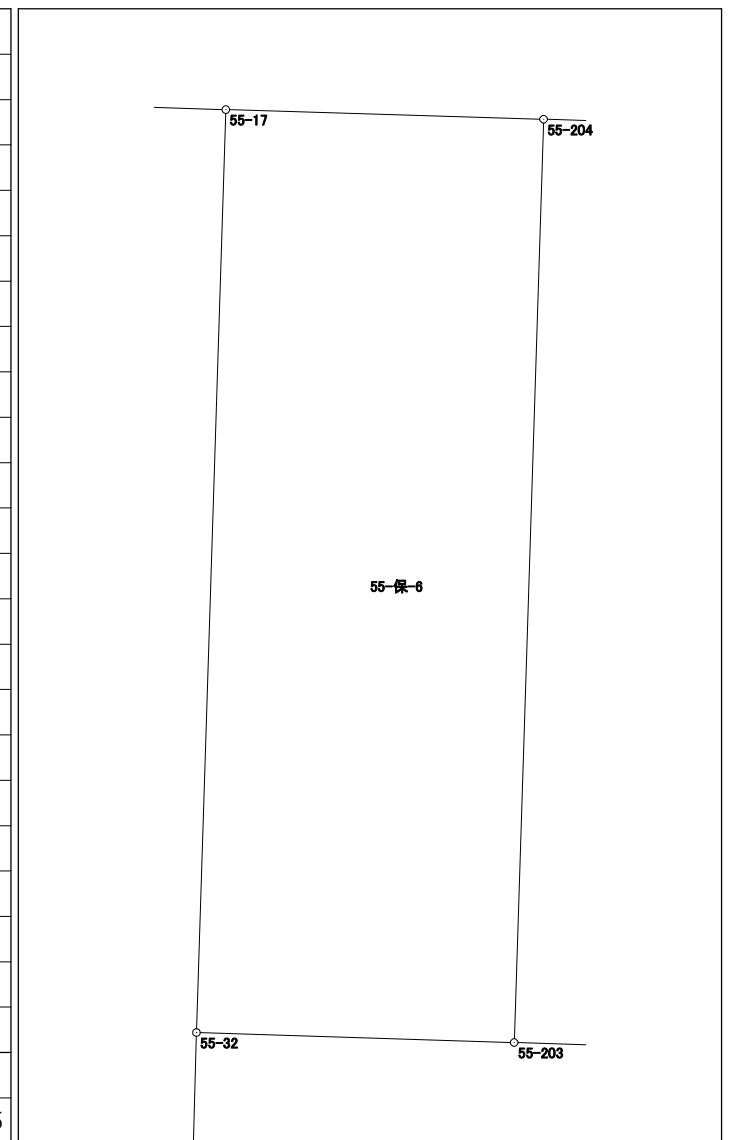


倍面積	120.012333
面積	60.0061665

面積計算書（座標法）

世界測地系（測地成果2011）

所在	地番	公簿地目	現況地目	地積	所有者
前橋市六供町二丁目	55-保-7			71.00 m ²	

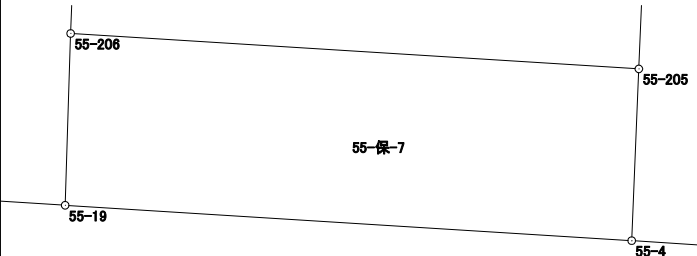
点名	X座標	Y座標	辺長	方向角	測角	DX	倍積 (Y×DX)		
55-19	41212.792	-68046.107	15.304	93-34-13	91-44-25	-5.585	380037.507595		
55-4	41211.839	-68030.833	4.634	2-23-13	88-49-00	3.677	-250149.372941		
55-205	41216.469	-68030.640	15.349	273-34-02	91-10-49	5.585	-379951.124400		
55-206	41217.424	-68045.959	4.634	181-49-48	88-15-46	-3.677	250204.991243		
						倍面積	142.001497		
						面積	71.0007485		

面積計算書 (座標法)

世界測地系 (測地成果2011)

所在	地番	公簿地目	現況地目	地積	所有者
前橋市六供町二丁目	55-保-10			6.00 m ²	

点名	X座標	Y座標	辺長	方向角	測角	DX	倍積 (Y×DX)
55-249	41235.482	-68088.943	0.429	91-52-09	90-07-55	-13.993	952768.579399
55-251	41235.468	-68088.514	13.986	1-44-14	89-52-05	13.966	-950924.186524
55-252	41249.448	-68088.090	0.429	271-44-09	89-59-55	13.993	-952756.643370
55-250	41249.461	-68088.519	13.985	181-44-14	90-00-05	-13.966	950924.256354
						倍面積	12.005859
						面積	6.0029295

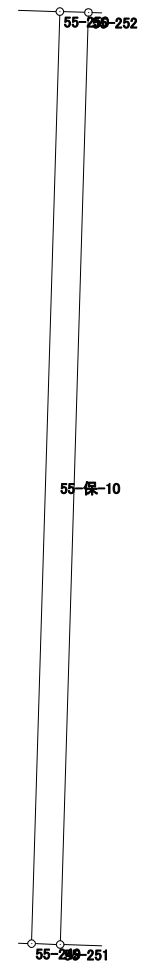


面積計算書（座標法）

世界測地系（測地成果2011）

所在	地番	公簿地目	現況地目	地積	所有者
前橋市六供町二丁目	55-保-12			6.00 m ²	

点名	X座標	Y座標	辺長	方向角	測角	DX	倍積 (Y×DX)
55-242	41249.578	-68092.265	13.982	181-44-01	89-59-52	-13.963	950772.296195
55-241	41235.602	-68092.688	0.429	91-52-09	90-08-08	-13.990	952616.705120
55-243	41235.588	-68092.259	13.983	1-44-00	89-51-51	13.963	-950772.212417
55-244	41249.565	-68091.836	0.429	271-44-09	90-00-09	13.990	-952604.785640

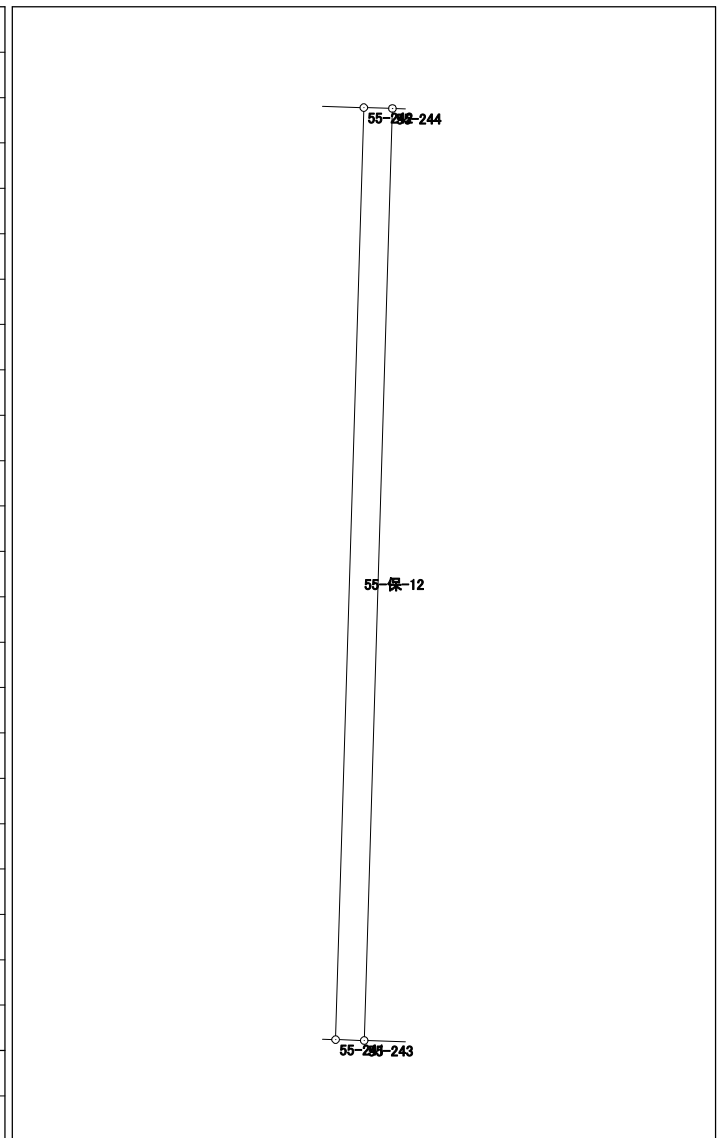


倍面積	12.003258
面積	6.0016290

面積計算書（座標法）

世界測地系（測地成果2011）

所 在	地 番	公簿地目	現況地目	地 積	所 有 者
前橋市六供町二丁目	55-保-13			13.00 m ²	

点 名	X 座標	Y 座標	辺 長	方 向 角	測 角	DX	倍 積 (Y×DX)
55-254	41249.326	-68084.172	13.990	181-43-57	89-56-40	-13.955	950114.620260
55-253	41235.342	-68084.595	0.929	91-50-59	90-07-02	-14.014	954137.514330
55-255	41235.312	-68083.666	13.991	1-43-57	89-52-58	13.955	-950107.559030
55-256	41249.297	-68083.243	0.929	271-47-17	90-03-20	14.014	-954118.567402
						倍面積	26.008158
						面 積	13.0040790

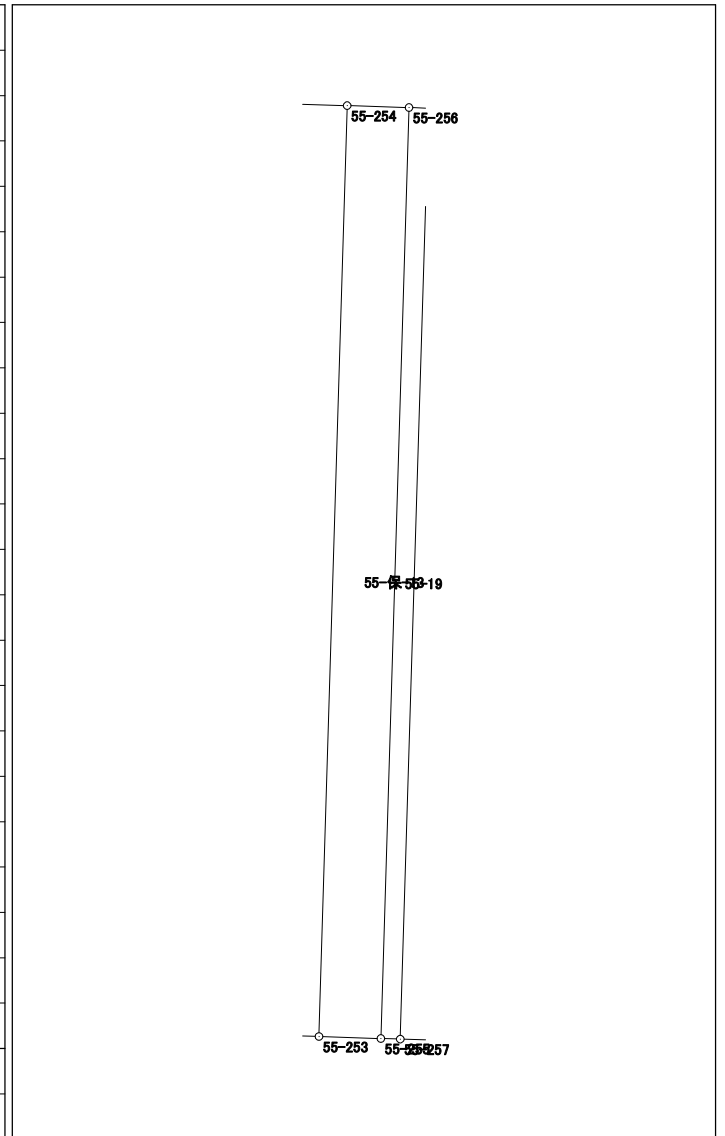

面積計算書（座標法）

世界測地系（測地成果2011）

所 在	地 番	公簿地目	現況地目	地 積	所 有 者
前橋市六供町二丁目	55-保-14			6.00 m ²	

点 名	X 座 標	Y 座 標	辺 長	方 向 角	測 角	DX	倍 積 (Y×DX)
55-118	41235.250	-68081.725	13.993	1-47-52	89-55-43	13.972	-951237.861700
55-117	41249.236	-68081.286	0.429	271-44-09	89-56-17	13.999	-953069.922714
55-211	41249.249	-68081.715	13.992	181-47-53	90-03-44	-13.972	951237.721980
55-212	41235.264	-68082.154	0.429	91-52-09	90-04-16	-13.999	953082.073846
						倍面積	12.011412
						面 積	6.0057060

