



57-1街区 画地出来形確認図 (2479.99m<sup>2</sup>)  
 57-2街区 (2059.64m<sup>2</sup>)

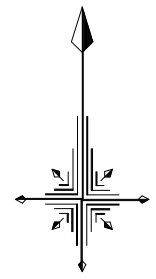

S=1/500

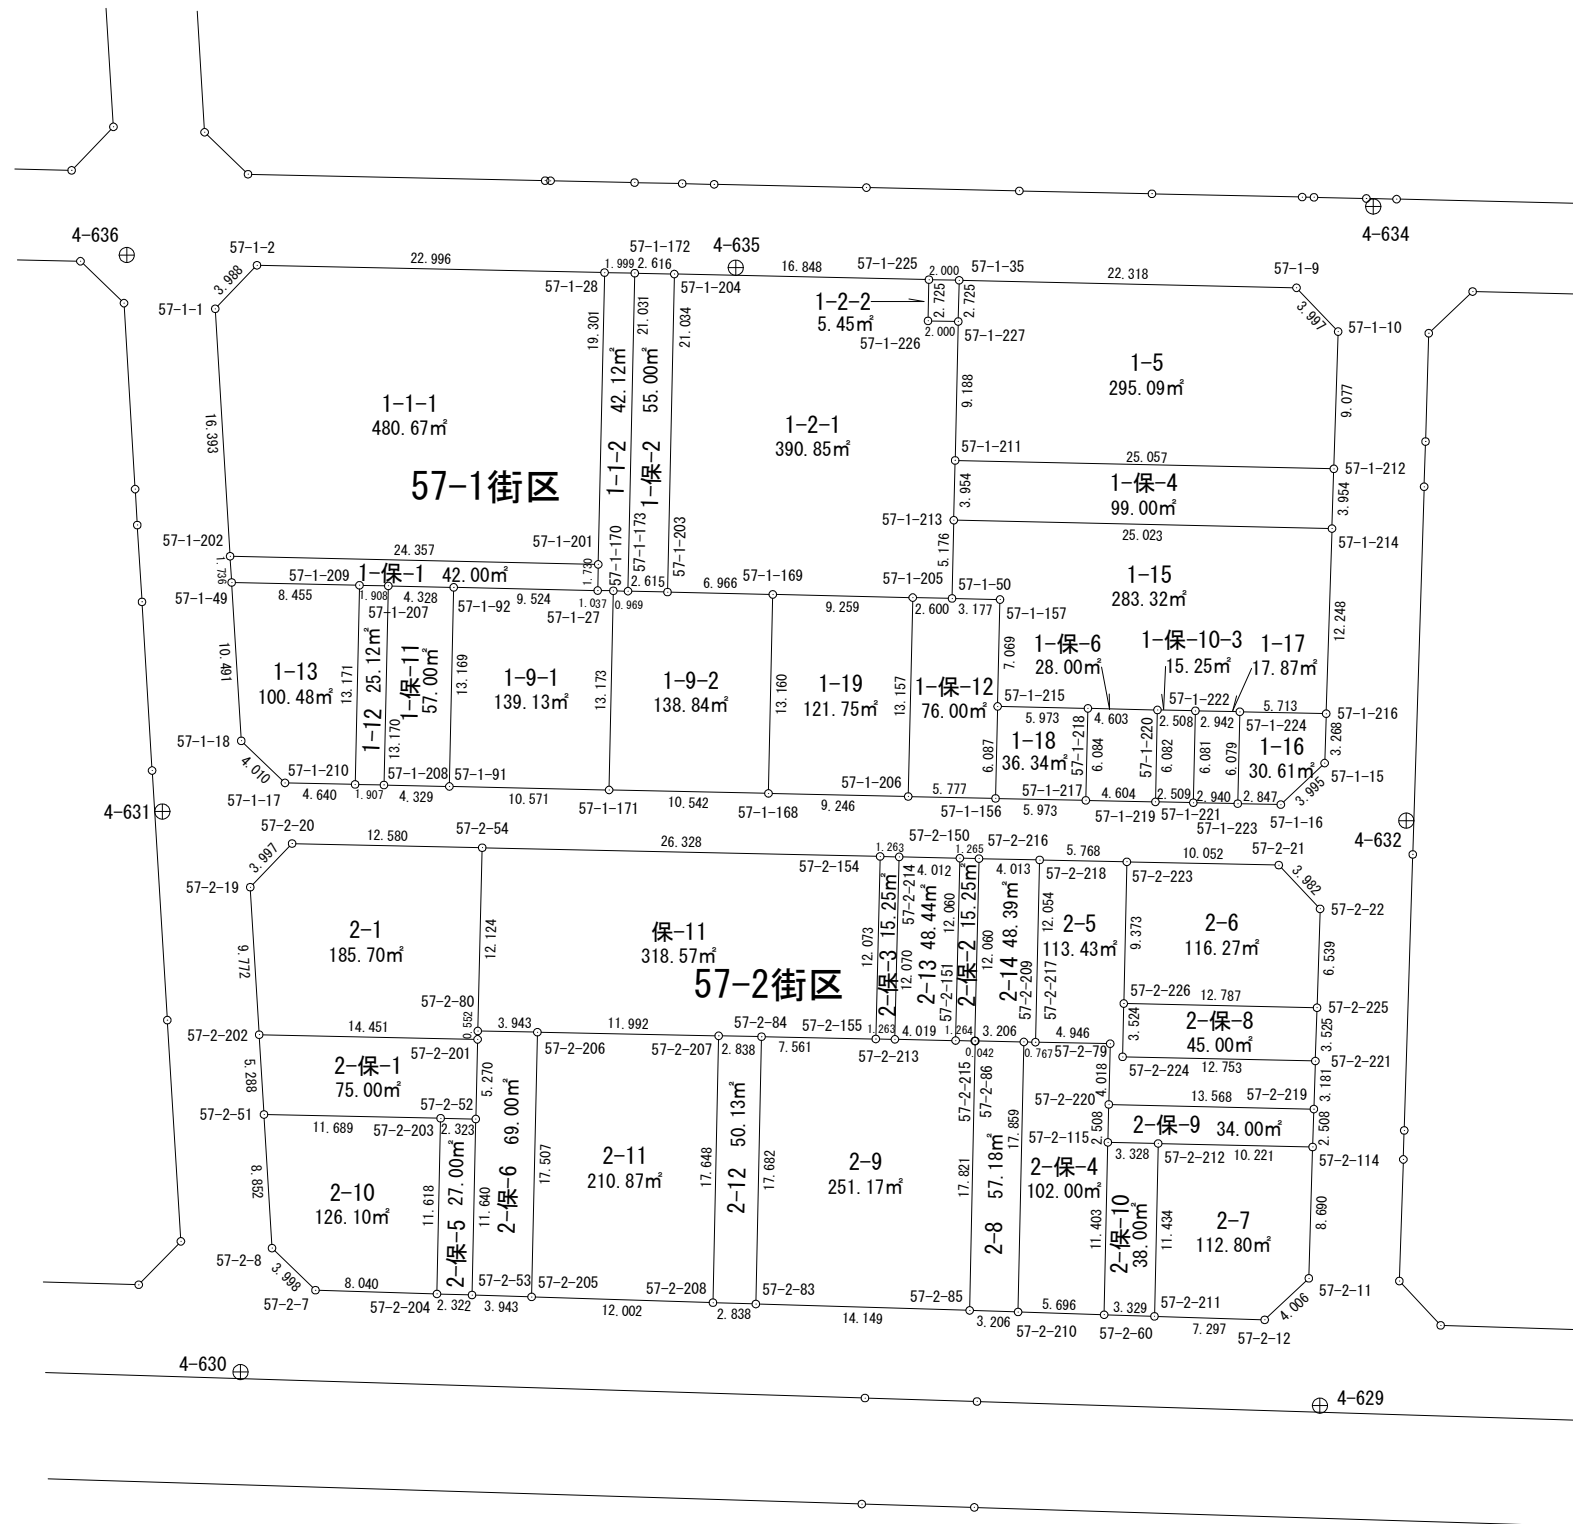


# 面積計算書（座標法）

世界測地系（測地成果2011）

所 在	地 番	公簿地目	現況地目	地 積	所 有 者
前橋市六供町二丁目	57-1-1-1			480.67 m <sup>2</sup>	

点 名	X 座標	Y 座標	辺 長	方 向 角	測 角	DX	倍 積 (Y×DX)
57-1-201	41317.396	-68099.797	19.301	1-14-28	89-58-49	18.760	-1277552.191720
57-1-28	41336.692	-68099.379	22.996	271-12-04	89-57-36	19.778	-1346869.517862
57-1-2	41337.174	-68122.370	3.988	223-48-04	132-36-00	-2.396	163221.198520
57-1-1	41334.296	-68125.130	16.393	176-33-57	132-45-53	-19.242	1310863.751460
57-1-202	41317.932	-68124.148	24.357	91-15-39	94-41-42	-16.900	1151298.101200
						倍面積	961.341598
						面 積	480.6707990

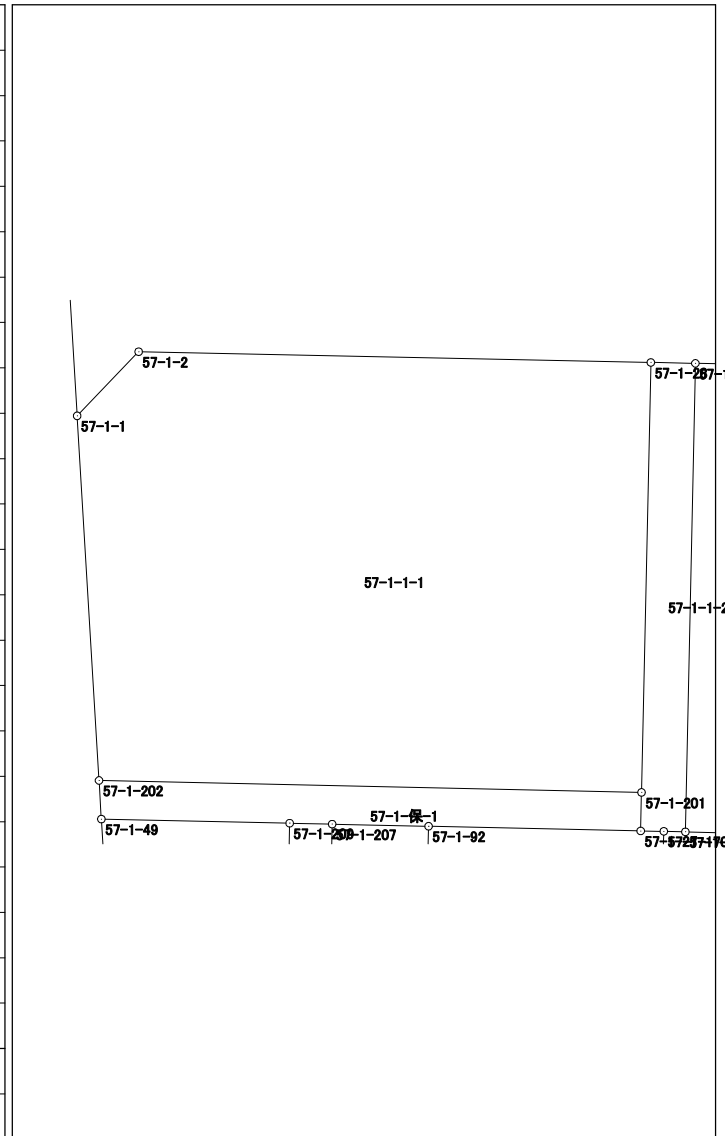


# 面積計算書 (座標法)

世界測地系 (測地成果2011)

所在	地番	公簿地目	現況地目	地積	所有者
前橋市六供町二丁目	57-1-1-2			42.12 m <sup>2</sup>	

点名	X座標	Y座標	辺長	方向角	測角	DX	倍積 (Y×DX)
57-1-28	41336.692	-68099.379	19.301	181-14-28	90-03-58	-19.255	1311253.542645
57-1-201	41317.396	-68099.797	1.730	181-13-31	179-59-03	-21.026	1431866.331722
57-1-27	41315.666	-68099.834	1.037	90-56-21	89-42-50	-1.747	118970.409998
57-1-170	41315.649	-68098.797	0.969	91-25-08	180-28-47	-0.041	2792.050677
57-1-173	41315.625	-68097.828	21.031	1-13-14	89-48-06	21.002	-1430190.583656
57-1-172	41336.651	-68097.380	1.999	271-10-30	89-57-16	21.067	-1434607.504460

倍面積	84.246926
面積	42.1234630

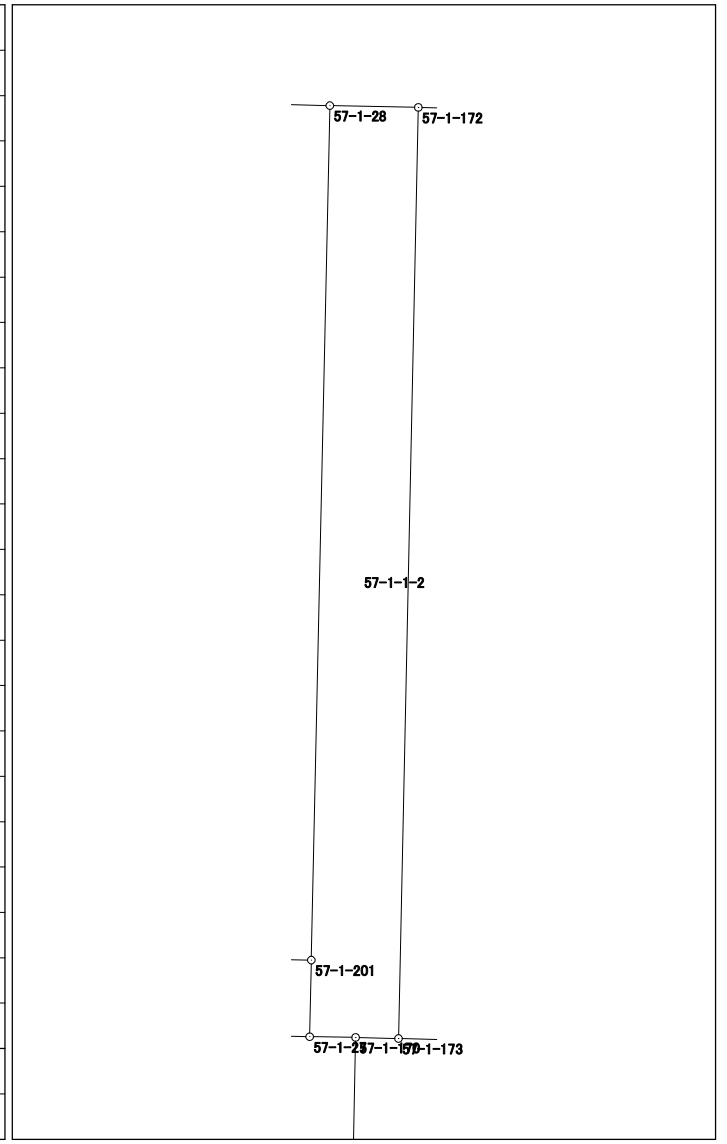


## 面積計算書（座標法）

世界測地系（測地成果2011）

所在	地番	公簿地目	現況地目	地積	所有者
前橋市六供町二丁目	57-1-2-1			390.85 m <sup>2</sup>	

点名	X座標	Y座標	辺長	方向角	測角	DX	倍積 (Y×DX)
57-1-203	41315.565	-68095.214	6.966	91-17-59	90-04-36	-21.187	1442733.299018
57-1-169	41315.407	-68088.250	9.259	91-16-52	179-58-53	-0.365	24852.211250
57-1-205	41315.200	-68078.993	2.600	91-16-42	179-59-50	-0.265	18040.933145
57-1-50	41315.142	-68076.394	5.176	1-17-03	90-00-21	5.117	-348346.908098
57-1-213	41320.317	-68076.278	3.954	1-17-23	180-00-20	9.128	-621400.265584
57-1-211	41324.270	-68076.189	9.188	1-17-27	180-00-04	13.139	-894453.047271
57-1-227	41333.456	-68075.982	2.000	271-15-37	89-58-10	9.230	-628341.313860
57-1-226	41333.500	-68077.982	2.725	1-16-58	270-01-21	2.768	-188439.854176
57-1-225	41336.224	-68077.921	16.848	271-15-30	89-58-32	3.094	-210633.087574
57-1-204	41336.594	-68094.765	21.034	181-13-23	89-57-53	-20.659	1406769.750135

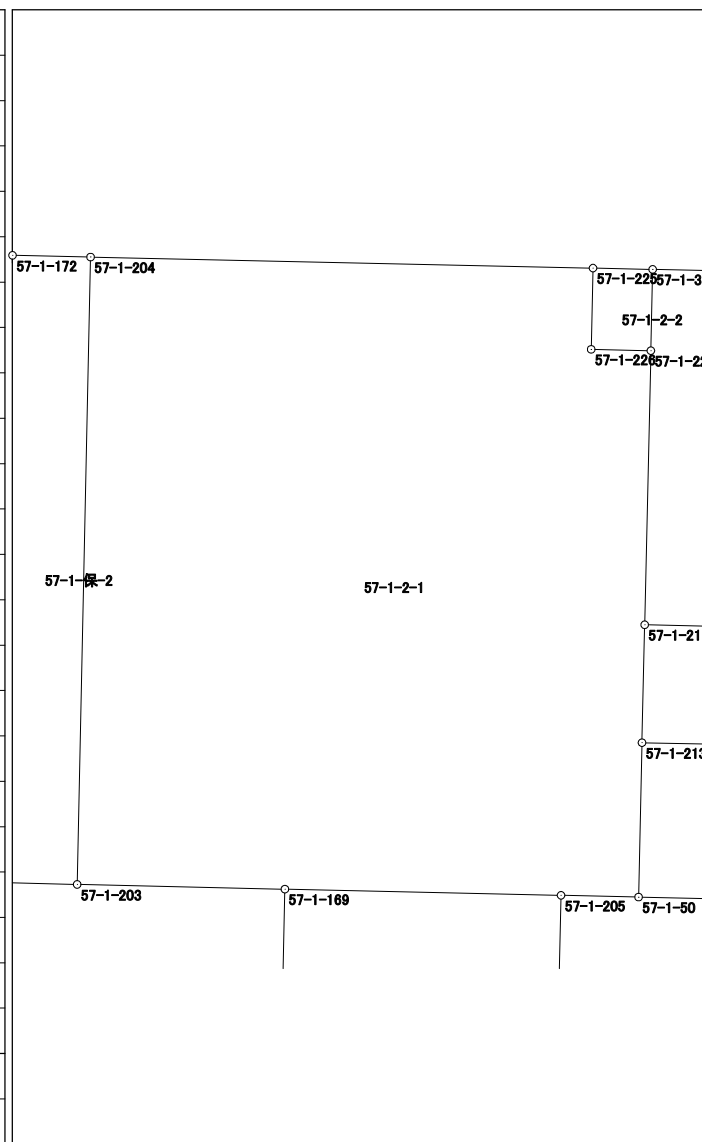


倍面積	781.716985
面積	390.8584925

# 面積計算書 (座標法)

世界測地系 (測地成果2011)

所 在	地 番	公簿地目	現況地目	地 積	所有 者
前橋市六供町二丁目	57-1-2-2			5.45 m <sup>2</sup>	

点 名	X 座標	Y 座標	辺 長	方 向 角	測 角	DX	倍 積 (Y×DX)
57-1-225	41336.224	-68077.921	2.725	181-16-58	90-01-21	-2.680	182448.828280
57-1-226	41333.500	-68077.982	2.000	91-15-37	89-58-39	-2.768	188439.854176
57-1-227	41333.456	-68075.982	2.725	1-16-58	90-01-21	2.680	-182443.631760
57-1-35	41336.180	-68075.921	2.000	271-15-37	89-58-39	2.768	-188434.149328

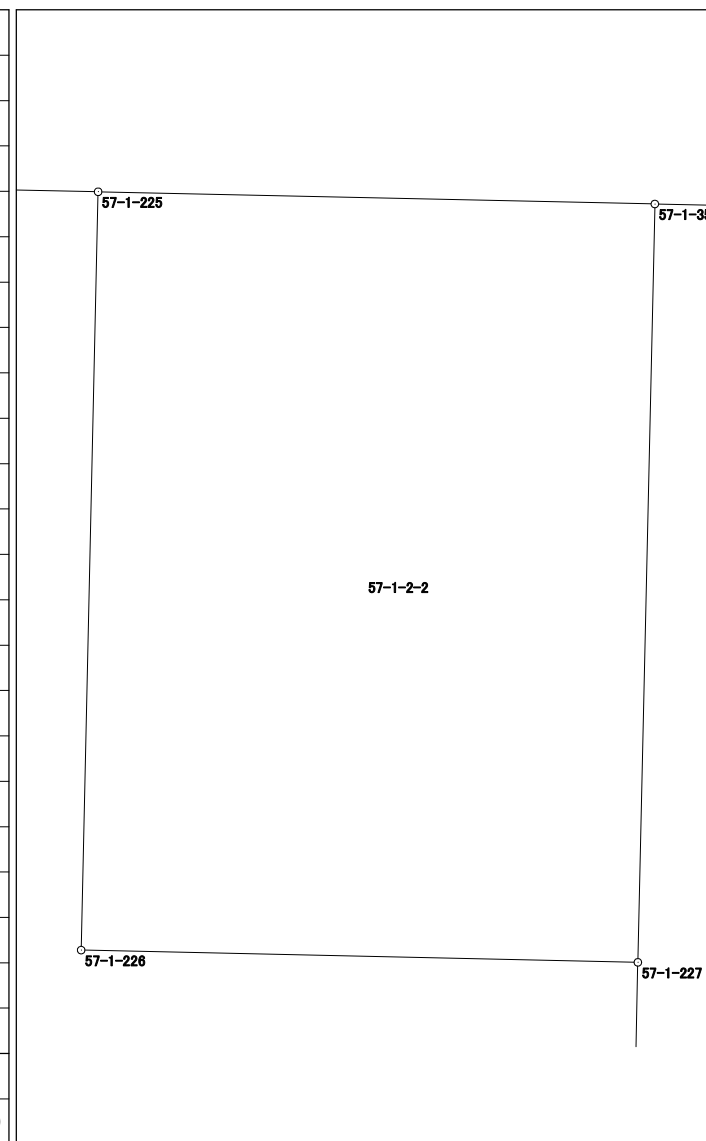

倍面積	10.901368
面積	5.4506840

# 面積計算書 (座標法)

世界測地系 (測地成果2011)

所 在	地 番	公簿地目	現況地目	地 積	所 有 者
前橋市六供町二丁目	57-1-5			295.09 m <sup>2</sup>	


点 名	X 座標	Y 座標	辺 長	方 向 角	測 角	DX	倍 積 (Y×DX)	
57-1-35	41336.180	-68075.921	2.725	181-16-58	90-01-01	-2.231	151877.379751	
57-1-227	41333.456	-68075.982	9.188	181-17-27	180-00-29	-11.910	810784.945620	
57-1-211	41324.270	-68076.189	25.057	91-15-53	89-58-26	-9.739	662994.004671	
57-1-212	41323.717	-68051.138	9.077	1-47-34	90-31-41	8.520	-579795.695760	
57-1-10	41332.790	-68050.854	3.997	316-26-58	134-39-24	11.970	-814568.722380	
57-1-9	41335.687	-68053.608	22.318	271-15-57	134-48-59	3.390	-230701.731120	
						倍面積	590.180782	
						面 積	295.0903910	

# 面積計算書 (座標法)

世界測地系 (測地成果2011)

所 在	地 番	公簿地目	現況地目	地 積	所 有 者
前橋市六供町二丁目	57-1-9-1			139.13 m <sup>2</sup>	

点 名	X 座標	Y 座標	辺 長	方 向 角	測 角	DX	倍 積 (Y×DX)
57-1-92	41315.877	-68109.356	13.169	181-15-11	89-59-01	-12.955	882356.706980
57-1-91	41302.711	-68109.644	10.571	91-15-27	90-00-16	-13.398	912533.010312
57-1-171	41302.479	-68099.076	13.173	1-12-49	89-57-22	12.938	-881065.845288
57-1-170	41315.649	-68098.797	1.037	270-56-21	89-43-32	13.187	-898018.836039
57-1-27	41315.666	-68099.834	9.524	271-16-10	180-19-49	0.228	-15526.762152
						倍面積	278.273813
						面 積	139.1369065

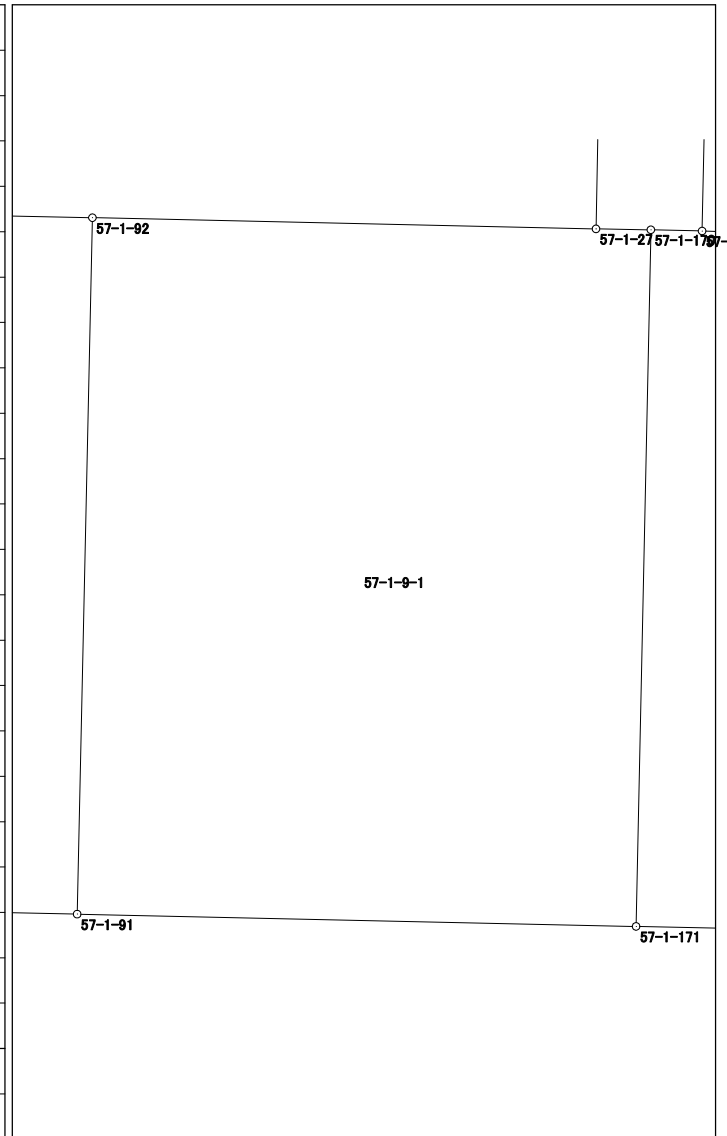

# 面積計算書（座標法）

世界測地系（測地成果2011）

所 在	地 番	公簿地目	現況地目	地 積	所 有 者
前橋市六供町二丁目	57-1-9-2			138.84 m <sup>2</sup>	

点 名	X 座標	Y 座標	辺 長	方 向 角	測 角	DX	倍 積 (Y×DX)	
57-1-170	41315.649	-68098.797	13.173	181-12-49	89-47-41	-13.146	895226.785362	
57-1-171	41302.479	-68099.076	10.542	91-14-41	90-01-52	-13.399	912459.519324	
57-1-168	41302.250	-68088.536	13.160	1-14-43	90-00-02	12.928	-880248.593408	
57-1-169	41315.407	-68088.250	6.966	271-17-59	90-03-16	13.315	-906595.048750	
57-1-203	41315.565	-68095.214	2.615	271-18-54	180-00-55	0.218	-14844.756652	
57-1-173	41315.625	-68097.828	0.969	271-25-08	180-06-14	0.084	-5720.217552	
							倍面積	277.688324
							面 積	138.8441620




# 面積計算書 (座標法)

世界測地系 (測地成果2011)

所 在	地 番	公簿地目	現況地目	地 積	所 有 者
前橋市六供町二丁目	57-1-12			25.12 m <sup>2</sup>	

点 名	X 座標	Y 座標	辺 長	方 向 角	測 角	DX	倍 積 (Y×DX)
57-1-207	41315.972	-68113.683	1.908	271-15-40	90-00-13	13.209	-899713.638747
57-1-209	41316.014	-68115.591	13.171	181-15-11	89-59-31	-13.126	894085.247466
57-1-210	41302.846	-68115.879	1.907	91-13-54	89-58-43	-13.209	899742.645711
57-1-208	41302.805	-68113.972	13.170	1-15-27	90-01-33	13.126	-894063.996472

倍面積	50.257958
面 積	25.1289790

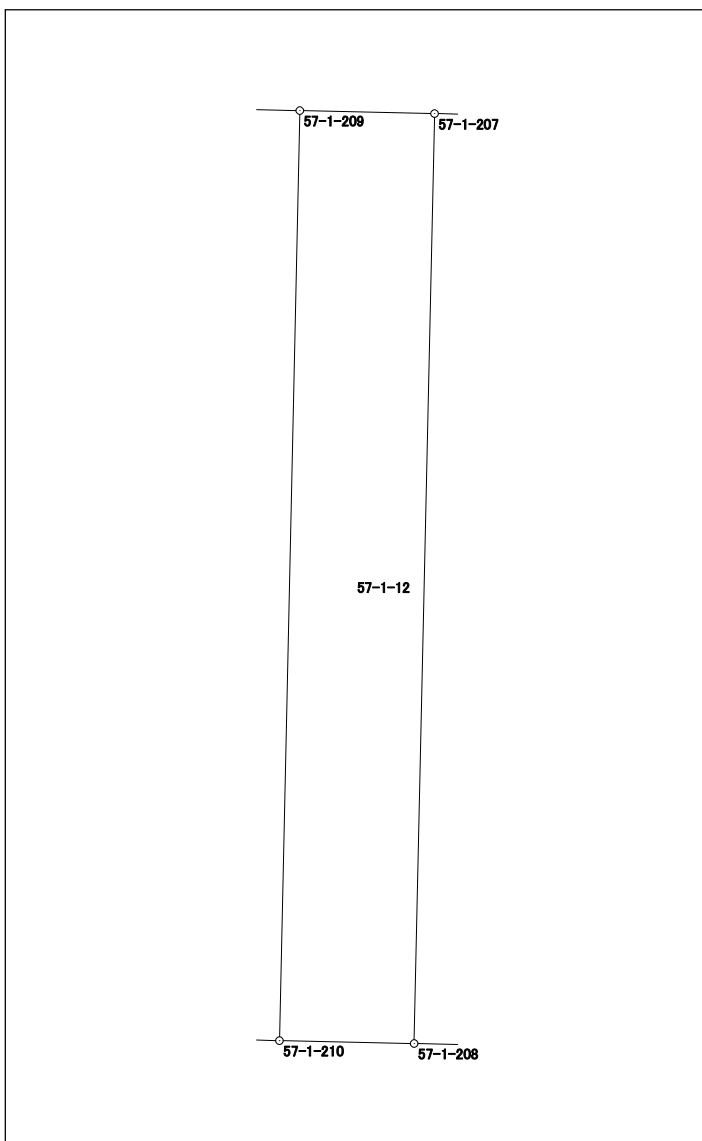


# 面積計算書（座標法）

世界測地系（測地成果2011）

所 在	地 番	公簿地目	現況地目	地 積	所 有 者
前橋市六供町二丁目	57-1-13			100.48 m <sup>2</sup>	

点 名	X 座標	Y 座標	辺 長	方 向 角	測 角	DX	倍 積 (Y×DX)
57-1-209	41316.014	-68115.591	8.455	271-15-14	90-00-03	13.353	-909547.486623
57-1-49	41316.199	-68124.044	10.491	176-31-28	85-16-14	-10.287	700792.040628
57-1-18	41305.727	-68123.408	4.010	133-53-19	137-21-51	-13.252	902771.402816
57-1-17	41302.947	-68120.518	4.640	91-14-50	137-21-31	-2.881	196255.212358
57-1-210	41302.846	-68115.879	13.171	1-15-11	90-00-21	13.067	-890070.190893
						倍面積	200.978286
						面 積	100.4891430

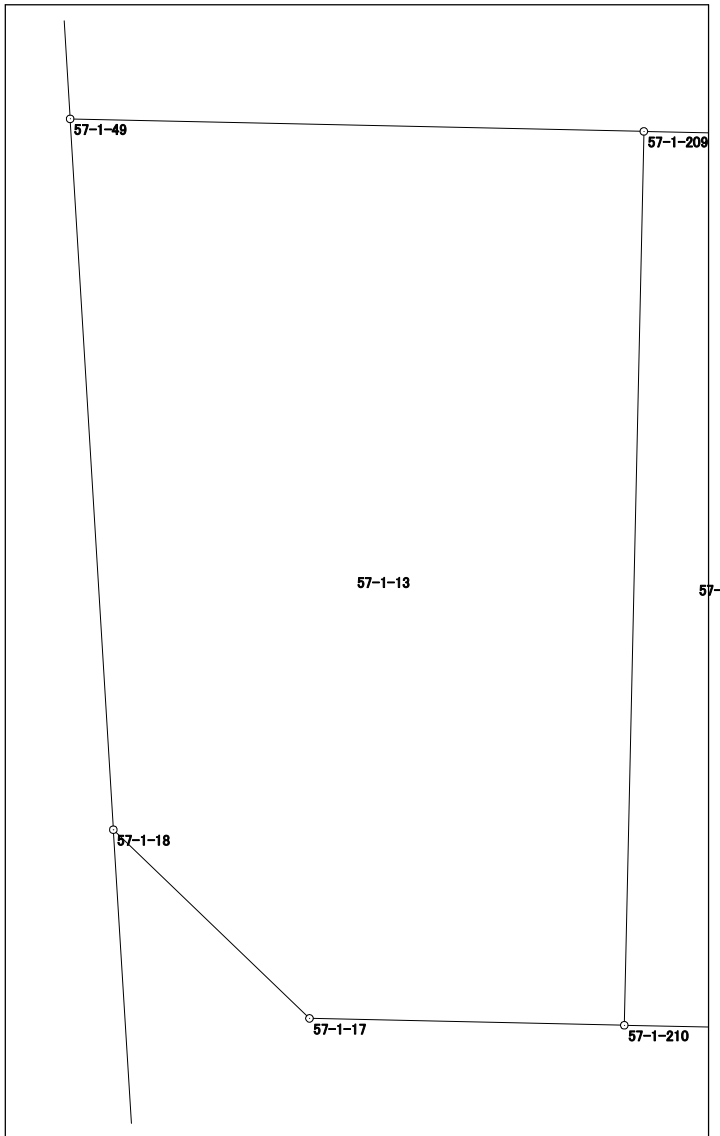




# 面積計算書 (座標法)

世界測地系 (測地成果2011)

所在	地番	公簿地目	現況地目	地積	所有者
前橋市六供町二丁目	57-1-16			30.61 m <sup>2</sup>	

点名	X座標	Y座標	辺長	方向角	測角	DX	倍積 (Y×DX)
57-1-223	41301.573	-68057.494	2.847	91-14-53	89-56-50	-6.139	417804.955666
57-1-16	41301.511	-68054.648	3.995	46-34-56	135-20-03	2.684	-182658.675232
57-1-15	41304.257	-68051.746	3.268	1-47-20	135-12-24	6.012	-409127.096952
57-1-216	41307.523	-68051.644	5.713	271-16-25	89-29-05	3.393	-230899.228092
57-1-224	41307.650	-68057.356	6.079	181-18-03	90-01-38	-5.950	404941.268200

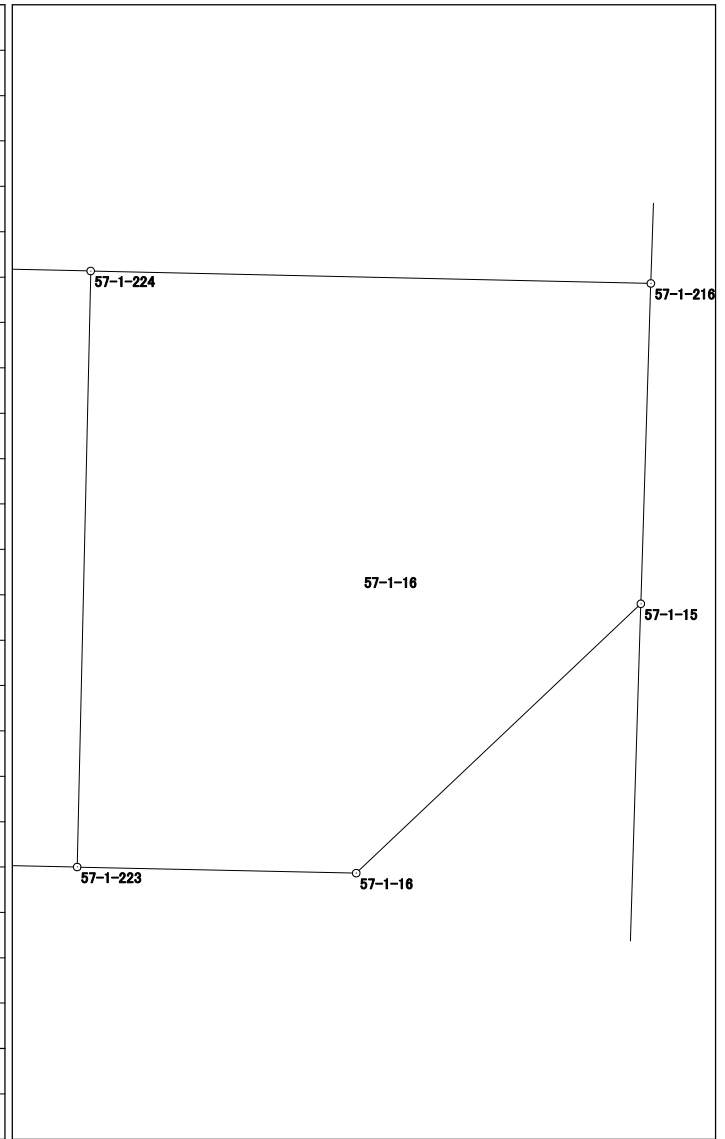


倍面積	61.223590
面積	30.6117950

# 面積計算書（座標法）

世界測地系（測地成果2011）

所在	地番	公簿地目	現況地目	地積	所有者
前橋市六供町二丁目	57-1-17			17.87 m <sup>2</sup>	

点名	X座標	Y座標	辺長	方向角	測角	DX	倍積 (Y×DX)
57-1-221	41301.636	-68060.433	2.940	91-13-41	89-56-47	-6.142	418027.179486
57-1-223	41301.573	-68057.494	6.079	1-18-03	90-04-22	6.014	-409297.768916
57-1-224	41307.650	-68057.356	2.942	271-15-58	89-57-55	6.142	-418008.280552
57-1-222	41307.715	-68060.297	6.081	181-16-54	90-00-56	-6.014	409314.626158
						倍面積	35.756176
						面積	17.8780880

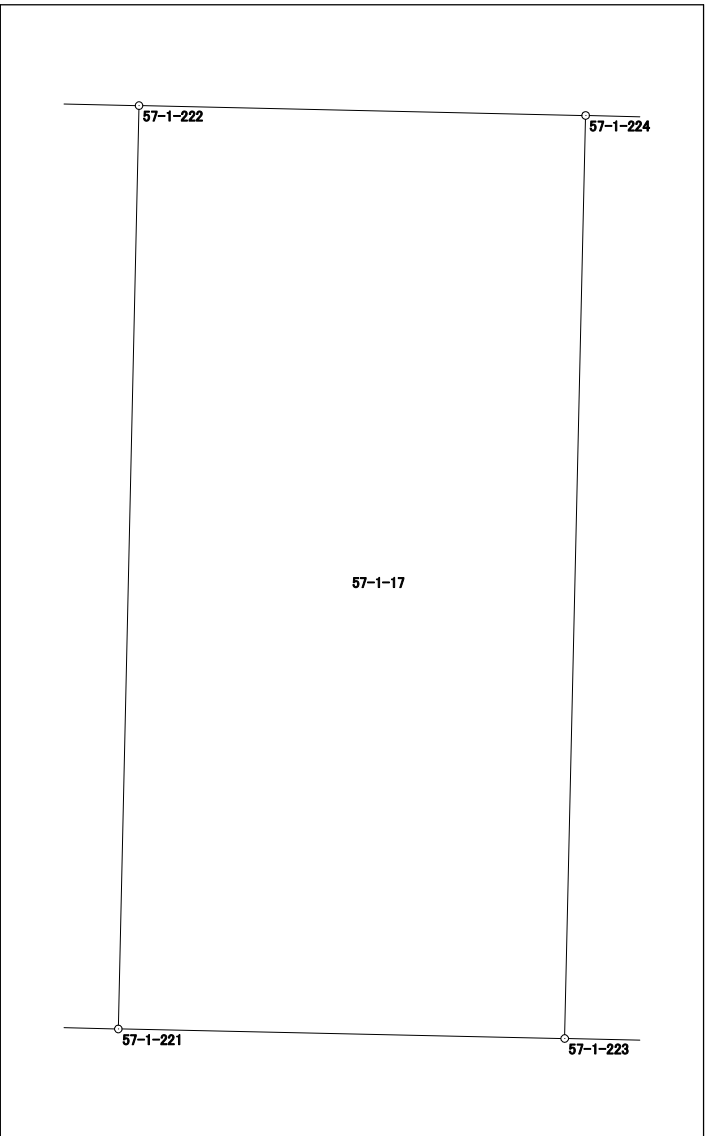


# 面積計算書 (座標法)

世界測地系 (測地成果2011)

所在	地番	公簿地目	現況地目	地積	所有者
前橋市六供町二丁目	57-1-18			36.34 m <sup>2</sup>	

点名	X座標	Y座標	辺長	方向角	測角	DX	倍積 (Y×DX)
57-1-215	41308.004	-68073.378	6.087	181-17-57	90-01-59	-5.953	405240.819234
57-1-156	41301.919	-68073.516	5.973	91-14-15	89-56-18	-6.214	423008.828424
57-1-217	41301.790	-68067.544	6.084	1-17-59	90-03-44	5.953	-405206.089432
57-1-218	41307.872	-68067.406	5.973	271-15-58	89-57-59	6.214	-422970.860884

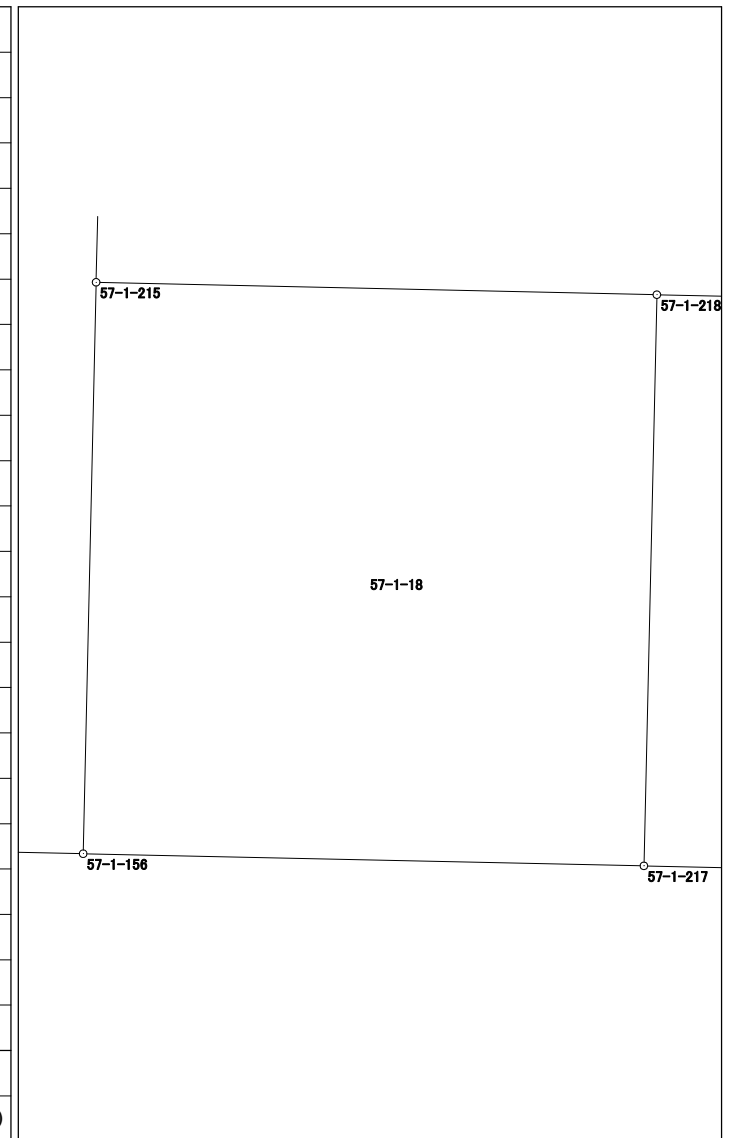

倍面積	72.697342
面積	36.3486710

# 面積計算書 (座標法)

世界測地系 (測地成果2011)

所 在	地 番	公簿地目	現況地目	地 積	所 有 者
前橋市六供町二丁目	57-1-19			121.75 m <sup>2</sup>	

点 名	X 座標	Y 座標	辺 長	方 向 角	測 角	DX	倍 積 (Y×DX)		
57-1-205	41315.200	-68078.993	9.259	271-16-52	89-58-44	13.361	-909603.425473		
57-1-169	41315.407	-68088.250	13.160	181-14-43	89-57-51	-12.950	881742.837500		
57-1-168	41302.250	-68088.536	9.246	91-15-51	90-01-08	-13.361	909730.929496		
57-1-206	41302.046	-68079.292	13.157	1-18-08	90-02-17	12.950	-881626.831400		
倍面積							243.510123		
面 積							121.7550615		

## 面積計算書（座標法）

世界測地系（測地成果2011）

所 在	地 番	公簿地目	現況地目	地 積	所 有 者
前橋市六供町二丁目	57-1-保-1			42.00 m <sup>2</sup>	

点 名	X 座標	Y 座標	辺 長	方 向 角	測 角	DX	倍 積 (Y×DX)	
57-1-49	41316.199	-68124.044	8.455	91-15-14	94-41-17	-1.918	130661.916392	
57-1-209	41316.014	-68115.591	1.908	91-15-40	180-00-26	-0.227	15462.239157	
57-1-207	41315.972	-68113.683	4.328	91-15-28	179-59-48	-0.137	9331.574571	
57-1-92	41315.877	-68109.356	9.524	91-16-10	180-00-42	-0.306	20841.462936	
57-1-27	41315.666	-68099.834	1.730	1-13-31	89-57-21	1.519	-103443.647846	
57-1-201	41317.396	-68099.797	24.357	271-15-39	90-02-08	2.266	-154314.140002	
57-1-202	41317.932	-68124.148	1.736	176-33-57	85-18-18	-1.197	81544.605156	
						倍面積	84.010364	
						面積	42.0051820	




# 面積計算書（座標法）

世界測地系（測地成果2011）

所 在	地 番	公簿地目	現況地目	地 積	所 有 者
前橋市六供町二丁目	57-1-保-2			55.00 m <sup>2</sup>	

点 名	X 座 標	Y 座 標	辺 長	方 向 角	測 角	DX	倍 積 (Y×DX)
57-1-172	41336.651	-68097.380	21.031	181-13-14	89-58-19	-20.969	1427933.961220
57-1-173	41315.625	-68097.828	2.615	91-18-54	90-05-40	-21.086	1435910.801208
57-1-203	41315.565	-68095.214	21.034	1-13-23	89-54-29	20.969	-1427888.542366
57-1-204	41336.594	-68094.765	2.616	271-14-55	90-01-32	21.086	-1435846.214790

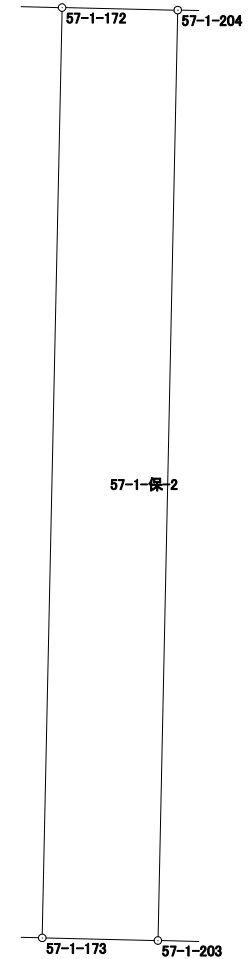


倍面積	110.005272
面 積	55.0026360

# 面積計算書（座標法）

世界測地系（測地成果2011）

所 在	地 番	公簿地目	現況地目	地 積	所 有 者
前橋市六供町二丁目	57-1-保-4			99.00 m <sup>2</sup>	


点 名	X 座標	Y 座標	辺 長	方 向 角	測 角	DX	倍 積 (Y×DX)
57-1-212	41323.717	-68051.138	25.057	271-15-53	89-28-55	4.505	-306570.376690
57-1-211	41324.270	-68076.189	3.954	181-17-23	90-01-30	-3.400	231459.042600
57-1-213	41320.317	-68076.278	25.023	91-15-50	89-58-27	-4.505	306683.632390
57-1-214	41319.765	-68051.261	3.954	1-46-58	90-31-08	3.400	-231374.287400
						倍面積	198.010900
						面 積	99.0054500

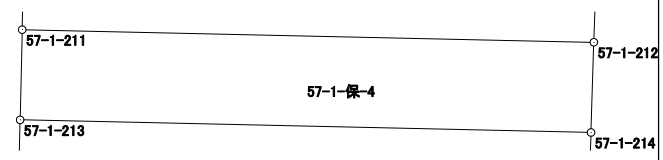

## 面積計算書（座標法）

世界測地系（測地成果2011）

所在	地番	公簿地目	現況地目	地積	所有者
前橋市六供町二丁目	57-1-保-6			28.00 m <sup>2</sup>	

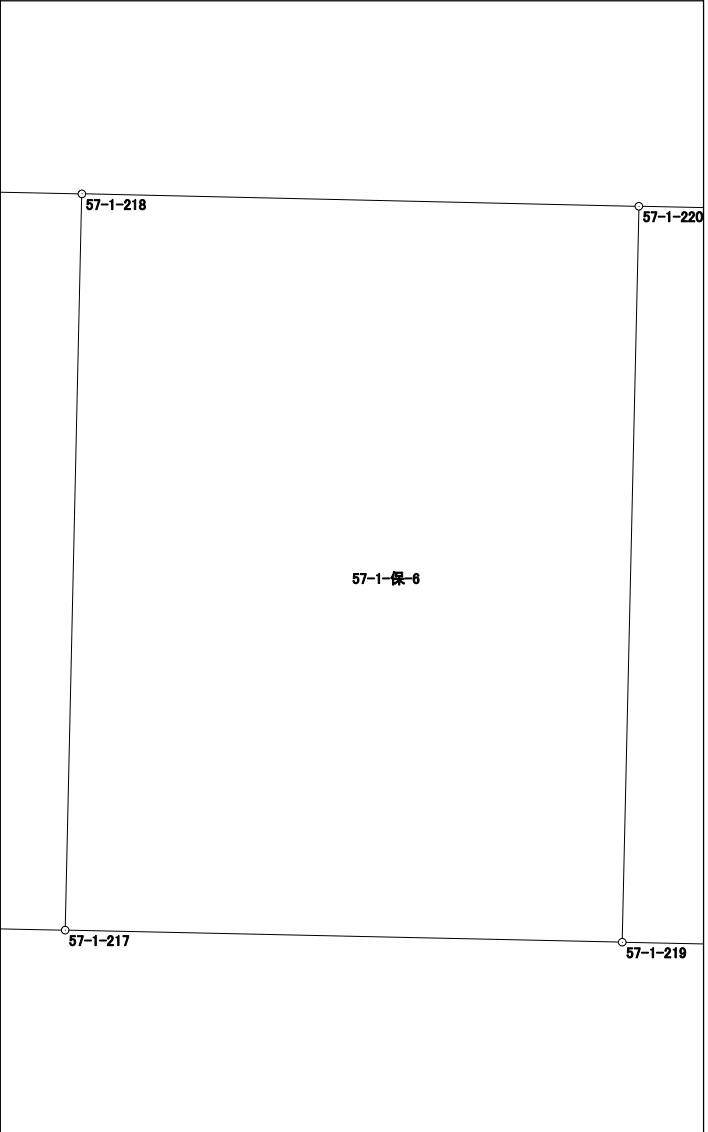点名	X座標	Y座標	辺長	方向角	測角	DX	倍積 (Y×DX)	
57-1-217	41301.790	-68067.544	4.604	91-14-40	89-56-41	-6.182	420793.557008	
57-1-219	41301.690	-68062.941	6.082	1-17-27	90-02-47	5.980	-407016.387180	
57-1-220	41307.770	-68062.804	4.603	271-16-11	89-58-44	6.182	-420764.254328	
57-1-218	41307.872	-68067.406	6.084	181-17-59	90-01-48	-5.980	407043.087880	
倍面積							56.003380	
面積							28.0016900	


# 面積計算書 (座標法)

世界測地系 (測地成果2011)

所在	地番	公簿地目	現況地目	地積	所有者
前橋市六供町二丁目	57-1-保-10-3			15.25 m <sup>2</sup>	

点名	X座標	Y座標	辺長	方向角	測角	DX	倍積 (Y×DX)
57-1-220	41307.770	-68062.804	6.082	181-17-27	90-02-03	-6.025	410078.394100
57-1-219	41301.690	-68062.941	2.509	91-14-00	89-56-33	-6.134	417498.080094
57-1-221	41301.636	-68060.433	6.081	1-16-54	90-02-54	6.025	-410064.108825
57-1-222	41307.715	-68060.297	2.508	271-15-24	89-58-30	6.134	-417481.861798

倍面積	30.503571
面積	15.2517855

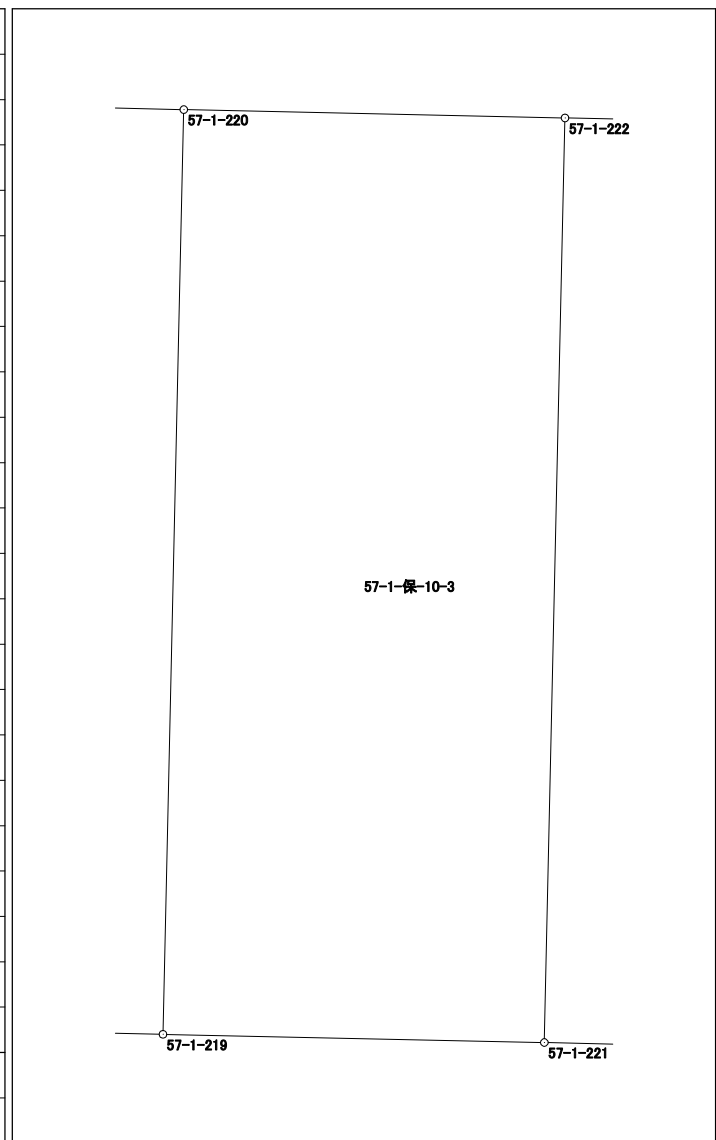


# 面積計算書（座標法）

世界測地系（測地成果2011）

所在	地番	公簿地目	現況地目	地積	所有者
前橋市六供町二丁目	57-1-保-11			57.00 m <sup>2</sup>	

点名	X座標	Y座標	辺長	方向角	測角	DX	倍積 (Y×DX)
57-1-92	41315.877	-68109.356	4.328	271-15-28	90-00-17	13.261	-903198.169916
57-1-207	41315.972	-68113.683	13.170	181-15-27	89-59-59	-13.072	890382.064176
57-1-208	41302.805	-68113.972	4.329	91-14-39	89-59-12	-13.261	903259.382692
57-1-91	41302.711	-68109.644	13.169	1-15-11	90-00-32	13.072	-890329.266368

倍面積	114.010584
面積	57.0052920

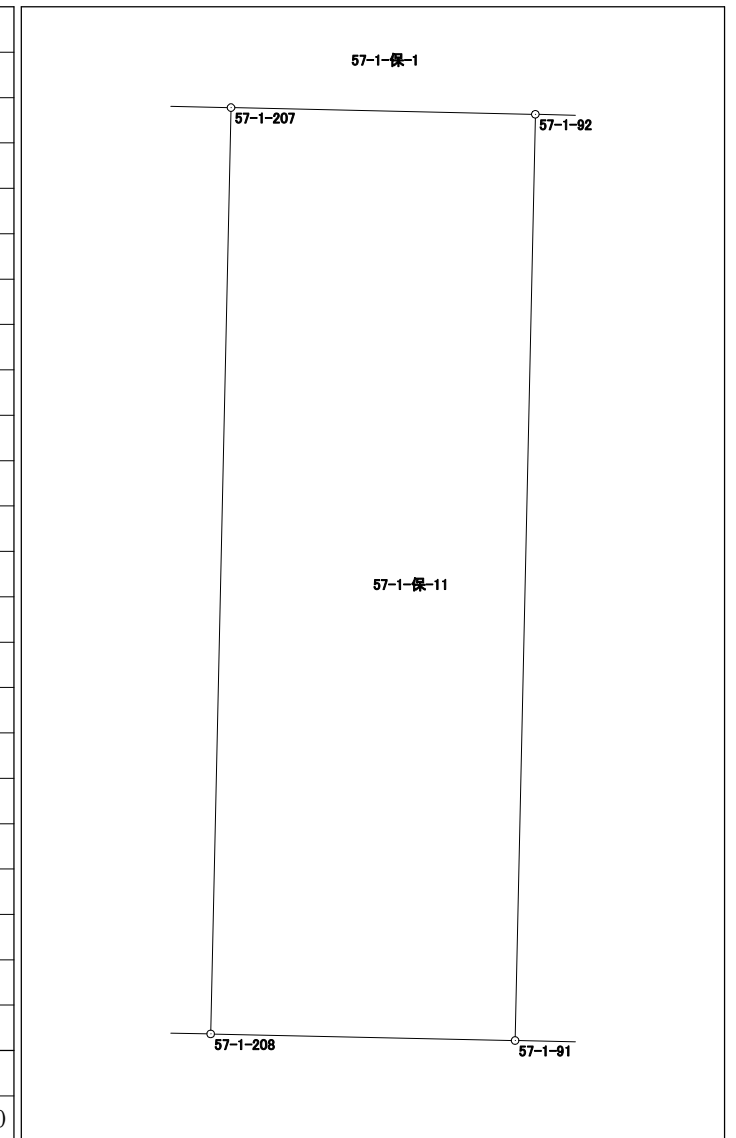


# 面積計算書 (座標法)

世界測地系 (測地成果2011)

所在	地番	公簿地目	現況地目	地積	所有者
前橋市六供町二丁目	57-1-保-12			76.00 m <sup>2</sup>	

点名	X座標	Y座標	辺長	方向角	測角	DX	倍積 (Y×DX)
57-1-156	41301.919	-68073.516	6.087	1-17-57	90-02-22	5.958	-405582.008328
57-1-215	41308.004	-68073.378	7.069	1-17-49	179-59-52	13.152	-895301.067456
57-1-157	41315.071	-68073.218	3.177	271-16-50	89-59-01	7.138	-485906.630084
57-1-50	41315.142	-68076.394	2.600	271-16-42	179-59-52	0.129	-8781.854826
57-1-205	41315.200	-68078.993	13.157	181-18-08	90-01-26	-13.096	891562.492328
57-1-206	41302.046	-68079.292	5.777	91-15-35	89-57-27	-13.281	904161.077052

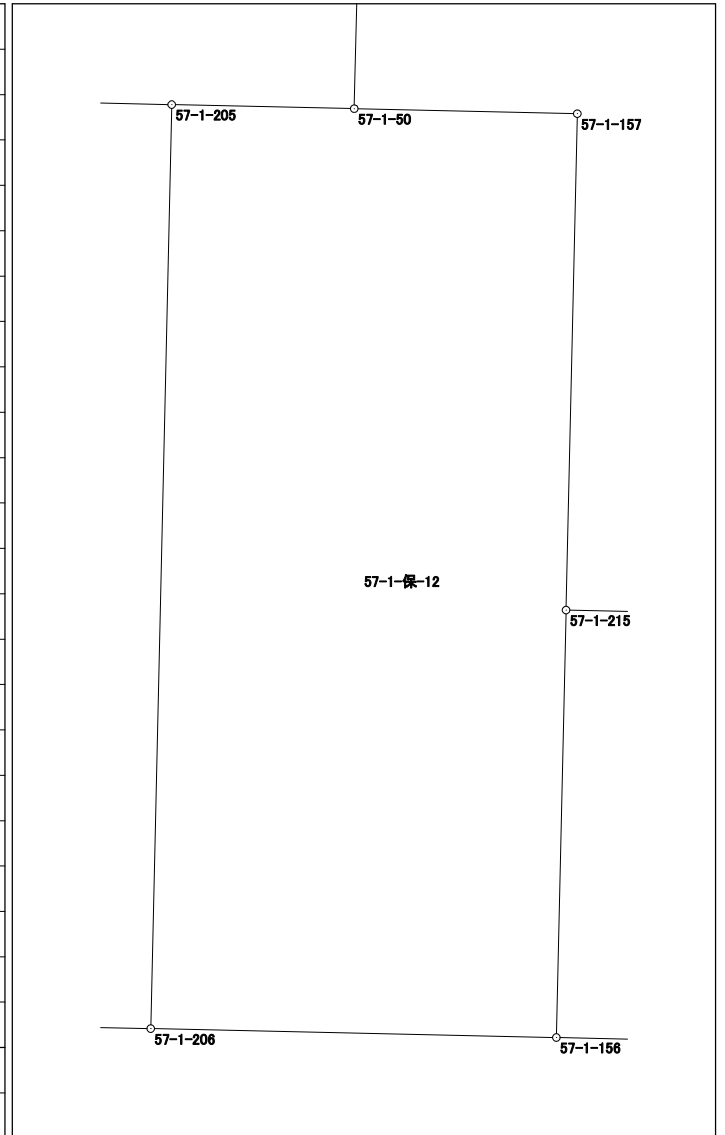

倍面積	152.008686
面積	76.0043430