



5-1 街区
5-2 街区
5-3 街区

画地出来形確認図

(744.74m²)
(260.06m²)
(694.94m²)

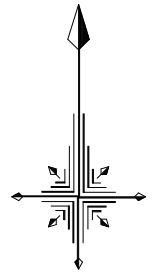

S=1/500

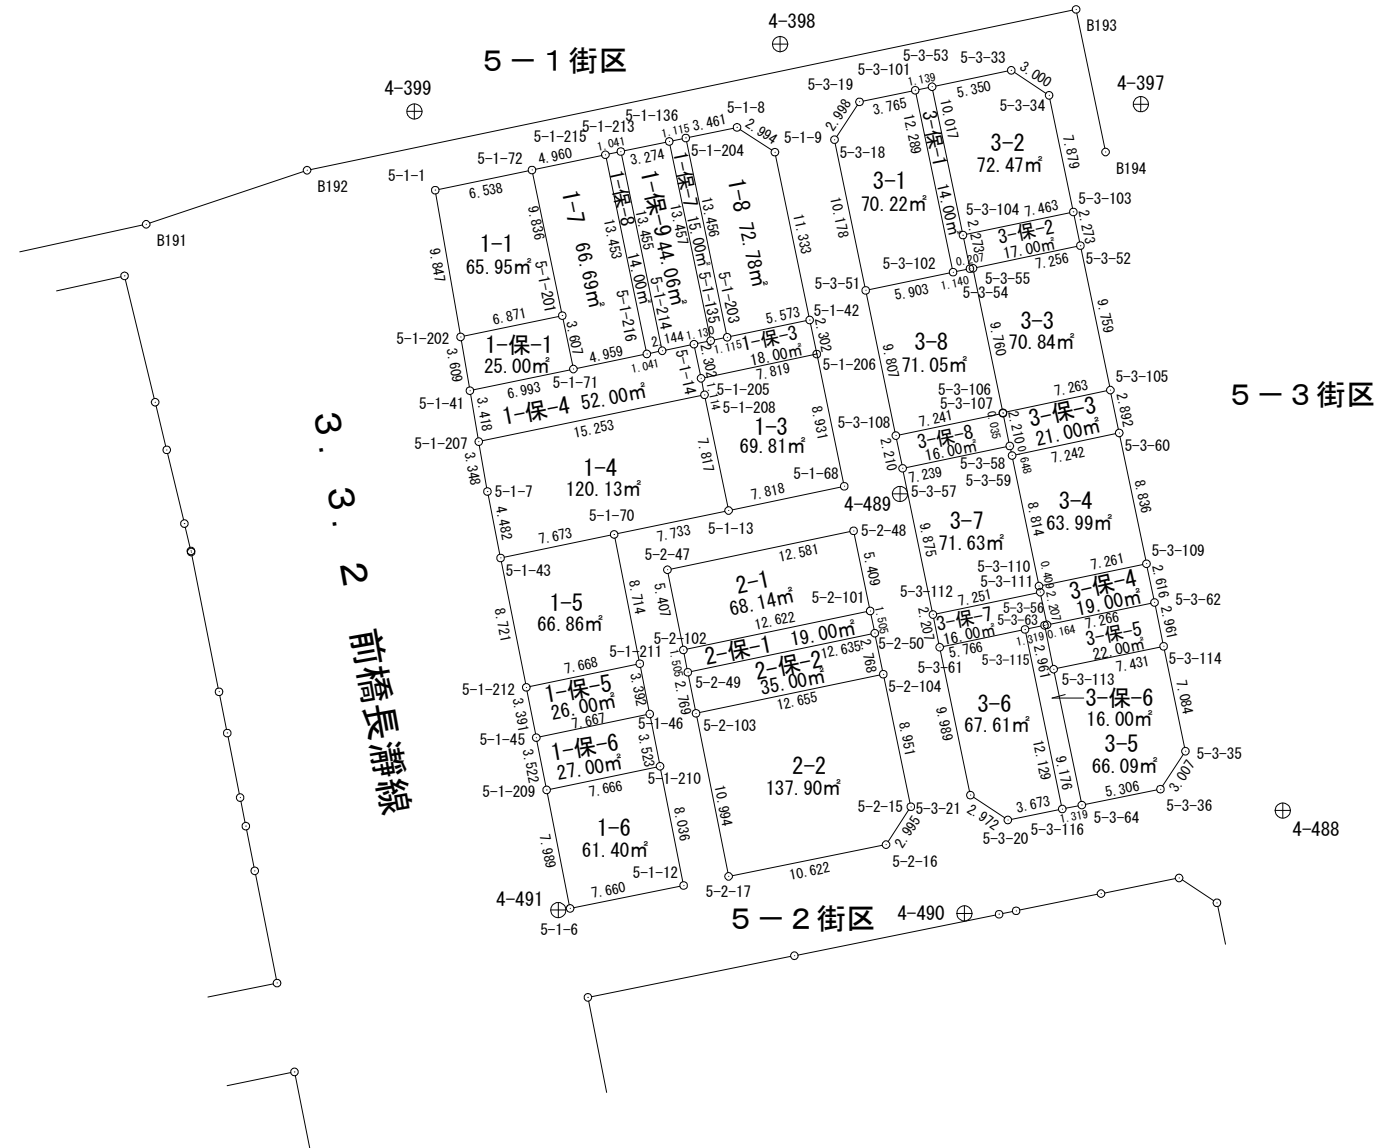


面積計算書（座標法）

世界測地系（測地成果2011）

所在	地番	公簿地目	現況地目	地積	所有者
前橋市六供町一丁目	5-3-1			70.22 m ²	

点名	X座標	Y座標	辺長	方向角	測角	DX	倍積 (Y×DX)
5-3-101	41916.361	-68419.391	3.765	258-13-50	89-58-39	11.264	-770676.020224
5-3-19	41915.593	-68423.077	2.998	213-29-19	135-15-29	-3.268	223606.615636
5-3-18	41913.093	-68424.731	10.178	168-18-21	134-49-02	-12.467	853051.121377
5-3-51	41903.126	-68422.668	5.903	78-14-27	89-56-06	-8.764	599656.262352
5-3-102	41904.329	-68416.889	12.289	348-15-11	90-00-44	13.235	-905497.525915

倍面積	140.453226
面積	70.2266130

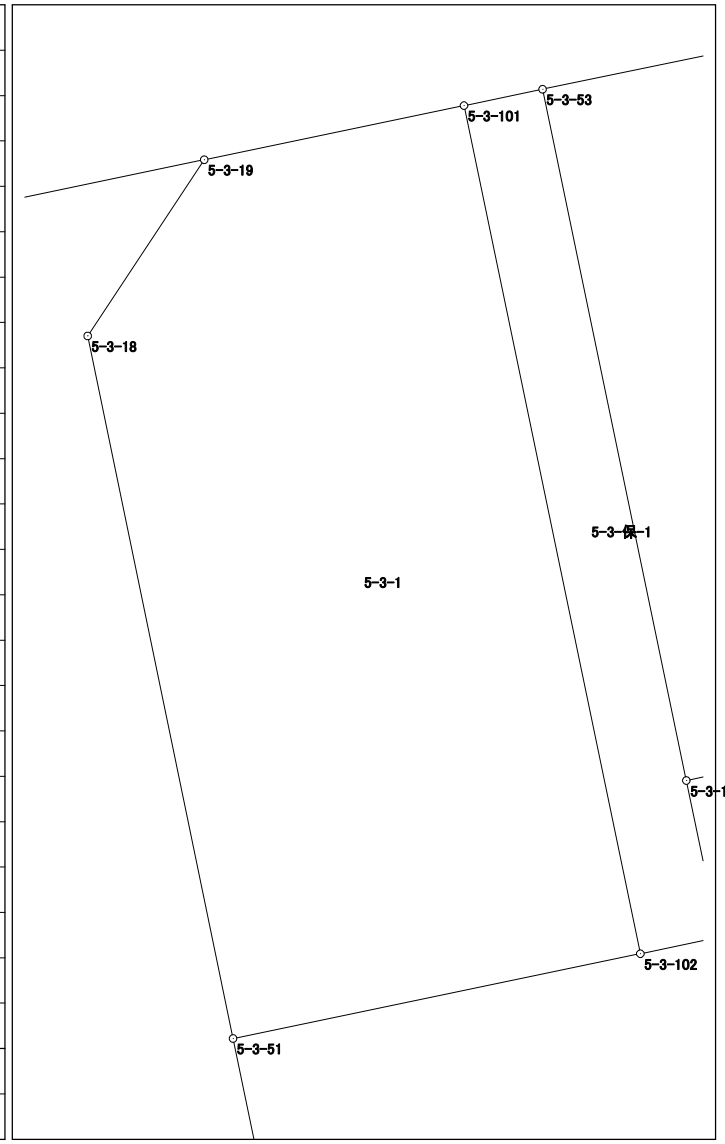


面積計算書 (座標法)

世界測地系 (測地成果2011)

所在	地番	公簿地目	現況地目	地積	所有者
前橋市六供町一丁目	5-3-4			63.99 m ²	

点名	X座標	Y座標	辺長	方向角	測角	DX	倍積 (Y×DX)
5-3-109	41885.050	-68404.095	8.836	348-13-56	89-57-42	10.126	-692659.865970
5-3-60	41893.700	-68405.897	7.242	258-06-07	89-52-11	7.157	-489581.004829
5-3-59	41892.207	-68412.983	8.814	168-21-22	90-15-15	-10.126	692749.865858
5-3-110	41883.574	-68411.204	7.261	78-16-14	89-54-52	-7.157	489618.987028

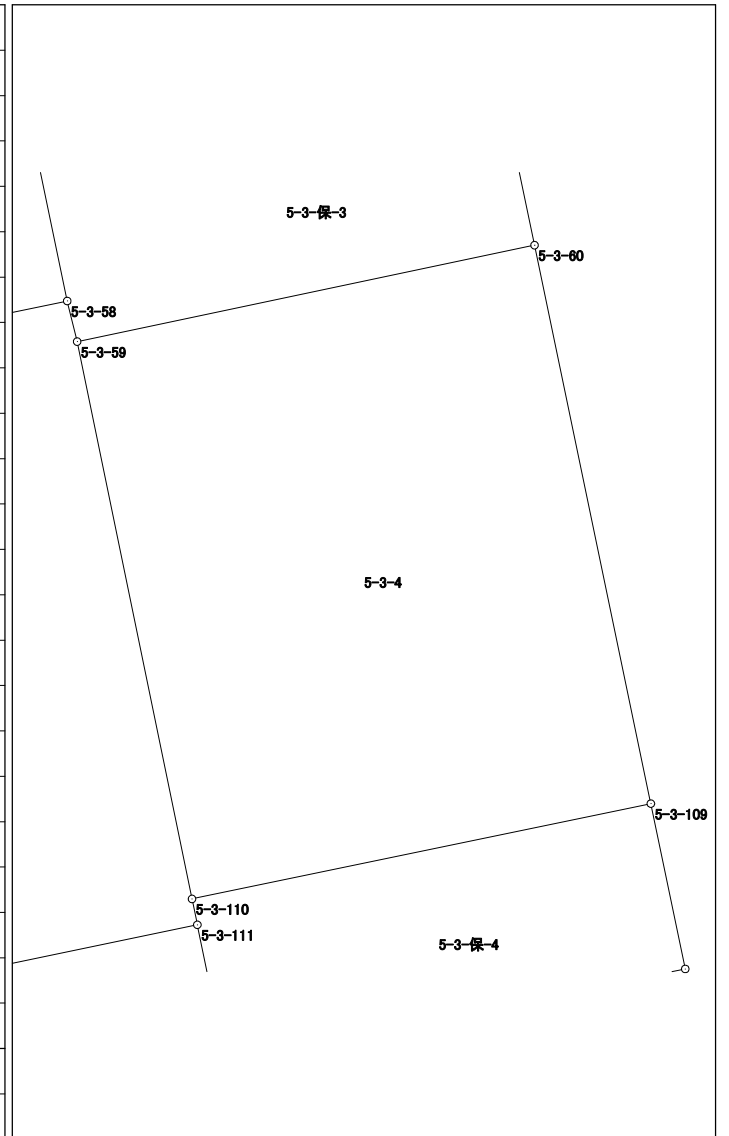


倍面積	127.982087
面積	63.9910435

面積計算書（座標法）

世界測地系（測地成果2011）

所在	地番	公簿地目	現況地目	地積	所有者
前橋市六供町一丁目	5-3-5			66.09 m ²	

点名	X座標	Y座標	辺長	方向角	測角	DX	倍積 (Y×DX)
5-3-113	41878.078	-68410.235	9.176	168-16-47	90-01-09	-10.497	718102.236795
5-3-64	41869.093	-68408.371	5.306	78-35-49	90-19-02	-7.936	542888.832256
5-3-36	41870.142	-68403.170	3.007	33-20-48	134-44-59	3.561	-243583.688370
5-3-35	41872.654	-68401.517	7.084	348-15-20	134-54-32	9.448	-646257.532616
5-3-114	41879.590	-68402.959	7.431	258-15-38	90-00-18	5.424	-371017.649616
倍面積							132.198449
面積							66.0992245

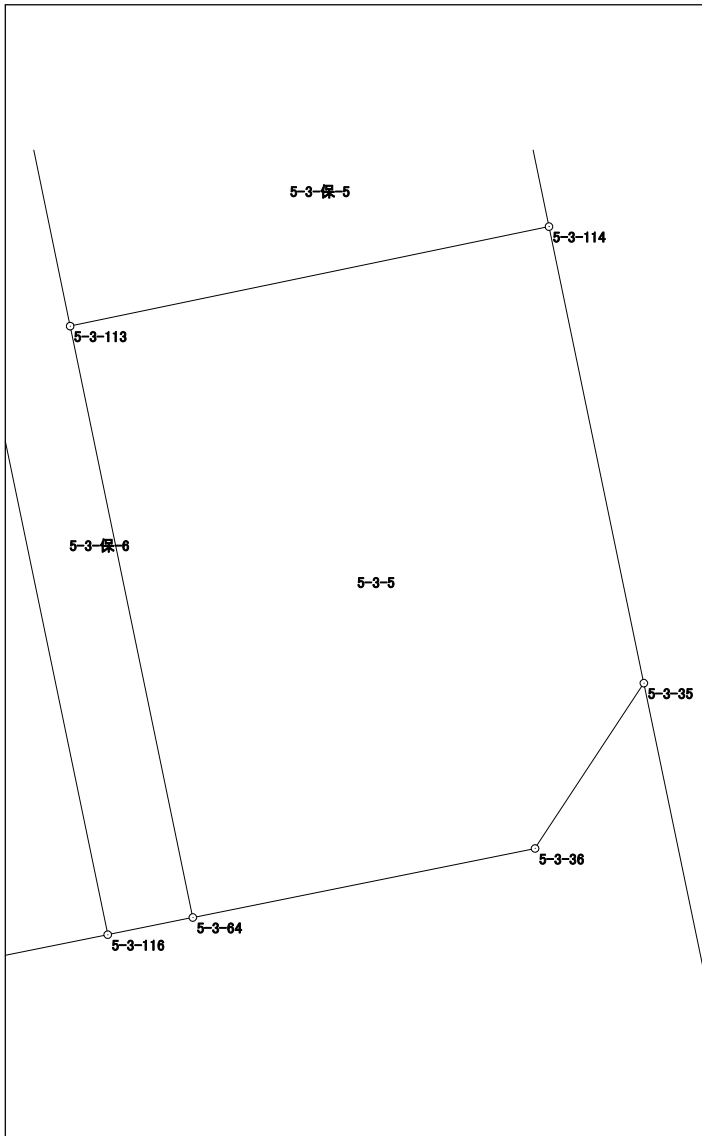


面積計算書 (座標法)

世界測地系 (測地成果2011)

所在	地番	公簿地目	現況地目	地積	所有者
前橋市六供町一丁目	5-3-6			67.61 m ²	

点名	X座標	Y座標	辺長	方向角	測角	DX	倍積 (Y×DX)
5-3-115	41880.708	-68412.127	5.766	258-12-38	89-55-38	10.698	-731872.934646
5-3-61	41879.530	-68417.771	9.989	168-16-30	90-03-52	-10.959	749790.352389
5-3-21	41869.749	-68415.741	2.972	123-34-01	135-17-31	-11.424	781581.425184
5-3-20	41868.106	-68413.265	3.673	78-36-05	135-02-04	-0.917	62734.964005
5-3-116	41868.832	-68409.664	12.129	348-17-00	89-40-55	12.602	-862098.585728

倍面積	135.221204
面積	67.6106020

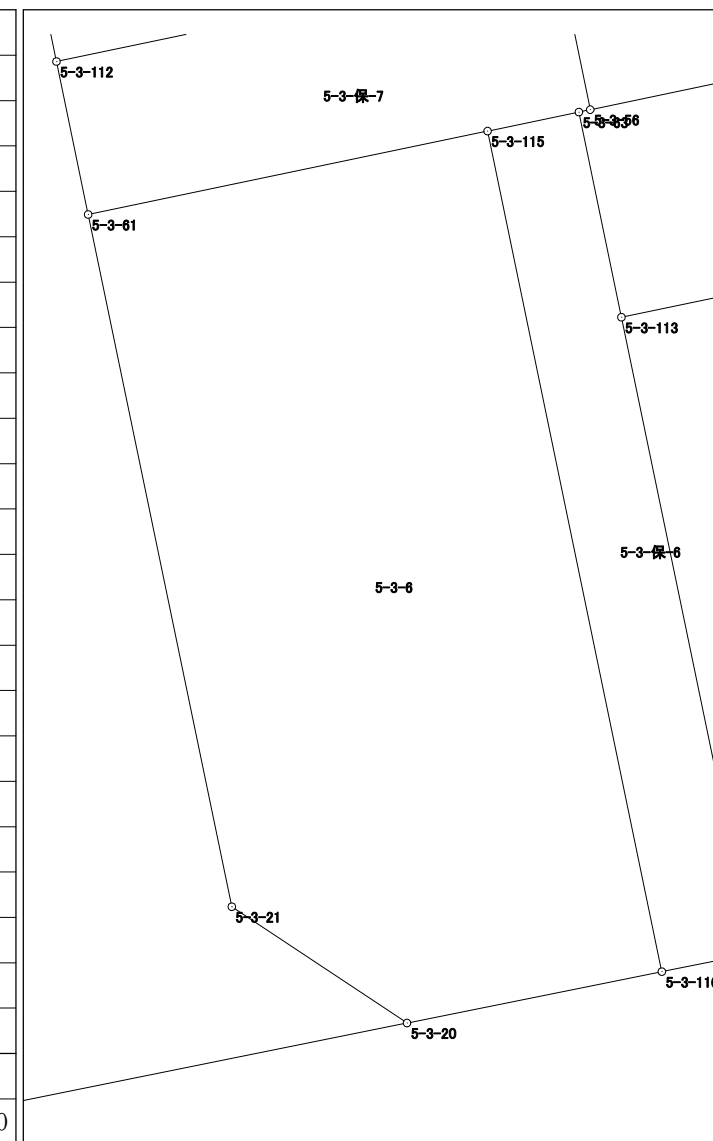


面積計算書（座標法）

世界測地系（測地成果2011）

所 在	地 番	公簿地目	現況地目	地 積	所 有 者
前橋市六供町一丁目	5-3-8			71.05 m ²	

点 名	X 座標	Y 座標	辺 長	方 向 角	測 角	DX	倍 積 (Y×DX)
5-3-107	41895.000	-68413.585	0.035	348-21-59	90-07-40	1.510	-103304.513350
5-3-106	41895.034	-68413.592	9.760	348-19-10	179-57-11	9.592	-656223.174464
5-3-55	41904.592	-68415.568	0.207	261-24-03	93-04-53	9.527	-651795.116336
5-3-54	41904.561	-68415.773	1.140	258-15-23	176-51-20	-0.263	17993.348299
5-3-102	41904.329	-68416.889	5.903	258-14-27	179-59-04	-1.435	98178.235715
5-3-51	41903.126	-68422.668	9.807	168-16-06	90-01-39	-10.805	739306.927740
5-3-108	41893.524	-68420.674	7.241	78-14-19	89-58-13	-8.126	555986.396924

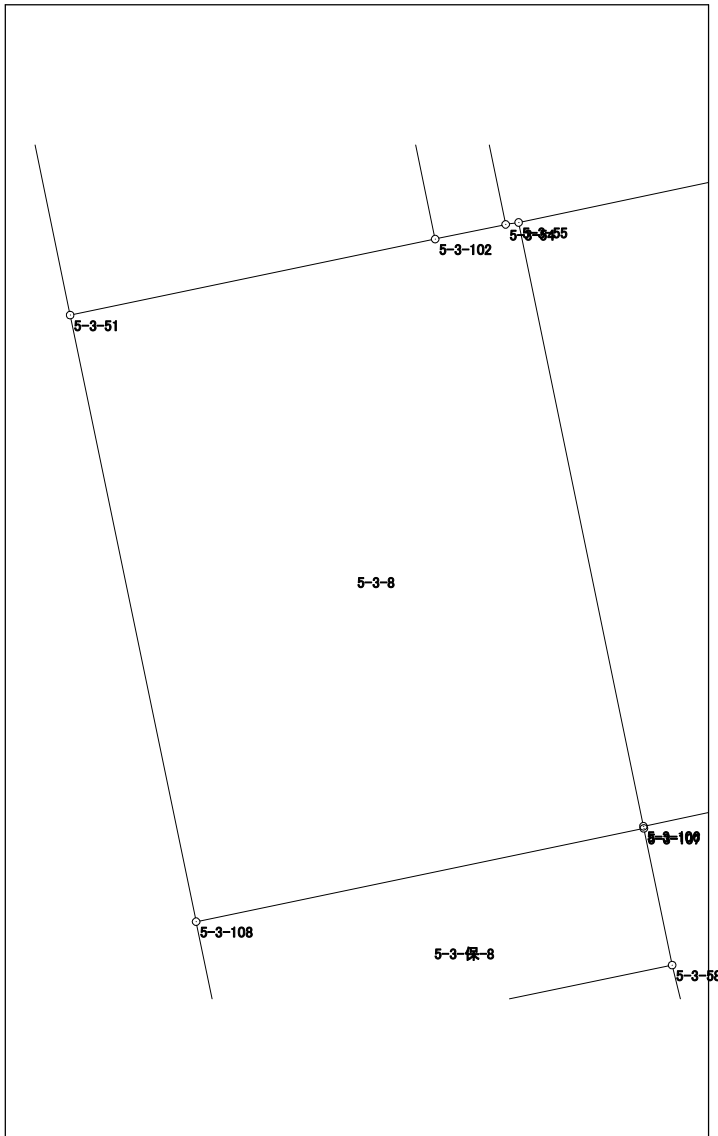


倍面積	142.104528
面積	71.0522640

面積計算書 (座標法)

世界測地系 (測地成果2011)

所在	地番	公簿地目	現況地目	地積	所有者
前橋市六供町一丁目	5-3-保-1			14.00 m ²	

点名	X座標	Y座標	辺長	方向角	測角	DX	倍積 (Y×DX)
5-3-54	41904.561	-68415.773	2.273	348-14-42	89-59-19	2.457	-168097.554261
5-3-104	41906.786	-68416.236	10.017	348-14-57	180-00-15	12.032	-823184.151552
5-3-53	41916.593	-68418.276	1.139	258-14-46	89-59-49	9.575	-655104.992700
5-3-101	41916.361	-68419.391	12.289	168-15-11	90-00-25	-12.264	839095.411224
5-3-102	41904.329	-68416.889	1.140	78-15-23	90-00-12	-11.800	807319.290200
						倍面積	28.002911
						面積	14.0014555

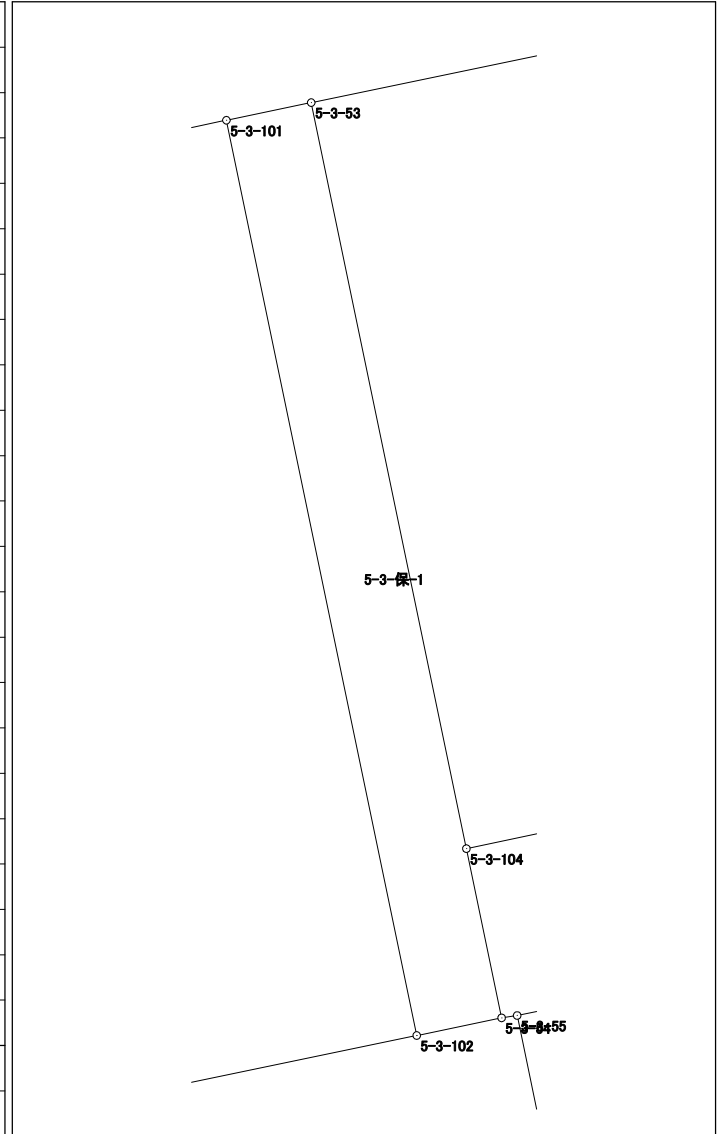


面積計算書（座標法）

世界測地系（測地成果2011）

所 在	地 番	公簿地目	現況地目	地 積	所 有 者
前橋市六供町一丁目	5-3-保-2			17.00 m ²	

点 名	X 座標	Y 座標	辺 長	方 向 角	測 角	DX	倍 積 (Y×DX)
5-3-55	41904.592	-68415.568	7.256	78-06-34	176-42-31	1.526	-104402.156768
5-3-52	41906.087	-68408.468	2.273	348-14-42	90-08-08	3.720	-254479.500960
5-3-103	41908.312	-68408.931	7.463	258-12-03	89-57-21	0.699	-47817.842769
5-3-104	41906.786	-68416.236	2.273	168-14-42	90-02-39	-3.751	256629.301236
5-3-54	41904.561	-68415.773	0.207	81-24-03	93-09-21	-2.194	150104.205962

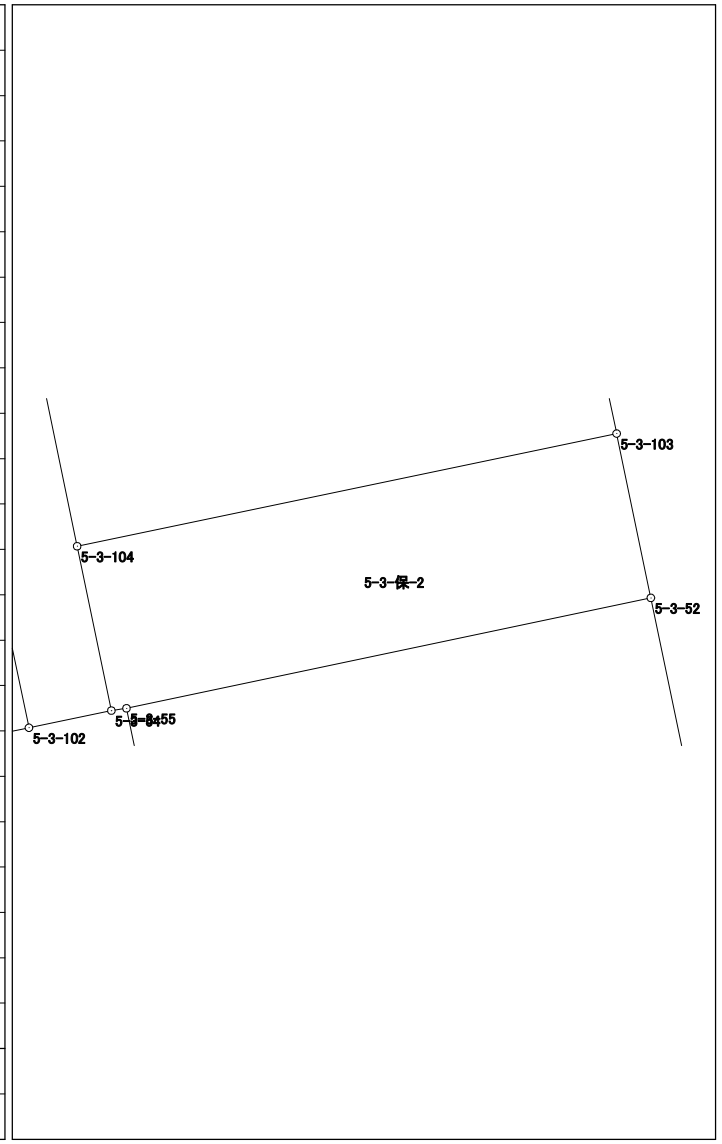

倍面積	34.006701
面 積	17.0033505

面積計算書（座標法）

世界測地系（測地成果2011）

所 在	地 番	公簿地目	現況地目	地 積	所 有 者
前橋市六供町一丁目	5-3-保-3			21.00 m ²	


点 名	X 座標	Y 座標	辺 長	方 向 角	測 角	DX	倍 積 (Y×DX)	
5-3-60	41893.700	-68405.897	2.892	348-16-14	90-10-07	4.325	-295855.504525	
5-3-105	41896.532	-68406.485	7.263	258-05-51	89-49-37	1.334	-91254.250990	
5-3-106	41895.034	-68413.592	0.035	168-21-59	90-16-08	-1.532	104809.622944	
5-3-107	41895.000	-68413.585	2.210	168-18-13	179-56-14	-2.198	150373.059830	
5-3-58	41892.836	-68413.137	0.648	166-14-34	177-56-21	-2.793	191077.891641	
5-3-59	41892.207	-68412.983	7.242	78-06-07	91-51-33	0.864	-59108.817312	
						倍面積	42.001588	
						面 積	21.0007940	

面積計算書（座標法）

世界測地系（測地成果2011）

所 在	地 番	公簿地目	現況地目	地 積	所 有 者
前橋市六供町一丁目	5-3-保-4			19.00 m ²	

点 名	X 座標	Y 座標	辺 長	方 向 角	測 角	DX	倍 積 (Y×DX)
5-3-56	41881.011	-68410.676	7.266	78-15-48	89-53-38	-0.684	46792.902384
5-3-62	41882.489	-68403.562	2.616	348-14-36	89-58-48	4.039	-276281.986918
5-3-109	41885.050	-68404.095	7.261	258-16-14	90-01-38	1.085	-74218.443075
5-3-110	41883.574	-68411.204	0.409	168-18-21	90-02-07	-1.877	128407.829908
5-3-111	41883.173	-68411.121	2.207	168-22-10	180-03-49	-2.563	175337.703123
						倍面積	38.005422
						面 積	19.0027110

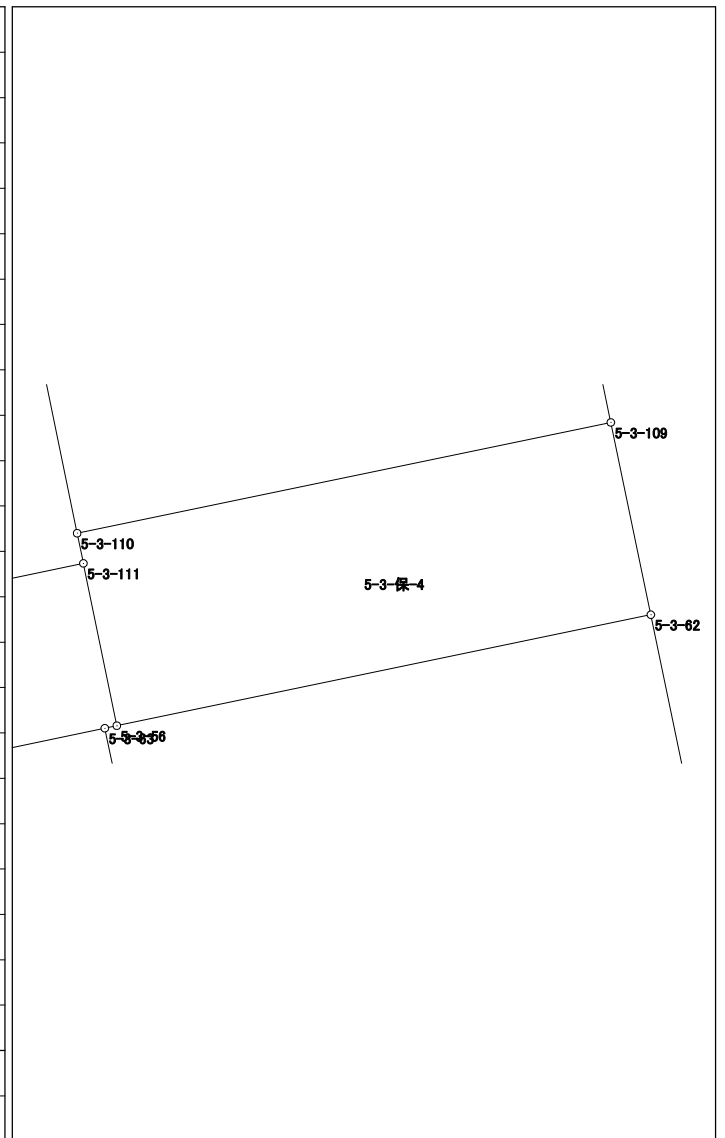


面積計算書（座標法）

世界測地系（測地成果2011）

所 在	地 番	公簿地目	現況地目	地 積	所 有 者
前橋市六供町一丁目	5-3-保-5			22.00 m ²	

点 名	X 座標	Y 座標	辺 長	方 向 角	測 角	DX	倍 積 (Y×DX)
5-3-56	41881.011	-68410.676	0.164	258-00-11	179-44-23	-1.512	103436.942112
5-3-63	41880.977	-68410.836	2.961	168-17-16	90-17-05	-2.933	200648.981988
5-3-113	41878.078	-68410.235	7.431	78-15-38	89-58-22	-1.387	94884.995945
5-3-114	41879.590	-68402.959	2.961	348-15-00	89-59-22	4.411	-301725.452149
5-3-62	41882.489	-68403.562	7.266	258-15-48	90-00-48	1.421	-97201.461602
						倍面積	44.006294
						面 積	22.0031470

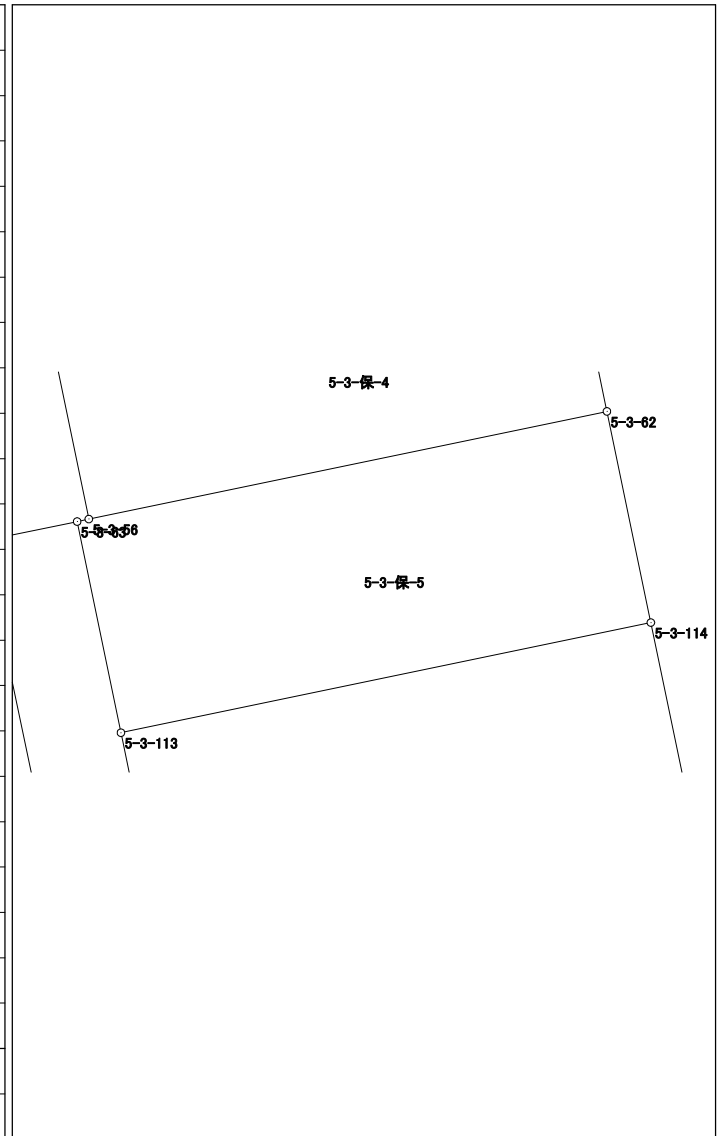


面積計算書（座標法）

世界測地系（測地成果2011）

所 在	地 番	公簿地目	現況地目	地 積	所 有 者
前橋市六供町一丁目	5-3-保-6			16.00 m ²	

点 名	X 座標	Y 座標	辺 長	方 向 角	測 角	DX	倍 積 (Y×DX)
5-3-63	41880.977	-68410.836	1.319	258-13-48	89-56-32	2.630	-179920.498680
5-3-115	41880.708	-68412.127	12.129	168-17-00	90-03-12	-12.145	830865.282415
5-3-116	41868.832	-68409.664	1.319	78-35-16	90-18-16	-11.615	794578.247360
5-3-64	41869.093	-68408.371	9.176	348-16-47	89-41-31	9.246	-632503.798266
5-3-113	41878.078	-68410.235	2.961	348-17-16	180-00-29	11.884	-812987.232740
倍面積						32.000089	
面 積						16.0000445	

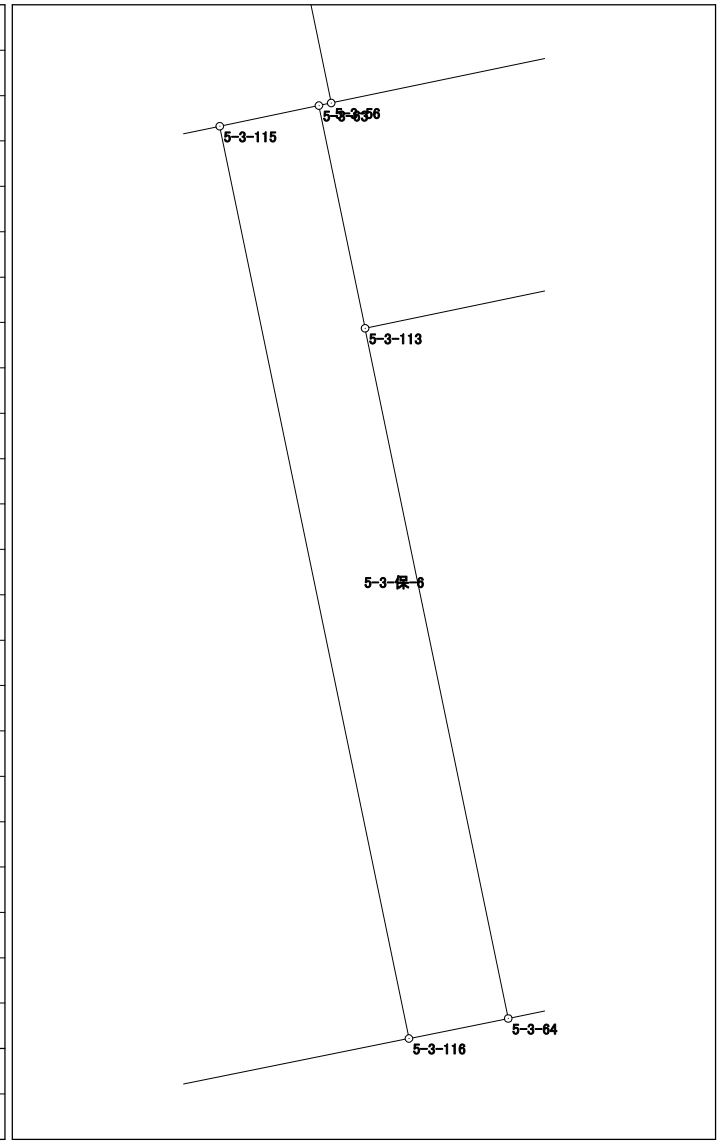


面積計算書 (座標法)

世界測地系 (測地成果2011)

所在	地番	公簿地目	現況地目	地積	所有者
前橋市六供町一丁目	5-3-保-7			16.00 m ²	

点名	X座標	Y座標	辺長	方向角	測角	DX	倍積 (Y×DX)
5-3-63	41880.977	-68410.836	0.164	78-00-11	179-46-23	0.303	-20728.483308
5-3-56	41881.011	-68410.676	2.207	348-22-10	90-21-59	2.196	-150229.844496
5-3-111	41883.173	-68411.121	7.251	258-12-24	89-50-14	0.680	-46519.562280
5-3-112	41881.691	-68418.219	2.207	168-17-16	90-04-52	-3.643	249247.571817
5-3-61	41879.530	-68417.771	5.766	78-12-38	89-55-22	-0.983	67254.668893
5-3-115	41880.708	-68412.127	1.319	78-13-48	180-01-10	1.447	-98992.347769

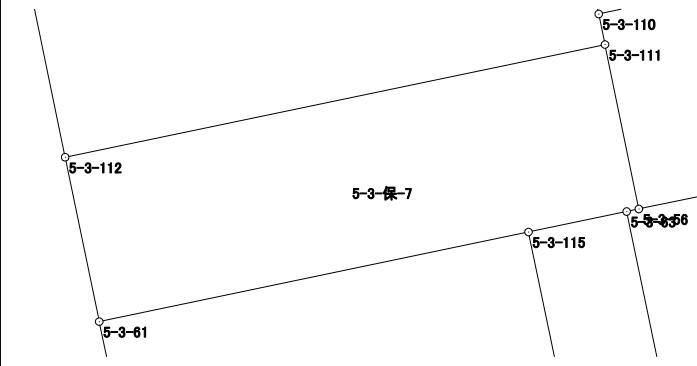

倍面積	32.002857
面積	16.0014285

面積計算書（座標法）

世界測地系（測地成果2011）

所在	地番	公簿地目	現況地目	地積	所有者
前橋市六供町一丁目	5-3-保-8			16.00 m ²	

点名	X座標	Y座標	辺長	方向角	測角	DX	倍積 (Y×DX)
5-3-57	41891.360	-68420.224	7.239	78-14-07	89-58-57	-0.688	47073.114112
5-3-58	41892.836	-68413.137	2.210	348-18-13	90-04-06	3.640	-249023.818680
5-3-107	41895.000	-68413.585	7.241	258-14-19	89-56-06	0.688	-47068.546480
5-3-108	41893.524	-68420.674	2.210	168-15-10	90-00-51	-3.640	249051.253360
						倍面積	32.002312
						面積	16.0011560

