



61街区 画地出来形確認図 (7380.81m²)

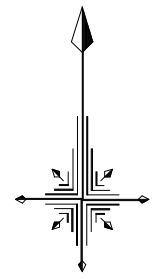

S=1/500

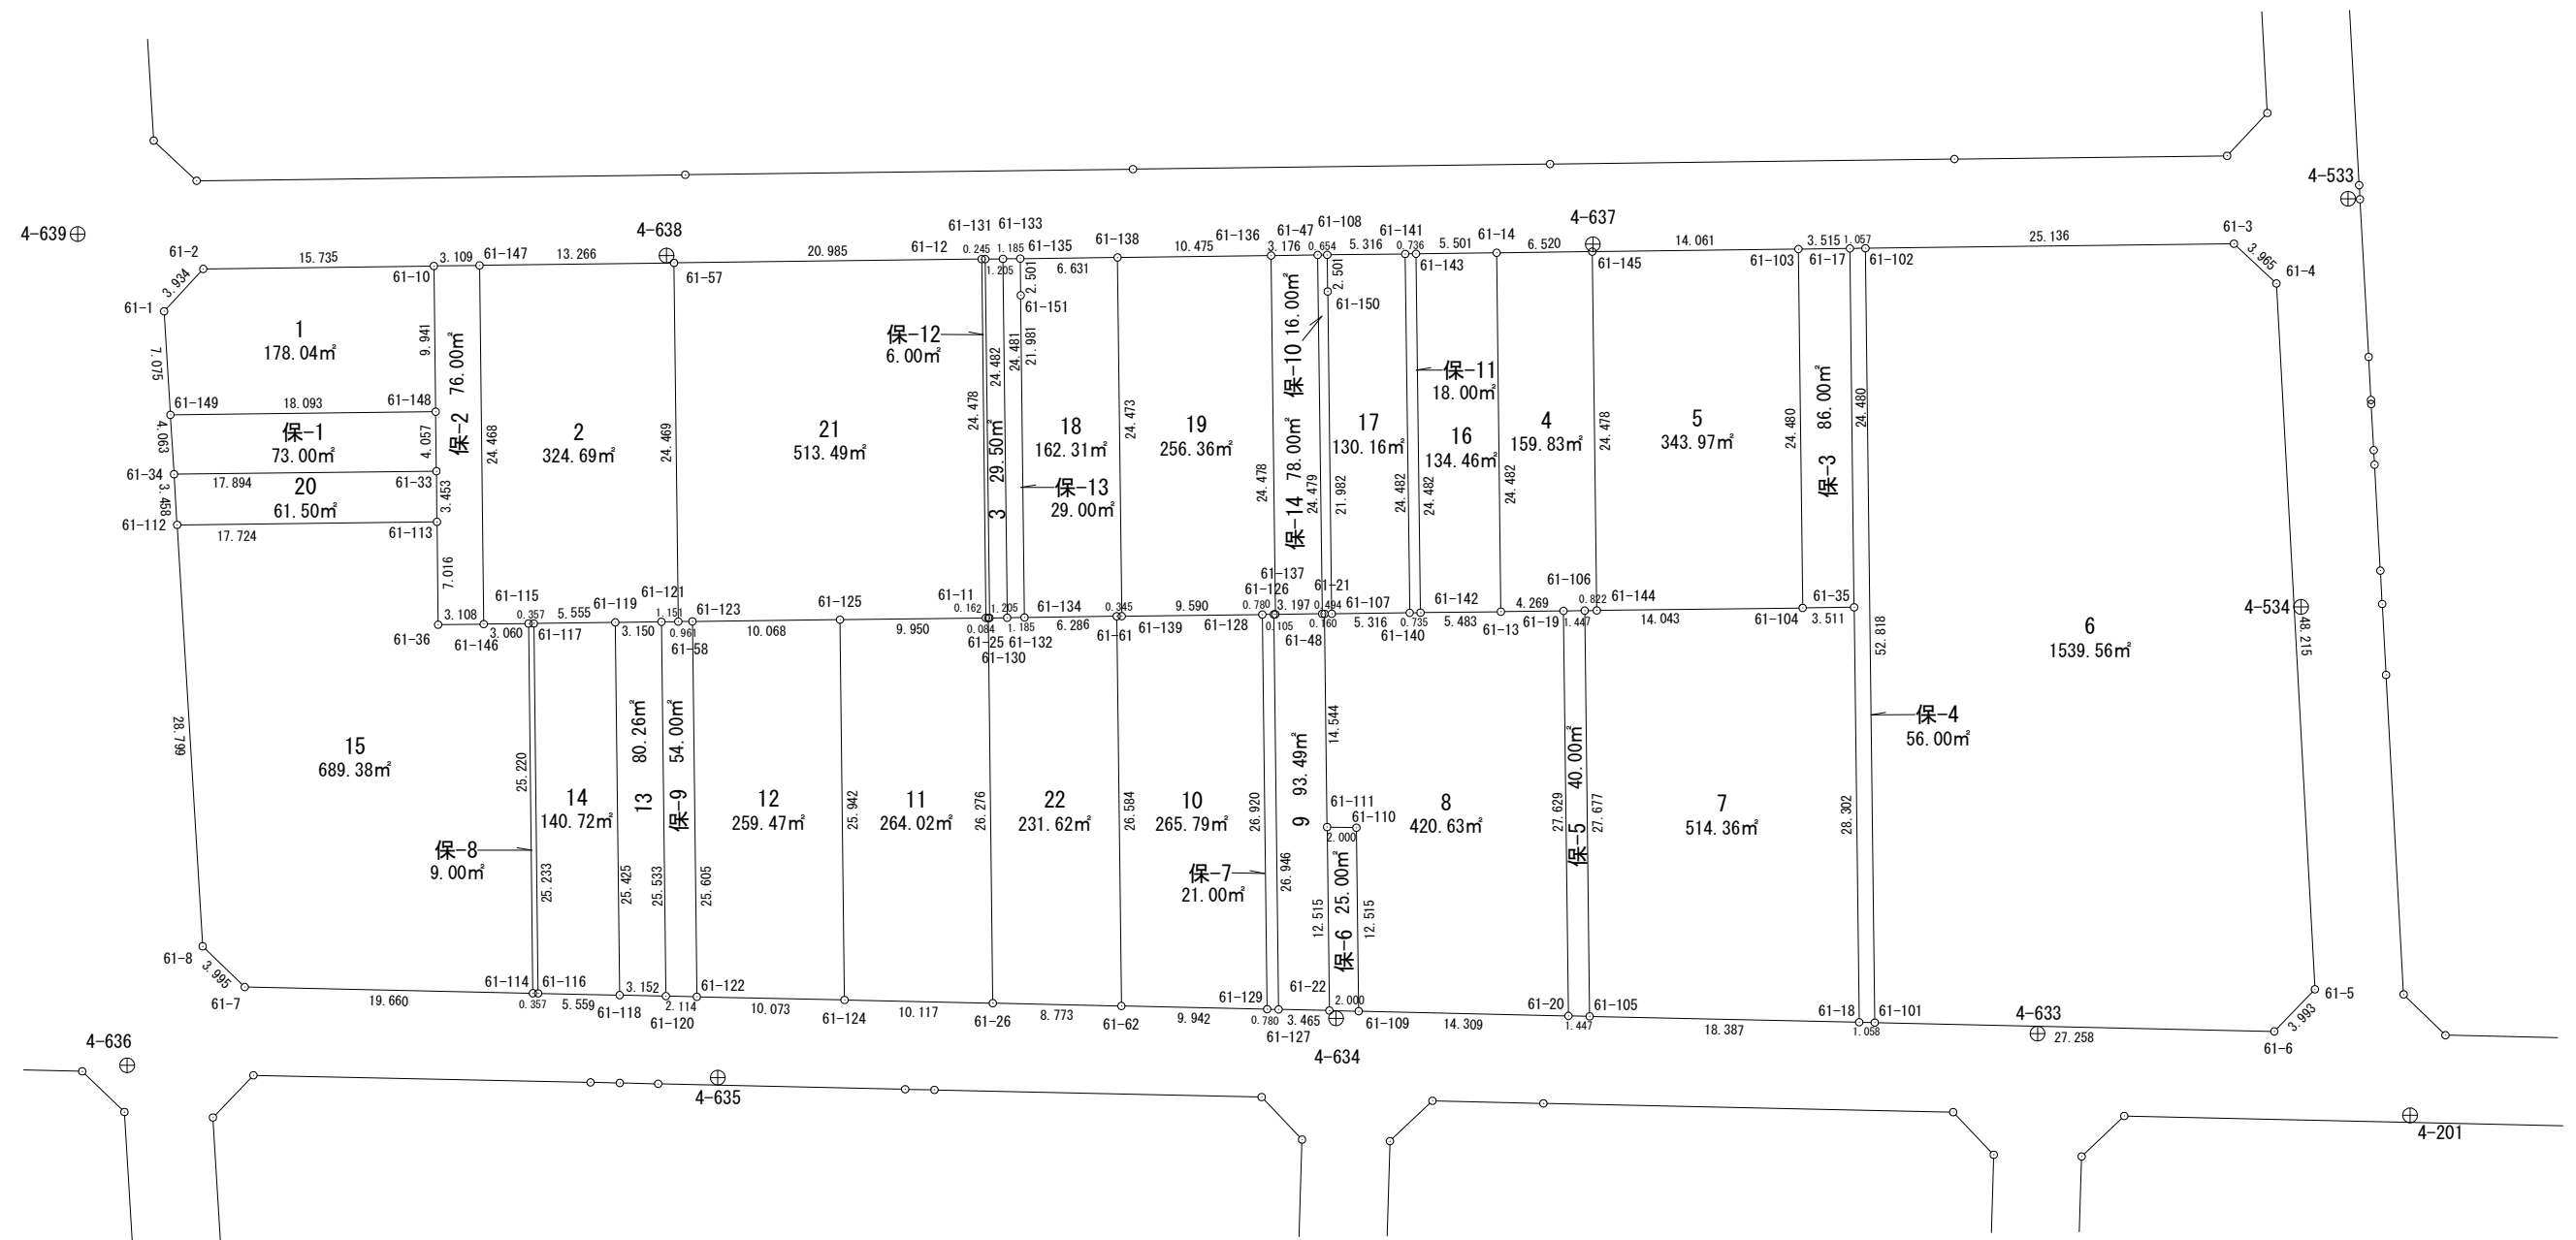


面積計算書 (座標法)

世界測地系 (測地成果2011)

所 在	地 番	公簿地目	現況地目	地 積	所 有 者
前橋市六供町二丁目	61-1			178.04 m ²	

点 名	X 座標	Y 座標	辺 長	方 向 角	測 角	DX	倍 積 (Y×DX)
61-148	41382.435	-68109.939	9.941	359-18-30	89-58-24	10.150	-691315.880850
61-10	41392.375	-68110.059	15.735	269-16-44	89-58-14	9.742	-663528.194778
61-2	41392.177	-68125.793	3.934	222-43-24	133-26-40	-3.088	210372.448784
61-1	41389.287	-68128.462	7.075	176-30-27	133-47-03	-9.952	678014.453824
61-149	41382.225	-68128.031	18.093	89-20-06	92-49-39	-6.852	466813.268412
							倍面積 356.095392
							面 積 178.0476960

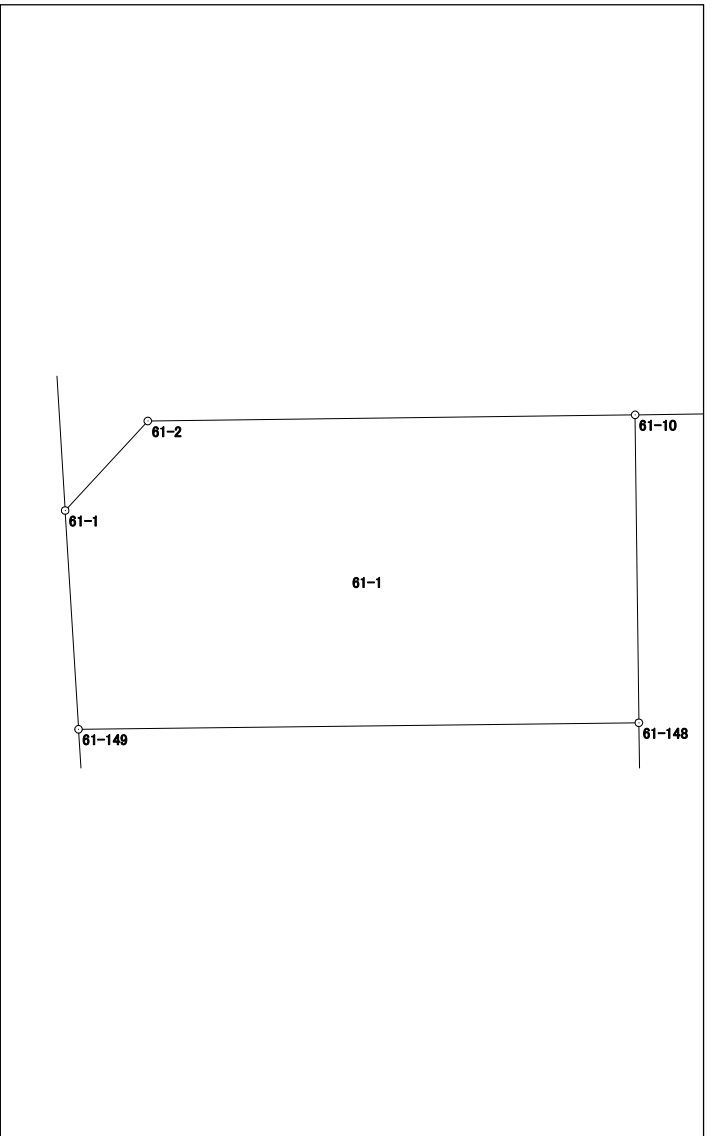


面積計算書 (座標法)

世界測地系 (測地成果2011)

所在	地番	公簿地目	現況地目	地積	所有者
前橋市六供町二丁目	61-2			324.69 m ²	

点名	X座標	Y座標	辺長	方向角	測角	DX	倍積 (Y×DX)
61-146	41367.949	-68106.664	3.060	89-15-04	89-55-15	-24.426	1663573.374864
61-115	41367.989	-68103.604	0.357	89-11-51	179-56-47	0.045	-3064.662180
61-117	41367.994	-68103.247	5.555	89-15-27	180-03-36	0.077	-5243.950019
61-119	41368.066	-68097.692	3.150	89-16-21	180-00-54	0.112	-7626.941504
61-121	41368.106	-68094.542	1.151	89-15-12	179-58-51	0.055	-3745.199810
61-58	41368.121	-68093.391	24.469	359-18-42	90-03-30	24.482	-1667062.398462
61-57	41392.588	-68093.685	13.266	269-15-10	89-56-28	24.294	-1654267.983390
61-147	41392.415	-68106.950	24.468	179-19-49	90-04-39	-24.639	1678087.141050

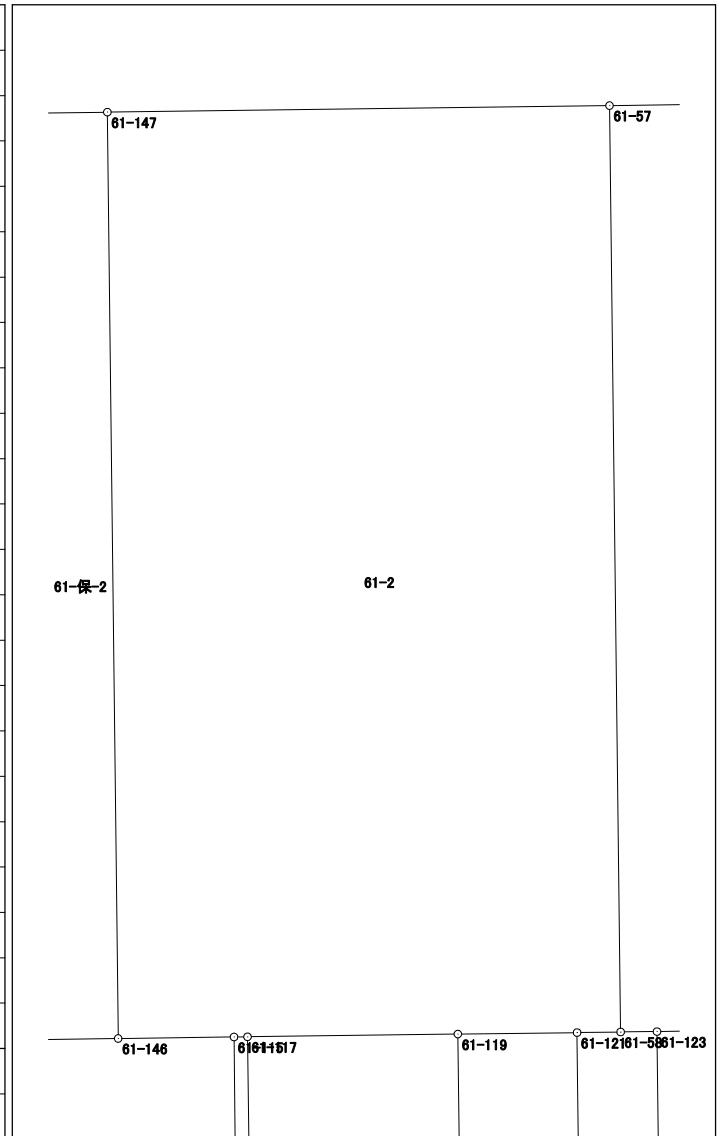

倍面積	649.380549
面積	324.6902745


面積計算書 (座標法)

世界測地系 (測地成果2011)

所在	地番	公簿地目	現況地目	地積	所有者
前橋市六供町二丁目	61-3			29.50 m ²	

点名	X座標	Y座標	辺長	方向角	測角	DX	倍積 (Y×DX)
61-131	41392.848	-68072.457	24.482	179-19-25	90-02-12	-24.495	1667434.834215
61-130	41368.368	-68072.168	1.205	89-14-21	89-54-56	-24.464	1665317.517952
61-132	41368.384	-68070.963	24.481	359-19-25	90-05-04	24.495	-1667398.238685
61-133	41392.863	-68071.252	1.205	269-17-13	89-57-48	24.464	-1665295.108928

倍面積	59.004554
面積	29.5022770

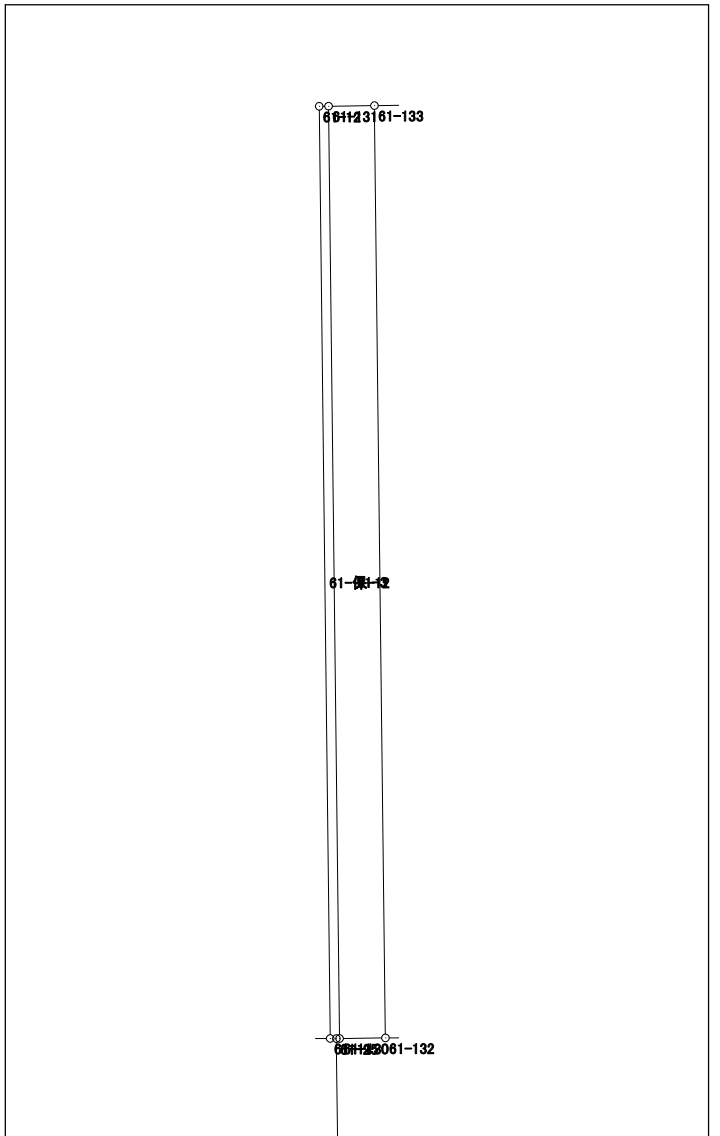


面積計算書 (座標法)

世界測地系 (測地成果2011)

所在	地番	公簿地目	現況地目	地積	所有者
前橋市六供町二丁目	61-4			159.83 m ²	

点名	X座標	Y座標	辺長	方向角	測角	DX	倍積 (Y×DX)
61-13	41368.796	-68037.289	4.269	89-14-54	89-55-37	-24.424	1661742.746536
61-19	41368.852	-68033.020	1.447	89-19-37	180-04-43	0.073	-4966.410460
61-106	41368.869	-68031.573	0.822	89-14-00	179-54-23	0.028	-1904.884044
61-144	41368.880	-68030.751	24.478	359-16-45	90-02-45	24.487	-1665868.999737
61-145	41393.356	-68031.059	6.520	269-17-49	90-01-04	24.396	-1659685.715364
61-14	41393.276	-68037.579	24.482	179-19-17	90-01-28	-24.560	1671002.940240
倍面積							319.677171
面積							159.8385855

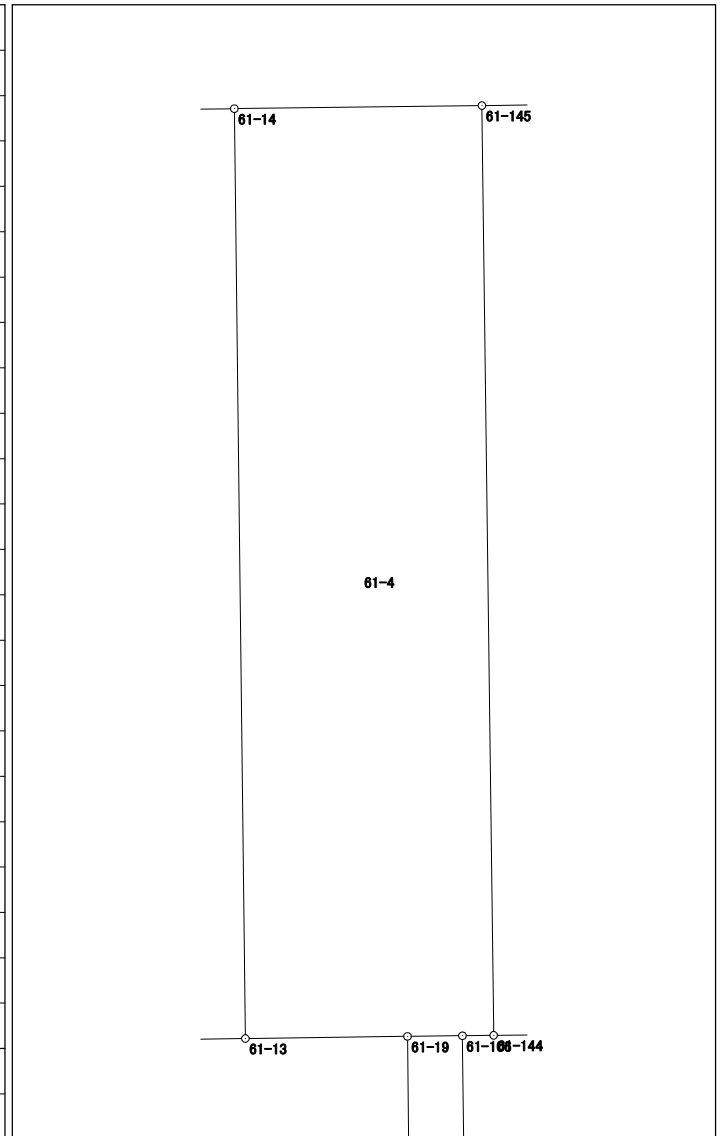


面積計算書 (座標法)

世界測地系 (測地成果2011)

所在	地番	公簿地目	現況地目	地積	所有者
前橋市六供町二丁目	61-5			343.97 m ²	

点名	X座標	Y座標	辺長	方向角	測角	DX	倍積 (Y×DX)
61-144	41368.880	-68030.751	14.043	89-17-54	90-01-09	-24.304	1653419.372304
61-104	41369.052	-68016.709	24.480	359-19-16	90-01-22	24.650	-1676611.876850
61-103	41393.530	-68016.999	14.061	269-17-27	89-58-11	24.304	-1653085.143696
61-145	41393.356	-68031.059	24.478	179-16-45	89-59-18	-24.650	1676965.604350

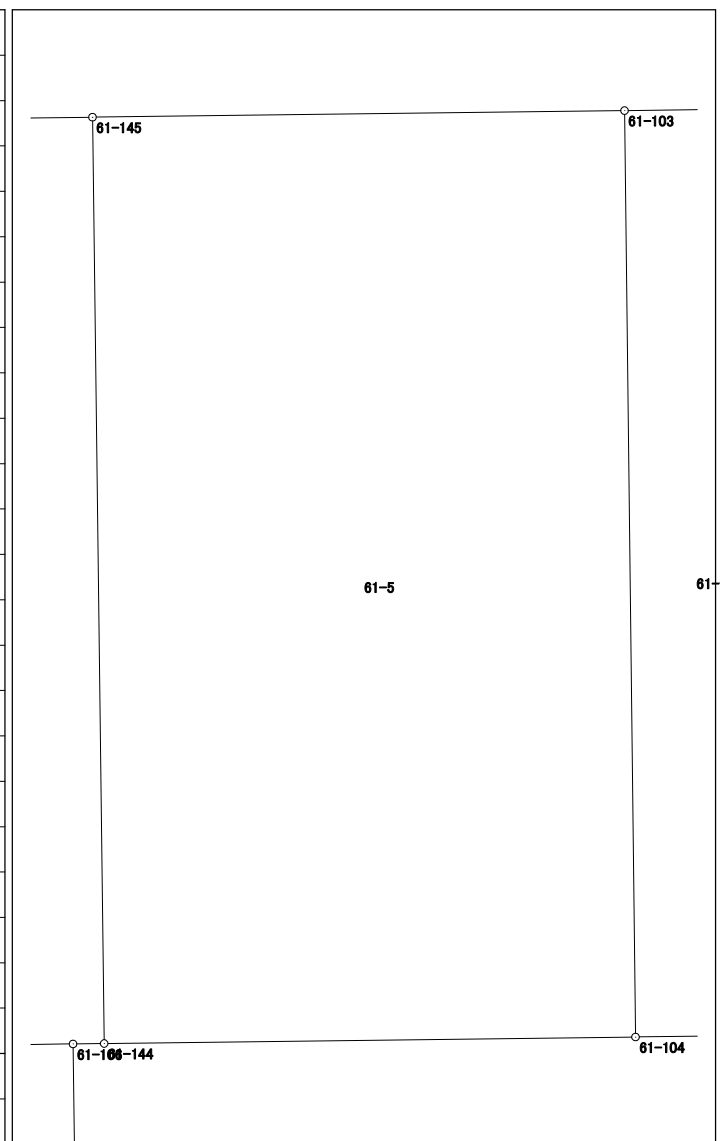


倍面積	687.956108
面積	343.9780540

面積計算書 (座標法)

世界測地系 (測地成果2011)

所 在	地 番	公簿地目	現況地目	地 積	所 有 者
前橋市六供町二丁目	61-6			1539.56 m ²	

点 名	X 座標	Y 座標	辺 長	方 向 角	測 角	DX	倍 積 (Y×DX)
61-101	41340.772	-68011.795	27.258	91-16-19	91-57-27	-53.419	3633122.077105
61-6	41340.167	-67984.544	3.993	43-57-54	132-41-35	2.269	-154256.930336
61-5	41343.041	-67981.772	48.215	356-52-40	132-54-46	51.017	-3468226.062124
61-4	41391.184	-67984.398	3.965	313-05-56	136-13-16	50.852	-3457142.607096
61-3	41393.893	-67987.293	25.136	269-18-01	136-12-05	2.402	-163305.477786
61-102	41393.586	-68012.427	52.818	179-18-52	90-00-51	-53.121	3612888.134667
倍面積							3079.134430
面 積							1539.5672150

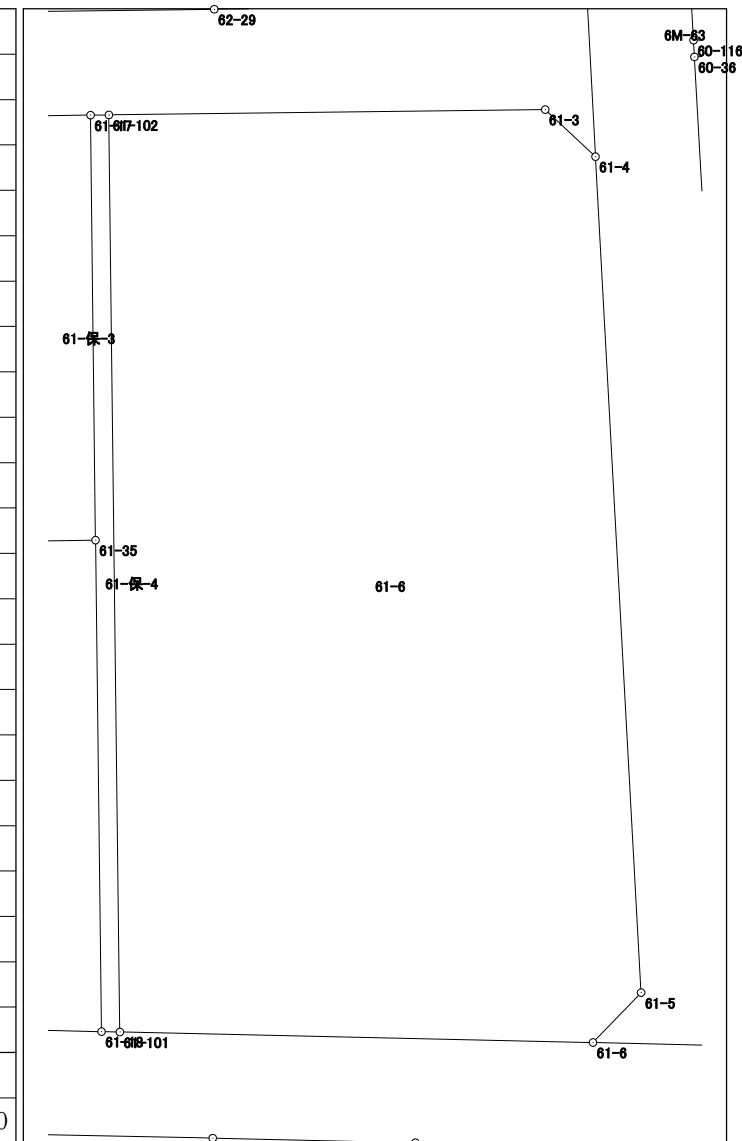


面積計算書 (座標法)

世界測地系 (測地成果2011)

所 在	地 番	公簿地目	現況地目	地 積	所 有 者
前橋市六供町二丁目	61-7			514.36 m ²	

点 名	X 座 標	Y 座 標	辺 長	方 向 角	測 角	DX	倍 積 (Y×DX)
61-105	41341.194	-68031.236	18.387	91-14-36	91-56-28	-28.074	1909908.919464
61-18	41340.795	-68012.853	28.302	359-18-06	88-03-30	27.901	-1897626.611553
61-35	41369.095	-68013.198	3.511	269-17-54	89-59-48	28.257	-1921848.935886
61-104	41369.052	-68016.709	14.043	269-17-54	180-00-00	-0.215	14623.592435
61-144	41368.880	-68030.751	0.822	269-14-00	179-56-06	-0.183	12449.627433
61-106	41368.869	-68031.573	27.677	179-18-08	90-04-08	-27.686	1883522.130078

倍面積	1028.721971
面 積	514.3609855

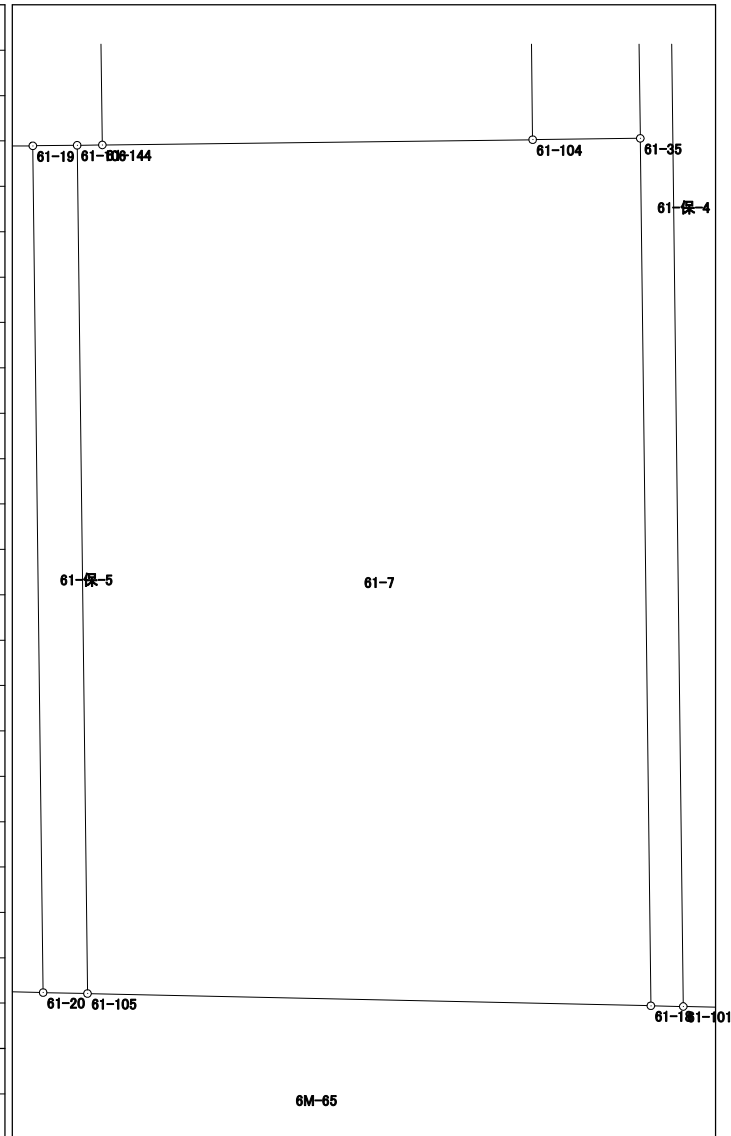


面積計算書（座標法）

世界測地系（測地成果2011）

所在	地番	公簿地目	現況地目	地積	所有者
前橋市六供町二丁目	61-8			420.63 m ²	

点名	X座標	Y座標	辺長	方向角	測角	DX	倍積 (Y×DX)
61-21	41368.649	-68049.317	14.544	179-18-10	89-59-55	-14.549	990049.513033
61-111	41354.106	-68049.140	2.000	91-17-22	91-59-12	-14.588	992700.854320
61-110	41354.061	-68047.141	12.515	179-17-58	268-00-36	-12.559	854604.043819
61-109	41341.547	-68046.988	14.309	91-17-22	91-59-24	-12.836	873451.137968
61-20	41341.225	-68032.683	27.629	359-18-04	88-00-42	27.305	-1857632.409315
61-19	41368.852	-68033.020	4.269	269-14-54	89-56-50	27.571	-1875738.394420
61-13	41368.796	-68037.289	5.483	269-18-00	180-03-06	-0.123	8368.586547
61-142	41368.729	-68042.772	0.735	269-17-54	179-59-54	-0.076	5171.250672
61-140	41368.720	-68043.507	5.316	269-17-58	180-00-04	-0.074	5035.219518
61-107	41368.655	-68048.823	0.494	269-18-15	180-00-17	-0.071	4831.466433
						倍面積	841.268575
						面積	420.6342875

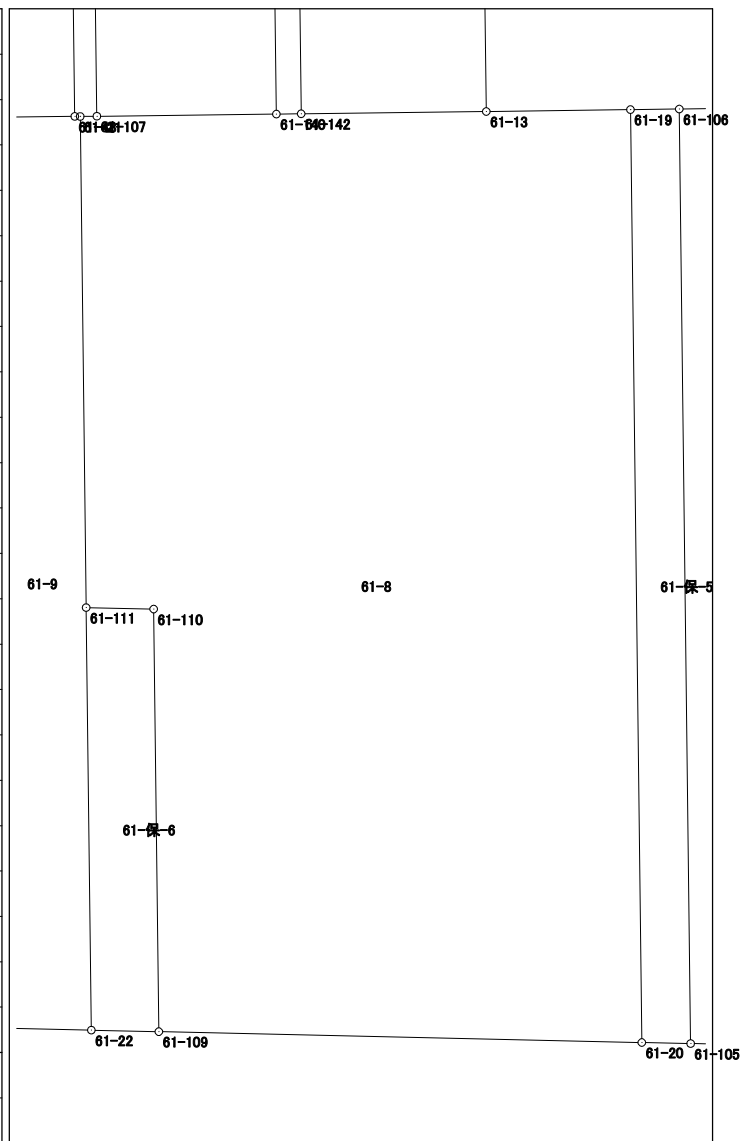


面積計算書 (座標法)

世界測地系 (測地成果2011)

所在	地番	公簿地目	現況地目	地積	所有者
前橋市六供町二丁目	61-9			93.49 m ²	

点名	X座標	Y座標	辺長	方向角	測角	DX	倍積 (Y×DX)
61-22	41341.592	-68048.987	12.515	359-17-58	88-02-33	12.438	-846393.300306
61-111	41354.106	-68049.140	14.544	359-18-10	180-00-12	27.057	-1841205.580980
61-21	41368.649	-68049.317	0.160	270-42-58	91-24-48	14.545	-989777.315765
61-48	41368.651	-68049.477	3.197	269-19-08	178-36-10	-0.036	2449.781172
61-137	41368.613	-68052.674	0.105	269-27-16	180-08-08	-0.039	2654.054286
61-126	41368.612	-68052.779	26.946	179-18-09	89-50-53	-26.945	1833682.130155
61-127	41341.668	-68052.451	3.465	91-15-25	91-57-16	-27.020	1838777.226020
						倍面積	186.994582
						面積	93.4972910

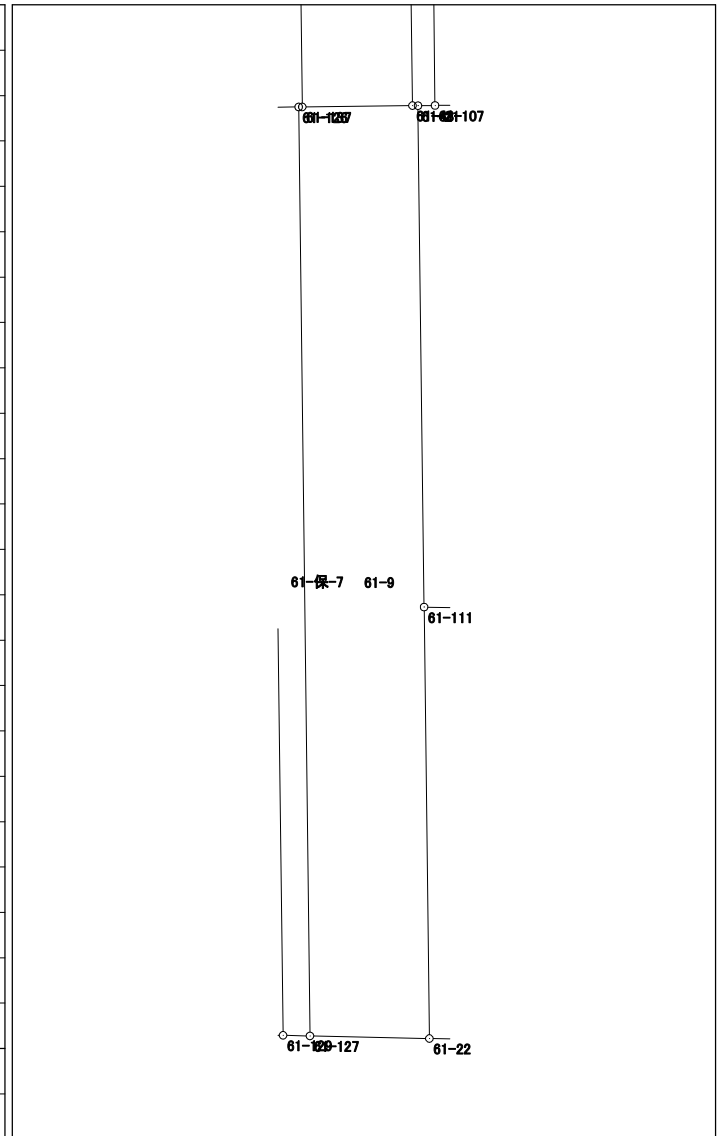


面積計算書（座標法）

世界測地系（測地成果2011）

所在	地番	公簿地目	現況地目	地積	所有者
前橋市六供町二丁目	61-11			264.02 m ²	

点名	X座標	Y座標	辺長	方向角	測角	DX	倍積 (Y×DX)
61-124	41342.311	-68082.057	10.117	91-14-05	91-54-38	-26.158	1780890.447006
61-26	41342.093	-68071.942	26.276	359-19-26	88-05-21	26.056	-1773682.520752
61-25	41368.367	-68072.252	0.162	270-42-26	91-23-00	26.276	-1788666.493552
61-11	41368.369	-68072.414	9.950	269-19-14	178-36-48	-0.116	7896.400024
61-125	41368.251	-68082.363	25.942	179-19-27	90-00-13	-26.058	1774090.215054
						倍面積	528.047780
						面積	264.0238900

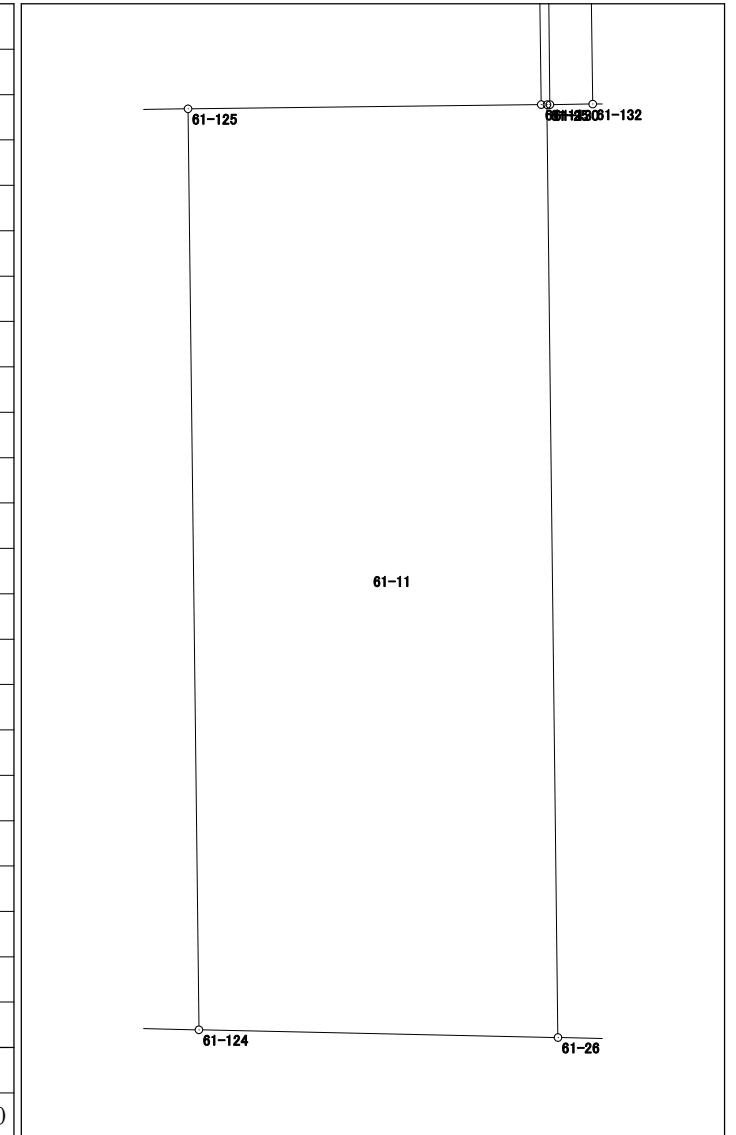


面積計算書 (座標法)

世界測地系 (測地成果2011)

所 在	地 番	公簿地目	現況地目	地 積	所 有 者
前橋市六供町二丁目	61-12			259.47 m ²	

点 名	X 座標	Y 座標	辺 長	方 向 角	測 角	D X	倍 積 (Y×DX)
61-123	41368.132	-68092.430	25.605	179-19-27	90-00-05	-25.722	1751473.484460
61-122	41342.529	-68092.128	10.073	91-14-24	91-54-57	-25.821	1758206.837088
61-124	41342.311	-68082.057	25.942	359-19-27	88-05-03	25.722	-1751206.670154
61-125	41368.251	-68082.363	10.068	269-19-22	89-59-55	25.821	-1757954.695023

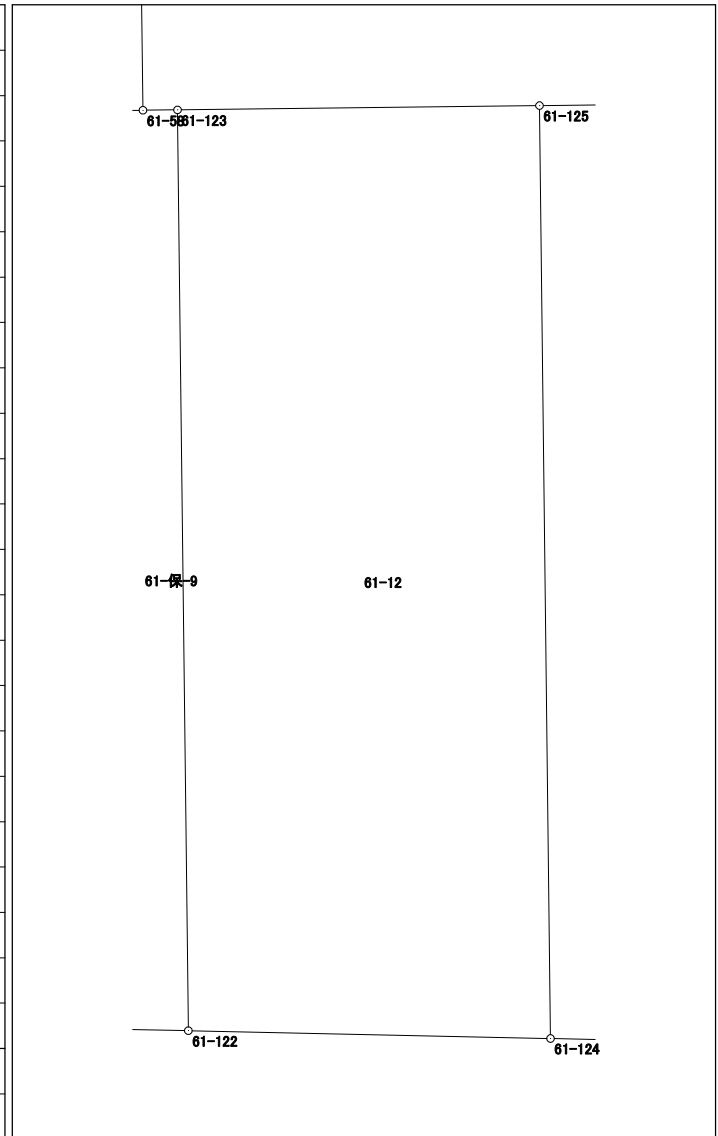


倍面積	518.956371
面 積	259.4781855

面積計算書 (座標法)

世界測地系 (測地成果2011)

所 在	地 番	公簿地目	現況地目	地 積	所 有 者
前橋市六供町二丁目	61-13			80.26 m ²	

点 名	X 座標	Y 座標	辺 長	方 向 角	測 角	DX	倍 積 (Y×DX)
61-119	41368.066	-68097.692	25.425	179-19-26	90-03-05	-25.463	1733971.531396
61-118	41342.643	-68097.392	3.152	91-14-11	91-54-45	-25.491	1735870.619472
61-120	41342.575	-68094.241	25.533	359-19-28	88-05-17	25.463	-1733883.658583
61-121	41368.106	-68094.542	3.150	269-16-21	89-56-53	25.491	-1735797.970122
倍面積							160.522163
面 積							80.2610815

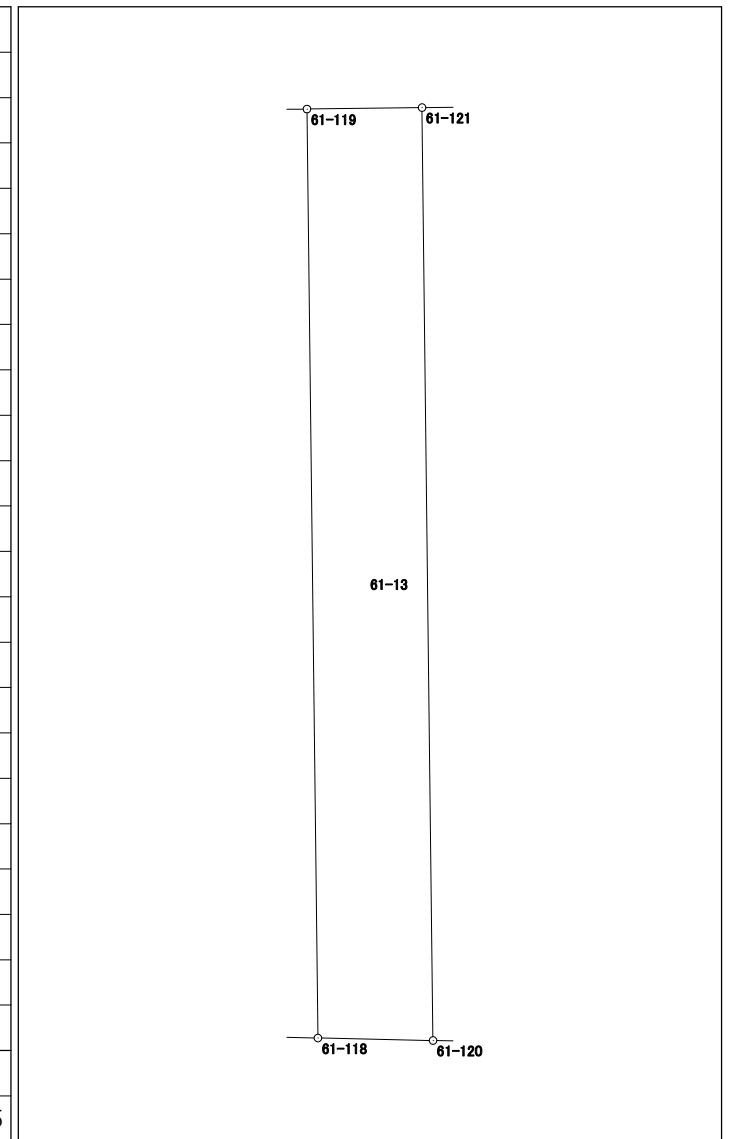


面積計算書 (座標法)

世界測地系 (測地成果2011)

所在	地番	公簿地目	現況地目	地積	所有者
前橋市六供町二丁目	61-14			140.72 m ²	

点名	X座標	Y座標	辺長	方向角	測角	DX	倍積 (Y×DX)
61-117	41367.994	-68103.247	25.233	179-19-32	90-04-05	-25.303	1723216.458841
61-116	41342.763	-68102.950	5.559	91-14-13	91-54-41	-25.351	1726477.885450
61-118	41342.643	-68097.392	25.425	359-19-26	88-05-13	25.303	-1723068.309776
61-119	41368.066	-68097.692	5.555	269-15-27	89-56-01	25.351	-1726344.589892

倍面積	281.444623
面積	140.7223115

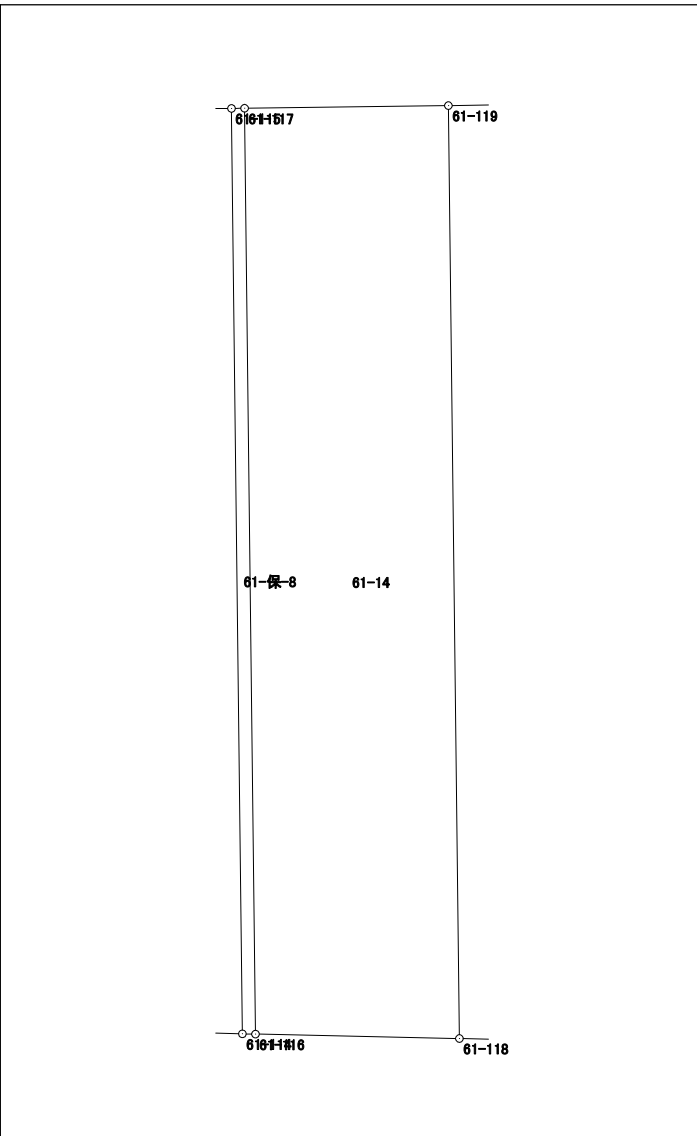


面積計算書 (座標法)

世界測地系 (測地成果2011)

所在	地番	公簿地目	現況地目	地積	所有者
前橋市六供町二丁目	61-15			689.38 m ²	

点名	X座標	Y座標	辺長	方向角	測角	DX	倍積 (Y×DX)
61-112	41374.718	-68127.574	28.799	176-32-10	87-12-19	-28.953	1972497.650022
61-8	41345.972	-68125.834	3.995	134-02-12	137-30-02	-31.523	2147530.665182
61-7	41343.195	-68122.962	19.660	91-14-09	137-11-57	-3.201	218061.601362
61-114	41342.771	-68103.307	25.220	359-19-31	88-05-22	24.794	-1688553.393758
61-115	41367.989	-68103.604	3.060	269-15-04	89-55-33	25.178	-1714712.541512
61-146	41367.949	-68106.664	3.108	269-15-46	180-00-42	-0.080	5448.533120
61-36	41367.909	-68109.772	7.016	359-21-18	270-05-32	6.976	-475133.769472
61-113	41374.925	-68109.851	17.724	269-19-51	89-58-33	6.809	-463759.975459
						倍面積	1378.769485
						面積	689.3847425

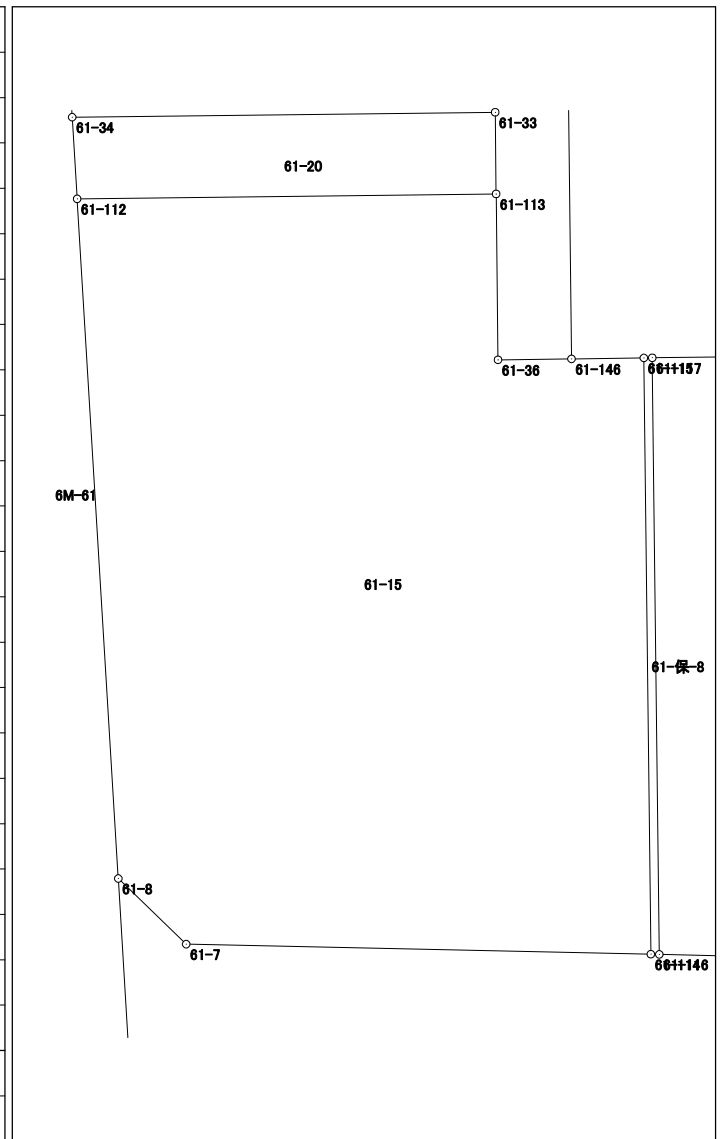


面積計算書（座標法）

世界測地系（測地成果2011）

所 在	地 番	公簿地目	現況地目	地 積	所 有 者
前橋市六供町二丁目	61-17			130.16 m ²	

点 名	X 座標	Y 座標	辺 長	方 向 角	測 角	DX	倍 積 (Y×DX)
61-107	41368.655	-68048.823	5.316	89-17-58	90-01-27	-21.915	1491289.956045
61-140	41368.720	-68043.507	24.482	359-16-37	89-58-39	24.545	-1670127.879315
61-141	41393.200	-68043.816	5.316	269-18-37	90-02-00	24.416	-1661357.811456
61-108	41393.136	-68049.132	2.501	179-17-23	89-58-46	-2.565	174546.023580
61-150	41390.635	-68049.101	21.982	179-16-31	179-59-08	-24.481	1665910.041581
						倍面積	260.330435
						面 積	130.1652175

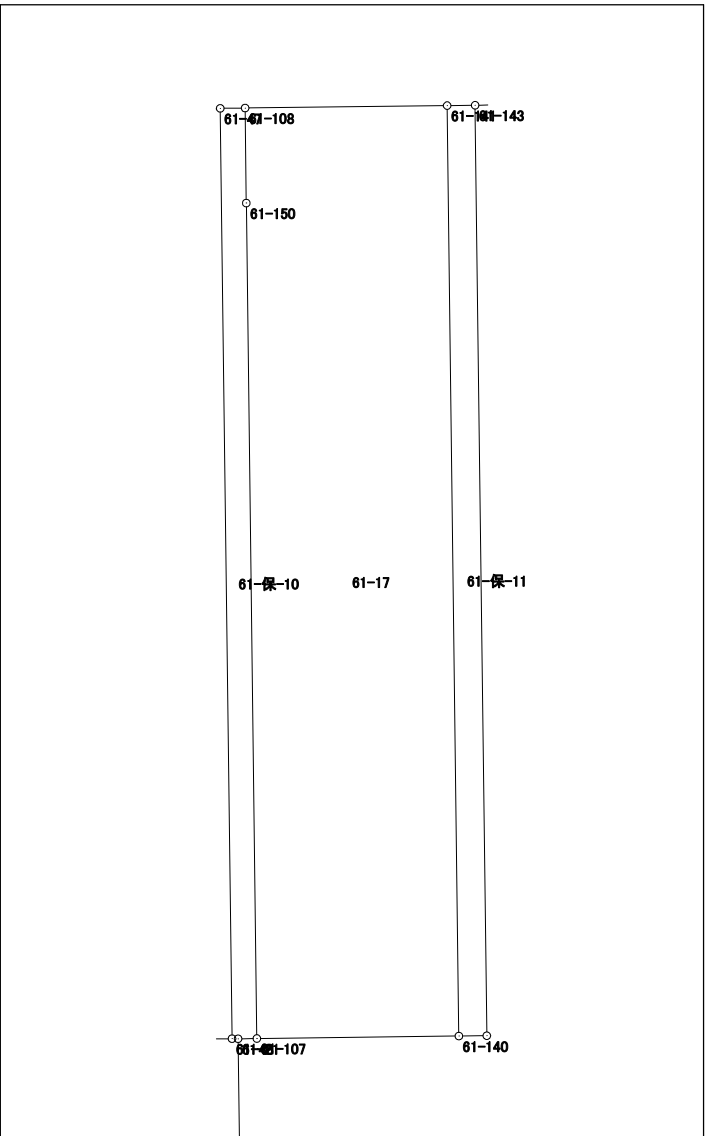


面積計算書（座標法）

世界測地系（測地成果2011）

所 在	地 番	公簿地目	現況地目	地 積	所 有 者
前橋市六供町二丁目	61-18			162.31 m ²	

点 名	X 座標	Y 座標	辺 長	方 向 角	測 角	DX	倍 積 (Y×DX)
61-138	41392.960	-68063.436	6.631	269-18-01	89-58-28	24.390	-1660067.204040
61-135	41392.879	-68070.067	2.501	179-20-08	90-02-07	-2.582	175756.912994
61-151	41390.378	-68070.038	21.981	179-19-20	179-59-12	-24.480	1666354.530240
61-134	41368.399	-68069.778	6.286	89-12-58	89-53-38	-21.893	1490251.649754
61-61	41368.485	-68063.493	0.345	89-20-09	180-07-11	0.090	-6125.714370
61-139	41368.489	-68063.148	24.473	359-19-33	89-59-24	24.475	-1665845.547300
倍面積							324.627278
面 積							162.3136390

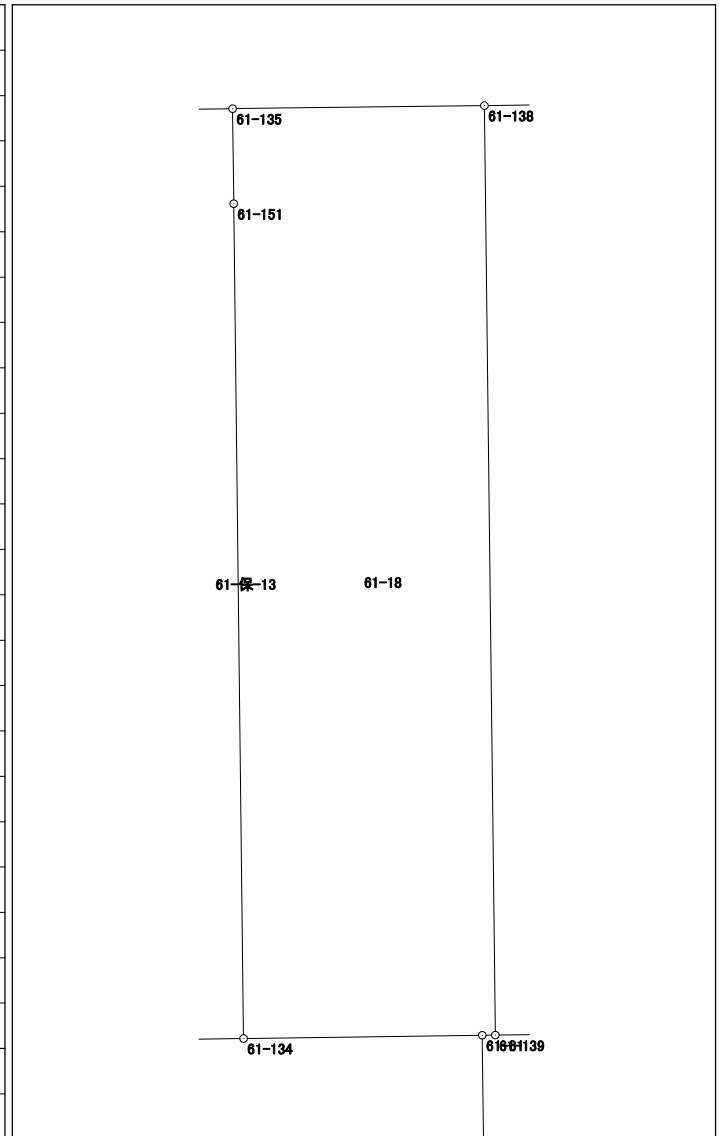


面積計算書（座標法）

世界測地系（測地成果2011）

所 在	地 番	公簿地目	現況地目	地 積	所 有 者
前橋市六供町二丁目	61-19			256.36 m ²	

点 名	X 座標	Y 座標	辺 長	方 向 角	測 角	DX	倍 積 (Y×DX)
61-136	41393.089	-68052.962	10.475	269-17-40	89-58-07	24.347	-1656885.465814
61-138	41392.960	-68063.436	24.473	179-19-33	90-01-53	-24.600	1674360.525600
61-139	41368.489	-68063.148	9.590	89-19-08	89-59-35	-24.357	1657814.095836
61-128	41368.603	-68053.559	0.780	89-20-20	180-01-12	0.123	-8370.587757
61-126	41368.612	-68052.779	0.105	89-27-16	180-06-56	0.010	-680.527790
61-137	41368.613	-68052.674	24.478	359-19-33	89-52-17	24.477	-1665725.301498
						倍面積	512.738577
						面 積	256.3692885

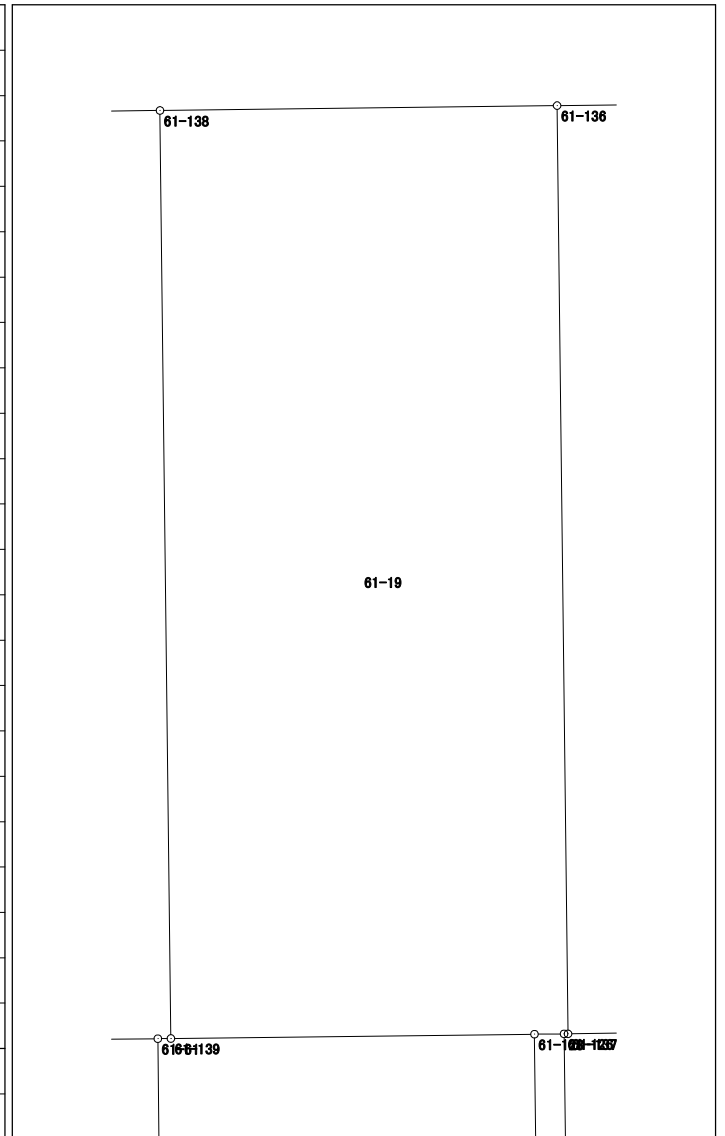


面積計算書 (座標法)

世界測地系 (測地成果2011)

所在	地番	公簿地目	現況地目	地積	所有者
前橋市六供町二丁目	61-21			513.49 m ²	

点名	X座標	Y座標	辺長	方向角	測角	DX	倍積 (Y×DX)
61-57	41392.588	-68093.685	24.469	179-18-42	90-00-48	-24.724	1683548.267940
61-58	41368.121	-68093.391	0.961	89-20-39	90-01-57	-24.456	1665291.970296
61-123	41368.132	-68092.430	10.068	89-19-22	179-58-43	0.130	-8852.015900
61-125	41368.251	-68082.363	9.950	89-19-14	179-59-52	0.237	-16135.520031
61-11	41368.369	-68072.414	24.478	359-19-33	90-00-19	24.594	-1674172.949916
61-12	41392.845	-68072.702	20.985	269-17-54	89-58-21	24.219	-1648652.769738
						倍面積	1026.982651
						面積	513.4913255

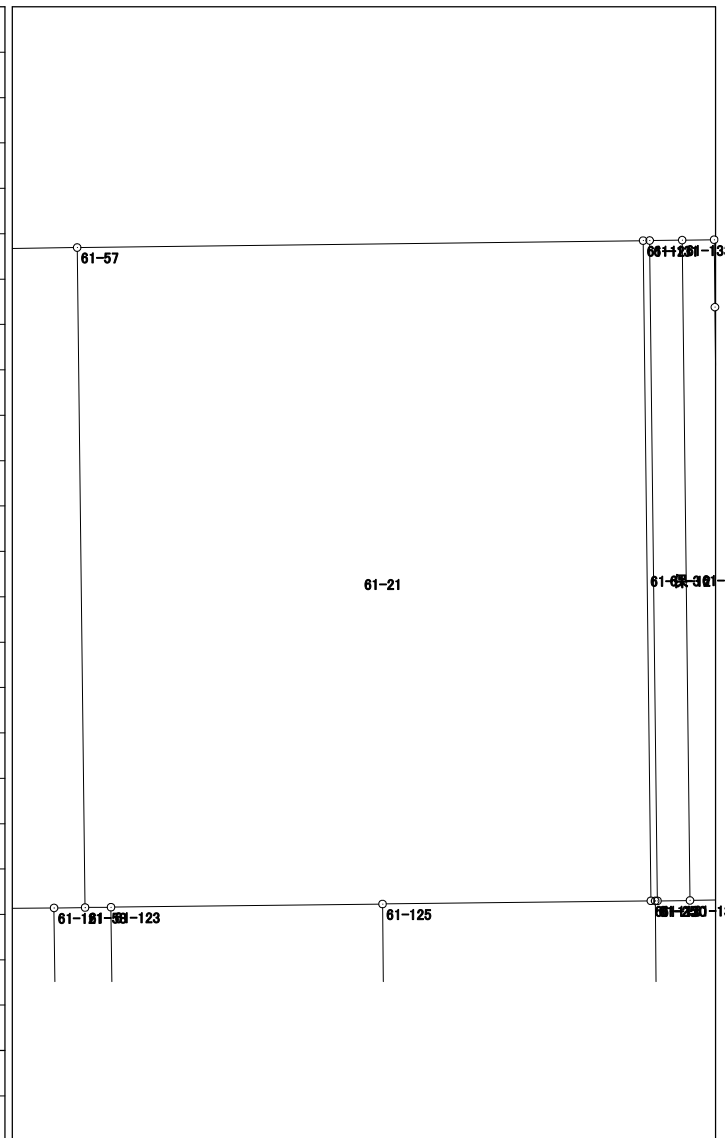


面積計算書（座標法）

世界測地系（測地成果2011）

所 在	地 番	公簿地目	現況地目	地 積	所 有 者
前橋市六供町二丁目	61-22			231.62 m ²	

点 名	X 座標	Y 座標	辺 長	方 向 角	測 角	DX	倍 積 (Y×DX)
61-25	41368.367	-68072.252	26.276	179-19-26	90-00-21	-26.275	1788598.421300
61-26	41342.093	-68071.942	8.773	91-14-27	91-55-01	-26.464	1801455.873088
61-62	41341.903	-68063.171	26.584	359-18-22	88-03-55	26.392	-1796323.209032
61-61	41368.485	-68063.493	6.286	269-12-58	89-54-36	26.496	-1803410.310528
61-134	41368.399	-68069.778	1.185	269-16-29	180-03-31	-0.101	6875.047578
61-132	41368.384	-68070.963	1.205	269-14-21	179-57-52	-0.031	2110.199853
61-130	41368.368	-68072.168	0.084	269-19-05	180-04-44	-0.017	1157.226856
						倍面積	463.249115
						面 積	231.6245575

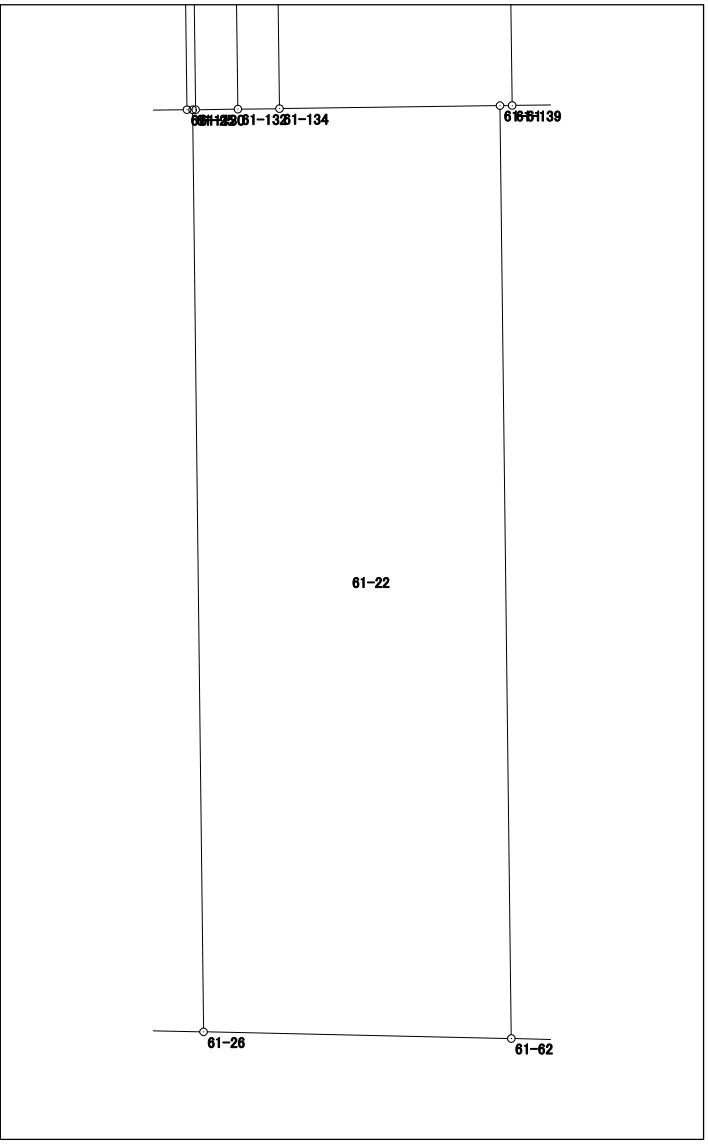


面積計算書 (座標法)

世界測地系 (測地成果2011)

所在	地番	公簿地目	現況地目	地積	所有者
前橋市六供町二丁目	61-保-1			73.00 m ²	

点名	X座標	Y座標	辺長	方向角	測角	DX	倍積 (Y×DX)
61-33	41378.378	-68109.890	4.057	359-18-29	89-58-27	4.265	-290488.680850
61-148	41382.435	-68109.939	18.093	269-20-06	90-01-37	3.847	-262018.935333
61-149	41382.225	-68128.031	4.063	176-30-01	87-09-55	-4.265	290566.052215
61-34	41378.170	-68127.783	17.894	89-20-02	92-50-01	-3.847	262087.581201

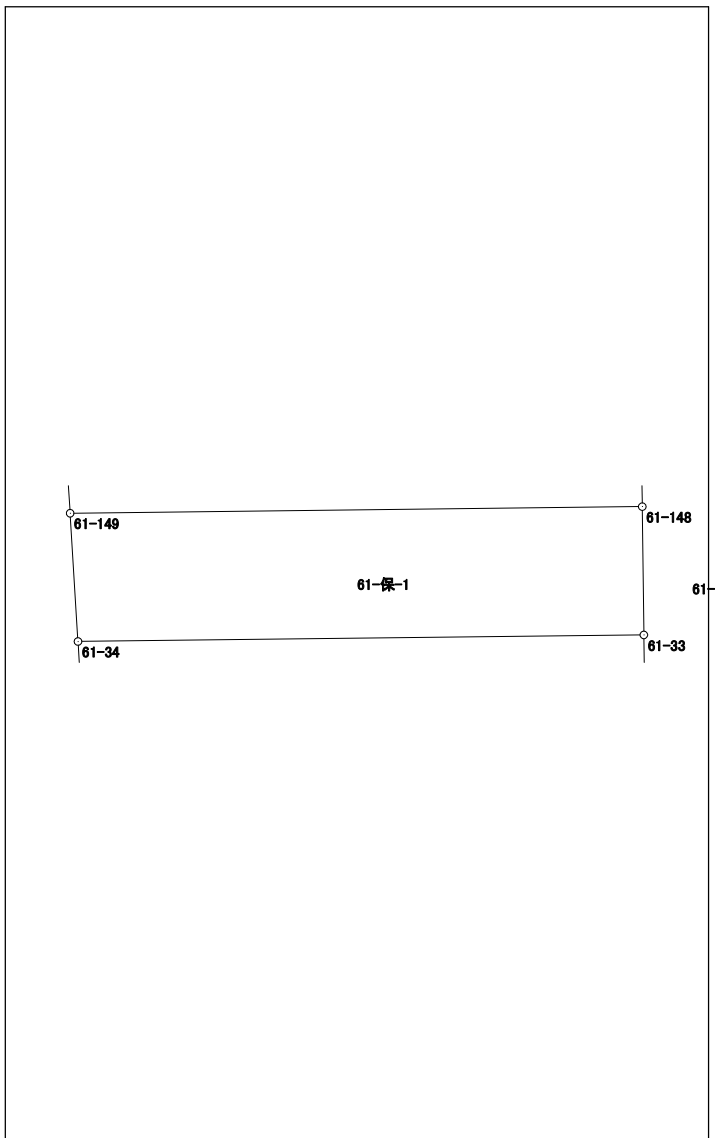


面積計算書（座標法）

世界測地系（測地成果2011）

所在	地番	公簿地目	現況地目	地積	所有者
前橋市六供町二丁目	61-保-3			86.00 m ²	

点名	X座標	Y座標	辺長	方向角	測角	DX	倍積 (Y×DX)
61-17	41393.573	-68013.484	3.515	269-17-57	89-58-07	24.435	-1661909.481540
61-103	41393.530	-68016.999	24.480	179-19-16	90-01-19	-24.521	1667844.832479
61-104	41369.052	-68016.709	3.511	89-17-54	89-58-38	-24.435	1661988.284415
61-35	41369.095	-68013.198	24.480	359-19-50	90-01-56	24.521	-1667751.628158
倍面積							172.007196
面積							86.0035980

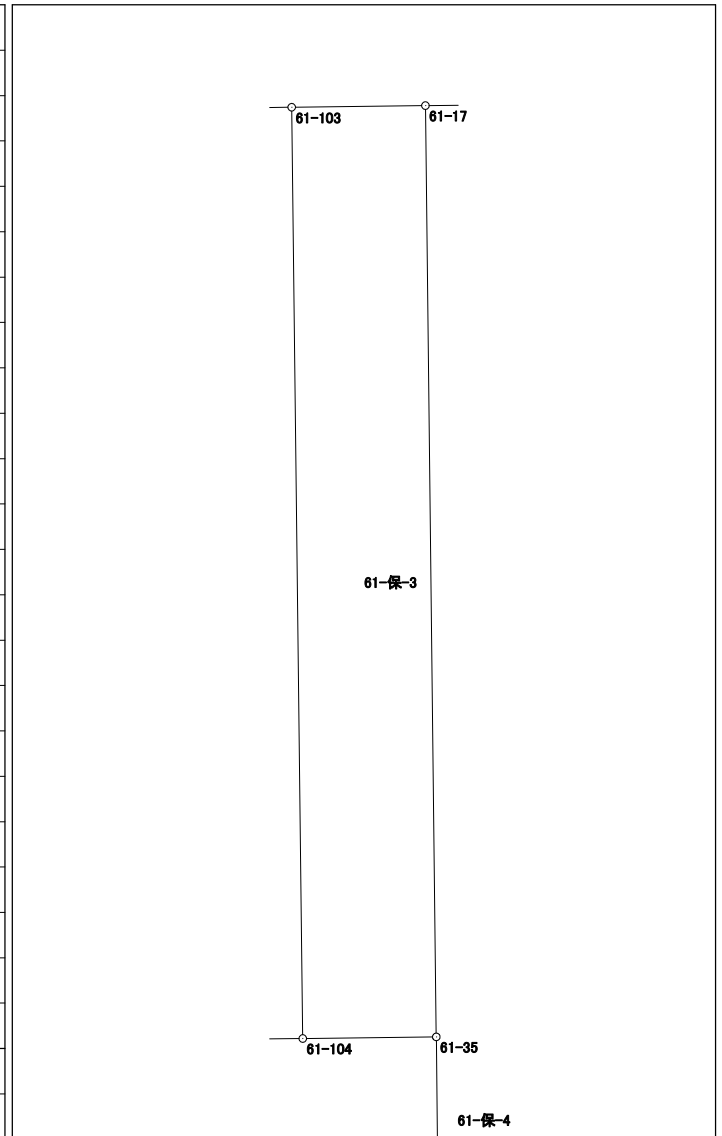

面積計算書（座標法）

世界測地系（測地成果2011）

所在	地番	公簿地目	現況地目	地積	所有者
前橋市六供町二丁目	61-保-4			56.00 m ²	


点名	X座標	Y座標	辺長	方向角	測角	DX	倍積 (Y×DX)	
61-35	41369.095	-68013.198	28.302	179-18-06	179-58-16	-52.778	3589600.564044	
61-18	41340.795	-68012.853	1.058	91-14-43	91-56-37	-28.323	1926328.035519	
61-101	41340.772	-68011.795	52.818	359-18-52	88-04-09	52.791	-3590410.669845	
61-102	41393.586	-68012.427	1.057	269-17-43	89-58-51	52.801	-3591124.158027	
61-17	41393.573	-68013.484	24.480	179-19-50	90-02-07	-24.491	1665718.236644	
							倍面積	112.008335
							面積	56.0041675

面積計算書（座標法）

世界測地系（測地成果2011）

所 在	地 番	公簿地目	現況地目	地 積	所 有 者
前橋市六供町二丁目	61-保-7			21.00 m ²	

点 名	X 座標	Y 座標	辺 長	方 向 角	測 角	DX	倍 積 (Y×DX)
61-126	41368.612	-68052.779	0.780	269-20-20	90-02-11	26.935	-1833001.602365
61-128	41368.603	-68053.559	26.920	179-18-07	89-57-47	-26.927	1832478.183193
61-129	41341.685	-68053.231	0.780	91-14-55	91-56-48	-26.935	1833013.776985
61-127	41341.668	-68052.451	26.946	359-18-09	88-03-14	26.927	-1832448.348077
						倍面積	42.009736
						面 積	21.0048680

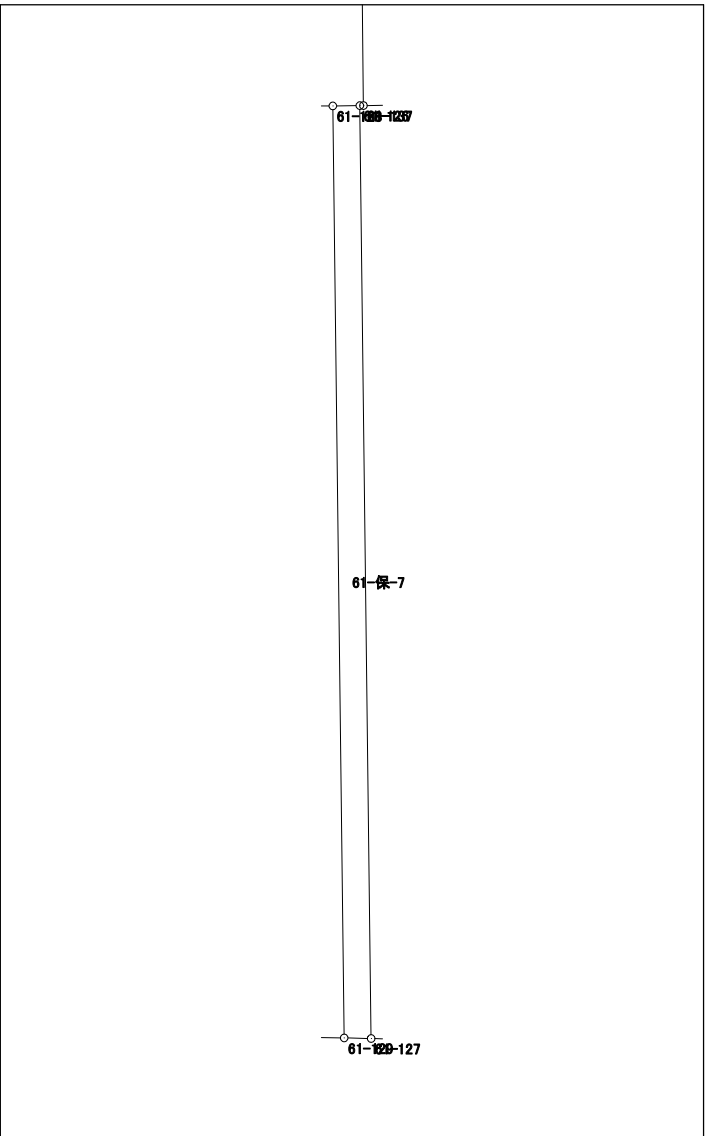


面積計算書 (座標法)

世界測地系 (測地成果2011)

所在	地番	公簿地目	現況地目	地積	所有者
前橋市六供町二丁目	61-保-8			9.00 m ²	

点名	X座標	Y座標	辺長	方向角	測角	DX	倍積 (Y×DX)
61-114	41342.771	-68103.307	0.357	91-17-01	91-57-30	-25.226	1717974.022382
61-116	41342.763	-68102.950	25.233	359-19-32	88-02-31	25.223	-1717760.707850
61-117	41367.994	-68103.247	0.357	269-11-51	89-52-19	25.226	-1717972.508822
61-115	41367.989	-68103.604	25.220	179-19-31	90-07-40	-25.223	1717777.203692

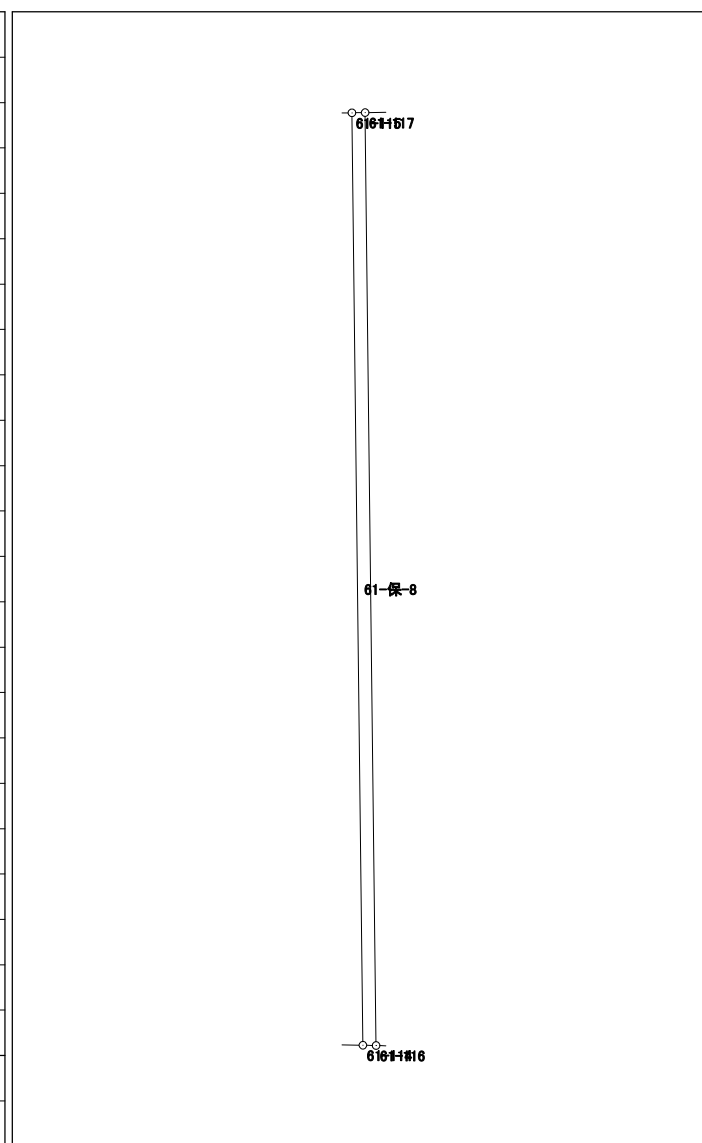

倍面積	18.009402
面積	9.0047010


面積計算書（座標法）

世界測地系（測地成果2011）

所在	地番	公簿地目	現況地目	地積	所有者
前橋市六供町二丁目	61-保-9			54.00 m ²	

点名	X座標	Y座標	辺長	方向角	測角	DX	倍積 (Y×DX)
61-121	41368.106	-68094.542	25.533	179-19-28	90-04-16	-25.546	1739543.169932
61-120	41342.575	-68094.241	2.114	91-14-50	91-55-22	-25.577	1741646.402057
61-122	41342.529	-68092.128	25.605	359-19-27	88-04-37	25.557	-1740230.515296
61-123	41368.132	-68092.430	0.961	269-20-39	90-01-12	25.592	-1742621.468560
61-58	41368.121	-68093.391	1.151	269-15-12	179-54-33	-0.026	1770.428166

倍面積	108.016299
面積	54.0081495

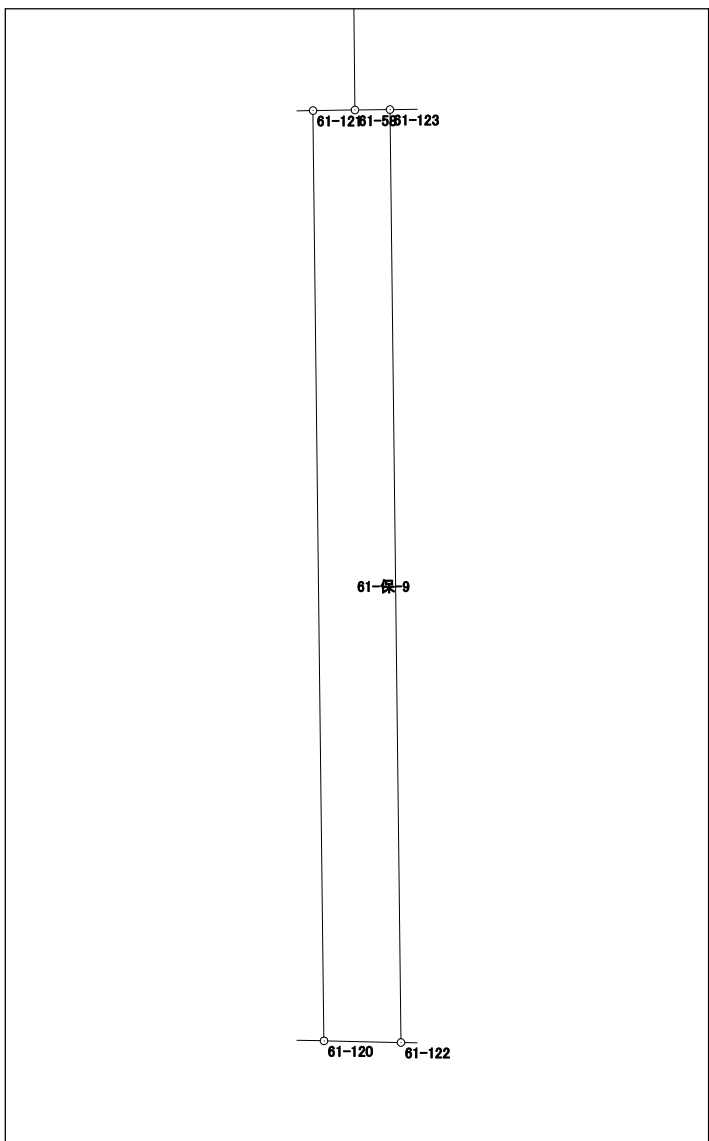


面積計算書（座標法）

世界測地系（測地成果2011）

所 在	地 番	公簿地目	現況地目	地 積	所 有 者
前橋市六供町二丁目	61-保-10			16.00 m ²	

点 名	X 座標	Y 座標	辺 長	方 向 角	測 角	DX	倍 積 (Y×DX)
61-48	41368.651	-68049.477	0.160	90-42-58	91-26-22	-24.479	1665783.147483
61-21	41368.649	-68049.317	0.494	89-18-15	178-35-17	0.004	-272.197268
61-107	41368.655	-68048.823	21.982	359-16-31	89-58-16	21.986	-1496121.422478
61-150	41390.635	-68049.101	2.501	359-17-23	180-00-52	24.481	-1665910.041581
61-108	41393.136	-68049.132	0.654	269-17-57	90-00-34	2.493	-169646.486076
61-47	41393.128	-68049.786	24.479	179-16-36	89-58-39	-24.485	1666199.010210
						倍面積	32.010290
						面 積	16.0051450

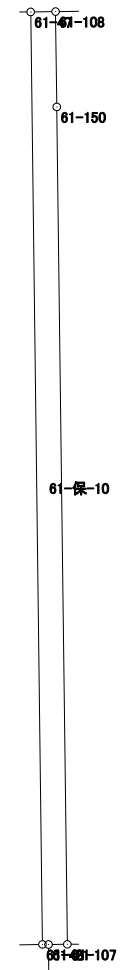

面積計算書（座標法）

世界測地系（測地成果2011）

所 在	地 番	公簿地目	現況地目	地 積	所 有 者
前橋市六供町二丁目	61-保-12			6.00 m ²	


点 名	X 座標	Y 座標	辺 長	方 向 角	測 角	DX	倍 積 (Y×DX)	
61-12	41392.845	-68072.702	24.478	179-19-33	90-01-39	-24.479	1666351.672258	
61-11	41368.369	-68072.414	0.162	90-42-26	91-22-53	-24.478	1666276.549892	
61-25	41368.367	-68072.252	0.084	89-19-05	178-36-39	-0.001	68.072252	
61-130	41368.368	-68072.168	24.482	359-19-25	90-00-20	24.481	-1666474.744808	
61-131	41392.848	-68072.457	0.245	269-17-54	89-58-29	24.477	-1666209.529989	
							倍面積	12.019605
							面 積	6.0098025

面積計算書 (座標法)

世界測地系 (測地成果2011)

所在	地番	公簿地目	現況地目	地積	所有者
前橋市六供町二丁目	61-保-13			29.00 m ²	

点名	X座標	Y座標	辺長	方向角	測角	DX	倍積 (Y×DX)
61-133	41392.863	-68071.252	24.481	179-19-25	90-05-50	-24.495	1667405.317740
61-132	41368.384	-68070.963	1.185	89-16-29	89-57-04	-24.464	1665288.038832
61-134	41368.399	-68069.778	21.981	359-19-20	90-02-51	21.994	-1497126.697332
61-151	41390.378	-68070.038	2.501	359-20-08	180-00-48	24.480	-1666354.530240
61-135	41392.879	-68070.067	1.185	269-13-35	89-53-27	2.485	-169154.116495
						倍面積	58.012505
						面積	29.0062525

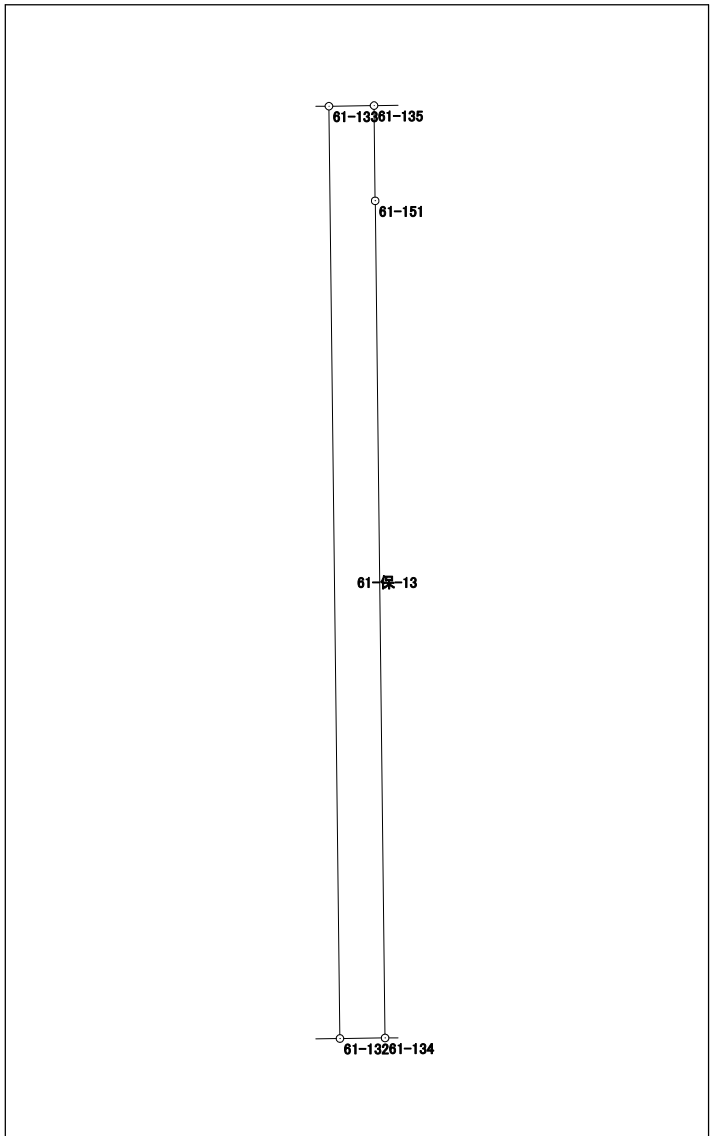

面積計算書（座標法）

世界測地系（測地成果2011）

所在	地番	公簿地目	現況地目	地積	所有者
前橋市六供町二丁目	61-保-14			78.00 m ²	

点名	X座標	Y座標	辺長	方向角	測角	DX	倍積 (Y×DX)	
61-48	41368.651	-68049.477	24.479	359-16-36	89-57-28	24.515	-1668232.928655	
61-47	41393.128	-68049.786	3.176	269-17-47	90-01-11	24.438	-1663000.670268	
61-136	41393.089	-68052.962	24.478	179-19-33	90-01-46	-24.515	1668318.363430	
61-137	41368.613	-68052.674	3.197	89-19-08	89-59-35	-24.438	1663071.247212	
							倍面積	156.011719
							面積	78.0058595

