



6 2 街区 画地出来形確認図 (8719.86m²)

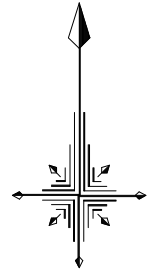

S=1/500

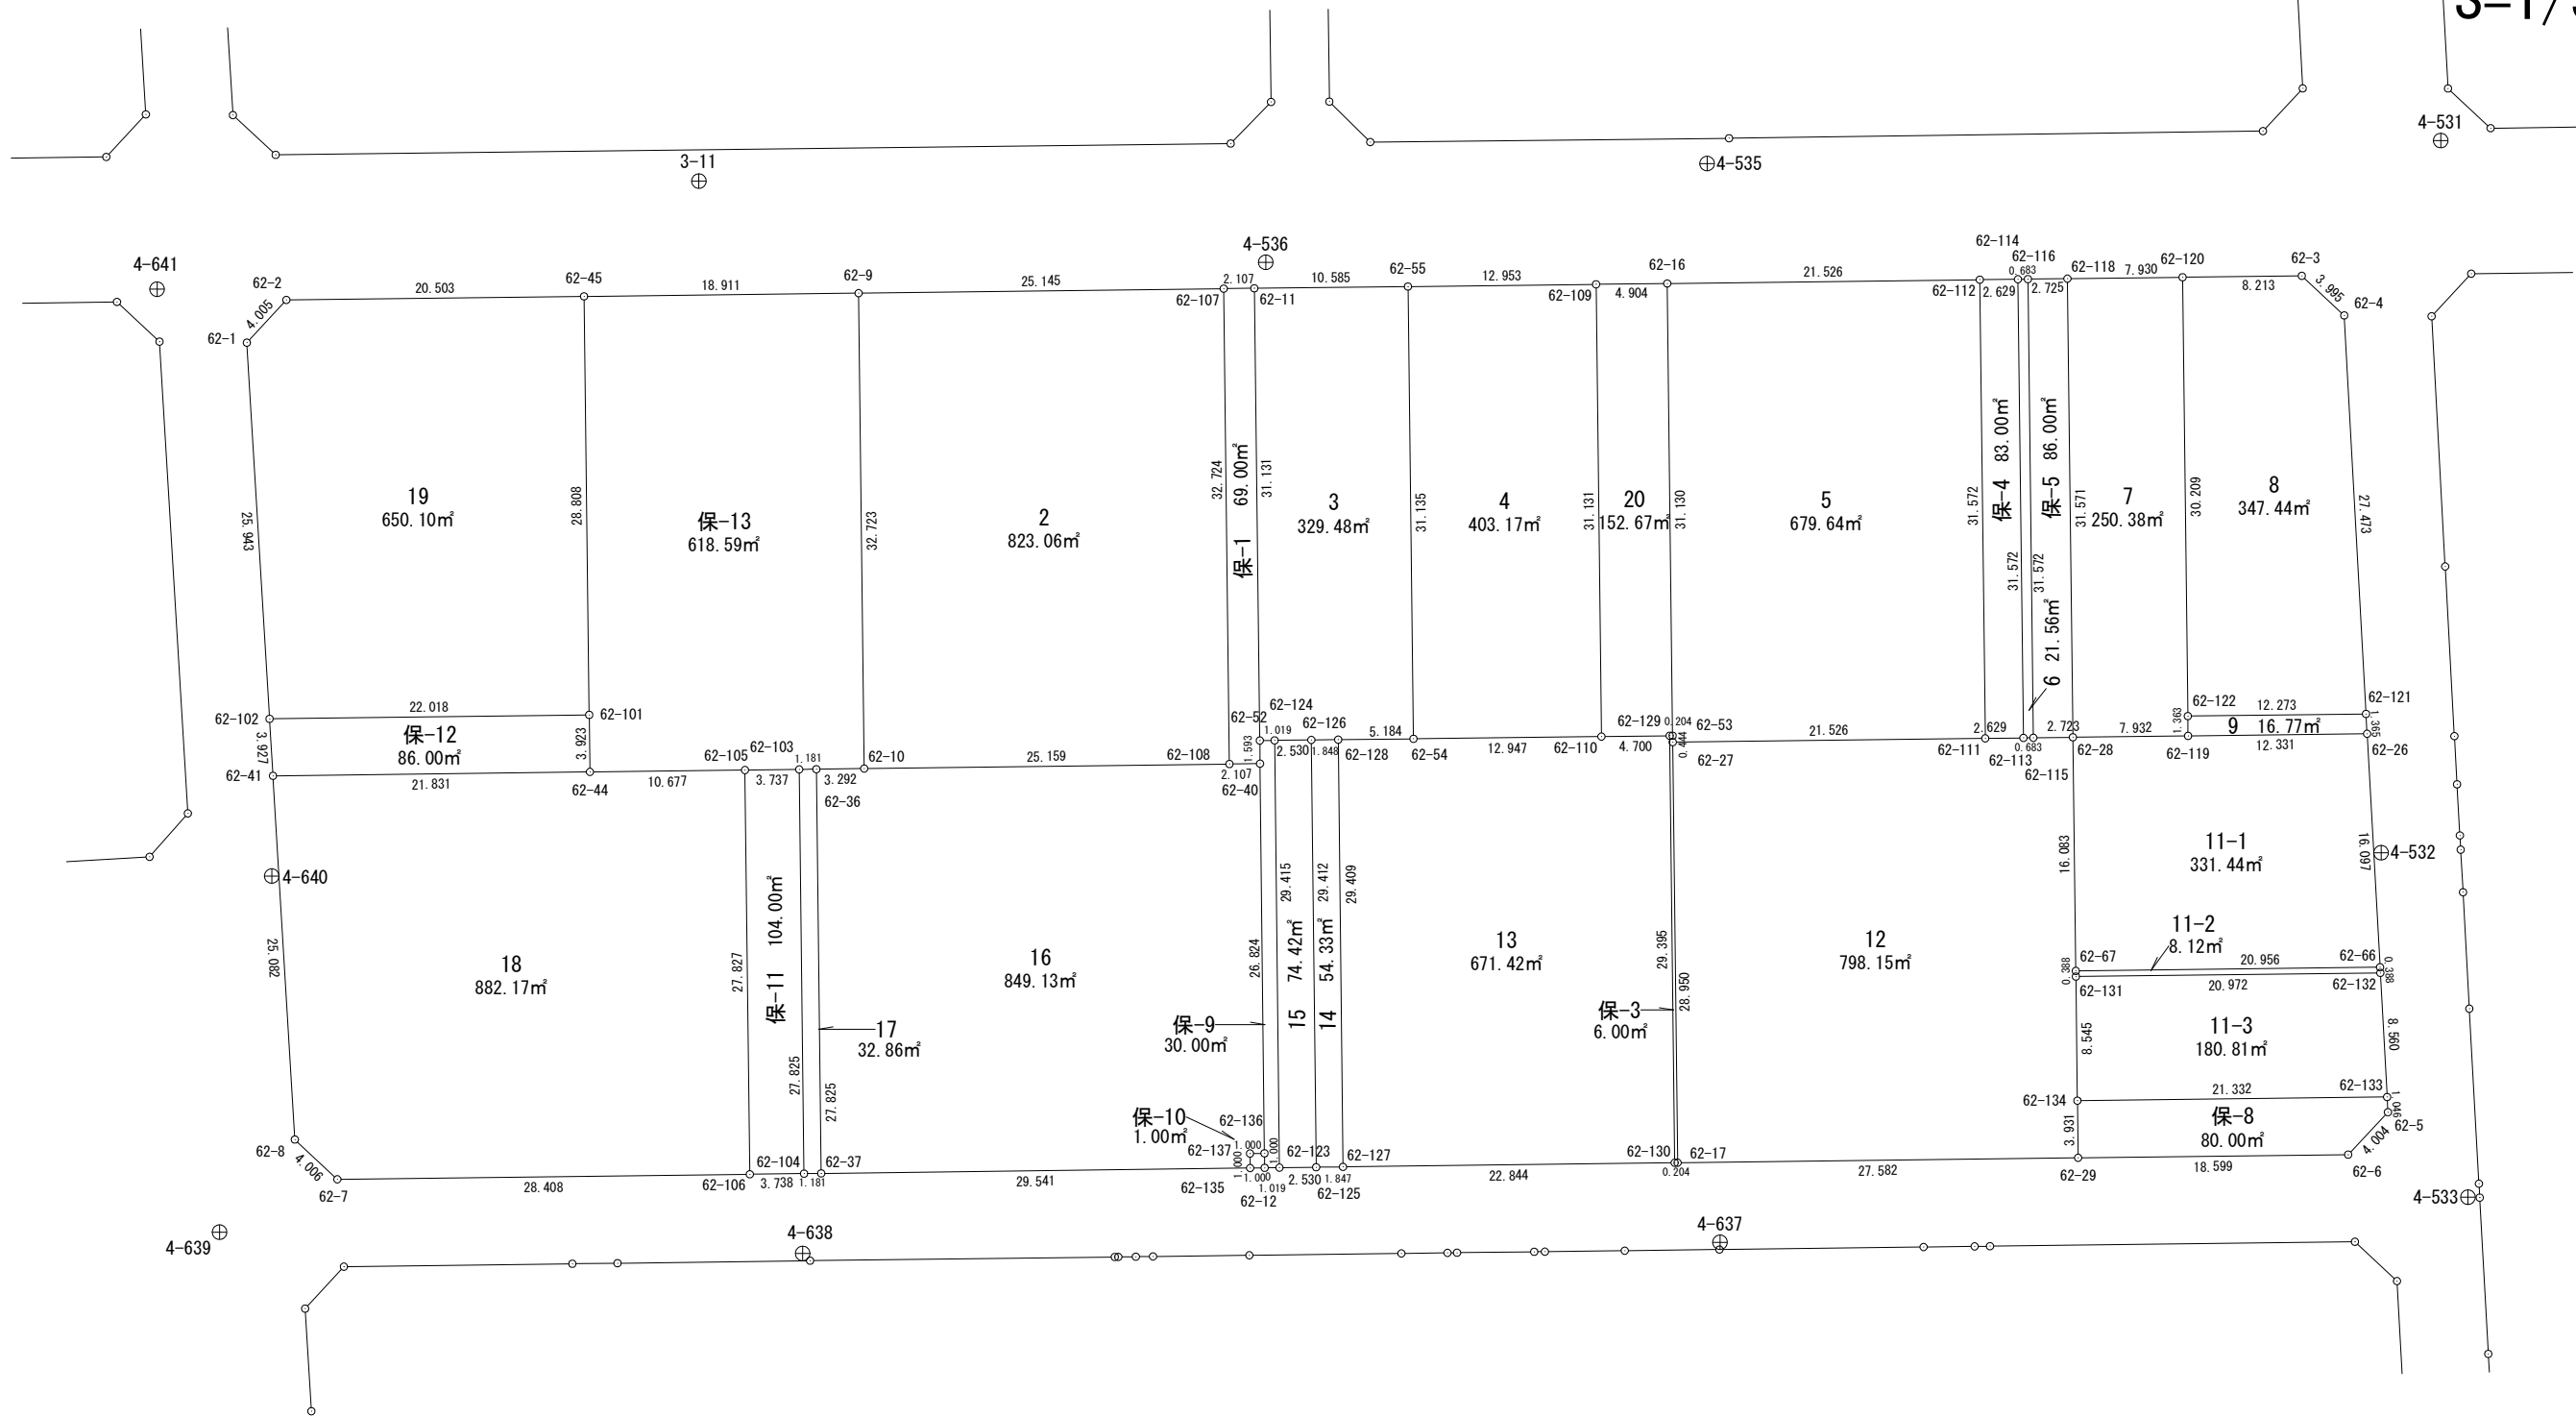


面積計算書（座標法）

世界測地系（測地成果2011）

所在	地番	公簿地目	現況地目	地積	所有者
前橋市六供町二丁目	62-4			403.17 m ²	

点名	X座標	Y座標	辺長	方向角	測角	DX	倍積 (Y×DX)
62-109	41459.795	-68039.557	12.953	269-19-39	90-00-37	30.977	-2107661.357189
62-55	41459.643	-68052.509	31.135	179-18-22	89-58-43	-31.285	2129022.744065
62-54	41428.510	-68052.132	12.947	89-18-35	90-00-13	-30.977	2108050.892964
62-110	41428.666	-68039.186	31.131	359-19-02	90-00-27	31.285	-2128605.934010

倍面積	806.345830
面積	403.1729150

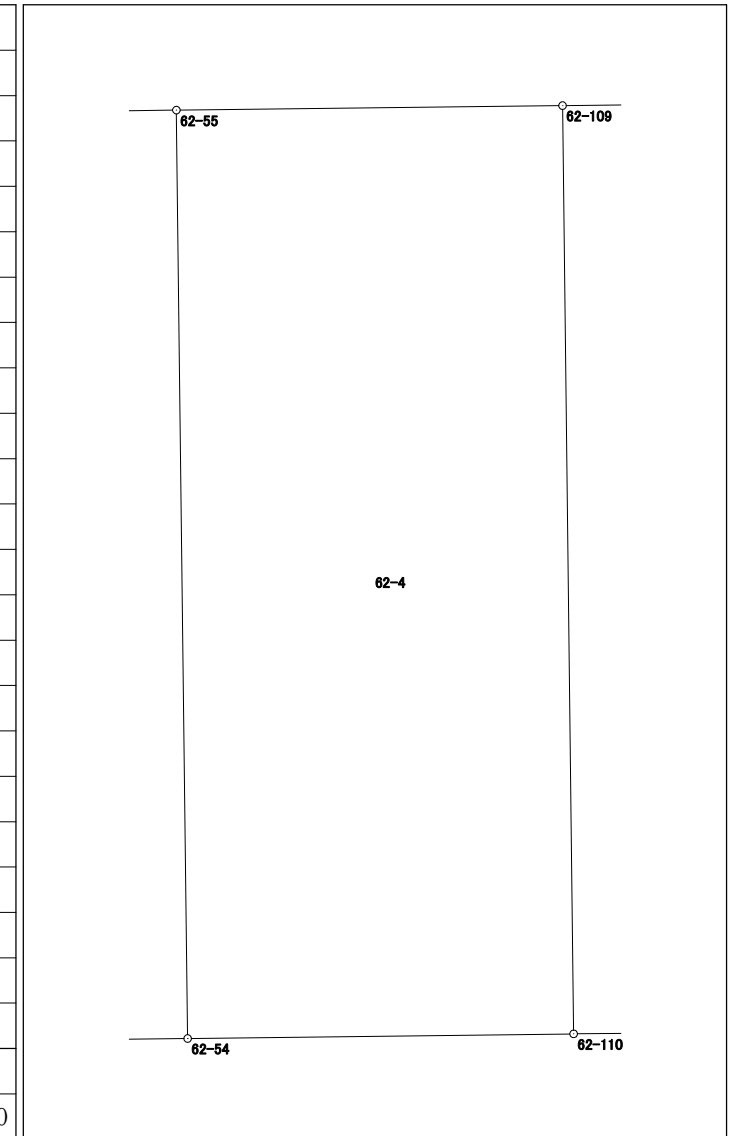


面積計算書 (座標法)

世界測地系 (測地成果2011)

所 在	地 番	公簿地目	現況地目	地 積	所 有 者
前橋市六供町二丁目	62-5			679.64 m ²	


点 名	X 座 標	Y 座 標	辺 長	方 向 角	測 角	DX	倍 積 (Y×DX)
62-53	41428.725	-68034.282	0.444	179-13-33	179-54-31	-31.572	2147978.351304
62-27	41428.281	-68034.276	21.526	89-18-09	90-04-36	-0.182	12382.238232
62-111	41428.543	-68012.752	31.572	359-18-57	90-00-48	31.832	-2164981.921664
62-112	41460.113	-68013.129	21.526	269-18-29	89-59-32	31.310	-2129491.068990
62-16	41459.853	-68034.653	31.130	179-19-02	90-00-33	-31.388	2135471.688364
						倍面積	1359.287246
						面 積	679.6436230

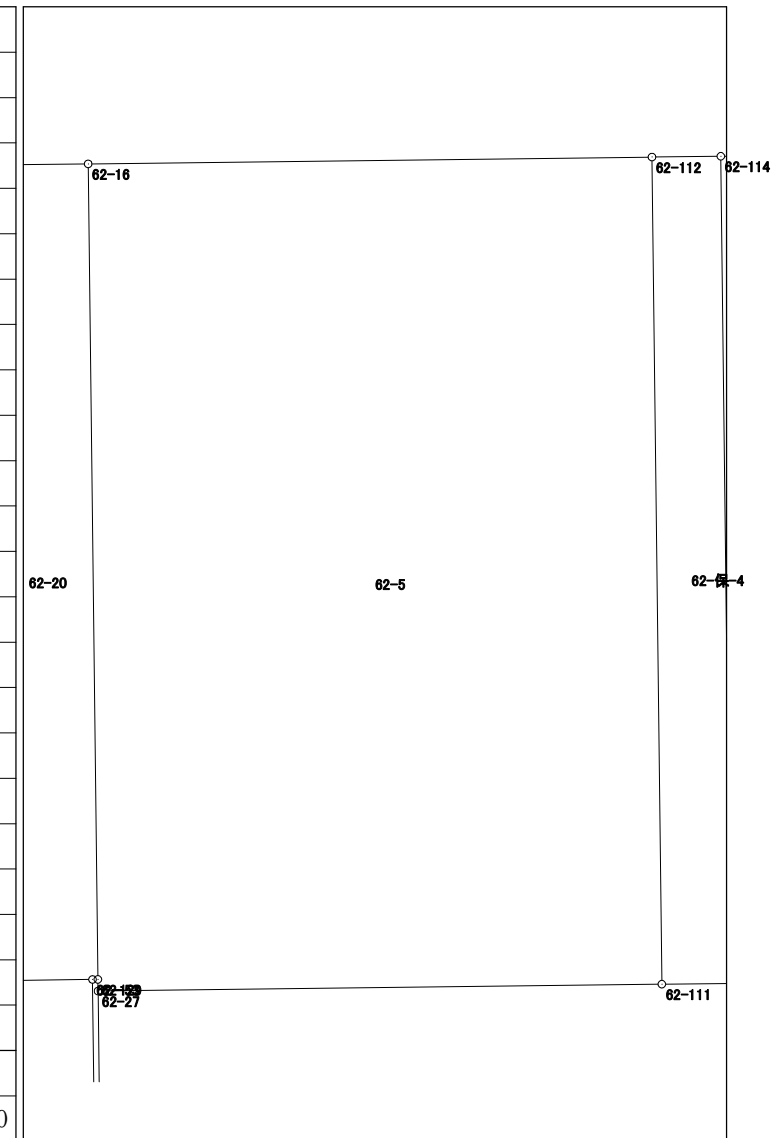

面積計算書 (座標法)

世界測地系 (測地成果2011)

所在	地番	公簿地目	現況地目	地積	所有者
前橋市六供町二丁目	62-7			250.38 m ²	

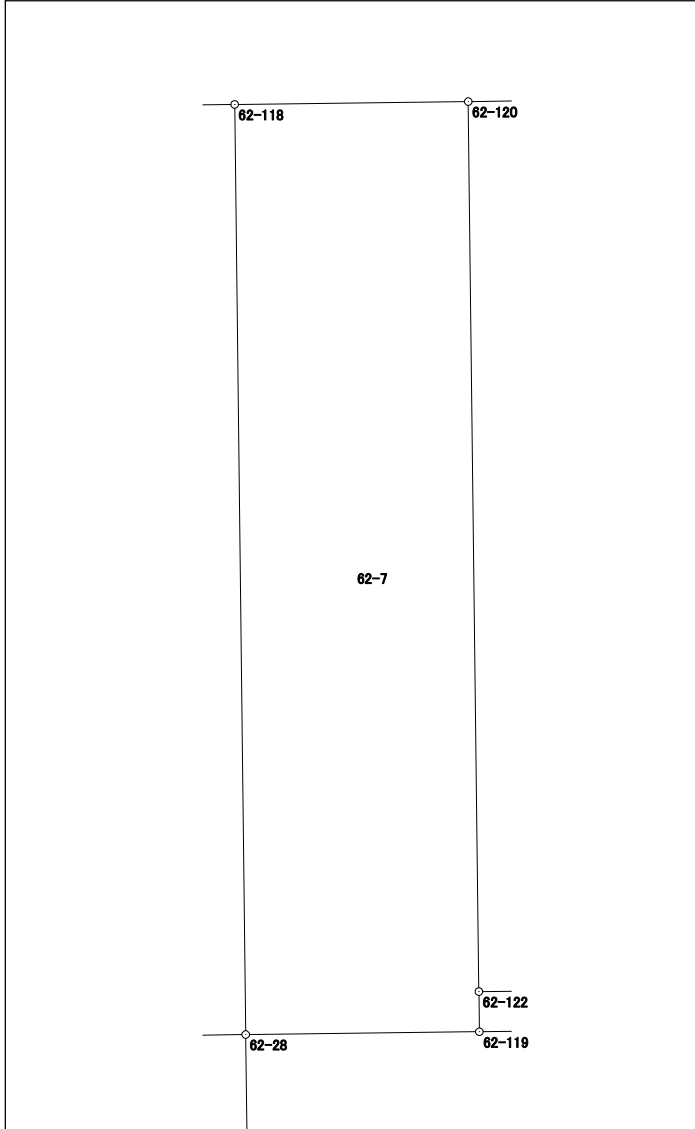
点名	X座標	Y座標	辺長	方向角	測角	DX	倍積 (Y×DX)		
62-118	41460.186	-68007.092	31.571	179-19-10	90-00-47	-31.665	2153444.568180		
62-28	41428.617	-68006.717	7.932	89-18-49	89-59-39	-31.474	2140443.410858		
62-119	41428.712	-67998.786	1.363	359-19-39	90-00-50	1.458	-99142.229988		
62-122	41430.075	-67998.802	30.209	359-18-55	179-59-16	31.570	-2146722.179140		
62-120	41460.282	-67999.163	7.930	269-18-23	89-59-28	30.111	-2047522.797093		
							倍面積		500.772817
							面積		250.3864085

面積計算書 (座標法)

世界測地系 (測地成果2011)

所在	地番	公簿地目	現況地目	地積	所有者
前橋市六供町二丁目	62-8			347.44 m ²	

点名	X座標	Y座標	辺長	方向角	測角	DX	倍積 (Y×DX)
62-121	41430.223	-67986.530	27.473	356-52-13	87-33-40	27.580	-1875068.497400
62-4	41457.655	-67988.030	3.995	313-01-20	136-09-07	30.158	-2050383.008740
62-3	41460.381	-67990.951	8.213	269-18-33	136-17-13	2.627	-178612.228277
62-120	41460.282	-67999.163	30.209	179-18-55	90-00-22	-30.306	2060782.633878
62-122	41430.075	-67998.802	12.273	89-18-33	89-59-38	-30.059	2043975.989318
						倍面積	694.888779
						面積	347.4443895

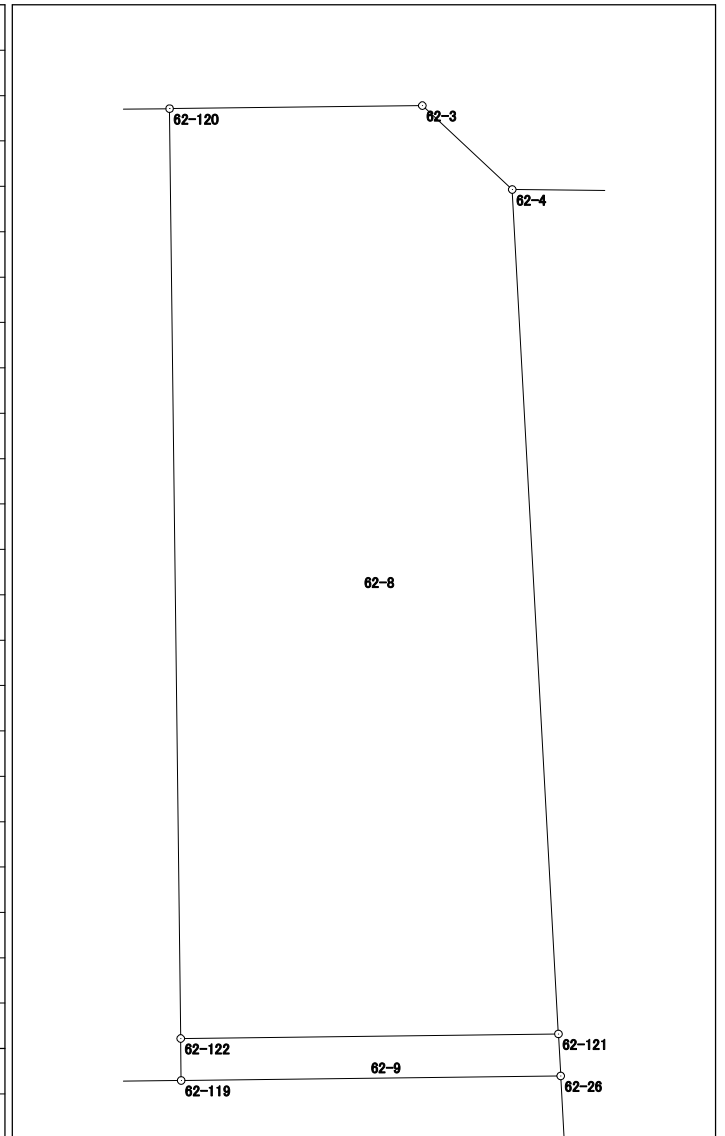


面積計算書 (座標法)

世界測地系 (測地成果2011)

所在	地番	公簿地目	現況地目	地積	所有者
前橋市六供町二丁目	62-9			16.77 m ²	


点名	X座標	Y座標	辺長	方向角	測角	DX	倍積 (Y×DX)
62-119	41428.712	-67998.786	12.331	89-18-44	89-59-05	-1.215	82618.524990
62-26	41428.860	-67986.456	1.365	356-53-32	87-34-48	1.511	-102727.535016
62-121	41430.223	-67986.530	12.273	269-18-33	92-25-01	1.215	-82603.633950
62-122	41430.075	-67998.802	1.363	179-19-39	90-01-06	-1.511	102746.189822
倍面積							33.545846
面積							16.7729230

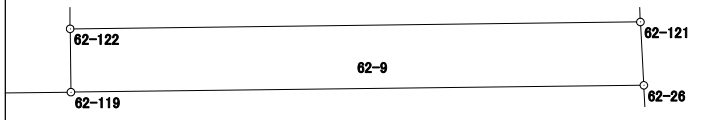

面積計算書（座標法）

世界測地系（測地成果2011）


所在	地番	公簿地目	現況地目	地積	所有者
前橋市六供町二丁目	62-11-2			8.12 m ²	

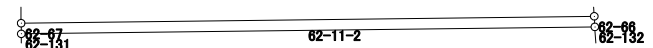点名	X座標	Y座標	辺長	方向角	測角	DX	倍積 (Y×DX)	
62-67	41412.535	-68006.517	0.388	179-15-42	89-57-12	-0.641	43592.177397	
62-131	41412.147	-68006.512	20.972	89-18-22	90-02-40	-0.134	9112.872608	
62-132	41412.401	-67985.542	0.388	356-53-38	87-35-16	0.641	-43578.732422	
62-66	41412.788	-67985.563	20.956	269-18-30	92-24-52	0.134	-9110.065442	
						倍面積	16.252141	
						面積	8.1260705	

面積計算書 (座標法)

世界測地系 (測地成果2011)

所在	地番	公簿地目	現況地目	地積	所有者
前橋市六供町二丁目	62-11-3			180.81 m ²	

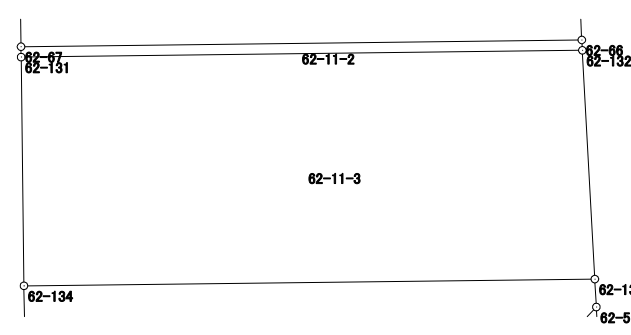
点名	X座標	Y座標	辺長	方向角	測角	DX	倍積 (Y×DX)	
62-133	41403.854	-67985.076	8.560	356-52-45	87-33-12	8.798	-598132.698648	
62-132	41412.401	-67985.542	20.972	269-18-22	92-25-37	8.293	-563804.099806	
62-131	41412.147	-68006.512	8.545	179-17-45	89-59-23	-8.798	598321.292576	
62-134	41403.603	-68006.407	21.332	89-19-33	90-01-48	-8.293	563977.133251	
倍面積							361.627373	
面積							180.8136865	

面積計算書（座標法）

世界測地系（測地成果2011）

所 在	地 番	公簿地目	現況地目	地 積	所 有 者
前橋市六供町二丁目	62-12			798.15 m ²	

点 名	X 座標	Y 座標	辺 長	方 向 角	測 角	DX	倍 積 (Y×DX)
62-27	41428.281	-68034.276	28.950	179-19-52	90-01-43	-29.210	1987281.201960
62-17	41399.333	-68033.938	27.582	89-17-45	89-57-53	-28.609	1946382.932242
62-29	41399.672	-68006.358	3.931	359-17-09	89-59-24	4.270	-290387.148660
62-134	41403.603	-68006.407	8.545	359-17-45	180-00-36	12.475	-848379.927325
62-131	41412.147	-68006.512	0.388	359-15-42	179-57-57	8.932	-607434.165184
62-67	41412.535	-68006.517	16.083	359-17-15	180-01-33	16.470	-1120067.334990
62-28	41428.617	-68006.717	2.723	269-17-05	89-59-50	16.048	-1091371.794416
62-115	41428.583	-68009.440	0.683	269-19-44	180-02-39	-0.042	2856.396480
62-113	41428.575	-68010.123	2.629	269-18-09	179-58-25	-0.040	2720.404920
62-111	41428.543	-68012.752	21.526	269-18-09	180-00-00	-0.294	19995.749088

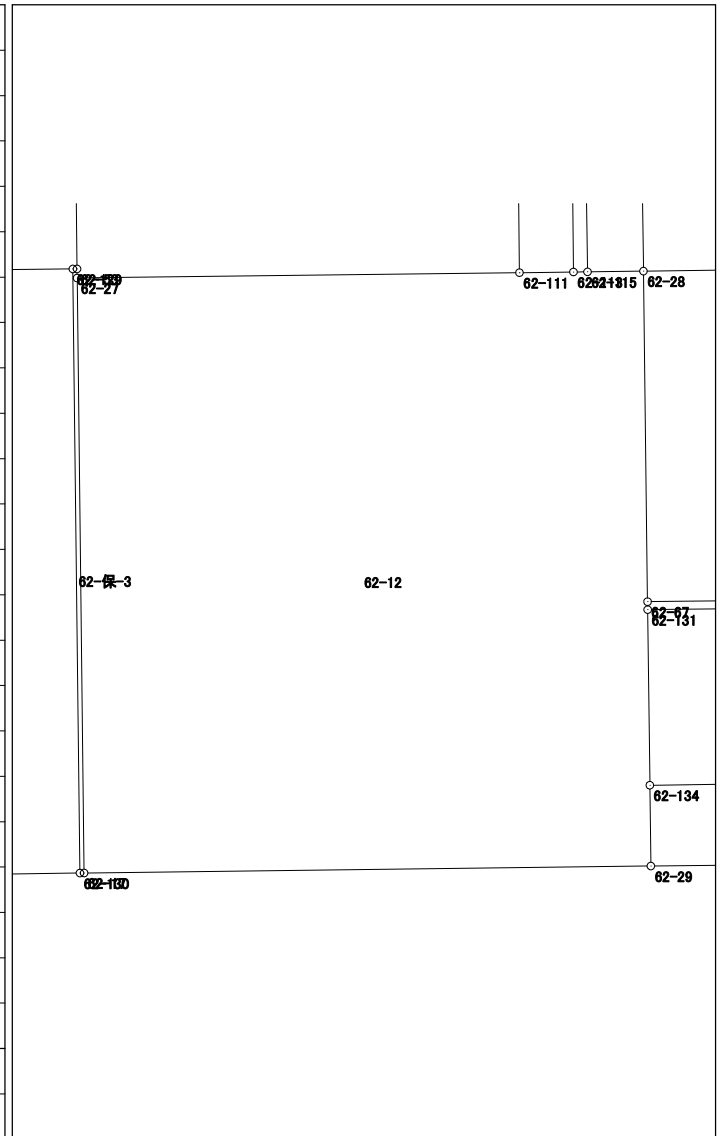

倍面積	1596.314115
面 積	798.1570575


面積計算書 (座標法)

世界測地系 (測地成果2011)

所在	地番	公簿地目	現況地目	地積	所有者
前橋市六供町二丁目	62-13			671.42 m ²	

点名	X座標	Y座標	辺長	方向角	測角	DX	倍積(Y×DX)
62-129	41428.723	-68034.486	4.700	269-18-19	89-58-33	29.336	-1995859.681296
62-110	41428.666	-68039.186	12.947	269-18-35	180-00-16	-0.213	14492.346618
62-54	41428.510	-68052.132	5.184	269-22-12	180-03-37	-0.213	14495.104116
62-128	41428.453	-68057.316	29.409	179-21-11	89-58-59	-29.464	2005240.758624
62-127	41399.046	-68056.984	22.844	89-17-16	89-56-05	-29.123	1982023.545032
62-130	41399.330	-68034.142	29.395	359-19-46	90-02-30	29.677	-2019049.232134

倍面積	1342.840960
面積	671.4204800

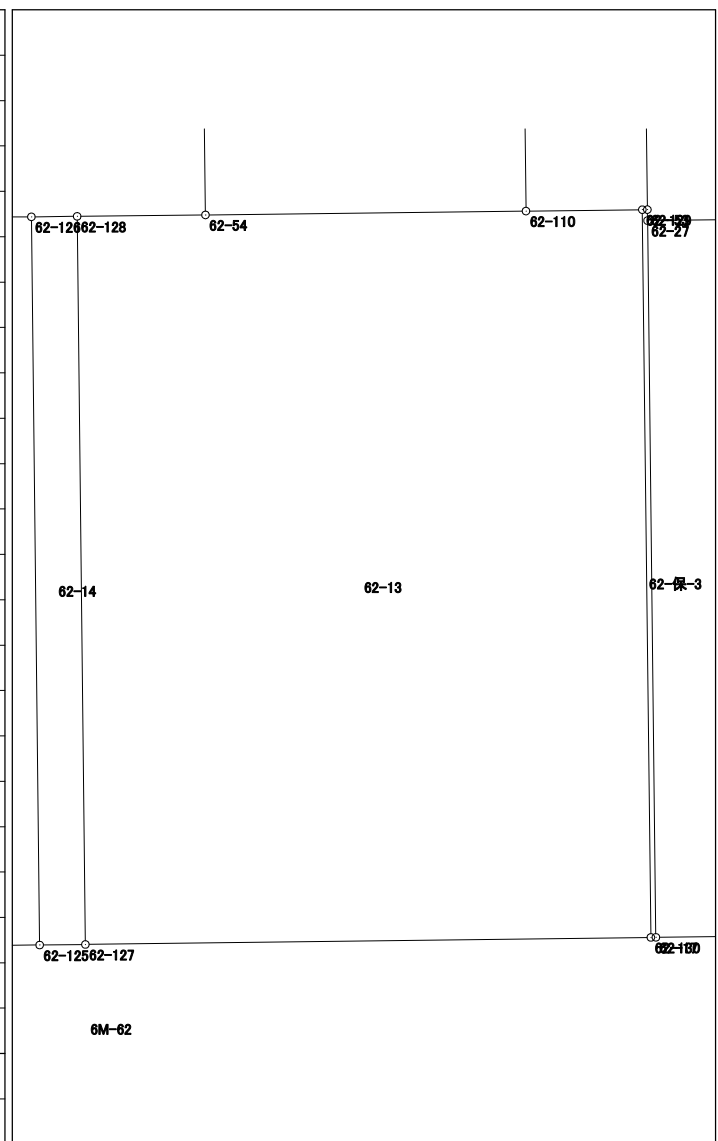


面積計算書 (座標法)

世界測地系 (測地成果2011)

所在	地番	公簿地目	現況地目	地積	所有者
前橋市六供町二丁目	62-14			54.33 m ²	

点名	X座標	Y座標	辺長	方向角	測角	DX	倍積 (Y×DX)
62-126	41428.433	-68059.164	29.412	179-21-05	89-58-17	-29.430	2002981.196520
62-125	41399.023	-68058.831	1.847	89-17-12	89-56-07	-29.387	2000044.866597
62-127	41399.046	-68056.984	29.409	359-21-11	90-03-59	29.430	-2002917.039120
62-128	41428.453	-68057.316	1.848	269-22-48	90-01-37	29.387	-2000000.345292

倍面積	108.678705
面積	54.3393525

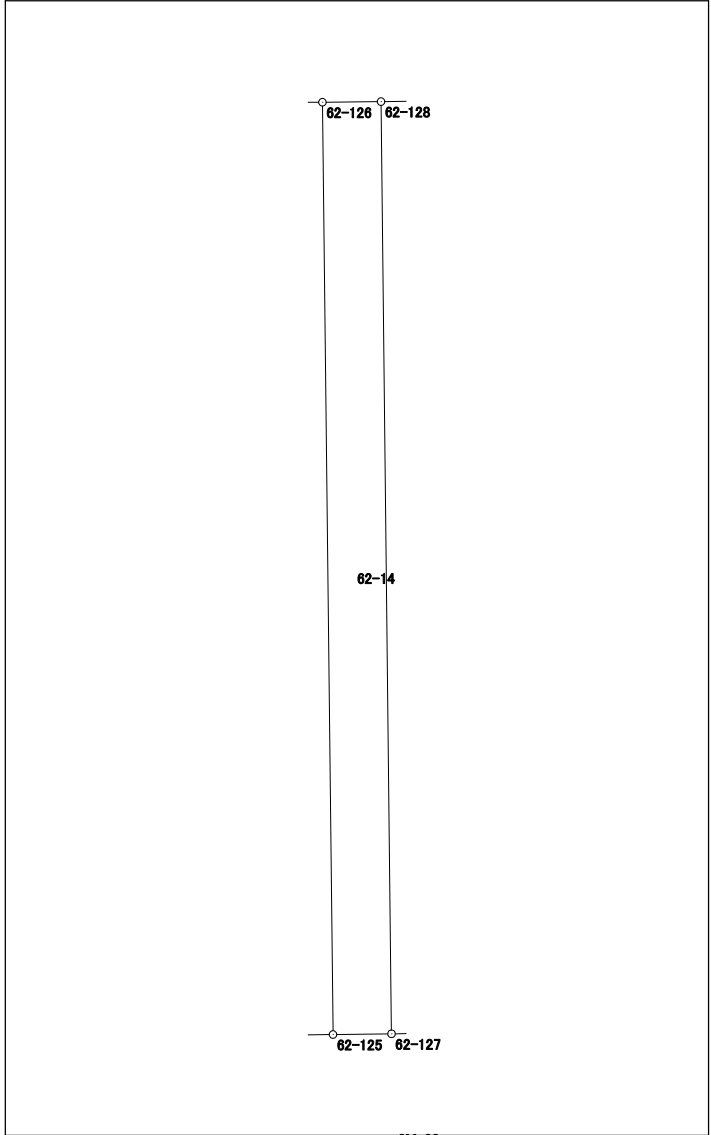


面積計算書（座標法）

世界測地系（測地成果2011）

所 在	地 番	公簿地目	現況地目	地 積	所 有 者
前橋市六供町二丁目	62-17			32.86 m ²	

点 名	X 座標	Y 座標	辺 長	方 向 角	測 角	DX	倍 積 (Y×DX)
62-37	41398.596	-68092.919	27.825	359-18-44	89-59-29	27.837	-1895502.586203
62-36	41426.419	-68093.253	1.181	269-19-15	90-00-31	27.809	-1893605.272677
62-103	41426.405	-68094.434	27.825	179-18-44	89-59-29	-27.837	1895544.759258
62-104	41398.582	-68094.100	1.181	89-19-15	90-00-31	-27.809	1893628.826900
						倍面積	65.727278
						面 積	32.8636390

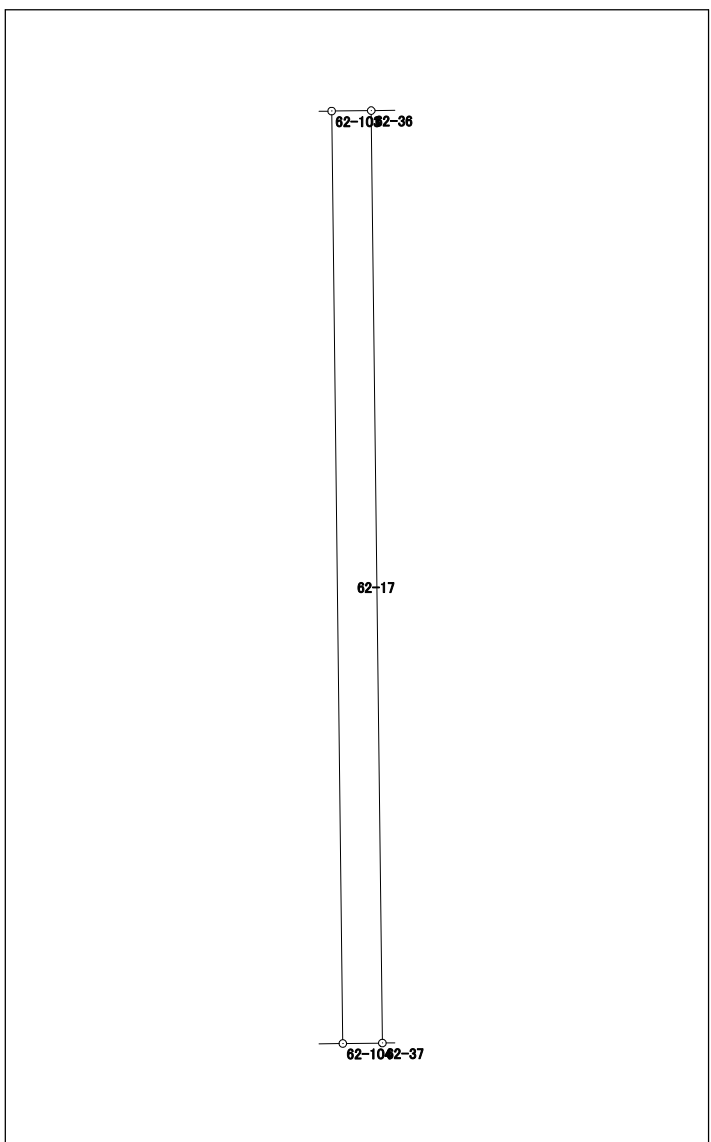


面積計算書（座標法）

世界測地系（測地成果2011）

所 在	地 番	公簿地目	現況地目	地 積	所 有 者
前橋市六供町二丁目	62-18			882.17 m ²	

点 名	X 座標	Y 座標	辺 長	方 向 角	測 角	DX	倍 積 (Y×DX)
62-105	41426.361	-68098.171	10.677	269-19-45	90-00-53	27.700	-1886319.336700
62-44	41426.236	-68108.847	21.831	269-17-10	179-57-25	-0.397	27039.212259
62-41	41425.964	-68130.676	25.082	176-33-20	87-16-10	-25.309	1724319.278884
62-8	41400.927	-68129.169	4.006	133-05-54	136-32-34	-27.774	1892219.539806
62-7	41398.190	-68126.244	28.408	89-18-08	136-12-14	-2.391	162889.849404
62-106	41398.536	-68097.838	27.827	359-18-52	90-00-44	28.171	-1918384.194298

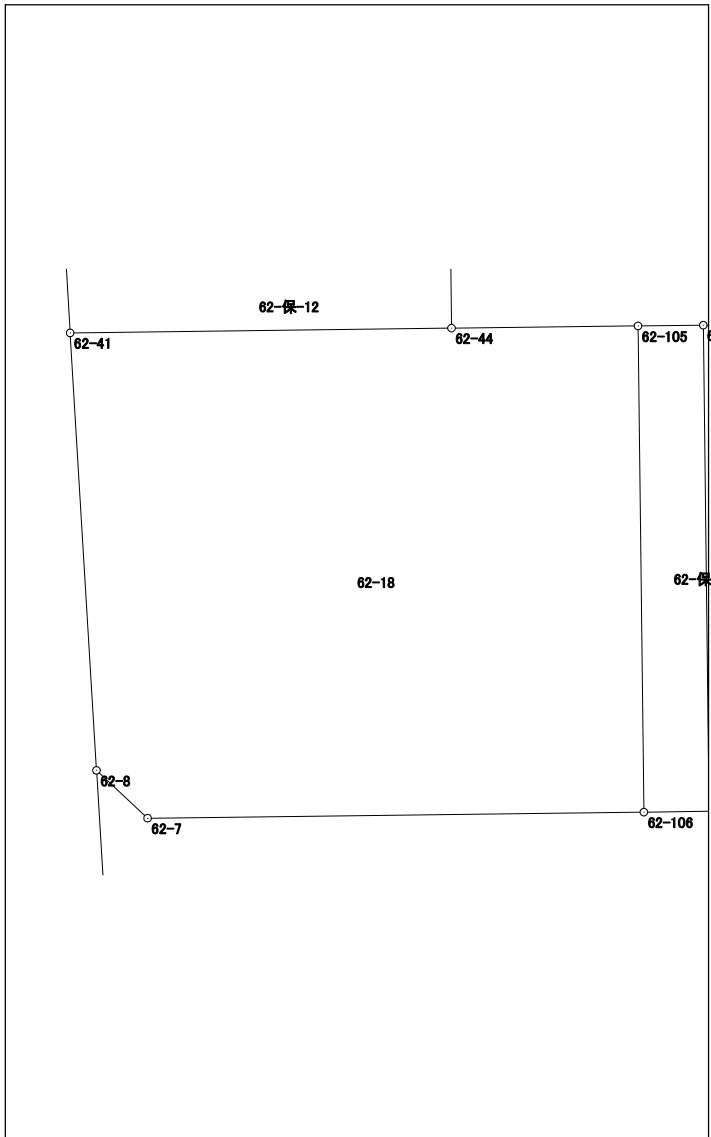

倍面積	1764.349355
面 積	882.1746775

面積計算書 (座標法)

世界測地系 (測地成果2011)

所 在	地 番	公簿地目	現況地目	地 積	所 有 者
前橋市六供町二丁目	62-19			650.10 m ²	

点 名	X 座標	Y 座標	辺 長	方 向 角	測 角	DX	倍 積 (Y×DX)	
62-101	41430.159	-68108.896	28.808	359-17-24	90-00-20	29.081	-1980674.804576	
62-45	41458.965	-68109.253	20.503	269-18-55	90-01-31	28.561	-1945268.374933	
62-2	41458.720	-68129.755	4.005	222-45-49	133-26-54	-3.185	216993.269675	
62-1	41455.780	-68132.474	25.943	176-32-54	133-47-05	-28.836	1964668.020264	
62-102	41429.884	-68130.912	22.018	89-17-04	92-44-10	-25.621	1745582.096352	
							倍面積	
							面 積	650.1033910


面積計算書 (座標法)

世界測地系 (測地成果2011)

所在	地番	公簿地目	現況地目	地積	所有者
前橋市六供町二丁目	62-20			152.67 m ²	

点名	X座標	Y座標	辺長	方向角	測角	DX	倍積 (Y×DX)
62-53	41428.725	-68034.282	31.130	359-19-02	89-52-44	31.130	-2117907.198660
62-16	41459.853	-68034.653	4.904	269-19-21	90-00-19	31.070	-2113836.668710
62-109	41459.795	-68039.557	31.131	179-19-02	89-59-41	-31.187	2121949.664159
62-110	41428.666	-68039.186	4.700	89-18-19	89-59-17	-31.072	2114113.587392
62-129	41428.723	-68034.486	0.204	89-26-18	180-07-59	0.059	-4014.034674

倍面積	305.349507
面積	152.6747535

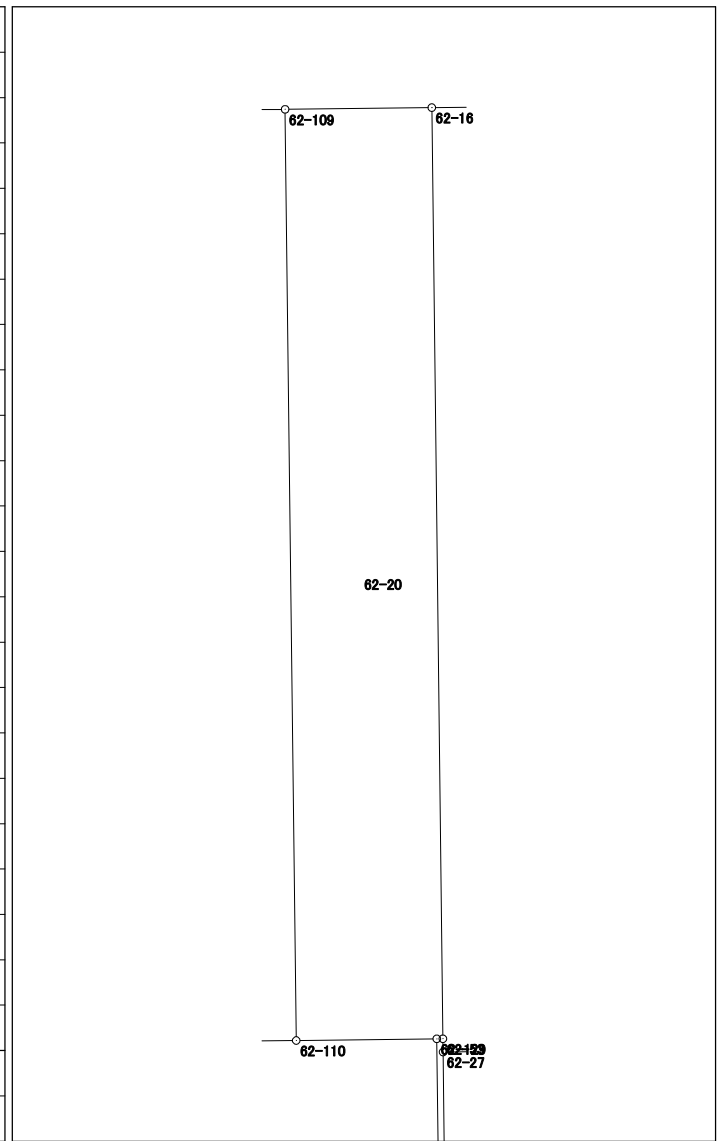


面積計算書（座標法）

世界測地系（測地成果2011）

所 在	地 番	公簿地目	現況地目	地 積	所 有 者
前橋市六供町二丁目	62-保-1			69.00 m ²	

点 名	X 座標	Y 座標	辺 長	方 向 角	測 角	DX	倍 積 (Y×DX)
62-52	41428.394	-68062.713	31.131	359-18-02	179-52-34	32.722	-2227148.094786
62-11	41459.523	-68063.093	2.107	269-17-35	89-59-33	31.103	-2116966.381579
62-107	41459.497	-68065.200	32.724	179-18-24	90-00-49	-32.748	2228999.169600
62-108	41426.775	-68064.804	2.107	89-17-35	89-59-11	-32.696	2225446.831584
62-40	41426.801	-68062.697	1.593	359-25-28	90-07-53	1.619	-110193.506443
倍面積							138.018376
面 積							69.0091880

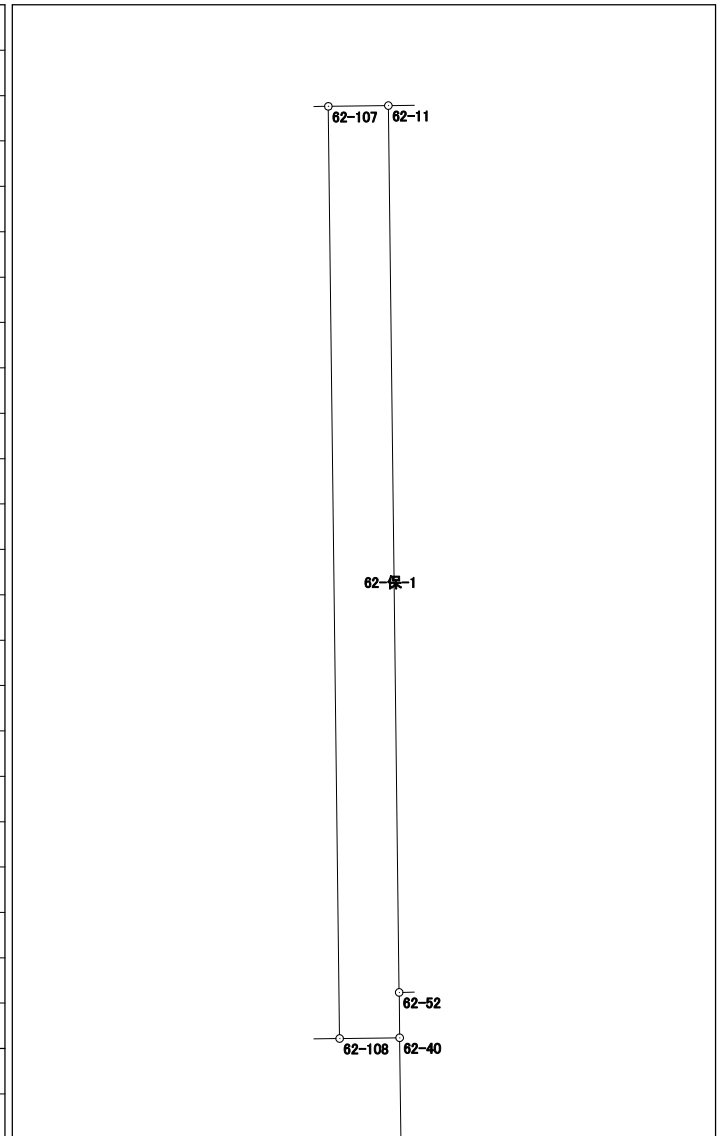

面積計算書 (座標法)

世界測地系 (測地成果2011)

所在	地番	公簿地目	現況地目	地積	所有者
前橋市六供町二丁目	62-保-3			6.00 m ²	


点名	X座標	Y座標	辺長	方向角	測角	DX	倍積 (Y×DX)			
62-27	41428.281	-68034.276	0.444	359-13-33	179-53-41	29.392	-1999663.440192			
62-53	41428.725	-68034.282	0.204	269-26-18	90-12-45	0.442	-30071.152644			
62-129	41428.723	-68034.486	29.395	179-19-46	89-53-28	-29.395	1999873.715970			
62-130	41399.330	-68034.142	0.204	89-09-27	89-49-41	-29.390	1999523.433380			
62-17	41399.333	-68033.938	28.950	359-19-52	90-10-25	28.951	-1969650.539038			
						倍面積	12.017476			
						面積	6.0087380			

面積計算書 (座標法)

世界測地系 (測地成果2011)

所在	地番	公簿地目	現況地目	地積	所有者
前橋市六供町二丁目	62-保-4			83.00 m ²	

点名	X座標	Y座標	辺長	方向角	測角	DX	倍積 (Y×DX)
62-112	41460.113	-68013.129	31.572	179-18-57	90-00-48	-31.602	2149350.902658
62-111	41428.543	-68012.752	2.629	89-18-09	89-59-12	-31.538	2144986.172576
62-113	41428.575	-68010.123	31.572	359-18-57	90-00-48	31.602	-2149255.907046
62-114	41460.145	-68010.500	2.629	269-18-09	89-59-12	31.538	-2144915.149000

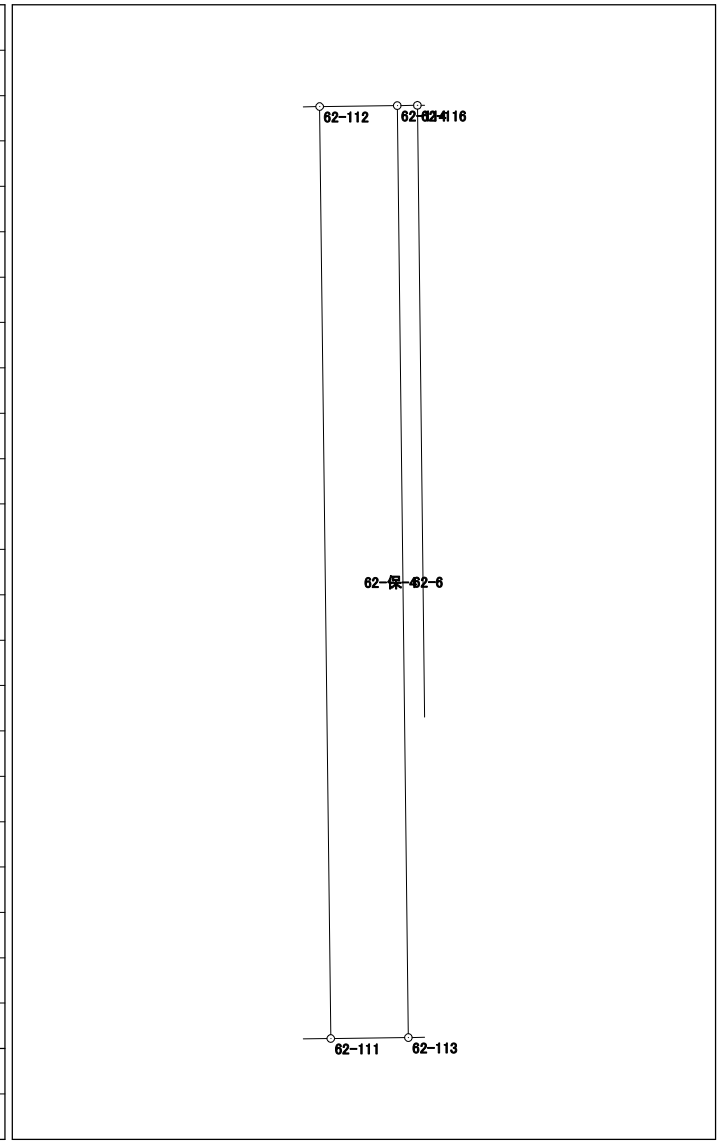


倍面積	166.019188
面積	83.0095940

面積計算書 (座標法)

世界測地系 (測地成果2011)

所 在	地 番	公簿地目	現況地目	地 積	所 有 者
前橋市六供町二丁目	62-保-5			86.00 m ²	


点 名	X 座標	Y 座標	辺 長	方 向 角	測 角	DX	倍 積 (Y×DX)
62-116	41460.153	-68009.817	31.572	179-18-57	90-00-35	-31.603	2149314.246651
62-115	41428.583	-68009.440	2.723	89-17-05	89-58-08	-31.536	2144745.699840
62-28	41428.617	-68006.717	31.571	359-19-10	90-02-05	31.603	-2149216.277351
62-118	41460.186	-68007.092	2.725	269-18-22	89-59-12	31.536	-2144671.653312
						倍面積	172.015828
						面 積	86.0079140

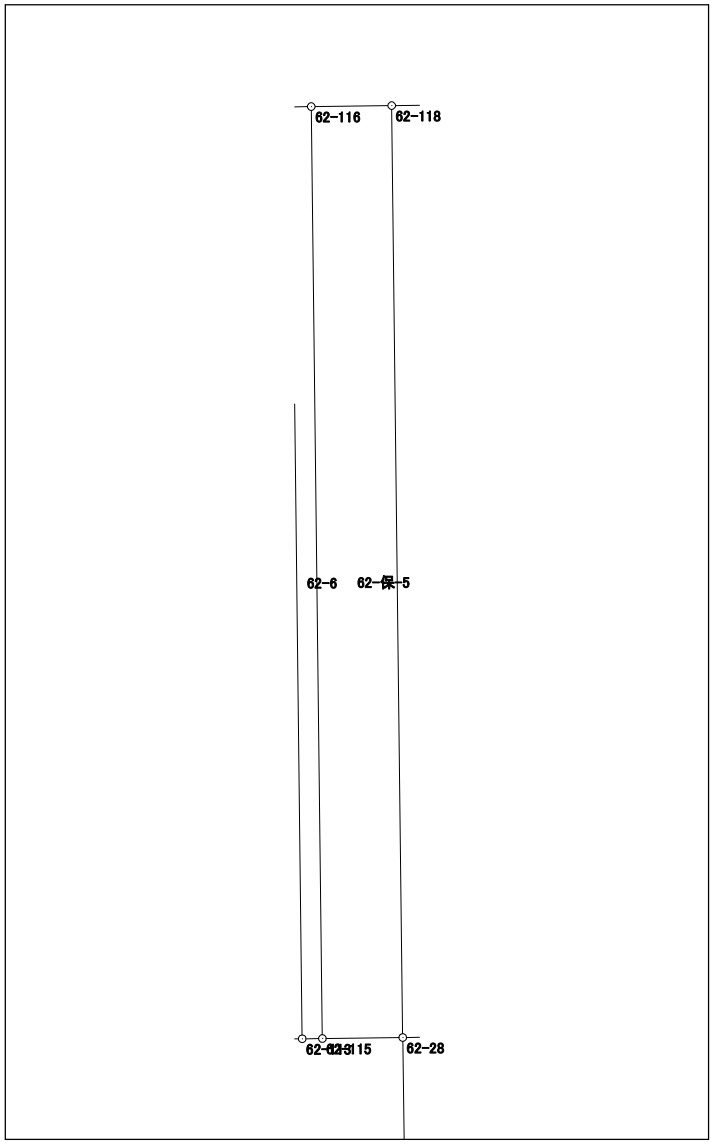

面積計算書 (座標法)

世界測地系 (測地成果2011)

所 在	地 番	公簿地目	現況地目	地 積	所 有 者
前橋市六供町二丁目	62-保-8			80.00 m ²	

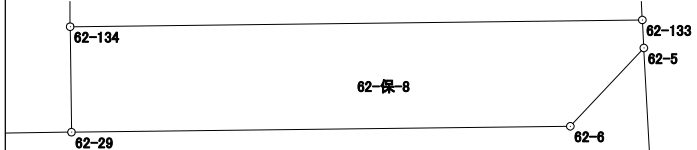
点 名	X 座標	Y 座標	辺 長	方 向 角	測 角	DX	倍 積 (Y×DX)	
62-29	41399.672	-68006.358	18.599	89-19-31	90-02-22	-3.712	252439.600896	
62-6	41399.891	-67987.760	4.004	43-11-55	133-52-24	3.138	-213345.590880	
62-5	41402.810	-67985.019	1.046	356-52-30	133-40-35	3.963	-269424.630297	
62-133	41403.854	-67985.076	21.332	269-19-33	92-27-03	0.793	-53912.165268	
62-134	41403.603	-68006.407	3.931	179-17-09	89-57-36	-4.182	284402.794074	
						倍面積	160.008525	
						面 積	80.0042625	

面積計算書 (座標法)

世界測地系 (測地成果2011)

所 在	地 番	公簿地目	現況地目	地 積	所 有 者
前橋市六供町二丁目	62-保-10			1.00 m ²	

点 名	X 座標	Y 座標	辺 長	方 向 角	測 角	DX	倍 積 (Y×DX)
62-137	41399.966	-68063.391	1.000	179-22-11	90-06-52	-1.013	68948.215083
62-135	41398.966	-68063.380	1.000	89-15-19	89-53-08	-0.987	67178.556060
62-12	41398.979	-68062.380	1.000	359-22-11	90-06-52	1.013	-68947.190940
62-136	41399.979	-68062.391	1.000	269-15-19	89-53-08	0.987	-67177.579917

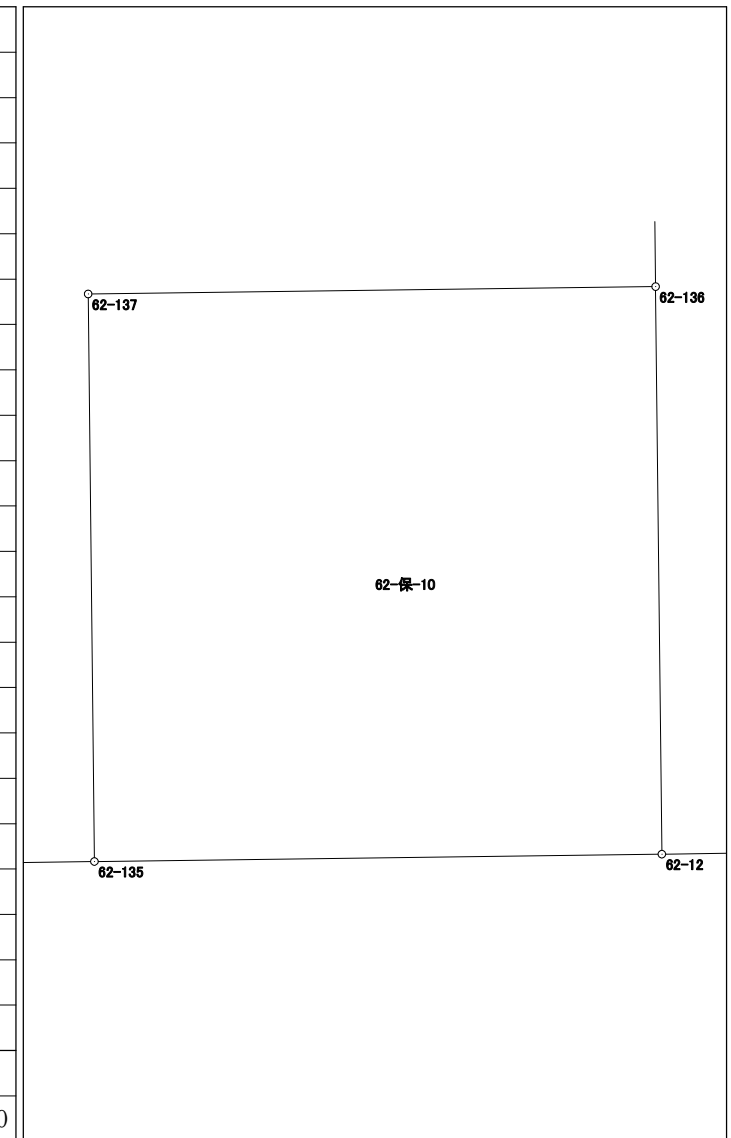


面積計算書（座標法）

世界測地系（測地成果2011）

所在	地番	公簿地目	現況地目	地積	所有者
前橋市六供町二丁目	62-保-11			104.00 m ²	

点名	X座標	Y座標	辺長	方向角	測角	DX	倍積 (Y×DX)
62-103	41426.405	-68094.434	3.737	269-19-32	90-00-48	27.779	-1891595.282086
62-105	41426.361	-68098.171	27.827	179-18-52	89-59-20	-27.869	1897827.927599
62-106	41398.536	-68097.838	3.738	89-17-42	89-58-50	-27.779	1891689.841802
62-104	41398.582	-68094.100	27.825	359-18-44	90-01-02	27.869	-1897714.472900
						倍面積	208.014415
						面積	104.0072075

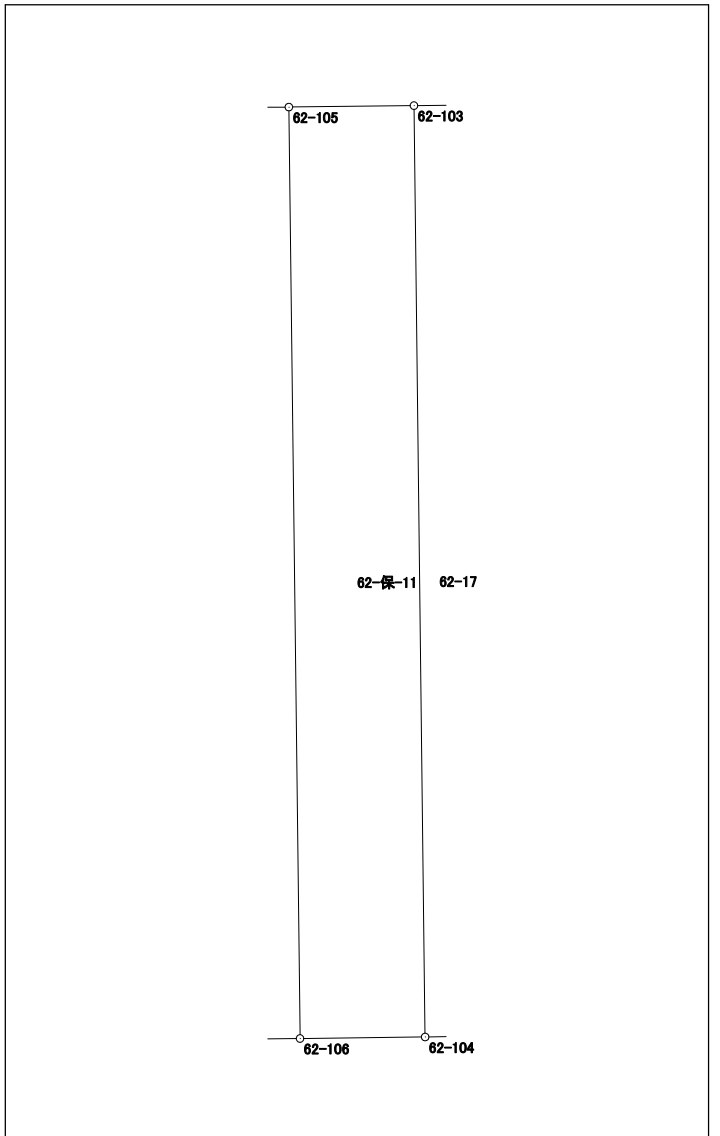


面積計算書（座標法）

世界測地系（測地成果2011）

所在	地番	公簿地目	現況地目	地積	所有者
前橋市六供町二丁目	62-保-12			86.00 m ²	

点名	X座標	Y座標	辺長	方向角	測角	DX	倍積 (Y×DX)
62-41	41425.964	-68130.676	21.831	89-17-10	92-43-53	-3.648	248540.706048
62-44	41426.236	-68108.847	3.923	359-17-04	89-59-54	4.195	-285716.613165
62-101	41430.159	-68108.896	22.018	269-17-04	90-00-00	3.648	-248461.252608
62-102	41429.884	-68130.912	3.927	176-33-17	87-16-13	-4.195	285809.175840

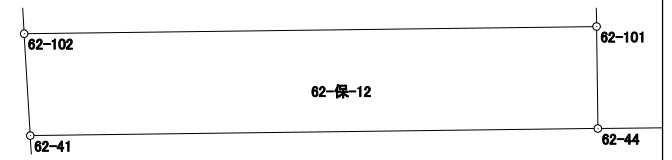

倍面積	172.016115
面積	86.0080575

