



63-1街区 画地出来形確認図 (1351.71m²)

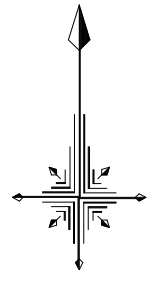

S=1/500

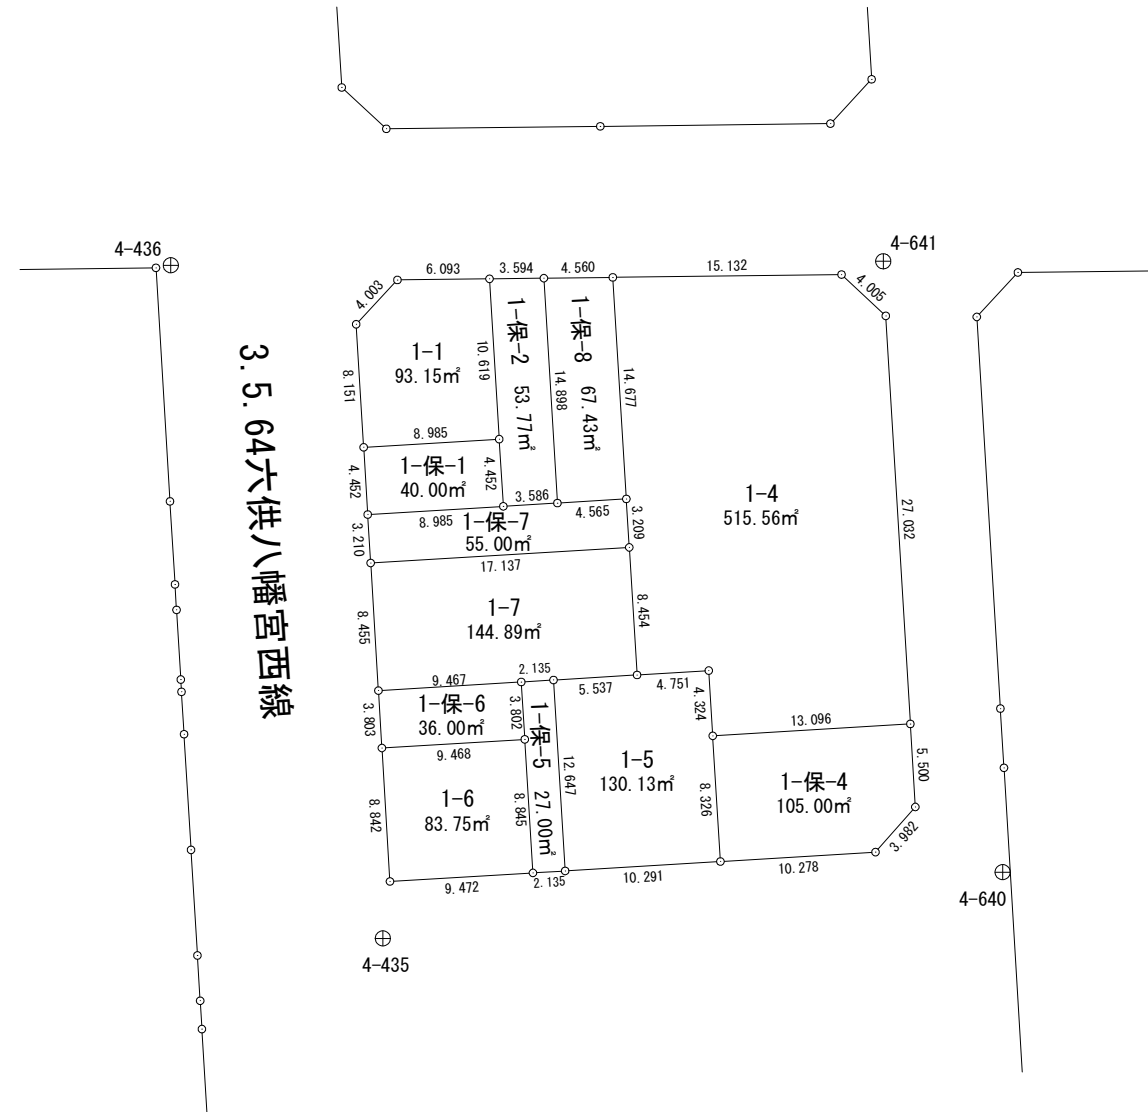


面積計算書（座標法）

世界測地系（測地成果2011）

所 在	地 番	公簿地目	現況地目	地 積	所 有 者
前橋市六供町二丁目	63-1-1			93.15 m ²	

点 名	X 座標	Y 座標	辺 長	方 向 角	測 角	DX	倍 積 (Y×DX)
63-1-101	41447.699	-68164.062	10.619	356-31-43	89-58-50	11.141	-759415.814742
63-1-19	41458.299	-68164.705	6.093	269-18-15	92-46-32	10.526	-717501.684830
63-1-2	41458.225	-68170.798	4.003	222-55-29	133-37-14	-3.005	204853.247990
63-1-1	41455.294	-68173.524	8.151	176-31-57	133-36-28	-11.067	754476.390108
63-1-102	41447.158	-68173.031	8.985	86-32-53	90-00-56	-7.595	517774.170445
						倍面積	186.308971
						面 積	93.1544855

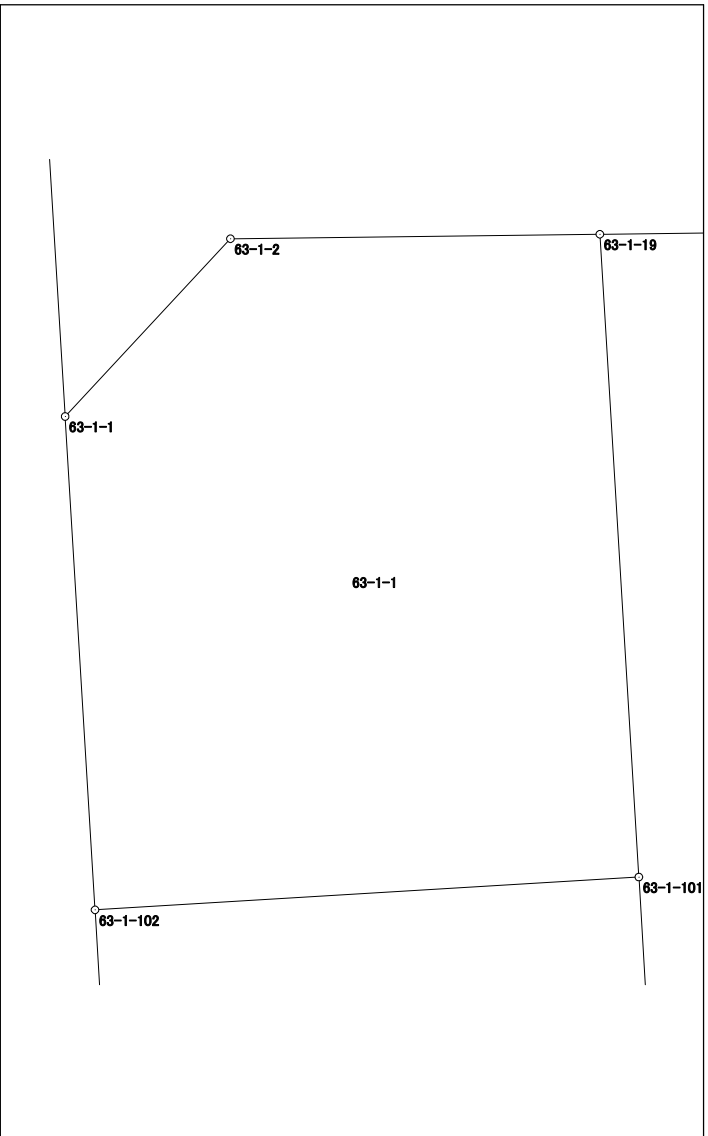


面積計算書 (座標法)

世界測地系 (測地成果2011)

所在	地番	公簿地目	現況地目	地積	所有者
前橋市六供町二丁目	63-1-4			515.56 m ²	


点名	X座標	Y座標	辺長	方向角	測角	DX	倍積 (Y×DX)
63-1-107	41428.867	-68136.868	27.032	356-33-21	90-00-20	27.771	-1892228.961228
63-1-4	41455.850	-68138.492	4.005	313-01-38	136-28-17	29.716	-2024803.428272
63-1-3	41458.583	-68141.420	15.132	269-17-17	136-15-39	2.545	-173419.913900
63-1-22	41458.395	-68156.551	14.677	176-30-00	87-12-43	-14.838	1011306.903738
63-1-16	41443.745	-68155.655	3.209	176-30-58	180-00-58	-17.853	1216782.908715
63-1-104	41440.542	-68155.460	8.454	176-30-51	179-59-53	-11.641	793397.709860
63-1-23	41432.104	-68154.946	4.751	86-29-18	89-58-27	-8.147	555258.345062
63-1-24	41432.395	-68150.204	4.324	176-29-59	270-00-41	-4.025	274304.571100
63-1-108	41428.079	-68149.940	13.096	86-33-01	90-03-02	-3.528	240432.988320
						倍面積	1031.123395
						面積	515.5616975

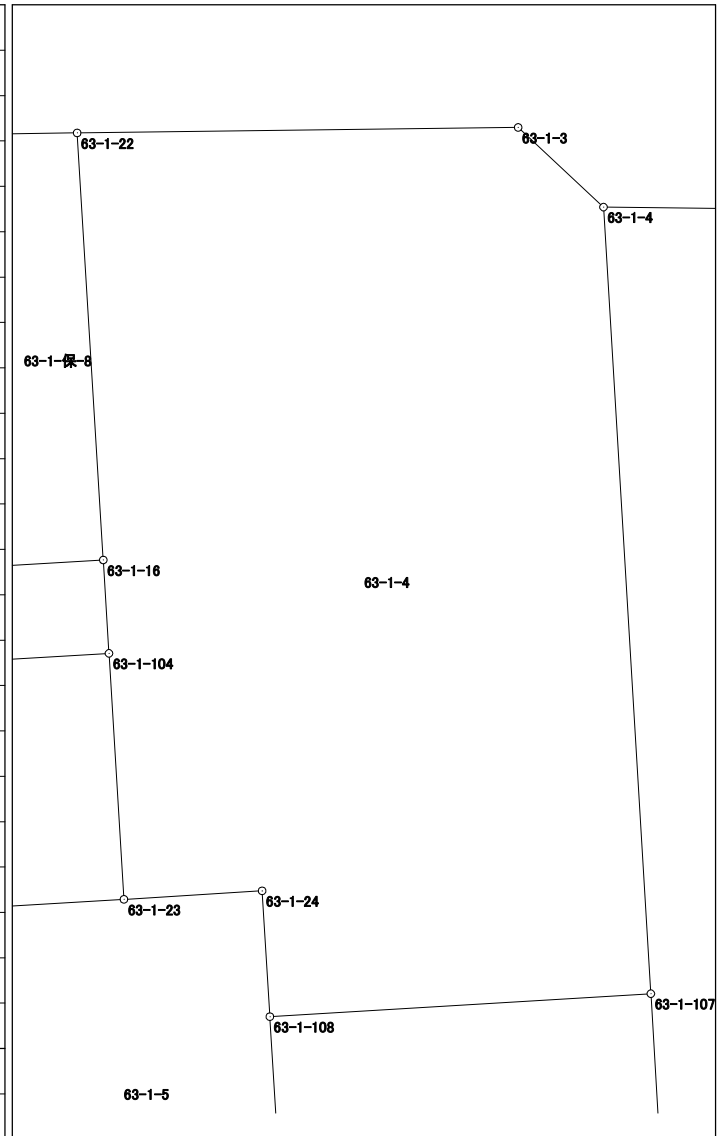

面積計算書 (座標法)

世界測地系 (測地成果2011)

所 在	地 番	公簿地目	現況地目	地 積	所 有 者
前橋市六供町二丁目	63-1-5			130.13 m ²	

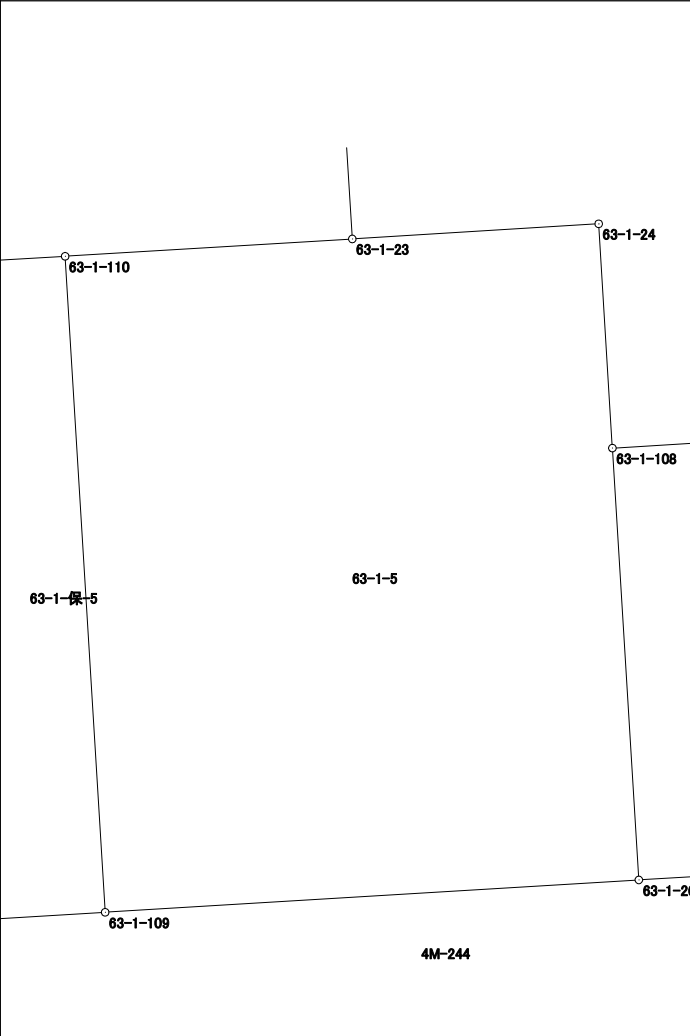
点 名	X 座 標	Y 座 標	辺 長	方 向 角	測 角	DX	倍 積 (Y×DX)	
63-1-109	41419.146	-68159.703	10.291	86-31-45	90-01-11	-12.001	817984.595703	
63-1-26	41419.769	-68149.431	8.326	356-29-42	89-57-57	8.933	-608778.867123	
63-1-108	41428.079	-68149.940	4.324	356-29-59	180-00-17	12.626	-860461.142440	
63-1-24	41432.395	-68150.204	4.751	266-29-18	89-59-19	4.025	-274304.571100	
63-1-23	41432.104	-68154.946	5.537	266-32-30	180-03-12	-0.625	42596.841250	
63-1-110	41431.770	-68160.473	12.647	176-30-34	89-58-04	-12.958	883223.409134	
倍面積							260.265424	
面 積							130.1327120	

面積計算書 (座標法)

世界測地系 (測地成果2011)

所在	地番	公簿地目	現況地目	地積	所有者
前橋市六供町二丁目	63-1-7			144.89 m ²	

点名	X座標	Y座標	辺長	方向角	測角	DX	倍積 (Y×DX)
63-1-103	41439.510	-68172.566	8.455	176-31-41	89-58-50	-9.471	645662.372586
63-1-25	41431.071	-68172.054	9.467	86-32-54	90-01-13	-7.869	536445.892926
63-1-27	41431.641	-68162.604	2.135	86-32-09	179-59-15	0.699	-47645.660196
63-1-110	41431.770	-68160.473	5.537	86-32-30	180-00-21	0.463	-31558.298999
63-1-23	41432.104	-68154.946	8.454	356-30-51	89-58-21	8.772	-597855.186312
63-1-104	41440.542	-68155.460	17.137	266-32-51	90-02-00	7.406	-504759.336760

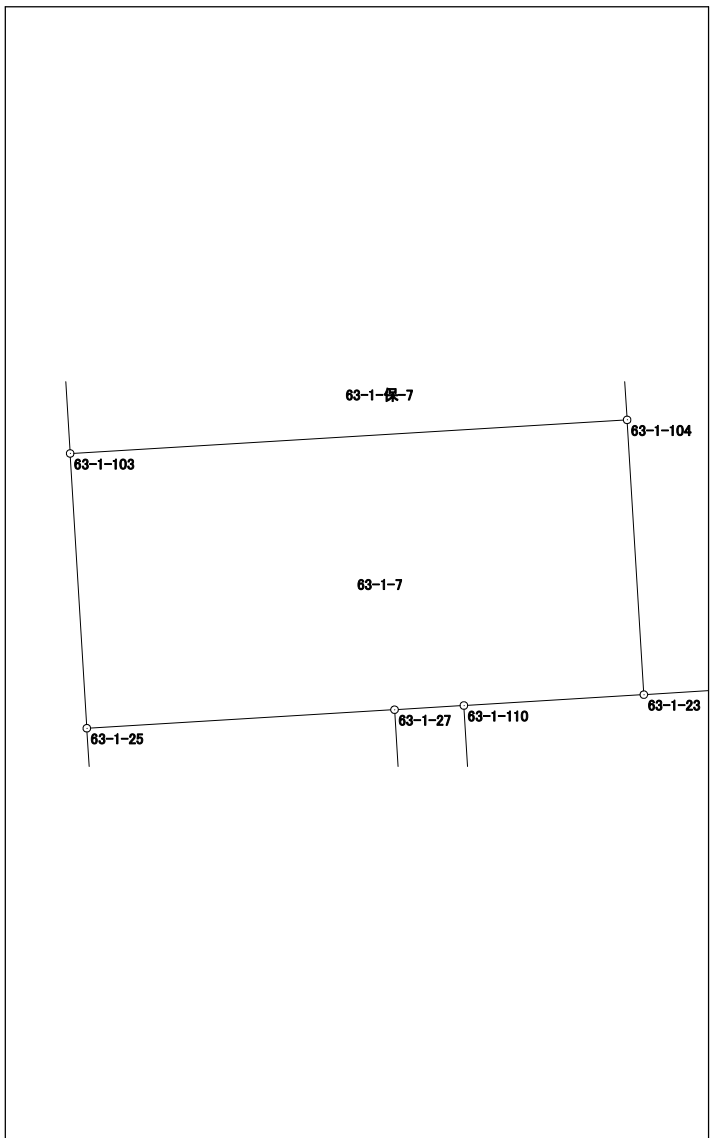


倍面積	289.783245
面積	144.8916225

面積計算書 (座標法)

世界測地系 (測地成果2011)

所在	地番	公簿地目	現況地目	地積	所有者
前橋市六供町二丁目	63-1-保-1			40.00 m ²	

点名	X座標	Y座標	辺長	方向角	測角	D _X	倍積 (Y×D _X)
63-1-18	41443.255	-68163.792	4.452	356-31-24	89-58-31	4.985	-339796.503120
63-1-101	41447.699	-68164.062	8.985	266-32-53	90-01-29	3.903	-266044.333986
63-1-102	41447.158	-68173.031	4.452	176-31-24	89-58-31	-4.985	339842.559535
63-1-17	41442.714	-68172.761	8.985	86-32-53	90-01-29	-3.903	266078.286183

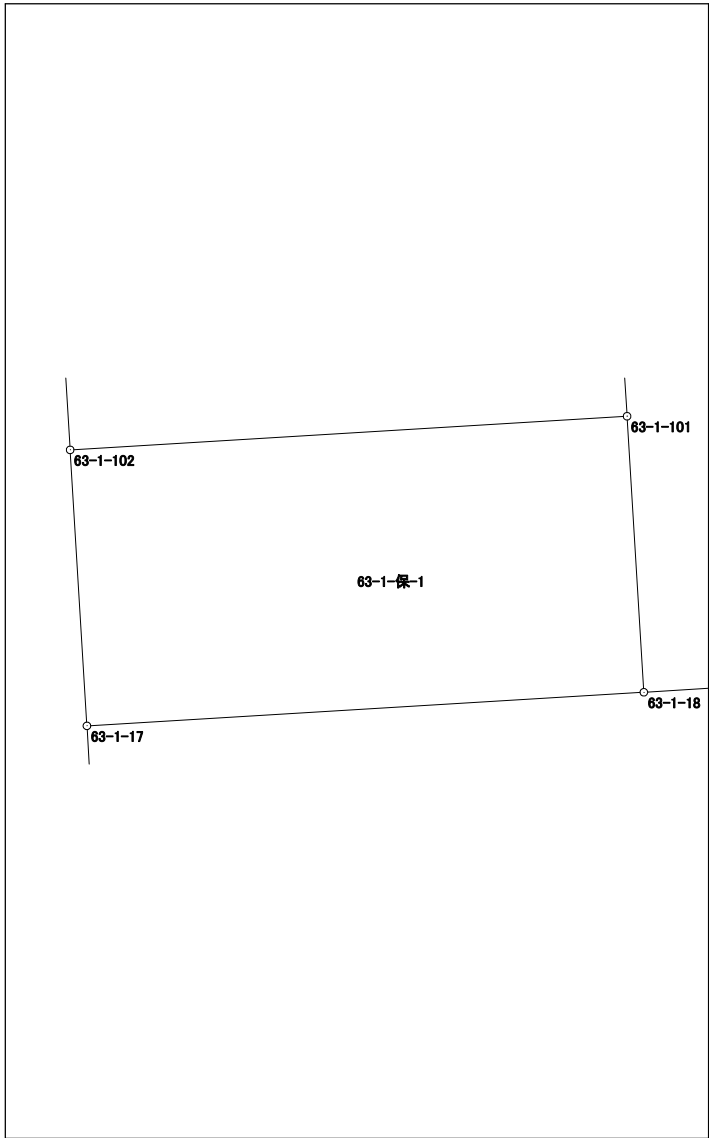


倍面積	80.008612
面積	40.0043060

面積計算書（座標法）

世界測地系（測地成果2011）

所 在	地 番	公簿地目	現況地目	地 積	所 有 者
前橋市六供町二丁目	63-1-保-5			27.00 m ²	

点 名	X 座標	Y 座標	辺 長	方 向 角	測 角	DX	倍 積 (Y×DX)
63-1-106	41427.846	-68162.373	8.845	176-30-23	179-59-23	-12.624	860481.796752
63-1-28	41419.017	-68161.834	2.135	86-32-09	90-01-46	-8.700	593007.955800
63-1-109	41419.146	-68159.703	12.647	356-30-34	89-58-25	12.753	-869240.692359
63-1-110	41431.770	-68160.473	2.135	266-32-09	90-01-35	12.495	-851665.110135
63-1-27	41431.641	-68162.604	3.802	176-31-00	89-58-51	-3.924	267470.058096
						倍面積	54.008154
						面 積	27.0040770

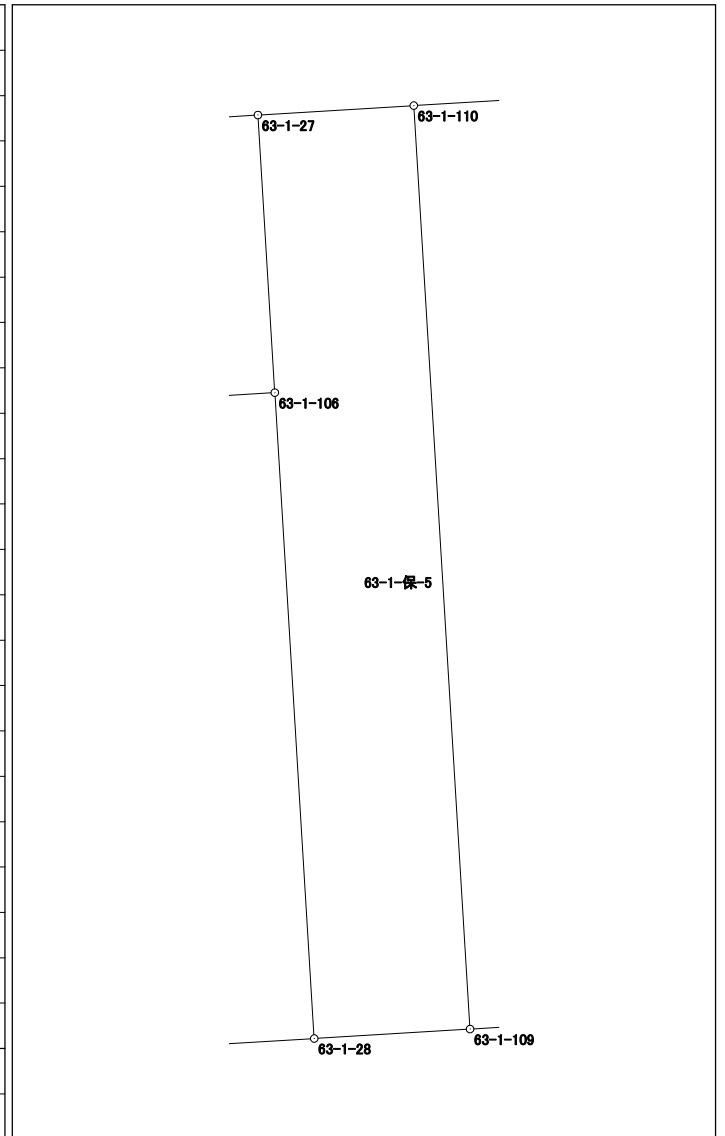


面積計算書（座標法）

世界測地系（測地成果2011）

所 在	地 番	公簿地目	現況地目	地 積	所 有 者
前橋市六供町二丁目	63-1-保-6			36.00 m ²	

点 名	X 座標	Y 座標	辺 長	方 向 角	測 角	DX	倍 積 (Y×DX)
63-1-25	41431.071	-68172.054	3.803	176-31-58	89-59-04	-4.366	297639.187764
63-1-105	41427.275	-68171.824	9.468	86-32-33	90-00-35	-3.225	219854.132400
63-1-106	41427.846	-68162.373	3.802	356-31-00	89-58-27	4.366	-297596.920518
63-1-27	41431.641	-68162.604	9.467	266-32-54	90-01-54	3.225	-219824.397900
						倍面積	72.001746
						面 積	36.0008730

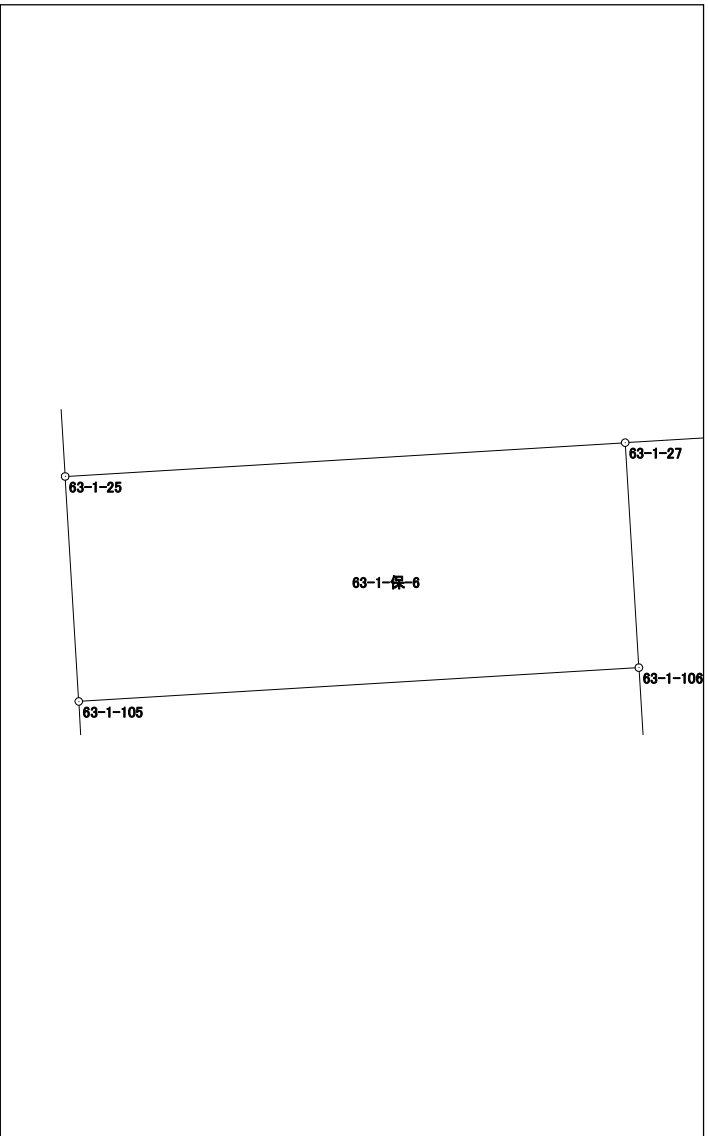

面積計算書 (座標法)

世界測地系 (測地成果2011)

所在	地番	公簿地目	現況地目	地積	所有者
前橋市六供町二丁目	63-1-保-8			67.43 m ²	

点名	X座標	Y座標	辺長	方向角	測角	DX	倍積 (Y×DX)
63-1-55	41458.341	-68161.111	14.898	176-32-26	87-13-08	-14.925	1017304.581675
63-1-56	41443.470	-68160.212	4.565	86-32-48	90-00-22	-14.596	994866.454352
63-1-16	41443.745	-68155.655	14.677	356-30-00	89-57-12	14.925	-1017223.150875
63-1-22	41458.395	-68156.551	4.560	269-19-18	92-49-18	14.596	-994813.018396

倍面積	134.866756
面積	67.4333780

