



# 68-2街区 画地出来形確認図 (1722.23m<sup>2</sup>)

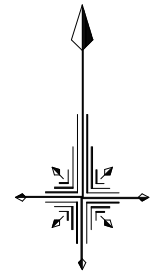

S=1/500

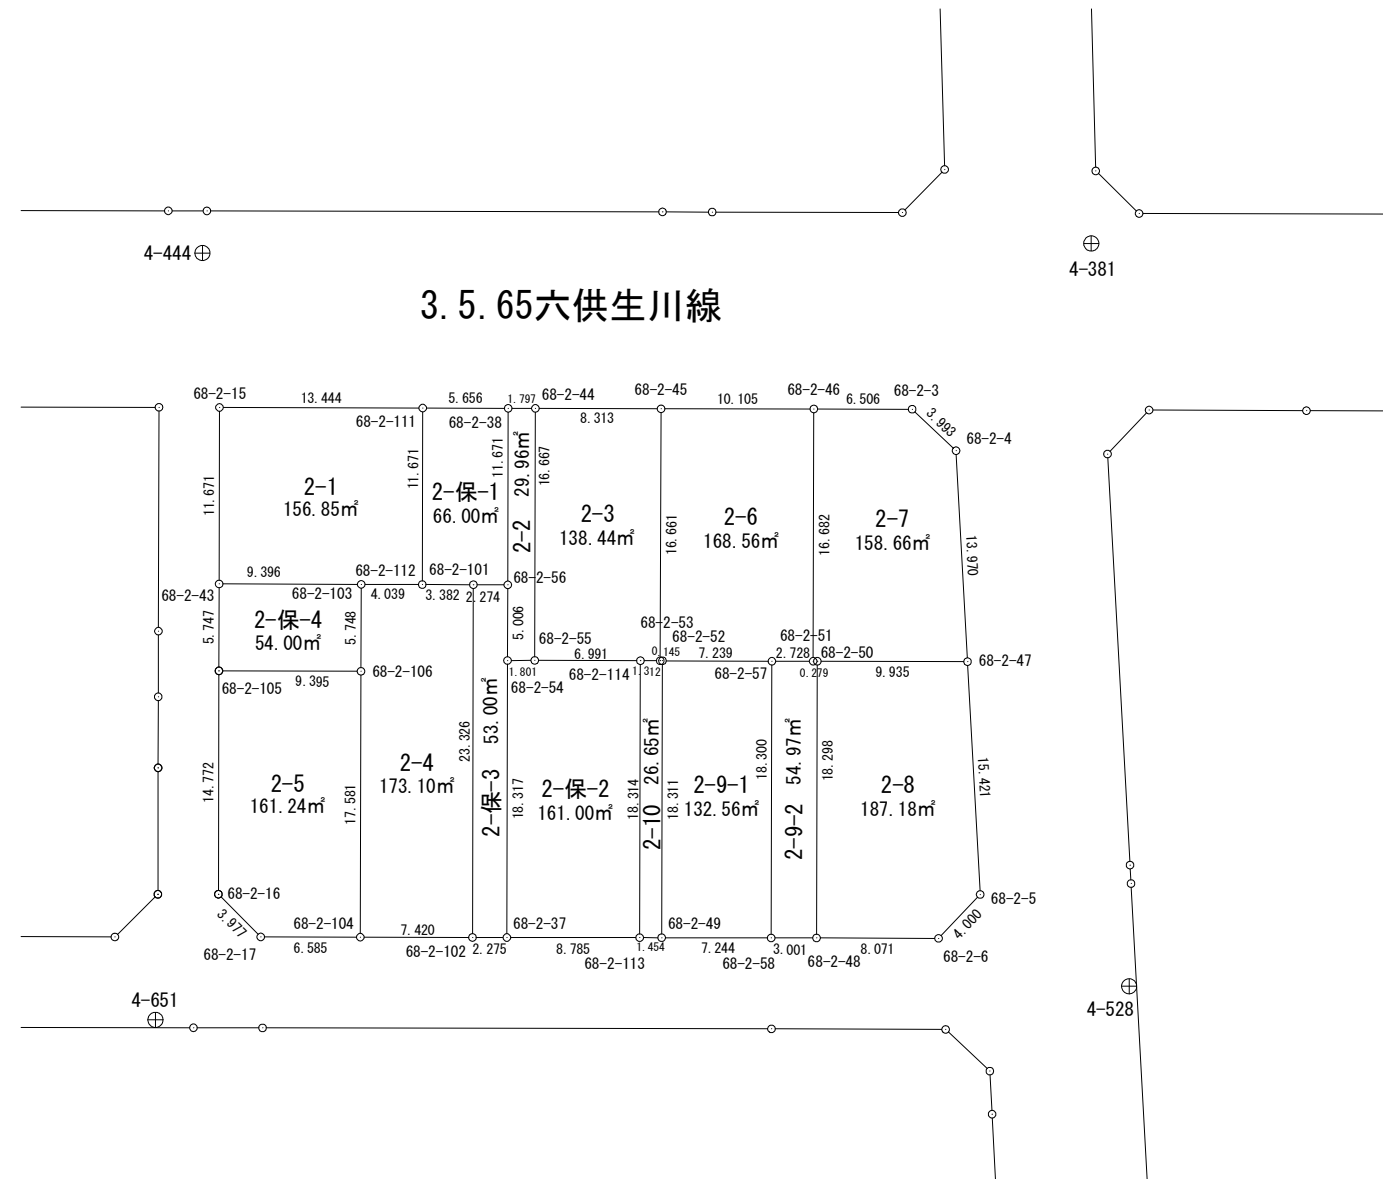

# 面積計算書 (座標法)

世界測地系 (測地成果2011)

所在	地番	公簿地目	現況地目	地積	所有者
前橋市六供町二丁目	68-2-1			156.85 m <sup>2</sup>	

点名	X座標	Y座標	辺長	方向角	測角	DX	倍積 (Y×DX)	
68-2-111	41631.830	-68034.671	13.444	270-10-14	90-01-41	11.711	-796754.032081	
68-2-15	41631.870	-68048.115	11.671	180-05-53	89-55-39	-11.631	791467.625565	
68-2-43	41620.199	-68048.135	9.396	90-10-15	90-04-22	-11.699	796095.131365	
68-2-103	41620.171	-68038.739	4.039	90-10-13	179-59-58	-0.040	2721.549560	
68-2-112	41620.159	-68034.700	11.671	0-08-33	89-58-20	11.659	-793216.567300	
倍面積							313.707109	
面積							156.8535545	

# 面積計算書 (座標法)

世界測地系 (測地成果2011)

所 在	地 番	公簿地目	現況地目	地 積	所 有 者
前橋市六供町二丁目	68-2-2			29.96 m <sup>2</sup>	


点 名	X 座標	Y 座標	辺 長	方 向 角	測 角	DX	倍 積 (Y×DX)		
68-2-38	41631.813	-68029.015	11.671	180-08-33	90-02-49	-11.668	793762.547020		
68-2-56	41620.142	-68029.044	5.006	180-11-40	180-03-07	-16.677	1134520.366788		
68-2-54	41615.136	-68029.061	1.801	89-46-38	89-34-58	-4.999	340077.275939		
68-2-55	41615.143	-68027.260	16.667	0-08-40	90-22-02	16.674	-1134286.533240		
68-2-44	41631.810	-68027.218	1.797	270-05-44	89-57-04	16.670	-1134013.724060		
倍面積							59.932447		
面 積							29.9662235		

# 面積計算書 (座標法)

世界測地系 (測地成果2011)

所 在	地 番	公簿地目	現況地目	地 積	所 有 者
前橋市六供町二丁目	68-2-3			138.44 m <sup>2</sup>	

点 名	X 座標	Y 座標	辺 長	方 向 角	測 角	DX	倍 積 (Y×DX)
68-2-44	41631.810	-68027.218	16.667	180-08-40	89-56-40	-16.638	1131836.853084
68-2-55	41615.143	-68027.260	6.991	90-09-21	90-00-41	-16.686	1135102.860360
68-2-114	41615.124	-68020.269	1.312	90-10-29	180-01-08	-0.023	1564.466187
68-2-53	41615.120	-68018.957	16.661	0-10-44	90-00-15	16.657	-1132991.766749
68-2-45	41631.781	-68018.905	8.313	270-12-00	90-01-16	16.690	-1135235.524450

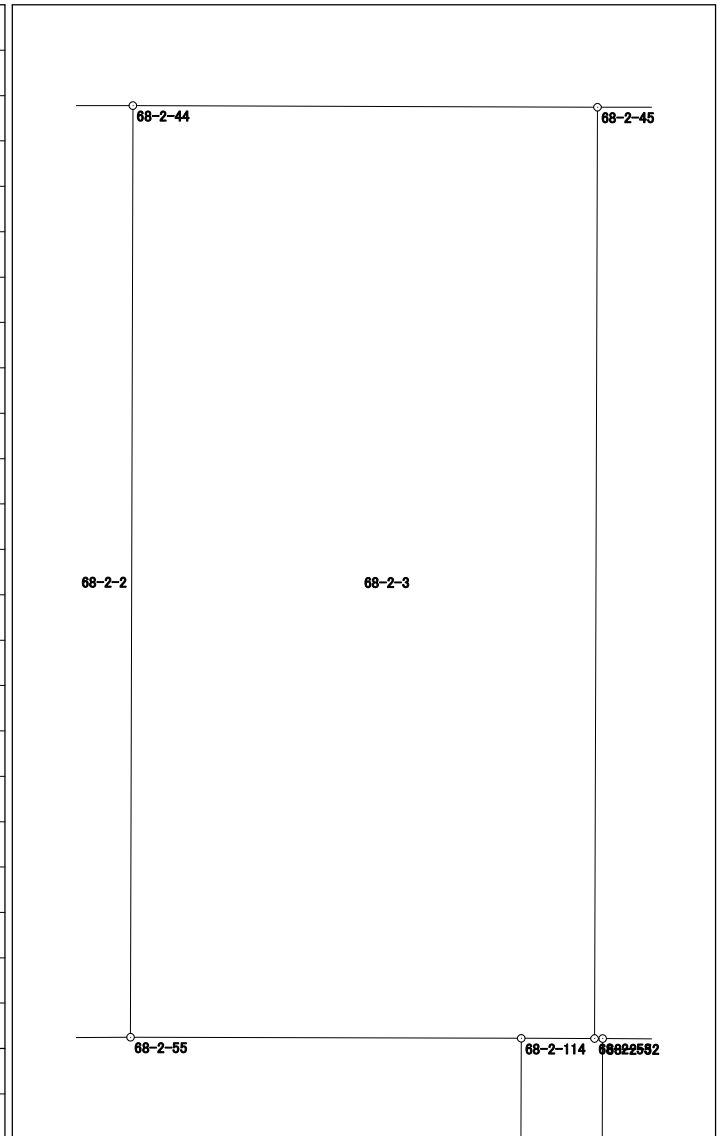

倍面積	276.888432
面 積	138.4442160


# 面積計算書 (座標法)

世界測地系 (測地成果2011)

所 在	地 番	公簿地目	現況地目	地 積	所 有 者
前橋市六供町二丁目	68-2-4			173.10 m <sup>2</sup>	

点 名	X 座標	Y 座標	辺 長	方 向 角	測 角	DX	倍 積 (Y×DX)
68-2-102	41596.824	-68031.378	23.326	0-08-51	90-00-31	23.308	-1585675.358424
68-2-101	41620.150	-68031.318	3.382	270-09-09	90-00-18	23.335	-1587510.805530
68-2-112	41620.159	-68034.700	4.039	270-10-13	180-01-04	0.021	-1428.728700
68-2-103	41620.171	-68038.739	5.748	180-08-58	89-58-45	-5.736	390270.206904
68-2-106	41614.423	-68038.754	17.581	180-08-36	179-59-38	-23.329	1587276.092066
68-2-104	41596.842	-68038.798	7.420	90-08-20	89-59-44	-17.599	1197414.806002

倍面積	346.212318
面 積	173.1061590

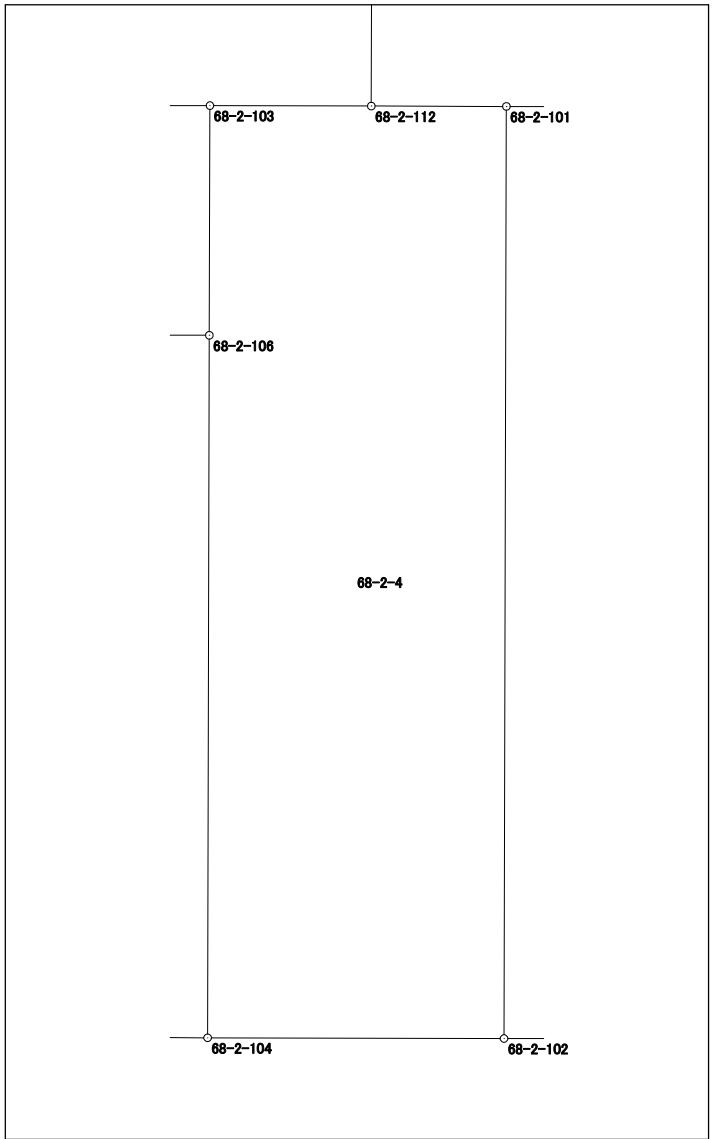


# 面積計算書（座標法）

世界測地系（測地成果2011）

所在	地番	公簿地目	現況地目	地積	所有者
前橋市六供町二丁目	68-2-5			161.24 m <sup>2</sup>	

点名	X座標	Y座標	辺長	方向角	測角	DX	倍積 (Y×DX)
68-2-105	41614.452	-68048.149	14.772	180-08-37	89-58-00	-14.743	1003233.860707
68-2-16	41599.680	-68048.186	3.977	135-11-37	135-03-00	-17.594	1197239.784484
68-2-17	41596.858	-68045.383	6.585	90-08-21	134-56-44	-2.838	193112.796954
68-2-104	41596.842	-68038.798	17.581	0-08-36	90-00-15	17.565	-1195101.486870
68-2-106	41614.423	-68038.754	9.395	270-10-37	90-02-01	17.610	-1198162.457940
						倍面積	322.497335
						面積	161.2486675

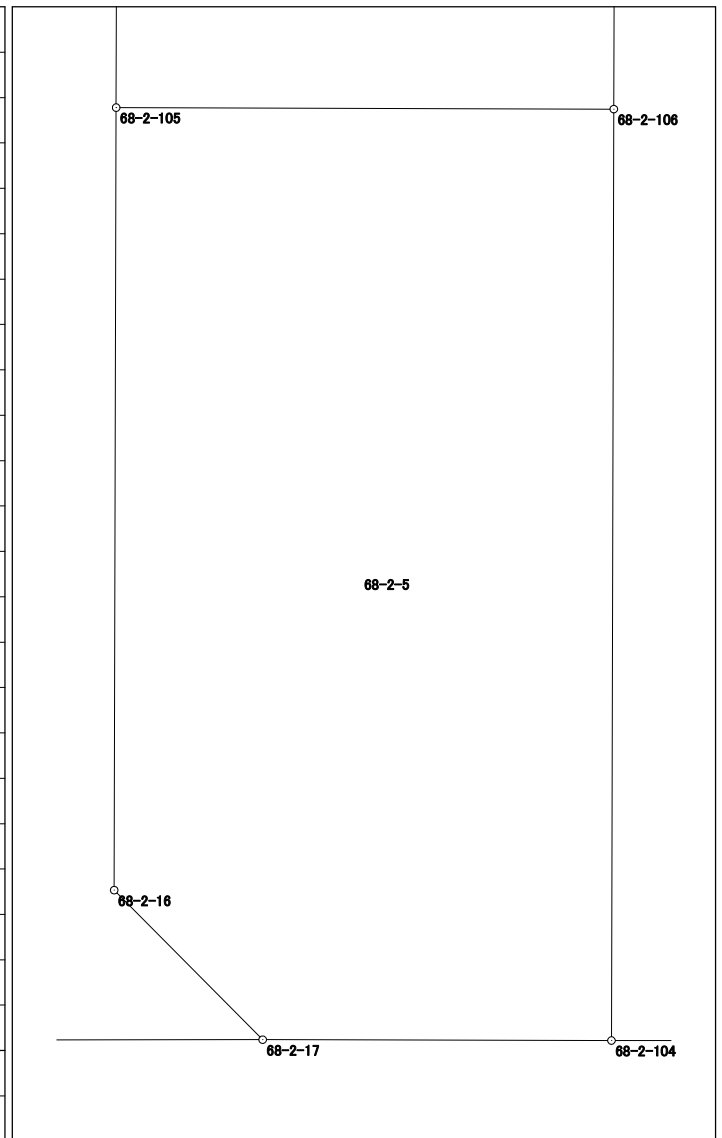

# 面積計算書（座標法）

世界測地系（測地成果2011）

所 在	地 番	公簿地目	現況地目	地 積	所 有 者
前橋市六供町二丁目	68-2-6			168.56 m <sup>2</sup>	

点 名	X 座標	Y 座標	辺 長	方 向 角	測 角	DX	倍 積 (Y×DX)	
68-2-45	41631.781	-68018.905	16.661	180-10-44	90-06-59	-16.650	1132514.768250	
68-2-53	41615.120	-68018.957	0.145	90-23-42	90-12-58	-16.662	1133331.861534	
68-2-52	41615.119	-68018.812	7.239	90-14-15	179-50-33	-0.031	2108.583172	
68-2-57	41615.089	-68011.573	2.728	90-01-16	179-47-01	-0.031	2108.358763	
68-2-51	41615.088	-68008.845	16.682	0-09-16	90-08-00	16.681	-1134455.543445	
68-2-46	41631.770	-68008.800	10.105	270-03-45	89-54-29	16.693	-1135270.898400	
							倍面積	337.129874
							面 積	168.5649370

## 面積計算書 (座標法)

世界測地系 (測地成果2011)

所在	地番	公簿地目	現況地目	地積	所有者
前橋市六供町二丁目	68-2-7			158.66 m <sup>2</sup>	

点名	X座標	Y座標	辺長	方向角	測角	DX	倍積 (Y×DX)	
68-2-46	41631.770	-68008.800	16.682	180-09-16	90-00-17	-16.665	1133366.652000	
68-2-51	41615.088	-68008.845	0.279	90-00-00	89-50-44	-16.682	1134523.552290	
68-2-50	41615.088	-68008.566	9.935	90-09-00	180-09-00	-0.026	1768.222716	
68-2-47	41615.062	-67998.631	13.970	356-52-53	86-43-53	13.923	-946744.939413	
68-2-4	41629.011	-67999.391	3.993	313-21-59	136-29-06	16.691	-1134977.835181	
68-2-3	41631.753	-68002.294	6.506	270-08-59	136-47-00	2.759	-187618.329146	
							倍面積	
							面積	158.6616330




# 面積計算書（座標法）

世界測地系（測地成果2011）

所 在	地 番	公簿地目	現況地目	地 積	所 有 者
前橋市六供町二丁目	68-2-8			187.18 m <sup>2</sup>	

点 名	X 座標	Y 座標	辺 長	方 向 角	測 角	DX	倍 積 (Y×DX)
68-2-50	41615.088	-68008.566	18.298	180-09-57	90-00-57	-18.272	1242652.517952
68-2-48	41596.790	-68008.619	8.071	90-11-30	90-01-33	-18.325	1246257.943175
68-2-6	41596.763	-68000.548	4.000	43-30-39	133-19-09	2.874	-195433.574952
68-2-5	41599.664	-67997.794	15.421	356-53-19	133-22-40	18.299	-1244291.632406
68-2-47	41615.062	-67998.631	9.935	270-09-00	93-15-41	15.424	-1048810.884544
倍面積							374.369225
面 積							187.1846125

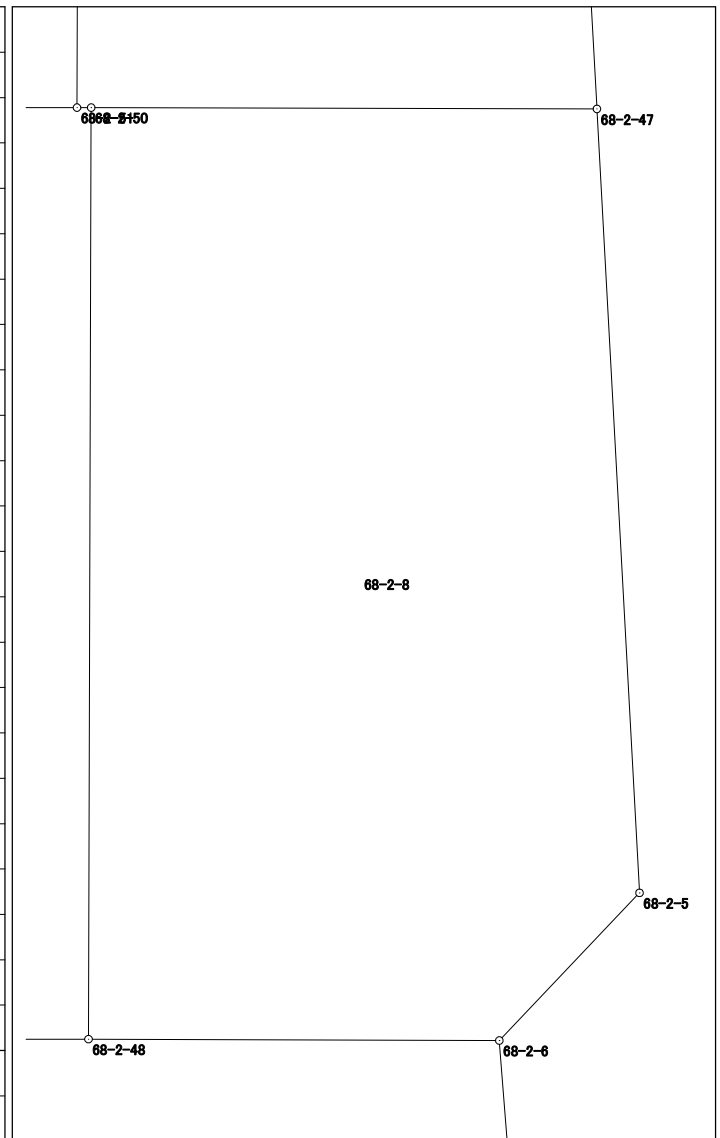


## 面積計算書（座標法）

世界測地系（測地成果2011）

所 在	地 番	公簿地目	現況地目	地 積	所 有 者
前橋市六供町二丁目	68-2-9-1			132.56 m <sup>2</sup>	

点 名	X 座 標	Y 座 標	辺 長	方 向 角	測 角	DX	倍 積 (Y×DX)
68-2-52	41615.119	-68018.812	18.311	180-09-46	89-55-31	-18.281	1243451.902172
68-2-49	41596.808	-68018.864	7.244	90-09-01	89-59-15	-18.330	1246785.777120
68-2-58	41596.789	-68011.620	18.300	0-08-50	89-59-49	18.281	-1243320.425220
68-2-57	41615.089	-68011.573	7.239	270-14-15	90-05-25	18.330	-1246652.133090

倍面積	265.120982
面 積	132.5604910

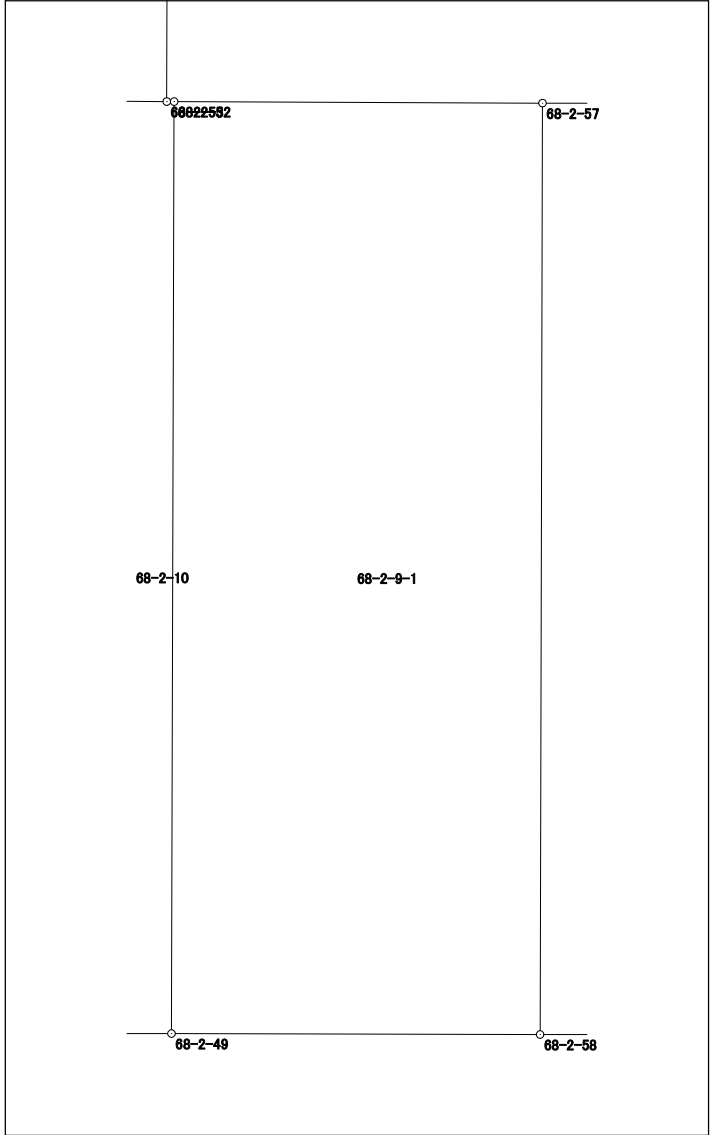


# 面積計算書（座標法）

世界測地系（測地成果2011）

所 在	地 番	公簿地目	現況地目	地 積	所 有 者
前橋市六供町二丁目	68-2-9-2			54.97 m <sup>2</sup>	

点 名	X 座標	Y 座標	辺 長	方 向 角	測 角	DX	倍 積 (Y×DX)
68-2-57	41615.089	-68011.573	18.300	180-08-50	90-07-34	-18.299	1244543.774327
68-2-58	41596.789	-68011.620	3.001	89-58-51	89-50-01	-18.299	1244544.634380
68-2-48	41596.790	-68008.619	18.298	0-09-57	90-11-06	18.299	-1244489.719081
68-2-50	41615.088	-68008.566	0.279	270-00-00	89-50-03	18.298	-1244420.740668
68-2-51	41615.088	-68008.845	2.728	270-01-16	180-01-16	0.001	-68.008845
倍面積							109.940113
面 積							54.9700565

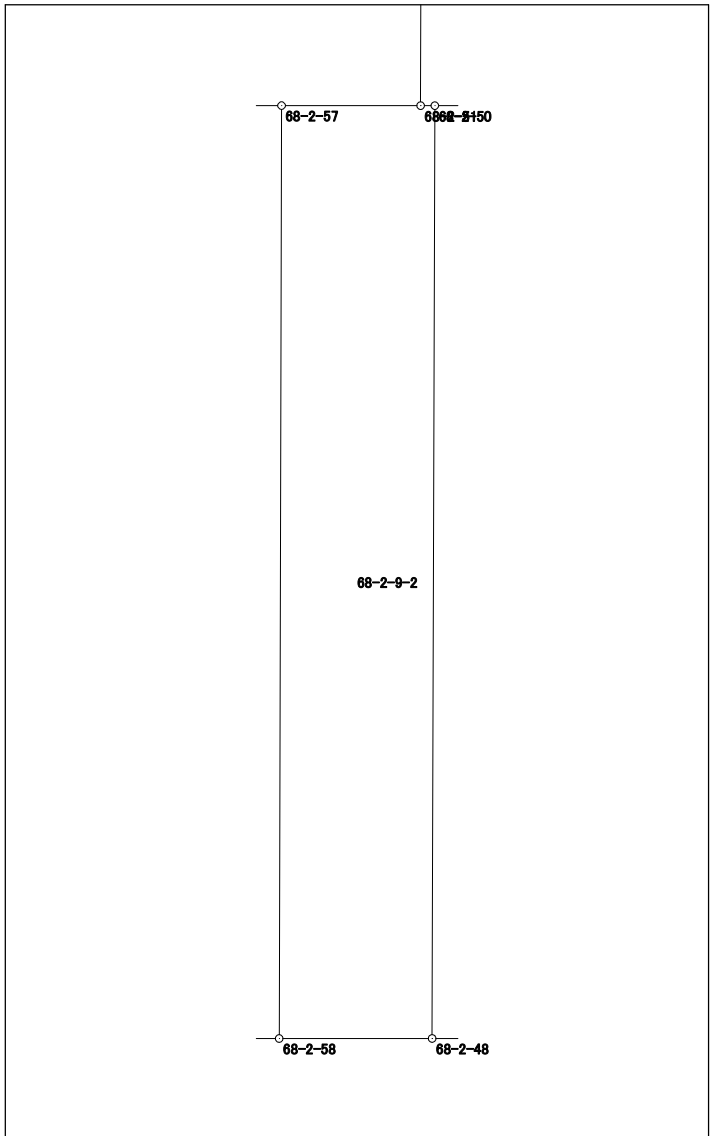


# 面積計算書 (座標法)

世界測地系 (測地成果2011)

所在	地番	公簿地目	現況地目	地積	所有者
前橋市六供町二丁目	68-2-10			26.65 m <sup>2</sup>	

点名	X 座標	Y 座標	辺長	方向角	測角	DX	倍積 (Y×DX)
68-2-114	41615.124	-68020.269	18.314	180-09-12	89-58-43	-18.310	1245451.125390
68-2-113	41596.810	-68020.318	1.454	90-04-44	89-55-32	-18.316	1245860.144488
68-2-49	41596.808	-68018.864	18.311	0-09-46	90-05-02	18.309	-1245357.380976
68-2-52	41615.119	-68018.812	0.145	270-23-42	90-13-56	18.312	-1245560.485344
68-2-53	41615.120	-68018.957	1.312	270-10-29	179-46-47	0.005	-340.094785
						倍面積	53.308773
						面積	26.6543865

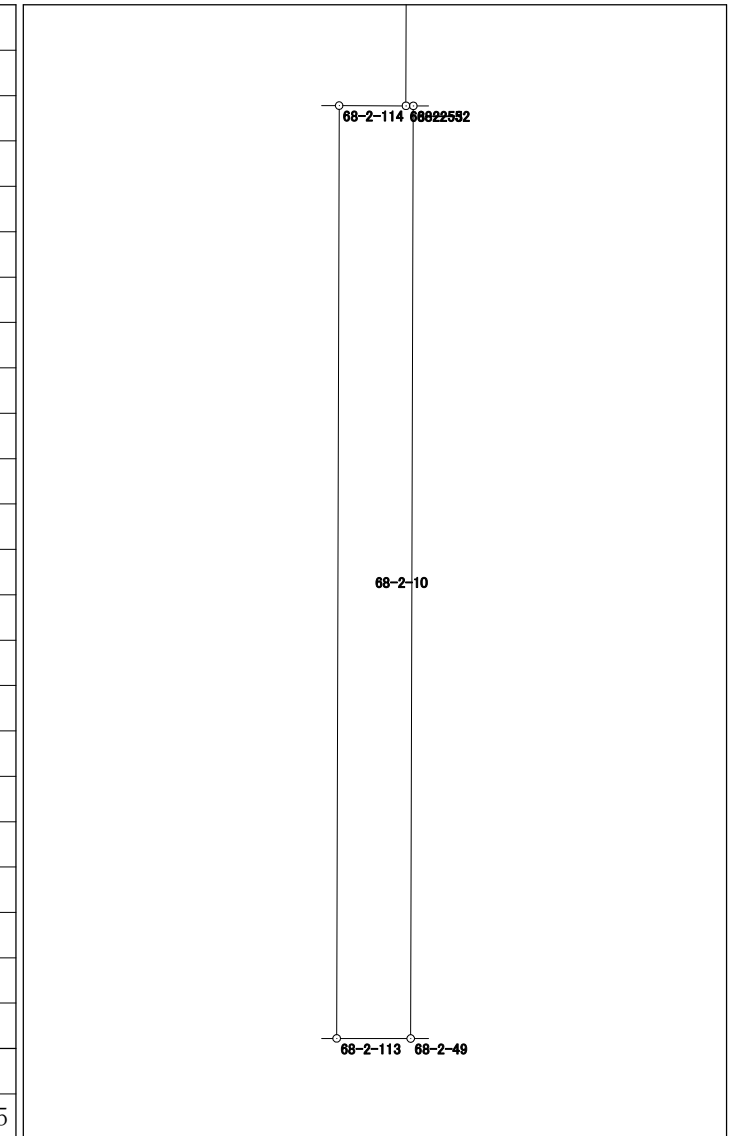




# 面積計算書（座標法）

世界測地系（測地成果2011）

所 在	地 番	公簿地目	現況地目	地 積	所 有 者
前橋市六供町二丁目	68-2-保-2			161.00 m <sup>2</sup>	

点 名	X 座標	Y 座標	辺 長	方 向 角	測 角	DX	倍 積 (Y×DX)
68-2-54	41615.136	-68029.061	18.317	180-07-53	90-21-15	-18.324	1246564.513764
68-2-37	41596.819	-68029.103	8.785	90-03-31	89-55-38	-18.326	1246701.341578
68-2-113	41596.810	-68020.318	18.314	0-09-12	90-05-41	18.305	-1245111.920990
68-2-114	41615.124	-68020.269	6.991	270-09-21	90-00-09	18.333	-1247015.591577
68-2-55	41615.143	-68027.260	1.801	269-46-38	179-37-17	0.012	-816.327120
						倍面積	322.015655
						面 積	161.0078275

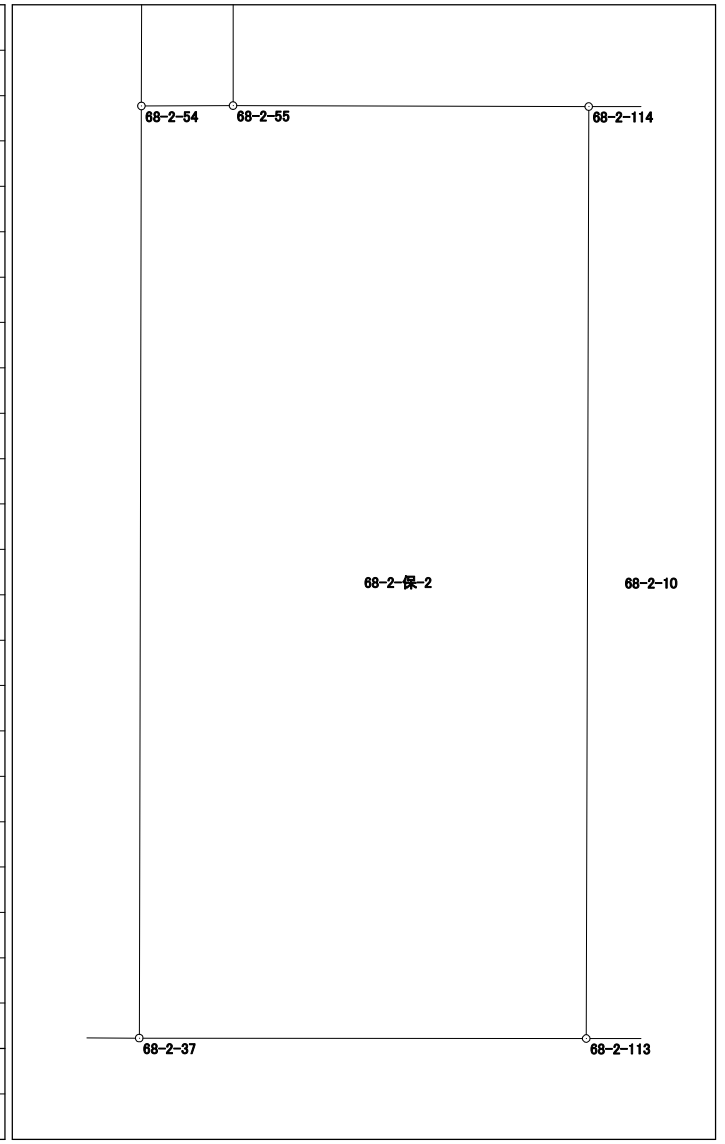


# 面積計算書 (座標法)

世界測地系 (測地成果2011)

所在	地番	公簿地目	現況地目	地積	所有者
前橋市六供町二丁目	68-2-保-3			53.00 m <sup>2</sup>	

点名	X座標	Y座標	辺長	方向角	測角	DX	倍積 (Y×DX)
68-2-37	41596.819	-68029.103	18.317	0-07-53	90-00-20	18.312	-1245748.934136
68-2-54	41615.136	-68029.061	5.006	0-11-40	180-03-47	23.323	-1586641.789703
68-2-56	41620.142	-68029.044	2.274	270-12-06	90-00-26	5.014	-341097.626616
68-2-101	41620.150	-68031.318	23.326	180-08-51	89-56-45	-23.318	1586354.273124
68-2-102	41596.824	-68031.378	2.275	90-07-33	89-58-42	-23.331	1587240.080118
						倍面積	106.002787
						面積	53.0013935

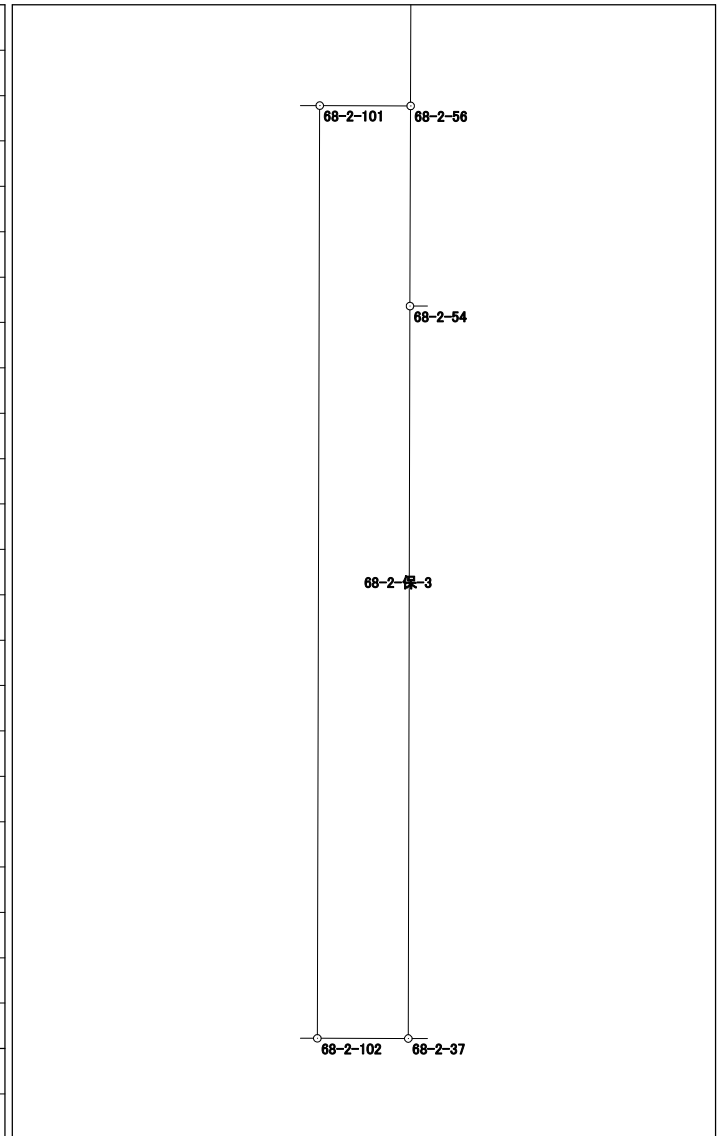


# 面積計算書（座標法）

世界測地系（測地成果2011）

所在	地番	公簿地目	現況地目	地積	所有者
前橋市六供町二丁目	68-2-保-4			54.00 m <sup>2</sup>	

点名	X座標	Y座標	辺長	方向角	測角	DX	倍積 (Y×DX)
68-2-103	41620.171	-68038.739	9.396	270-10-15	90-01-17	5.776	-392991.756464
68-2-43	41620.199	-68048.135	5.747	180-08-22	89-58-07	-5.719	389167.284065
68-2-105	41614.452	-68048.149	9.395	90-10-37	90-02-15	-5.776	393046.108624
68-2-106	41614.423	-68038.754	5.748	0-08-58	89-58-21	5.719	-389113.634126

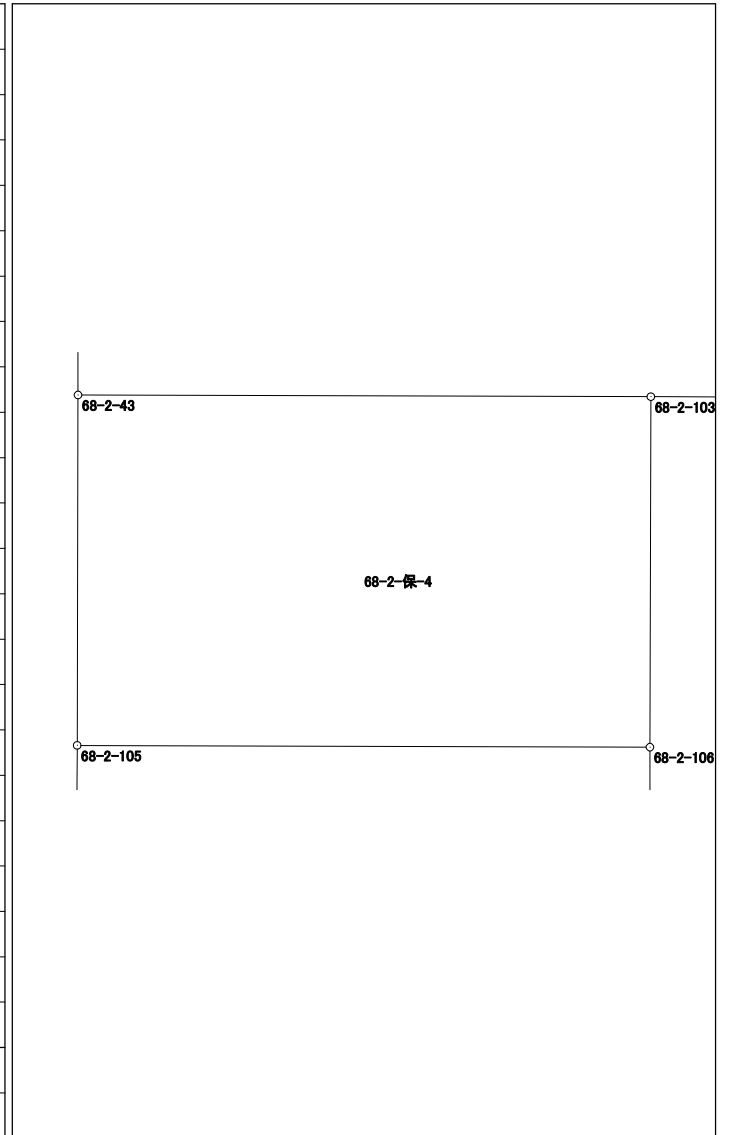

倍面積	108.002099
面積	54.0010495