



- 6-1 街区
- 6-2 街区
- 6-3 街区

# 画地出来形確認図

- (1327.76m<sup>2</sup>)
- (507.07m<sup>2</sup>)
- (1354.79m<sup>2</sup>)

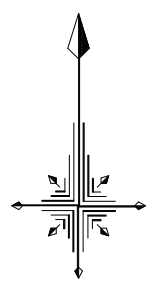

S=1/500

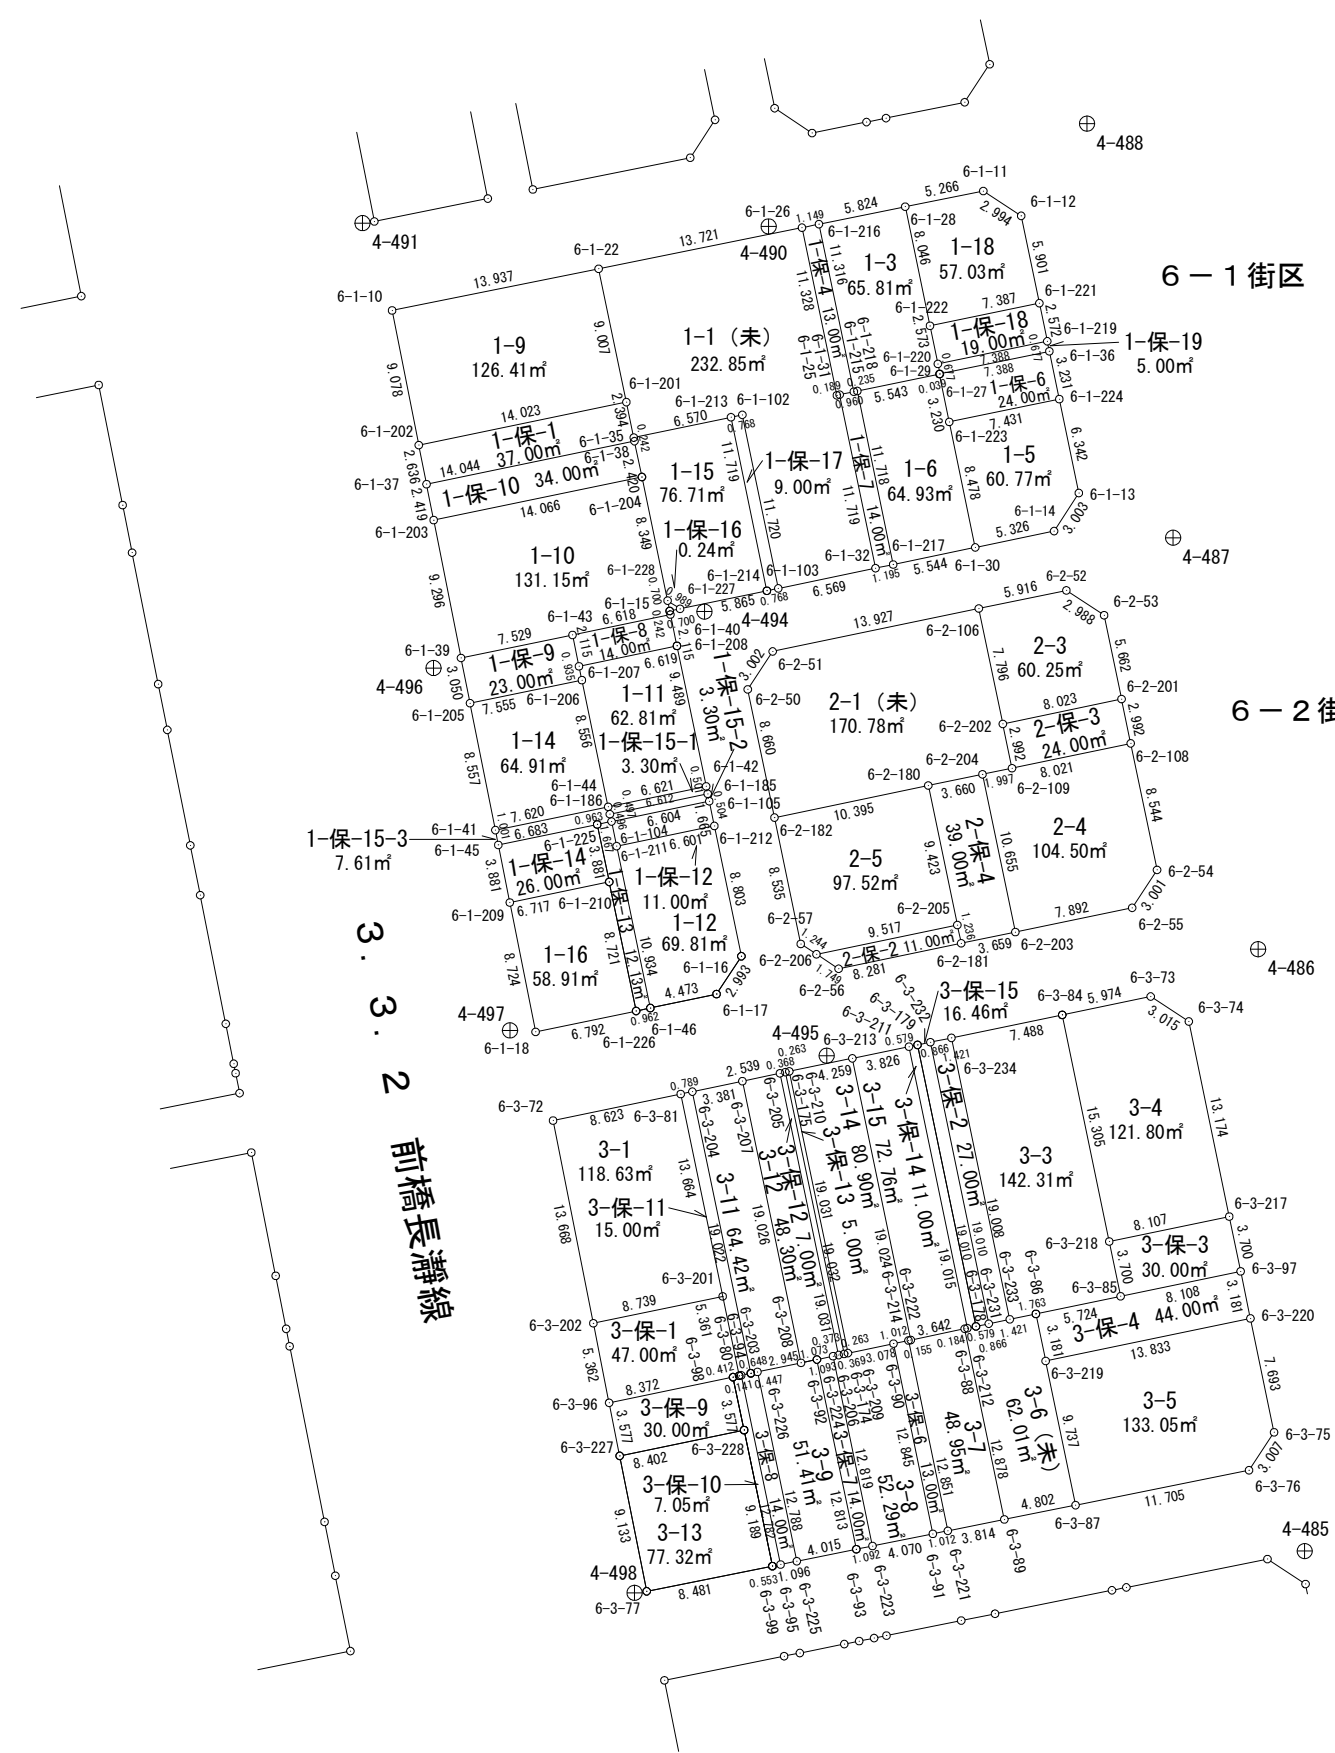


# 面積計算書（座標法）

世界測地系（測地成果2011）

所在	地番	公簿地目	現況地目	地積	所有者
前橋市六供町一丁目	6-1-1（未）			232.85 m <sup>2</sup>	

点名	X座標	Y座標	辺長	方向角	測角	DX	倍積 (Y×DX)
6-1-22	41859.130	-68427.383	9.007	168-14-18	89-40-37	-11.539	789583.572437
6-1-201	41850.312	-68425.547	2.394	168-14-22	180-00-04	-11.162	763765.955614
6-1-35	41847.968	-68425.059	6.570	78-10-43	89-56-21	-0.998	68288.208882
6-1-213	41849.314	-68418.628	0.768	78-12-27	180-01-44	1.503	-102833.197884
6-1-102	41849.471	-68417.876	11.720	168-18-31	270-06-04	-11.320	774490.356320
6-1-103	41837.994	-68415.501	6.569	78-15-26	89-56-55	-10.140	693733.180140
6-1-32	41839.331	-68409.069	11.719	348-19-19	90-03-53	12.813	-876525.401097
6-1-31	41850.807	-68411.441	0.189	255-53-24	87-34-05	11.430	-781942.770630
6-1-25	41850.761	-68411.624	11.328	348-13-44	272-20-20	11.044	-755537.975456
6-1-26	41861.851	-68413.935	13.721	258-33-41	90-19-57	8.369	-572556.222015

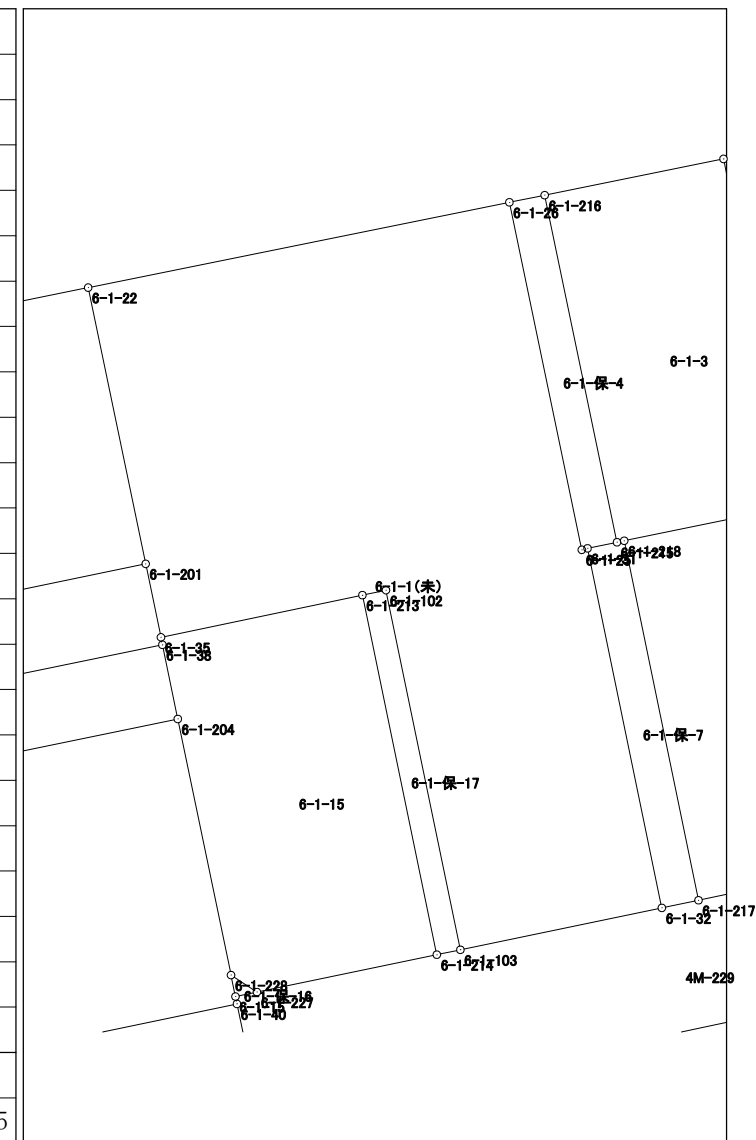


倍面積	465.706311
面積	232.8531555

# 面積計算書（座標法）

世界測地系（測地成果2011）

所 在	地 番	公簿地目	現況地目	地 積	所 有 者
前橋市六供町一丁目	6-1-3			65.81 m <sup>2</sup>	

点 名	X 座標	Y 座標	辺 長	方 向 角	測 角	DX	倍 積 (Y×DX)
6-1-215	41851.001	-68410.501	0.235	78-12-43	89-58-50	-11.030	754567.826030
6-1-218	41851.049	-68410.271	5.543	78-20-36	180-07-53	1.168	-79903.196528
6-1-29	41852.169	-68404.842	0.039	76-40-32	178-19-56	1.129	-77229.066618
6-1-27	41852.178	-68404.804	0.677	348-14-31	91-33-59	0.672	-45968.028288
6-1-220	41852.841	-68404.942	2.573	348-16-15	180-01-44	3.182	-217664.525444
6-1-222	41855.360	-68405.465	8.046	348-16-06	179-59-51	10.397	-711211.619605
6-1-28	41863.238	-68407.101	5.824	258-31-20	90-15-14	6.719	-459627.311619
6-1-216	41862.079	-68412.809	11.316	168-13-53	89-42-33	-12.237	837167.543733
倍面積						131.621661	
面 積						65.8108305	

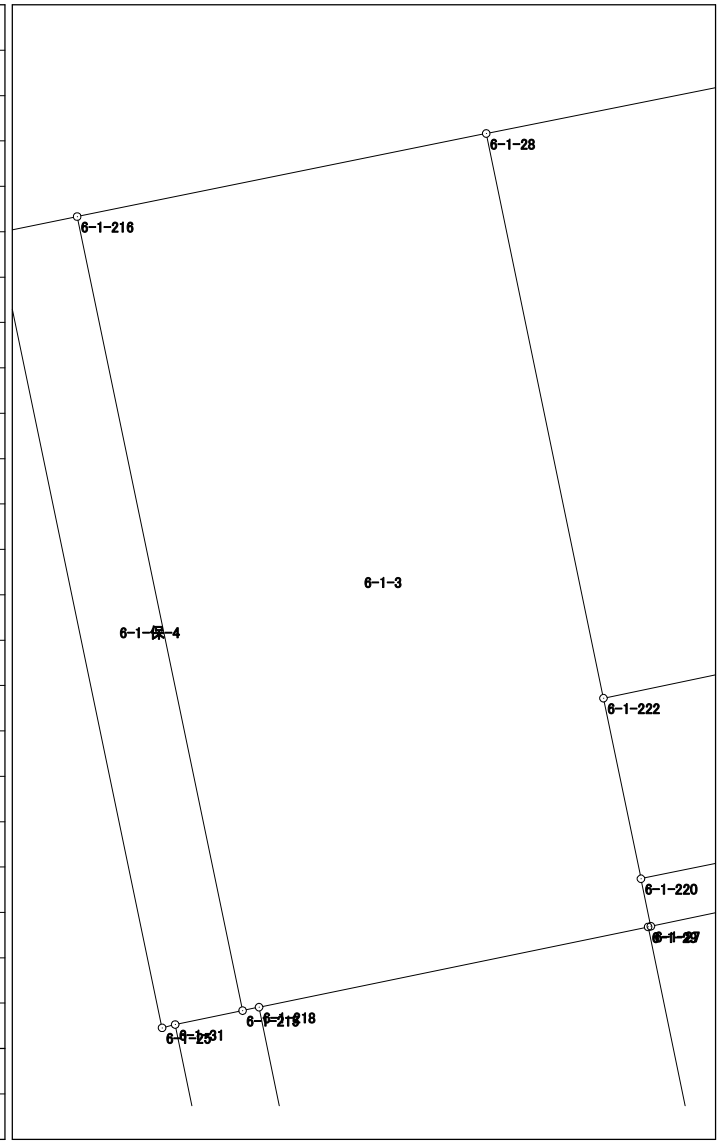






## 面積計算書（座標法）

世界測地系（測地成果2011）

所在	地番	公簿地目	現況地目	地積	所有者
前橋市六供町一丁目	6-1-9			126.41 m <sup>2</sup>	

点名	X座標	Y座標	辺長	方向角	測角	D <sub>X</sub>	倍積 (Y×DX)
6-1-201	41850.312	-68425.547	9.007	348-14-18	89-55-53	11.660	-797841.878020
6-1-22	41859.130	-68427.383	13.937	258-35-56	90-21-38	6.063	-414875.223129
6-1-10	41856.375	-68441.045	9.078	168-46-58	90-11-02	-11.660	798022.584700
6-1-202	41847.470	-68439.279	14.023	78-18-25	89-31-27	-6.063	414947.348577

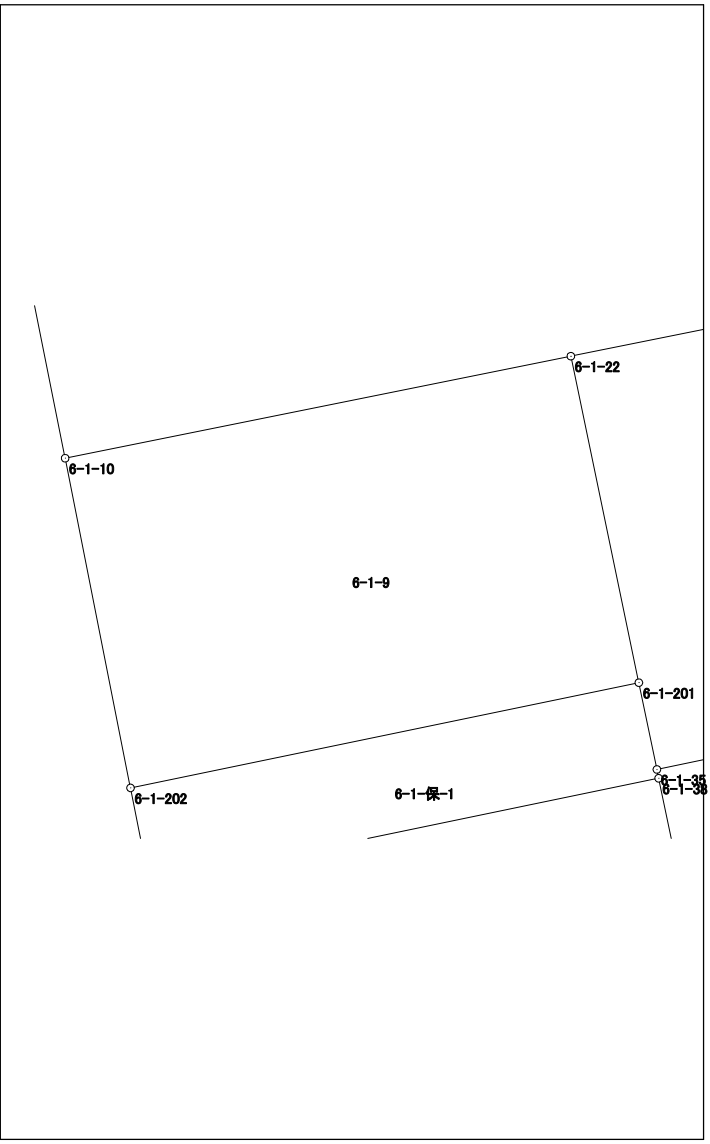


倍面積	252.832128
面積	126.4160640

# 面積計算書（座標法）

世界測地系（測地成果2011）

所在	地番	公簿地目	現況地目	地積	所有者
前橋市六供町一丁目	6-1-10			131.15 m <sup>2</sup>	

点名	X座標	Y座標	辺長	方向角	測角	DX	倍積 (Y×DX)
6-1-203	41842.511	-68438.295	9.296	168-46-42	90-28-07	-11.968	819069.514560
6-1-39	41833.393	-68436.486	7.529	78-20-43	89-34-01	-7.597	519911.984142
6-1-43	41834.914	-68429.112	6.618	78-13-17	179-52-34	2.872	-196528.409664
6-1-40	41836.265	-68422.633	0.242	348-46-59	90-33-42	1.588	-108655.141204
6-1-15	41836.502	-68422.680	0.700	348-17-19	179-30-20	0.922	-63085.710960
6-1-228	41837.187	-68422.822	8.349	348-15-29	179-58-10	8.859	-606157.780098
6-1-204	41845.361	-68424.521	14.066	258-18-35	90-03-06	5.324	-364292.149804

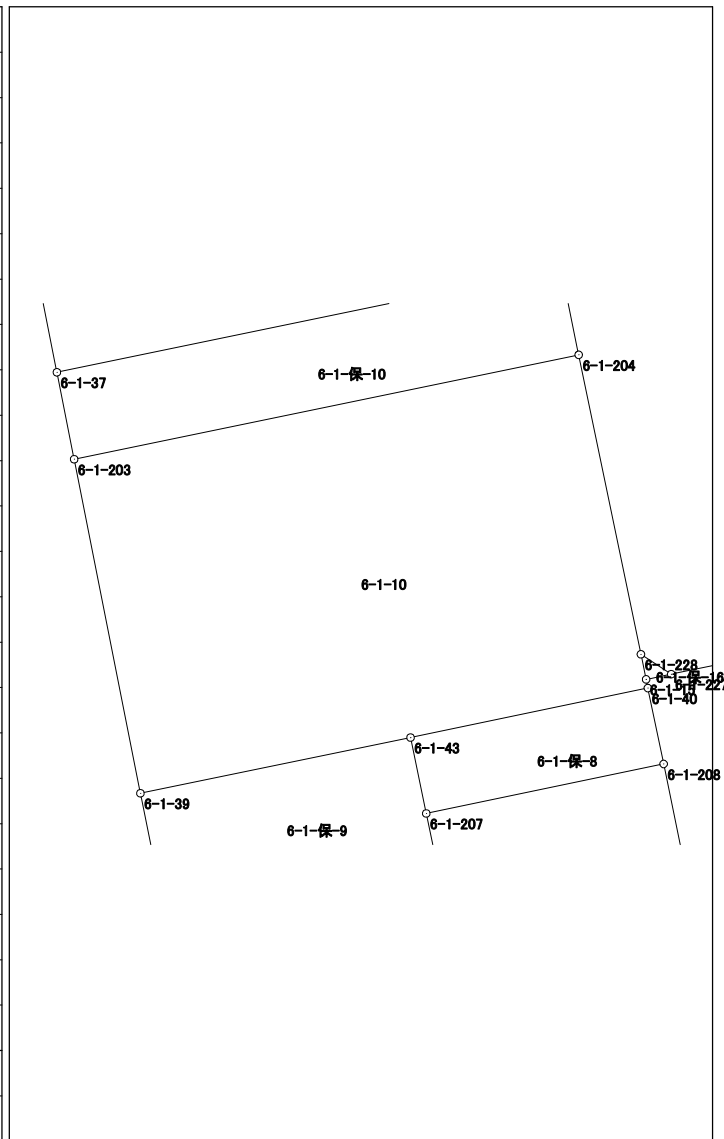


# 面積計算書（座標法）

世界測地系（測地成果2011）

所 在	地 番	公簿地目	現況地目	地 積	所 有 者
前橋市六供町一丁目	6-1-11			62.81 m <sup>2</sup>	

点 名	X 座標	Y 座標	辺 長	方 向 角	測 角	D	DX	倍 積 (Y×DX)
6-1-207	41832.843	-68428.682	0.935	168-08-57	89-55-33	-2.266		155059.393412
6-1-206	41831.928	-68428.490	8.556	168-16-21	180-07-24	-9.292		635837.529080
6-1-44	41823.551	-68426.751	6.621	78-12-29	89-56-08	-7.024		480629.499024
6-1-42	41824.904	-68420.270	9.489	348-15-07	90-02-38	10.643		-728196.933610
6-1-208	41834.194	-68422.202	6.619	258-13-24	89-58-17	7.939		-543203.861678

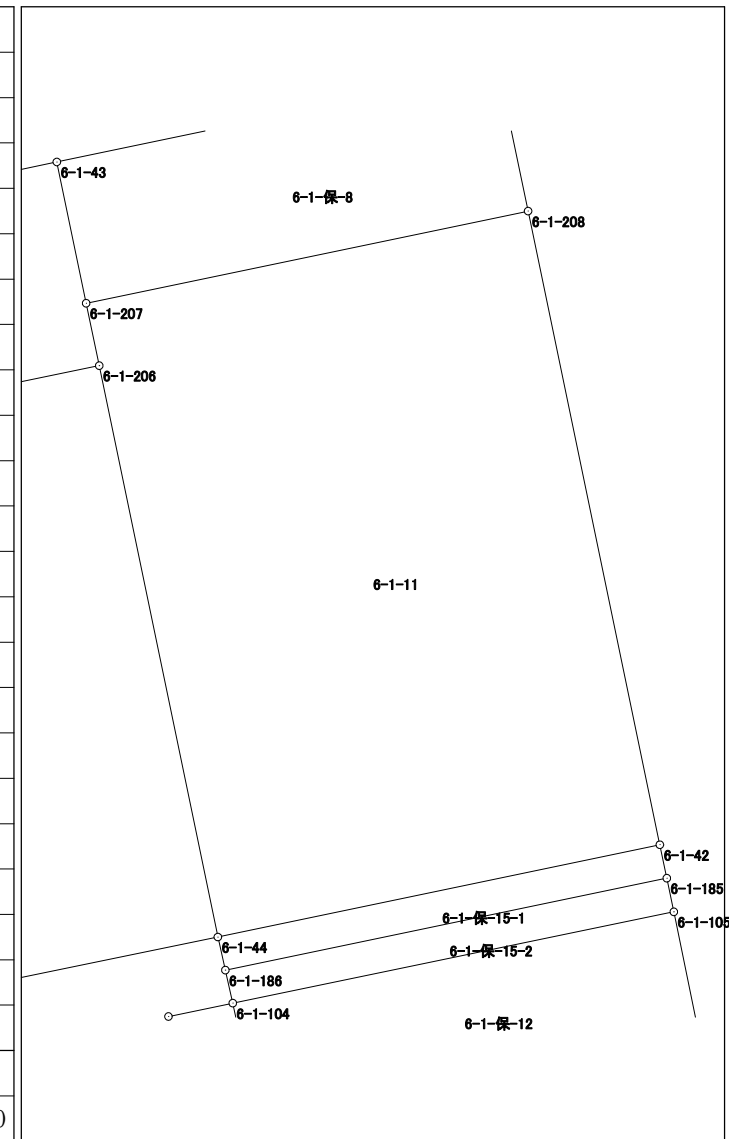

倍面積	125.626228
面 積	62.8131140



## 面積計算書 (座標法)

世界測地系 (測地成果2011)

所 在	地 番	公簿地目	現況地目	地 積	所 有 者
前橋市六供町一丁目	6-1-12			69.81 m <sup>2</sup>	


点 名	X 座標	Y 座標	辺 長	方 向 角	測 角	DX	倍 積 (Y×DX)	
6-1-211	41820.950	-68426.192	10.934	168-13-36	89-56-18	-12.044	824125.056448	
6-1-46	41810.246	-68423.961	4.473	78-05-32	89-51-56	-9.781	669254.762541	
6-1-17	41811.169	-68419.584	2.993	33-19-06	135-13-34	3.424	-234268.655616	
6-1-16	41813.670	-68417.940	8.803	348-16-54	134-57-48	11.121	-760875.910740	
6-1-212	41822.290	-68419.728	6.601	258-17-18	90-00-24	7.280	-498095.619840	
							倍面積	139.632793
							面 積	69.8163965

# 面積計算書（座標法）

世界測地系（測地成果2011）

所 在	地 番	公簿地目	現況地目	地 積	所 有 者
前橋市六供町一丁目	6-1-14			64.91 m <sup>2</sup>	


点 名	X 座標	Y 座標	辺 長	方 向 角	測 角	DX	倍 積 (Y×DX)
6-1-205	41830.402	-68435.889	8.557	168-42-40	90-21-53	-9.917	678678.711213
6-1-41	41822.011	-68434.214	7.620	78-20-26	89-37-46	-6.851	468842.800114
6-1-44	41823.551	-68426.751	8.556	348-16-21	89-55-55	9.917	-678588.089667
6-1-206	41831.928	-68428.490	7.555	258-20-47	90-04-26	6.851	-468803.584990
						倍面積	129.836670
						面 積	64.9183350

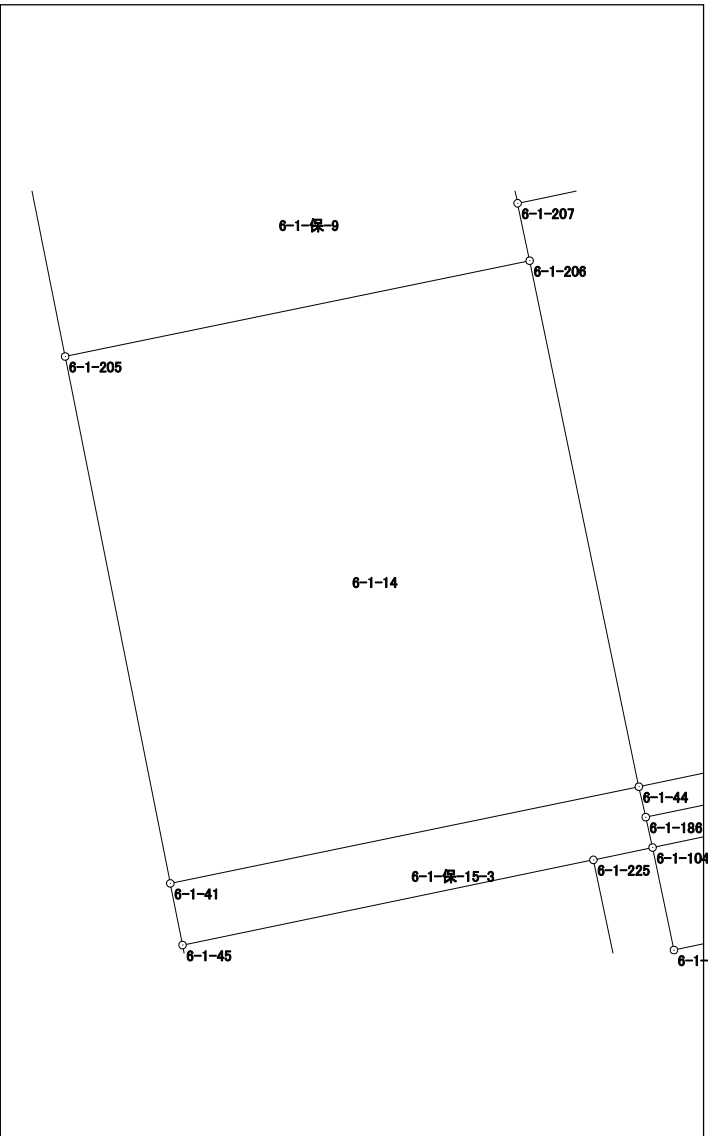

# 面積計算書 (座標法)

所在	地番	公簿地目	現況地目	地積	所有者
前橋市六供町一丁目	6-1-15			76.71 m <sup>2</sup>	

点名	X座標	Y座標	辺長	方向角	測角	DX	倍積 (Y×DX)
6-1-213	41849.314	-68418.628	6.570	258-10-43	89-52-16	10.130	-693080.701640
6-1-35	41847.968	-68425.059	0.242	169-03-39	90-52-56	-1.584	108385.293456
6-1-38	41847.730	-68425.013	2.420	168-16-03	179-12-24	-2.607	178384.008891
6-1-204	41845.361	-68424.521	8.349	168-15-29	179-59-26	-10.543	721399.724903
6-1-228	41837.187	-68422.822	0.989	123-17-19	135-01-50	-8.717	596441.739374
6-1-227	41836.644	-68421.995	5.865	78-15-12	134-57-53	0.651	-44542.718745
6-1-214	41837.838	-68416.253	11.719	348-18-27	90-03-15	12.670	-866833.925510

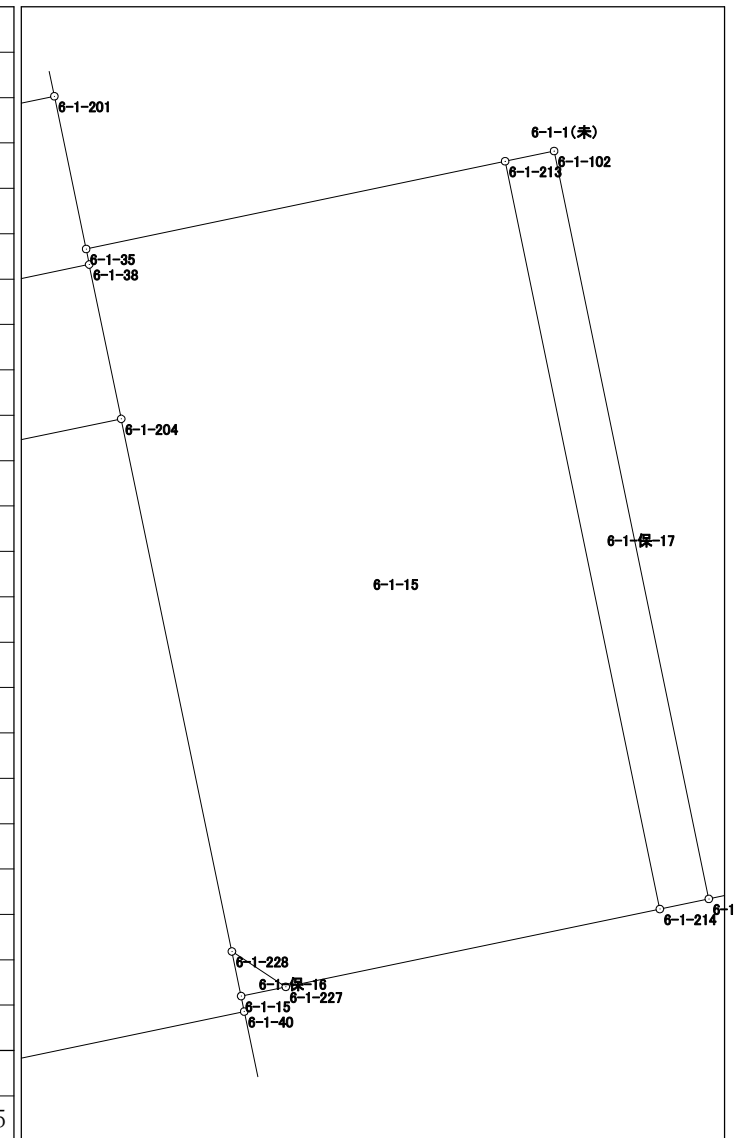

倍面積	153.420729
面積	76.7103645

# 面積計算書（座標法）

世界測地系（測地成果2011）

所在	地番	公簿地目	現況地目	地積	所有者
前橋市六供町一丁目	6-1-16			58.91 m <sup>2</sup>	

点名	X座標	Y座標	辺長	方向角	測角	DX	倍積 (Y×DX)
6-1-209	41817.223	-68433.260	8.724	168-42-57	90-25-56	-9.919	678789.505940
6-1-18	41808.668	-68431.553	6.792	78-15-36	89-32-39	-7.173	490859.529669
6-1-226	41810.050	-68424.903	8.721	348-13-20	89-57-44	9.919	-678706.612857
6-1-210	41818.587	-68426.683	6.717	258-17-01	90-03-41	7.173	-490824.597159
倍面積							117.825593
面積							58.9127965

6-1-210

6-1-209

6-1-13

6-1-16

6-1-226


6-1-18

# 面積計算書 (座標法)

世界測地系 (測地成果2011)

所在	地番	公簿地目	現況地目	地積	所有者
前橋市六供町一丁目	6-1-18			57.03 m <sup>2</sup>	


点名	X座標	Y座標	辺長	方向角	測角	DX	倍積 (Y×DX)
6-1-221	41856.855	-68398.231	5.901	348-14-47	89-55-23	7.272	-497391.935832
6-1-12	41862.632	-68399.433	2.994	303-12-45	134-57-58	7.417	-507318.594561
6-1-11	41864.272	-68401.938	5.266	258-40-30	135-27-45	0.606	-41451.574428
6-1-28	41863.238	-68407.101	8.046	168-16-06	89-35-36	-8.912	609644.084112
6-1-222	41855.360	-68405.465	7.387	78-19-24	90-03-18	-6.383	436632.083095
						倍面積	114.062386
						面積	57.0311930

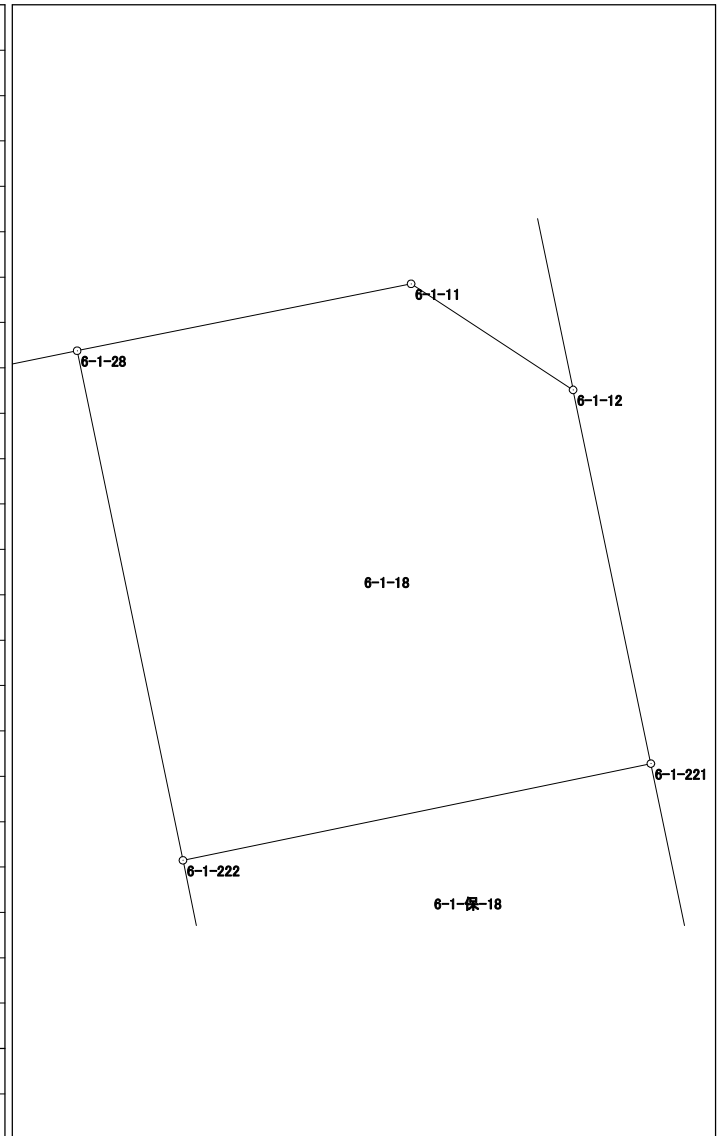

# 面積計算書 (座標法)

所在	地番	公簿地目	現況地目	地積	所有者
前橋市六供町一丁目	6-1-保-1			37.00 m <sup>2</sup>	

点名	X座標	Y座標	辺長	方向角	測角	DX	倍積 (Y×DX)
6-1-37	41844.884	-68438.766	14.044	78-18-30	89-31-44	0.260	-17794.079160
6-1-38	41847.730	-68425.013	0.242	349-03-39	90-45-09	3.084	-211022.740092
6-1-35	41847.968	-68425.059	2.394	348-14-22	179-10-43	2.582	-176673.502338
6-1-201	41850.312	-68425.547	14.023	258-18-25	90-04-03	-0.498	34075.922406
6-1-202	41847.470	-68439.279	2.636	168-46-46	90-28-21	-5.428	371488.406412
						倍面積	74.007228
						面積	37.0036140

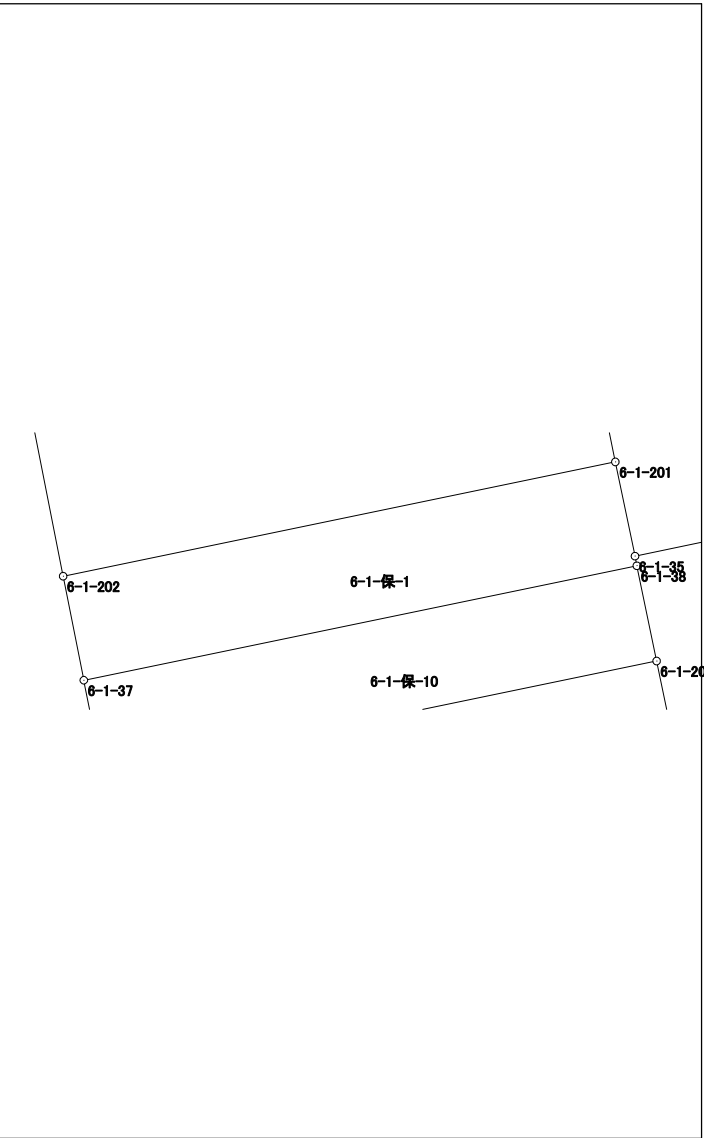


## 面積計算書 (座標法)

世界測地系 (測地成果2011)

所在	地番	公簿地目	現況地目	地積	所有者
前橋市六供町一丁目	6-1-保-4			13.00 m <sup>2</sup>	

点名	X座標	Y座標	辺長	方向角	測角	DX	倍積 (Y×DX)
6-1-25	41850.761	-68411.624	0.189	75-53-24	87-39-40	-11.044	755537.975456
6-1-31	41850.807	-68411.441	0.960	78-20-20	182-26-56	0.240	-16418.745840
6-1-215	41851.001	-68410.501	11.316	348-13-53	89-53-33	11.272	-771123.167272
6-1-216	41862.079	-68412.809	1.149	258-33-11	90-19-18	10.850	-742278.977650
6-1-26	41861.851	-68413.935	11.328	168-13-44	89-40-33	-11.318	774308.916330
						倍面積	26.001024
						面積	13.0005120

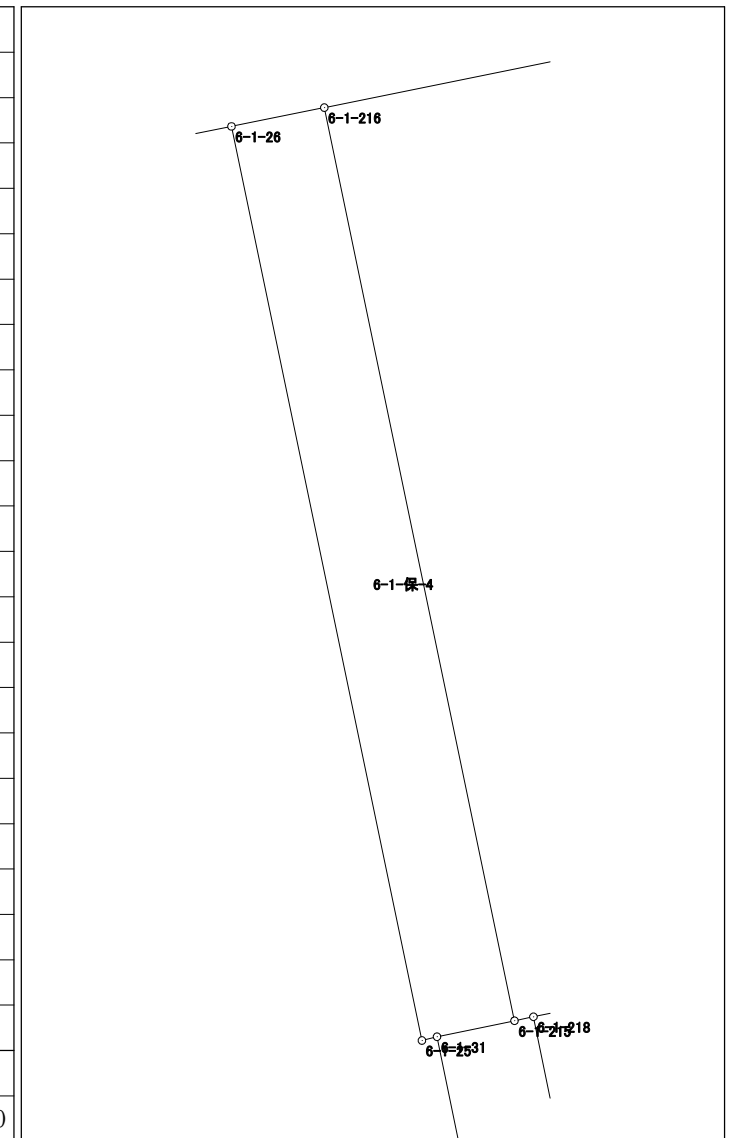


# 面積計算書（座標法）

世界測地系（測地成果2011）

所在	地番	公簿地目	現況地目	地積	所有者
前橋市六供町一丁目	6-1-保-6			24.00 m <sup>2</sup>	

点名	X座標	Y座標	辺長	方向角	測角	DX	倍積 (Y×DX)
6-1-36	41853.674	-68397.569	7.388	258-19-03	90-04-09	1.667	-114018.747523
6-1-27	41852.178	-68404.804	0.039	256-40-32	178-21-29	-1.505	102949.230020
6-1-29	41852.169	-68404.842	3.230	168-19-04	91-38-32	-3.172	216980.158824
6-1-223	41849.006	-68404.188	7.431	78-18-54	89-59-50	-1.658	113414.143704
6-1-224	41850.511	-68396.911	3.231	348-14-54	89-56-00	4.668	-319276.780548
						倍面積	48.004477
						面積	24.0022385

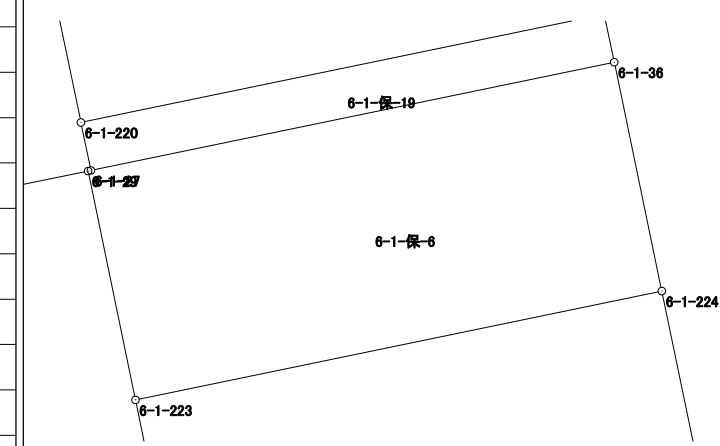






# 面積計算書（座標法）

世界測地系（測地成果2011）

所在	地番	公簿地目	現況地目	地積	所有者
前橋市六供町一丁目	6-1-保-8			14.00 m <sup>2</sup>	

点名	X座標	Y座標	辺長	方向角	測角	D <sub>X</sub>	倍積 (Y×D <sub>X</sub> )
6-1-43	41834.914	-68429.112	2.115	168-16-13	90-02-56	-3.422	234164.421264
6-1-207	41832.843	-68428.682	6.619	78-13-24	89-57-11	-0.720	49268.651040
6-1-208	41834.194	-68422.202	2.115	348-14-38	90-01-14	3.422	-234140.775244
6-1-40	41836.265	-68422.633	6.618	258-13-17	89-58-39	0.720	-49264.295760

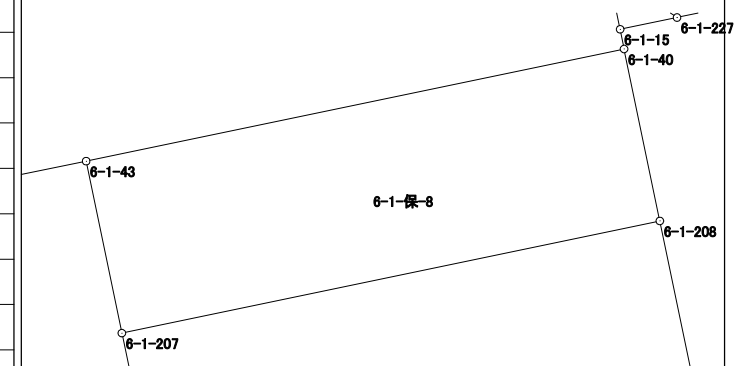

倍面積	28.001300
面積	14.0006500


# 面積計算書（座標法）

世界測地系（測地成果2011）

所在	地番	公簿地目	現況地目	地積	所有者
前橋市六供町一丁目	6-1-保-9			23.00 m <sup>2</sup>	

点名	X座標	Y座標	辺長	方向角	測角	DX	倍積 (Y×DX)
6-1-39	41833.393	-68436.486	3.050	168-42-44	90-22-01	-4.512	308785.424832
6-1-205	41830.402	-68435.889	7.555	78-20-47	89-38-03	-1.465	100258.577385
6-1-206	41831.928	-68428.490	0.935	348-08-57	89-48-10	2.441	-167033.944090
6-1-207	41832.843	-68428.682	2.115	348-16-13	180-07-16	2.986	-204328.044452
6-1-43	41834.914	-68429.112	7.529	258-20-43	90-04-30	0.550	-37636.011600

倍面積	46.002075
面積	23.0010375

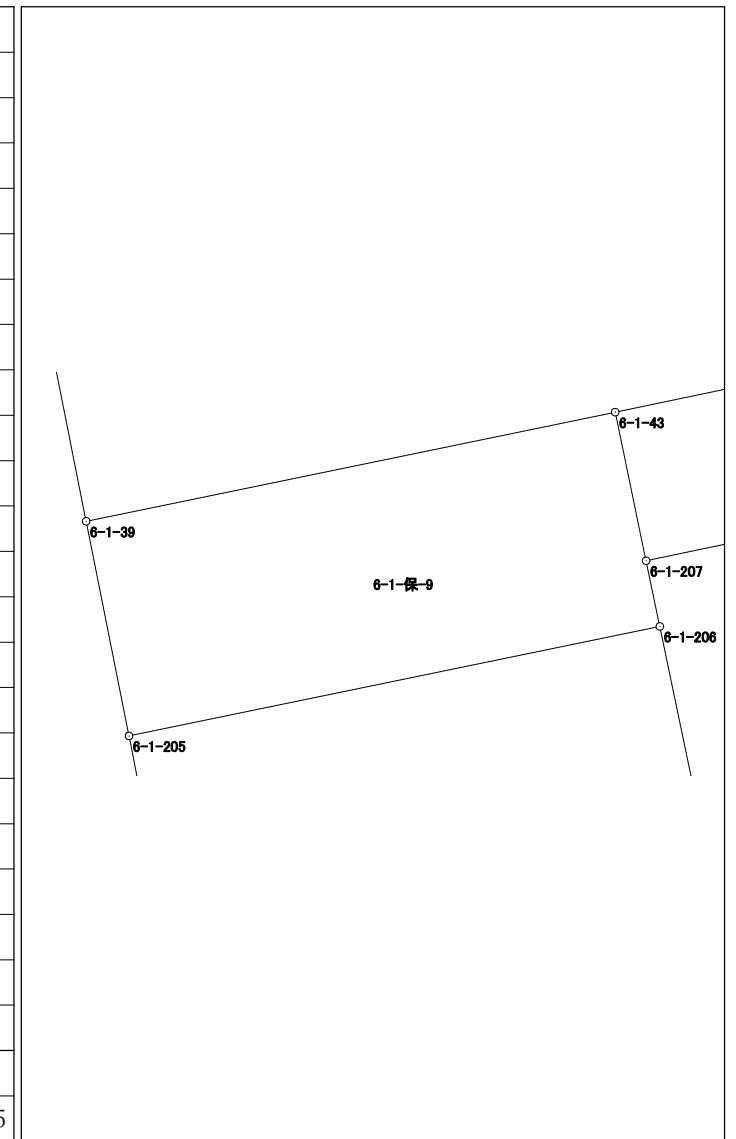


# 面積計算書 (座標法)

世界測地系 (測地成果2011)

所在	地番	公簿地目	現況地目	地積	所有者
前橋市六供町一丁目	6-1-保-10			34.00 m <sup>2</sup>	


点名	X座標	Y座標	辺長	方向角	測角	Dx	倍積 (Y×Dx)
6-1-37	41844.884	-68438.766	2.419	168-46-25	90-27-55	-5.219	357181.919754
6-1-203	41842.511	-68438.295	14.066	78-18-35	89-32-10	0.477	-32645.066715
6-1-204	41845.361	-68424.521	2.420	348-16-03	89-57-28	5.219	-357107.575099
6-1-38	41847.730	-68425.013	14.044	258-18-30	90-02-27	-0.477	32638.731201
						倍面積	68.009141
						面積	34.0045705

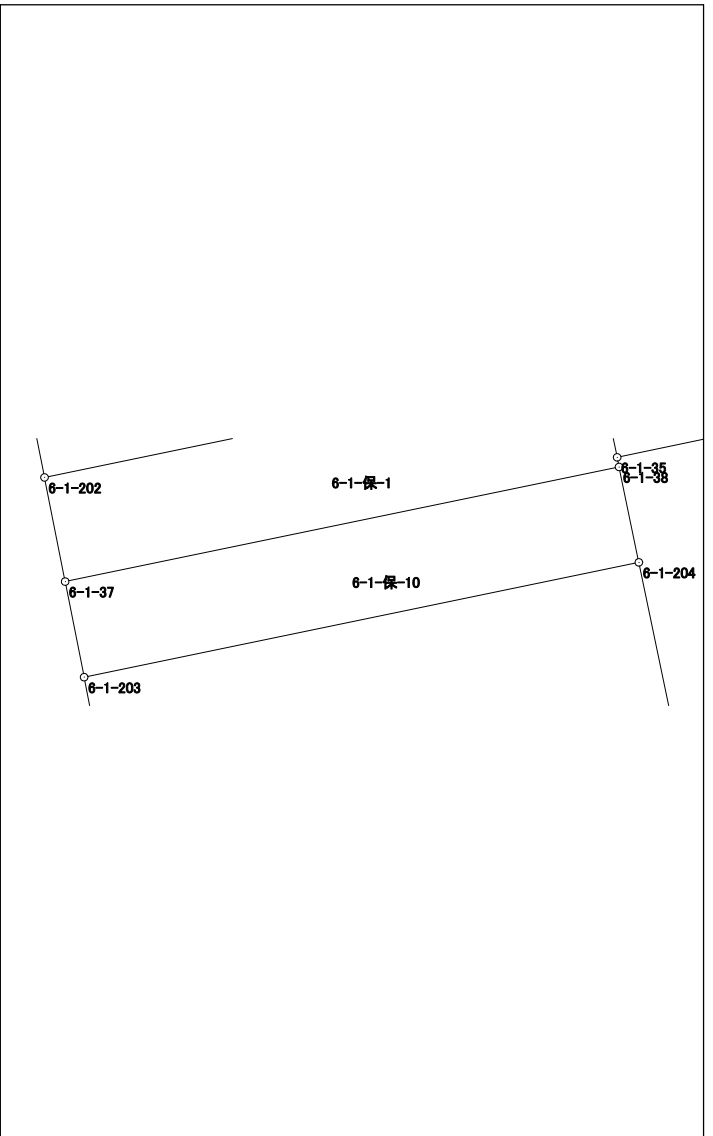

# 面積計算書 (座標法)

世界測地系 (測地成果2011)

所 在	地 番	公簿地目	現況地目	地 積	所 有 者
前橋市六供町一丁目	6-1-保-12			11.00 m <sup>2</sup>	

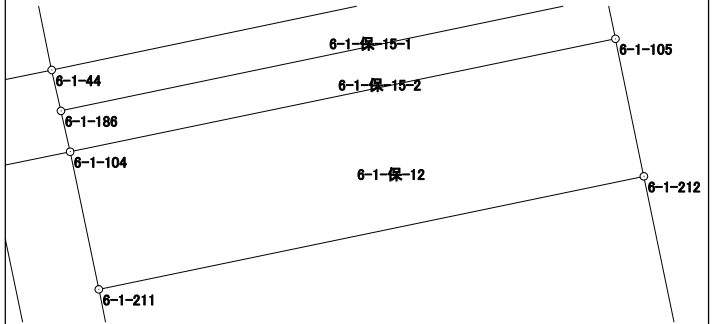点 名	X 座標	Y 座標	辺 長	方 向 角	測 角	DX	倍 積 (Y×DX)	
6-1-104	41822.582	-68426.532	1.667	168-13-54	89-55-46	-2.971	203295.226572	
6-1-211	41820.950	-68426.192	6.601	78-17-18	90-03-24	-0.292	19980.448064	
6-1-212	41822.290	-68419.728	1.665	348-19-33	90-02-15	2.971	-203275.011888	
6-1-105	41823.921	-68420.065	6.604	258-18-08	89-58-35	0.292	-19978.658980	
倍面積							22.003768	
面 積							11.0018840	




# 面積計算書 (座標法)

世界測地系 (測地成果2011)

所在	地番	公簿地目	現況地目	地積	所有者
前橋市六供町一丁目	6-1-保-14			26.00 m <sup>2</sup>	

点名	X座標	Y座標	辺長	方向角	測角	DX	倍積 (Y×DX)
6-1-225	41822.386	-68427.475	6.683	258-17-06	90-03-40	2.442	-167099.893950
6-1-45	41821.029	-68434.019	3.881	168-43-19	90-26-13	-5.163	353324.840097
6-1-209	41817.223	-68433.260	6.717	78-17-01	89-33-42	-2.442	167114.020920
6-1-210	41818.587	-68426.683	3.881	348-13-26	89-56-25	5.163	-353286.964329
						倍面積	52.002738
						面積	26.0013690

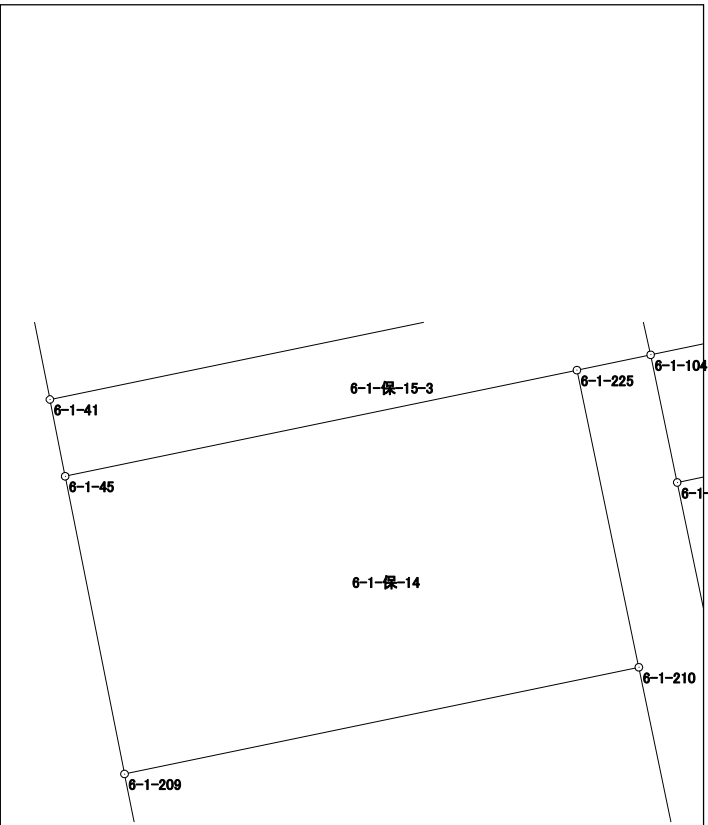






面積計算書 (座標法)

世界測地系 (測地成果2011)

所在	地番	公簿地目	現況地目	地積	所有者
前橋市六供町一丁目	6-1-保-15-2			3.30 m <sup>2</sup>	

点名	X座標	Y座標	辺長	方向角	測角	DX	倍積 (Y×DX)
6-1-186	41823.066	-68426.641	0.496	167-18-30	89-04-19	-1.832	125357.606312
6-1-104	41822.582	-68426.532	6.604	78-18-08	90-59-38	0.855	-58504.684860
6-1-105	41823.921	-68420.065	0.504	348-11-57	89-53-49	1.832	-125345.559080
6-1-185	41824.414	-68420.168	6.612	258-14-11	90-02-14	-0.855	58499.243640

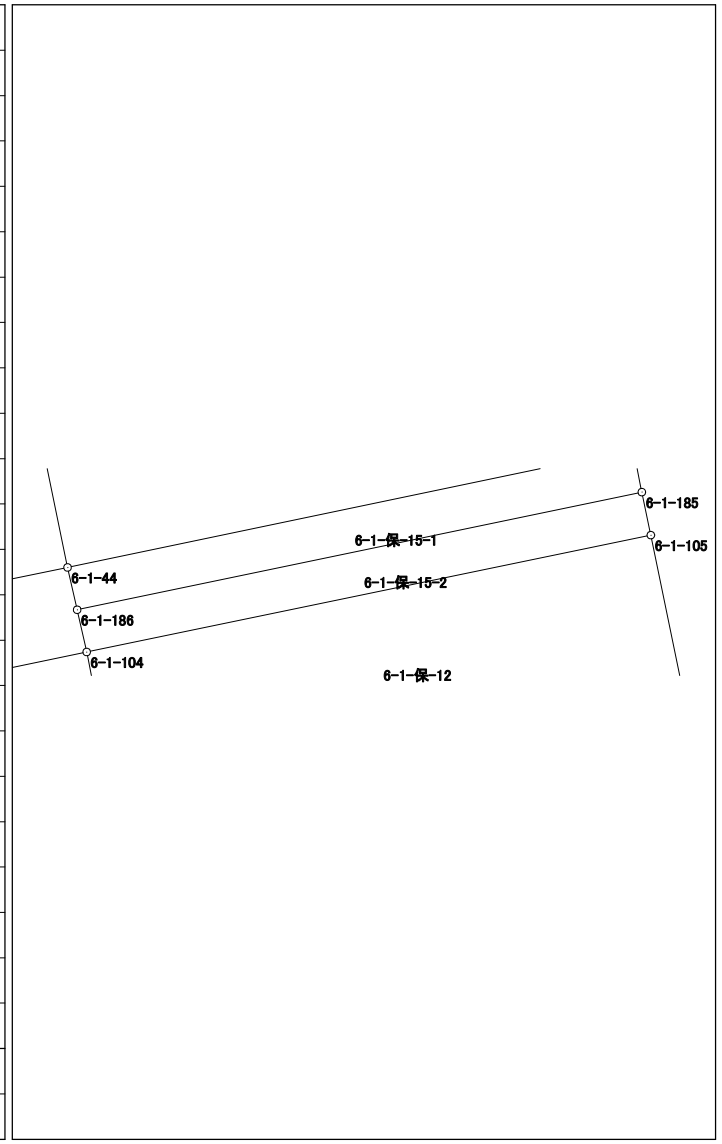


倍面積	6.606012
面積	3.3030060

# 面積計算書 (座標法)

世界測地系 (測地成果2011)

所在	地番	公簿地目	現況地目	地積	所有者
前橋市六供町一丁目	6-1-保-15-3			7.61 m <sup>2</sup>	

点名	X座標	Y座標	辺長	方向角	測角	DX	倍積 (Y×DX)
6-1-41	41822.011	-68434.214	1.001	168-46-07	90-25-41	-2.522	172591.087708
6-1-45	41821.029	-68434.019	6.683	78-17-06	89-30-59	0.375	-25662.757125
6-1-225	41822.386	-68427.475	0.963	78-15-30	179-58-24	1.553	-106267.868675
6-1-104	41822.582	-68426.532	0.496	347-18-30	89-03-00	0.680	-46530.041760
6-1-186	41823.066	-68426.641	0.497	347-13-17	179-54-47	0.969	-66305.415129
6-1-44	41823.551	-68426.751	7.620	258-20-26	91-07-09	-1.055	72190.222305

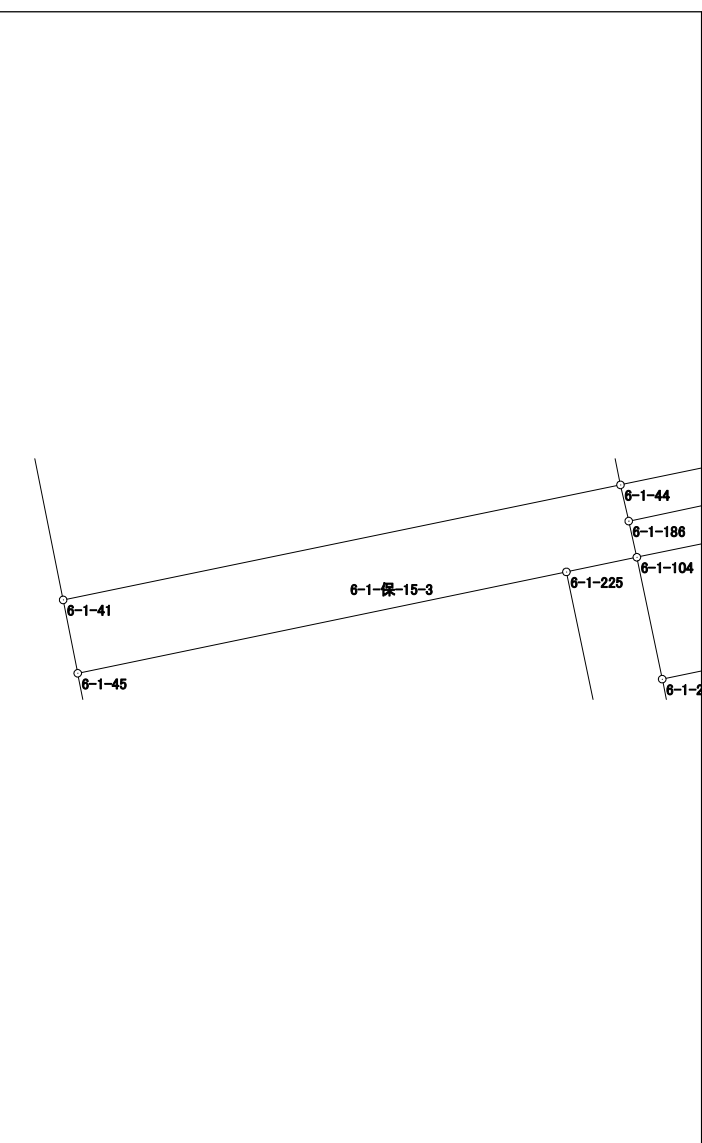


倍面積	15.227324
面積	7.6136620

# 面積計算書（座標法）

世界測地系（測地成果2011）

所在	地番	公簿地目	現況地目	地積	所有者
前橋市六供町一丁目	6-1-保-16			0.24 m <sup>2</sup>	

点名	X座標	Y座標	辺長	方向角	測角	DX	倍積 (Y×DX)
6-1-228	41837.187	-68422.822	0.700	168-17-19	45-00-00	-0.142	9716.040724
6-1-15	41836.502	-68422.680	0.700	78-17-19	90-00-00	-0.543	37153.515240
6-1-227	41836.644	-68421.995	0.989	303-17-19	45-00-00	0.685	-46869.066575
						倍面積	0.489389
						面積	0.2446945

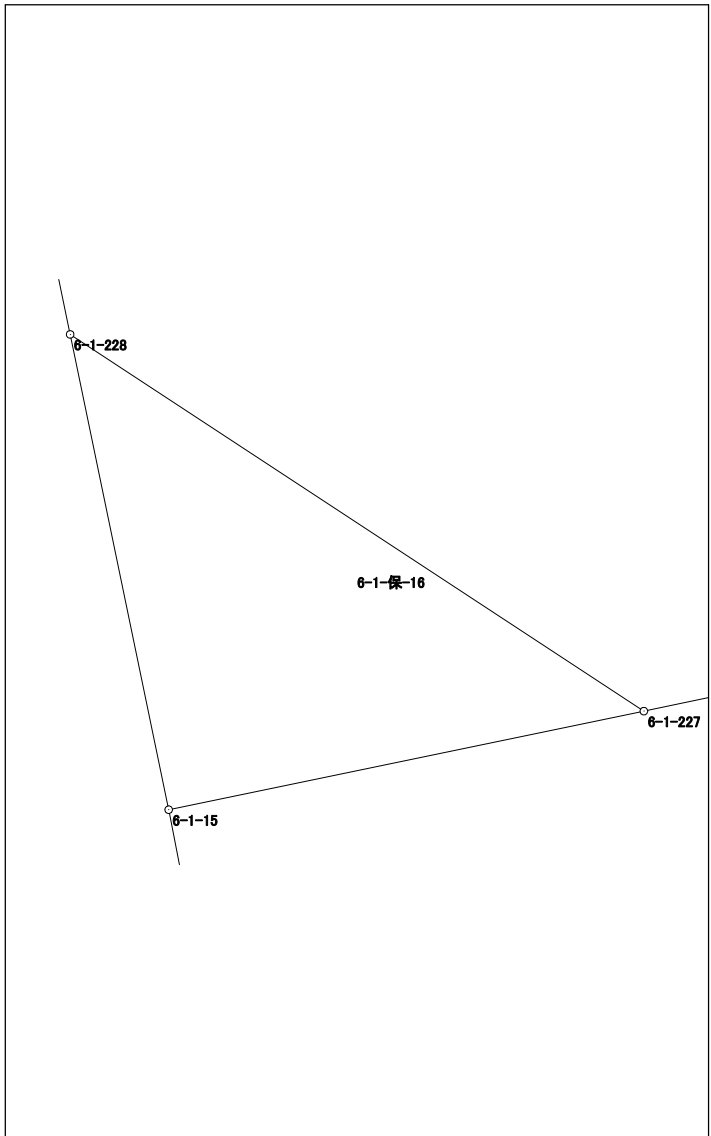




## 面積計算書 (座標法)

世界測地系 (測地成果2011)

所 在	地 番	公簿地目	現況地目	地 積	所 有 者
前橋市六供町一丁目	6-1-保-18			19.00 m <sup>2</sup>	

点 名	X 座標	Y 座標	辺 長	方 向 角	測 角	DX	倍 積 (Y×DX)
6-1-219	41854.337	-68397.707	2.572	348-14-40	89-55-37	4.014	-274548.395898
6-1-221	41856.855	-68398.231	7.387	258-19-24	90-04-44	1.023	-69971.390313
6-1-222	41855.360	-68405.465	2.573	168-16-15	89-56-51	-4.014	274579.536510
6-1-220	41852.841	-68404.942	7.388	78-19-03	90-02-48	-1.023	69978.255666

倍面積	38.005965
面 積	19.0029825

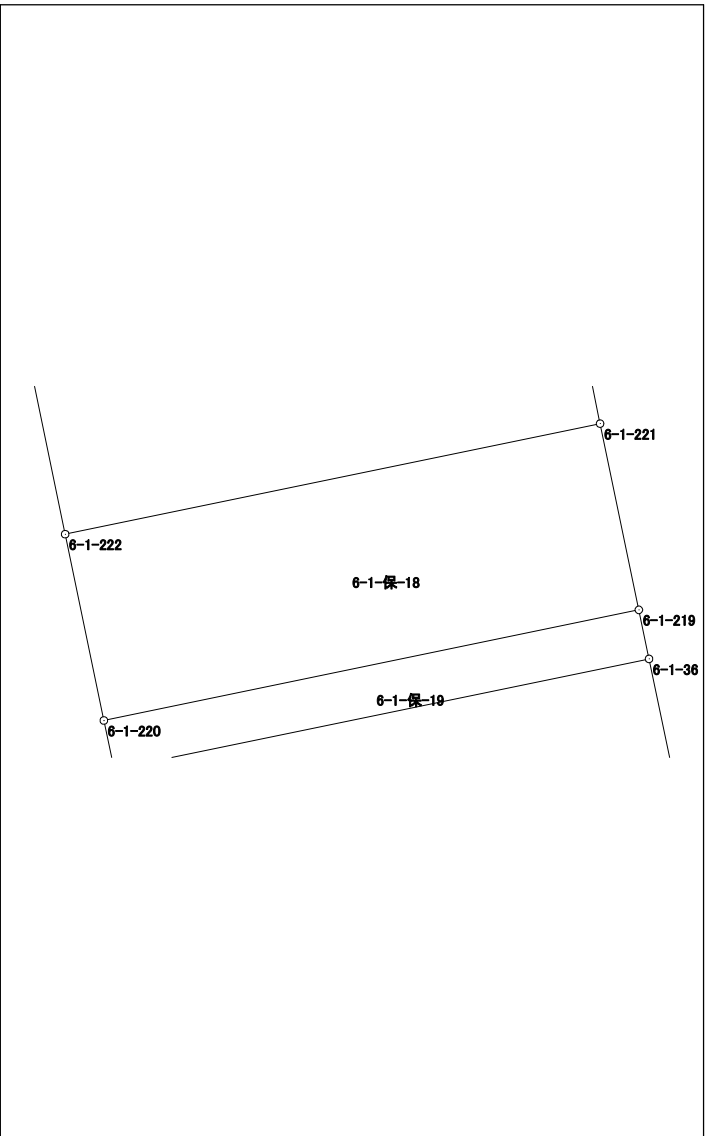




# 面積計算書 (座標法)

世界測地系 (測地成果2011)

所在	地番	公簿地目	現況地目	地積	所有者
前橋市六供町一丁目	6-2-1 (未)			170.78 m <sup>2</sup>	

点名	X座標	Y座標	辺長	方向角	測角	DX	倍積 (Y×DX)
6-2-51	41833.826	-68415.870	3.002	213-17-54	135-03-36	-5.348	365888.072760
6-2-50	41831.317	-68417.518	8.660	168-14-23	134-56-29	-10.987	751703.270266
6-2-182	41822.839	-68415.753	10.395	78-13-35	89-59-12	-6.357	434918.941821
6-2-180	41824.960	-68405.577	3.660	78-20-02	180-06-27	2.861	-195708.355797
6-2-204	41825.700	-68401.993	1.997	78-21-29	180-01-27	1.143	-78183.477999
6-2-109	41826.103	-68400.037	2.992	348-14-08	89-52-39	3.332	-227908.923284
6-2-202	41829.032	-68400.647	7.796	348-14-51	180-00-43	10.562	-722447.633614
6-2-106	41836.665	-68402.235	13.927	258-14-18	89-59-27	4.794	-327920.314590

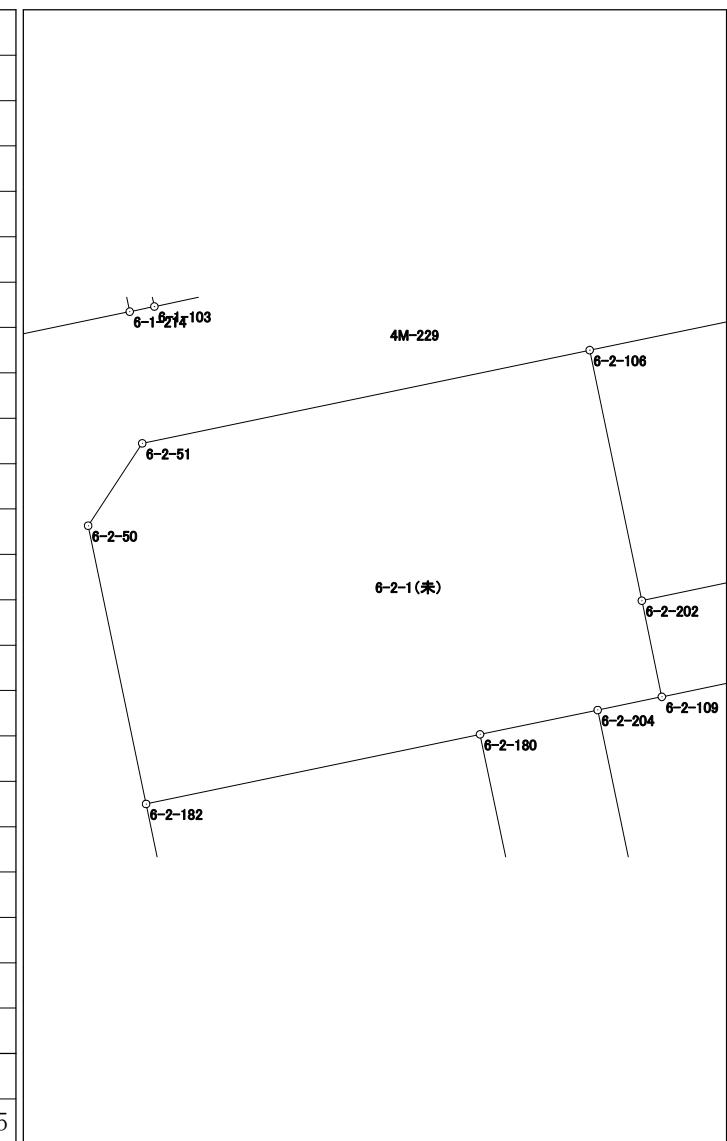

倍面積	341.579563
面積	170.7897815