



- 6-1 街区
- 6-2 街区
- 6-3 街区

# 画地出来形確認図

(1327.76m<sup>2</sup>)  
(507.07m<sup>2</sup>)  
(1354.79m<sup>2</sup>)

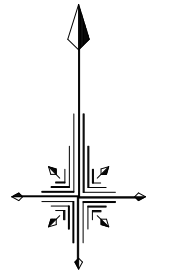

S=1/500

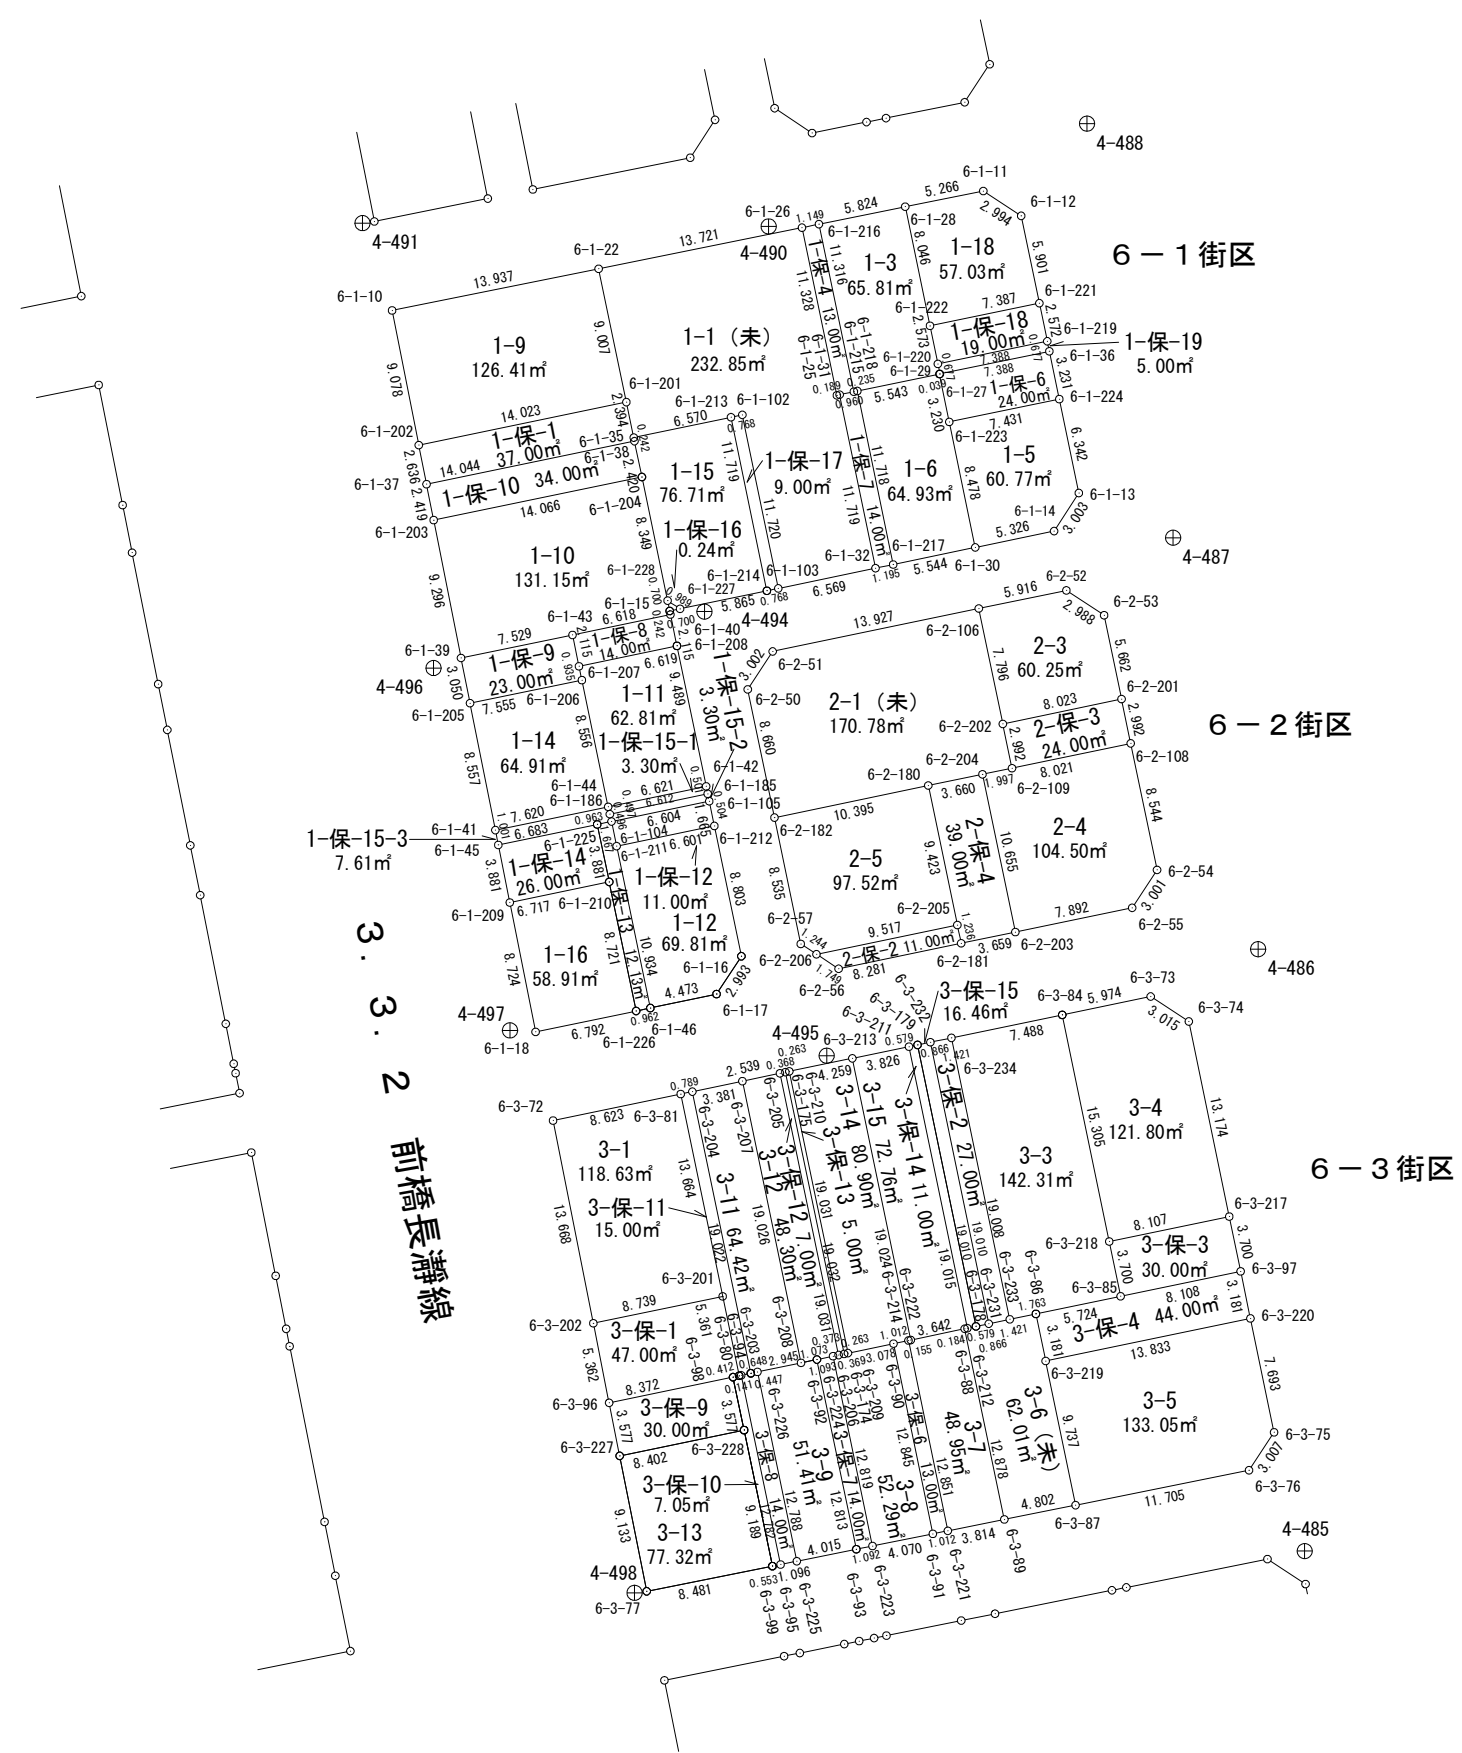




# 面積計算書（座標法）

世界測地系（測地成果2011）

所在	地番	公簿地目	現況地目	地積	所有者
前橋市六供町一丁目	6-2-3			60.25 m <sup>2</sup>	

点名	X座標	Y座標	辺長	方向角	測角	DX	倍積 (Y×DX)
6-2-201	41830.676	-68392.794	5.662	348-15-41	90-05-07	7.188	-491607.403272
6-2-53	41836.220	-68393.946	2.988	303-21-18	135-05-37	7.187	-491547.289902
6-2-52	41837.863	-68396.442	5.916	258-18-57	134-57-39	0.445	-30436.416690
6-2-106	41836.665	-68402.235	7.796	168-14-51	89-55-54	-8.831	604060.137285
6-2-202	41829.032	-68400.647	8.023	78-10-34	89-55-43	-5.989	409651.474883

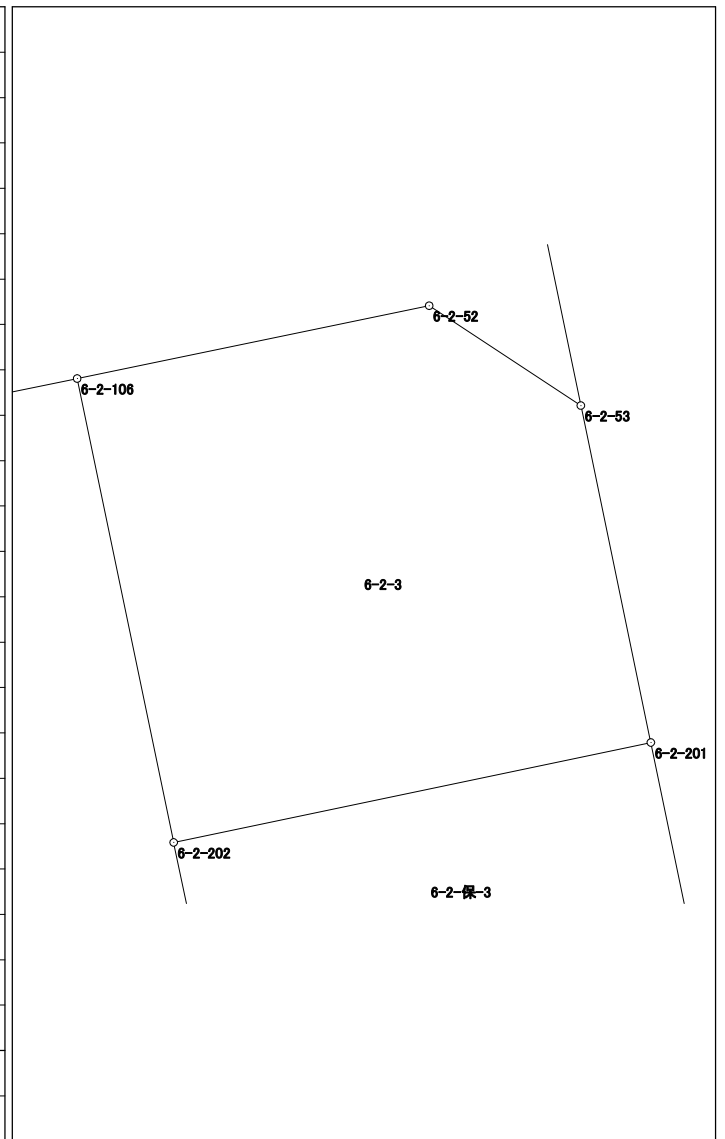


倍面積	120.502304
面積	60.2511520

# 面積計算書 (座標法)

世界測地系 (測地成果2011)

所在	地番	公簿地目	現況地目	地積	所有者
前橋市六供町一丁目	6-2-4			104.50 m <sup>2</sup>	

点名	X座標	Y座標	辺長	方向角	測角	DX	倍積 (Y×DX)
6-2-203	41815.269	-68399.818	7.892	78-16-48	90-03-29	-8.828	603833.593304
6-2-55	41816.872	-68392.091	3.001	33-15-59	134-59-11	4.112	-281228.278192
6-2-54	41819.381	-68390.445	8.544	348-14-35	134-58-36	10.874	-743677.698930
6-2-108	41827.746	-68392.186	8.021	258-10-48	89-56-13	6.722	-459732.274292
6-2-109	41826.103	-68400.037	1.997	258-21-29	180-10-41	-2.046	139946.475702
6-2-204	41825.700	-68401.993	10.655	168-13-19	89-51-50	-10.834	741067.192162

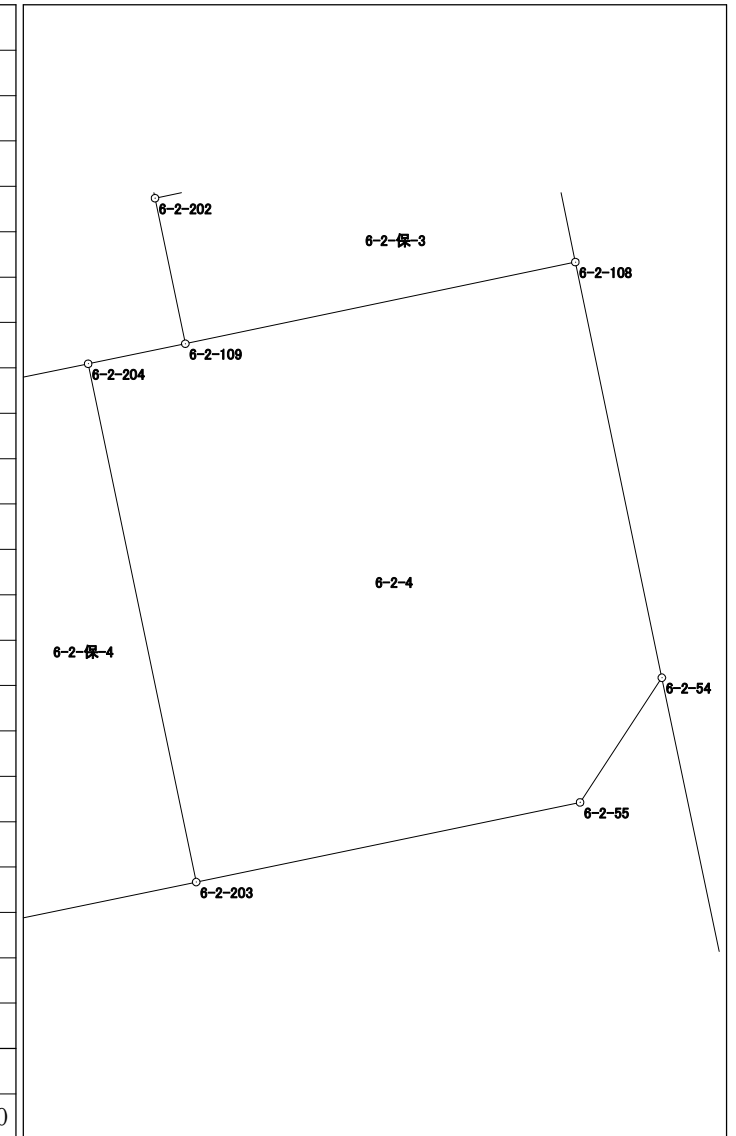

倍面積	209.009754
面積	104.5048770






# 面積計算書（座標法）

世界測地系（測地成果2011）

所在	地番	公簿地目	現況地目	地積	所有者
前橋市六供町一丁目	6-2-保-3			24.00 m <sup>2</sup>	

点名	X座標	Y座標	辺長	方向角	測角	DX	倍積 (Y×DX)
6-2-109	41826.103	-68400.037	8.021	78-10-48	89-56-40	-1.286	87962.447582
6-2-108	41827.746	-68392.186	2.992	348-16-37	90-05-49	4.573	-312757.466578
6-2-201	41830.676	-68392.794	8.023	258-10-34	89-53-57	1.286	-87953.133084
6-2-202	41829.032	-68400.647	2.992	168-14-08	90-03-34	-4.573	312796.158731
						倍面積	48.006651
						面積	24.0033255

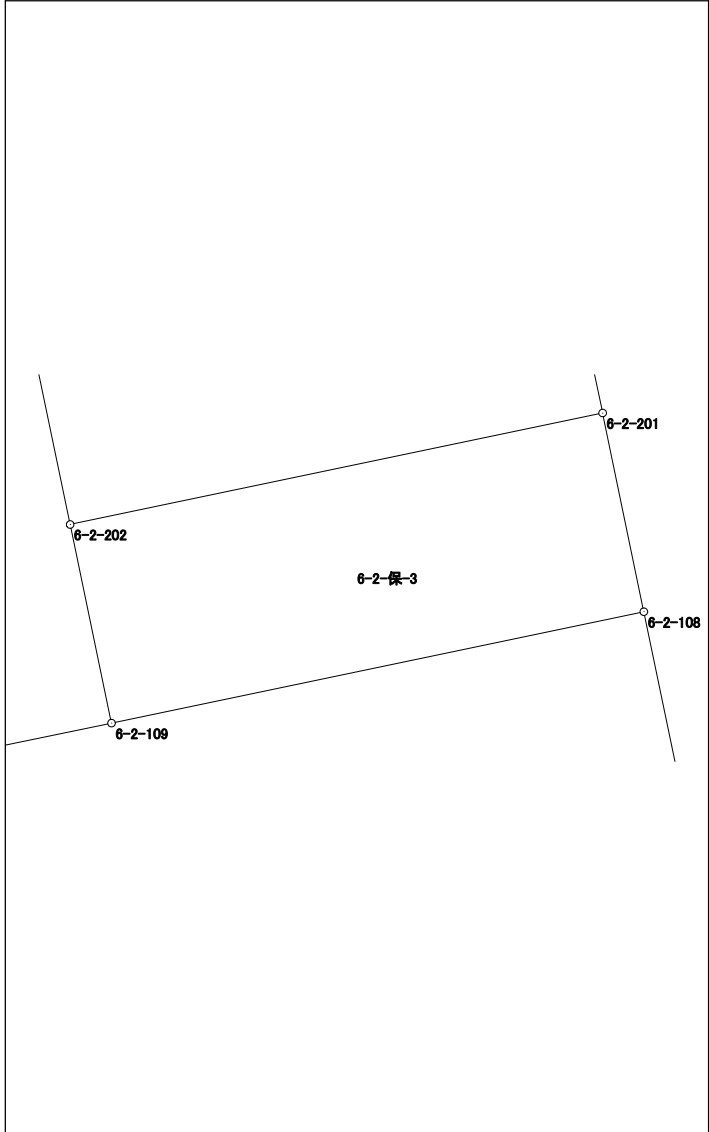

# 面積計算書 (座標法)

世界測地系 (測地成果2011)

所在	地番	公簿地目	現況地目	地積	所有者
前橋市六供町一丁目	6-2-保-4			39.00 m <sup>2</sup>	

点名	X座標	Y座標	辺長	方向角	測角	DX	倍積 (Y×DX)
6-2-180	41824.960	-68405.577	9.423	168-13-30	89-53-28	-9.965	681661.574805
6-2-205	41815.735	-68403.654	1.236	168-11-24	179-57-54	-10.435	713792.129490
6-2-181	41814.525	-68403.401	3.659	78-16-10	90-04-46	-0.466	31875.984866
6-2-203	41815.269	-68399.818	10.655	348-13-19	89-57-09	11.175	-764367.966150
6-2-204	41825.700	-68401.993	3.660	258-20-02	90-06-43	9.691	-662883.714163
						倍面積	78.008848
						面積	39.0044240

