



6-1 街区  
6-2 街区  
6-3 街区

# 画地出来形確認図

(1327.76m<sup>2</sup>)  
(507.07m<sup>2</sup>)  
(1354.79m<sup>2</sup>)

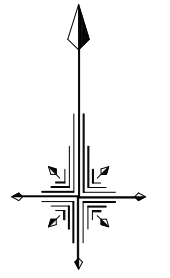

S=1/500

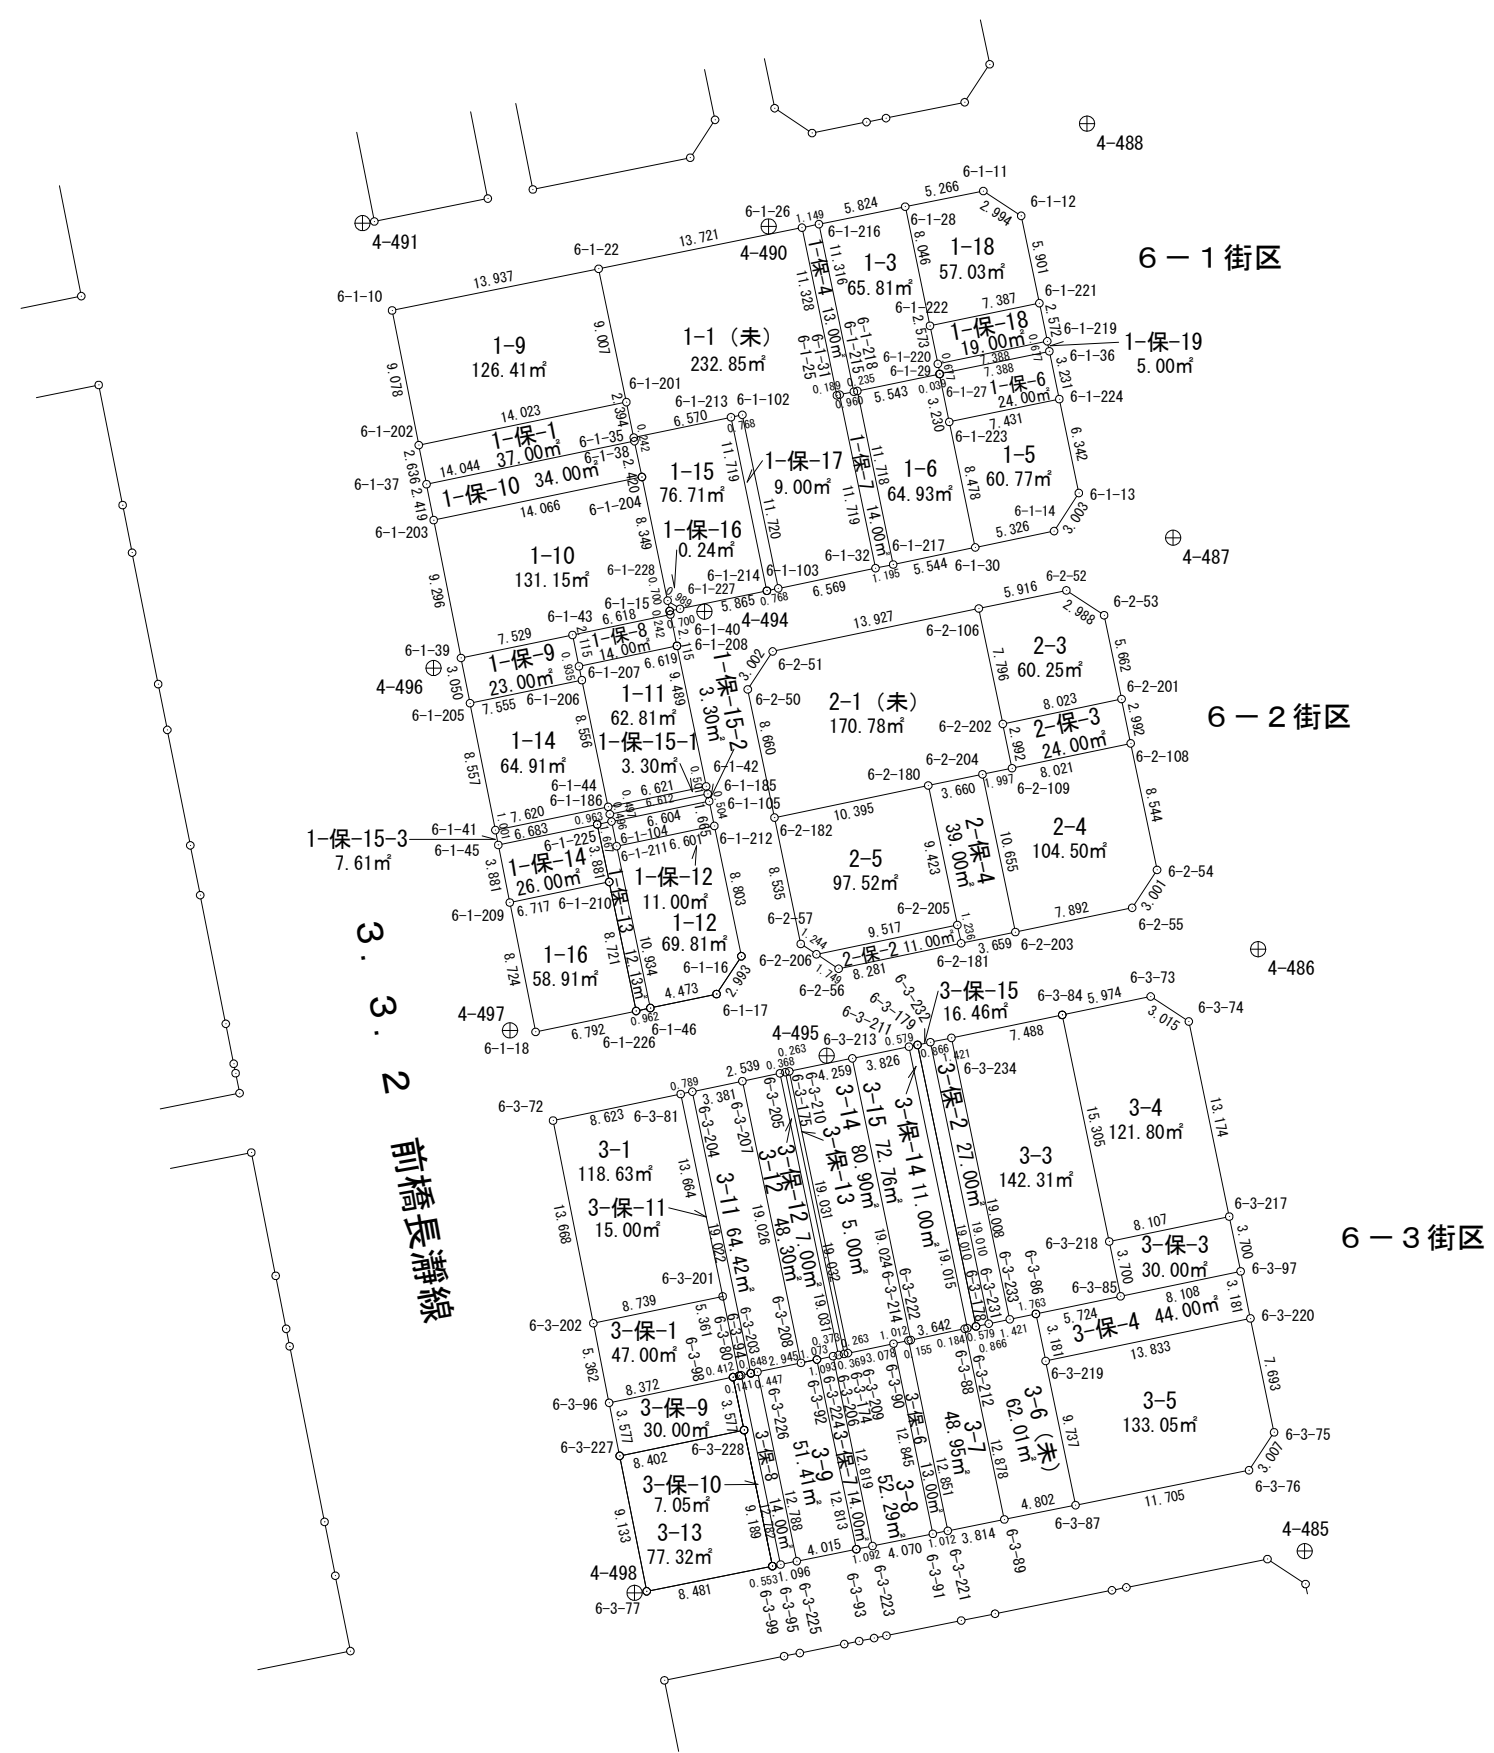


# 面積計算書 (座標法)

世界測地系 (測地成果2011)

所在	地番	公簿地目	現況地目	地積	所有者
前橋市六供町一丁目	6-3-1			118.63 m <sup>2</sup>	

点名	X座標	Y座標	辺長	方向角	測角	DX	倍積 (Y×DX)
6-3-201	41791.177	-68419.177	13.664	348-16-11	90-00-33	15.157	-1037029.465789
6-3-81	41804.556	-68421.955	8.623	258-17-01	90-00-50	11.628	-795610.492740
6-3-72	41802.805	-68430.398	13.668	168-45-24	90-28-23	-15.157	1037199.542486
6-3-202	41789.399	-68427.733	8.739	78-15-38	89-30-14	-11.628	795677.679324
						倍面積	237.263281
						面積	118.6316405

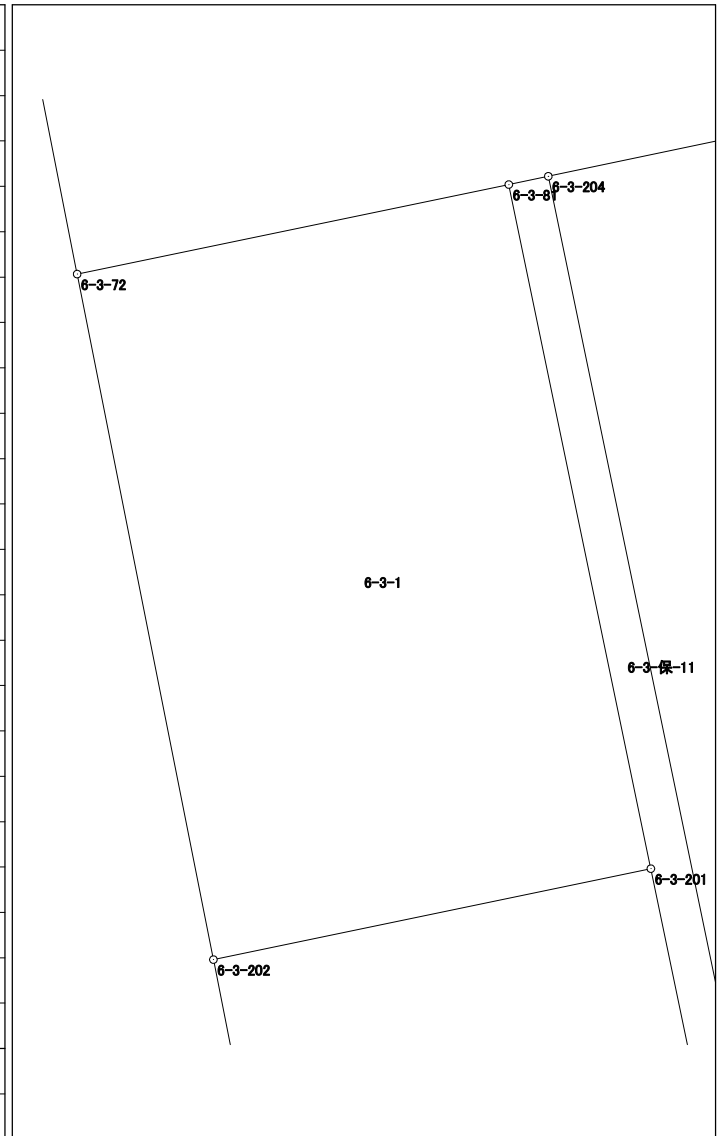


# 面積計算書（座標法）

世界測地系（測地成果2011）

所 在	地 番	公簿地目	現況地目	地 積	所 有 者
前橋市六供町一丁目	6-3-3			142.31 m <sup>2</sup>	

点 名	X 座標	Y 座標	辺 長	方 向 角	測 角	DX	倍 積 (Y×DX)
6-3-233	41789.660	-68400.185	1.763	78-15-01	89-58-22	-18.253	1248508.576805
6-3-86	41790.019	-68398.459	5.724	78-15-22	180-00-21	1.524	-104239.251516
6-3-85	41791.184	-68392.855	3.700	348-17-21	90-01-59	4.788	-327464.989740
6-3-218	41794.807	-68393.606	15.305	348-16-47	179-59-26	18.609	-1272736.614054
6-3-84	41809.793	-68396.715	7.488	258-16-49	90-00-02	13.465	-920961.767475
6-3-234	41808.272	-68404.047	19.008	168-16-39	89-59-50	-20.133	1377178.678251
						倍面積	284.632271
						面積	142.3161355

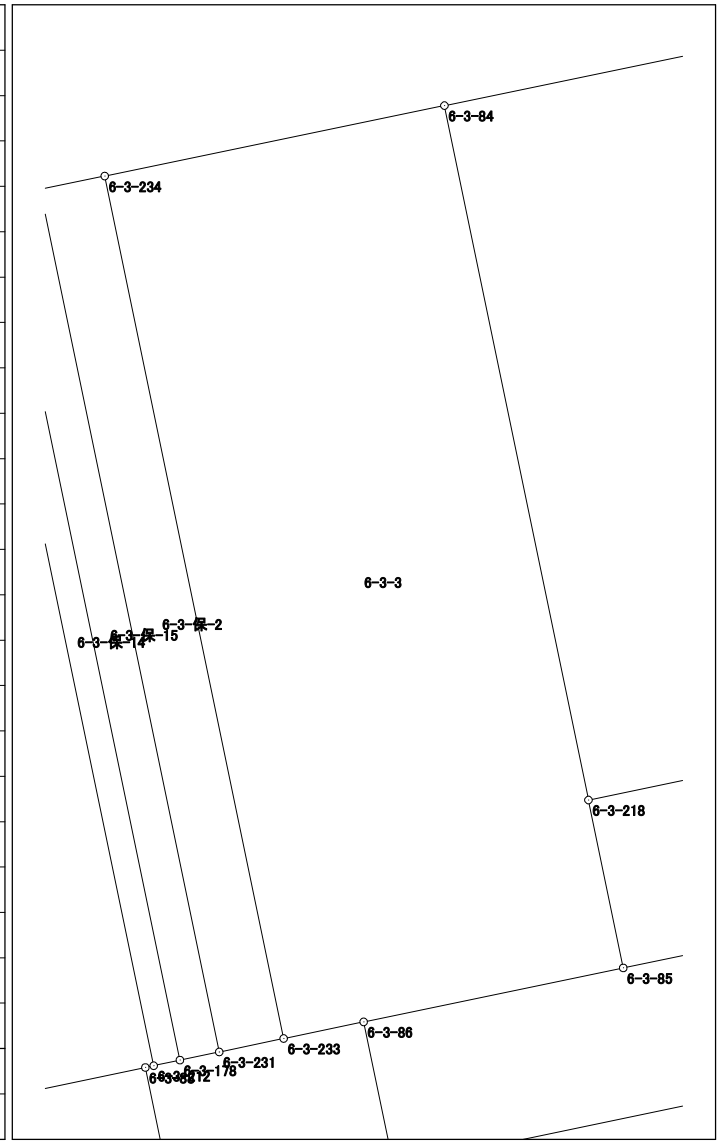


# 面積計算書 (座標法)

世界測地系 (測地成果2011)

所在	地番	公簿地目	現況地目	地積	所有者
前橋市六供町一丁目	6-3-4			121.80 m <sup>2</sup>	

点名	X 座標	Y 座標	辺長	方向角	測角	DX	倍積 (Y×DX)
6-3-217	41796.456	-68385.668	13.174	348-16-47	90-00-55	14.548	-994874.698064
6-3-74	41809.355	-68388.344	3.015	303-13-34	134-56-47	14.551	-995118.793544
6-3-73	41811.007	-68390.866	5.974	258-16-28	135-02-54	0.438	-29955.199308
6-3-84	41809.793	-68396.715	15.305	168-16-47	90-00-19	-16.200	1108026.783000
6-3-218	41794.807	-68393.606	8.107	78-15-52	89-59-05	-13.337	912165.523222

倍面積	243.615306
面積	121.8076530

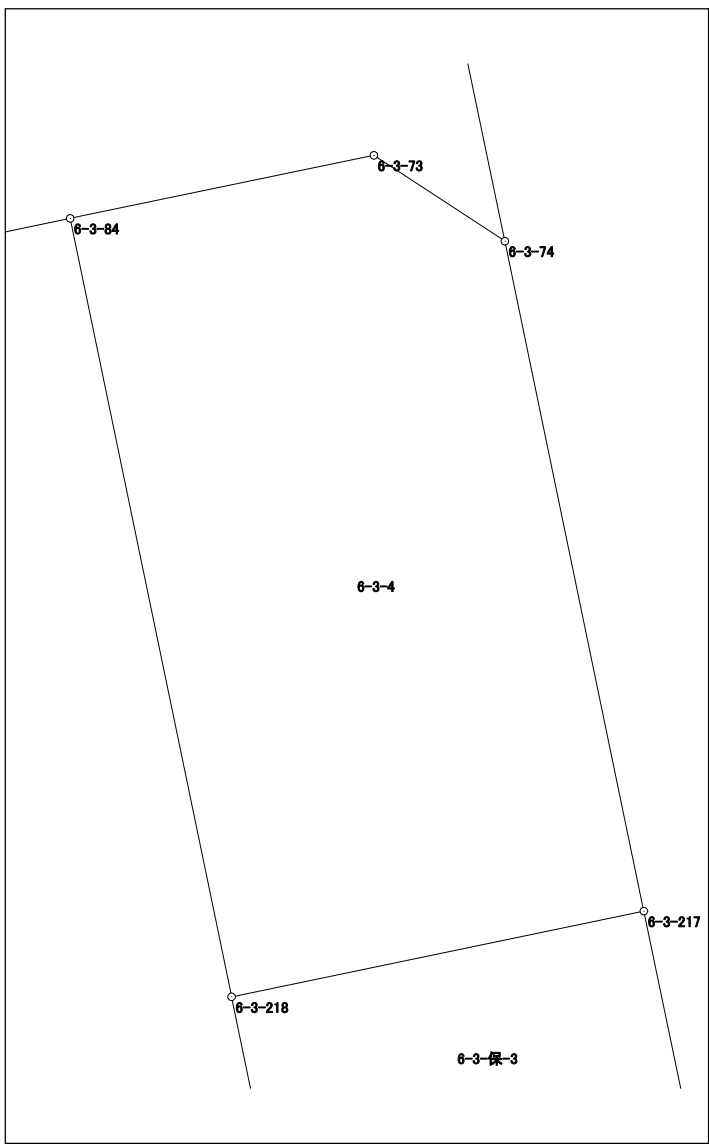

# 面積計算書（座標法）

世界測地系（測地成果2011）

所 在	地 番	公簿地目	現況地目	地 積	所 有 者
前橋市六供町一丁目	6-3-5			133.05 m <sup>2</sup>	


点 名	X 座標	Y 座標	辺 長	方 向 角	測 角	DX	倍 積 (Y×DX)	
6-3-219	41786.904	-68397.813	9.737	168-17-27	90-01-56	-12.349	844644.592737	
6-3-87	41777.370	-68395.837	11.705	78-37-22	90-19-55	-7.225	494159.922325	
6-3-76	41779.679	-68384.362	3.007	33-29-02	134-51-40	4.817	-329407.471754	
6-3-75	41782.187	-68382.703	7.693	348-15-17	134-46-15	10.040	-686562.338120	
6-3-220	41789.719	-68384.269	13.833	258-15-31	90-00-14	4.717	-322568.596873	
							倍面積	266.108315
							面 積	133.0541575

面積計算書 (座標法)

所在	地番	公簿地目	現況地目	地積	所有者
前橋市六供町一丁目	6-3-6 (未)			62.01 m <sup>2</sup>	

点名	X座標	Y座標	辺長	方向角	測角	DX	倍積 (Y×DX)
6-3-89	41776.427	-68400.546	4.802	78-40-34	90-25-58	-11.665	797892.369090
6-3-87	41777.370	-68395.837	9.737	348-17-27	89-36-53	10.477	-716583.184249
6-3-219	41786.904	-68397.813	3.181	348-17-02	179-59-35	12.649	-865163.936637
6-3-86	41790.019	-68398.459	1.763	258-15-01	89-57-59	2.756	-188506.153004
6-3-233	41789.660	-68400.185	1.421	258-13-25	179-58-24	-0.649	44391.720065
6-3-231	41789.370	-68401.576	0.866	258-16-30	180-03-05	-0.466	31875.134416
6-3-178	41789.194	-68402.424	0.579	257-55-58	179-39-28	-0.297	20315.519928
6-3-212	41789.073	-68402.990	0.184	258-04-45	180-08-47	-0.159	10876.075410
6-3-88	41789.035	-68403.170	12.878	168-14-36	90-09-51	-12.646	865026.487820

倍面積	124.032839
面積	62.0164195

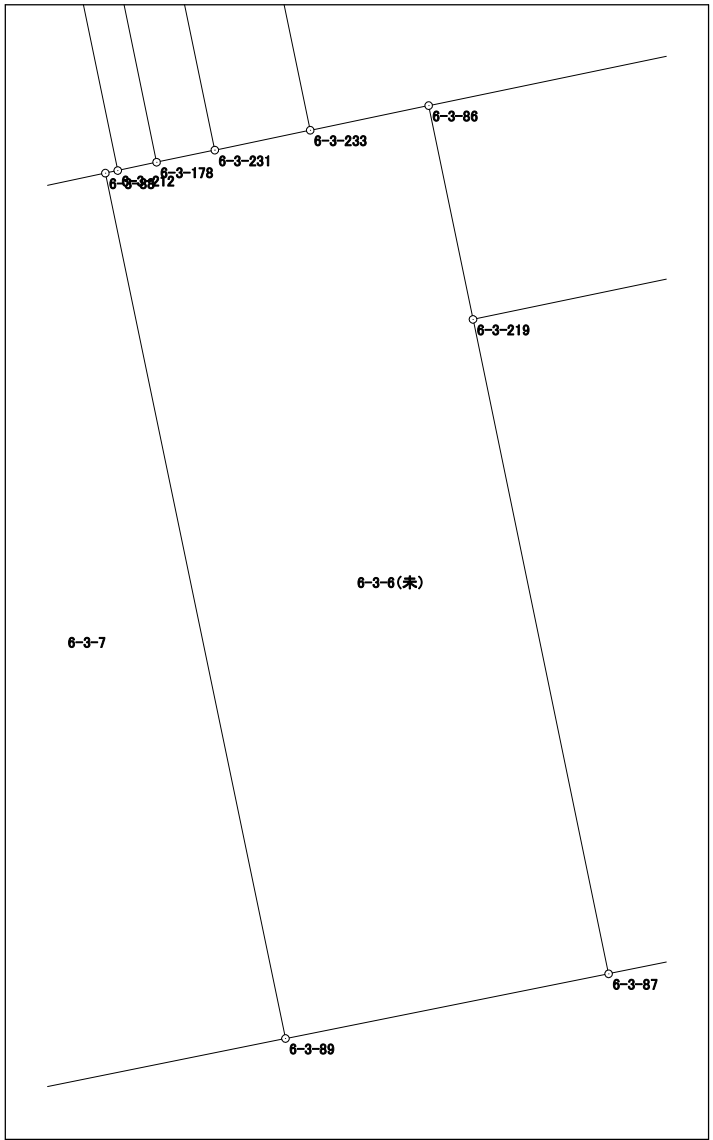




# 面積計算書（座標法）

世界測地系（測地成果2011）

所 在	地 番	公簿地目	現況地目	地 積	所 有 者
前橋市六供町一丁目	6-3-8			52.29 m <sup>2</sup>	

点 名	X 座 標	Y 座 標	辺 長	方 向 角	測 角	DX	倍 積 (Y×DX)
6-3-223	41774.671	-68409.267	4.070	78-37-16	90-21-19	-11.748	803672.068716
6-3-91	41775.474	-68405.277	12.845	348-19-03	89-41-47	13.382	-915399.416814
6-3-90	41788.053	-68407.878	3.078	258-14-41	89-55-38	11.952	-817610.957856
6-3-209	41787.426	-68410.891	0.263	258-08-02	179-53-21	-0.681	46587.816771
6-3-174	41787.372	-68411.148	0.369	258-24-56	180-16-54	-0.128	8756.626944
6-3-206	41787.298	-68411.509	0.373	258-14-17	179-49-21	-0.150	10261.726350
6-3-224	41787.222	-68411.874	12.819	168-15-57	90-01-40	-12.627	863836.732998
						倍面積	104.597109
						面 積	52.2985545

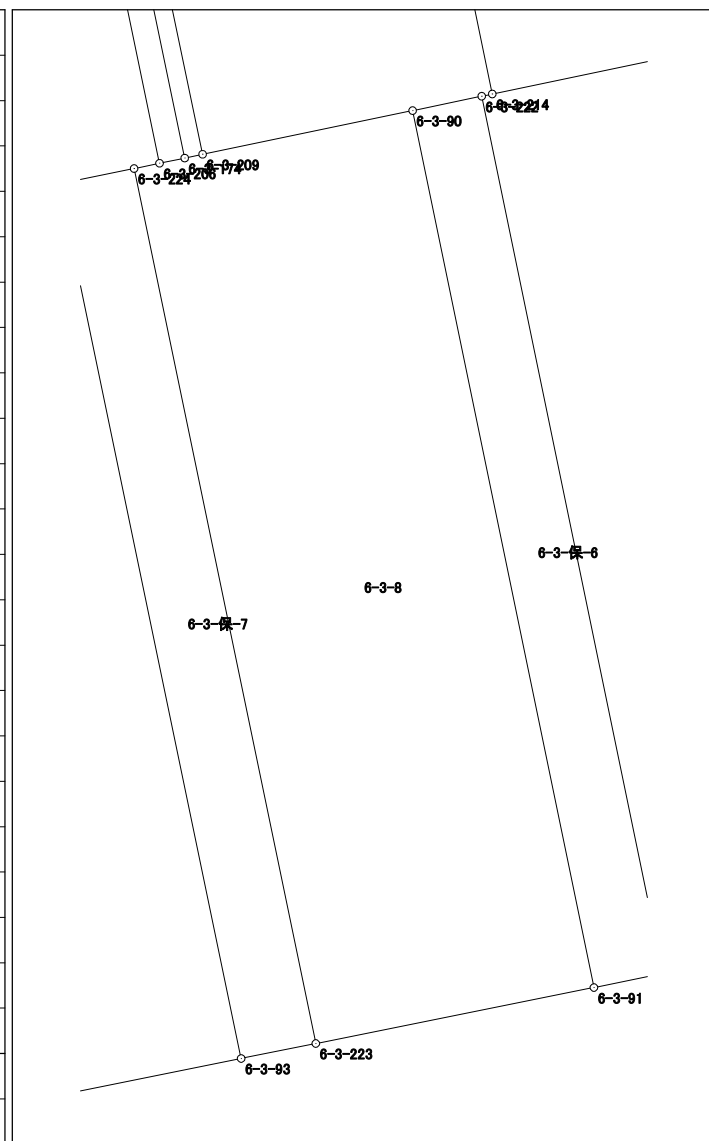




# 面積計算書（座標法）

世界測地系（測地成果2011）

所在	地番	公簿地目	現況地目	地積	所有者
前橋市六供町一丁目	6-3-9			51.41 m <sup>2</sup>	

点名	X座標	Y座標	辺長	方向角	測角	DX	倍積 (Y×DX)
6-3-225	41773.663	-68414.274	4.015	78-36-32	90-21-29	-11.727	802294.191198
6-3-93	41774.456	-68410.338	12.813	348-15-53	89-39-21	13.338	-912457.088244
6-3-92	41787.001	-68412.944	1.073	258-16-54	90-01-01	12.327	-843326.360688
6-3-208	41786.783	-68413.995	2.945	258-14-37	179-57-43	-0.818	55962.647910
6-3-226	41786.183	-68416.878	12.788	168-15-03	90-00-26	-13.120	897629.439360
倍面積							102.829536
面積							51.4147680

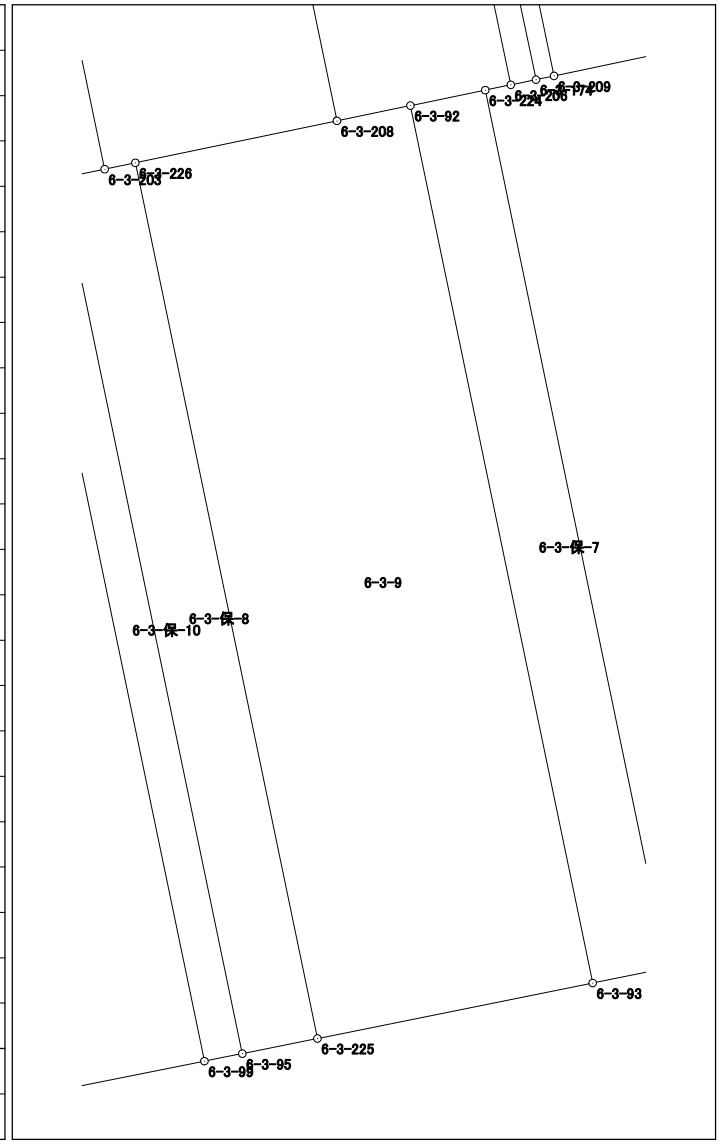


# 面積計算書（座標法）

世界測地系（測地成果2011）

所 在	地 番	公簿地目	現況地目	地 積	所 有 者
前橋市六供町一丁目	6-3-11			64.42 m <sup>2</sup>	

点 名	X 座標	Y 座標	辺 長	方 向 角	測 角	D X	倍 積 (Y×DX)
6-3-207	41805.409	-68417.874	3.381	258-11-17	89-57-08	17.934	-1227006.152316
6-3-204	41804.717	-68421.183	19.022	168-16-14	90-04-57	-19.317	1321691.992011
6-3-203	41786.092	-68417.316	0.447	78-15-47	89-59-33	-18.534	1268046.534744
6-3-226	41786.183	-68416.878	2.945	78-14-37	179-58-50	0.691	-47276.062698
6-3-208	41786.783	-68413.995	19.026	348-14-09	89-59-32	19.226	-1315327.467870

倍面積	128.843871
面積	64.4219355

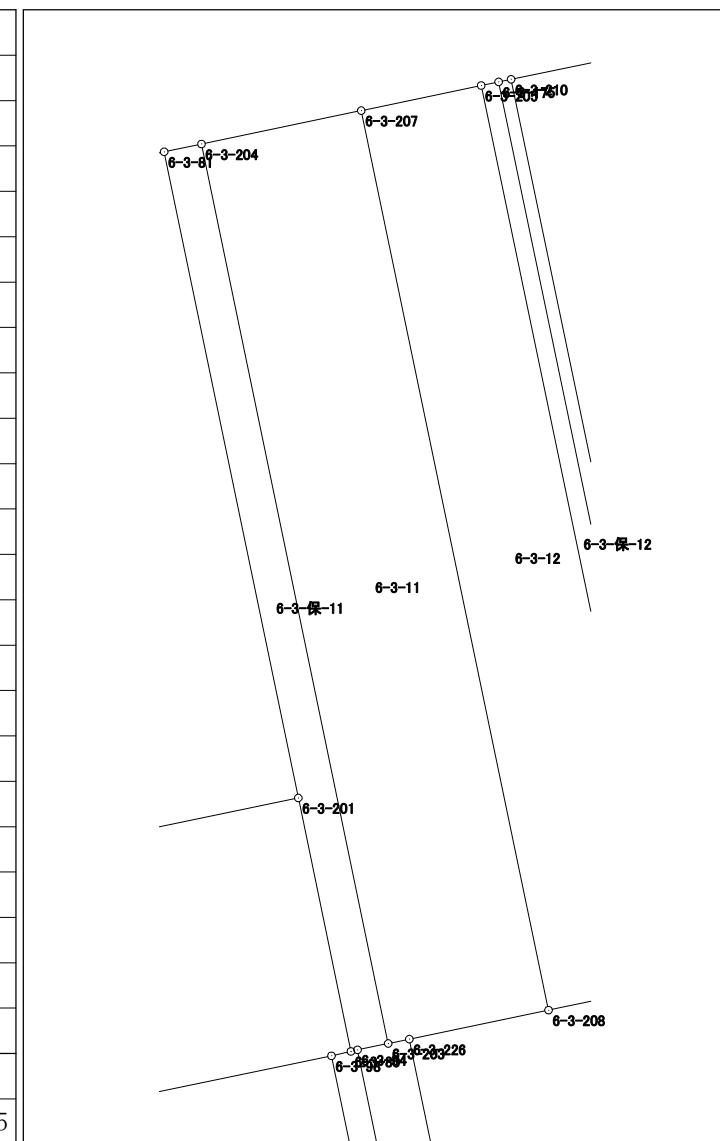








# 面積計算書 (座標法)

世界測地系 (測地成果2011)

所在	地番	公簿地目	現況地目	地積	所有者
前橋市六供町一丁目	6-3-15			72.76 m <sup>2</sup>	

点名	X座標	Y座標	辺長	方向角	測角	DX	倍積 (Y×DX)
6-3-212	41789.073	-68402.990	19.015	348-16-41	90-11-56	18.656	-1276126.181440
6-3-211	41807.691	-68406.853	3.826	258-20-37	90-03-56	17.845	-1220720.291785
6-3-213	41806.918	-68410.600	19.024	168-16-40	89-56-03	-19.400	1327165.640000
6-3-214	41788.291	-68406.735	3.642	78-12-43	89-56-03	-17.883	1223317.642005
6-3-88	41789.035	-68403.170	0.184	78-04-45	179-52-02	0.782	-53491.278940
倍面積							145.529840
面積							72.7649200

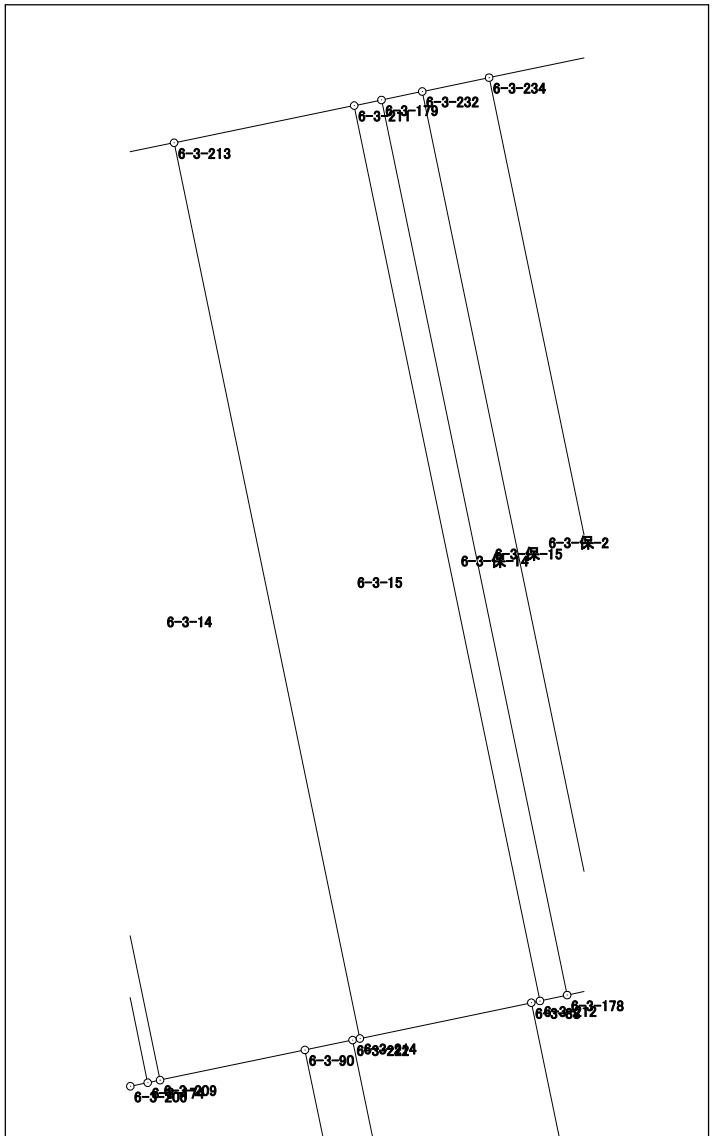




# 面積計算書（座標法）

世界測地系（測地成果2011）

所 在	地 番	公簿地目	現況地目	地 積	所 有 者
前橋市六供町一丁目	6-3-保-2			27.00 m <sup>2</sup>	

点 名	X 座標	Y 座標	辺 長	方 向 角	測 角	DX	倍 積 (Y×DX)
6-3-231	41789.370	-68401.576	1.421	78-13-25	89-56-42	-18.324	1253390.478624
6-3-233	41789.660	-68400.185	19.008	348-16-39	90-03-14	18.902	-1292900.296870
6-3-234	41808.272	-68404.047	1.421	258-18-09	90-01-30	18.324	-1253435.757228
6-3-232	41807.984	-68405.438	19.010	168-16-43	89-58-34	-18.902	1292999.589076
						倍面積	54.013602
						面 積	27.0068010

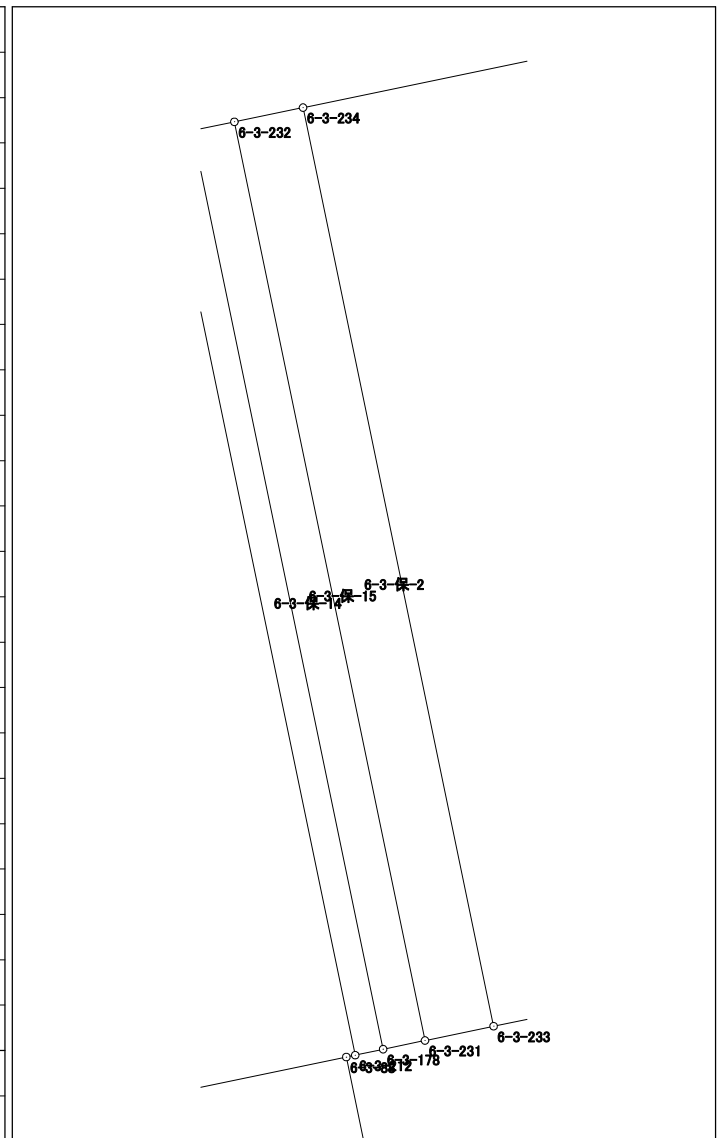




# 面積計算書 (座標法)

世界測地系 (測地成果2011)

所 在	地 番	公簿地目	現況地目	地 積	所 有 者
前橋市六供町一丁目	6-3-保-3			30.00 m <sup>2</sup>	

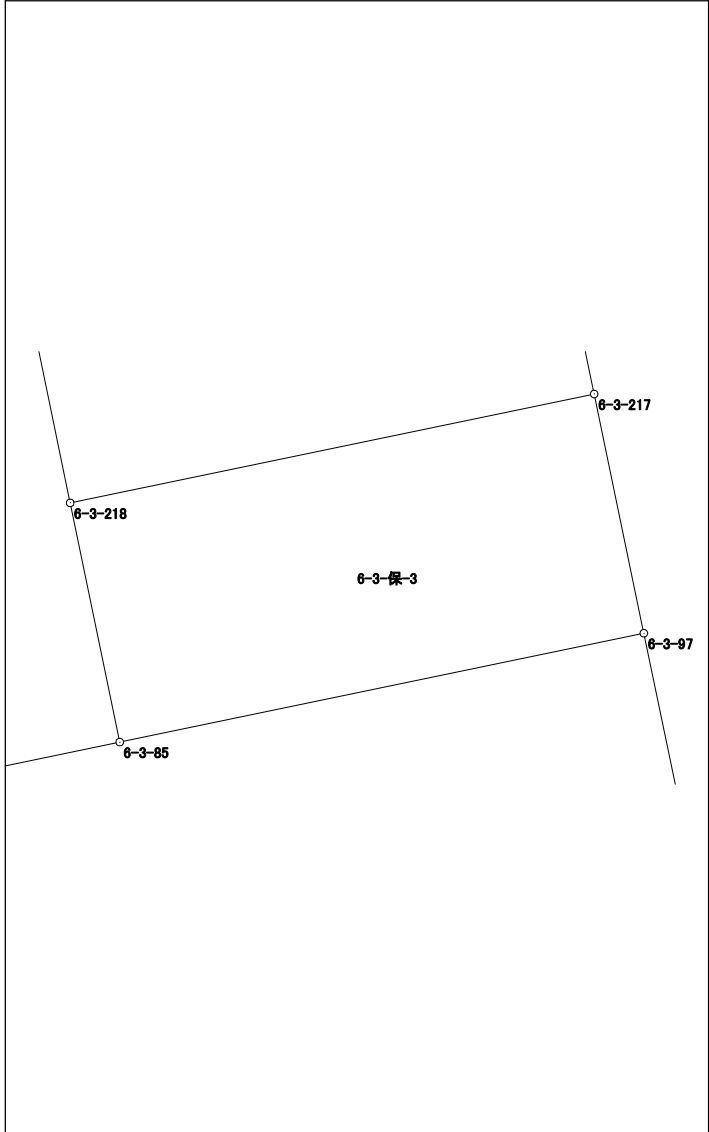点 名	X 座標	Y 座標	辺 長	方 向 角	測 角	DX	倍 積 (Y×DX)	
6-3-85	41791.184	-68392.855	8.108	78-15-58	89-58-37	-1.974	135007.495770	
6-3-97	41792.833	-68384.916	3.700	348-16-27	90-00-29	5.272	-360525.277152	
6-3-217	41796.456	-68385.668	8.107	258-15-52	89-59-25	1.974	-134993.308632	
6-3-218	41794.807	-68393.606	3.700	168-17-21	90-01-29	-5.272	360571.090832	
倍面積							60.000818	
面 積							30.0004090	










# 面積計算書 (座標法)

世界測地系 (測地成果2011)

所在	地番	公簿地目	現況地目	地積	所有者
前橋市六供町一丁目	6-3-保-9			30.00 m <sup>2</sup>	

点名	X座標	Y座標	辺長	方向角	測角	DX	倍積 (Y×DX)
6-3-98	41785.837	-68418.490	8.372	258-18-17	90-03-50	1.805	-123495.374450
6-3-96	41784.140	-68426.688	3.577	168-43-51	90-25-34	-5.205	356160.911040
6-3-227	41780.632	-68425.989	8.402	78-18-23	89-34-32	-1.805	123508.910145
6-3-228	41782.335	-68417.761	3.577	348-14-27	89-56-04	5.205	-356114.446005
						倍面積	60.000730
						面積	30.0003650

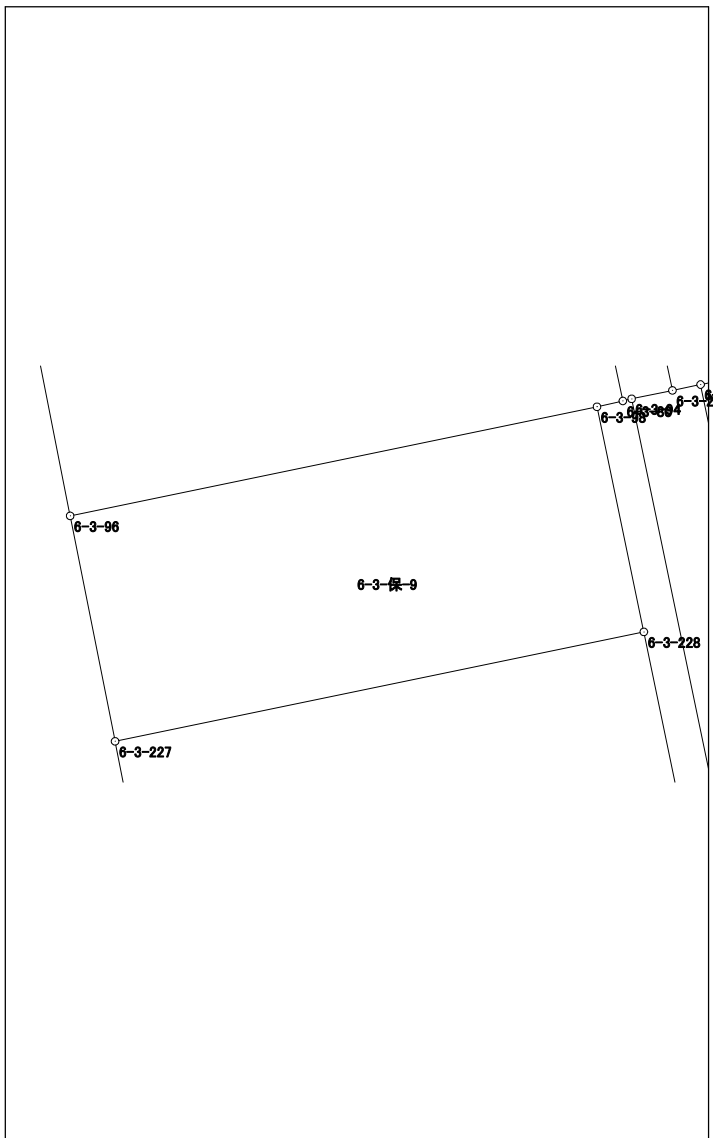




# 面積計算書（座標法）

世界測地系（測地成果2011）

所 在	地 番	公簿地目	現況地目	地 積	所 有 者
前橋市六供町一丁目	6-3-保-11			15.00 m <sup>2</sup>	

点 名	X 座標	Y 座標	辺 長	方 向 角	測 角	DX	倍 積 (Y×DX)
6-3-80	41785.928	-68418.088	0.141	76-27-25	88-10-40	-5.216	356868.747008
6-3-94	41785.961	-68417.951	0.648	78-20-36	181-53-11	0.164	-11220.543964
6-3-203	41786.092	-68417.316	19.022	348-16-14	89-55-38	18.756	-1283235.178896
6-3-204	41804.717	-68421.183	0.789	258-13-11	89-56-57	18.464	-1263328.722912
6-3-81	41804.556	-68421.955	13.664	168-16-11	90-03-00	-13.540	926433.270700
6-3-201	41791.177	-68419.177	5.361	168-16-45	180-00-34	-18.628	1274512.429156
						倍面積	30.001092
						面 積	15.0005460

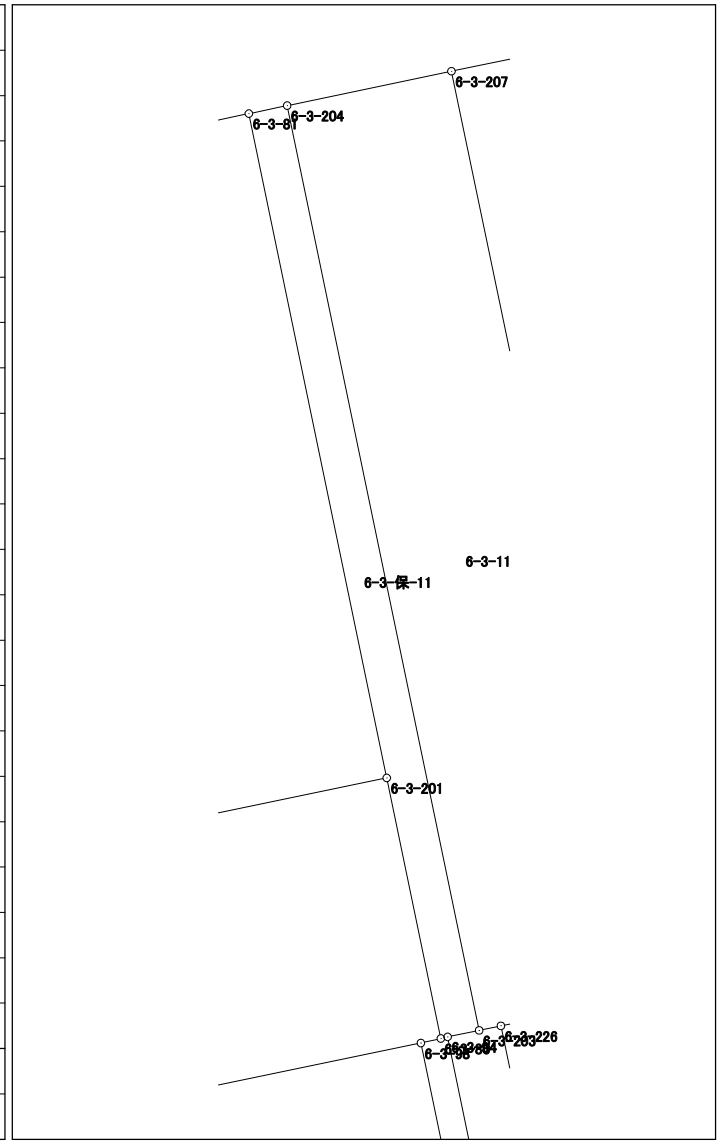






# 面積計算書 (座標法)

世界測地系 (測地成果2011)

所在	地番	公簿地目	現況地目	地積	所有者
前橋市六供町一丁目	6-3-保-13			5.00 m <sup>2</sup>	


点名	X座標	Y座標	辺長	方向角	測角	DX	倍積 (Y×DX)
6-3-175	41806.004	-68415.029	19.032	168-14-01	89-50-32	-18.685	1278334.816865
6-3-174	41787.372	-68411.148	0.263	78-08-02	89-54-01	-18.578	1270942.307544
6-3-209	41787.426	-68410.891	19.031	348-14-10	90-06-08	18.685	-1278257.498335
6-3-210	41806.057	-68414.771	0.263	258-23-29	90-09-19	18.578	-1271009.615638
						倍面積	10.010436
						面積	5.0052180

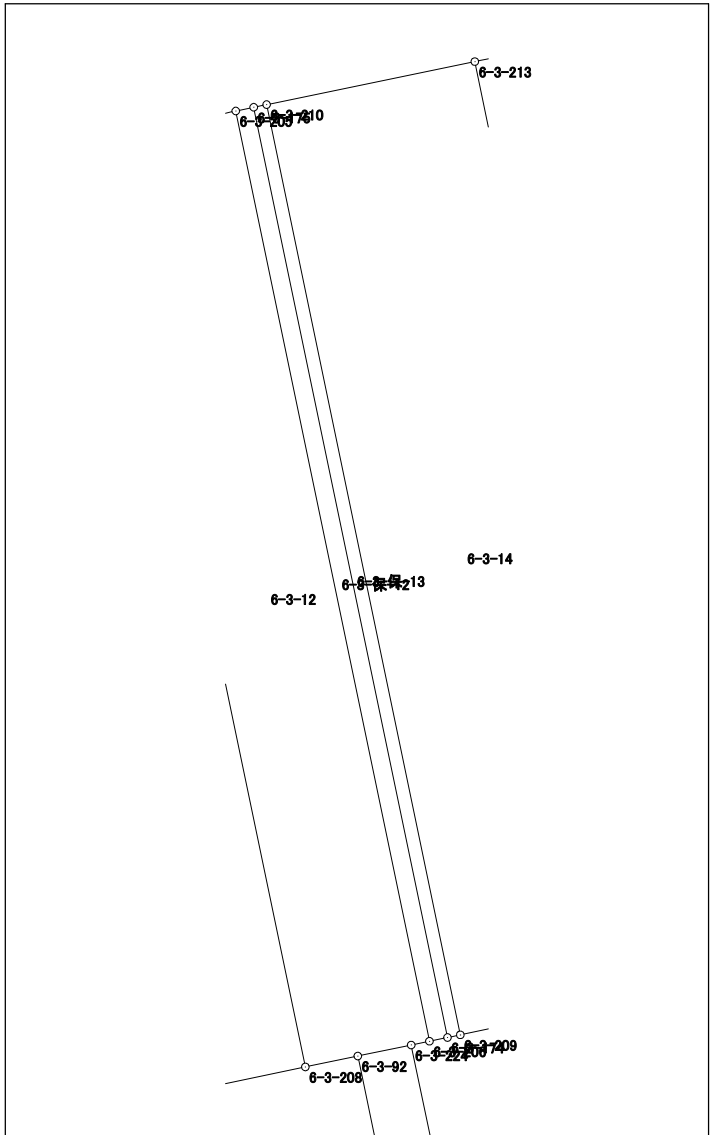

# 面積計算書（座標法）

所 在	地 番	公簿地目	現況地目	地 積	所 有 者
前橋市六供町一丁目	6-3-保-14			11.00 m <sup>2</sup>	

点 名	X 座 標	Y 座 標	辺 長	方 向 角	測 角	DX	倍 積 (Y×DX)
6-3-178	41789.194	-68402.424	19.010	348-16-43	90-20-45	18.735	-1281519.413640
6-3-179	41807.808	-68406.286	0.579	258-20-27	90-03-44	18.497	-1265311.072142
6-3-211	41807.691	-68406.853	19.015	168-16-41	89-56-14	-18.735	1281602.390955
6-3-212	41789.073	-68402.990	0.579	77-55-58	89-39-17	-18.497	1265250.106030
						倍面積	22.011203
						面積	11.0056015

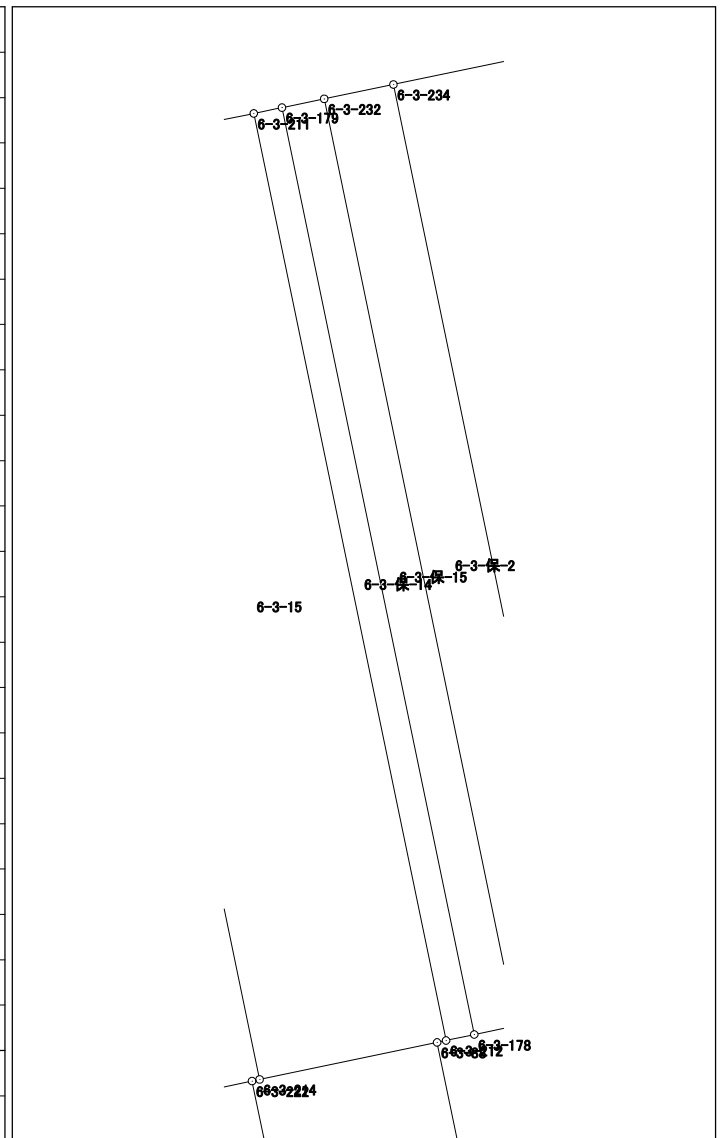

# 面積計算書（座標法）

世界測地系（測地成果2011）

所 在	地 番	公簿地目	現況地目	地 積	所 有 者
前橋市六供町一丁目	6-3-保-15			16.46 m <sup>2</sup>	

点 名	X 座標	Y 座標	辺 長	方 向 角	測 角	DX	倍 積 (Y×DX)
6-3-179	41807.808	-68406.286	19.010	168-16-43	90-00-13	-18.790	1285354.113940
6-3-178	41789.194	-68402.424	0.866	78-16-30	89-59-47	-18.438	1261203.893712
6-3-231	41789.370	-68401.576	19.010	348-16-43	90-00-13	18.790	-1285265.613040
6-3-232	41807.984	-68405.438	0.866	258-16-30	89-59-47	18.438	-1261259.465844
						倍面積	32.928768
						面 積	16.4643840

