



70-1 街区  
 70-2 街区  
 70-3 街区

# 画地出来形確認図

( 401.50 m<sup>2</sup> )  
 ( 0.94 m<sup>2</sup> )  
 ( 0.80 m<sup>2</sup> )

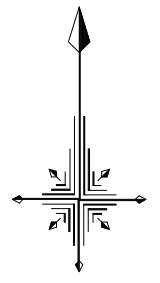

S=1/500

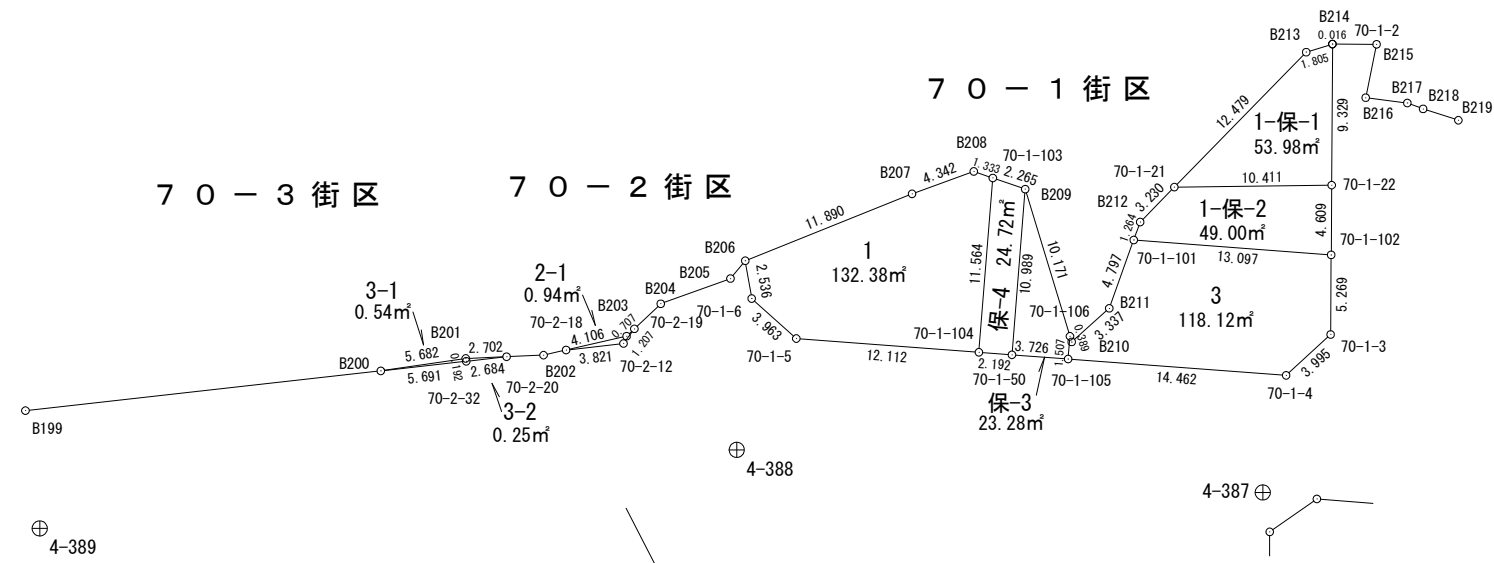

拡大図1/250

