



7 1 街区 画地出来形確認図 (1709.64m²)

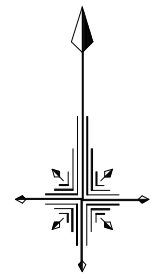

S=1/500

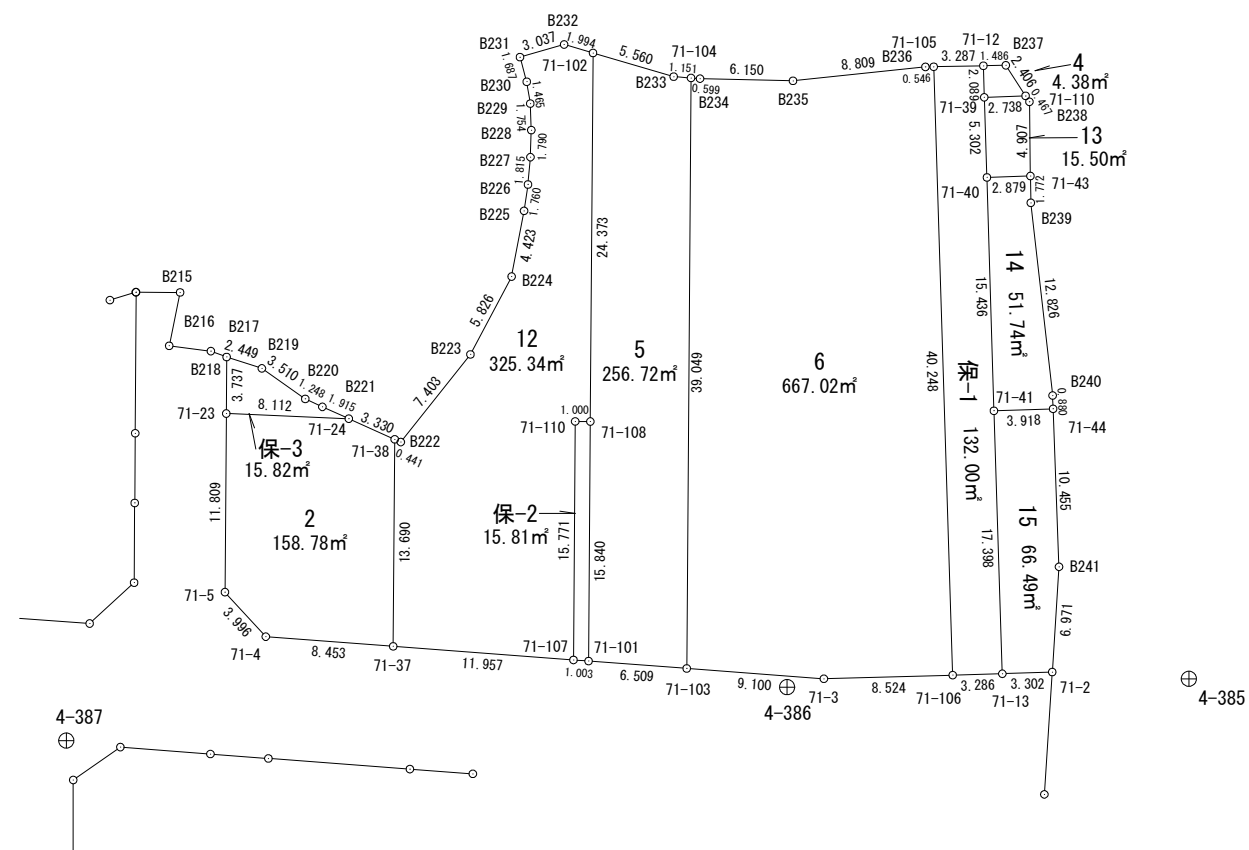


面積計算書（座標法）

所 在	地 番	公簿地目	現況地目	地 積	所 有 者
前橋市六供町一丁目	71-2			158.78 m ²	

点 名	X 座標	Y 座標	辺 長	方 向 角	測 角	DX	倍 積 (Y×DX)
71-23	41815.572	-68126.207	11.809	180-25-20	88-00-47	-11.468	781271.341876
71-5	41803.763	-68126.294	3.996	137-29-41	137-04-21	-14.755	1005203.467970
71-4	41800.817	-68123.594	8.453	94-20-56	136-51-15	-3.587	244359.331678
71-37	41800.176	-68115.165	13.690	0-25-07	86-04-11	13.049	-888834.788085
71-38	41813.866	-68115.065	3.330	294-12-07	113-47-00	15.055	-1025472.303575
71-24	41815.231	-68118.102	8.112	272-24-33	158-12-26	1.706	-116209.482012

倍面積	317.567852
面 積	158.7839260

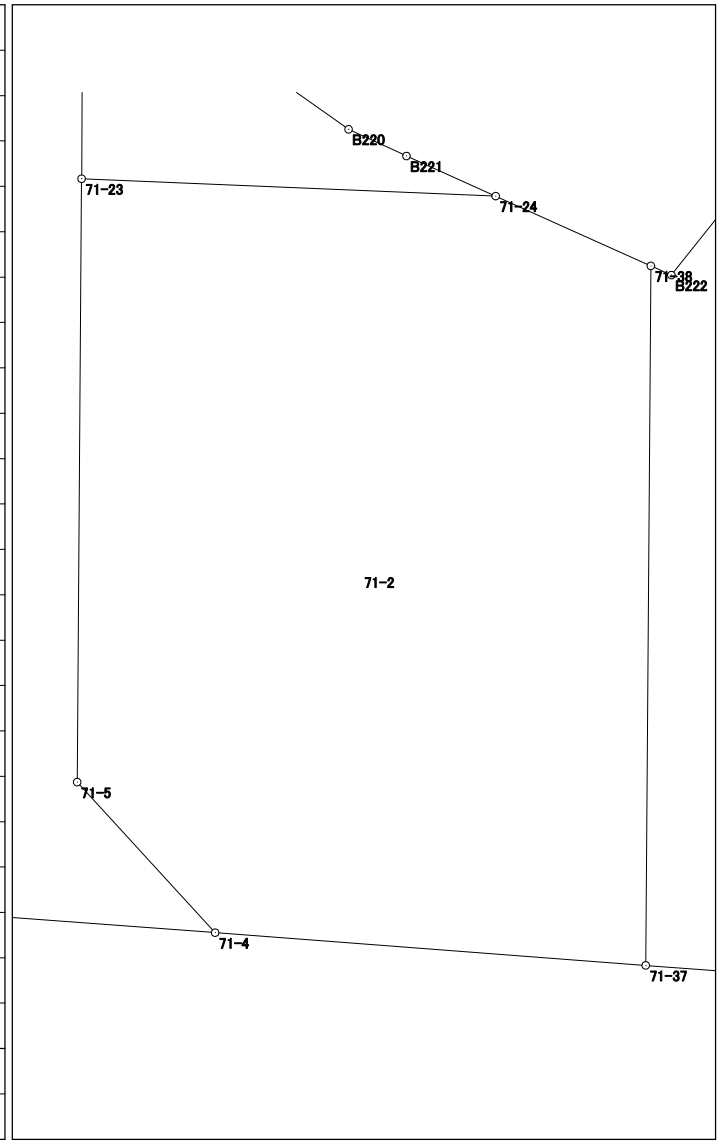


面積計算書（座標法）

世界測地系（測地成果2011）

所 在	地 番	公簿地目	現況地目	地 積	所 有 者
前橋市六供町一丁目	71-4			4.38 m ²	

点 名	X 座標	Y 座標	辺 長	方 向 角	測 角	DX	倍 積 (Y×DX)
71-12	41838.570	-68076.127	2.089	178-27-49	89-37-13	-2.118	144185.236986
71-39	41836.482	-68076.071	2.738	87-58-10	89-30-21	-1.991	135539.457361
71-110	41836.579	-68073.335	2.406	327-07-44	59-09-34	2.118	-144179.323530
B237	41838.600	-68074.641	1.486	268-50-36	121-42-52	1.991	-135536.610231
						倍面積	8.760586
						面 積	4.3802930

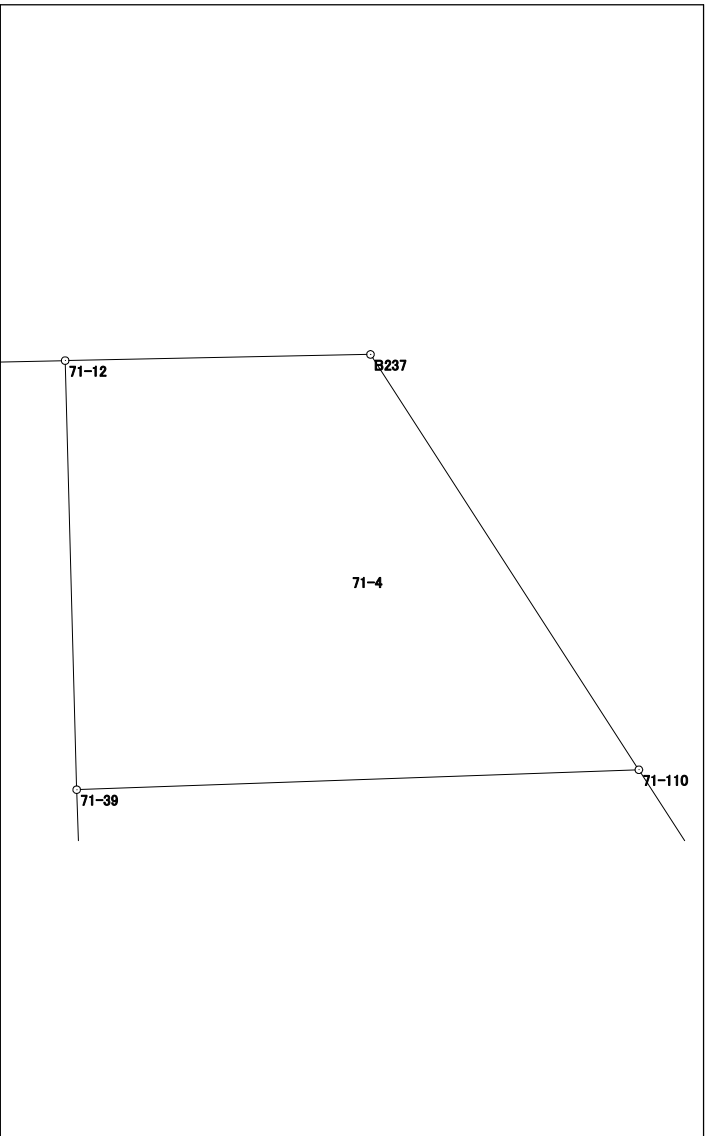


面積計算書 (座標法)

世界測地系 (測地成果2011)

所在	地番	公簿地目	現況地目	地積	所有者
前橋市六供町一丁目	71-5			256.72 m ²	

点名	X座標	Y座標	辺長	方向角	測角	DX	倍積 (Y×DX)
71-101	41799.203	-68102.242	6.509	94-17-58	93-52-48	-16.328	1111973.407376
71-103	41798.715	-68095.751	39.049	0-25-11	86-07-13	38.560	-2625772.158560
71-104	41837.763	-68095.465	1.151	274-20-02	93-54-51	39.135	-2664916.022775
B233	41837.850	-68096.613	5.560	286-20-56	192-00-54	1.652	-112495.604676
71-102	41839.415	-68101.948	24.373	180-25-06	74-04-10	-22.807	1553201.128036
71-108	41815.043	-68102.126	15.840	180-25-10	180-00-04	-40.212	2738522.690712
倍面積						513.440113	
面積						256.7200565	

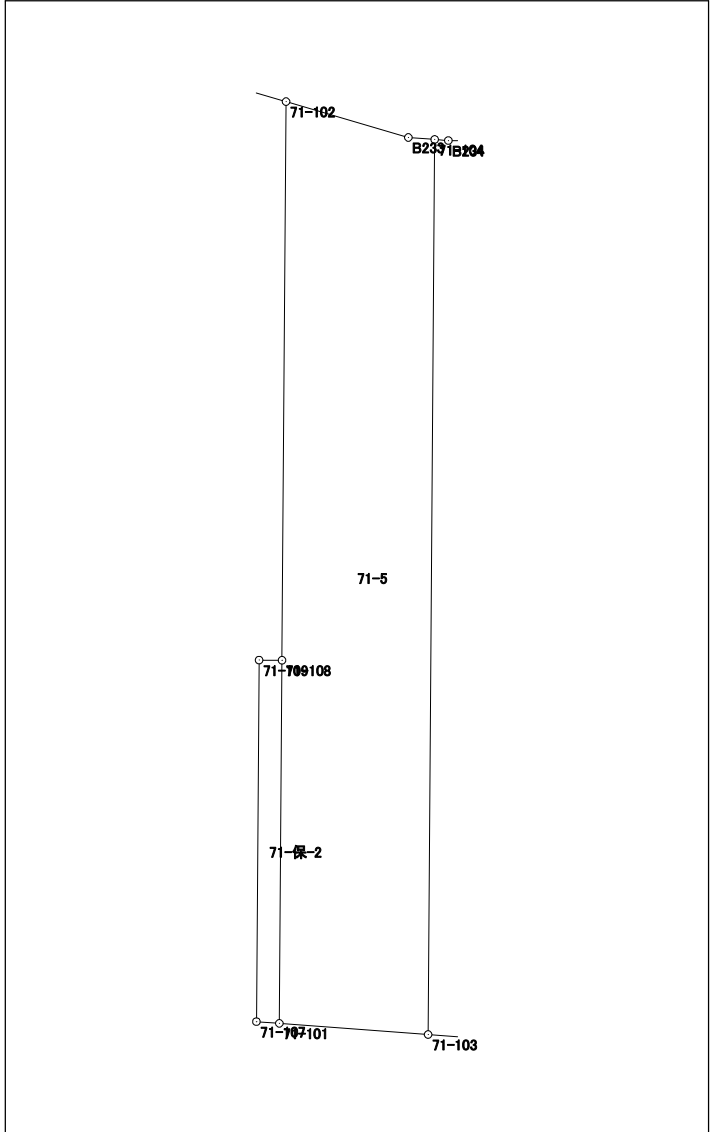


面積計算書 (座標法)

世界測地系 (測地成果2011)

所在	地番	公簿地目	現況地目	地積	所有者
前橋市六供町一丁目	71-6			667.02 m ²	

点名	X座標	Y座標	辺長	方向角	測角	DX	倍積 (Y×DX)
71-105	41838.502	-68079.413	0.546	269-03-20	90-50-43	40.219	-2738085.911447
B236	41838.493	-68079.959	8.809	264-00-19	174-56-59	-0.929	63246.281911
B235	41837.573	-68088.720	6.150	271-20-30	187-20-11	-0.776	52836.846720
B234	41837.717	-68094.868	0.599	274-24-22	183-03-52	0.190	-12938.024920
71-104	41837.763	-68095.465	39.049	180-25-11	86-00-49	-39.002	2655859.325930
71-103	41798.715	-68095.751	9.100	94-18-16	93-53-05	-39.731	2705512.282981
71-3	41798.032	-68086.677	8.524	88-22-24	174-04-08	-0.441	30026.224557
71-106	41798.274	-68078.156	40.248	358-12-37	89-50-13	40.470	-2755122.973320

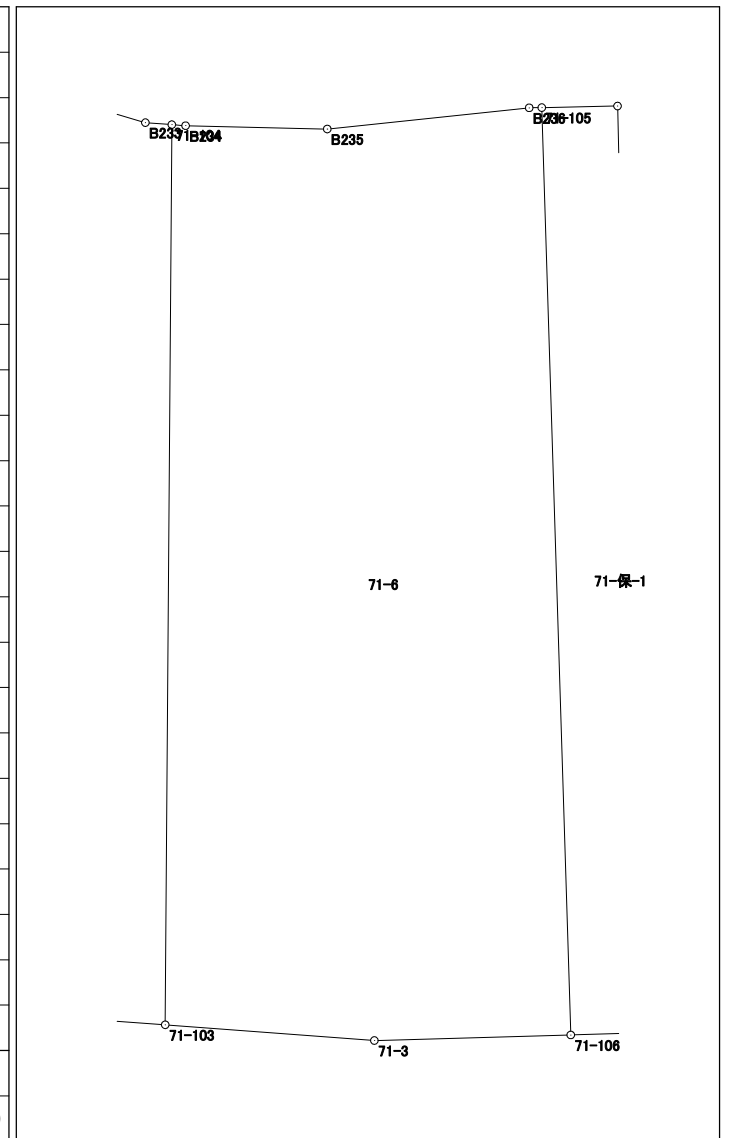

倍面積	1334.052412
面積	667.0262060


面積計算書 (座標法)

世界測地系 (測地成果2011)

所在	地番	公簿地目	現況地目	地積	所有者
前橋市六供町一丁目	71-12			325.34 m ²	

点名	X座標	Y座標	辺長	方向角	測角	Dx	倍積 (Y×Dx)
71-38	41813.866	-68115.065	13.690	180-25-07	66-10-44	-13.509	920166.413085
71-37	41800.176	-68115.165	11.957	94-18-26	93-53-19	-14.588	993664.027020
71-107	41799.278	-68103.242	15.771	0-25-17	86-06-51	14.873	-1012899.518266
71-109	41815.049	-68103.126	1.000	90-20-38	269-55-21	15.765	-1073645.781390
71-108	41815.043	-68102.126	24.373	0-25-06	90-04-28	24.366	-1659376.402116
71-102	41839.415	-68101.948	1.994	286-20-39	105-55-33	24.933	-1697985.869484
B232	41839.976	-68103.861	3.037	254-00-01	147-39-22	-0.276	18796.665636
B231	41839.139	-68106.780	1.687	164-35-45	90-35-44	-2.463	167746.999140
B230	41837.513	-68106.332	1.465	170-46-09	186-10-24	-3.072	209222.651904
B229	41836.067	-68106.097	1.754	177-48-40	187-02-31	-3.199	217871.404303
B228	41834.314	-68106.030	1.790	181-49-30	184-00-50	-3.542	241231.558260
B227	41832.525	-68106.087	1.815	185-10-59	183-21-29	-3.597	244977.594939
B226	41830.717	-68106.251	1.760	188-25-46	183-14-47	-3.549	241709.084799
B225	41828.976	-68106.509	4.423	190-43-23	182-17-37	-6.087	414564.320283
B224	41824.630	-68107.332	5.826	207-53-52	197-10-29	-9.495	646679.117340
B223	41819.481	-68110.058	7.403	218-28-03	190-34-11	-10.945	745464.584810
B222	41813.685	-68114.663	0.441	294-14-23	255-46-20	-5.615	382463.832745

倍面積	650.683008
面積	325.3415040

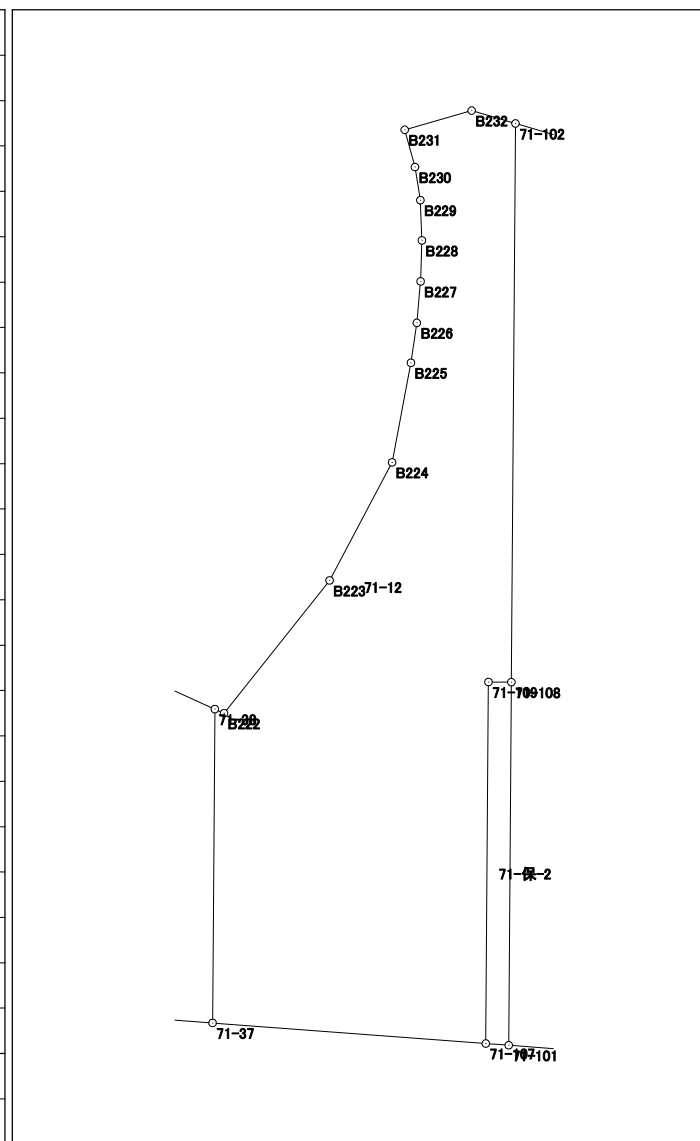


面積計算書（座標法）

世界測地系（測地成果2011）

所 在	地 番	公簿地目	現況地目	地 積	所 有 者
前橋市六供町一丁目	71-13			15.50 m ²	

点 名	X 座標	Y 座標	辺 長	方 向 角	測 角	DX	倍 積 (Y×DX)
71-39	41836.482	-68076.071	5.302	178-03-16	90-05-06	-5.396	367338.479116
71-40	41831.183	-68075.891	2.879	88-04-08	90-00-52	-5.202	354130.784982
71-43	41831.280	-68073.014	4.907	359-12-22	91-08-14	5.004	-340637.362056
B238	41836.187	-68073.082	0.467	327-09-41	147-57-19	5.299	-360719.261518
71-110	41836.579	-68073.335	2.738	267-58-10	120-48-29	0.295	-20081.633825
倍面積							31.006699
面 積							15.5033495

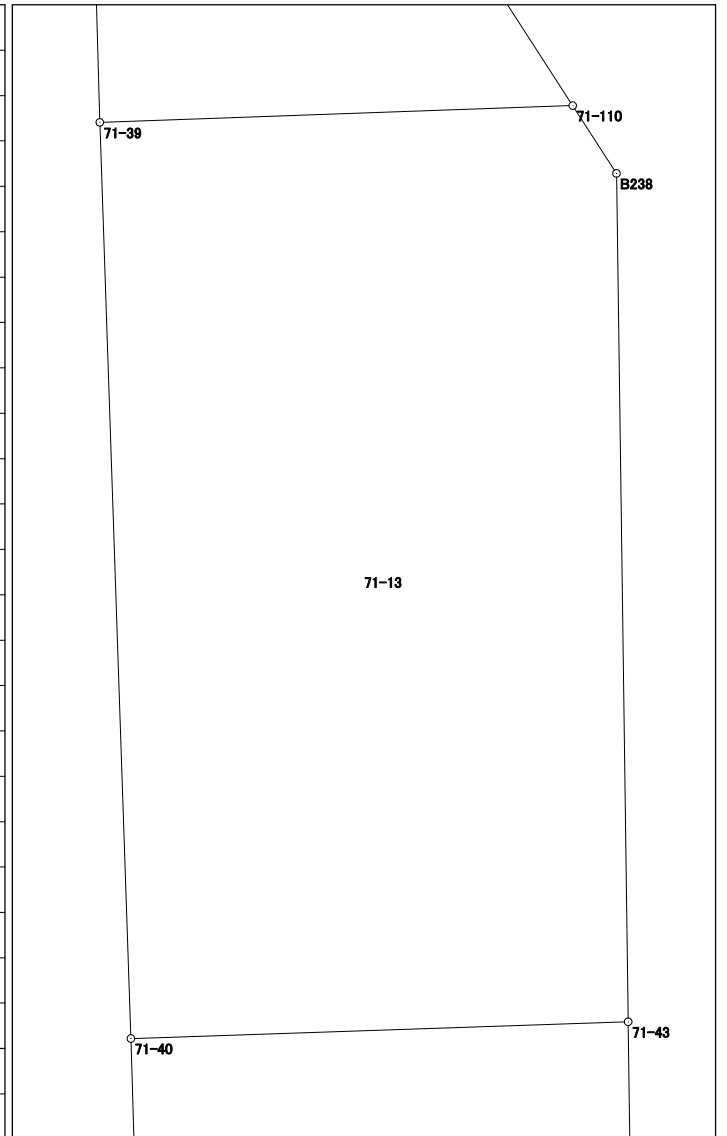


面積計算書 (座標法)

世界測地系 (測地成果2011)

所在	地番	公簿地目	現況地目	地積	所有者
前橋市六供町一丁目	71-14			51.74 m ²	

点名	X座標	Y座標	辺長	方向角	測角	DX	倍積 (Y×DX)	Diagram
71-40	41831.183	-68075.891	15.436	178-17-06	90-12-58	-15.526	1056946.283666	
71-41	41815.754	-68075.429	3.918	88-05-55	89-48-49	-15.299	1041485.988271	
71-44	41815.884	-68071.513	0.880	357-51-00	89-45-05	1.009	-68684.156617	
B240	41816.763	-68071.546	12.826	353-32-26	175-41-26	13.624	-927406.742704	
B239	41829.508	-68072.989	1.772	359-11-30	185-39-04	14.517	-988215.581313	
71-43	41831.280	-68073.014	2.879	268-04-08	88-52-38	1.675	-114022.298450	
								Diagram
倍面積							103.492853	Diagram
面積							51.7464265	

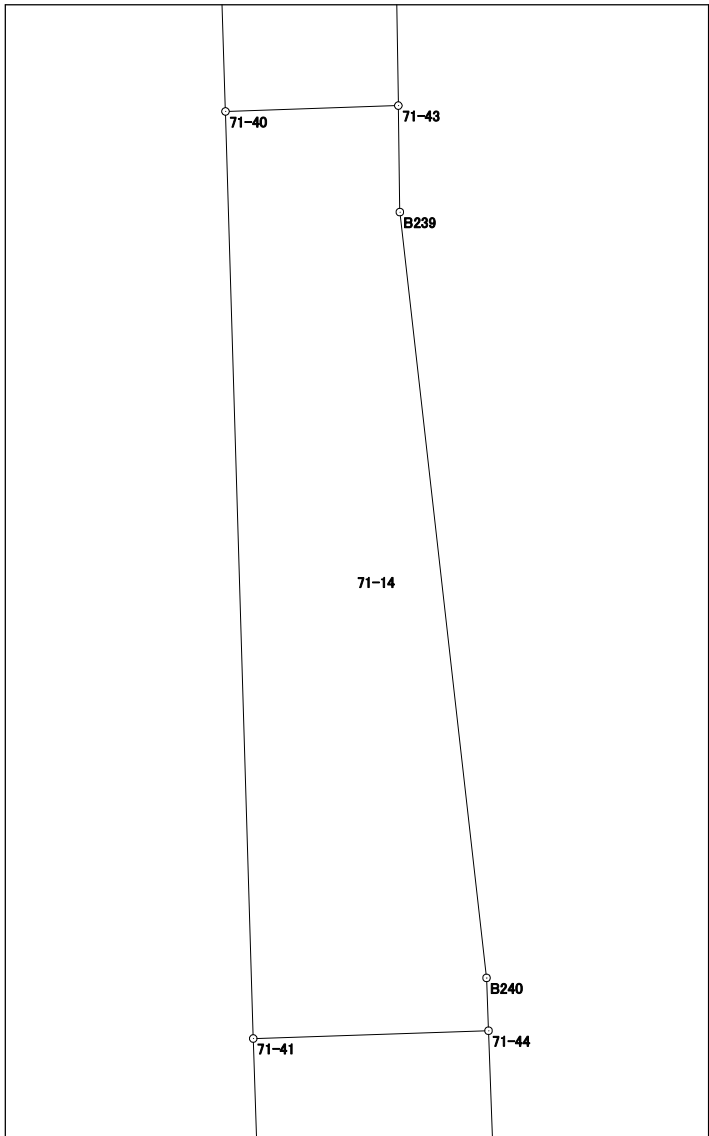


面積計算書 (座標法)

世界測地系 (測地成果2011)

所 在	地 番	公簿地目	現況地目	地 積	所 有 者
前橋市六供町一丁目	71-15			66.49 m ²	

点 名	X 座標	Y 座標	辺 長	方 向 角	測 角	DX	倍 積 (Y×DX)
71-41	41815.754	-68075.429	17.398	178-09-43	90-03-48	-17.519	1192613.440651
71-13	41798.365	-68074.871	3.302	88-01-17	89-51-34	-17.275	1175993.396525
71-2	41798.479	-68071.571	6.971	3-41-04	95-39-47	7.071	-481334.078541
B241	41805.436	-68071.123	10.455	357-51-44	174-10-40	17.405	-1184777.895815
71-44	41815.884	-68071.513	3.918	268-05-55	90-14-11	10.318	-702361.871134
						倍面積	132.991686
						面 積	66.4958430

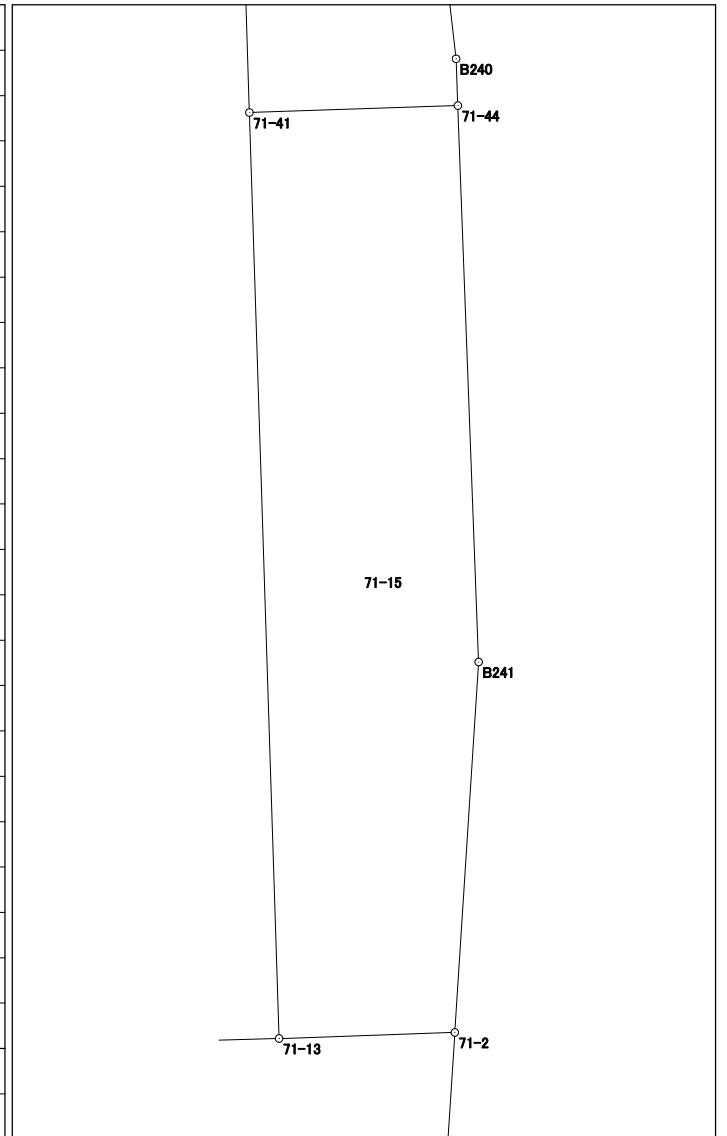

面積計算書（座標法）

世界測地系（測地成果2011）

所在	地番	公簿地目	現況地目	地積	所有者
前橋市六供町一丁目	71-保-2			15.81 m ²	

点名	X座標	Y座標	辺長	方向角	測角	DX	倍積 (Y×DX)
71-108	41815.043	-68102.126	1.000	270-20-38	89-55-28	15.846	-1079146.288596
71-109	41815.049	-68103.126	15.771	180-25-17	90-04-39	-15.765	1073645.781390
71-107	41799.278	-68103.242	1.003	94-17-21	93-52-04	-15.846	1079163.972732
71-101	41799.203	-68102.242	15.840	0-25-10	86-07-49	15.765	-1073631.845130

倍面積	31.620396
面積	15.8101980

