



72-1 街区
72-2 街区

画地出来形確認図

(1401.56m²)
(2861.54m²)

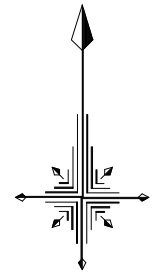

S=1/500

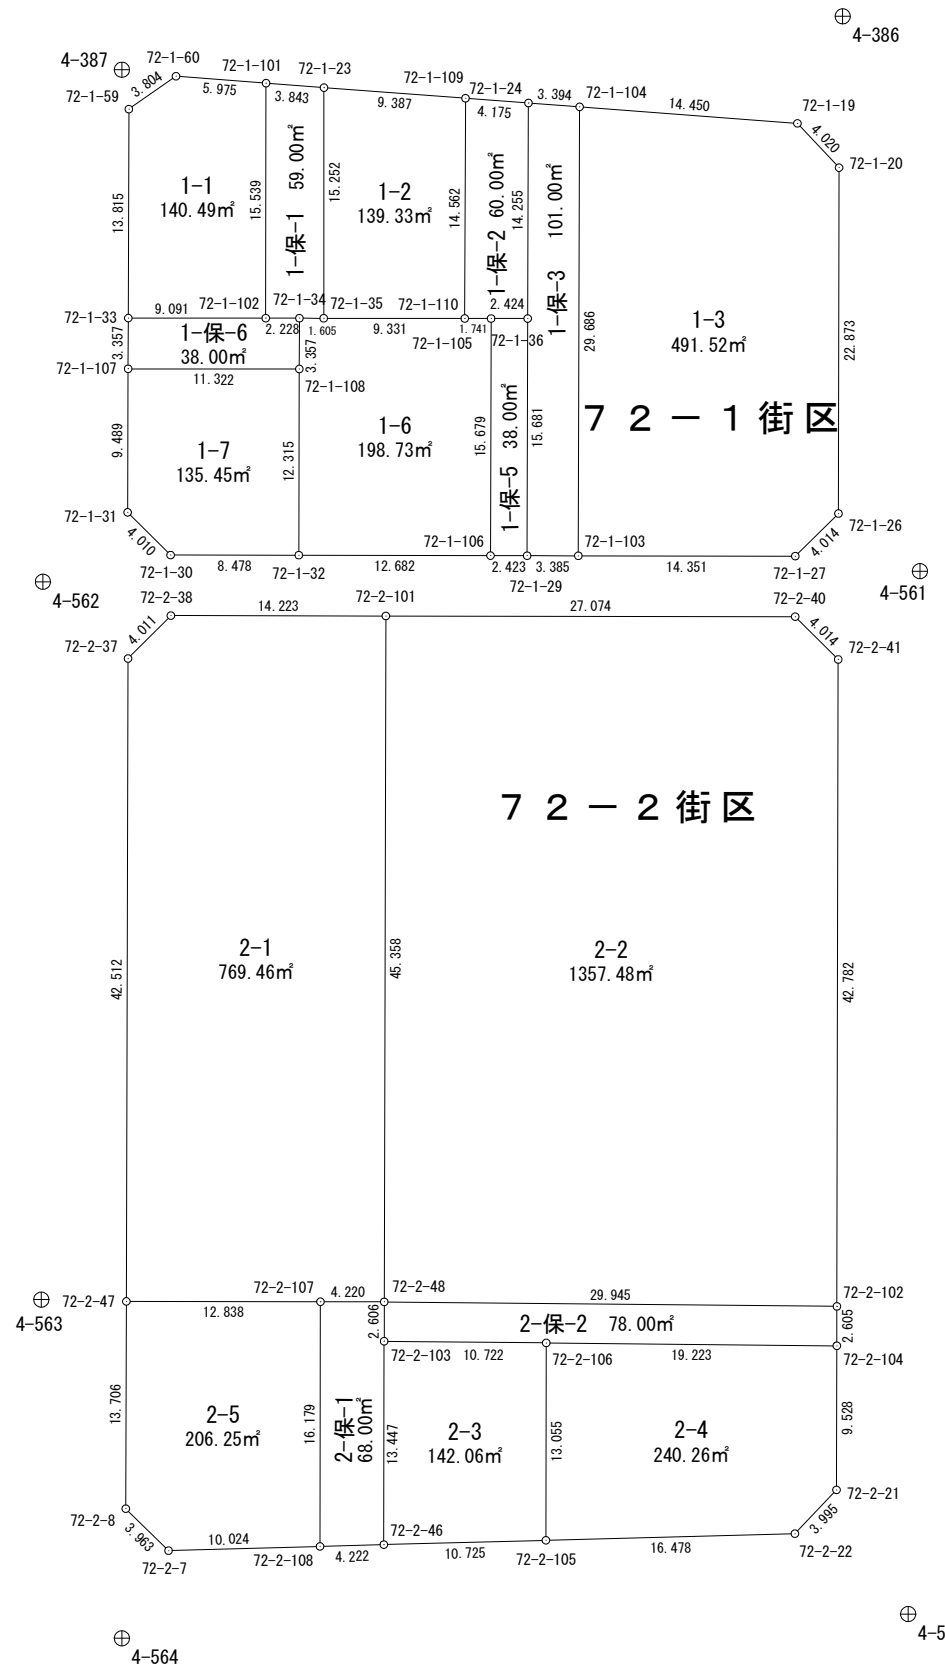


面積計算書 (座標法)

世界測地系 (測地成果2011)

所在	地番	公簿地目	現況地目	地積	所有者
前橋市六供町一丁目	72-1-1			140.49 m ²	

点名	X座標	Y座標	辺長	方向角	測角	DX	倍積 (Y×DX)
72-1-101	41793.057	-68127.254	5.975	274-23-47	94-19-08	15.997	-1089831.682238
72-1-60	41793.515	-68133.211	3.804	235-06-24	140-42-37	-1.718	117052.856498
72-1-59	41791.339	-68136.331	13.815	180-08-43	125-02-19	-15.991	1089568.069021
72-1-33	41777.524	-68136.366	9.091	90-02-16	89-53-33	-13.821	941712.714486
72-1-102	41777.518	-68127.275	15.539	0-04-39	90-02-23	15.533	-1058220.962575
						倍面積	280.995192
						面積	140.4975960

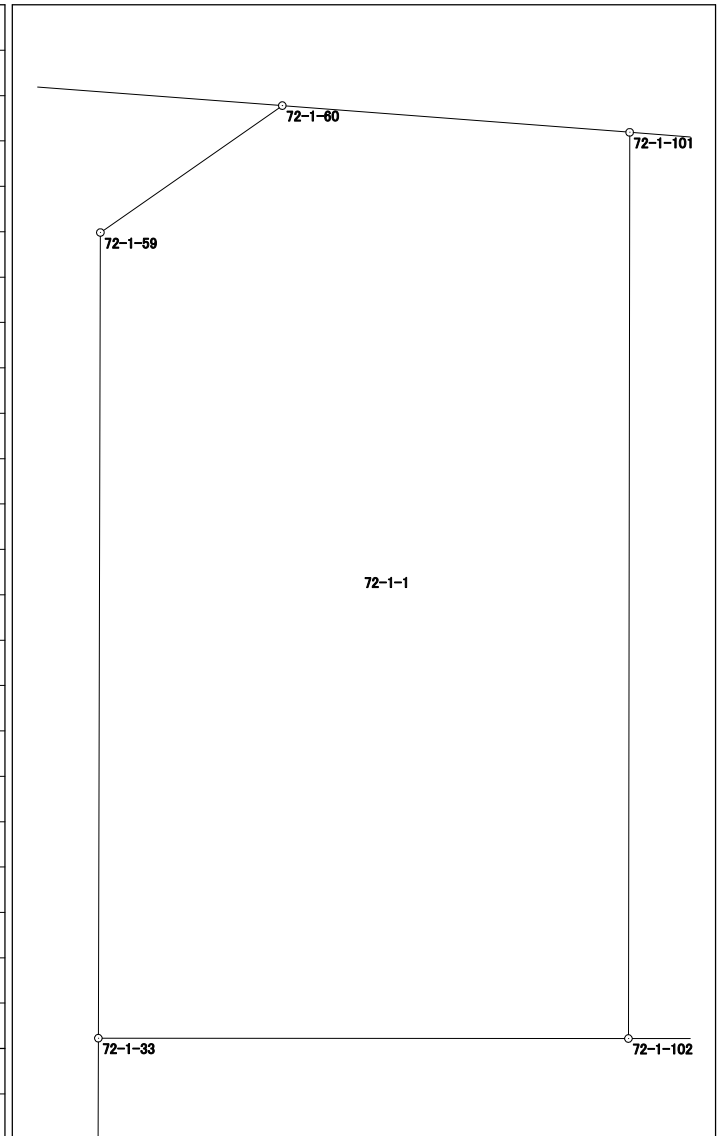


面積計算書 (座標法)

世界測地系 (測地成果2011)

所在	地番	公簿地目	現況地目	地積	所有者
前橋市六供町一丁目	72-1-2			139.33 m ²	

点名	X 座標	Y 座標	辺長	方向角	測角	DX	倍積 (Y×DX)
72-1-109	41792.059	-68114.061	9.387	274-17-41	94-05-53	15.265	-1039761.141165
72-1-23	41792.762	-68123.422	15.252	180-04-30	85-46-49	-14.549	991127.666678
72-1-35	41777.510	-68123.442	9.331	90-04-47	90-00-17	-15.265	1039904.342130
72-1-110	41777.497	-68114.111	14.562	0-11-48	90-07-01	14.549	-990992.200939

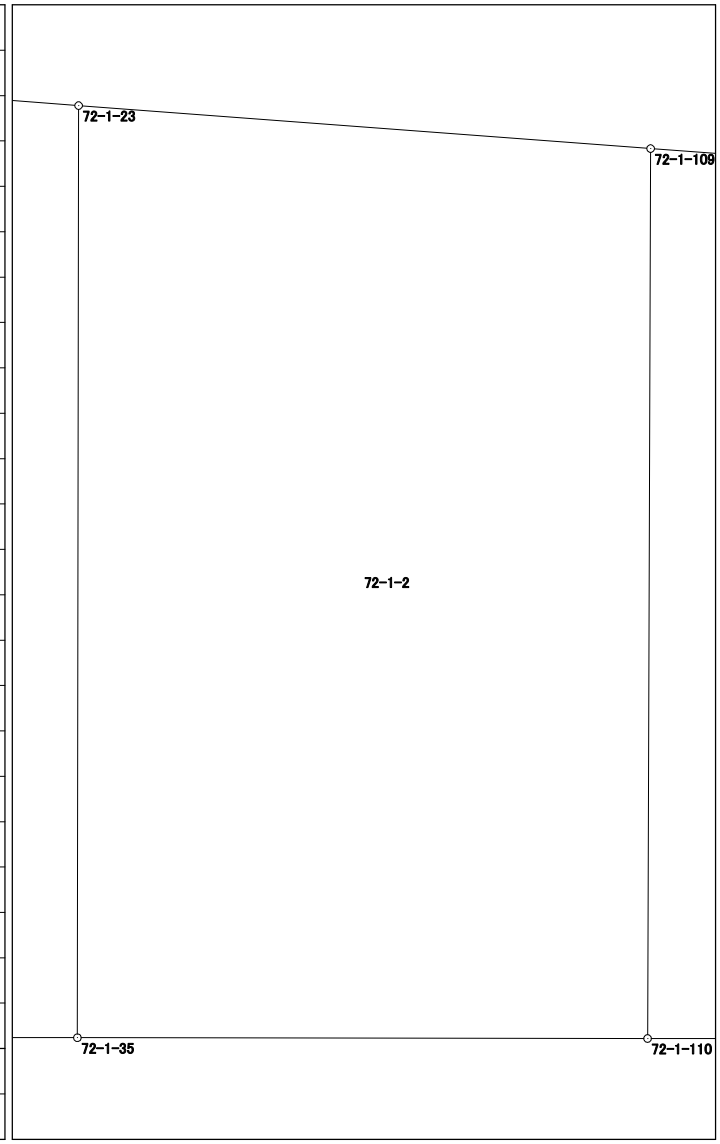


倍面積	278.666704
面積	139.3333520

面積計算書 (座標法)

世界測地系 (測地成果2011)

所 在	地 番	公簿地目	現況地目	地 積	所 有 者
前橋市六供町一丁目	72-1-3			491.52 m ²	

点 名	X 座標	Y 座標	辺 長	方 向 角	測 角	DX	倍 積 (Y×DX)
72-1-103	41761.804	-68106.600	14.351	90-05-45	89-55-47	-29.710	2023447.086000
72-1-27	41761.780	-68092.249	4.014	45-25-26	135-19-41	2.793	-190181.651457
72-1-26	41764.597	-68089.390	22.873	0-05-43	134-40-17	25.690	-1749216.429100
72-1-20	41787.470	-68089.352	4.020	316-46-27	136-40-44	25.802	-1756841.460304
72-1-19	41790.399	-68092.105	14.450	274-19-48	137-33-21	4.020	-273730.262100
72-1-104	41791.490	-68106.514	29.686	180-09-58	85-50-10	-28.595	1947505.767830
						倍面積	983.050869
						面 積	491.5254345

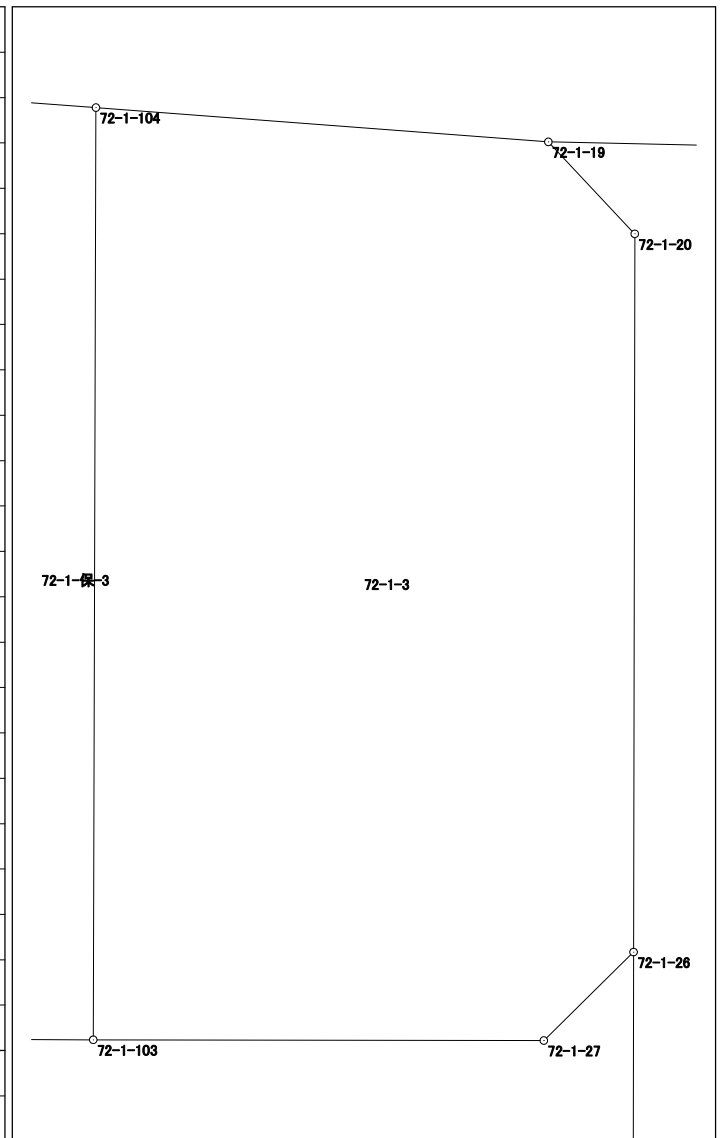


面積計算書 (座標法)

世界測地系 (測地成果2011)

所在	地番	公簿地目	現況地目	地積	所有者
前橋市六供町一丁目	72-1-6			198.73 m ²	

点名	X座標	Y座標	辺長	方向角	測角	DX	倍積 (Y×DX)
72-1-105	41777.494	-68112.370	1.741	270-05-55	89-57-35	15.682	-1068138.186340
72-1-110	41777.497	-68114.111	9.331	270-04-47	179-58-52	0.016	-1089.825776
72-1-35	41777.510	-68123.442	1.605	270-12-51	180-08-04	0.019	-1294.345398
72-1-34	41777.516	-68125.047	3.357	180-09-13	89-56-22	-3.351	228287.032497
72-1-108	41774.159	-68125.056	12.315	180-09-29	180-00-16	-15.672	1067655.877632
72-1-32	41761.844	-68125.090	12.682	90-07-52	89-58-23	-12.344	840936.110960
72-1-106	41761.815	-68112.408	15.679	0-08-20	90-00-28	15.650	-1065959.185200
						倍面積	397.478375
						面積	198.7391875

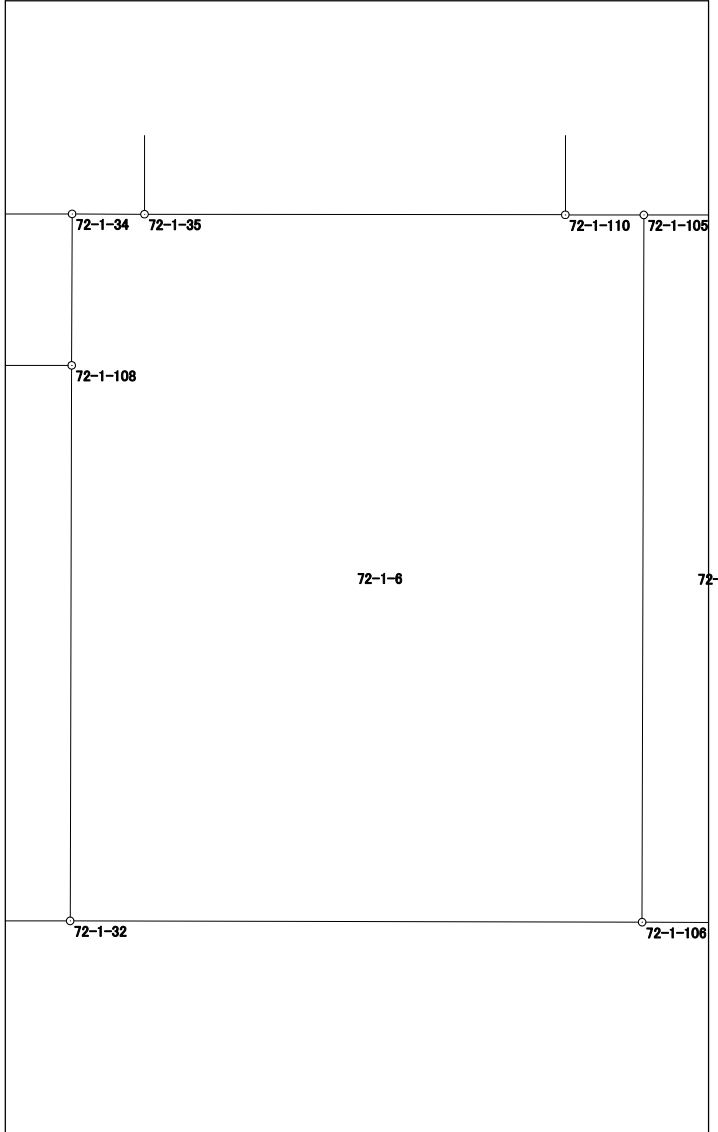


面積計算書 (座標法)

世界測地系 (測地成果2011)

所在	地番	公簿地目	現況地目	地積	所有者
前橋市六供町一丁目	72-1-7			135.45 m ²	

点名	X座標	Y座標	辺長	方向角	測角	DX	倍積(Y×DX)
72-1-107	41774.167	-68136.378	9.489	180-12-19	90-09-53	-9.481	646000.999818
72-1-31	41764.678	-68136.412	4.010	134-49-42	134-37-23	-12.316	839168.050192
72-1-30	41761.851	-68133.568	8.478	90-02-50	135-13-08	-2.834	193090.531712
72-1-32	41761.844	-68125.090	12.315	0-09-29	90-06-39	12.308	-838483.607720
72-1-108	41774.159	-68125.056	11.322	270-02-26	89-52-57	12.323	-839505.065088

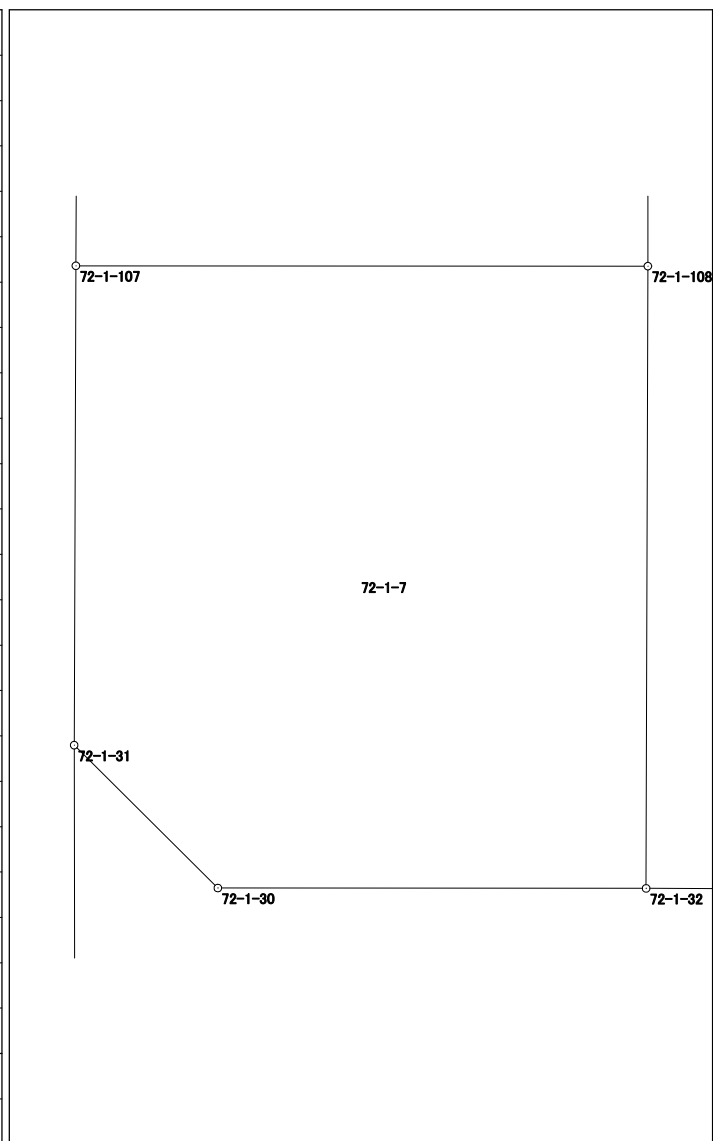


倍面積	270.908914
面積	135.4544570

面積計算書 (座標法)

世界測地系 (測地成果2011)

所在	地番	公簿地目	現況地目	地積	所有者
前橋市六供町一丁目	72-1-保-1			59.00 m ²	

点名	X座標	Y座標	辺長	方向角	測角	DX	倍積 (Y×DX)
72-1-35	41777.510	-68123.442	15.252	0-04-30	89-51-39	15.246	-1038609.996732
72-1-23	41792.762	-68123.422	3.843	274-24-08	94-19-38	15.547	-1059114.841834
72-1-101	41793.057	-68127.254	15.539	180-04-39	85-40-31	-15.244	1038531.859976
72-1-102	41777.518	-68127.275	2.228	90-03-05	89-58-26	-15.541	1058765.980775
72-1-34	41777.516	-68125.047	1.605	90-12-51	180-09-46	-0.008	545.000376
						倍面積	118.002561
						面積	59.0012805

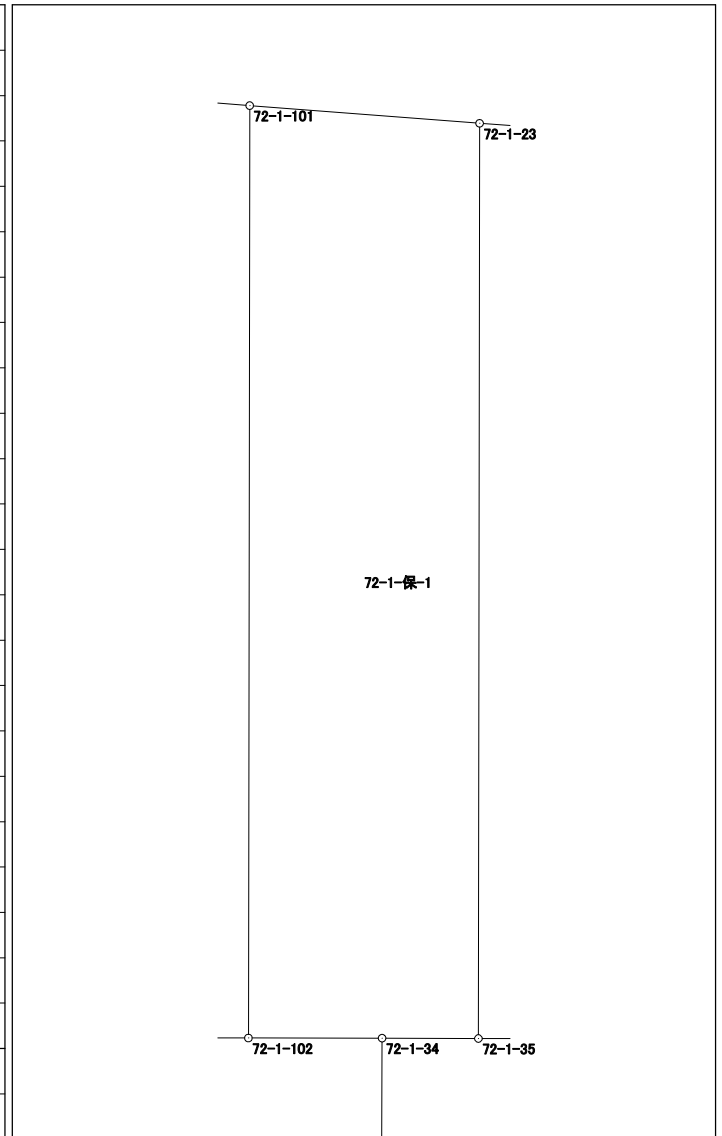


面積計算書（座標法）

世界測地系（測地成果2011）

所在	地番	公簿地目	現況地目	地積	所有者
前橋市六供町一丁目	72-1-保-2			60.00 m ²	

点名	X座標	Y座標	辺長	方向角	測角	DX	倍積 (Y×DX)
72-1-36	41777.491	-68109.946	14.255	0-11-35	90-07-20	14.252	-970702.950392
72-1-24	41791.746	-68109.898	4.175	274-17-59	94-06-24	14.568	-992224.994064
72-1-109	41792.059	-68114.061	14.562	180-11-48	85-53-49	-14.249	970557.255189
72-1-110	41777.497	-68114.111	1.741	90-05-55	89-54-07	-14.565	992082.026715
72-1-105	41777.494	-68112.370	2.424	90-04-15	179-58-20	-0.006	408.674220
						倍面積	120.011668
						面積	60.0058340

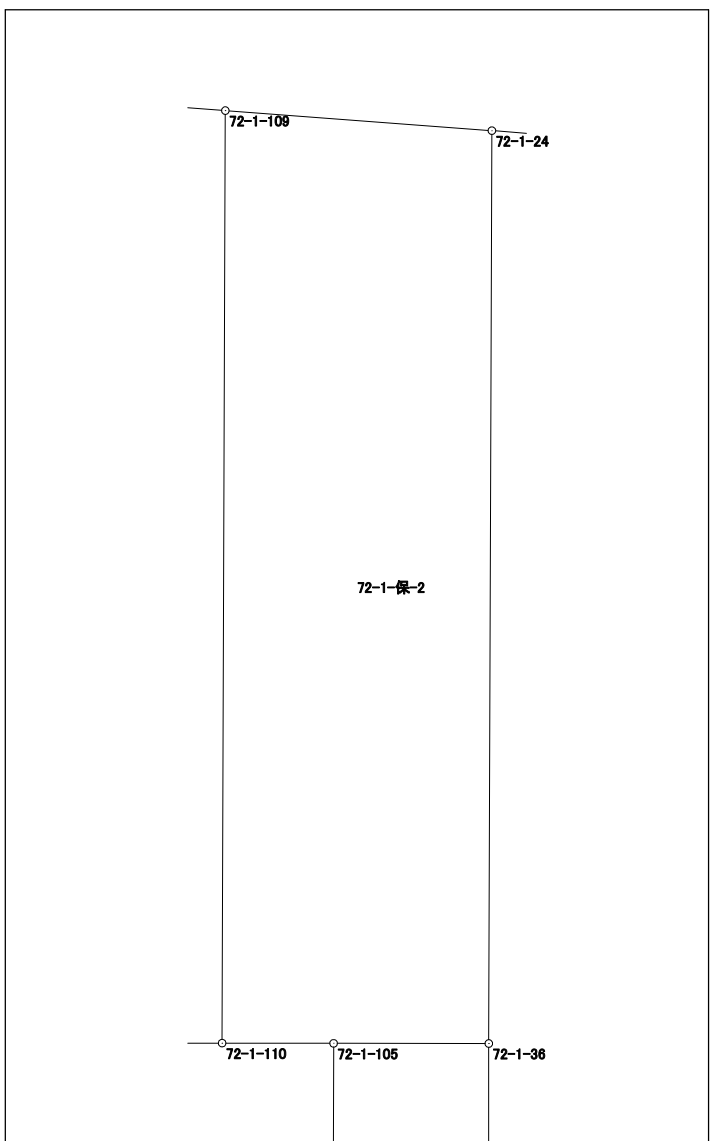


面積計算書（座標法）

世界測地系（測地成果2011）

所在	地番	公簿地目	現況地目	地積	所有者
前橋市六供町一丁目	72-1-保-3			101.00 m ²	

点名	X座標	Y座標	辺長	方向角	測角	DX	倍積 (Y×DX)
72-1-36	41777.491	-68109.946	15.681	180-08-33	179-56-58	-29.936	2038939.343456
72-1-29	41761.810	-68109.985	3.385	90-06-06	89-57-33	-15.687	1068441.334695
72-1-103	41761.804	-68106.600	29.686	0-09-58	90-03-52	29.680	-2021403.888000
72-1-104	41791.490	-68106.514	3.394	274-19-34	94-09-36	29.942	-2039245.242188
72-1-24	41791.746	-68109.898	14.255	180-11-35	85-52-01	-13.999	953470.462102
						倍面積	202.010065
						面積	101.0050325

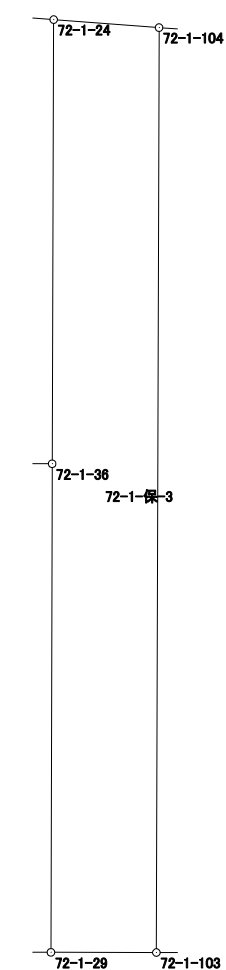


面積計算書（座標法）

世界測地系（測地成果2011）

所 在	地 番	公簿地目	現況地目	地 積	所 有 者
前橋市六供町一丁目	72-1-保-5			38.00 m ²	

点 名	X 座 標	Y 座 標	辺 長	方 向 角	測 角	DX	倍 積 (Y×DX)
72-1-29	41761.810	-68109.985	15.681	0-08-33	90-01-27	15.676	-1067692.124860
72-1-36	41777.491	-68109.946	2.424	270-04-15	89-55-42	15.684	-1068236.393064
72-1-105	41777.494	-68112.370	15.679	180-08-20	90-04-05	-15.676	1067729.512120
72-1-106	41761.815	-68112.408	2.423	90-07-06	89-58-46	-15.684	1068275.007072

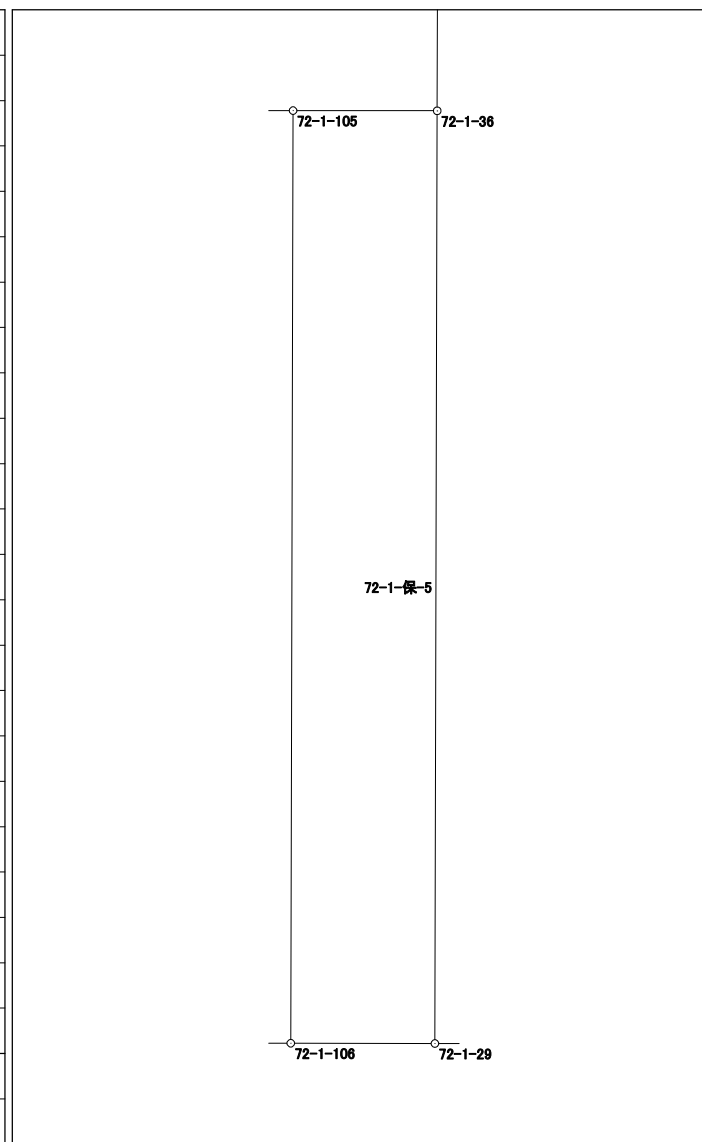

倍面積	76.001268
面 積	38.0006340

