



7 3 街区 画地出来形確認図 (5602.88㎡)

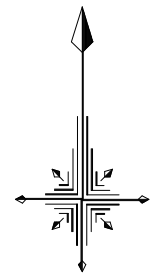

S=1/500

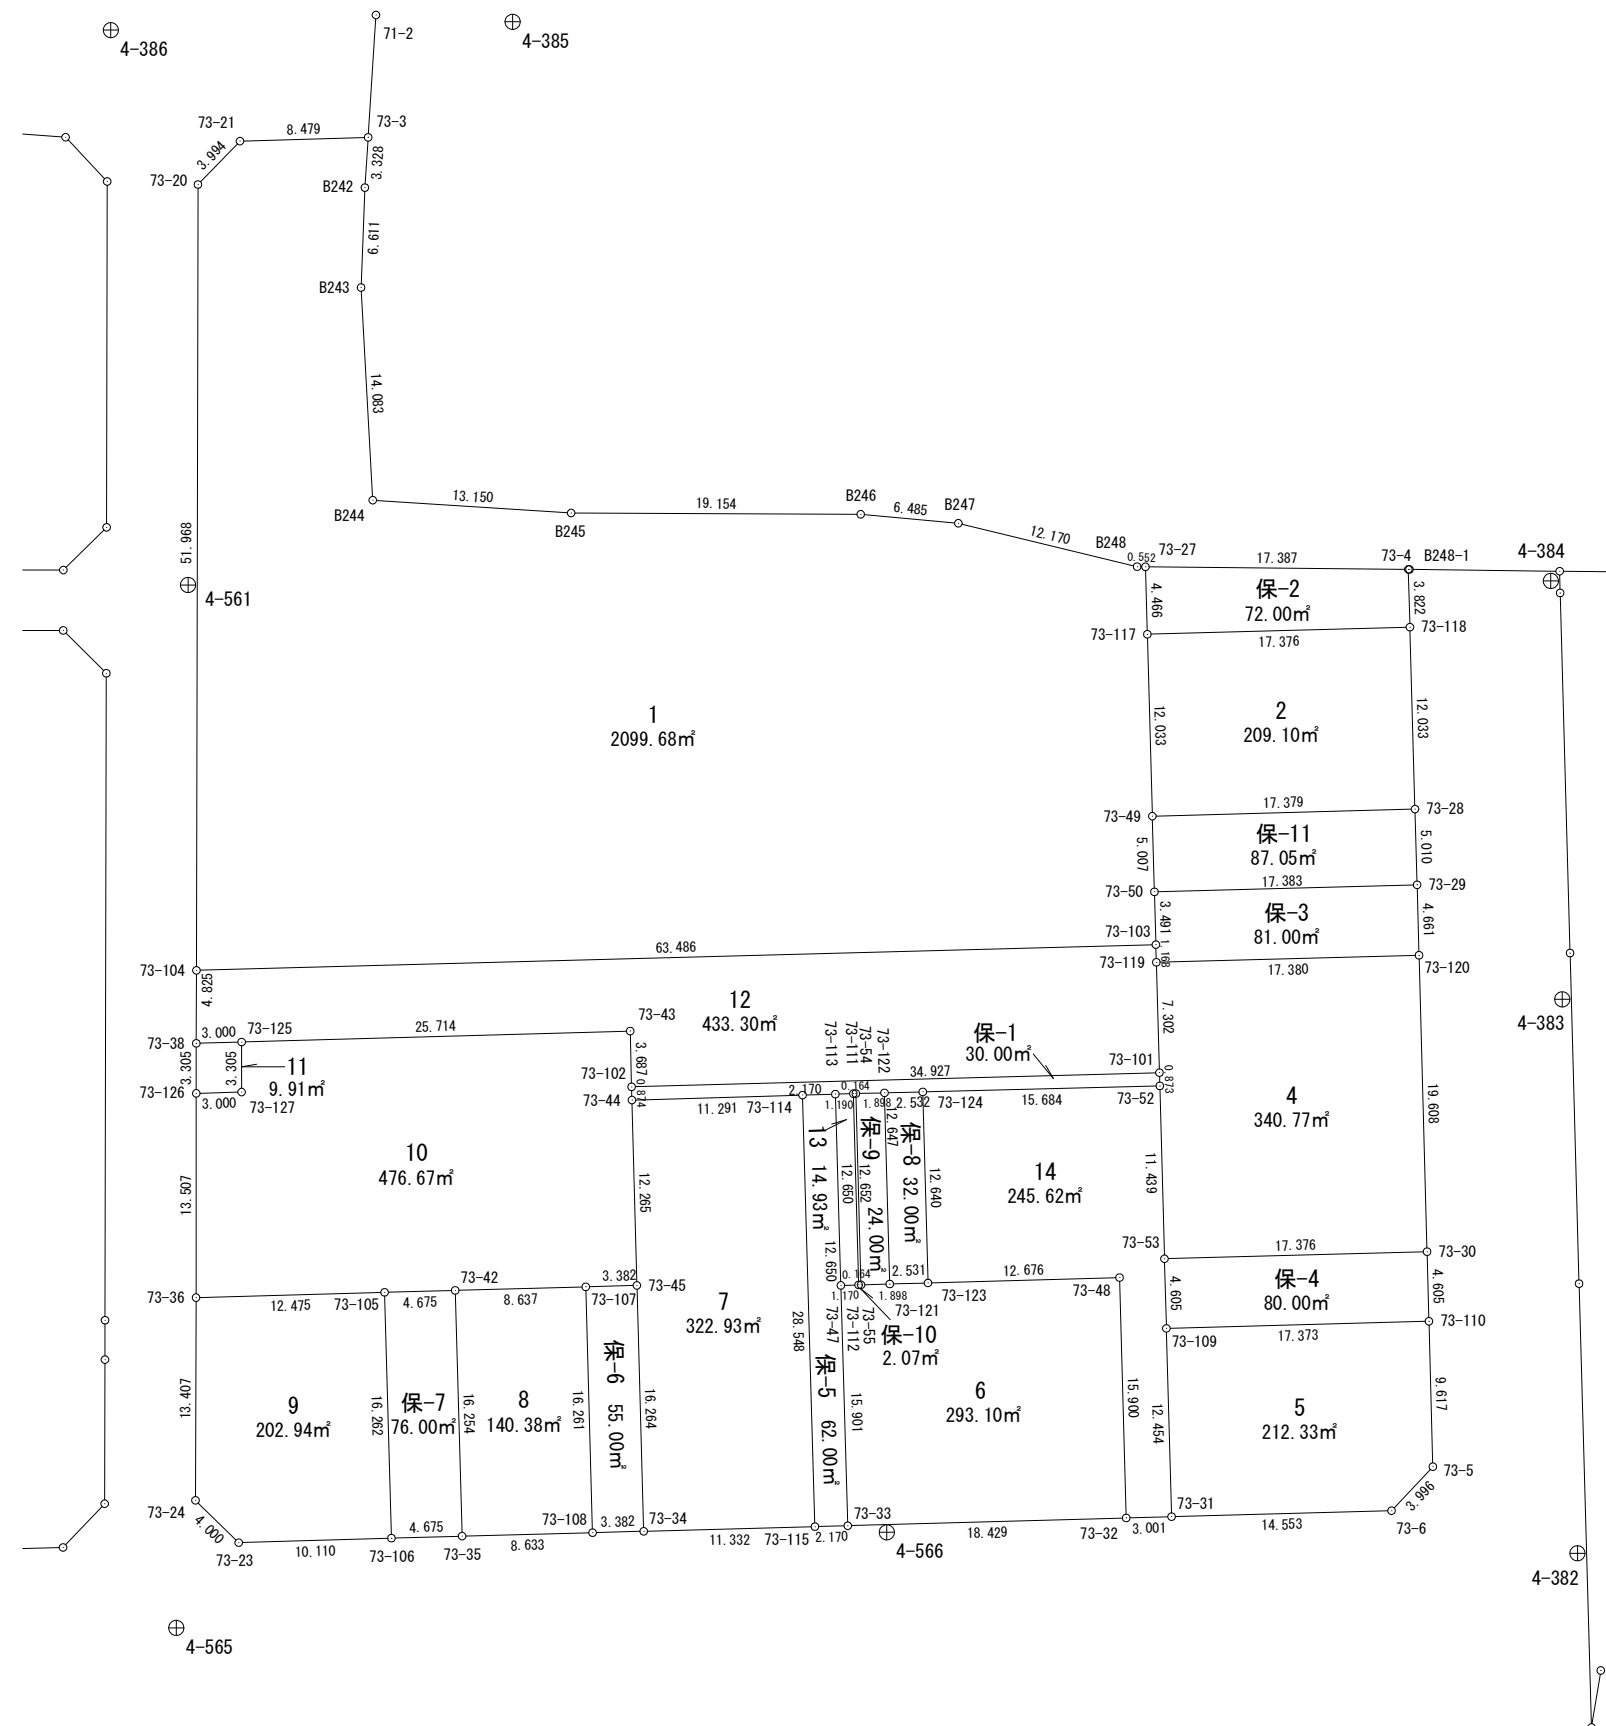


面積計算書（座標法）

世界測地系（測地成果2011）

所 在	地 番	公簿地目	現況地目	地 積	所 有 者
前橋市六供町一丁目	73-1			2099.68 m ²	

点 名	X 座標	Y 座標	辺 長	方 向 角	測 角	DX	倍 積 (Y×DX)
73-103	41737.005	-68019.985	3.491	358-25-28	89-57-42	5.193	-353227.782105
73-50	41740.495	-68020.081	5.007	358-26-37	180-01-09	8.495	-577830.588095
73-49	41745.500	-68020.217	12.033	358-25-08	179-58-31	17.033	-1158588.356161
73-117	41757.528	-68020.549	4.466	358-25-18	180-00-10	16.492	-1121794.894108
73-27	41761.992	-68020.672	0.552	270-37-22	92-12-04	4.470	-304052.403840
B248	41761.998	-68021.224	12.170	283-39-01	193-01-39	2.878	-195765.082672
B247	41764.870	-68033.050	6.485	275-14-47	171-35-46	3.465	-235734.518250
B246	41765.463	-68039.508	19.154	270-15-15	175-00-28	0.678	-46130.786424
B245	41765.548	-68058.662	13.150	273-42-06	183-26-51	0.934	-63566.790308
B244	41766.397	-68071.785	14.083	356-50-58	263-08-52	14.911	-1015018.386135
B243	41780.459	-68072.559	6.611	2-11-36	185-20-38	20.668	-1406923.649412
B242	41787.065	-68072.306	3.328	3-41-13	181-29-37	9.927	-675753.781662
73-3	41790.386	-68072.092	8.479	268-19-50	84-38-37	3.074	-209253.610808
73-21	41790.139	-68080.567	3.994	224-05-13	135-45-23	-3.116	212139.046772
73-20	41787.270	-68083.346	51.968	180-06-45	136-01-32	-54.837	3733486.444602
73-104	41735.302	-68083.448	63.486	88-27-46	88-21-01	-50.265	3422214.513720

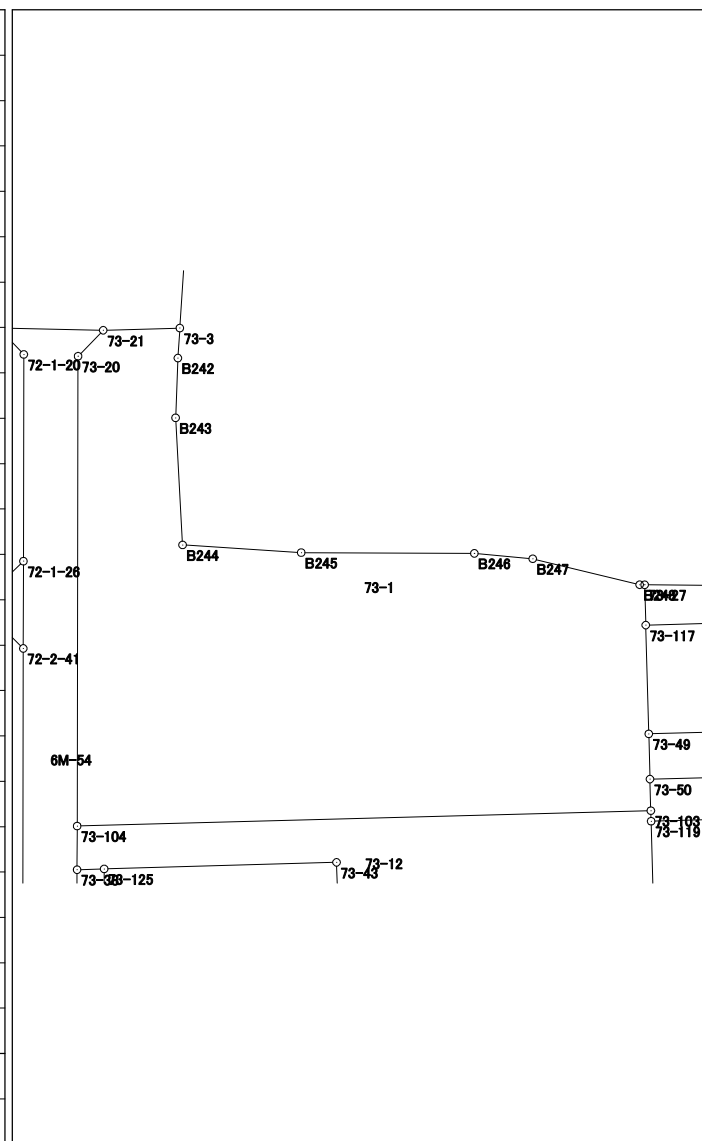


倍面積	4199.375114
面 積	2099.6875570

面積計算書（座標法）

世界測地系（測地成果2011）

所 在	地 番	公簿地目	現況地目	地 積	所 有 者
前橋市六供町一丁目	73-2			209.10 m ²	

点 名	X 座標	Y 座標	辺 長	方 向 角	測 角	DX	倍 積 (Y×DX)
73-117	41757.528	-68020.549	12.033	178-25-08	89-57-56	-12.497	850052.800853
73-49	41745.500	-68020.217	17.379	88-27-13	90-02-05	-11.559	786245.688303
73-28	41745.969	-68002.844	12.033	358-24-17	89-57-04	12.497	-849831.541468
73-118	41757.997	-68003.179	17.376	268-27-12	90-02-55	11.559	-786048.746061

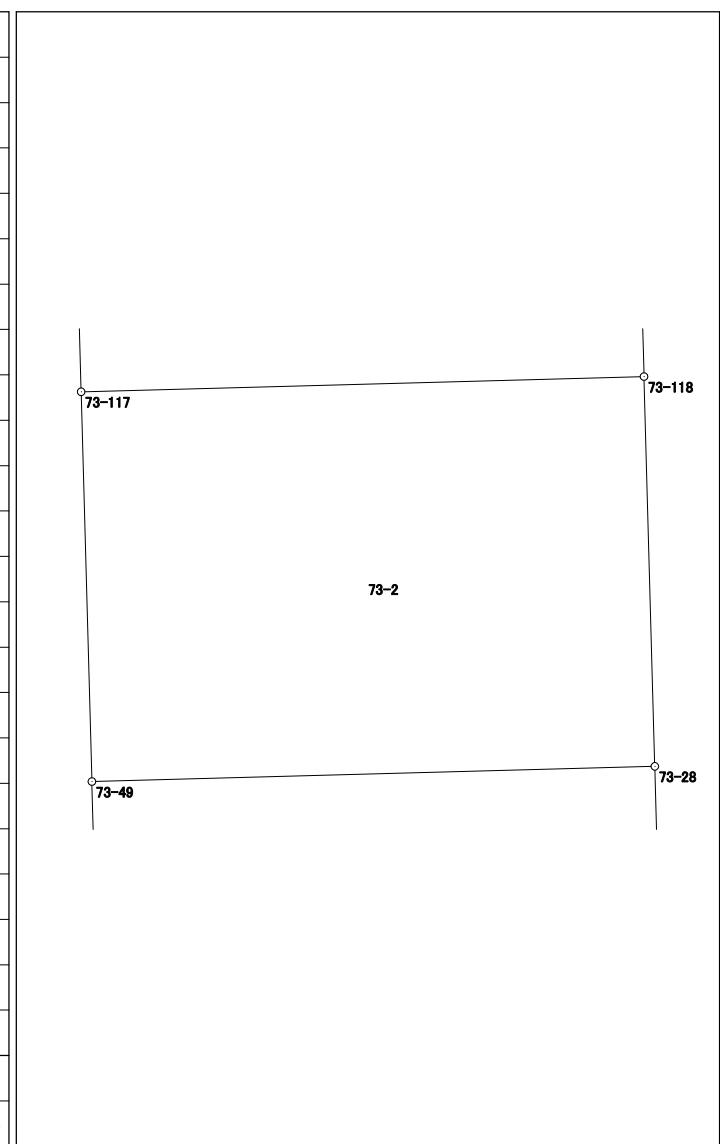


倍面積	418.201627
面 積	209.1008135

面積計算書 (座標法)

所在	地番	公簿地目	現況地目	地積	所有者
前橋市六供町一丁目	73-4			340.77 m ²	

点名	X座標	Y座標	辺長	方向角	測角	DX	倍積 (Y×DX)
73-119	41735.837	-68019.952	7.302	178-24-25	89-56-24	-7.764	528106.907328
73-101	41728.538	-68019.749	0.873	178-25-31	180-01-06	-8.172	555857.388828
73-52	41727.665	-68019.725	11.439	178-27-08	180-01-37	-12.308	837186.775300
73-53	41716.230	-68019.416	17.376	88-26-48	89-59-40	-10.964	745764.877024
73-30	41716.701	-68002.046	19.608	358-26-43	89-59-55	20.072	-1364937.067312
73-120	41736.302	-68002.578	17.380	268-28-01	90-01-18	19.136	-1301297.332608

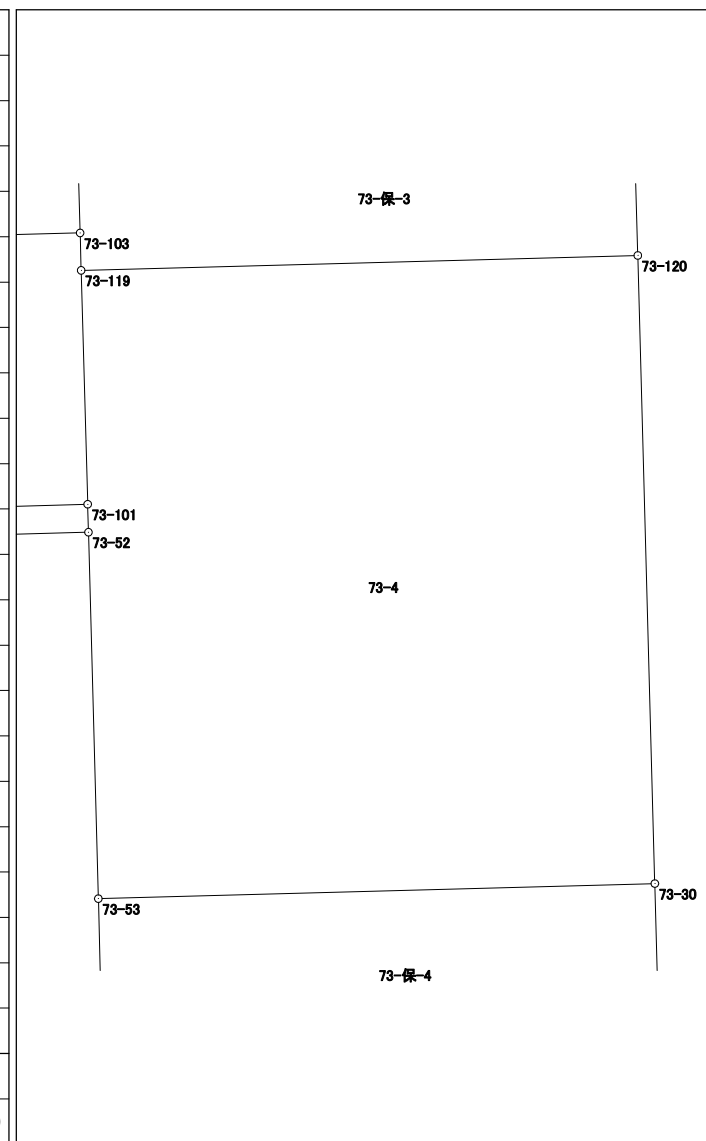


倍面積	681.548560
面積	340.7742800

面積計算書（座標法）

世界測地系（測地成果2011）

所在	地番	公簿地目	現況地目	地積	所有者
前橋市六供町一丁目	73-5			212.33 m ²	

点名	X座標	Y座標	辺長	方向角	測角	DX	倍積 (Y×DX)
73-109	41711.627	-68019.289	12.454	178-24-45	89-57-58	-12.920	878809.213880
73-31	41699.178	-68018.944	14.553	88-27-09	90-02-24	-12.056	820036.388864
73-6	41699.571	-68004.396	3.996	43-10-29	134-43-20	3.307	-224890.537572
73-5	41702.485	-68001.662	9.617	358-27-03	135-16-34	12.527	-851856.819874
73-110	41712.098	-68001.922	17.373	268-26-47	89-59-44	9.142	-621673.570924
倍面積							424.674374
面積							212.3371870

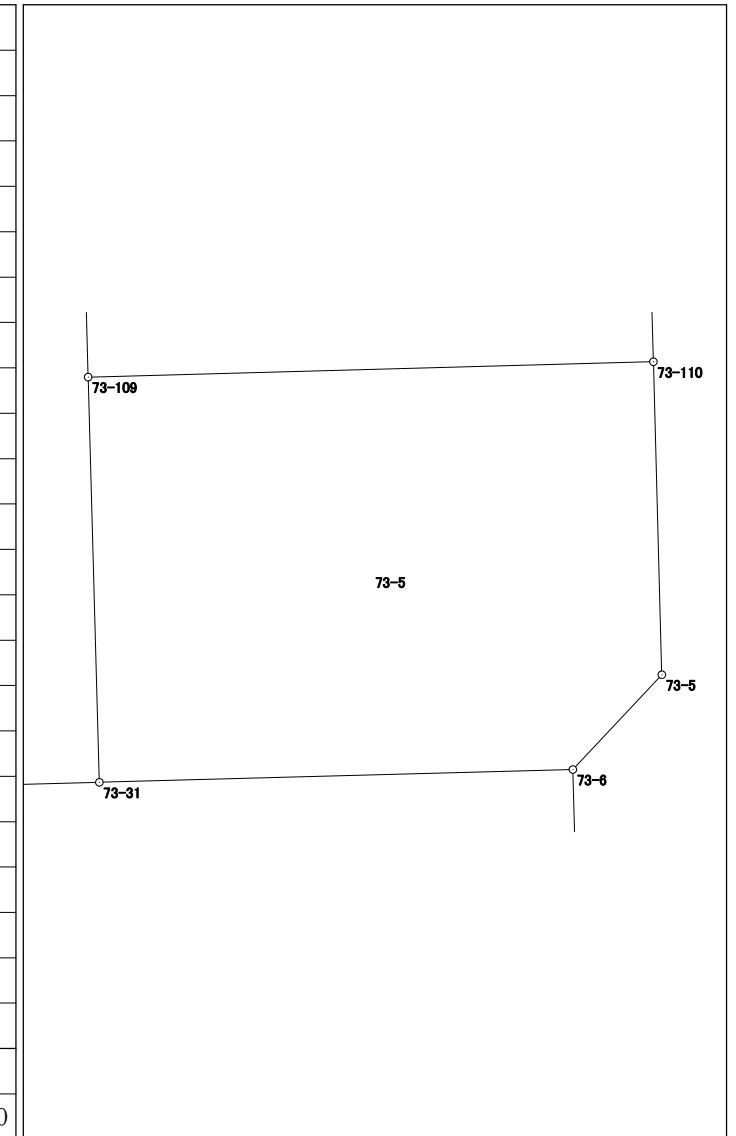


面積計算書（座標法）

世界測地系（測地成果2011）

所 在	地 番	公簿地目	現況地目	地 積	所 有 者
前橋市六供町一丁目	73-6			293.10 m ²	

点 名	X 座標	Y 座標	辺 長	方 向 角	測 角	DX	倍 積 (Y×DX)
73-47	41714.472	-68040.819	15.901	178-22-03	89-56-03	-15.927	1083686.124213
73-33	41698.577	-68040.366	18.429	88-23-33	90-01-30	-15.378	1046324.748348
73-32	41699.094	-68021.944	15.900	358-24-12	90-00-39	16.411	-1116308.122984
73-48	41714.988	-68022.387	12.676	268-23-26	89-59-14	15.538	-1056931.849206
73-123	41714.632	-68035.058	2.531	268-23-33	180-00-07	-0.427	29050.969766
73-121	41714.561	-68037.588	1.898	268-23-59	180-00-26	-0.124	8436.660912
73-55	41714.508	-68039.485	0.164	268-36-10	180-12-11	-0.057	3878.250645
73-112	41714.504	-68039.649	1.170	268-26-00	179-49-50	-0.036	2449.427364

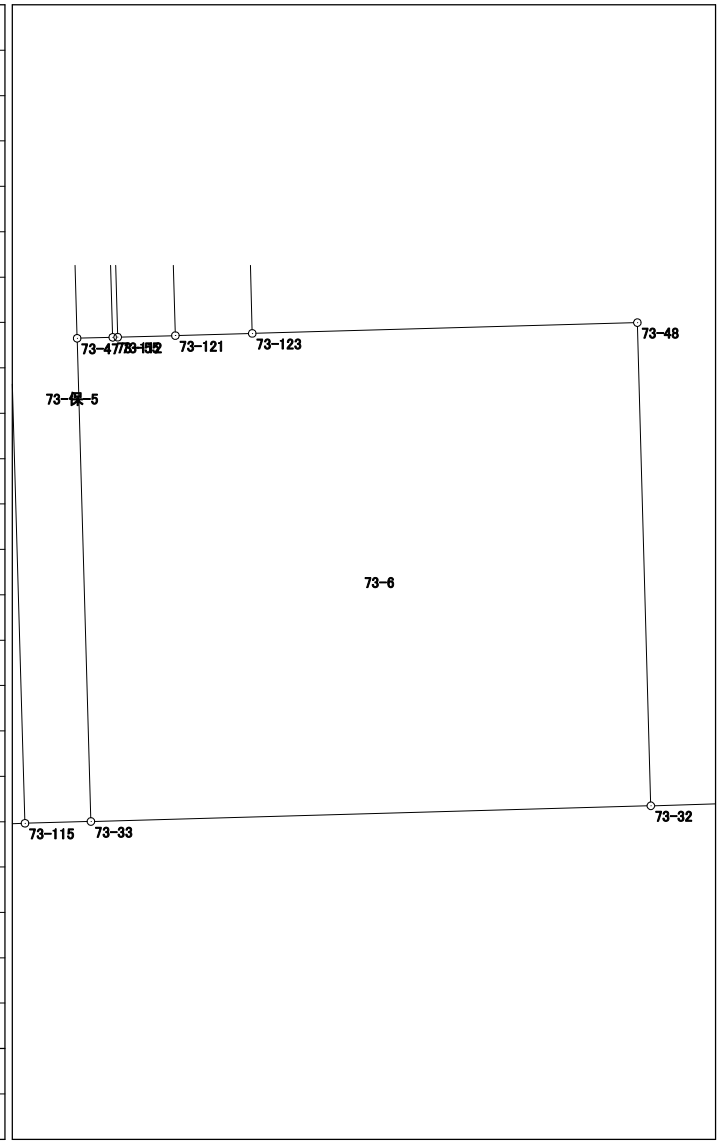


倍面積	586.209058
面 積	293.1045290

面積計算書 (座標法)

世界測地系 (測地成果2011)

所在	地番	公簿地目	現況地目	地積	所有者
前橋市六供町一丁目	73-7			322.93 m ²	

点名	X座標	Y座標	辺長	方向角	測角	DX	倍積 (Y×DX)
73-114	41727.054	-68043.355	11.291	268-20-44	89-59-30	28.210	-1919503.044550
73-44	41726.728	-68054.641	12.265	178-28-37	90-07-53	-12.587	856603.766267
73-45	41714.467	-68054.315	16.264	178-24-27	179-55-50	-28.519	1940841.009485
73-34	41698.209	-68053.863	11.332	88-26-15	90-01-48	-15.949	1085391.060987
73-115	41698.518	-68042.535	28.548	358-21-14	89-54-59	28.845	-1962686.922075

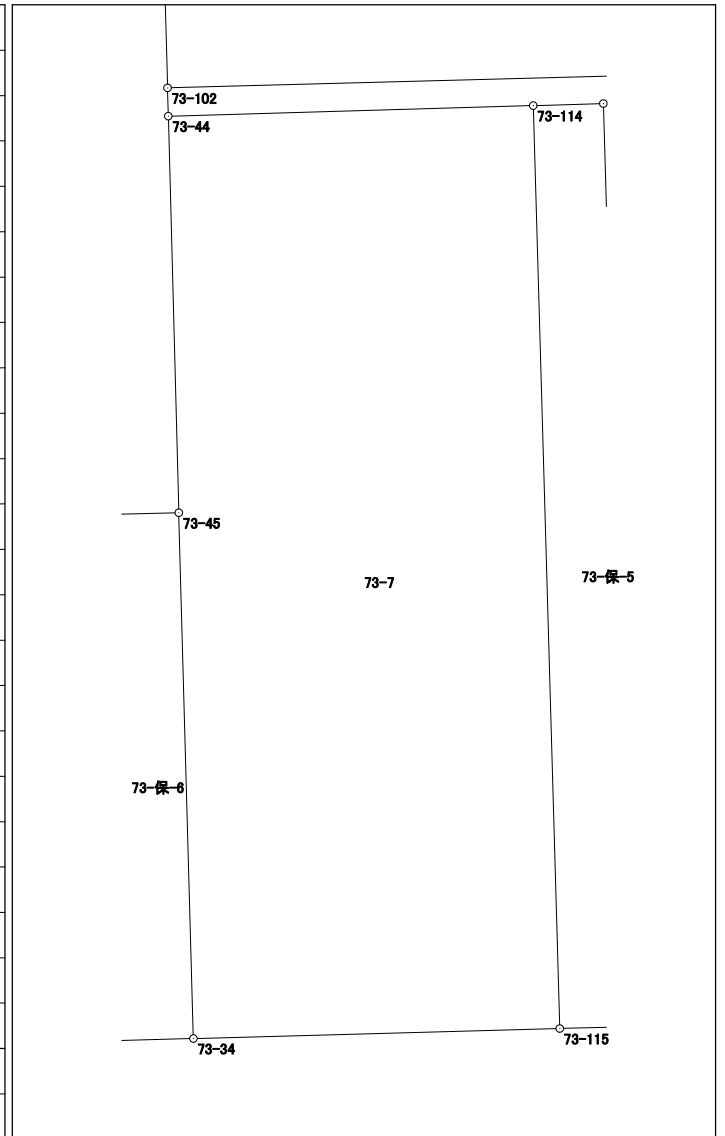


倍面積	645.870114
面積	322.9350570

面積計算書 (座標法)

世界測地系 (測地成果2011)

所在	地番	公簿地目	現況地目	地積	所有者
前橋市六供町一丁目	73-8			140.38 m ²	

点名	X座標	Y座標	辺長	方向角	測角	DX	倍積 (Y×DX)
73-107	41714.375	-68057.696	8.637	268-26-27	90-02-01	16.020	-1090284.289920
73-42	41714.140	-68066.330	16.254	178-23-33	89-57-06	-16.483	1121937.317390
73-35	41697.892	-68065.874	8.633	88-29-12	90-05-39	-16.020	1090415.301480
73-108	41698.120	-68057.244	16.261	358-24-26	89-55-14	16.483	-1121787.552852
倍面積						280.776098	
面積						140.3880490	

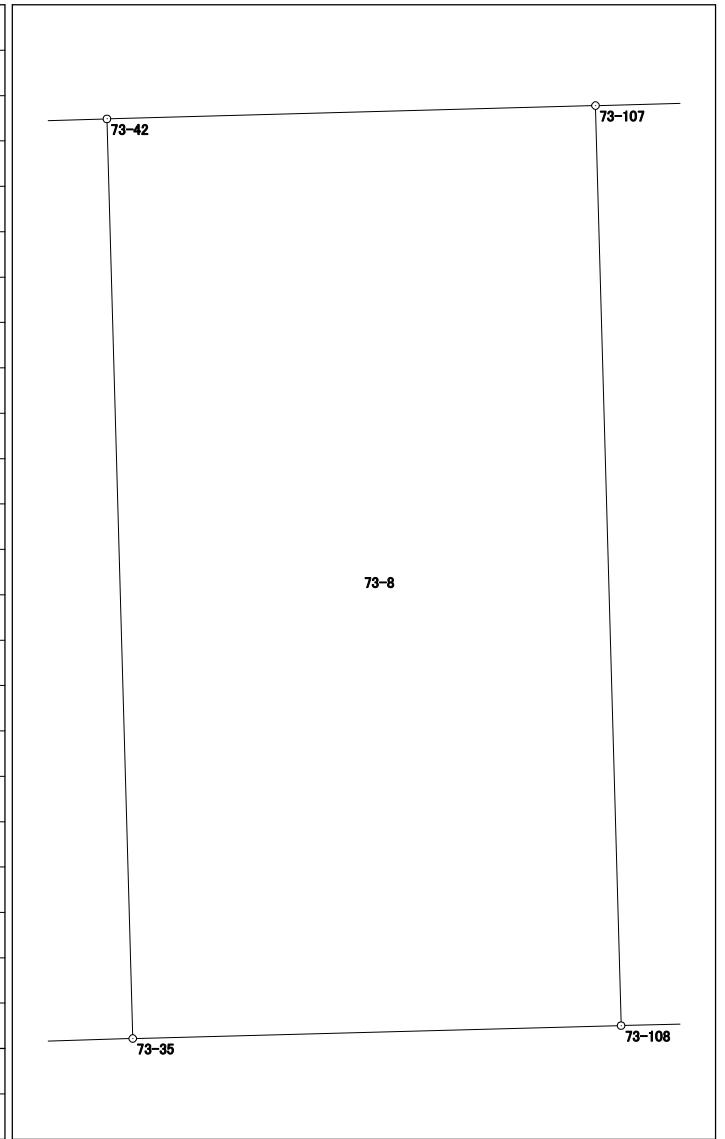


面積計算書 (座標法)

世界測地系 (測地成果2011)

所在	地番	公簿地目	現況地目	地積	所有者
前橋市六供町一丁目	73-9			202.94 m ²	

点名	X座標	Y座標	辺長	方向角	測角	DX	倍積 (Y×DX)
73-105	41714.011	-68071.003	12.475	268-24-38	90-01-02	15.910	-1083009.657730
73-36	41713.665	-68083.473	13.407	180-09-14	91-44-36	-13.753	936352.004169
73-24	41700.258	-68083.509	4.000	134-25-58	134-16-44	-16.207	1103429.430363
73-23	41697.458	-68080.653	10.110	88-19-00	133-53-02	-2.503	170405.874459
73-106	41697.755	-68070.547	16.262	358-23-36	90-04-36	16.553	-1126771.764491

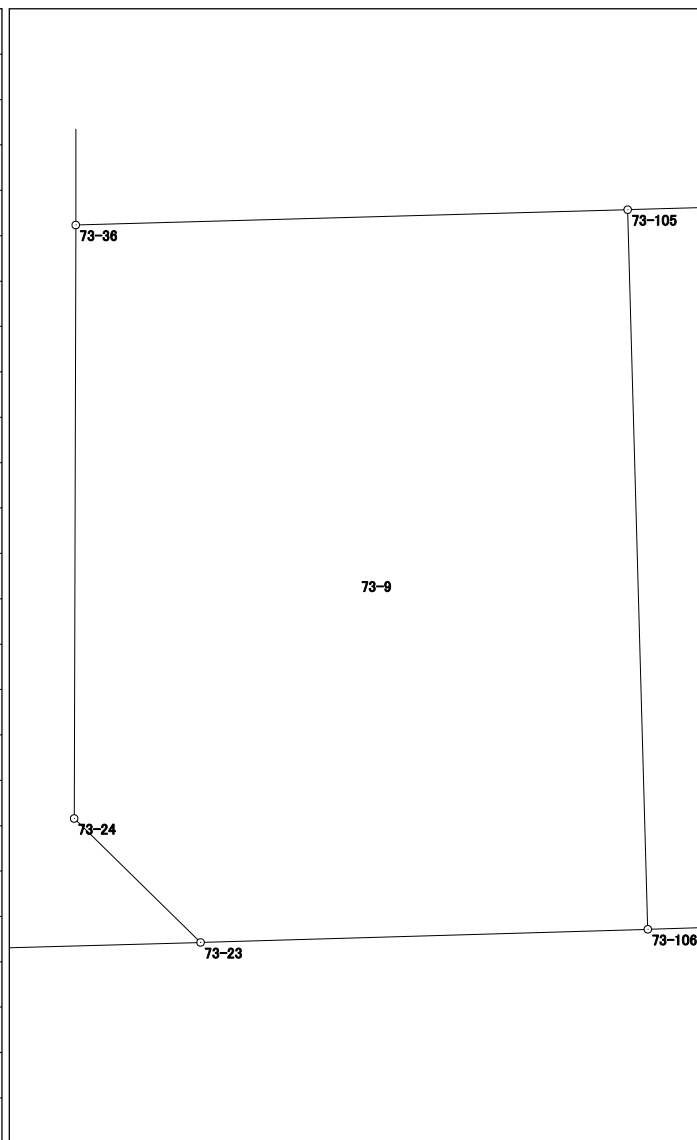


倍面積	405.886770
面積	202.9433850

面積計算書 (座標法)

世界測地系 (測地成果2011)

所 在	地 番	公簿地目	現況地目	地 積	所 有 者
前橋市六供町一丁目	73-10			476.67 m ²	


点 名	X 座標	Y 座標	辺 長	方 向 角	測 角	DX	倍 積 (Y×DX)
73-125	41730.562	-68080.459	3.305	180-03-07	91-40-11	-4.031	274432.330229
73-127	41727.257	-68080.462	3.000	268-22-35	268-19-28	-3.390	230792.766180
73-126	41727.172	-68083.461	13.507	180-03-03	91-40-28	-13.592	925390.401912
73-36	41713.665	-68083.473	12.475	88-24-38	88-21-35	-13.161	896046.588153
73-105	41714.011	-68071.003	4.675	88-25-07	180-00-29	0.475	-32333.726425
73-42	41714.140	-68066.330	8.637	88-26-27	180-01-20	0.364	-24776.144120
73-107	41714.375	-68057.696	3.382	88-26-29	180-00-02	0.327	-22254.866592
73-45	41714.467	-68054.315	12.265	358-28-37	90-02-08	12.353	-840674.953195
73-44	41726.728	-68054.641	0.874	358-33-29	180-04-52	13.135	-893897.709535
73-102	41727.602	-68054.663	3.687	358-34-13	180-00-44	4.560	-310329.263280
73-43	41731.288	-68054.755	25.714	268-22-56	89-48-43	2.960	-201442.074800

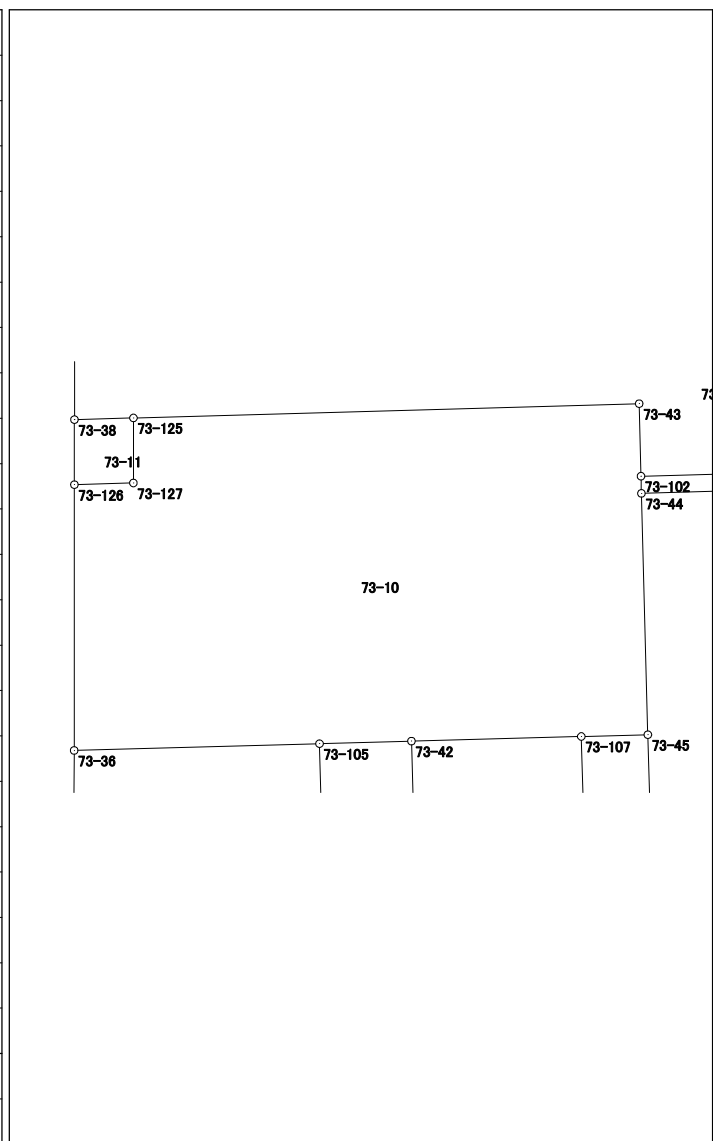

面積計算書（座標法）

世界測地系（測地成果2011）

所 在	地 番	公簿地目	現況地目	地 積	所 有 者
前橋市六供町一丁目	73-12			433.30 m ²	

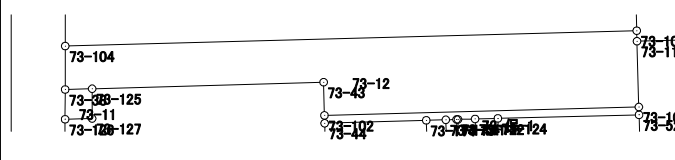
点 名	X 座標	Y 座標	辺 長	方 向 角	測 角	DX	倍 積 (Y×DX)	
73-101	41728.538	-68019.749	7.302	358-24-25	89-56-33	8.235	-560142.633015	
73-119	41735.837	-68019.952	1.168	358-22-54	179-58-29	8.467	-575924.933584	
73-103	41737.005	-68019.985	63.486	268-27-46	90-04-52	-0.535	36390.691975	
73-104	41735.302	-68083.448	4.825	180-07-07	91-39-21	-6.528	444448.748544	
73-38	41730.477	-68083.458	3.000	88-22-35	88-15-28	-4.740	322715.590920	
73-125	41730.562	-68080.459	25.714	88-22-56	180-00-21	0.811	-55213.252249	
73-43	41731.288	-68054.755	3.687	178-34-13	270-11-17	-2.960	201442.074800	
73-102	41727.602	-68054.663	34.927	88-27-52	89-53-39	-2.750	187150.323250	
倍面積							866.610641	
面 積							433.3053205	

面積計算書 (座標法)

世界測地系 (測地成果2011)

所在	地番	公簿地目	現況地目	地積	所有者
前橋市六供町一丁目	73-13			14.93 m ²	

点名	X座標	Y座標	辺長	方向角	測角	DX	倍積 (Y×DX)
73-47	41714.472	-68040.819	1.170	88-26-00	90-05-45	-12.613	858198.850047
73-112	41714.504	-68039.649	12.650	358-25-41	89-59-41	12.677	-862538.630373
73-111	41727.149	-68039.996	1.190	268-27-35	90-01-54	12.613	-858188.469548
73-113	41727.117	-68041.186	12.650	178-20-15	89-52-40	-12.677	862558.114922
						倍面積	29.865048
						面積	14.9325240

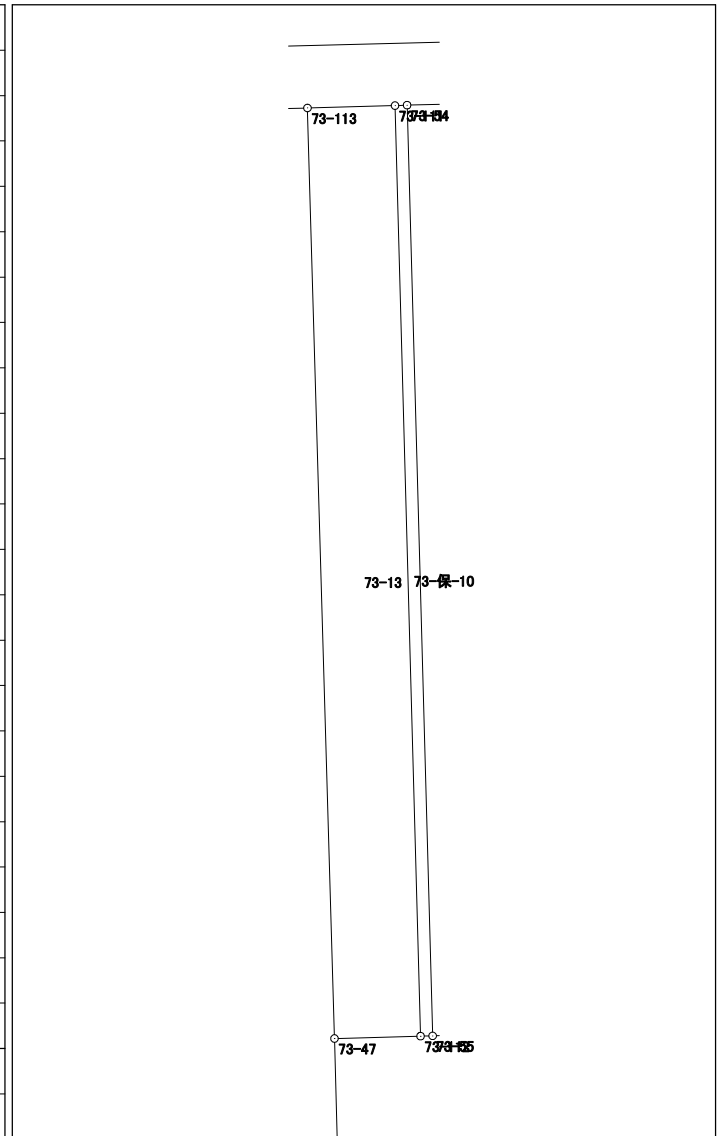


面積計算書（座標法）

世界測地系（測地成果2011）

所 在	地 番	公簿地目	現況地目	地 積	所 有 者
前橋市六供町一丁目	73-14			245.62 m ²	

点 名	X 座標	Y 座標	辺 長	方 向 角	測 角	DX	倍 積 (Y×DX)
73-123	41714.632	-68035.058	12.676	88-23-26	89-57-33	-12.279	835402.477182
73-48	41714.988	-68022.387	15.900	178-24-12	270-00-46	-15.538	1056931.849206
73-32	41699.094	-68021.944	3.001	88-23-46	89-59-34	-15.810	1075426.934640
73-31	41699.178	-68018.944	12.454	358-24-45	90-00-59	12.533	-852481.425152
73-109	41711.627	-68019.289	4.605	358-25-10	180-00-25	17.052	-1159864.916028
73-53	41716.230	-68019.416	11.439	358-27-08	180-01-58	16.038	-1090895.393808
73-52	41727.665	-68019.725	15.684	268-32-45	90-05-37	11.037	-750733.704825
73-124	41727.267	-68035.404	12.640	178-25-53	89-53-08	-13.033	886705.420332

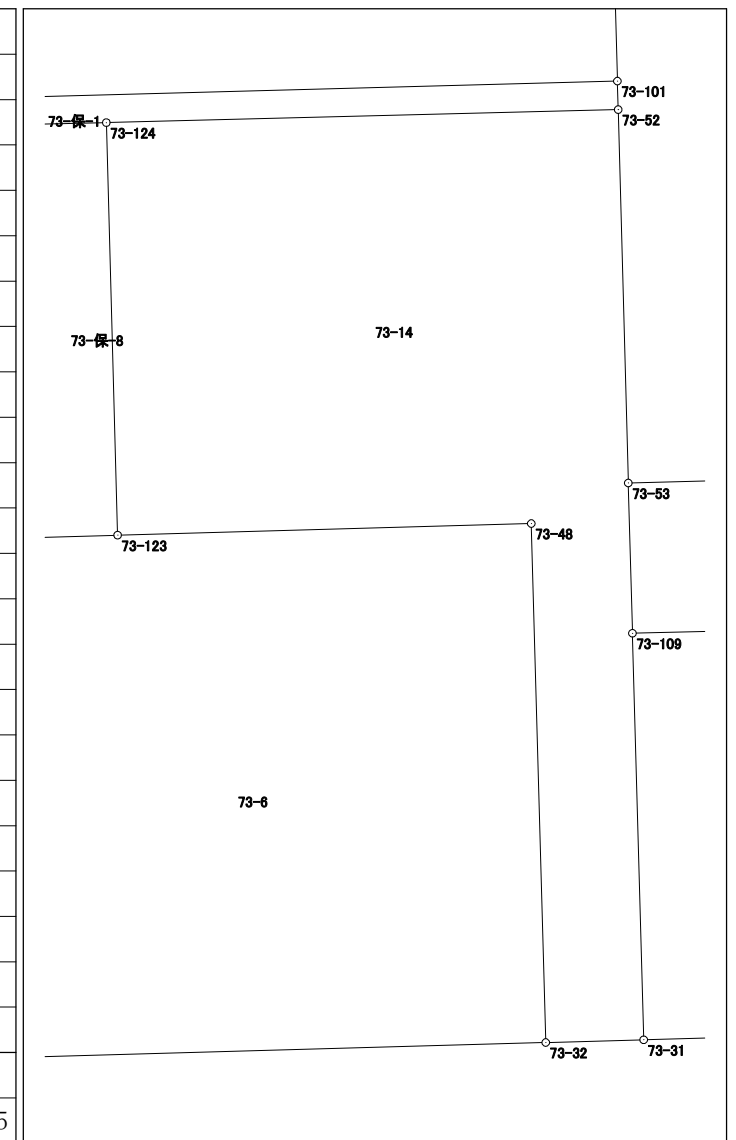

倍面積	491.241547
面 積	245.6207735

面積計算書 (座標法)

世界測地系 (測地成果2011)

所在	地番	公簿地目	現況地目	地積	所有者
前橋市六供町一丁目	73-保-2			72.00 m ²	


点名	X座標	Y座標	辺長	方向角	測角	Dx	倍積 (Y×Dx)	
73-27	41761.992	-68020.672	4.466	178-25-18	87-50-54	-4.290	291808.682880	
73-117	41757.528	-68020.549	17.376	88-27-12	90-01-54	-3.995	271742.093255	
73-118	41757.997	-68003.179	3.822	358-23-45	89-56-33	4.290	-291733.637910	
73-4	41761.818	-68003.286	17.387	270-34-24	92-10-39	3.995	-271673.127570	
倍面積							144.010655	
面積							72.0053275	

面積計算書 (座標法)

世界測地系 (測地成果2011)

所在	地番	公簿地目	現況地目	地積	所有者
前橋市六供町一丁目	73-保-4			80.00 m ²	

点名	X座標	Y座標	辺長	方向角	測角	DX	倍積 (Y×DX)
73-53	41716.230	-68019.416	4.605	178-25-10	89-58-22	-5.074	345130.516784
73-109	41711.627	-68019.289	17.373	88-26-47	90-01-37	-4.132	281055.702148
73-110	41712.098	-68001.922	4.605	358-27-25	90-00-38	5.074	-345041.752228
73-30	41716.701	-68002.046	17.376	268-26-48	89-59-23	4.132	-280984.454072
						倍面積	160.012632
						面積	80.0063160

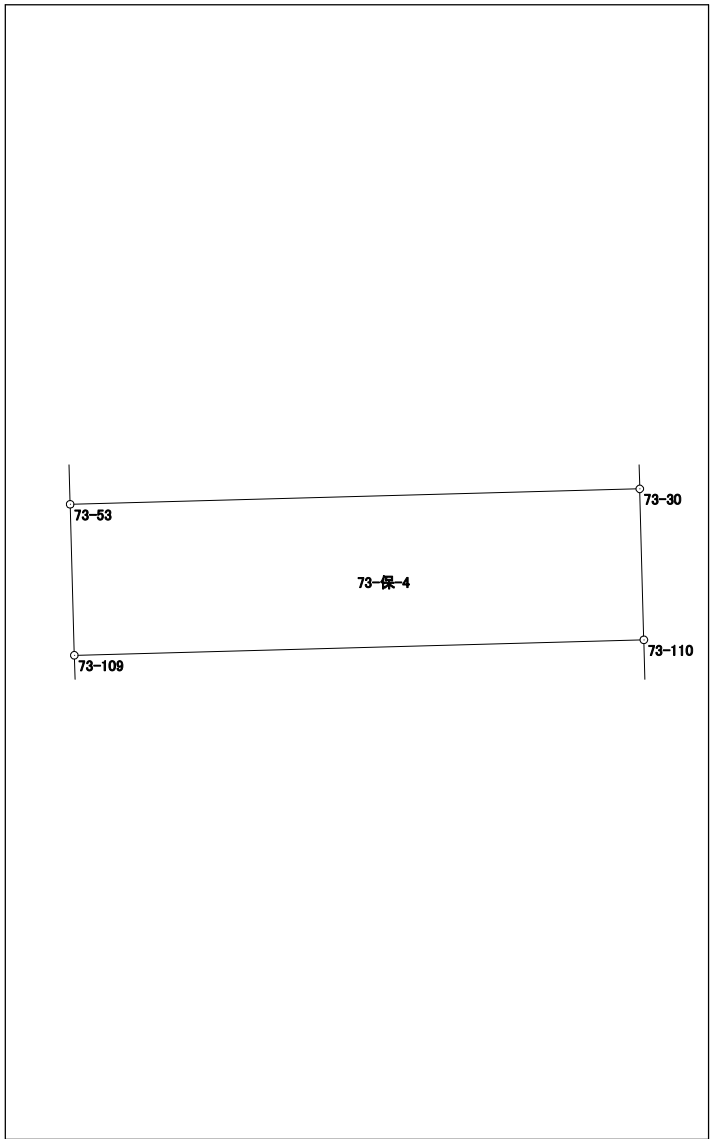


面積計算書（座標法）

世界測地系（測地成果2011）

所 在	地 番	公簿地目	現況地目	地 積	所 有 者
前橋市六供町一丁目	73-保-5			62.00 m ²	

点 名	X 座標	Y 座標	辺 長	方 向 角	測 角	DX	倍 積 (Y×DX)
73-47	41714.472	-68040.819	12.650	358-20-15	179-58-12	28.540	-1941884.974260
73-113	41727.117	-68041.186	2.170	268-20-11	89-59-56	12.582	-856094.202252
73-114	41727.054	-68043.355	28.548	178-21-14	90-01-03	-28.599	1945971.909645
73-115	41698.518	-68042.535	2.170	88-26-31	90-05-17	-28.477	1937647.269195
73-33	41698.577	-68040.366	15.901	358-22-03	89-55-32	15.954	-1085515.999164

倍面積	124.003164
面 積	62.0015820

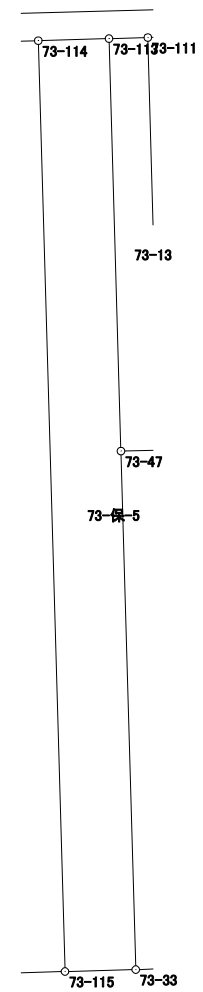


面積計算書 (座標法)

世界測地系 (測地成果2011)

所在	地番	公簿地目	現況地目	地積	所有者
前橋市六供町一丁目	73-保-6			55.00 m ²	

点名	X座標	Y座標	辺長	方向角	測角	DX	倍積 (Y×DX)
73-34	41698.209	-68053.863	16.264	358-24-27	89-54-55	16.347	-1112476.498461
73-45	41714.467	-68054.315	3.382	268-26-29	90-02-02	16.166	-1100166.056290
73-107	41714.375	-68057.696	16.261	178-24-26	89-57-57	-16.347	1112539.156512
73-108	41698.120	-68057.244	3.382	88-29-32	90-05-06	-16.166	1100213.406504
						倍面積	110.008265
						面積	55.0041325

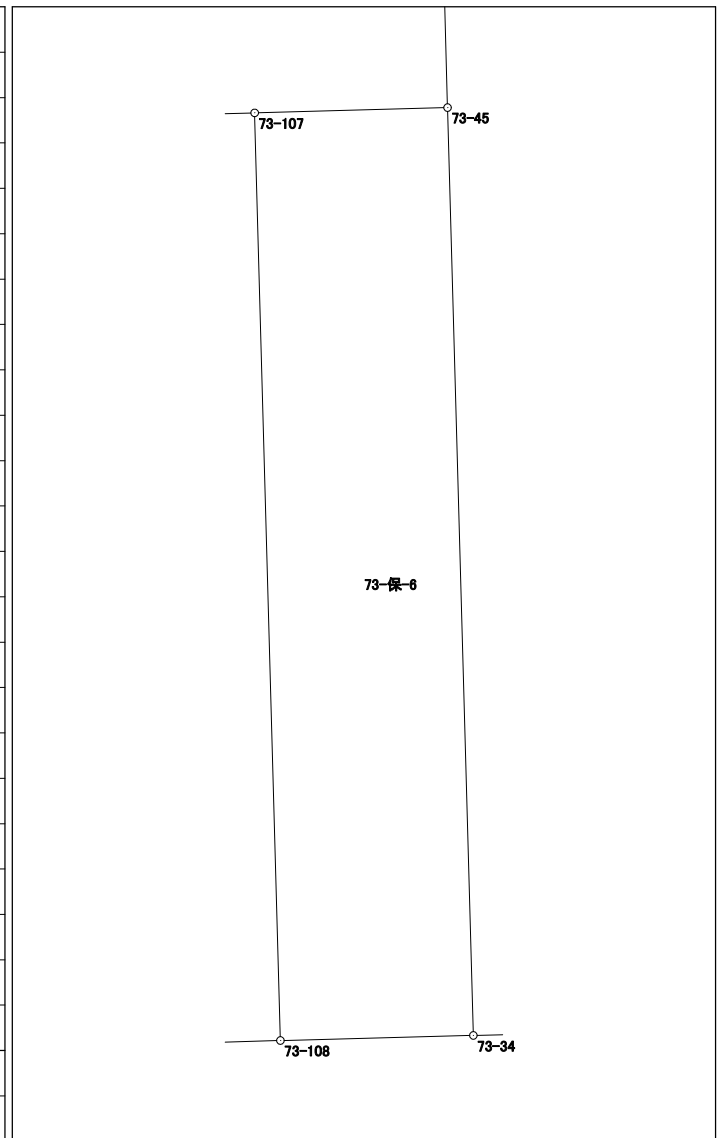


面積計算書（座標法）

世界測地系（測地成果2011）

所在	地番	公簿地目	現況地目	地積	所有者
前橋市六供町一丁目	73-保-8			32.00 m ²	

点名	X座標	Y座標	辺長	方向角	測角	DX	倍積(Y×DX)
73-122	41727.203	-68037.935	12.647	178-25-40	89-52-35	-12.706	864490.002110
73-121	41714.561	-68037.588	2.531	88-23-33	89-57-53	-12.571	855300.518748
73-123	41714.632	-68035.058	12.640	358-25-53	90-02-20	12.706	-864453.446948
73-124	41727.267	-68035.404	2.532	268-33-05	90-07-12	12.571	-855273.063684
						倍面積	64.010226
						面積	32.0051130

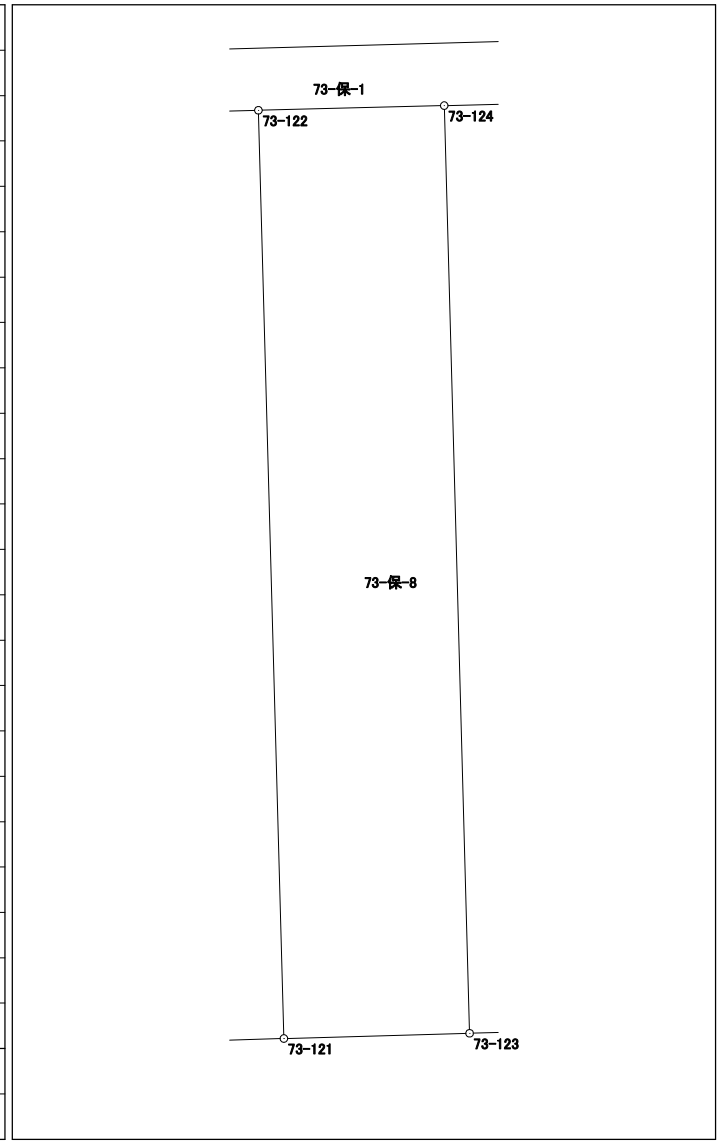


面積計算書（座標法）

世界測地系（測地成果2011）

所在	地番	公簿地目	現況地目	地積	所有者
前橋市六供町一丁目	73-保-9			24.00 m ²	

点名	X座標	Y座標	辺長	方向角	測角	DX	倍積 (Y×DX)
73-55	41714.508	-68039.485	1.898	88-23-59	89-58-17	-12.594	856889.274090
73-121	41714.561	-68037.588	12.647	358-25-40	90-01-41	12.695	-863737.179660
73-122	41727.203	-68037.935	1.898	268-33-02	90-07-22	12.594	-856869.753390
73-54	41727.155	-68039.832	12.652	178-25-42	89-52-40	-12.695	863765.667240
倍面積							48.008280
面積							24.0041400

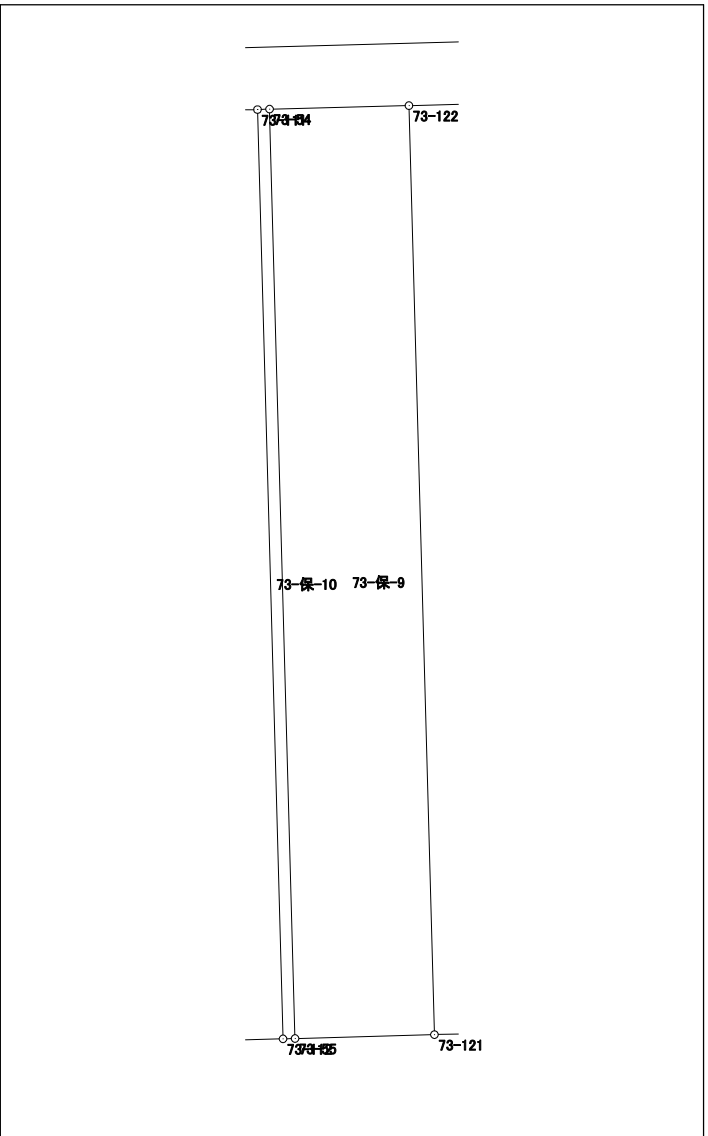


面積計算書（座標法）

世界測地系（測地成果2011）

所 在	地 番	公簿地目	現況地目	地 積	所 有 者
前橋市六供町一丁目	73-保-10			2.07 m ²	

点 名	X 座標	Y 座標	辺 長	方 向 角	測 角	DX	倍 積 (Y×DX)
73-54	41727.155	-68039.832	0.164	267-54-17	89-28-35	12.641	-860091.516312
73-111	41727.149	-68039.996	12.650	178-25-41	90-31-24	-12.651	860773.989396
73-112	41714.504	-68039.649	0.164	88-36-10	90-10-29	-12.641	860089.203009
73-55	41714.508	-68039.485	12.652	358-25-42	89-49-32	12.651	-860767.524735
						倍面積	4.151358
						面 積	2.0756790

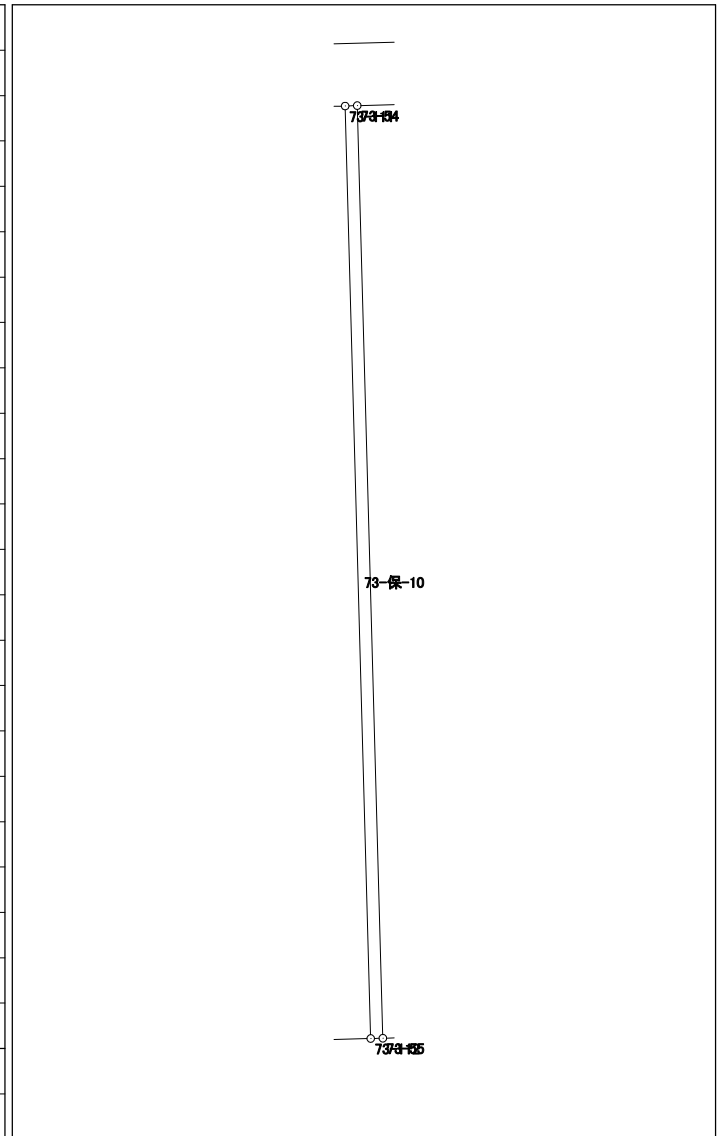

面積計算書（座標法）

世界測地系（測地成果2011）

所 在	地 番	公簿地目	現況地目	地 積	所 有 者
前橋市六供町一丁目	73-保-11			87.05 m ²	

点 名	X 座標	Y 座標	辺 長	方 向 角	測 角	DX	倍 積 (Y×DX)		
73-49	41745.500	-68020.217	5.007	178-26-37	89-59-24	-5.474	372342.667858		
73-50	41740.495	-68020.081	17.383	88-27-50	90-01-13	-4.539	308743.147659		
73-29	41740.961	-68002.704	5.010	358-23-55	89-56-05	5.474	-372246.801696		
73-28	41745.969	-68002.844	17.379	268-27-13	90-03-18	4.539	-308664.908916		
							倍面積		174.104905
							面 積		87.0524525