



7 4 街区 画地出来形確認図 (6358.62m²)

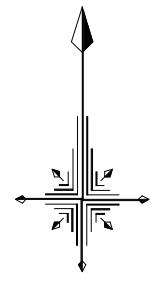

S=1/500

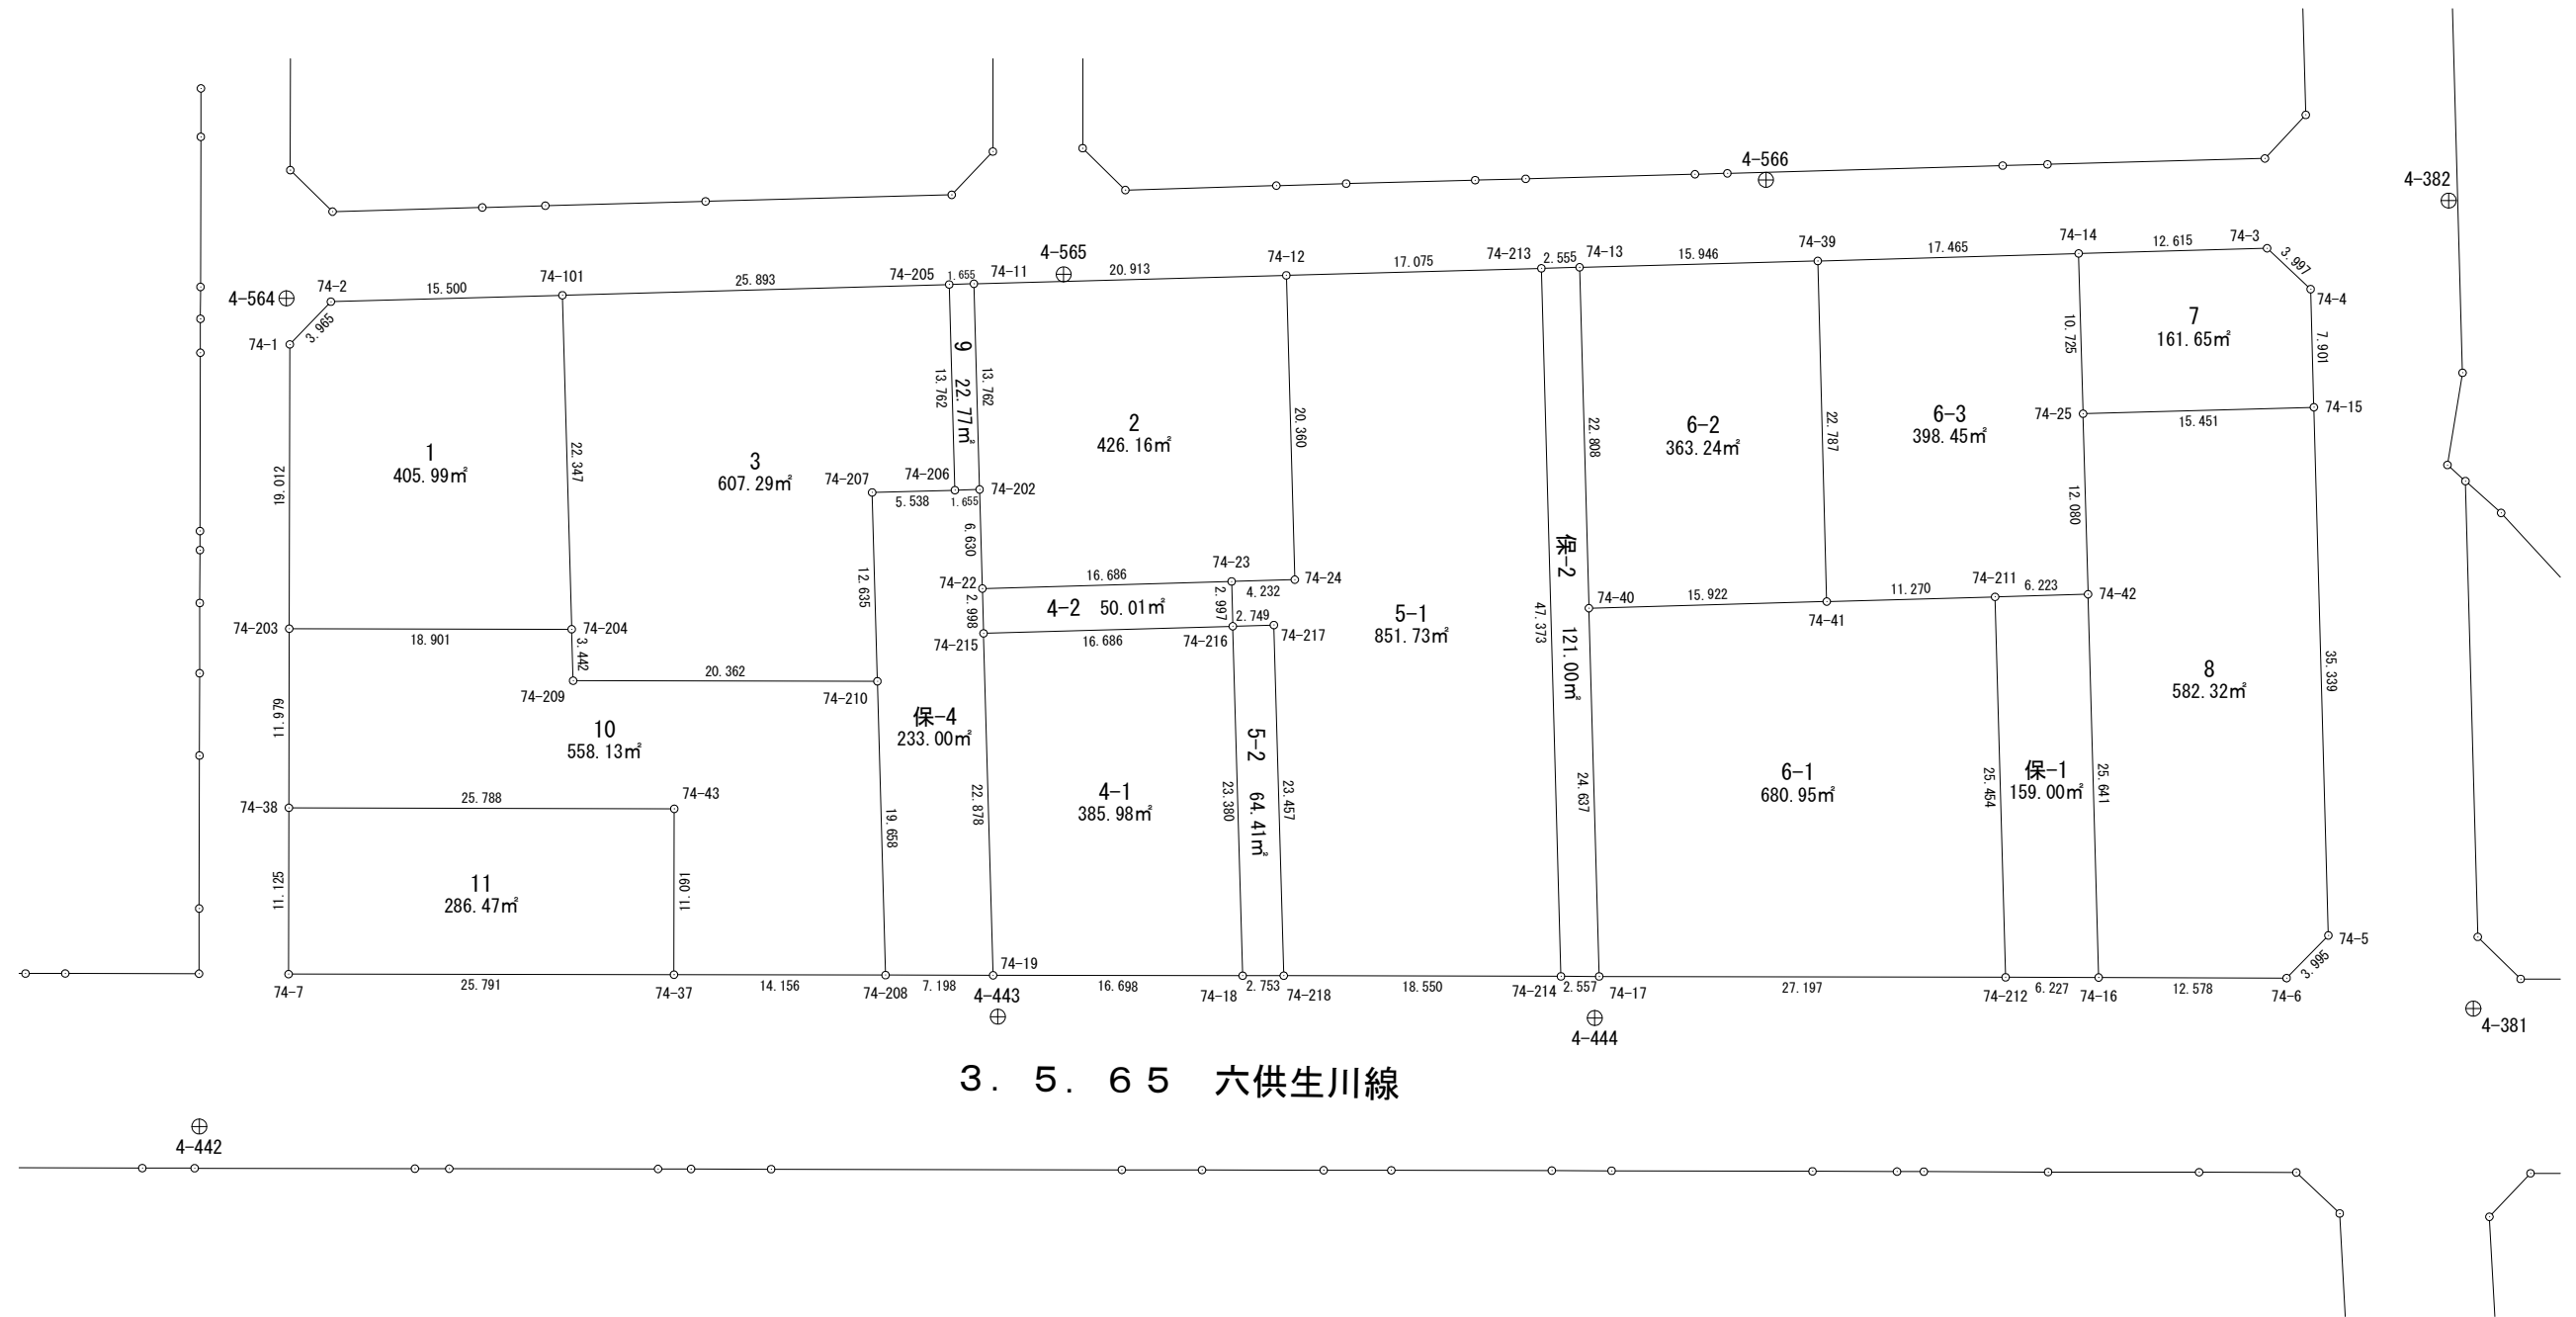


面積計算書 (座標法)

世界測地系 (測地成果2011)

所在	地番	公簿地目	現況地目	地積	所有者
前橋市六供町一丁目	74-1			405.99 m ²	

点名	X座標	Y座標	辺長	方向角	測角	DX	倍積 (Y×DX)
74-101	41690.423	-68118.323	15.500	268-24-24	89-59-57	21.907	-1492268.101961
74-2	41689.992	-68133.817	3.965	223-53-47	135-29-23	-3.288	224023.990296
74-1	41687.135	-68136.566	19.012	180-06-41	136-12-54	-21.869	1490078.561854
74-203	41668.123	-68136.603	18.901	90-06-55	90-00-14	-19.050	1298002.287150
74-204	41668.085	-68117.702	22.347	358-24-27	88-17-32	22.300	-1519024.754600

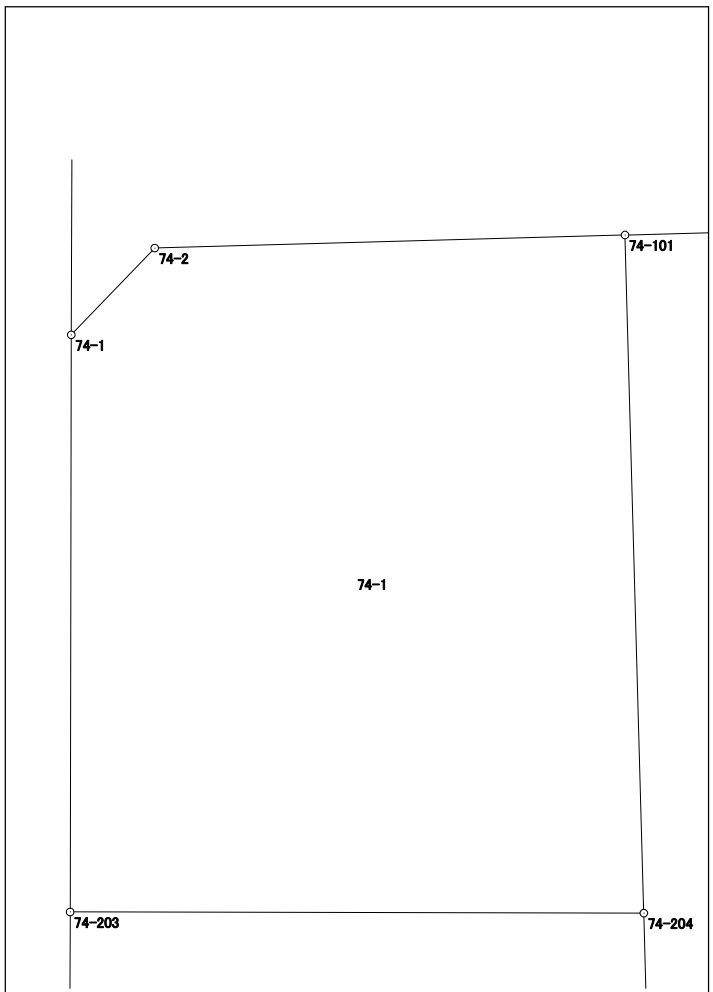


倍面積	811.982739
面積	405.9913695

面積計算書（座標法）

世界測地系（測地成果2011）

所在	地番	公簿地目	現況地目	地積	所有者
前橋市六供町一丁目	74-2			426.16 m ²	

点名	X座標	Y座標	辺長	方向角	測角	DX	倍積 (Y×DX)
74-11	41691.190	-68090.786	13.762	178-24-49	89-57-33	-14.321	975128.146306
74-202	41677.433	-68090.405	6.630	178-25-06	180-00-17	-20.384	1387954.815520
74-22	41670.806	-68090.222	16.686	88-22-07	89-57-01	-6.152	418891.045744
74-23	41671.281	-68073.543	4.232	88-21-41	179-59-34	0.596	-40571.831628
74-24	41671.402	-68069.313	20.360	358-24-05	90-02-24	20.473	-1393583.045049
74-12	41691.754	-68069.881	20.913	268-27-16	90-03-11	19.788	-1346966.805228

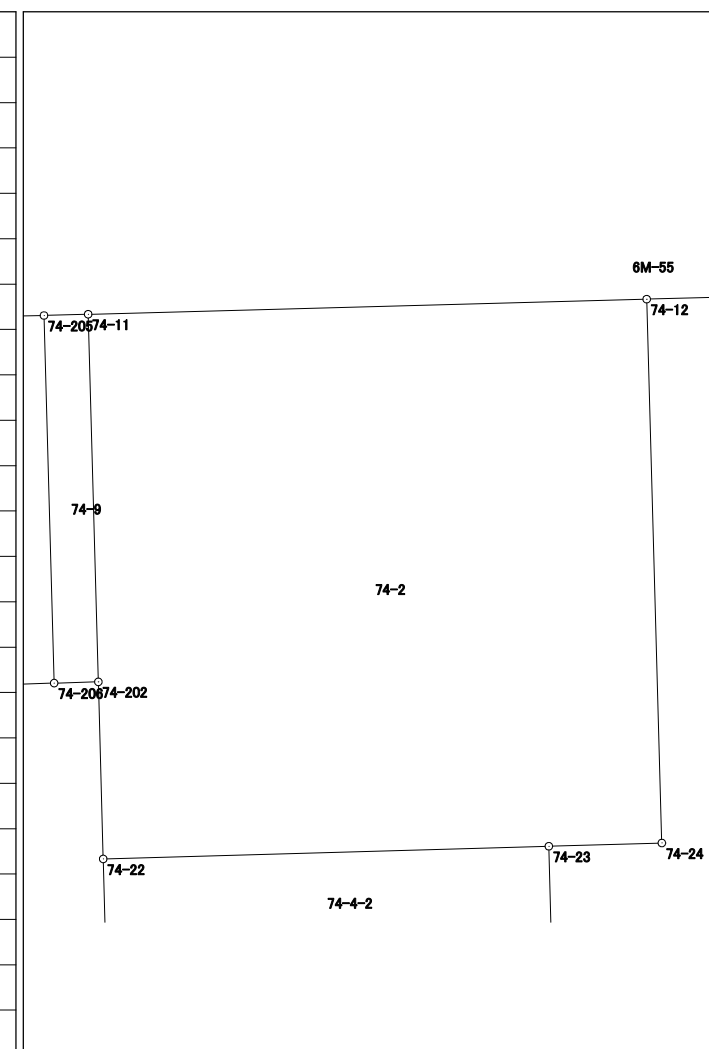


倍面積	852.325665
面積	426.1628325

面積計算書 (座標法)

世界測地系 (測地成果2011)

所 在	地 番	公簿地目	現況地目	地 積	所 有 者
前橋市六供町一丁目	74-3			607.29 m ²	

点 名	X 座標	Y 座標	辺 長	方 向 角	測 角	DX	倍 積 (Y×DX)
74-205	41691.144	-68092.440	25.893	268-24-16	89-59-27	13.036	-887653.047840
74-101	41690.423	-68118.323	22.347	178-24-27	90-00-11	-23.059	1570740.410057
74-204	41668.085	-68117.702	3.442	178-24-07	179-59-40	-25.779	1756006.239858
74-209	41664.644	-68117.606	20.362	90-06-45	91-42-38	-3.481	237117.386486
74-210	41664.604	-68097.244	12.635	358-24-29	88-17-44	12.590	-857344.301960
74-207	41677.234	-68097.595	5.538	88-25-01	270-00-32	12.783	-870491.556885
74-206	41677.387	-68092.059	13.762	358-24-49	89-59-48	13.910	-947160.540690
						倍面積	1214.589026
						面 積	607.2945130

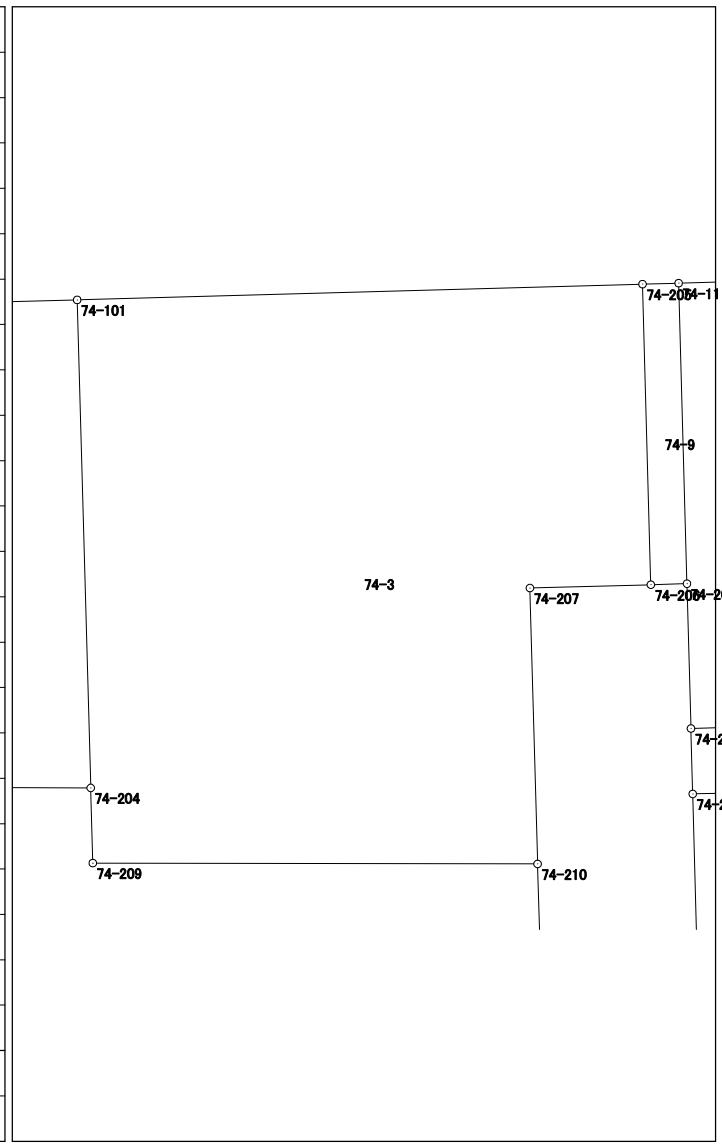


面積計算書（座標法）

世界測地系（測地成果2011）

所 在	地 番	公簿地目	現況地目	地 積	所 有 者
前橋市六供町一丁目	74-4-1			385.98 m ²	

点 名	X 座標	Y 座標	辺 長	方 向 角	測 角	DX	倍 積 (Y×DX)
74-215	41667.809	-68090.141	22.878	178-24-07	90-02-12	-23.345	1589564.341645
74-19	41644.940	-68089.503	16.698	90-05-21	91-41-14	-22.895	1558909.171185
74-18	41644.914	-68072.805	23.380	358-23-23	88-18-02	23.345	-1589159.632725
74-216	41668.285	-68073.462	16.686	268-21-55	89-58-32	22.895	-1558541.912490

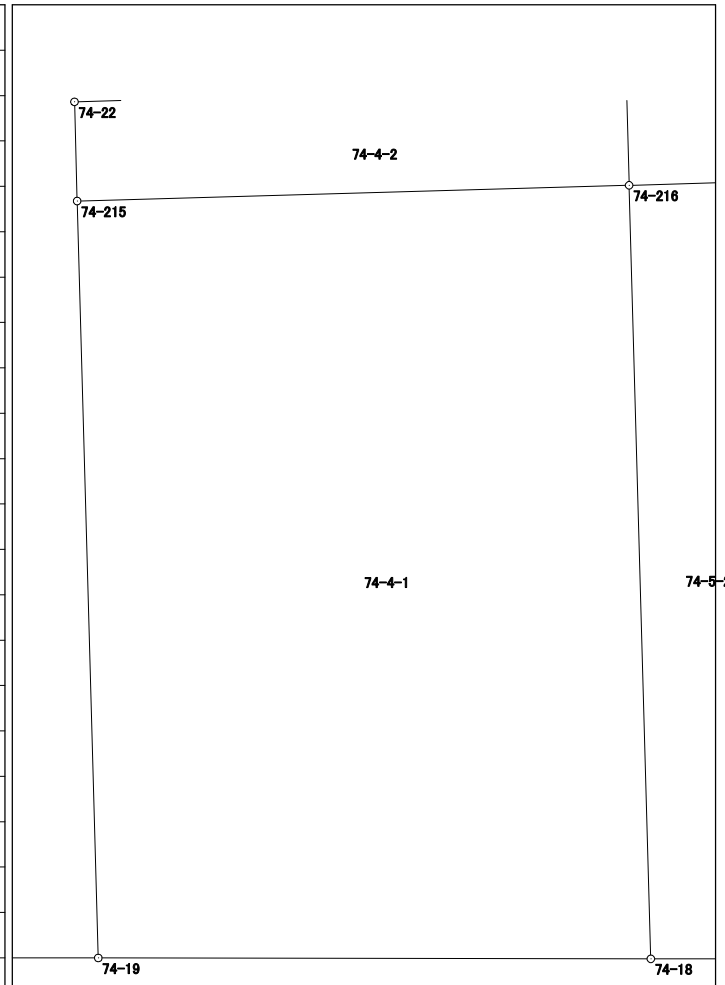

倍面積	771.967615
面 積	385.983075

面積計算書（座標法）

世界測地系（測地成果2011）

所在	地番	公簿地目	現況地目	地積	所有者
前橋市六供町一丁目	74-4-2			50.01 m ²	


点名	X座標	Y座標	辺長	方向角	測角	DX	倍積 (Y×DX)	
74-22	41670.806	-68090.222	2.998	178-27-07	90-05-00	-3.472	236409.250784	
74-215	41667.809	-68090.141	16.686	88-21-55	89-54-48	-2.521	171655.245461	
74-216	41668.285	-68073.462	2.997	358-27-05	90-05-10	3.472	-236351.060064	
74-23	41671.281	-68073.543	16.686	268-22-07	89-55-02	2.521	-171613.401903	
						倍面積		100.034278
						面積		50.0171390

面積計算書 (座標法)

世界測地系 (測地成果2011)

所在	地番	公簿地目	現況地目	地積	所有者
前橋市六供町一丁目	74-5-1			851.73 m ²	

点名	X 座標	Y 座標	辺長	方向角	測角	D _X	倍積 (Y×DX)
74-213	41692.225	-68052.812	17.075	268-25-10	90-00-15	46.884	-3190588.037808
74-12	41691.754	-68069.881	20.360	178-24-05	89-58-55	-20.823	1417419.132063
74-24	41671.402	-68069.313	4.232	268-21-41	269-57-36	-20.473	1393583.045049
74-23	41671.281	-68073.543	2.997	178-27-05	90-05-24	-3.117	212185.233531
74-216	41668.285	-68073.462	2.749	88-21-12	89-54-07	-2.917	198570.288654
74-217	41668.364	-68070.714	23.457	178-22-58	270-01-46	-23.369	1590744.515466
74-218	41644.916	-68070.052	18.550	90-08-31	91-45-33	-23.494	1599237.801688
74-214	41644.870	-68051.502	47.373	358-24-55	88-16-24	47.309	-3219448.508118
						倍面積	1703.470525
						面積	851.7352625

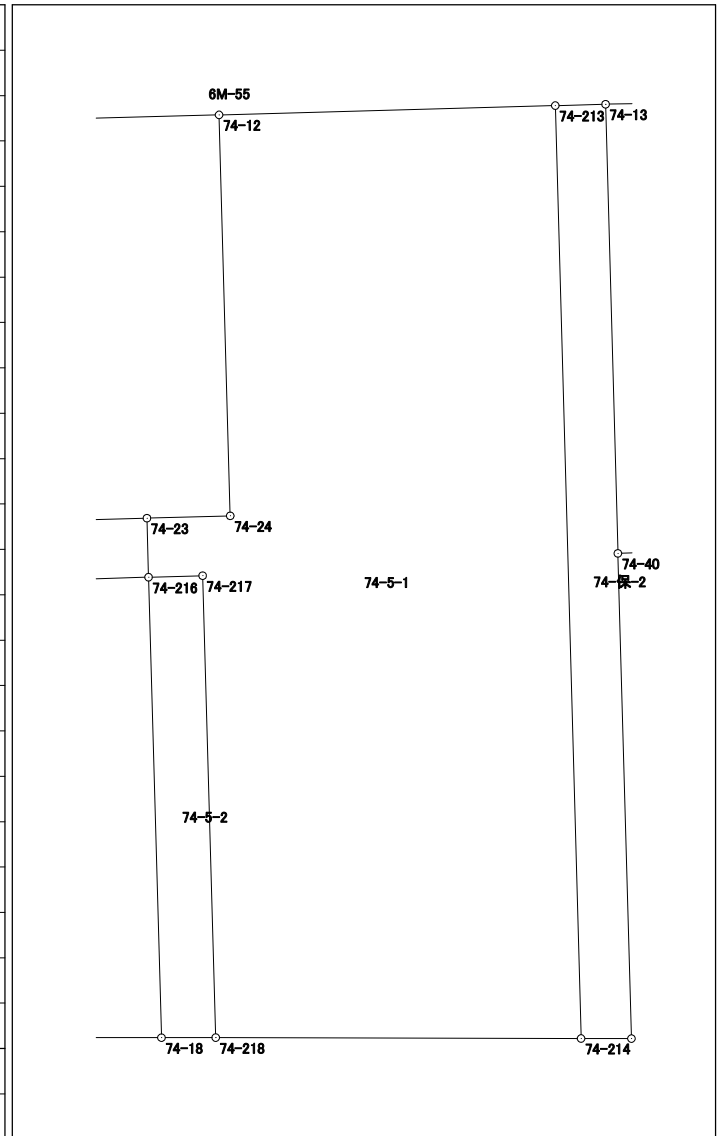


面積計算書 (座標法)

世界測地系 (測地成果2011)

所在	地番	公簿地目	現況地目	地積	所有者
前橋市六供町一丁目	74-6-1			680.95 m ²	

点名	X座標	Y座標	辺長	方向角	測角	DX	倍積 (Y×DX)
74-40	41669.494	-68049.633	24.637	178-23-59	89-59-52	-25.071	1706072.348943
74-17	41644.867	-68048.945	27.197	90-07-35	91-43-36	-24.687	1679924.305215
74-212	41644.807	-68021.748	25.454	358-25-02	88-17-27	25.384	-1726664.051232
74-211	41670.251	-68022.451	11.270	268-24-31	89-59-29	25.131	-1709472.216081
74-41	41669.938	-68033.717	15.922	268-24-07	179-59-36	-0.757	51501.523769

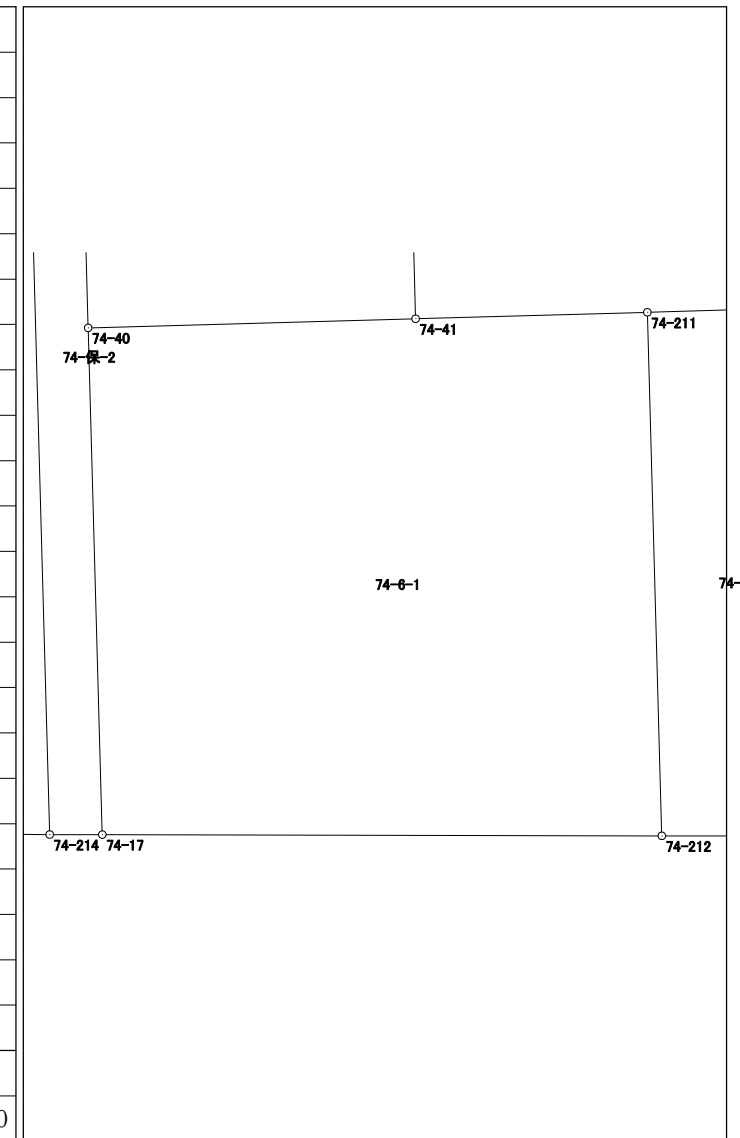

倍面積	1361.910614
面積	680.9553070

面積計算書 (座標法)

世界測地系 (測地成果2011)

所在	地番	公簿地目	現況地目	地積	所有者
前橋市六供町一丁目	74-6-2			363.24 m ²	


点名	X座標	Y座標	辺長	方向角	測角	Dx	倍積 (Y×Dx)
74-13	41692.293	-68050.258	22.808	178-25-47	89-57-12	-23.223	1580331.141534
74-40	41669.494	-68049.633	15.922	88-24-07	89-58-20	-22.355	1521249.545715
74-41	41669.938	-68033.717	22.787	358-29-19	90-05-12	23.223	-1579947.009891
74-39	41692.717	-68034.318	15.946	268-28-35	89-59-16	22.355	-1520907.178890
						倍面積	726.498468
						面積	363.2492340

面積計算書 (座標法)

世界測地系 (測地成果2011)

所在	地番	公簿地目	現況地目	地積	所有者
前橋市六供町一丁目	74-6-3			398.45 m ²	

点名	X座標	Y座標	辺長	方向角	測角	DX	倍積 (Y×DX)
74-39	41692.717	-68034.318	22.787	178-29-19	90-08-20	-23.282	1583974.991676
74-41	41669.938	-68033.717	11.270	88-24-31	89-55-12	-22.466	1528445.486122
74-211	41670.251	-68022.451	6.223	88-24-25	179-59-54	0.486	-33058.911186
74-42	41670.424	-68016.230	12.080	358-24-56	90-00-31	12.248	-833062.785040
74-25	41682.499	-68016.564	10.725	358-25-07	180-00-11	22.796	-1550505.592944
74-14	41693.220	-68016.860	17.465	268-20-59	89-55-52	10.218	-694996.275480

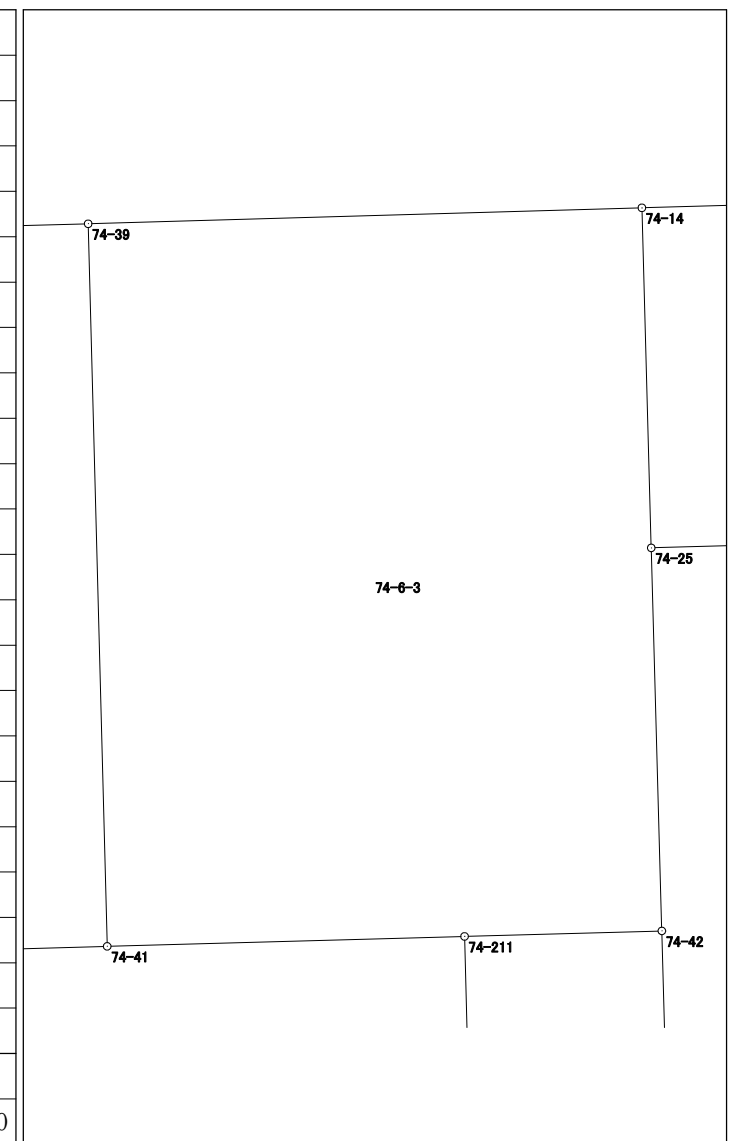


倍面積	796.913148
面積	398.4565740

面積計算書 (座標法)

世界測地系 (測地成果2011)

所在	地番	公簿地目	現況地目	地積	所有者
前橋市六供町一丁目	74-7			161.65 m ²	

点名	X座標	Y座標	辺長	方向角	測角	DX	倍積 (Y×DX)
74-14	41693.220	-68016.860	10.725	178-25-07	89-59-42	-11.068	752810.606480
74-25	41682.499	-68016.564	15.451	88-23-26	89-58-19	-10.287	699686.393868
74-15	41682.933	-68001.119	7.901	358-25-34	90-02-08	8.332	-566585.323508
74-4	41690.831	-68001.336	3.997	313-11-44	134-46-10	10.634	-723126.207024
74-3	41693.567	-68004.250	12.615	268-25-25	135-13-41	2.389	-162462.153250
						倍面積	323.316566
						面積	161.6582830

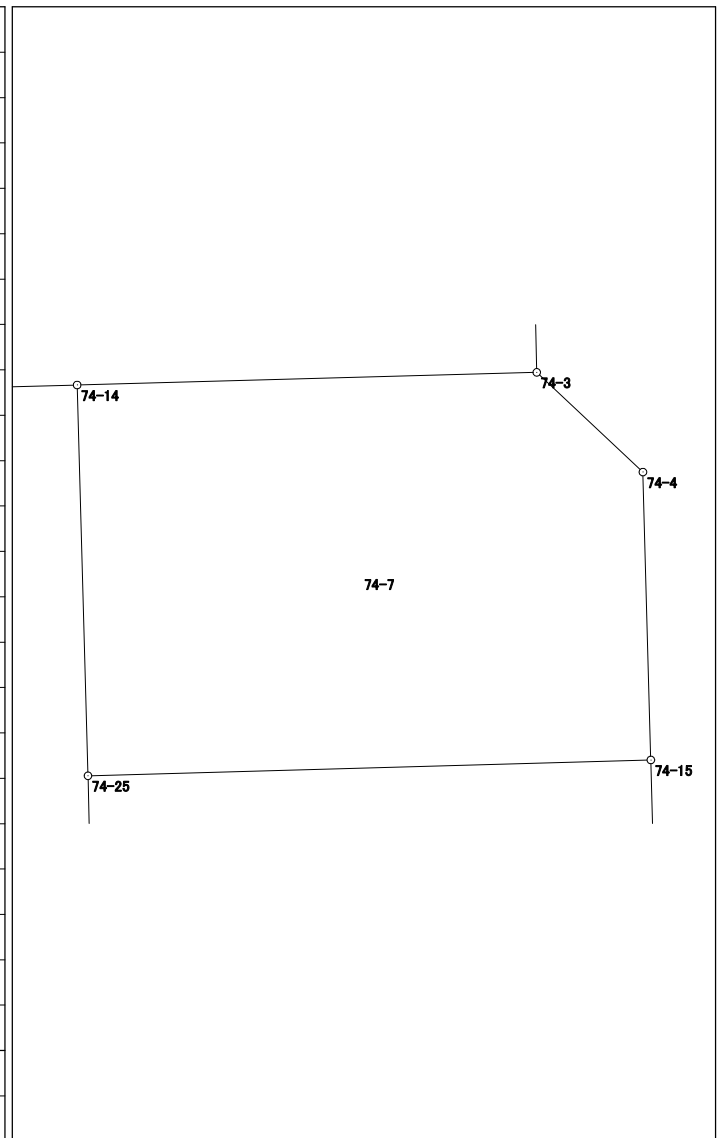

面積計算書（座標法）

世界測地系（測地成果2011）

所 在	地 番	公簿地目	現況地目	地 積	所 有 者
前橋市六供町一丁目	74-10			558.13 m ²	


点 名	X 座標	Y 座標	辺 長	方 向 角	測 角	DX	倍 積 (Y×DX)	
74-203	41668.123	-68136.603	11.979	180-06-53	89-59-58	-11.941	813619.176423	
74-38	41656.144	-68136.627	25.788	90-09-28	90-02-35	-12.050	821046.355350	
74-43	41656.073	-68110.839	11.091	180-05-35	269-56-07	-11.162	760253.184918	
74-37	41644.982	-68110.857	14.156	90-06-48	90-01-13	-11.119	757324.618983	
74-208	41644.954	-68096.701	19.658	358-25-02	88-18-14	19.622	-1336193.467022	
74-210	41664.604	-68097.244	20.362	270-06-45	91-41-43	19.690	-1340834.734360	
74-209	41664.644	-68117.606	3.442	358-24-07	268-17-22	3.481	-237117.386486	
74-204	41668.085	-68117.702	18.901	270-06-55	91-42-48	3.479	-236981.485258	
倍面積							1116.262548	
面 積							558.1312740	

面積計算書（座標法）

世界測地系（測地成果2011）

所在	地番	公簿地目	現況地目	地積	所有者
前橋市六供町一丁目	74-11			286.47 m ²	

点名	X座標	Y座標	辺長	方向角	測角	DX	倍積 (Y×DX)
74-38	41656.144	-68136.627	11.125	180-06-29	89-57-01	-11.054	753182.274858
74-7	41645.019	-68136.648	25.791	90-04-56	89-58-27	-11.162	760541.264976
74-37	41644.982	-68110.857	11.091	0-05-35	90-00-39	11.054	-752897.413278
74-43	41656.073	-68110.839	25.788	270-09-28	90-03-53	11.162	-760253.184918
						倍面積	572.941638
						面積	286.4708190

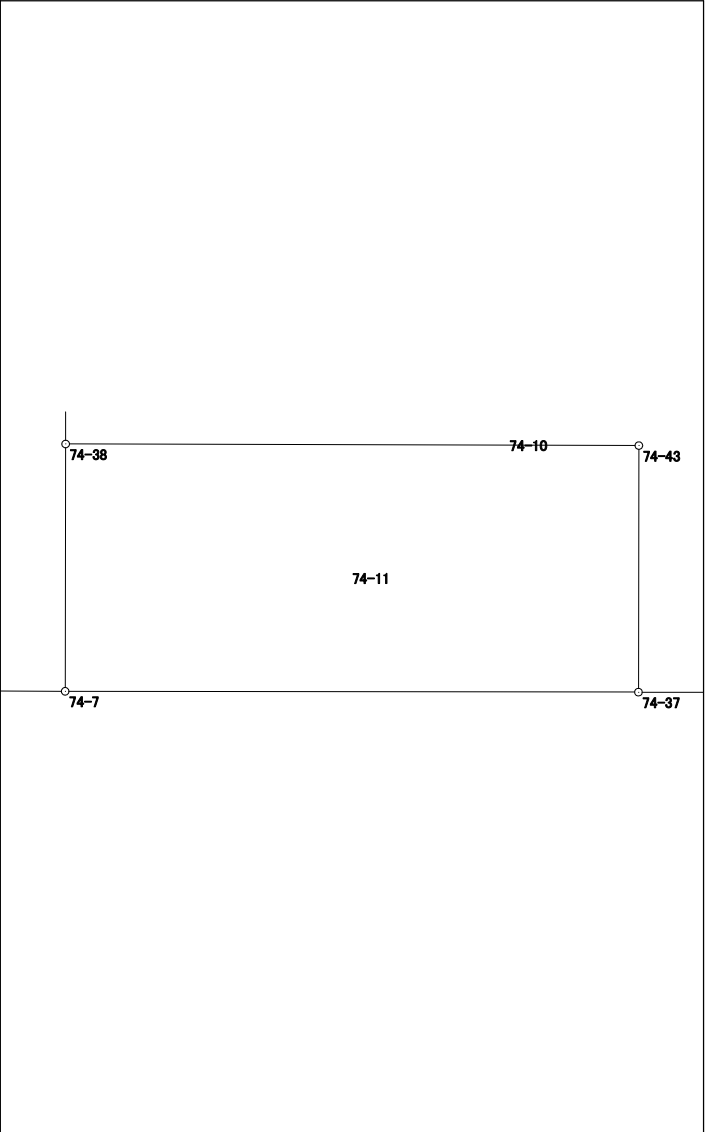


面積計算書 (座標法)

世界測地系 (測地成果2011)

所在	地番	公簿地目	現況地目	地積	所有者
前橋市六供町一丁目	74-保-1			159.00 m ²	

点名	X座標	Y座標	辺長	方向角	測角	DX	倍積 (Y×DX)
74-211	41670.251	-68022.451	25.454	178-25-02	90-00-37	-25.617	1742531.127267
74-212	41644.807	-68021.748	6.227	90-07-44	91-42-42	-25.458	1731697.660584
74-16	41644.793	-68015.521	25.641	358-24-56	88-17-12	25.617	-1742353.601457
74-42	41670.424	-68016.230	6.223	268-24-25	89-59-29	25.458	-1731557.183340
						倍面積	318.003054
						面積	159.0015270

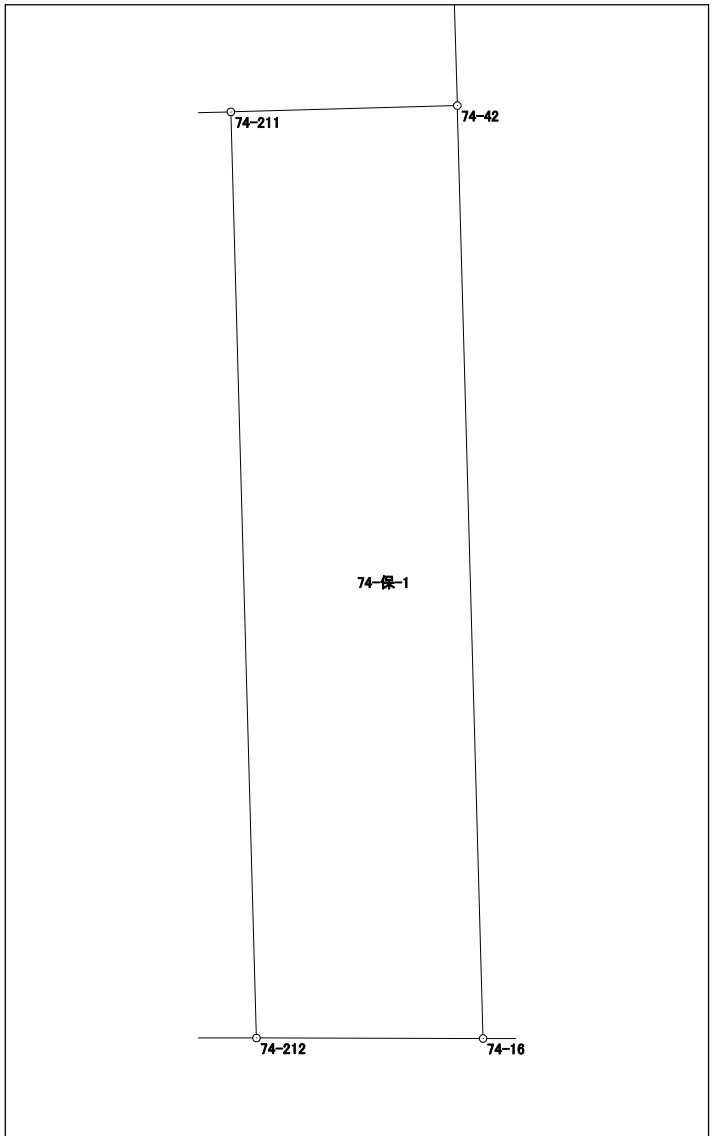


面積計算書（座標法）

世界測地系（測地成果2011）

所 在	地 番	公簿地目	現況地目	地 積	所 有 者
前橋市六供町一丁目	74-保-2			121.00 m ²	

点 名	X 座標	Y 座標	辺 長	方 向 角	測 角	DX	倍 積 (Y×DX)
74-17	41644.867	-68048.945	24.637	358-23-59	88-19-57	24.624	-1675637.221680
74-40	41669.494	-68049.633	22.808	358-25-47	180-01-48	47.426	-3227321.894658
74-13	41692.293	-68050.258	2.555	268-28-30	90-02-43	22.731	-1546850.414598
74-213	41692.225	-68052.812	47.373	178-24-55	89-56-25	-47.423	3227268.503476
74-214	41644.870	-68051.502	2.557	90-04-02	91-39-07	-47.358	3222783.031716

倍面積	242.004256
面 積	121.0021280

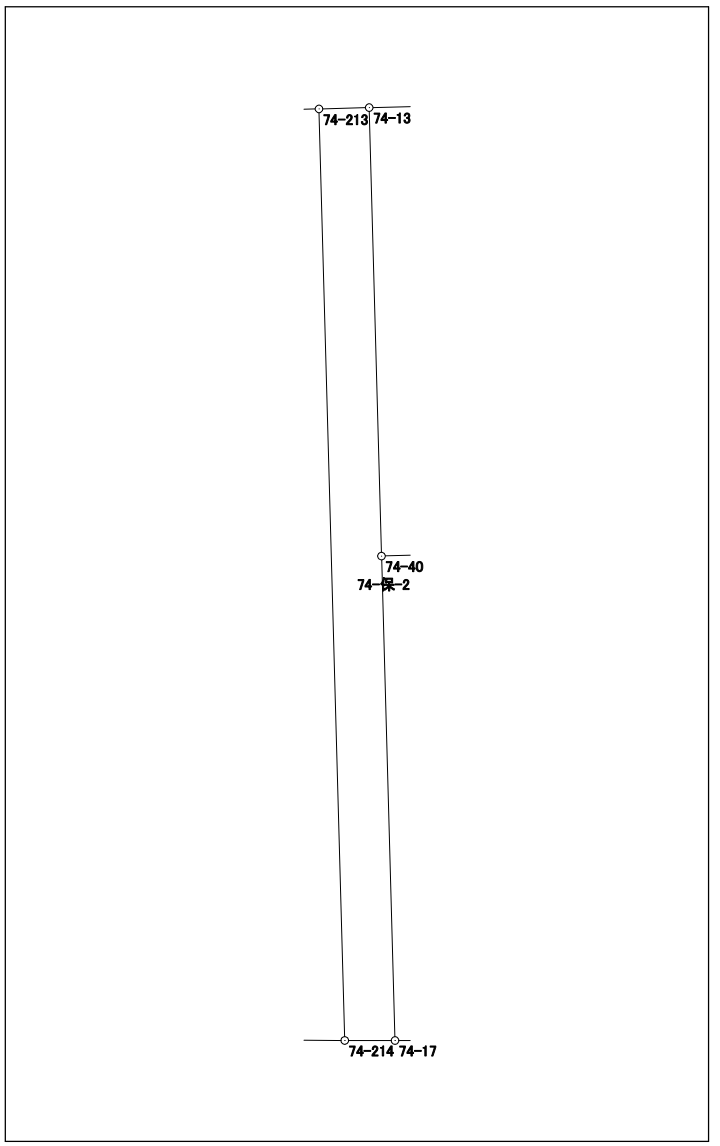


面積計算書（座標法）

世界測地系（測地成果2011）

所 在	地 番	公簿地目	現況地目	地 積	所 有 者
前橋市六供町一丁目	74-保-4			233.00 m ²	

点 名	X 座 標	Y 座 標	辺 長	方 向 角	測 角	DX	倍 積 (Y×DX)
74-202	41677.433	-68090.405	1.655	268-24-25	89-59-19	6.581	-448102.955305
74-206	41677.387	-68092.059	5.538	268-25-01	180-00-36	-0.199	13550.319741
74-207	41677.234	-68097.595	12.635	178-24-29	89-59-28	-12.783	870491.556885
74-210	41664.604	-68097.244	19.658	178-25-02	180-00-33	-32.280	2198179.036320
74-208	41644.954	-68096.701	7.198	90-06-41	91-41-39	-19.664	1339053.528464
74-19	41644.940	-68089.503	22.878	358-24-07	88-17-26	22.855	-1556185.591065
74-215	41667.809	-68090.141	2.998	358-27-07	180-03-00	25.866	-1761219.587106
74-22	41670.806	-68090.222	6.630	358-25-06	179-57-59	9.624	-655300.296528

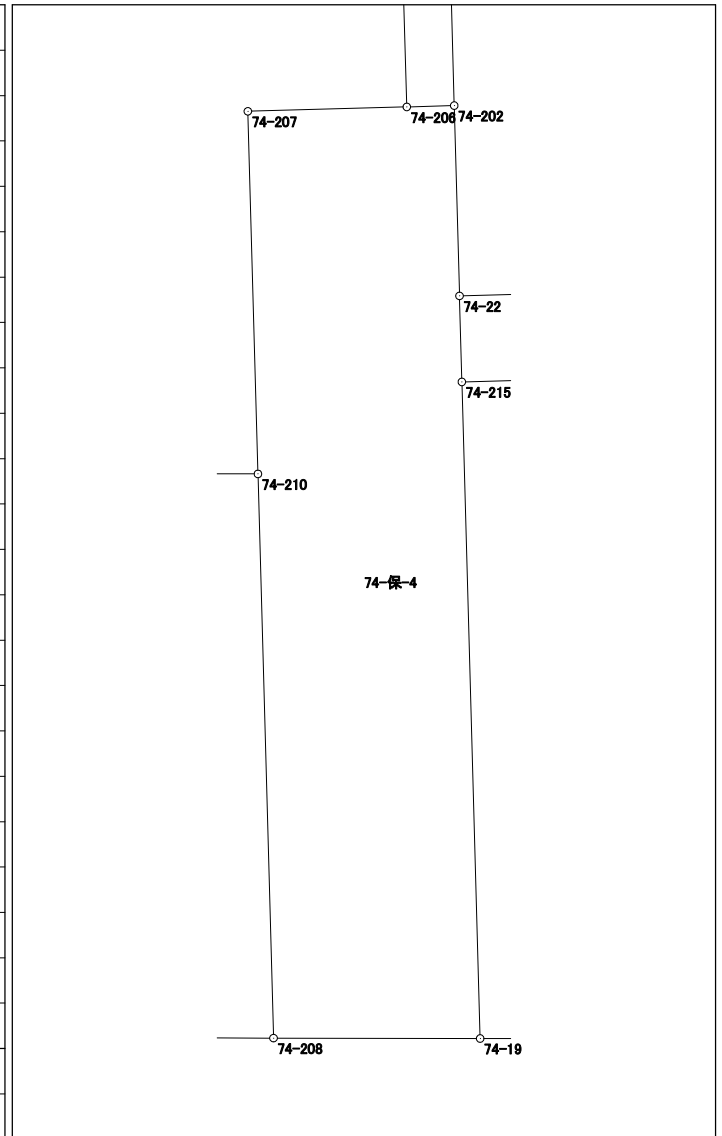

倍面積	466.011406
面 積	233.0057030