



75-1 街区  
75-2 街区

画地出来形確認図 ( 317.76 m<sup>2</sup> )  
( 1073.98 m<sup>2</sup> )

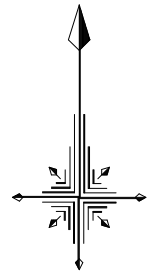

S=1/500

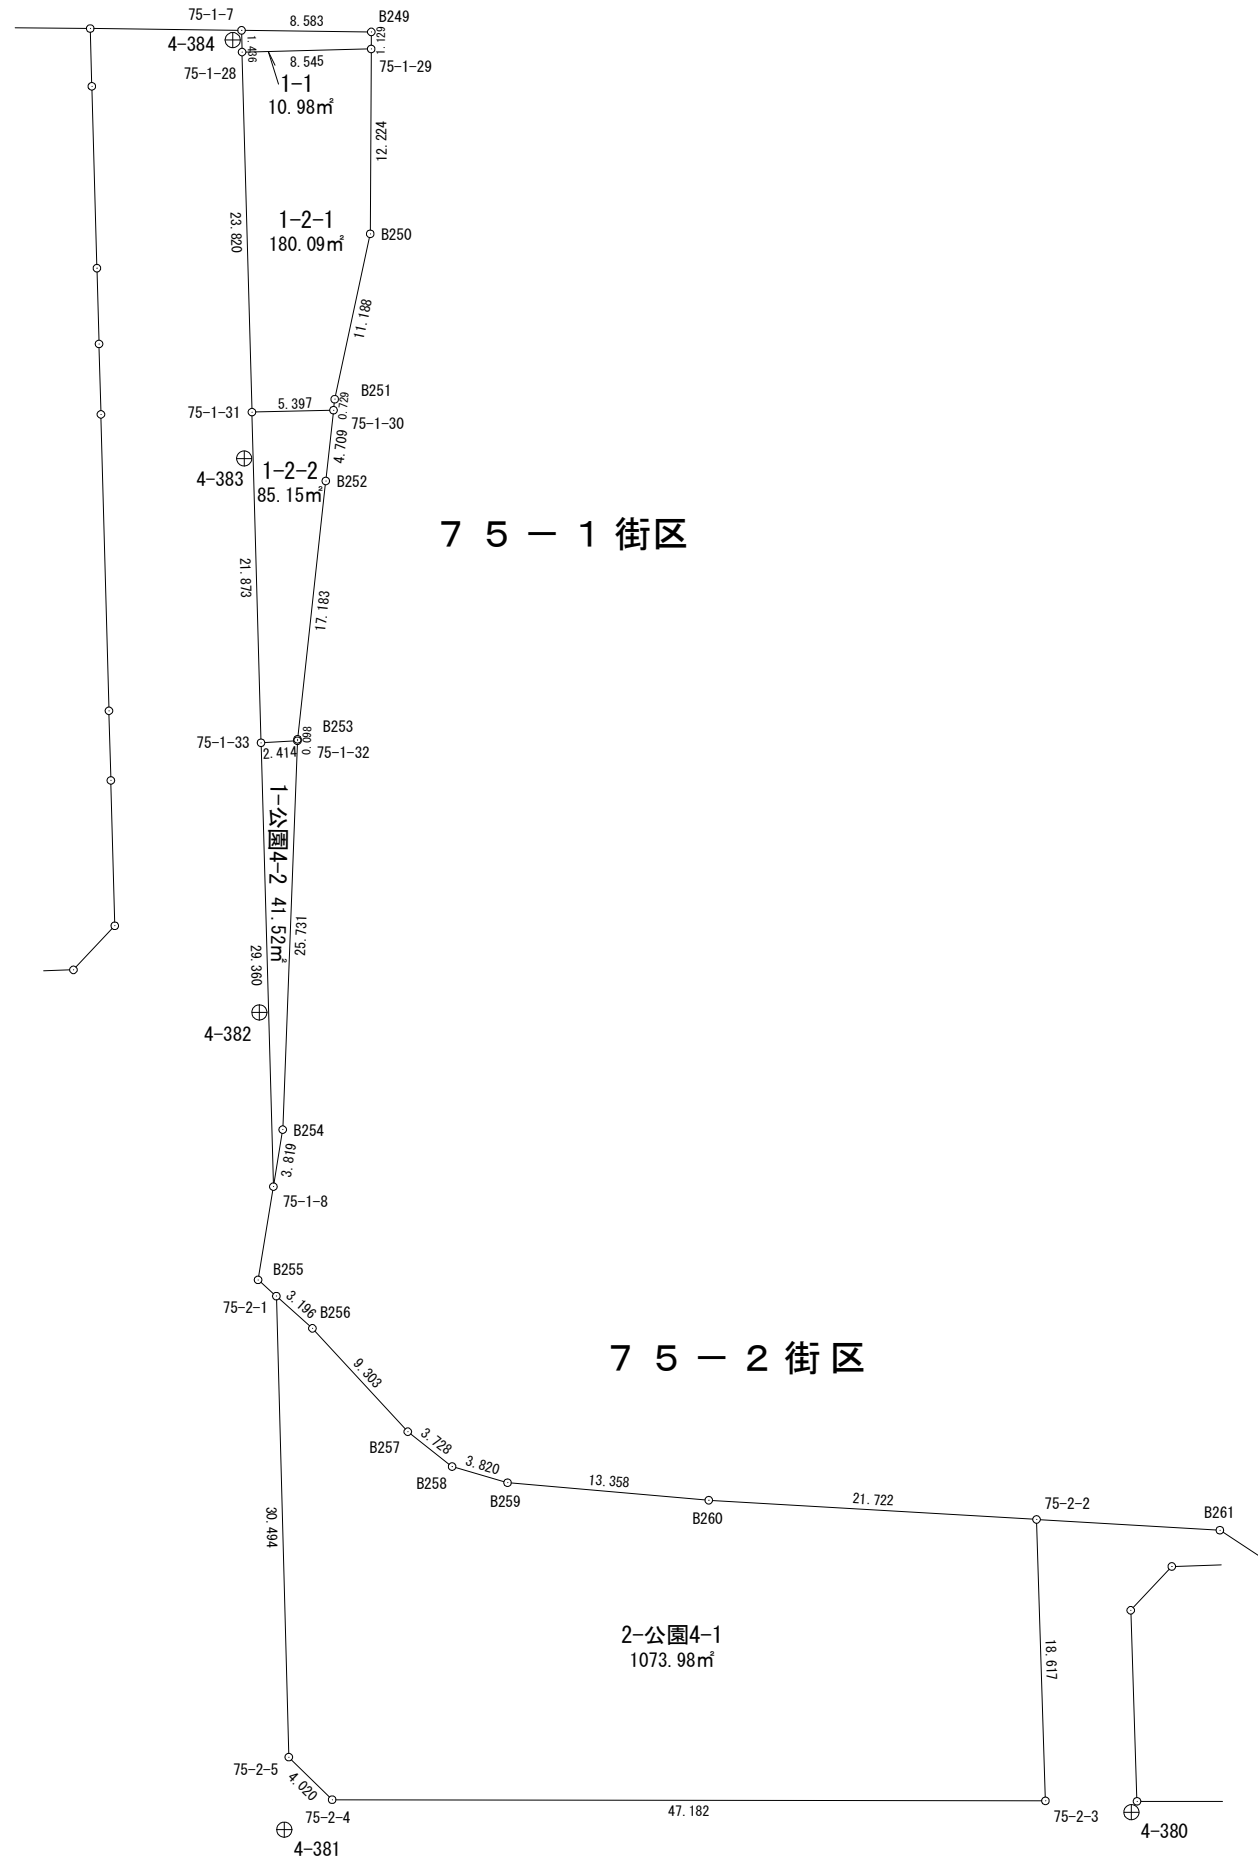

75-1 街区

75-2 街区

2-公園4-1  
1073.98 m<sup>2</sup>


3. 5. 6 5 六供生川線

面積計算書（座標法）

世界測地系（測地成果2011）

所在	地番	公簿地目	現況地目	地積	所有者
前橋市六供町一丁目	75-2-公園4-1			1073.98 m <sup>2</sup>	

点名	X座標	Y座標	辺長	方向角	測角	Dx	倍積(Y×Dx)
75-2-1	41677.993	-67990.974	30.494	178-27-19	46-42-52	-28.355	1927884.067770
75-2-5	41647.510	-67990.152	4.020	134-26-45	135-59-26	-33.298	2263936.081296
75-2-4	41644.695	-67987.282	47.182	90-05-37	135-38-52	-2.892	196619.219544
75-2-3	41644.618	-67940.100	18.617	358-11-24	88-05-47	18.531	-1258997.993100
75-2-2	41663.226	-67940.688	21.722	273-21-16	95-09-52	19.879	-1350592.936752
B260	41664.497	-67962.373	13.358	274-58-54	181-37-38	2.431	-165216.528763
B259	41665.657	-67975.681	3.820	286-13-10	191-14-16	2.227	-151381.841587
B258	41666.724	-67979.349	3.728	308-11-30	201-58-20	3.372	-229226.364828
B257	41669.029	-67982.279	9.303	317-17-29	189-05-59	9.141	-621426.012339
B256	41675.865	-67988.589	3.196	311-44-27	174-26-58	8.964	-609449.711796

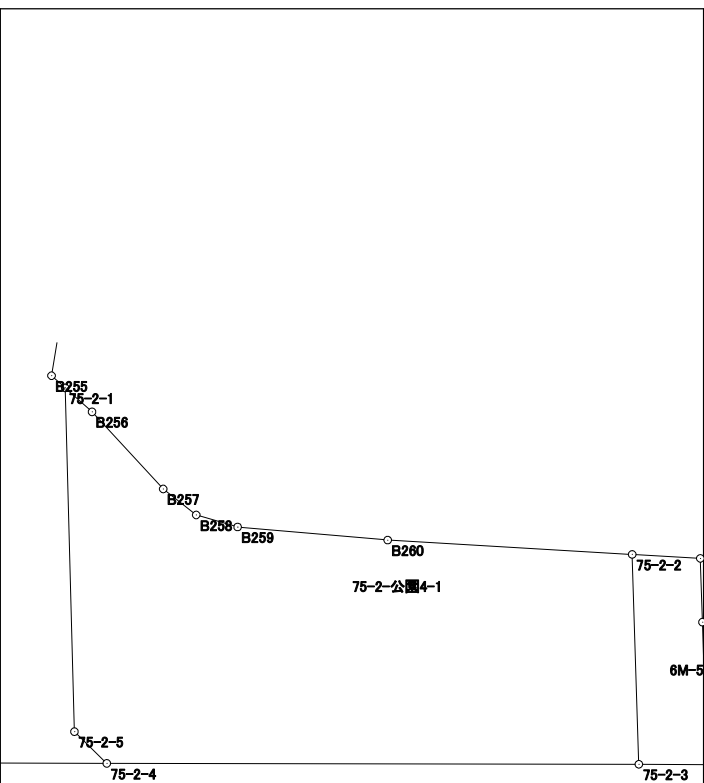

倍面積	2147.979445
面積	1073.9897225