



7-1 街区
7-2 街区
7-3 街区

画地出来形確認図

(782.02m²)
(754.36m²)
(365.35m²)

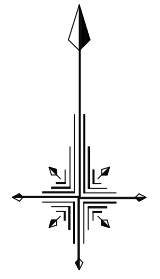

S=1/500

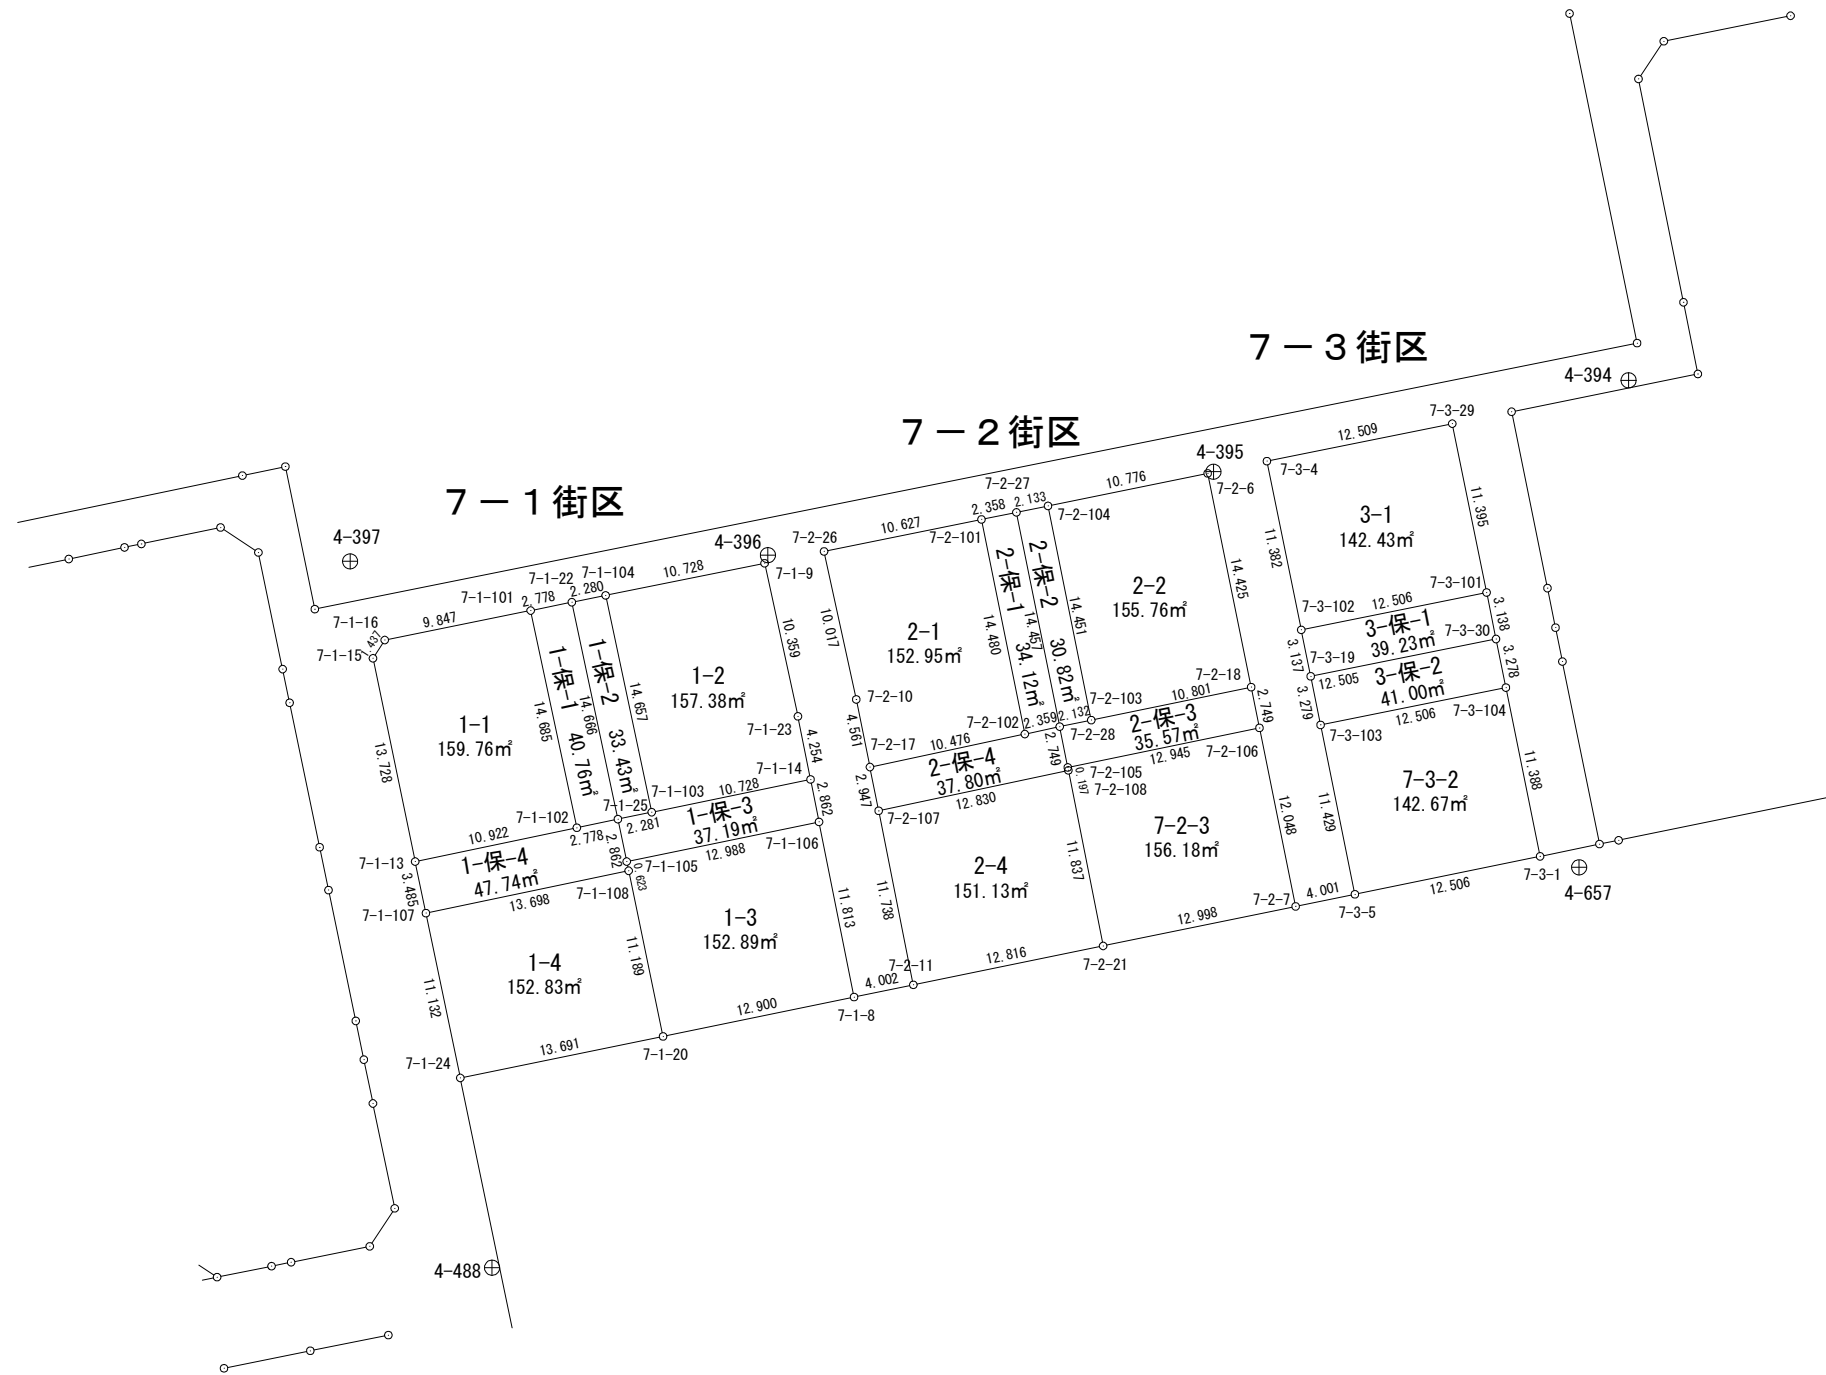


面積計算書 (座標法)

世界測地系 (測地成果2011)

所在	地番	公簿地目	現況地目	地積	所有者
前橋市六供町一丁目	7-2-1			152.95 m ²	


点名	X座標	Y座標	辺長	方向角	測角	DX	倍積 (Y×DX)	
7-2-101	41918.211	-68362.704	10.627	258-31-11	89-56-23	12.078	-825684.738912	
7-2-26	41916.096	-68373.118	10.017	167-43-03	89-11-52	-11.903	813845.223554	
7-2-10	41906.308	-68370.987	4.561	168-34-10	180-51-07	-14.259	974901.903633	
7-2-17	41901.837	-68370.083	10.476	77-58-59	89-24-49	-2.290	156567.490070	
7-2-102	41904.018	-68359.837	14.480	348-34-48	90-35-49	16.374	-1119323.971038	
							倍面積	305.907307
							面積	152.9536535

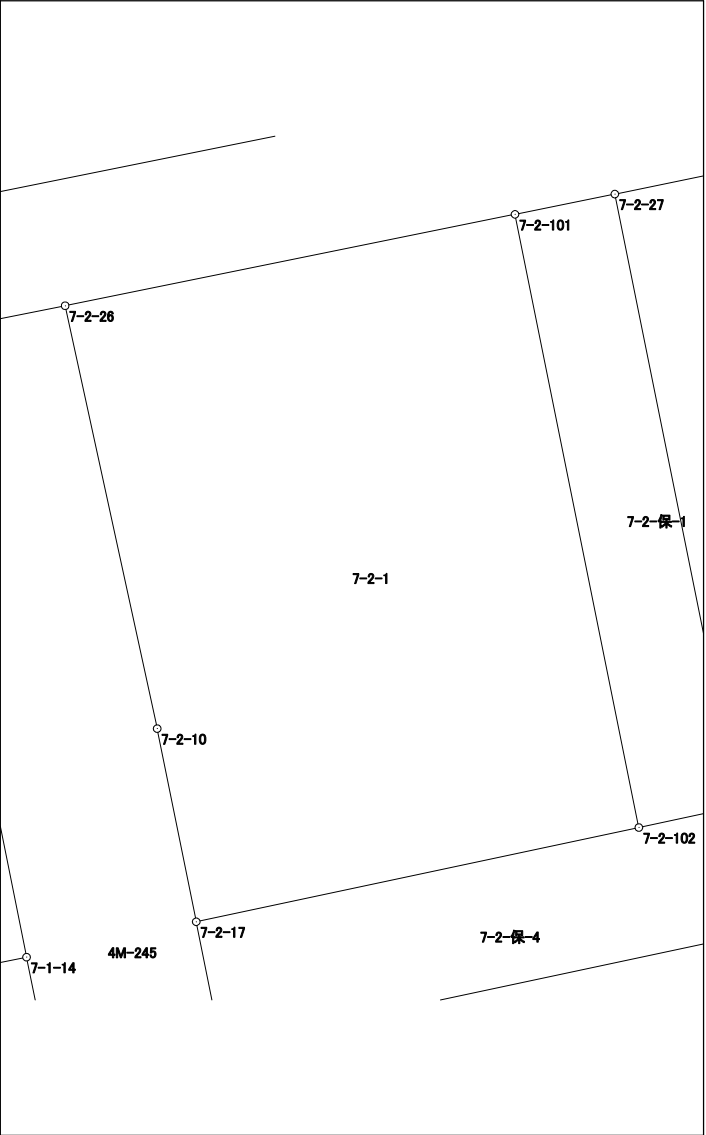

面積計算書 (座標法)

世界測地系 (測地成果2011)

所在	地番	公簿地目	現況地目	地積	所有者
前橋市六供町一丁目	7-2-3			156.18 m ²	

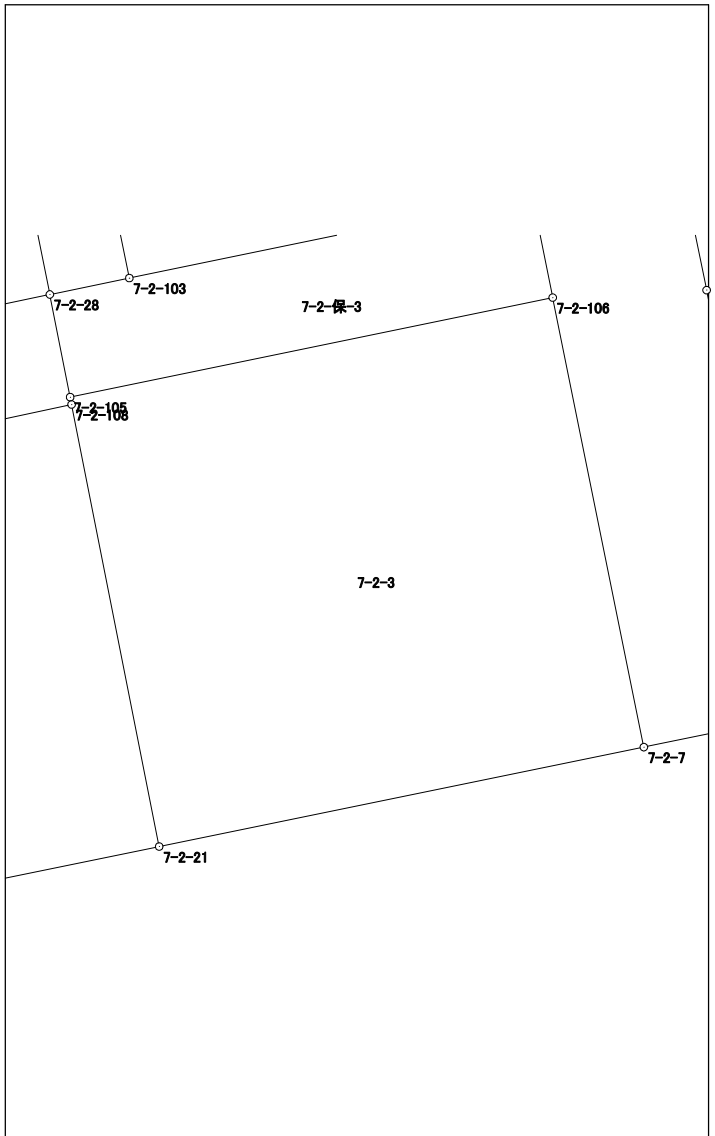
点名	X座標	Y座標	辺長	方向角	測角	DX	倍積 (Y×DX)	
7-2-105	41901.812	-68356.996	0.197	168-51-41	90-30-57	-2.808	191946.444768	
7-2-108	41901.619	-68356.958	11.837	168-47-26	179-55-45	-11.804	806885.532232	
7-2-21	41890.008	-68354.657	12.998	78-24-42	89-37-16	-9.000	615191.913000	
7-2-7	41892.619	-68341.924	12.048	348-32-20	90-07-38	14.419	-985422.202156	
7-2-106	41904.427	-68344.318	12.945	258-20-44	89-48-24	9.193	-628289.315374	
							倍面積	
							面積	156.1862350

面積計算書（座標法）

世界測地系（測地成果2011）

所 在	地 番	公簿地目	現況地目	地 積	所 有 者
前橋市六供町一丁目	7-2-4			151.13 m ²	

点 名	X 座標	Y 座標	辺 長	方 向 角	測 角	DX	倍 積 (Y×DX)
7-2-107	41898.947	-68369.507	11.738	168-43-28	90-44-41	-14.183	969684.717781
7-2-11	41887.436	-68367.212	12.816	78-25-22	89-41-54	-8.939	611134.508068
7-2-21	41890.008	-68354.657	11.837	348-47-26	90-22-04	14.183	-969474.100231
7-2-108	41901.619	-68356.958	12.830	257-58-47	89-11-21	8.939	-611042.847562
倍面積							302.278056
面 積							151.1390280

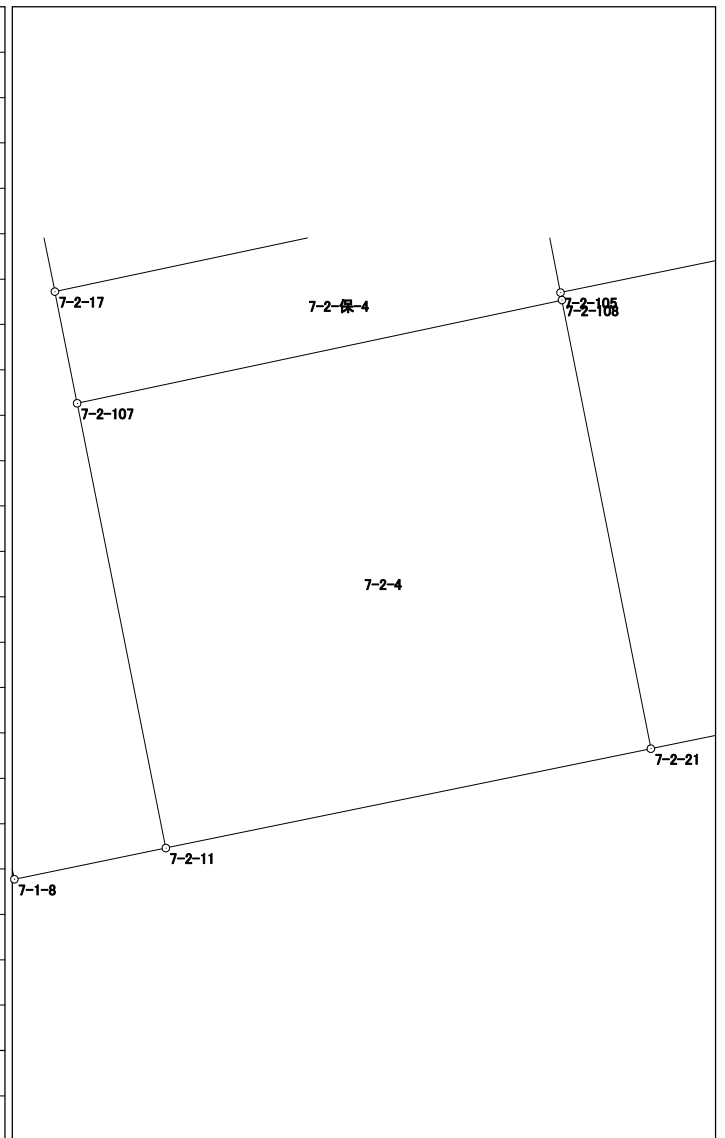


面積計算書（座標法）

世界測地系（測地成果2011）

所在	地番	公簿地目	現況地目	地積	所有者
前橋市六供町一丁目	7-2-保-2			30.82 m ²	

点名	X座標	Y座標	辺長	方向角	測角	DX	倍積 (Y×DX)
7-2-28	41904.509	-68357.530	2.132	78-20-13	89-45-32	-13.740	939232.462200
7-2-103	41904.940	-68355.442	14.451	348-34-52	90-14-39	14.596	-997716.031432
7-2-104	41919.105	-68358.303	2.133	258-30-20	89-55-28	13.740	-939243.083220
7-2-27	41918.680	-68360.393	14.457	168-34-41	90-04-21	-14.596	997788.296228
倍面積						61.643776	
面積						30.8218880	

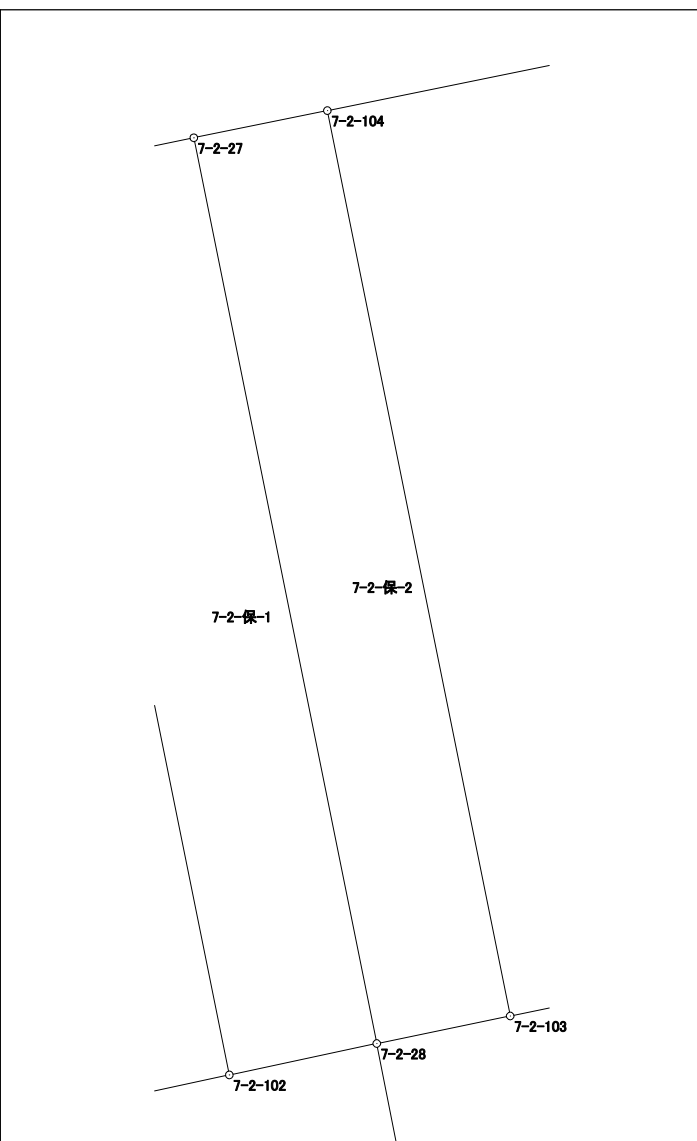

面積計算書 (座標法)

世界測地系 (測地成果2011)

所 在	地 番	公簿地目	現況地目	地 積	所 有 者
前橋市六供町一丁目	7-2-保-3			35.57 m ²	

点 名	X 座標	Y 座標	辺 長	方 向 角	測 角	DX	倍 積 (Y×DX)	
7-2-103	41904.940	-68355.442	2.132	258-20-13	179-59-13	-2.612	178544.414504	
7-2-28	41904.509	-68357.530	2.749	168-48-01	90-27-48	-3.128	213822.353840	
7-2-105	41901.812	-68356.996	12.945	78-20-44	89-32-43	-0.082	5605.273672	
7-2-106	41904.427	-68344.318	2.749	348-32-34	90-11-50	5.309	-362839.984262	
7-2-18	41907.121	-68344.864	10.801	258-21-00	89-48-26	0.513	-35060.915232	
						倍面積	71.142522	
						面 積	35.5712610	

面積計算書（座標法）

世界測地系（測地成果2011）

所 在	地 番	公簿地目	現況地目	地 積	所 有 者
前橋市六供町一丁目	7-2-保-4			37.80 m ²	

点 名	X 座標	Y 座標	辺 長	方 向 角	測 角	DX	倍 積 (Y×DX)	
7-2-102	41904.018	-68359.837	10.476	257-58-59	179-59-53	-2.672	182657.484464	
7-2-17	41901.837	-68370.083	2.947	168-43-42	90-44-43	-5.071	346704.690893	
7-2-107	41898.947	-68369.507	12.830	77-58-47	89-15-05	-0.218	14904.552526	
7-2-108	41901.619	-68356.958	0.197	348-51-41	90-52-54	2.865	-195842.684670	
7-2-105	41901.812	-68356.996	2.749	348-48-01	179-56-20	2.890	-197551.718440	
7-2-28	41904.509	-68357.530	2.359	257-59-06	89-11-05	2.206	-150796.711180	
						倍面積	75.613593	
						面 積	37.8067965	