



# 80-2街区 画地出来形確認図 (1149.59m<sup>2</sup>)

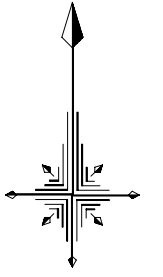

S=1/500

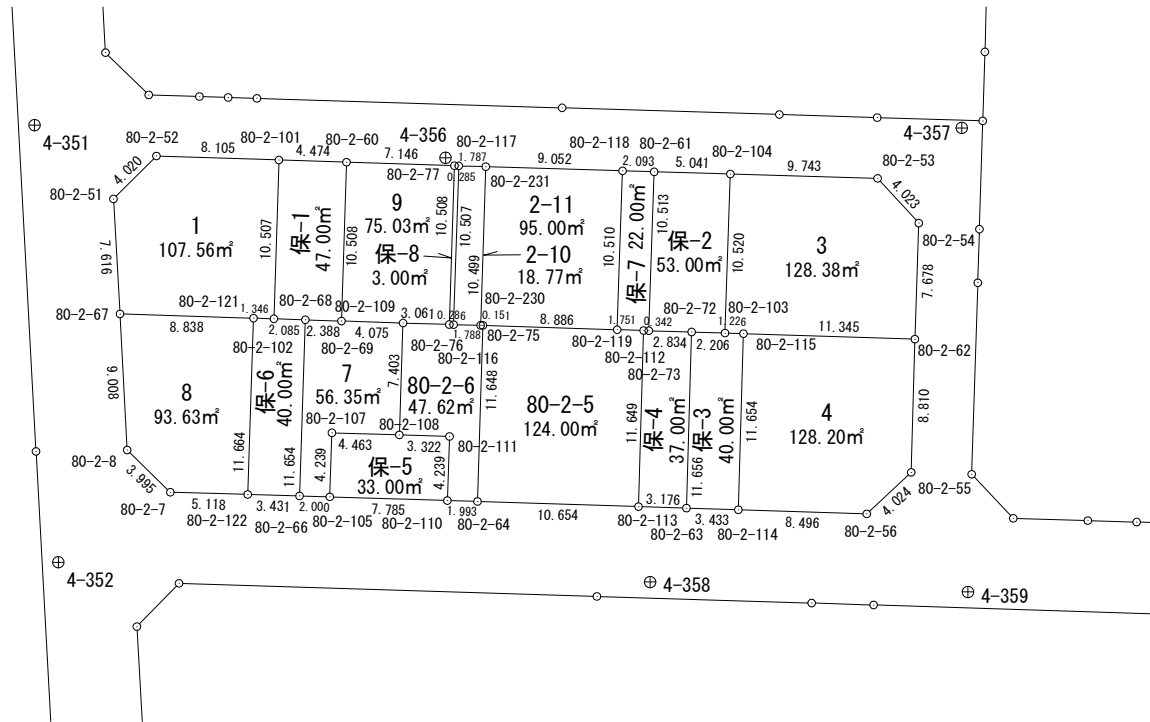


# 面積計算書 (座標法)

世界測地系 (測地成果2011)

所在	地番	公簿地目	現況地目	地積	所有者
前橋市六供町四丁目	80-2-1			107.56 m <sup>2</sup>	

点名	X座標	Y座標	辺長	方向角	測角	DX	倍積 (Y×DX)
80-2-101	41542.470	-67791.287	8.105	271-52-25	90-03-47	10.767	-729908.787129
80-2-52	41542.735	-67799.388	4.020	225-00-36	133-08-11	-2.577	174719.022876
80-2-51	41539.893	-67802.231	7.616	176-44-27	131-43-51	-10.446	708262.105026
80-2-67	41532.289	-67801.798	8.838	91-48-32	95-04-05	-7.883	534481.573634
80-2-121	41532.010	-67792.964	1.346	91-47-19	179-58-47	-0.321	21761.541444
80-2-102	41531.968	-67791.619	10.507	1-48-38	90-01-19	10.460	-709100.334740

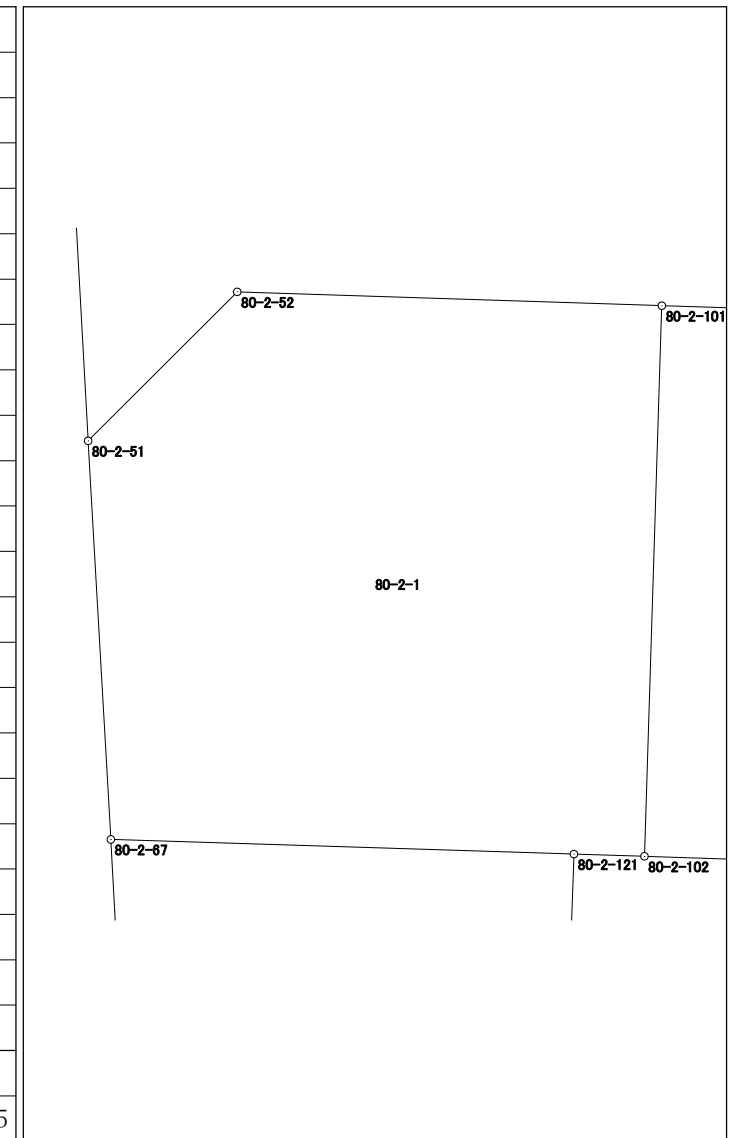


倍面積	215.121111
面積	107.5605555

# 面積計算書 (座標法)

世界測地系 (測地成果2011)

所 在	地 番	公簿地目	現況地目	地 積	所 有 者
前橋市六供町四丁目	80-2-3			128.38 m <sup>2</sup>	

点 名	X 座標	Y 座標	辺 長	方 向 角	測 角	DX	倍 積 (Y×DX)
80-2-103	41531.026	-67761.781	1.226	91-52-13	89-55-12	-10.554	715157.836674
80-2-115	41530.986	-67760.556	11.345	91-50-56	179-58-43	-0.406	27510.785736
80-2-62	41530.620	-67749.217	7.678	1-54-38	90-03-42	7.308	-495111.277836
80-2-54	41538.294	-67748.961	4.023	317-23-52	135-29-14	10.635	-720510.200235
80-2-53	41541.255	-67751.684	9.743	271-40-34	134-16-42	3.246	-219921.966264
80-2-104	41541.540	-67761.423	10.520	181-57-01	90-16-27	-10.229	693131.595867

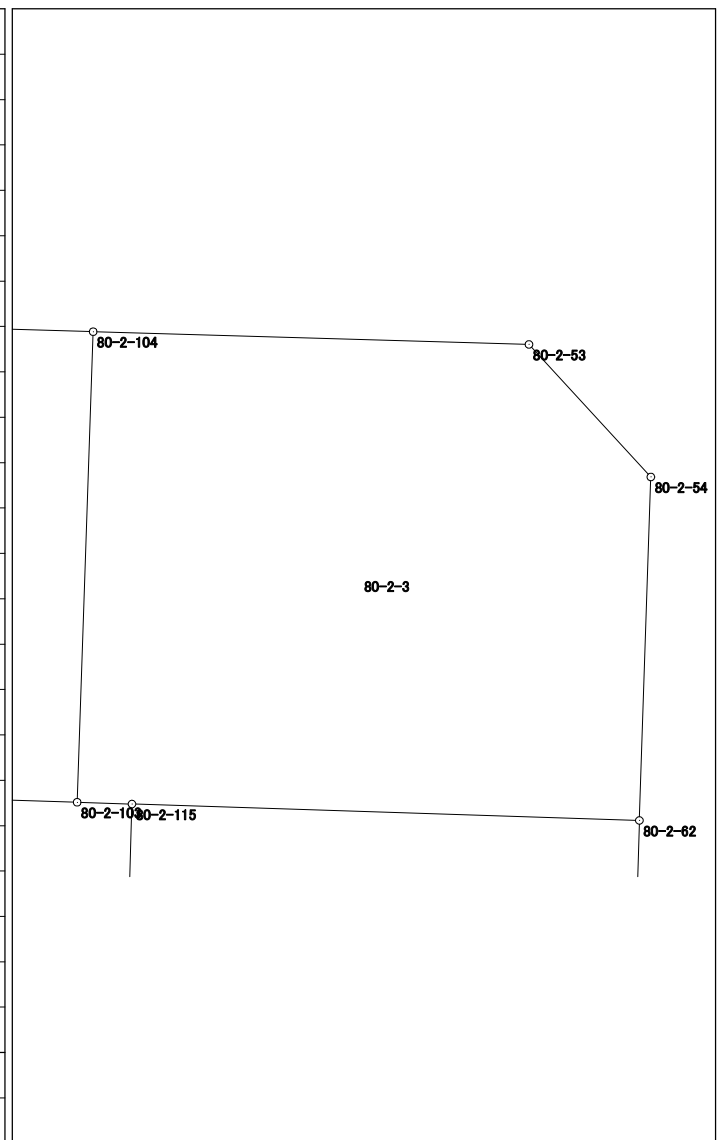


倍面積	256.773942
面 積	128.3869710

# 面積計算書 (座標法)

世界測地系 (測地成果2011)

所 在	地 番	公簿地目	現況地目	地 積	所 有 者
前橋市六供町四丁目	80-2-4			128.20 m <sup>2</sup>	

点 名	X 座標	Y 座標	辺 長	方 向 角	測 角	DX	倍 積 (Y×DX)
80-2-114	41519.337	-67760.895	8.496	91-49-16	90-09-15	-11.919	807642.107505
80-2-56	41519.067	-67752.403	4.024	46-57-50	135-08-34	2.476	-167754.949828
80-2-55	41521.813	-67749.462	8.810	1-35-37	134-37-47	11.553	-782709.534486
80-2-62	41530.620	-67749.217	11.345	271-50-56	90-15-19	9.173	-621463.567541
80-2-115	41530.986	-67760.556	11.654	181-40-01	89-49-05	-11.283	764542.353348
						倍面積	256.408998
						面 積	128.2044990

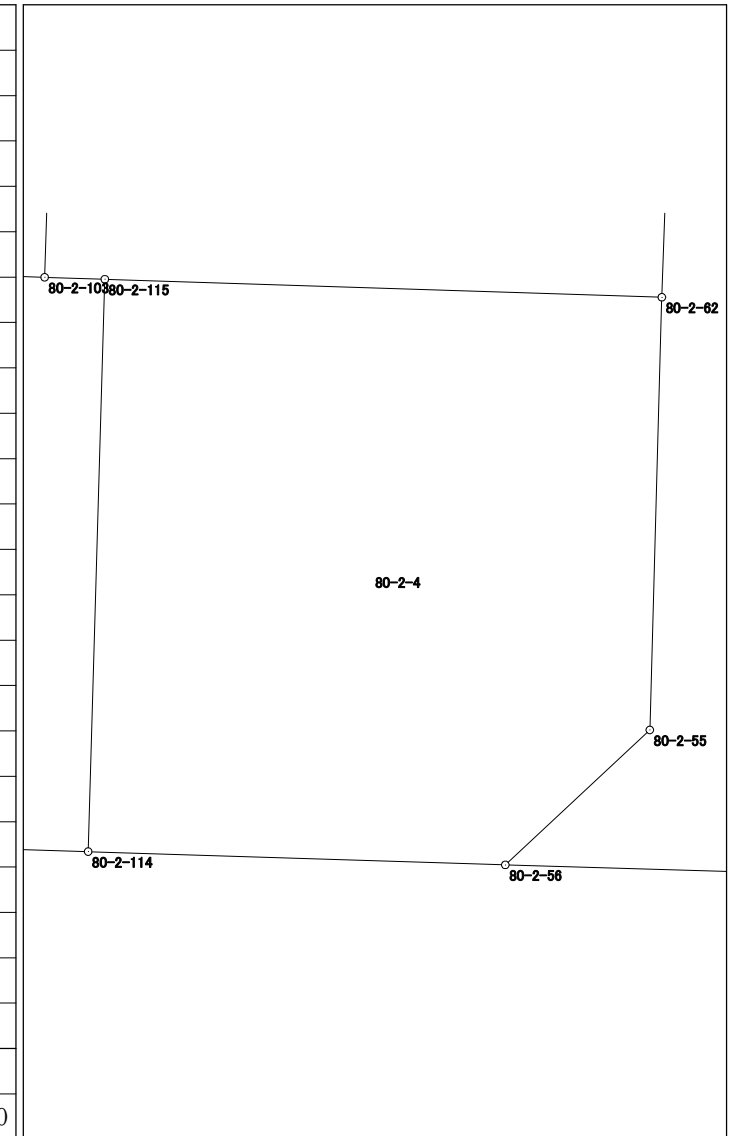


# 面積計算書 (座標法)

世界測地系 (測地成果2011)

所在	地番	公簿地目	現況地目	地積	所有者
前橋市六供町四丁目	80-2-5			124.00 m <sup>2</sup>	

点名	X座標	Y座標	辺長	方向角	測角	DX	倍積 (Y×DX)
80-2-75	41531.531	-67777.792	11.648	181-45-23	89-55-29	-11.359	769887.939328
80-2-64	41519.888	-67778.149	10.654	91-50-03	90-04-40	-11.984	812253.337616
80-2-113	41519.547	-67767.500	11.649	1-40-03	89-50-00	11.303	-765976.052500
80-2-112	41531.191	-67767.161	1.751	271-49-58	90-09-55	11.700	-792875.783700
80-2-119	41531.247	-67768.911	8.886	271-49-54	179-59-56	0.340	-23041.429740

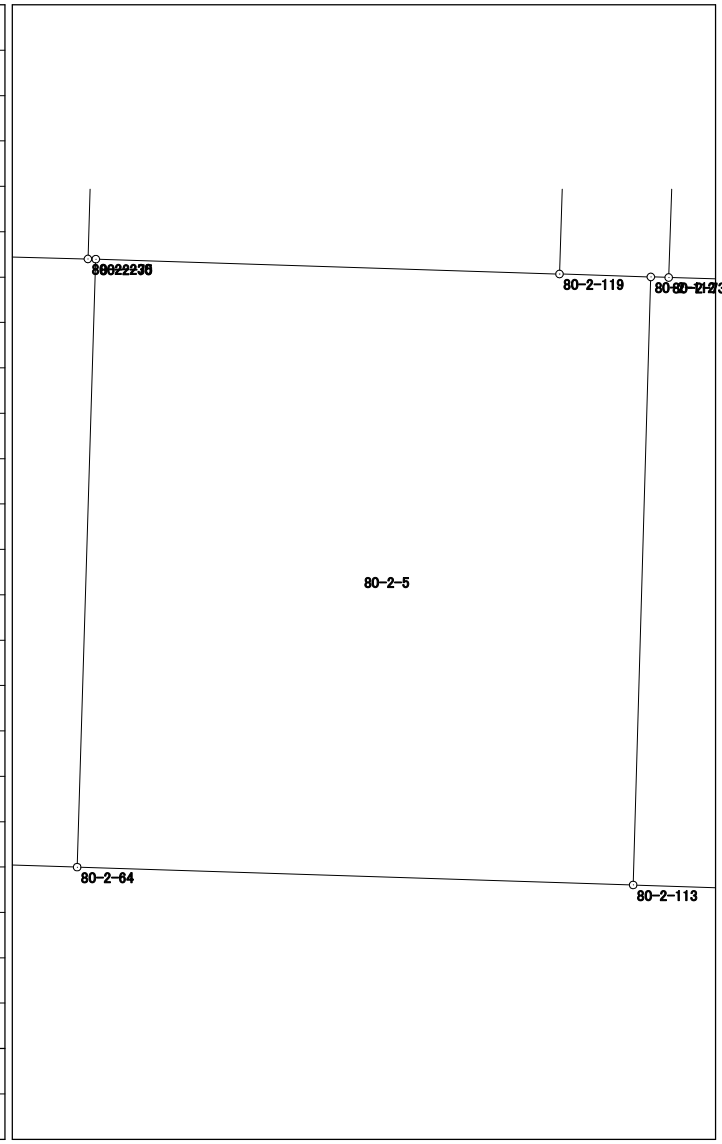

倍面積	248.011004
面積	124.0055020




# 面積計算書（座標法）

世界測地系（測地成果2011）

所在	地番	公簿地目	現況地目	地積	所有者
前橋市六供町四丁目	80-2-7			56.35 m <sup>2</sup>	

点名	X座標	Y座標	辺長	方向角	測角	DX	倍積 (Y×DX)
80-2-68	41531.902	-67789.535	11.654	181-53-53	89-55-50	-11.566	784053.761810
80-2-66	41520.254	-67789.921	2.000	91-46-35	89-52-42	-11.710	793819.974910
80-2-105	41520.192	-67787.922	4.239	1-53-33	90-06-58	4.175	-283014.574350
80-2-107	41524.429	-67787.782	4.463	91-47-05	269-53-32	4.098	-277794.330636
80-2-108	41524.290	-67783.321	7.403	1-54-15	90-07-10	7.260	-492106.910460
80-2-109	41531.689	-67783.075	4.075	271-50-32	89-56-17	7.530	-510406.554750
80-2-69	41531.820	-67787.148	2.388	271-58-03	180-07-31	0.213	-14438.662524
倍面積						112.704000	
面積						56.3520000	

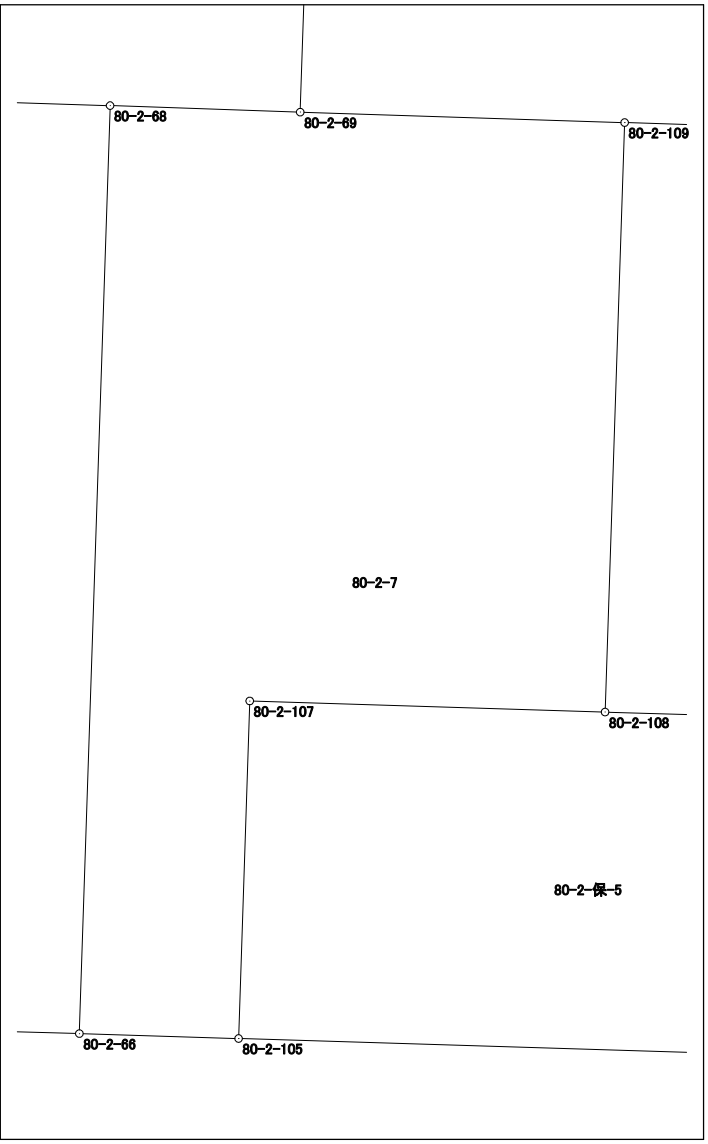









# 面積計算書 (座標法)

世界測地系 (測地成果2011)

所 在	地 番	公簿地目	現況地目	地 積	所 有 者
前橋市六供町四丁目	80-2-11			95.00 m <sup>2</sup>	


点 名	X 座 標	Y 座 標	辺 長	方 向 角	測 角	DX	倍 積 (Y×DX)	
80-2-230	41531.535	-67777.943	0.151	91-31-03	89-39-22	-10.497	711465.067671	
80-2-75	41531.531	-67777.792	8.886	91-49-54	180-18-51	-0.288	19520.004096	
80-2-119	41531.247	-67768.911	10.510	1-56-48	90-06-54	10.220	-692598.270420	
80-2-118	41541.751	-67768.554	9.052	271-45-13	89-48-25	10.781	-730612.780674	
80-2-231	41542.028	-67777.602	10.499	181-51-41	90-06-28	-10.216	692415.982032	
							倍面積	190.002705
							面 積	95.0013525

# 面積計算書（座標法）

世界測地系（測地成果2011）

所 在	地 番	公簿地目	現況地目	地 積	所 有 者
前橋市六供町四丁目	80-2-保-1			47.00 m <sup>2</sup>	


点 名	X 座標	Y 座標	辺 長	方 向 角	測 角	DX	倍 積 (Y×DX)
80-2-60	41542.323	-67786.815	4.474	271-52-58	90-04-01	10.650	-721929.579750
80-2-101	41542.470	-67791.287	10.507	181-48-38	89-55-40	-10.355	701978.776885
80-2-102	41531.968	-67791.619	2.085	91-48-50	90-00-12	-10.568	716421.829592
80-2-68	41531.902	-67789.535	2.388	91-58-03	180-09-13	-0.148	10032.851180
80-2-69	41531.820	-67787.148	10.508	1-48-57	89-50-54	10.421	-706409.869308
倍面積							94.008599
面 積							47.0042995

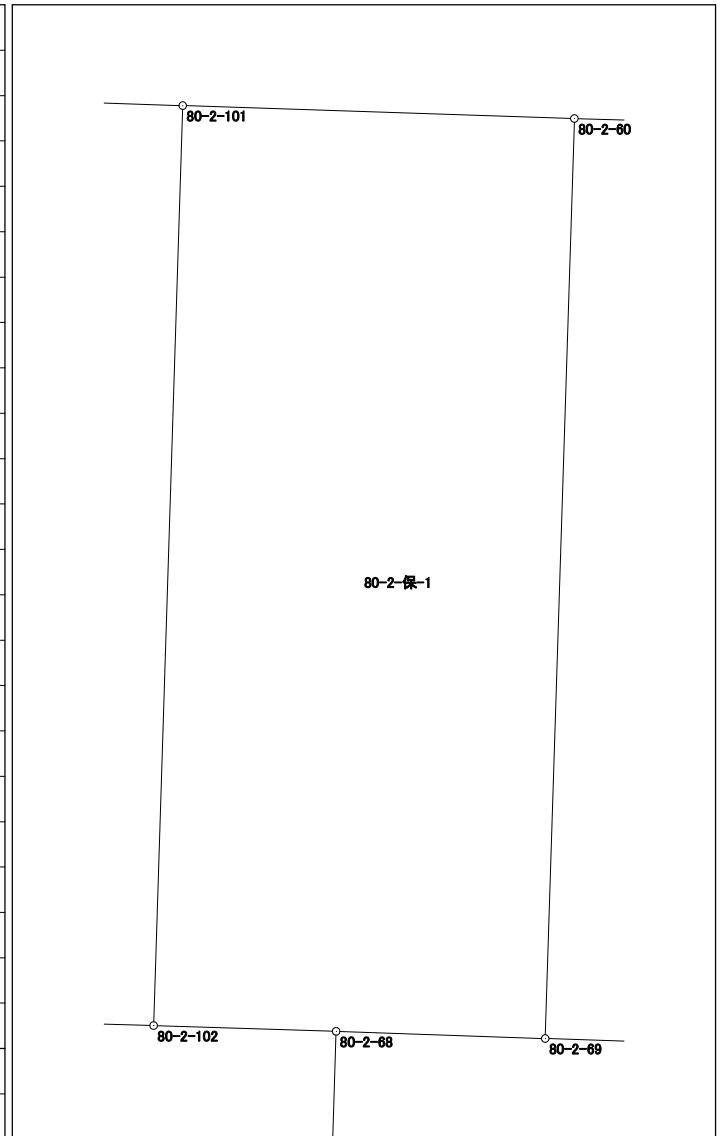

# 面積計算書（座標法）

所在	地番	公簿地目	現況地目	地積	所有者
前橋市六供町四丁目	80-2-保-2			53.00 m <sup>2</sup>	

点名	X座標	Y座標	辺長	方向角	測角	DX	倍積 (Y×DX)	
80-2-73	41531.180	-67766.819	2.834	91-40-41	89-43-55	-10.590	717650.613210	
80-2-72	41531.097	-67763.986	2.206	91-50-39	180-09-58	-0.154	10435.653844	
80-2-103	41531.026	-67761.781	10.520	1-57-01	90-06-22	10.443	-707636.278983	
80-2-104	41541.540	-67761.423	5.041	271-40-16	89-43-15	10.661	-722404.530603	
80-2-61	41541.687	-67766.462	10.513	181-56-46	90-16-30	-10.360	702060.546320	
							倍面積	106.003788
							面積	53.0018940

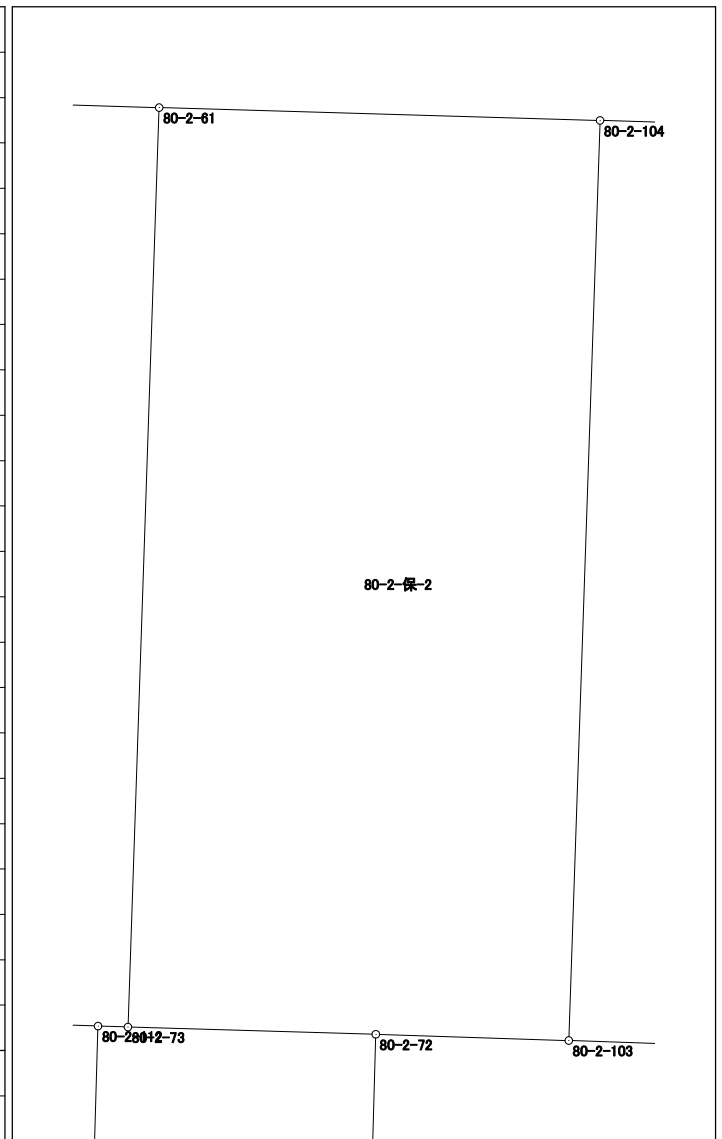


# 面積計算書 (座標法)

世界測地系 (測地成果2011)

所在	地番	公簿地目	現況地目	地積	所有者
前橋市六供町四丁目	80-2-保-3			40.00 m <sup>2</sup>	

点名	X座標	Y座標	辺長	方向角	測角	DX	倍積 (Y×DX)
80-2-72	41531.097	-67763.986	11.656	181-40-18	89-49-39	-11.580	784706.957880
80-2-63	41519.446	-67764.326	3.433	91-49-11	90-08-53	-11.760	796908.473760
80-2-114	41519.337	-67760.895	11.654	1-40-01	89-50-50	11.540	-781960.728300
80-2-115	41530.986	-67760.556	1.226	271-52-13	90-12-12	11.689	-792053.139084
80-2-103	41531.026	-67761.781	2.206	271-50-39	179-58-26	0.111	-7521.557691
						倍面積	80.006565
						面積	40.0032825

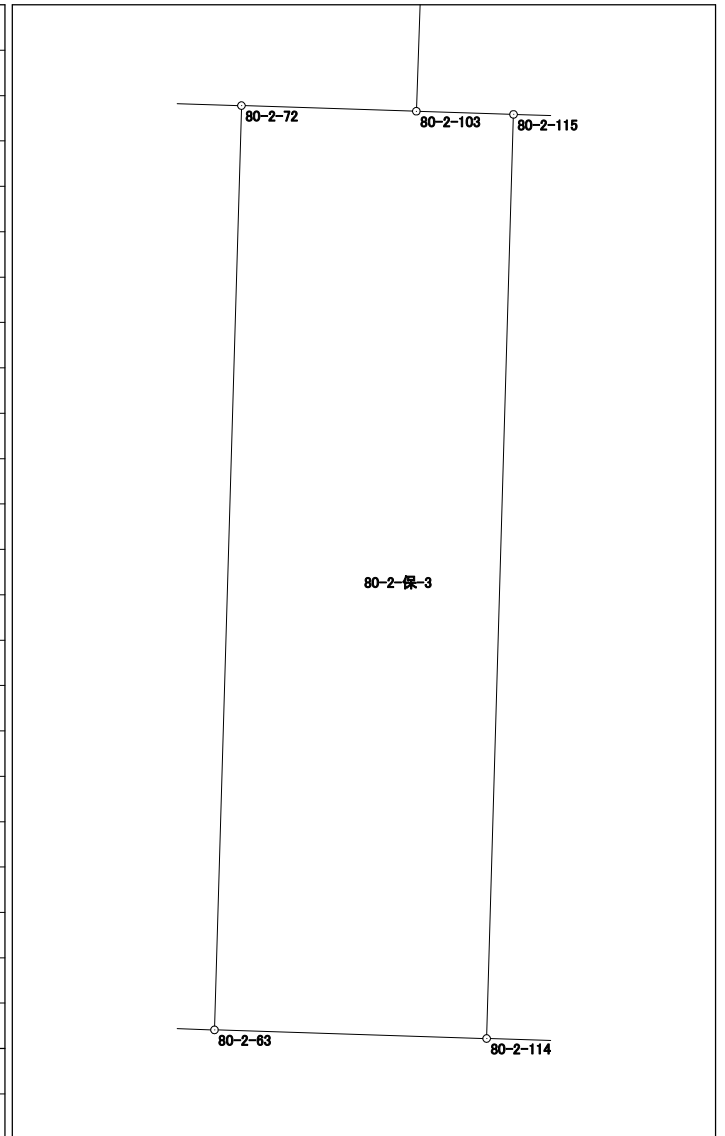


# 面積計算書（座標法）

世界測地系（測地成果2011）

所在	地番	公簿地目	現況地目	地積	所有者
前橋市六供町四丁目	80-2-保-4			37.00 m <sup>2</sup>	

点名	X座標	Y座標	辺長	方向角	測角	DX	倍積(Y×DX)
80-2-63	41519.446	-67764.326	11.656	1-40-18	89-50-57	11.550	-782677.965300
80-2-72	41531.097	-67763.986	2.834	271-40-41	90-00-23	11.734	-795142.611724
80-2-73	41531.180	-67766.819	0.342	271-50-32	180-09-51	0.094	-6370.080986
80-2-112	41531.191	-67767.161	11.649	181-40-03	89-49-31	-11.633	788335.383913
80-2-113	41519.547	-67767.500	3.176	91-49-21	90-09-18	-11.745	795929.287500

倍面積	74.013403
面積	37.0067015

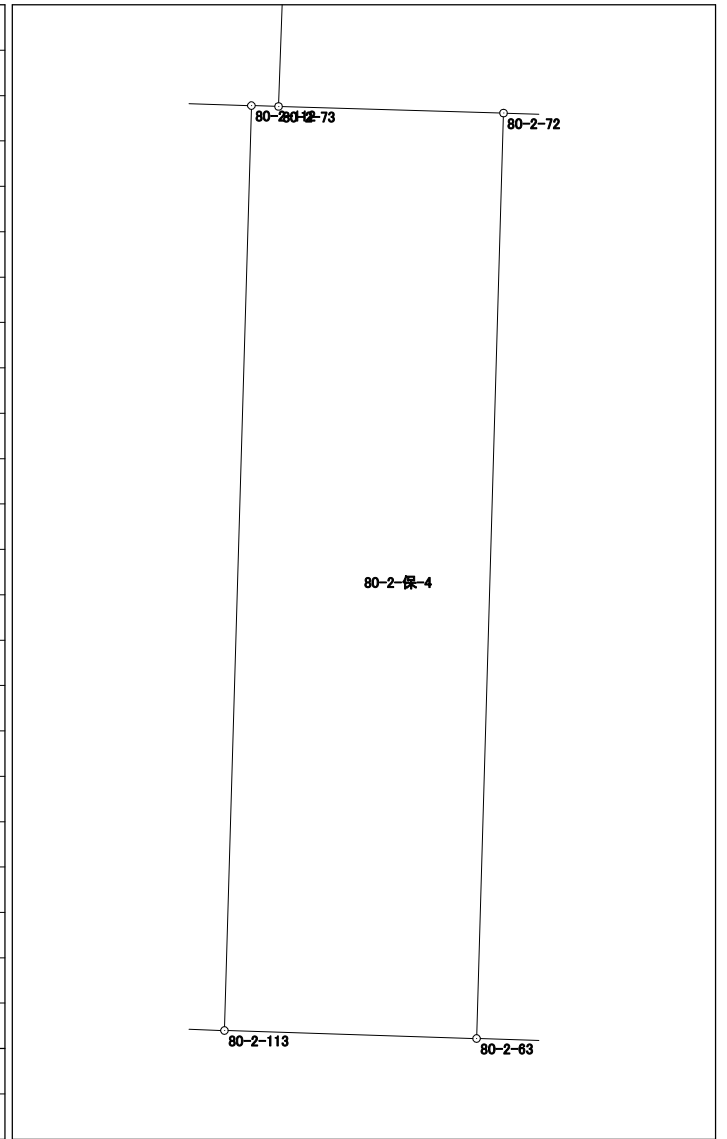


# 面積計算書 (座標法)

世界測地系 (測地成果2011)

所 在	地 番	公簿地目	現況地目	地 積	所 有 者
前橋市六供町四丁目	80-2-保-5			33.00 m <sup>2</sup>	

点 名	X 座標	Y 座標	辺 長	方 向 角	測 角	DX	倍 積 (Y×DX)
80-2-107	41524.429	-67787.782	4.239	181-53-33	90-06-28	-4.098	277794.330636
80-2-105	41520.192	-67787.922	7.785	91-46-53	89-53-20	-4.479	303622.102638
80-2-110	41519.950	-67780.141	4.239	1-53-33	90-06-40	3.995	-270781.663295
80-2-111	41524.187	-67780.001	3.322	271-46-37	89-53-04	4.340	-294165.204340
80-2-108	41524.290	-67783.321	4.463	271-47-05	180-00-28	0.242	-16403.563682
						倍面積	66.001957
						面 積	33.0009785

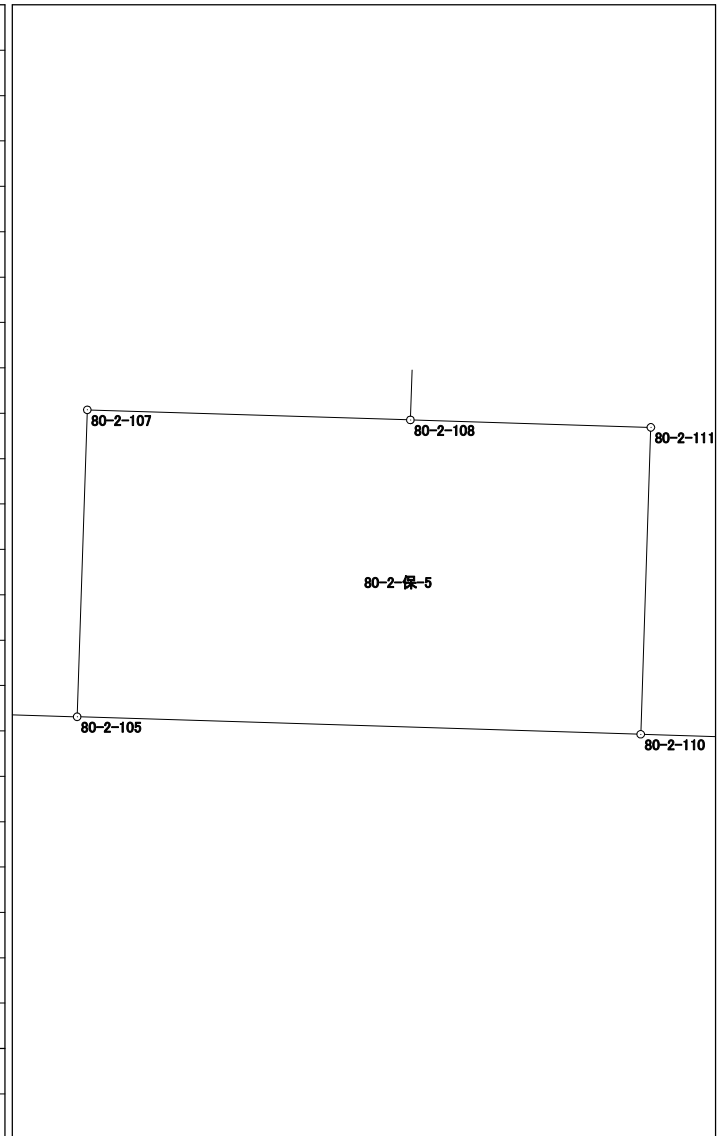




# 面積計算書 (座標法)

世界測地系 (測地成果2011)

所在	地番	公簿地目	現況地目	地積	所有者
前橋市六供町四丁目	80-2-保-6			40.00 m <sup>2</sup>	

点名	X座標	Y座標	辺長	方向角	測角	DX	倍積 (Y×DX)
80-2-68	41531.902	-67789.535	2.085	271-48-50	89-54-57	11.714	-794086.612990
80-2-102	41531.968	-67791.619	1.346	271-47-19	179-58-29	0.108	-7321.494852
80-2-121	41532.010	-67792.964	11.664	181-54-05	90-06-46	-11.616	787483.069824
80-2-122	41520.352	-67793.351	3.431	91-38-12	89-44-07	-11.756	796978.634356
80-2-66	41520.254	-67789.921	11.654	1-53-53	90-15-41	11.550	-782973.587550
						倍面積	80.008788
						面積	40.0043940

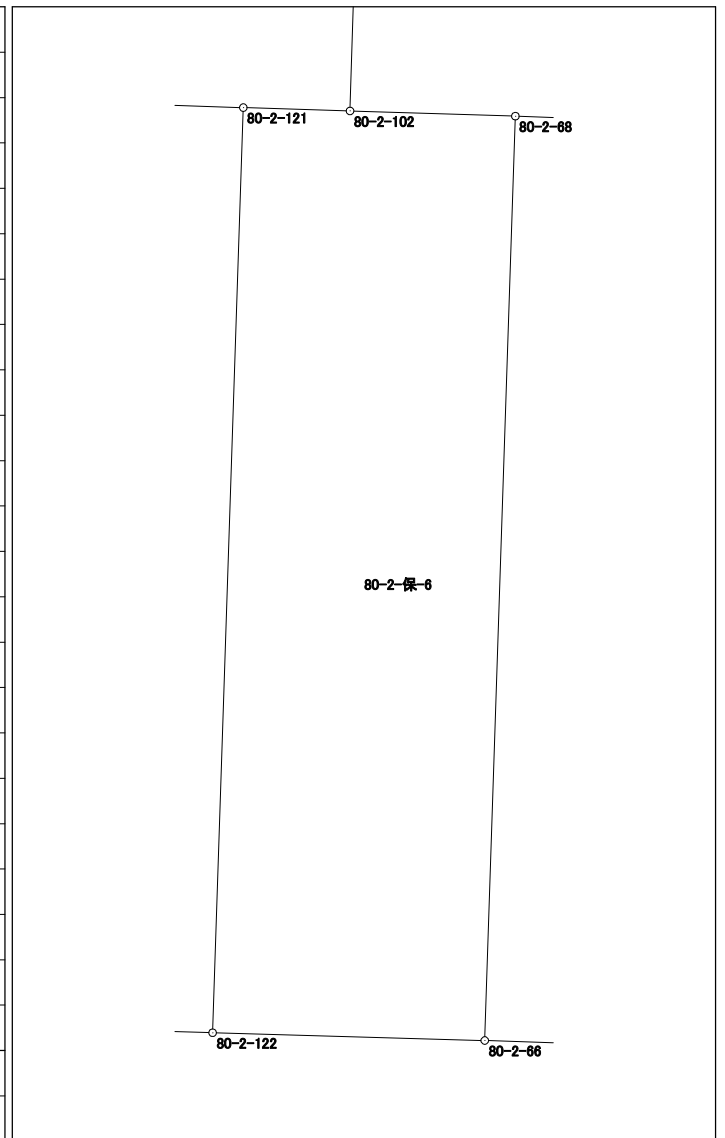


# 面積計算書 (座標法)

世界測地系 (測地成果2011)

所 在	地 番	公簿地目	現況地目	地 積	所 有 者
前橋市六供町四丁目	80-2-保-7			22.00 m <sup>2</sup>	

点 名	X 座 標	Y 座 標	辺 長	方 向 角	測 角	DX	倍 積 (Y×DX)
80-2-61	41541.687	-67766.462	2.093	271-45-08	89-48-22	10.571	-716359.269802
80-2-118	41541.751	-67768.554	10.510	181-56-48	90-11-40	-10.440	707503.703760
80-2-119	41531.247	-67768.911	1.751	91-49-58	89-53-10	-10.560	715639.700160
80-2-112	41531.191	-67767.161	0.342	91-50-32	180-00-34	-0.067	4540.399787
80-2-73	41531.180	-67766.819	10.513	1-56-46	90-06-14	10.496	-711280.532224
						倍面積	44.001681
						面 積	22.0008405

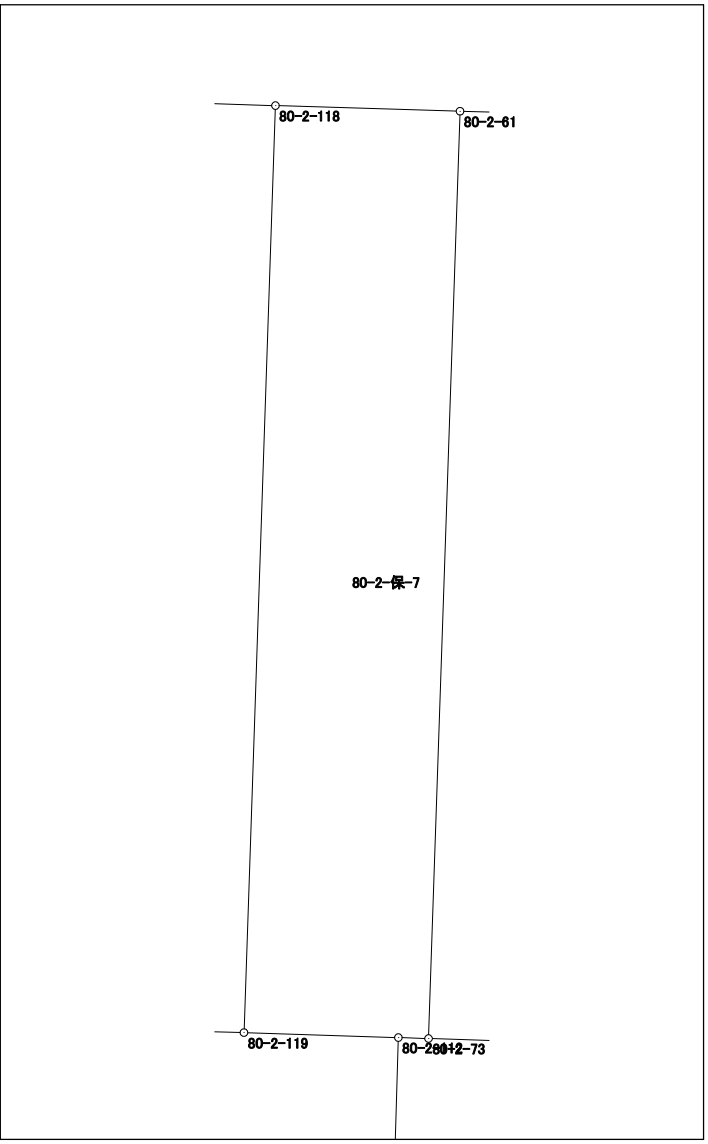

# 面積計算書（座標法）

世界測地系（測地成果2011）

所 在	地 番	公簿地目	現況地目	地 積	所 有 者
前橋市六供町四丁目	80-2-保-8			3.00 m <sup>2</sup>	

点 名	X 座標	Y 座標	辺 長	方 向 角	測 角	DX	倍 積 (Y×DX)
80-2-77	41542.092	-67779.673	10.508	181-52-14	90-03-43	-10.493	711212.108789
80-2-76	41531.590	-67780.016	0.286	91-36-08	89-43-54	-10.510	712367.968160
80-2-116	41531.582	-67779.730	10.507	1-51-55	90-15-47	10.493	-711212.706890
80-2-117	41542.083	-67779.388	0.285	271-48-31	89-56-36	10.510	-712361.367880
						倍面積	6.002179
						面 積	3.0010895

