



81街区 画地出来形確認図 (4946.54m²)

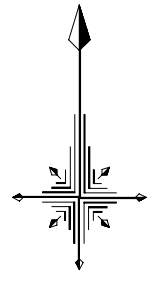

S=1/500

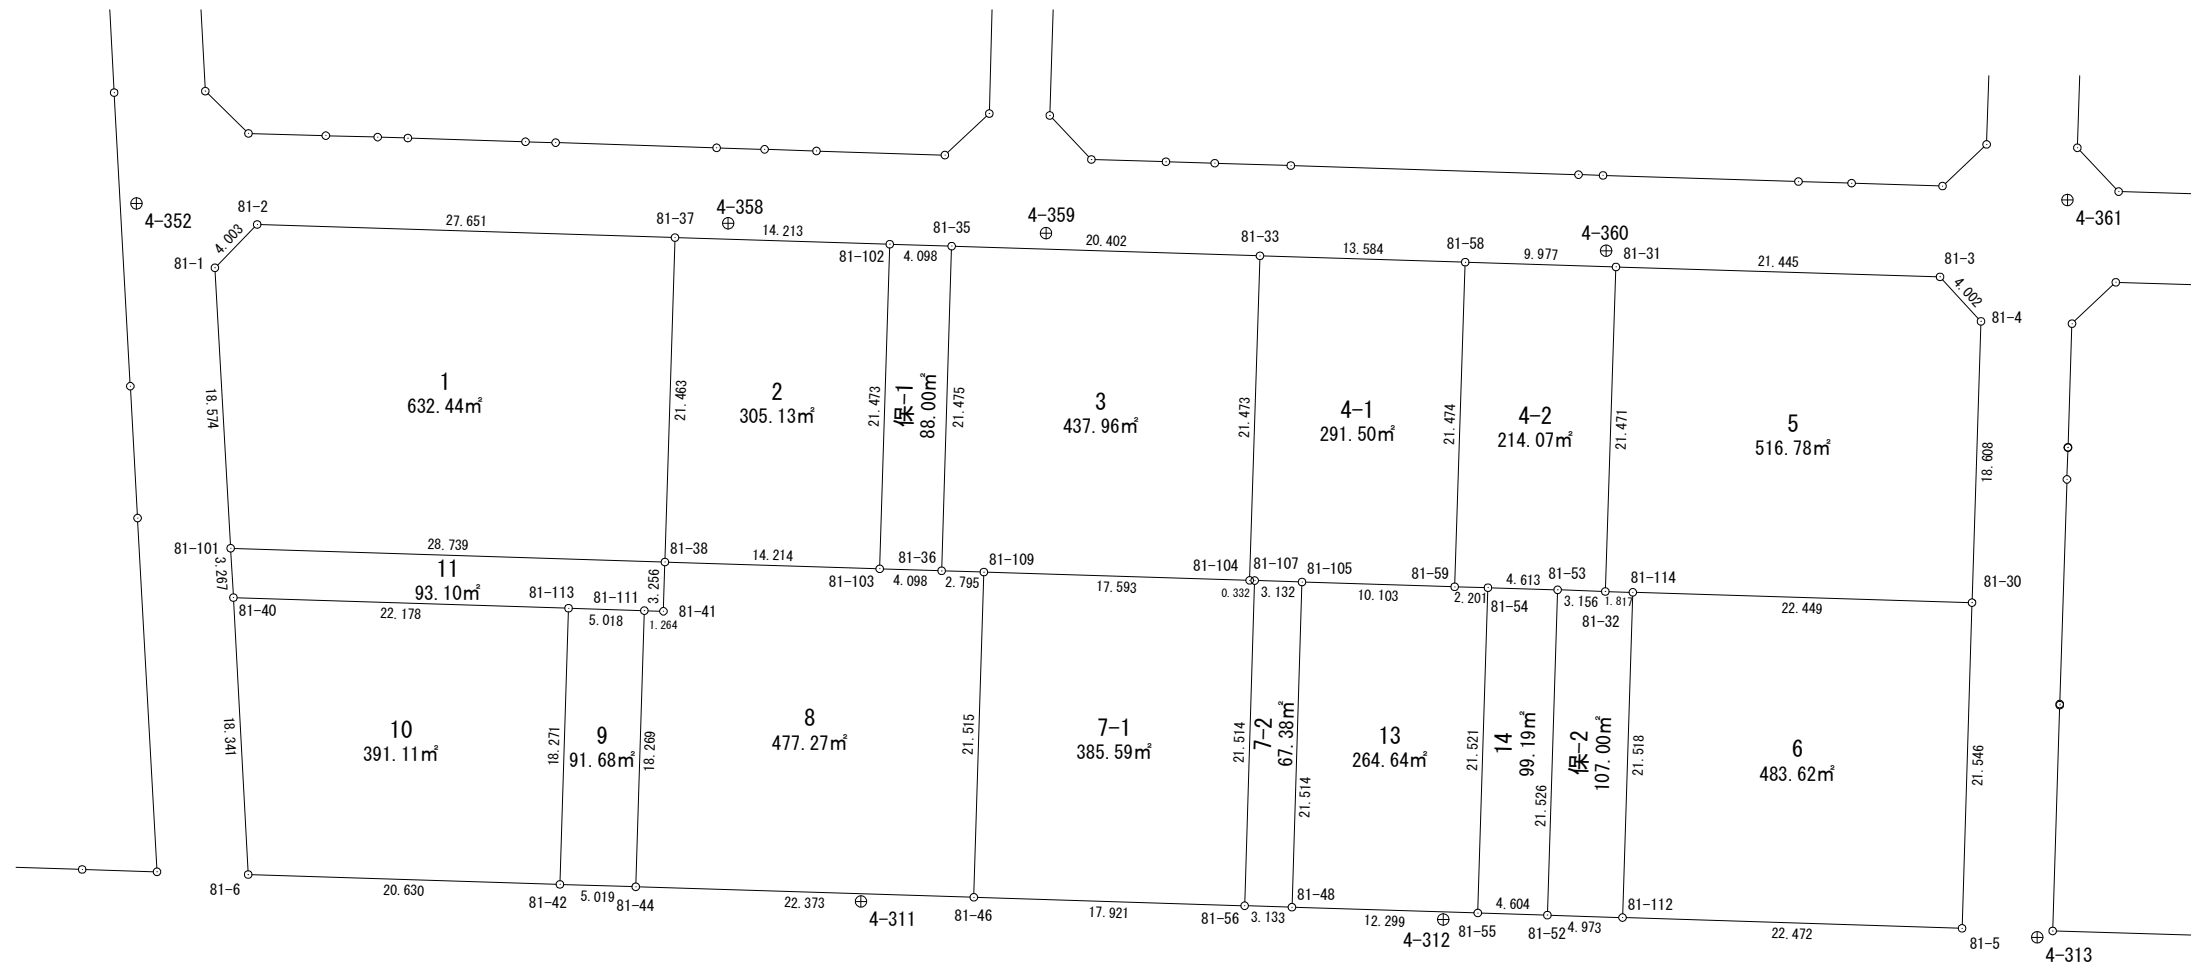

3. 5. 6 3 天川原六供線

⊕ 4-287

⊕ 4-313