



8 2 街区 画地出来形確認図 (5500.20m²)

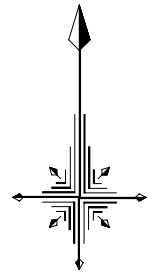

S=1/500

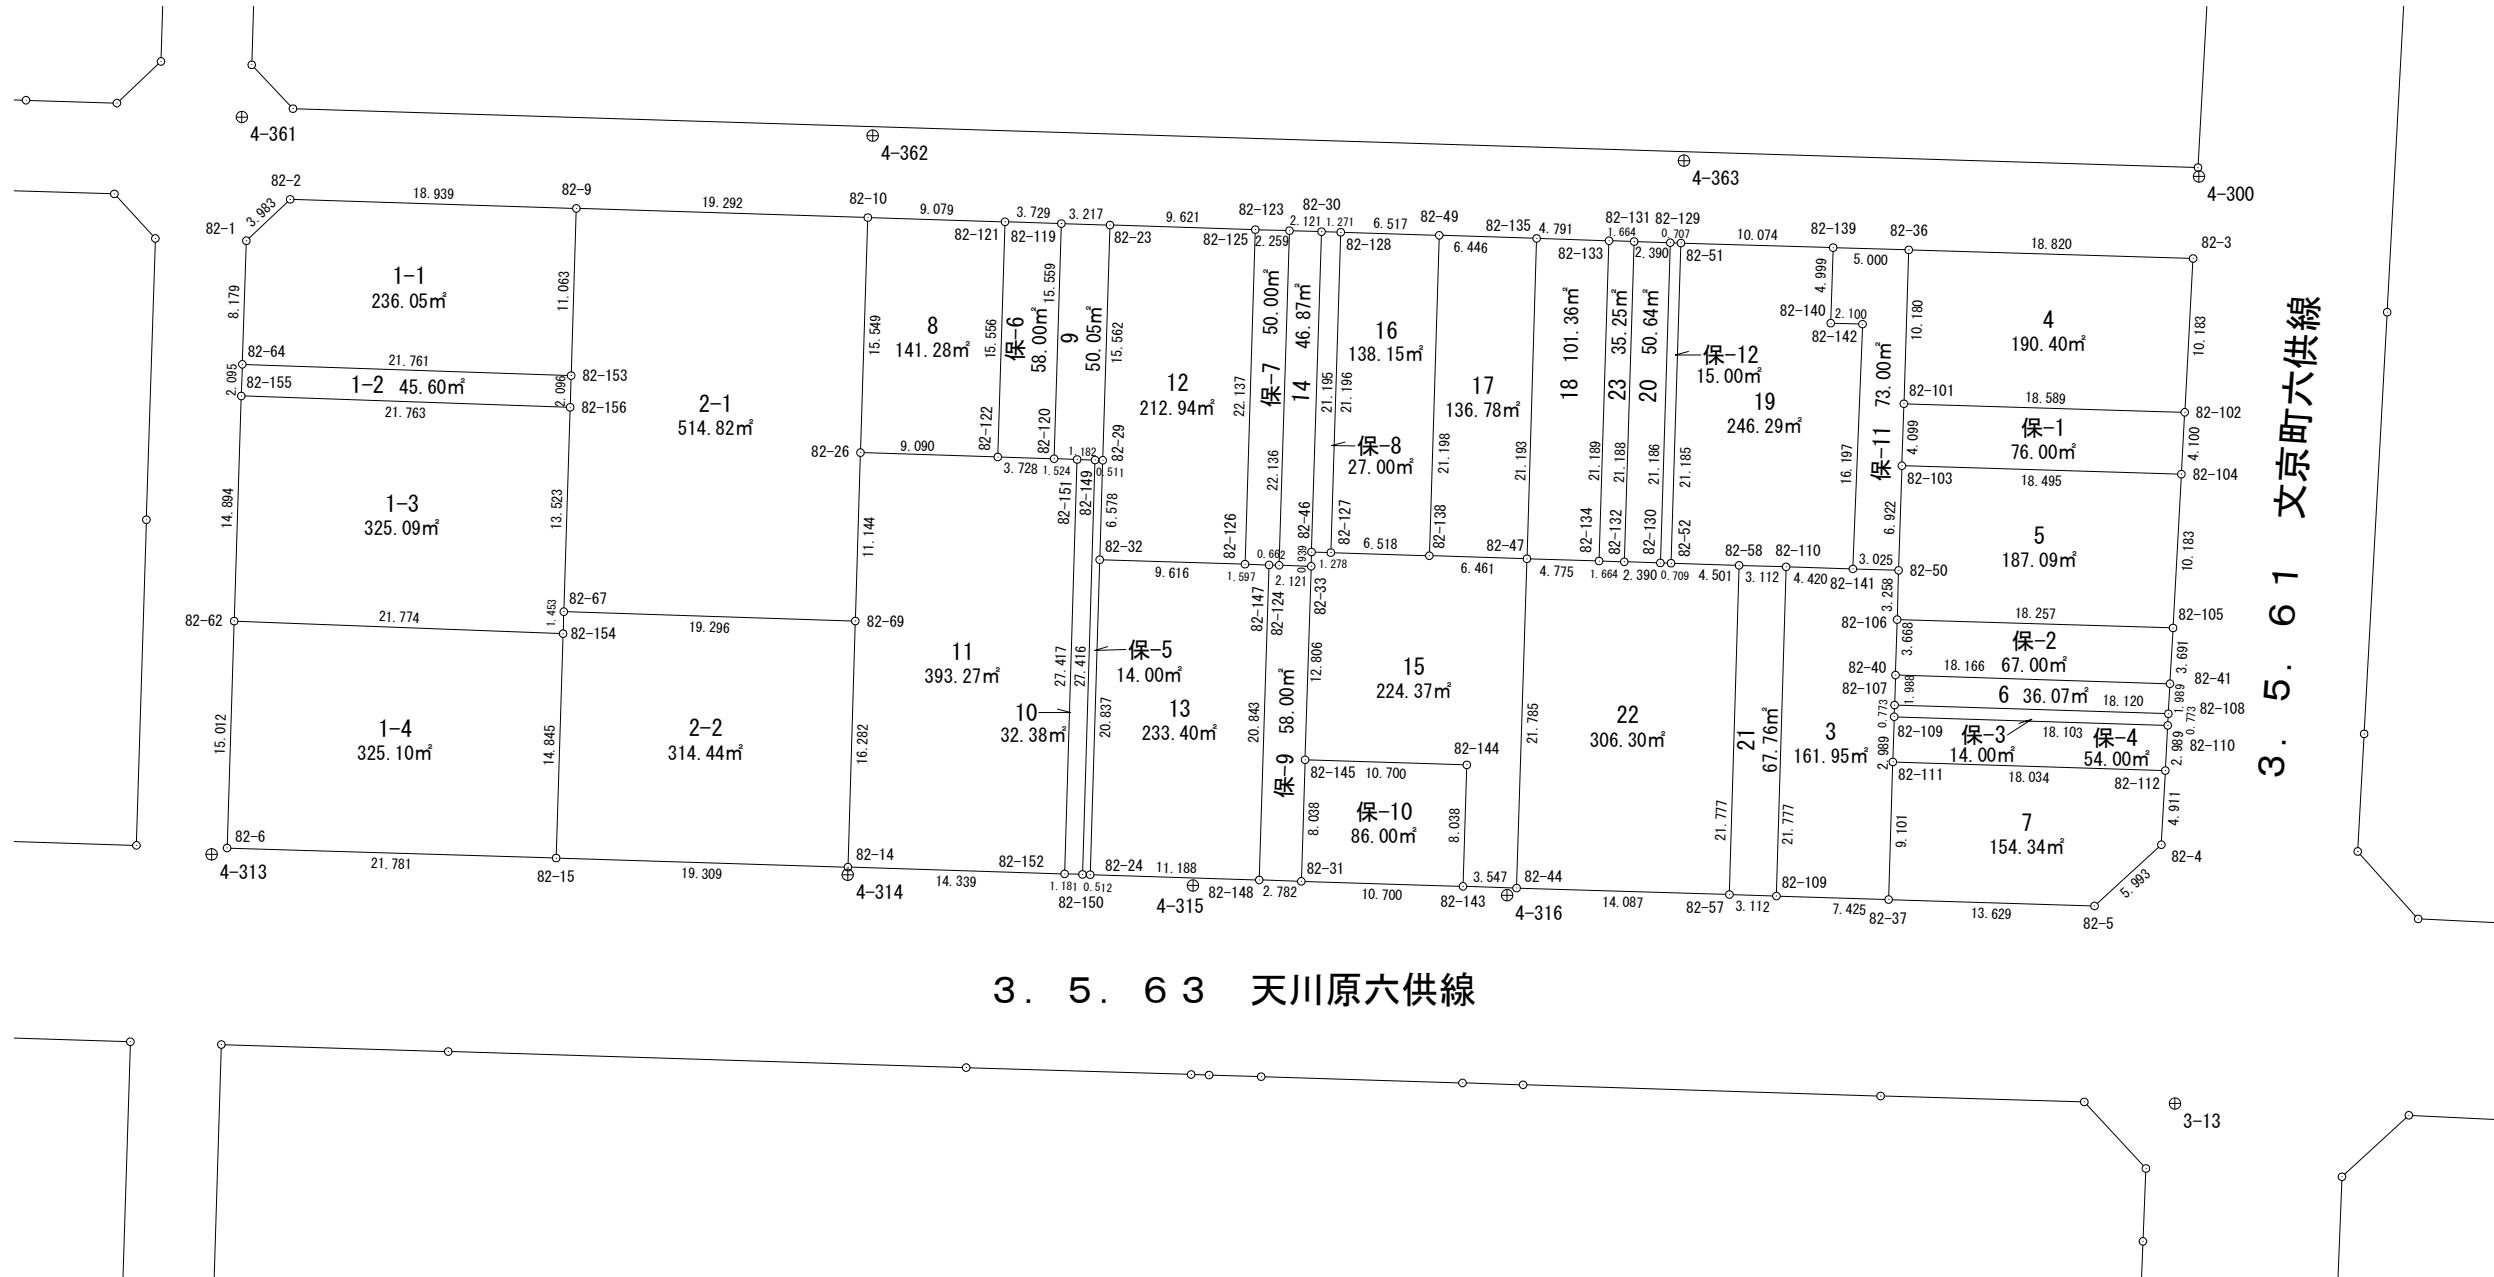

3. 5. 6 3 天川原六供線


3. 5. 6 1 文京町六供線

面積計算書 (座標法)

世界測地系 (測地成果2011)

所在	地番	公簿地目	現況地目	地積	所有者
前橋市六供町四丁目	82-4			190.40 m ²	

点名	X座標	Y座標	辺長	方向角	測角	DX	倍積 (Y×DX)
82-36	41507.312	-67567.884	10.180	181-48-45	90-04-26	-9.604	648921.957936
82-101	41497.137	-67568.206	18.589	91-44-19	89-55-34	-10.739	725614.964234
82-102	41496.573	-67549.626	10.183	3-06-47	91-22-28	9.604	-648746.608104
82-3	41506.741	-67549.073	18.820	271-44-19	88-37-32	10.739	-725409.494947

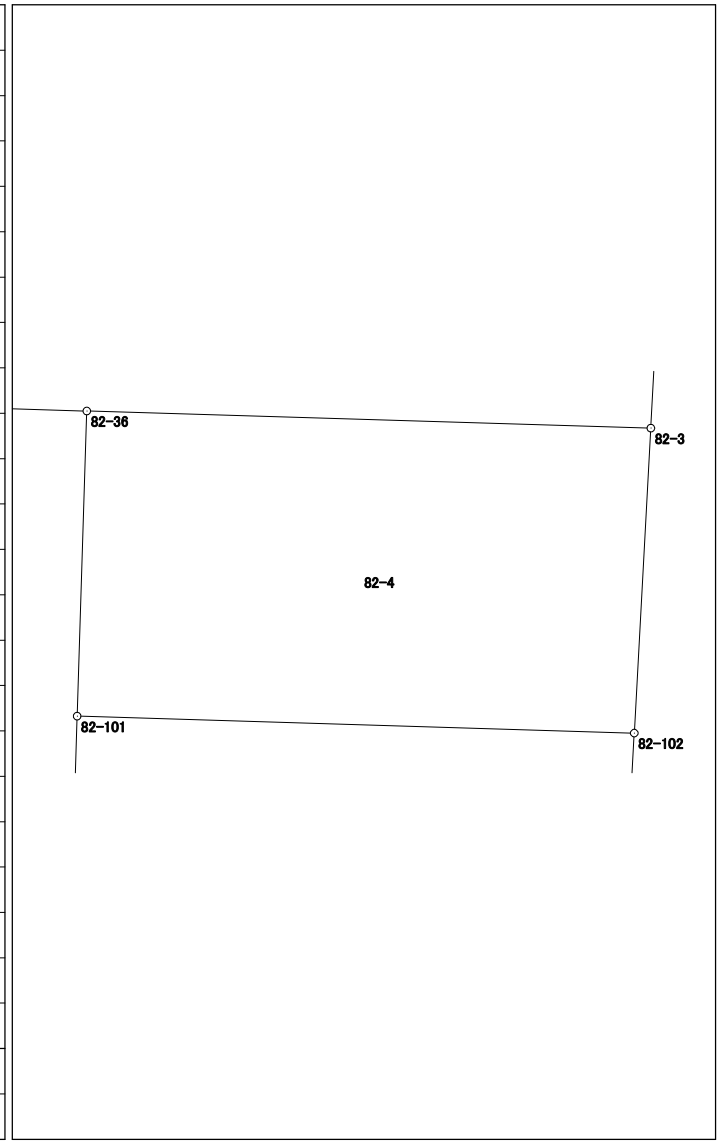


倍面積	380.819119
面積	190.4095595

面積計算書（座標法）

世界測地系（測地成果2011）

所 在	地 番	公簿地目	現況地目	地 積	所 有 者
前橋市六供町四丁目	82-5			187.09 m ²	

点 名	X 座標	Y 座標	辺 長	方 向 角	測 角	DX	倍 積 (Y×DX)
82-105	41482.311	-67550.402	10.183	3-06-47	91-22-38	9.615	-649497.115230
82-104	41492.479	-67549.849	18.495	271-44-18	88-37-31	10.729	-724742.329921
82-103	41493.040	-67568.335	6.922	181-48-47	90-04-29	-6.358	429599.473930
82-50	41486.121	-67568.554	3.258	181-42-21	179-53-34	-10.176	687577.605504
82-106	41482.864	-67568.651	18.257	91-44-09	90-01-48	-3.810	257436.560310
						倍面積	374.194593
						面 積	187.0972965

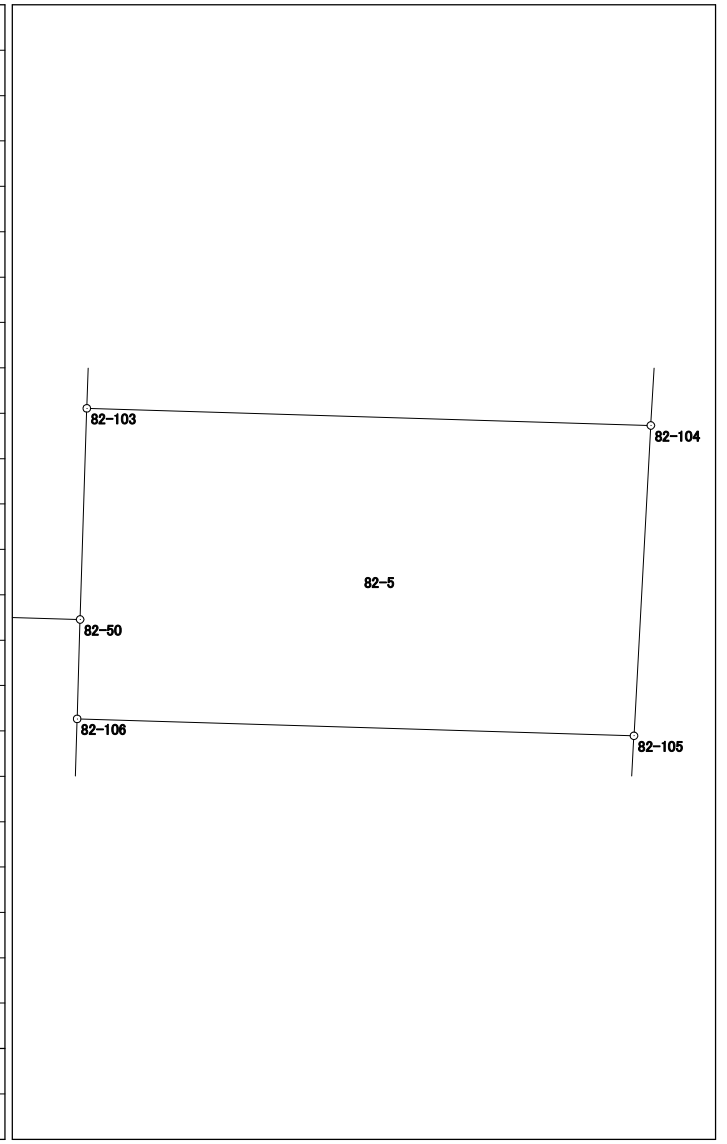


面積計算書 (座標法)

世界測地系 (測地成果2011)

所 在	地 番	公簿地目	現況地目	地 積	所 有 者
前橋市六供町四丁目	82-6			36.07 m ²	

点 名	X 座標	Y 座標	辺 長	方 向 角	測 角	DX	倍 積 (Y×DX)
82-40	41479.198	-67568.760	1.988	181-45-30	89-57-03	-1.414	95542.226640
82-107	41477.211	-67568.821	18.120	91-48-32	90-03-02	-2.559	172908.612939
82-108	41476.639	-67550.710	1.989	3-05-02	91-16-30	1.414	-95516.703940
82-41	41478.625	-67550.603	18.166	271-48-27	88-43-25	2.559	-172861.993077

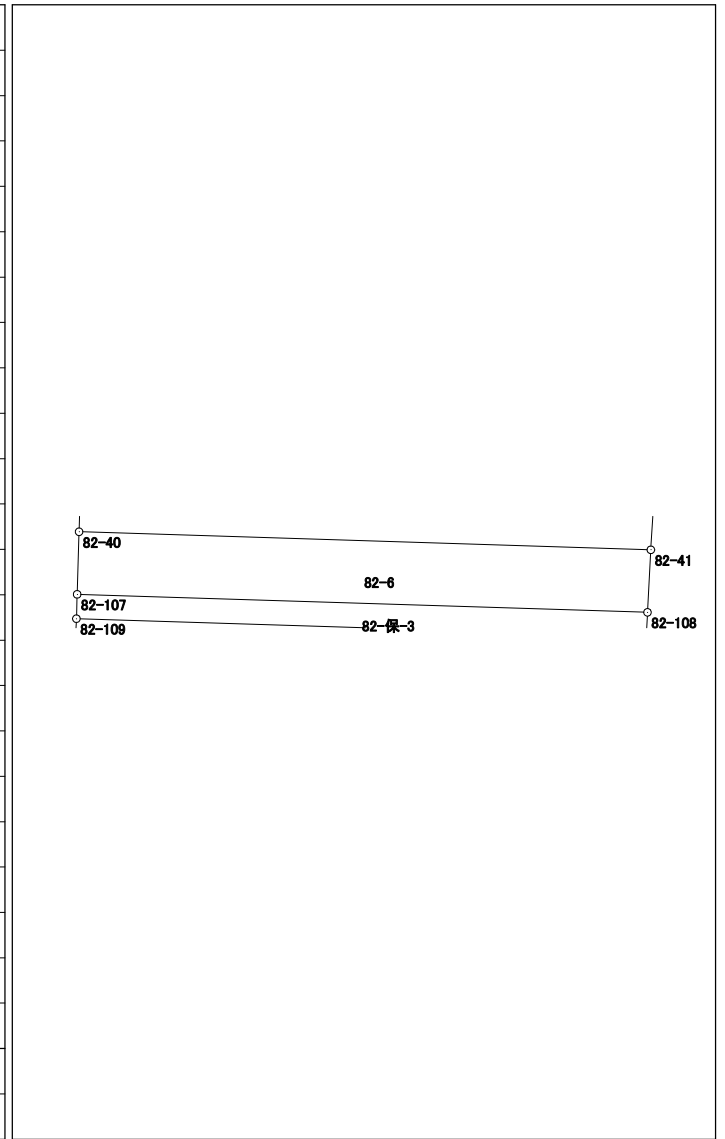


倍面積	72.142562
面 積	36.0712810

面積計算書 (座標法)

世界測地系 (測地成果2011)

所在	地番	公簿地目	現況地目	地積	所有者
前橋市六供町四丁目	82-7			154.34 m ²	

点名	X座標	Y座標	辺長	方向角	測角	DX	倍積 (Y×DX)
82-111	41473.450	-67568.936	9.101	181-45-01	89-56-43	-8.529	576295.455144
82-37	41464.353	-67569.214	13.629	91-47-13	90-02-12	-9.522	643394.055708
82-5	41463.928	-67555.592	5.993	47-28-55	135-41-42	3.625	-244889.021000
82-4	41467.978	-67551.175	4.911	3-04-53	135-35-58	8.954	-604853.220950
82-112	41472.882	-67550.911	18.034	271-48-18	88-43-25	5.472	-369638.584992

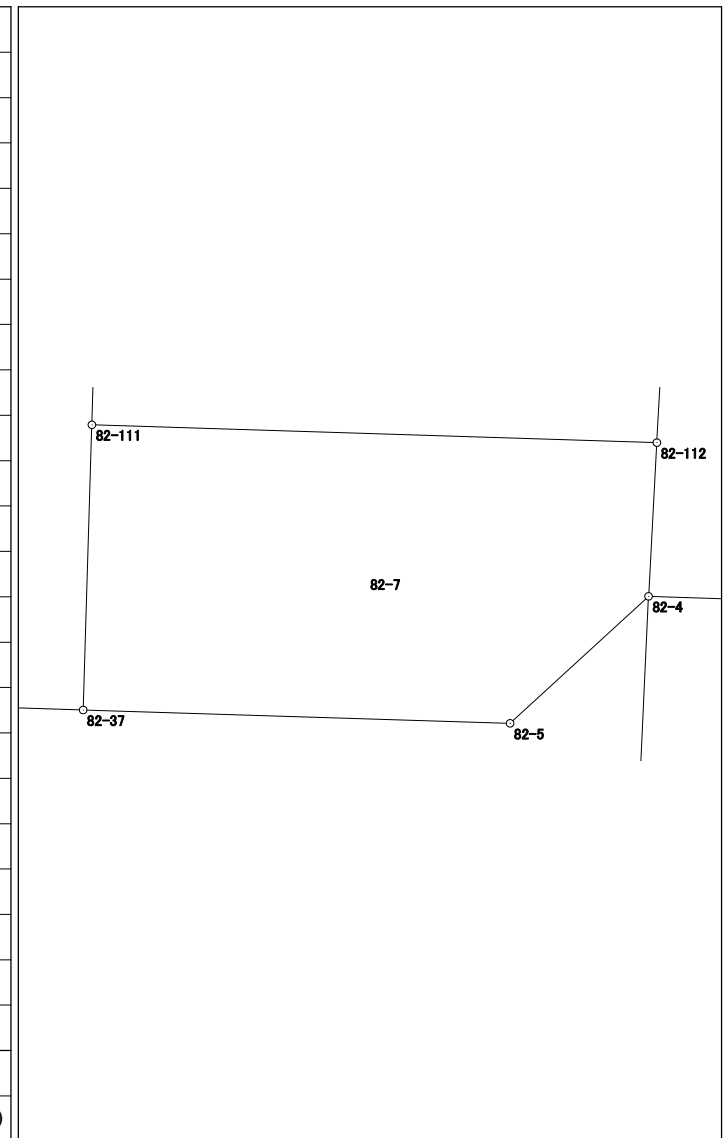


倍面積	308.683910
面積	154.3419550

面積計算書 (座標法)

世界測地系 (測地成果2011)

所在	地番	公簿地目	現況地目	地積	所有者
前橋市六供町四丁目	82-8			141.28 m ²	

点名	X座標	Y座標	辺長	方向角	測角	DX	倍積 (Y×DX)
82-121	41509.168	-67627.662	9.079	271-46-25	90-00-46	15.830	-1070545.889460
82-10	41509.449	-67636.737	15.549	181-47-55	90-01-30	-15.260	1032136.606620
82-26	41493.908	-67637.225	9.090	91-49-19	90-01-24	-15.830	1070697.271750
82-122	41493.619	-67628.140	15.556	1-45-39	89-56-20	15.260	-1032005.416400

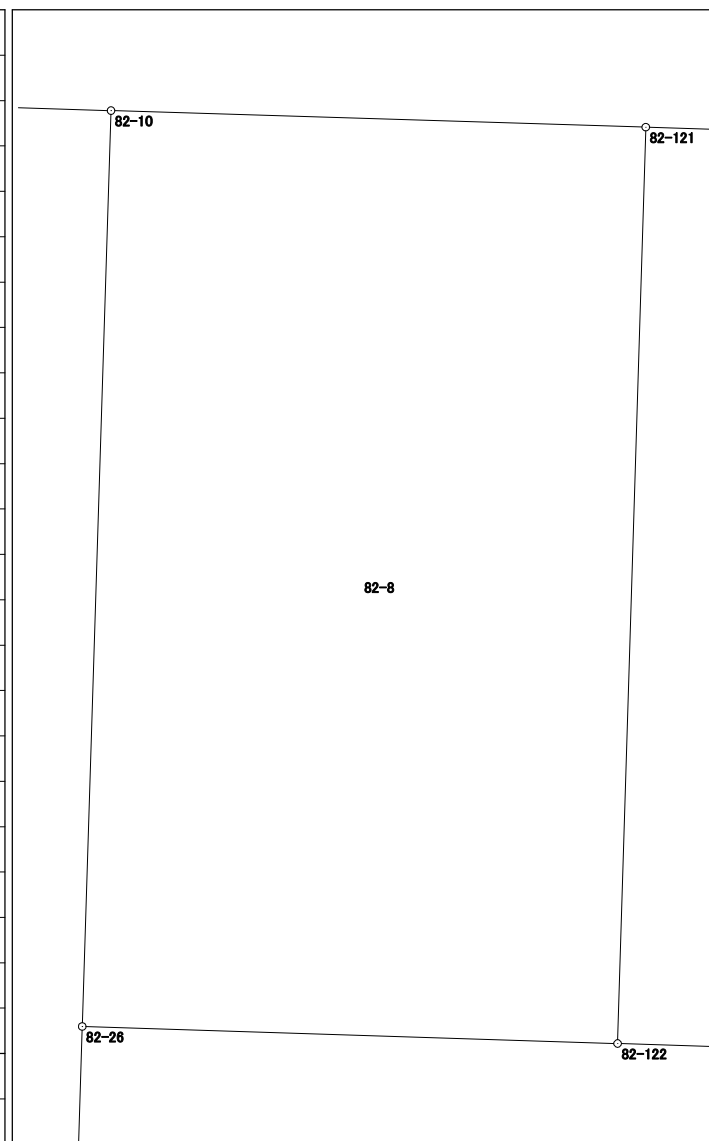

倍面積	282.572510
面積	141.2862550


面積計算書（座標法）

世界測地系（測地成果2011）

所在	地番	公簿地目	現況地目	地積	所有者
前橋市六供町四丁目	82-10			32.38 m ²	

点名	X座標	Y座標	辺長	方向角	測角	DX	倍積 (Y×DX)
82-149	41493.415	-67621.710	1.182	271-50-35	90-06-29	27.441	-1855607.344110
82-151	41493.453	-67622.891	27.417	181-43-58	89-53-23	-27.366	1850568.035106
82-152	41466.049	-67623.720	1.181	91-47-46	90-03-48	-27.441	1855662.500520
82-150	41466.012	-67622.540	27.416	1-44-06	89-56-20	27.366	-1850558.429640

倍面積	64.761876
面積	32.3809380

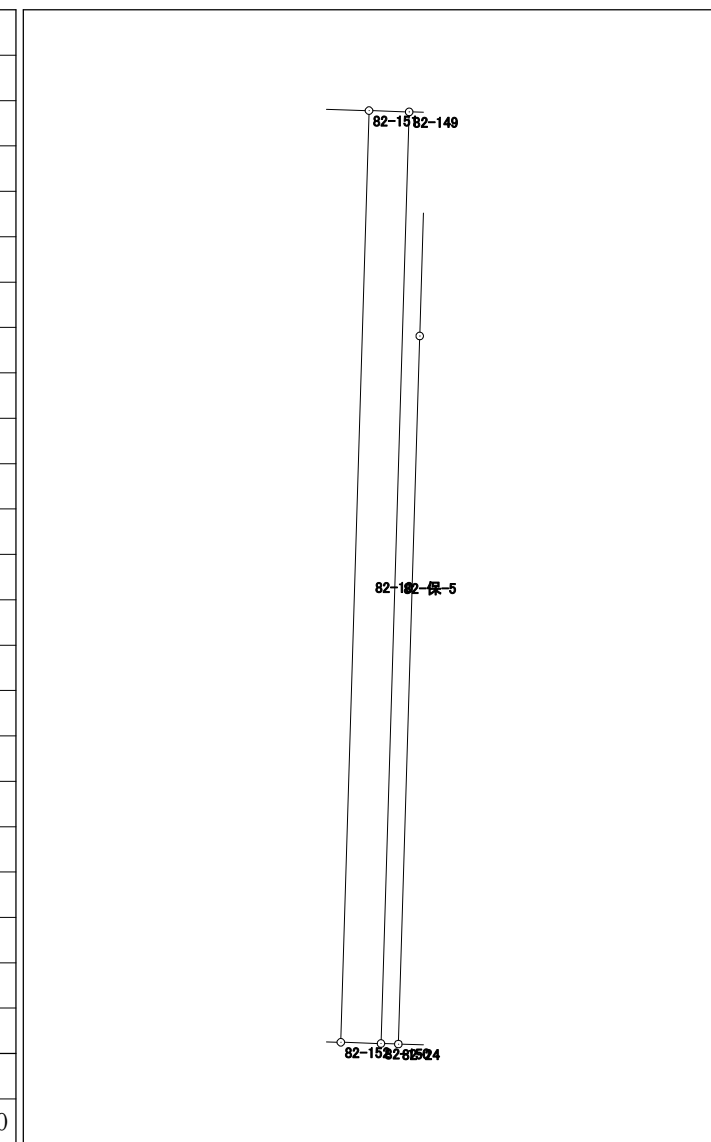


面積計算書 (座標法)

世界測地系 (測地成果2011)

所在	地番	公簿地目	現況地目	地積	所有者
前橋市六供町四丁目	82-11			393.27 m ²	

点名	X座標	Y座標	辺長	方向角	測角	DX	倍積 (Y×DX)
82-151	41493.453	-67622.891	1.524	271-48-19	90-04-21	27.452	-1856383.603732
82-120	41493.501	-67624.414	3.728	271-48-50	180-00-31	0.166	-11225.652724
82-122	41493.619	-67628.140	9.090	271-49-19	180-00-29	0.407	-27524.652980
82-26	41493.908	-67637.225	11.144	181-44-54	89-55-35	-10.850	733863.891250
82-69	41482.769	-67637.565	16.282	181-42-50	179-57-56	-27.414	1854216.206910
82-14	41466.494	-67638.052	14.339	91-46-42	90-03-52	-16.720	1130908.229440
82-152	41466.049	-67623.720	27.417	1-43-58	89-57-16	26.959	-1823067.867480

倍面積	786.550684
面積	393.2753420

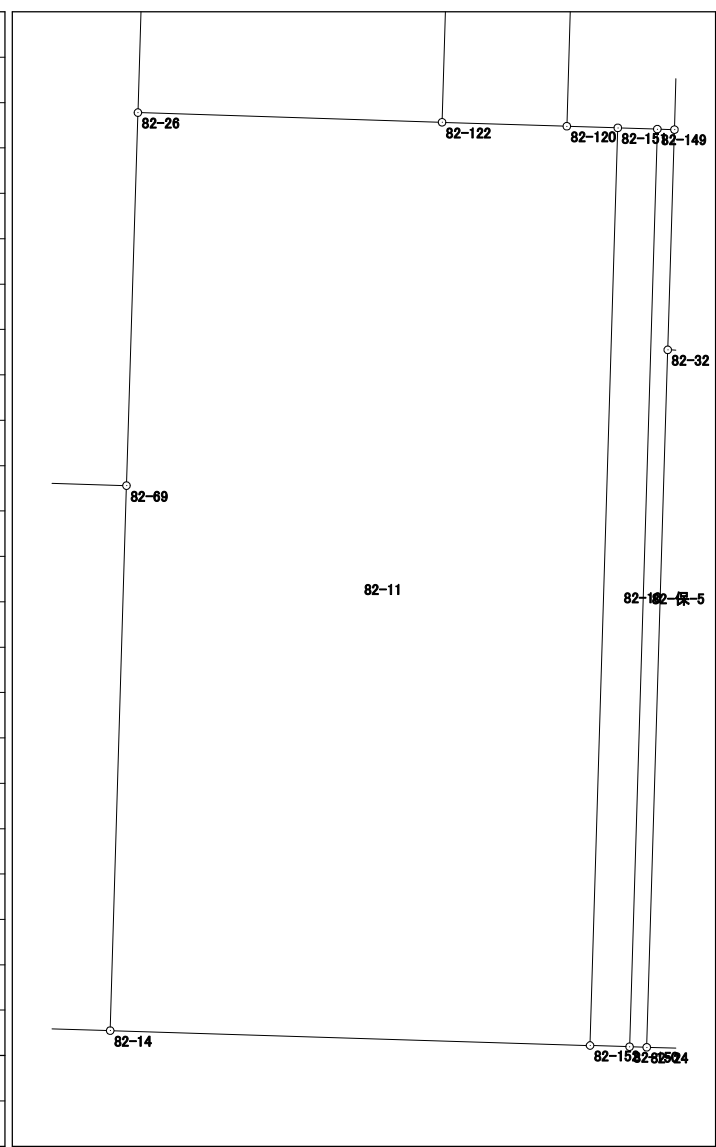


面積計算書 (座標法)

世界測地系 (測地成果2011)

所在	地番	公簿地目	現況地目	地積	所有者
前橋市六供町四丁目	82-20			50.64 m ²	

点名	X座標	Y座標	辺長	方向角	測角	DX	倍積 (Y×DX)
82-129	41507.788	-67583.658	2.390	271-49-20	90-02-52	21.252	-1436287.899816
82-131	41507.864	-67586.047	21.188	181-46-27	89-57-07	-21.102	1426200.763794
82-132	41486.686	-67586.703	2.390	91-46-27	90-00-00	-21.252	1436352.612156
82-130	41486.612	-67584.314	21.186	1-46-28	90-00-01	21.102	-1426164.194028

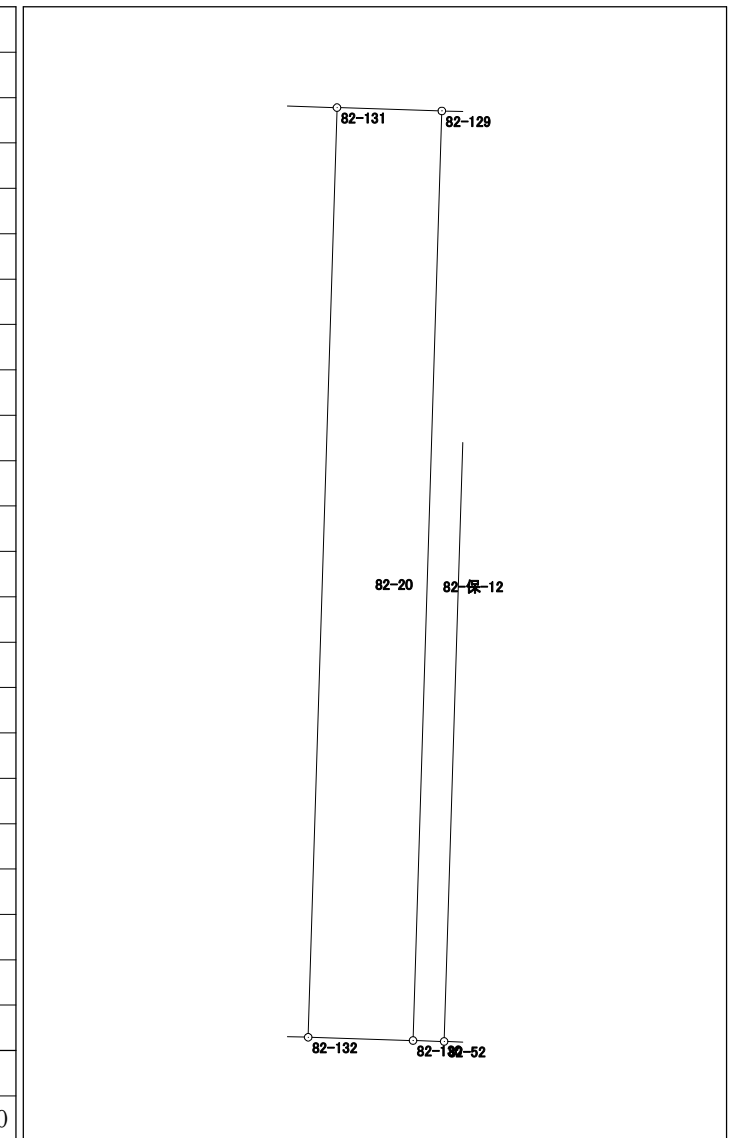

倍面積	101.282106
面積	50.6410530


面積計算書（座標法）

世界測地系（測地成果2011）

所在	地番	公簿地目	現況地目	地積	所有者
前橋市六供町四丁目	82-21			67.76 m ²	

点名	X 座標	Y 座標	辺長	方向角	測角	DX	倍積 (Y×DX)
82-58	41486.450	-67579.106	21.777	181-40-53	89-53-42	-21.671	1464506.806126
82-57	41464.682	-67579.745	3.112	91-47-11	90-06-18	-21.865	1477631.124425
82-158	41464.585	-67576.635	21.777	1-40-53	89-53-42	21.671	-1464453.257085
82-157	41486.353	-67575.996	3.112	271-47-11	90-06-18	21.865	-1477549.152540

倍面積	135.520926
面積	67.7604630

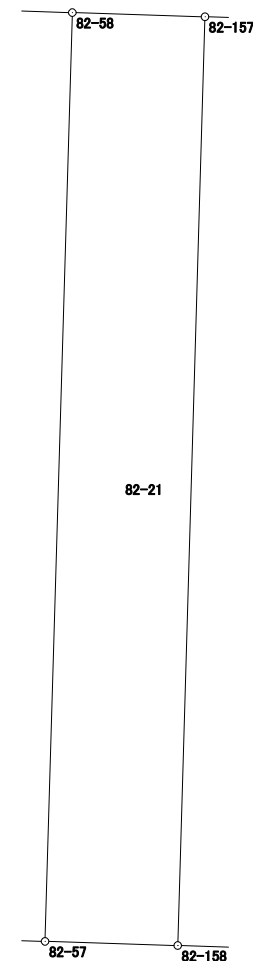


面積計算書 (座標法)

世界測地系 (測地成果2011)

所在	地番	公簿地目	現況地目	地積	所有者
前橋市六供町四丁目	82-22			306.30 m ²	

点名	X座標	Y座標	辺長	方向角	測角	DX	倍積 (Y×DX)
82-47	41486.887	-67593.139	21.785	181-48-16	90-00-59	-21.625	1461701.630875
82-44	41465.113	-67593.825	14.087	91-45-12	89-56-56	-22.205	1500920.884125
82-57	41464.682	-67579.745	21.777	1-40-53	89-55-41	21.337	-1441949.019065
82-58	41486.450	-67579.106	4.501	271-46-56	90-06-03	21.908	-1480523.054248
82-52	41486.590	-67583.605	0.709	271-46-38	179-59-42	0.162	-10948.544010
82-130	41486.612	-67584.314	2.390	271-46-27	179-59-49	0.096	-6488.094144
82-132	41486.686	-67586.703	1.664	271-47-28	180-01-01	0.126	-8515.924578
82-134	41486.738	-67588.366	4.775	271-47-17	179-59-49	0.201	-13585.261566

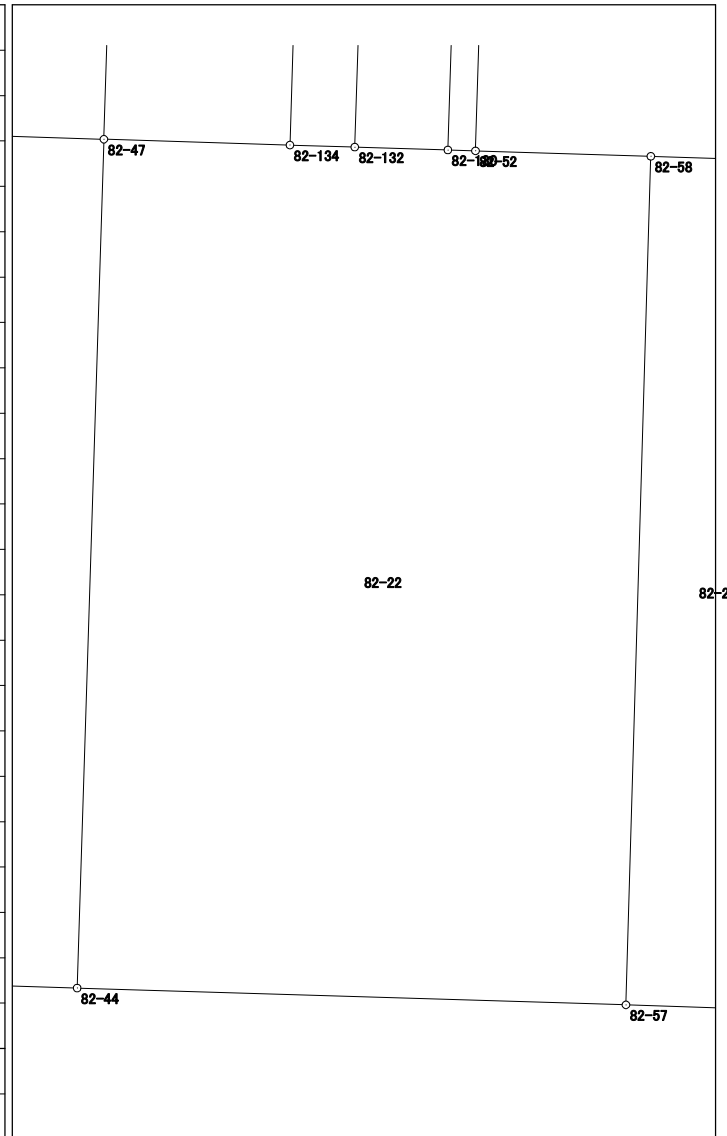


倍面積	612.617389
面積	306.3086945

面積計算書 (座標法)

世界測地系 (測地成果2011)

所 在	地 番	公簿地目	現況地目	地 積	所 有 者
前橋市六供町四丁目	82-23			35.25 m ²	

点 名	X 座標	Y 座標	辺 長	方 向 角	測 角	DX	倍 積 (Y×DX)
82-131	41507.864	-67586.047	1.664	271-49-31	90-03-04	21.231	-1434919.363857
82-133	41507.917	-67587.710	21.189	181-46-27	89-56-56	-21.126	1427857.961460
82-134	41486.738	-67588.366	1.664	91-47-28	90-01-01	-21.231	1434968.598546
82-132	41486.686	-67586.703	21.188	1-46-27	89-58-59	21.126	-1427836.687578
倍面積						70.508571	
面 積						35.2542855	

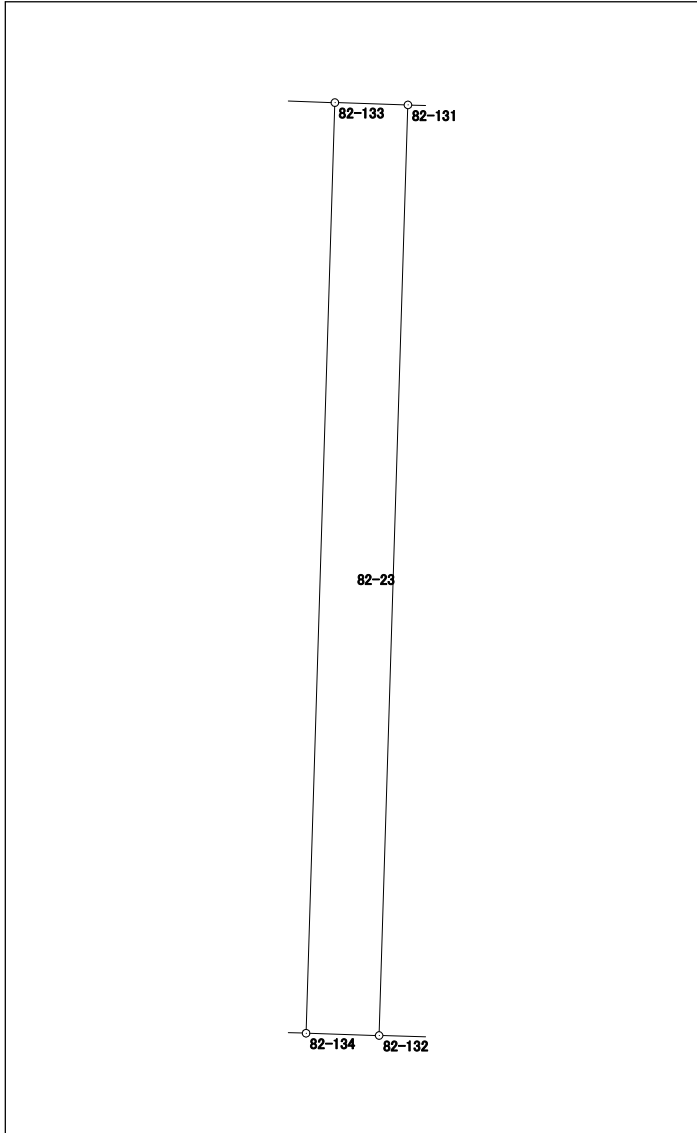


面積計算書（座標法）

世界測地系（測地成果2011）

所 在	地 番	公簿地目	現況地目	地 積	所 有 者
前橋市六供町四丁目	82-保-1			76.00 m ²	

点 名	X 座標	Y 座標	辺 長	方 向 角	測 角	DX	倍 積 (Y×DX)
82-101	41497.137	-67568.206	4.099	181-48-12	90-03-53	-3.533	238718.471798
82-103	41493.040	-67568.335	18.495	91-44-18	89-56-06	-4.658	314733.304430
82-104	41492.479	-67549.849	4.100	3-07-04	91-22-46	3.533	-238653.616517
82-102	41496.573	-67549.626	18.589	271-44-19	88-37-15	4.658	-314646.157908
						倍面積	152.001803
						面 積	76.0009015

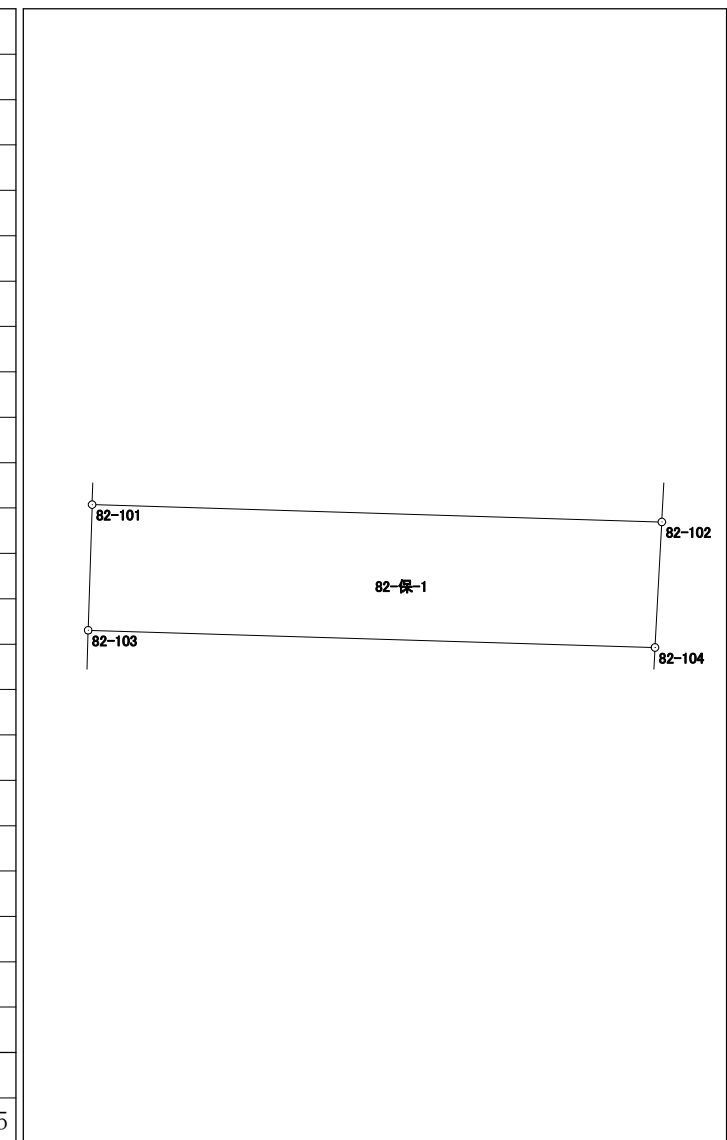


面積計算書（座標法）

世界測地系（測地成果2011）

所 在	地 番	公簿地目	現況地目	地 積	所 有 者
前橋市六供町四丁目	82-保-2			67.00 m ²	

点 名	X 座標	Y 座標	辺 長	方 向 角	測 角	DX	倍 積 (Y×DX)
82-41	41478.625	-67550.603	3.691	3-07-17	91-18-50	3.113	-210285.027139
82-105	41482.311	-67550.402	18.257	271-44-09	88-36-52	4.239	-286346.154078
82-106	41482.864	-67568.651	3.668	181-42-11	89-58-02	-3.113	210341.210563
82-40	41479.198	-67568.760	18.166	91-48-27	90-06-16	-4.239	286423.973640

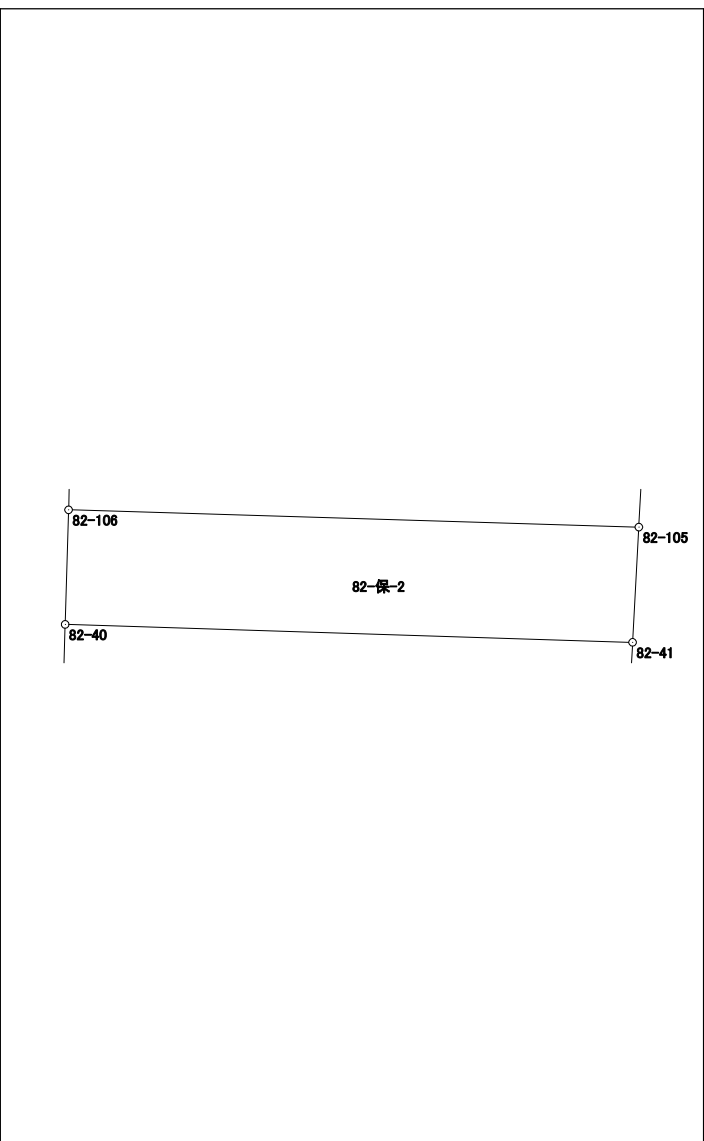


倍面積	134.002986
面 積	67.0014930

面積計算書 (座標法)

世界測地系 (測地成果2011)

所 在	地 番	公簿地目	現況地目	地 積	所 有 者
前橋市六供町四丁目	82-保-3			14.00 m ²	

点 名	X 座標	Y 座標	辺 長	方 向 角	測 角	DX	倍 積 (Y×DX)
82-107	41477.211	-67568.821	0.773	181-46-42	89-58-10	-0.201	13581.333021
82-109	41476.438	-67568.845	18.103	91-48-27	90-01-45	-1.344	90812.527680
82-110	41475.867	-67550.751	0.773	3-02-24	91-13-57	0.201	-13577.700951
82-108	41476.639	-67550.710	18.120	271-48-32	88-46-08	1.344	-90788.154240
						倍面積	28.005510
						面 積	14.0027550

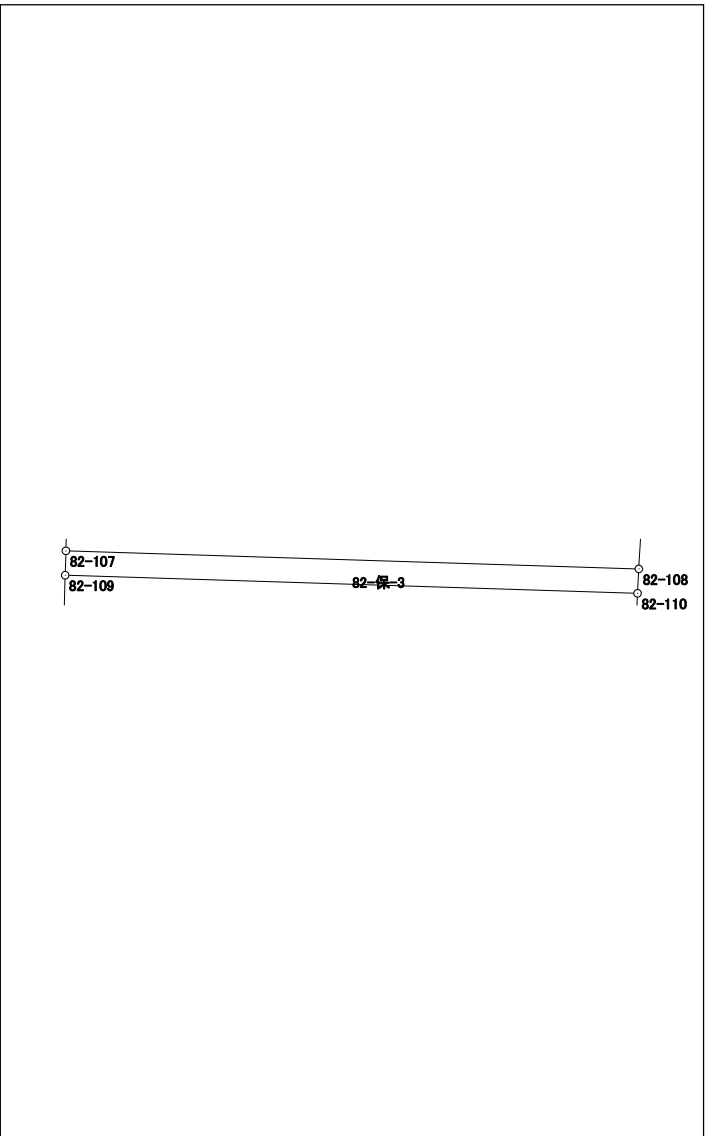


面積計算書 (座標法)

世界測地系 (測地成果2011)

所在	地番	公簿地目	現況地目	地積	所有者
前橋市六供町四丁目	82-保-4			54.00 m ²	

点名	X座標	Y座標	辺長	方向角	測角	DX	倍積 (Y×DX)
82-110	41475.867	-67550.751	18.103	271-48-27	88-44-22	3.556	-240210.470556
82-109	41476.438	-67568.845	2.989	181-44-40	89-56-13	-2.417	163313.898365
82-111	41473.450	-67568.936	18.034	91-48-18	90-03-38	-3.556	240275.136416
82-112	41472.882	-67550.911	2.989	3-04-05	91-15-47	2.417	-163270.551887

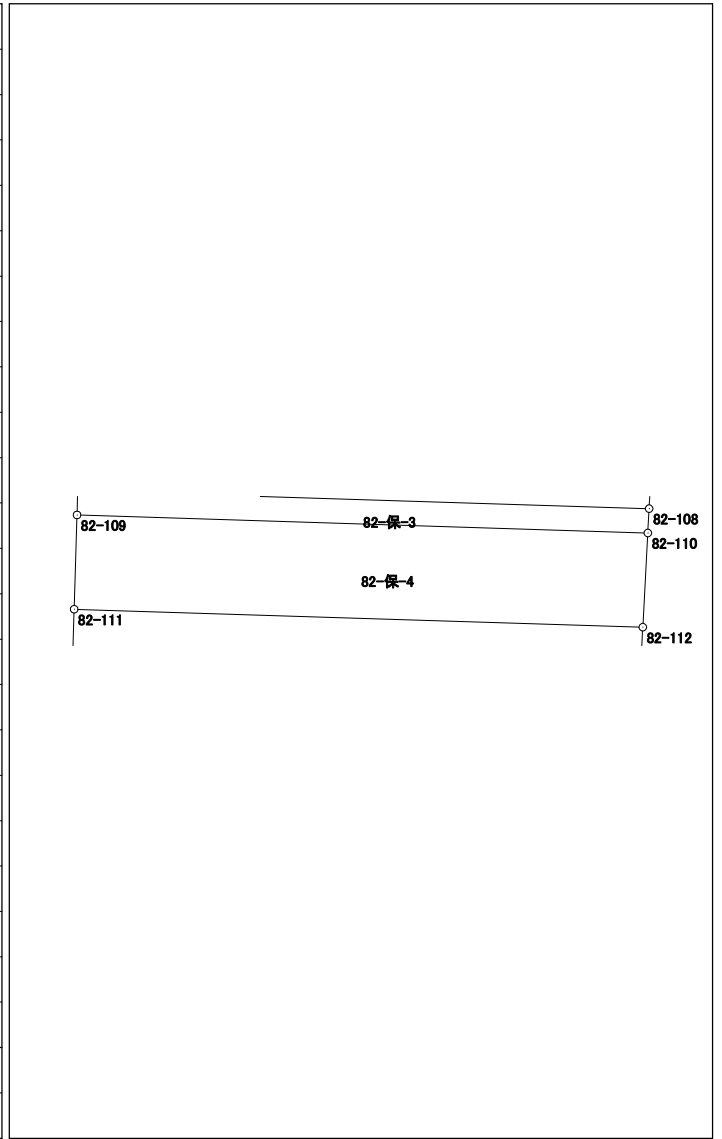

倍面積	108.012338
面積	54.0061690


面積計算書（座標法）

世界測地系（測地成果2011）

所在	地番	公簿地目	現況地目	地積	所有者
前橋市六供町四丁目	82-保-5			14.00 m ²	

点名	X座標	Y座標	辺長	方向角	測角	DX	倍積(Y×DX)
82-24	41465.996	-67622.028	20.837	1-43-37	89-56-13	20.812	-1407349.646736
82-32	41486.824	-67621.400	6.578	1-45-04	180-01-27	27.403	-1853029.224200
82-29	41493.399	-67621.199	0.511	271-47-36	90-02-32	6.591	-445691.322609
82-149	41493.415	-67621.710	27.416	181-44-06	89-56-30	-27.387	1851955.771770
82-150	41466.012	-67622.540	0.512	91-47-24	90-03-18	-27.419	1854142.424260

倍面積	28.002485
面積	14.0012425

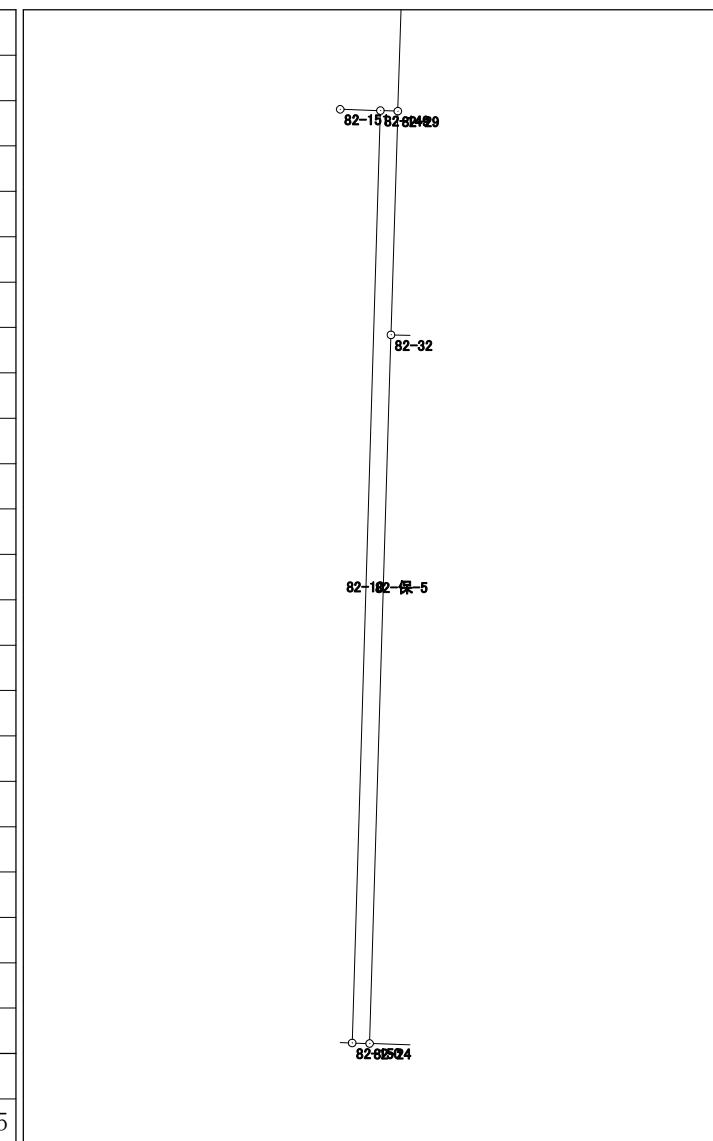


面積計算書（座標法）

世界測地系（測地成果2011）

所在	地番	公簿地目	現況地目	地積	所有者
前橋市六供町四丁目	82-保-6			58.00 m ²	

点名	X座標	Y座標	辺長	方向角	測角	DX	倍積 (Y×DX)
82-119	41509.053	-67623.935	3.729	271-46-02	90-00-11	15.667	-1059464.189645
82-121	41509.168	-67627.662	15.556	181-45-39	89-59-37	-15.434	1043765.335308
82-122	41493.619	-67628.140	3.728	91-48-50	90-03-11	-15.667	1059530.069380
82-120	41493.501	-67624.414	15.559	1-45-51	89-57-01	15.434	-1043715.205676

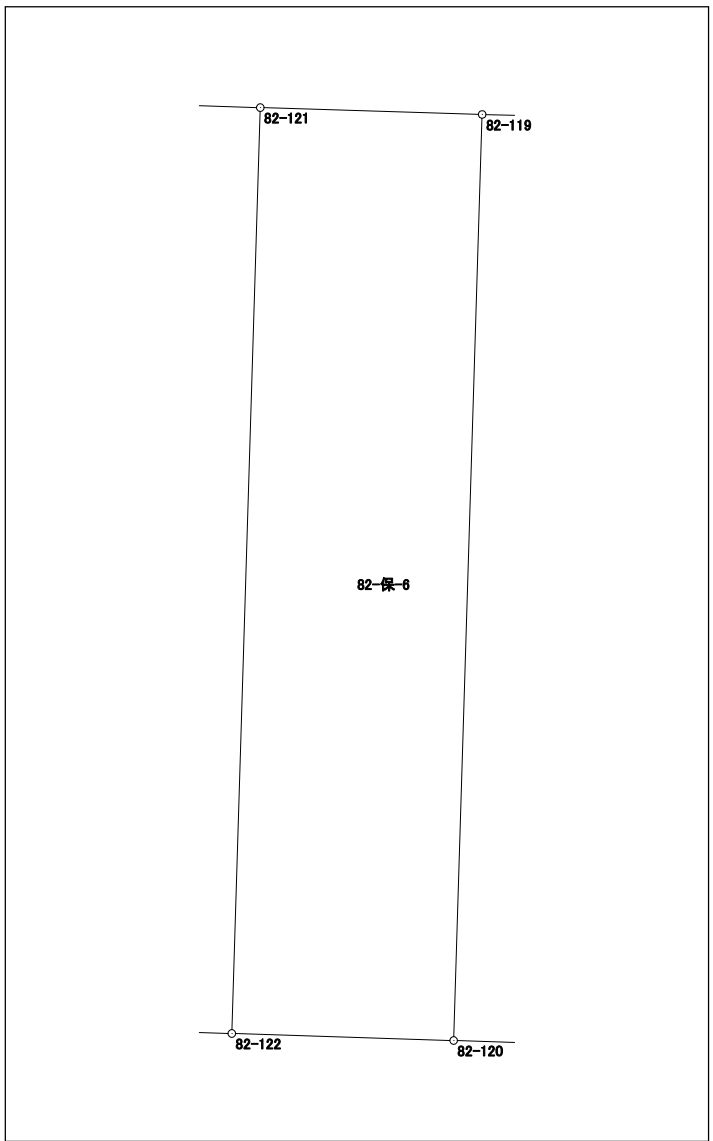


倍面積	116.009367
面積	58.0046835

面積計算書 (座標法)

世界測地系 (測地成果2011)

所在	地番	公簿地目	現況地目	地積	所有者
前橋市六供町四丁目	82-保-7			50.00 m ²	

点名	X座標	Y座標	辺長	方向角	測角	Dx	倍積 (Y×Dx)
82-124	41486.457	-67609.531	22.136	1-46-24	89-57-23	22.104	-1494441.073224
82-123	41508.582	-67608.846	2.259	271-48-04	90-01-40	22.196	-1500645.945816
82-125	41508.653	-67611.104	22.137	181-46-24	89-58-20	-22.055	1491162.898720
82-126	41486.527	-67611.789	1.597	91-45-31	89-59-07	-22.175	1499291.421075
82-147	41486.478	-67610.193	0.662	91-49-01	180-03-30	-0.070	4732.713510

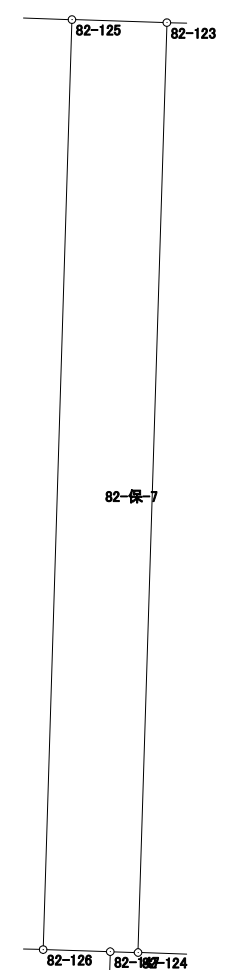


倍面積	100.014265
面積	50.0071325

面積計算書 (座標法)

世界測地系 (測地成果2011)

所在	地番	公簿地目	現況地目	地積	所有者
前橋市六供町四丁目	82-保-8			27.00 m ²	

点名	X座標	Y座標	辺長	方向角	測角	DX	倍積 (Y×DX)
82-46	41487.331	-67607.389	1.278	91-47-39	90-00-06	-21.225	1434966.831525
82-127	41487.291	-67606.112	21.196	1-46-25	89-58-46	21.146	-1429598.844352
82-128	41508.477	-67605.456	1.271	271-45-32	89-59-07	21.225	-1434925.803600
82-30	41508.516	-67606.726	21.195	181-47-33	90-02-01	-21.146	1429611.827996
						倍面積	54.011569
						面積	27.0057845

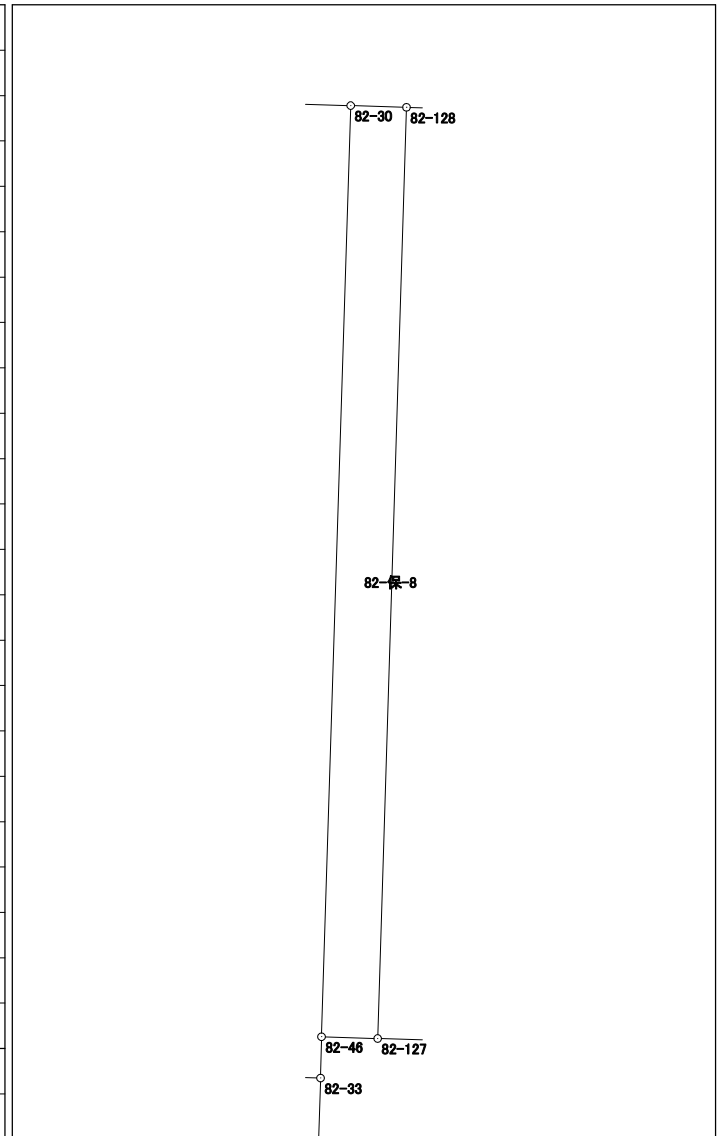


面積計算書 (座標法)

世界測地系 (測地成果2011)

所在	地番	公簿地目	現況地目	地積	所有者
前橋市六供町四丁目	82-保-9			58.00 m ²	

点名	X座標	Y座標	辺長	方向角	測角	DX	倍積 (Y×DX)
82-31	41465.558	-67608.065	8.038	1-47-48	90-00-17	7.947	-537281.292555
82-145	41473.592	-67607.813	12.806	1-47-56	180-00-08	20.834	-1408541.176042
82-33	41486.392	-67607.411	2.121	271-45-22	89-57-26	12.865	-869769.342515
82-124	41486.457	-67609.531	0.662	271-49-01	180-03-39	0.086	-5814.419666
82-147	41486.478	-67610.193	20.843	181-47-43	89-58-42	-20.812	1407103.336716
82-148	41465.645	-67610.846	2.782	91-47-31	89-59-48	-20.920	1414418.898320

倍面積	116.004258
面積	58.0021290

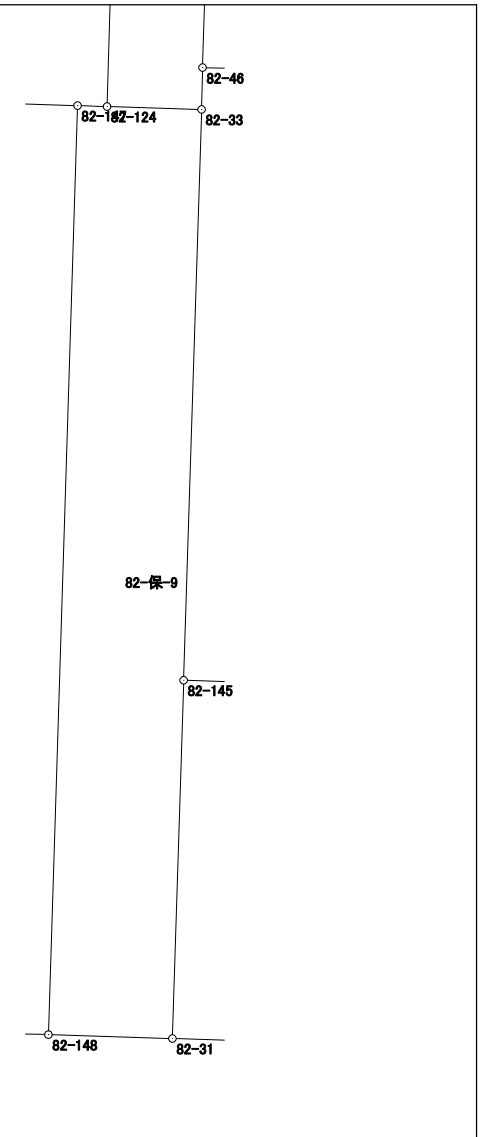


面積計算書（座標法）

世界測地系（測地成果2011）

所在	地番	公簿地目	現況地目	地積	所有者
前橋市六供町四丁目	82-保-10			86.00 m ²	

点名	X座標	Y座標	辺長	方向角	測角	DX	倍積 (Y×DX)
82-31	41465.558	-67608.065	10.700	91-47-19	89-59-31	-8.368	565744.287920
82-143	41465.224	-67597.370	8.038	1-47-48	90-00-29	7.700	-520499.749000
82-144	41473.258	-67597.118	10.700	271-47-19	89-59-31	8.368	-565652.683424
82-145	41473.592	-67607.813	8.038	181-47-48	90-00-29	-7.700	520580.160100

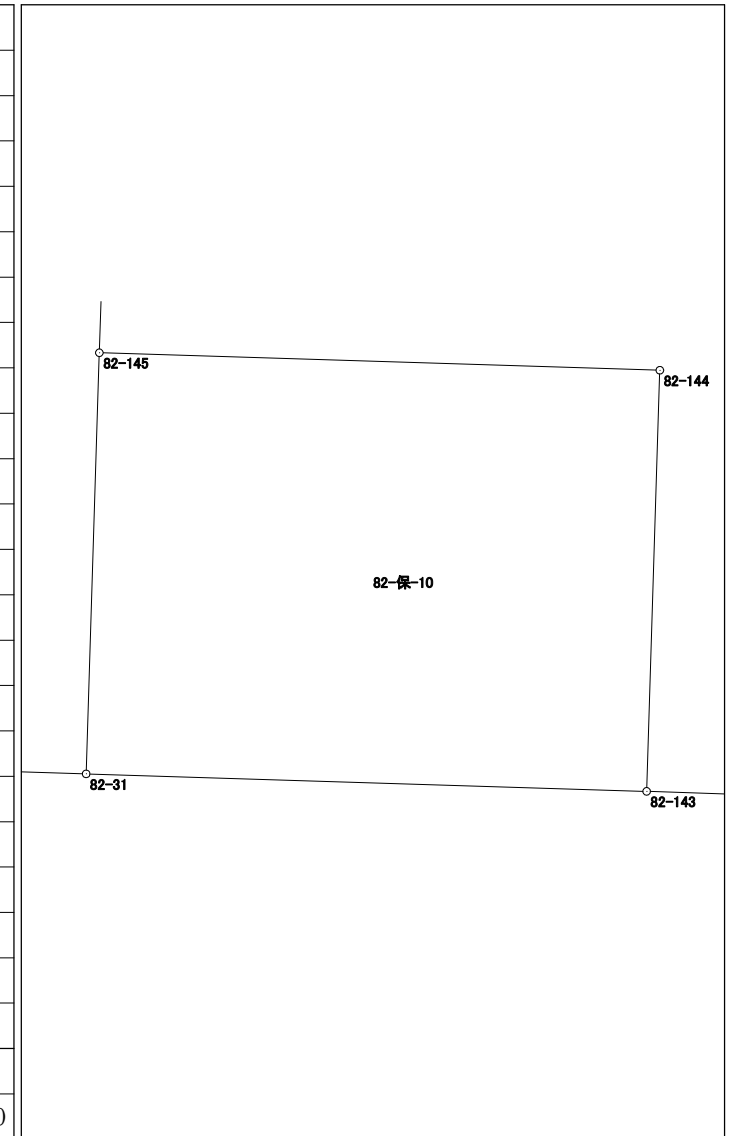


倍面積	172.015596
面積	86.0077980

面積計算書 (座標法)

世界測地系 (測地成果2011)

所在	地番	公簿地目	現況地目	地積	所有者
前橋市六供町四丁目	82-保-12			15.00 m ²	

点名	X座標	Y座標	辺長	方向角	測角	DX	倍積 (Y×DX)
82-52	41486.590	-67583.605	21.185	1-46-09	89-59-31	21.153	-1429595.996565
82-51	41507.765	-67582.951	0.707	271-51-48	90-05-39	21.198	-1432623.395298
82-129	41507.788	-67583.658	21.186	181-46-28	89-54-40	-21.153	1429597.117674
82-130	41486.612	-67584.314	0.709	91-46-38	90-00-10	-21.198	1432652.288172

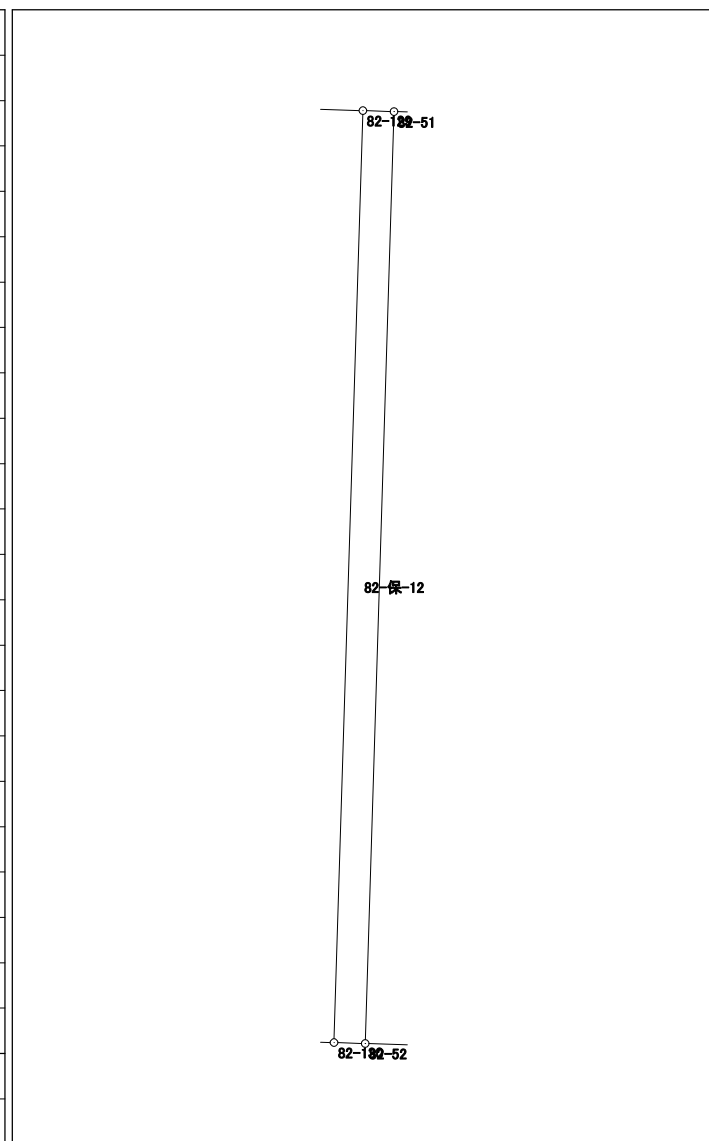

倍面積	30.013983
面積	15.0069915