


85街区 画地出来形確認図 (6635.67m²)



S=1/500

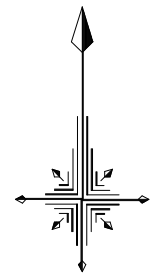


面積計算書（座標法）

世界測地系（測地成果2011）

| 所 在 | 地 番 | 公簿地目 | 現況地目 | 地 積 | 所 有 者 |
|------------|------|------|------|-----------------------|-------|
| 前橋市天川原町一丁目 | 85-4 | | | 781.85 m ² | |

| 点 名 | X 座標 | Y 座標 | 辺 長 | 方 向 角 | 測 角 | DX | 倍 積 (Y×DX) |
|--------|-----------|------------|--------|-----------|-----------|---------|-----------------|
| 85-123 | 41501.809 | -67508.338 | 27.931 | 272-50-17 | 89-58-54 | 29.281 | -1976711.644978 |
| 85-13 | 41503.192 | -67536.235 | 27.927 | 183-07-49 | 90-17-32 | -26.502 | 1789845.299970 |
| 85-27 | 41475.307 | -67537.760 | 16.508 | 92-49-47 | 89-41-58 | -28.700 | 1938333.712000 |
| 85-117 | 41474.492 | -67521.272 | 6.311 | 92-50-02 | 180-00-15 | -1.127 | 76096.473544 |
| 85-28 | 41474.180 | -67514.969 | 5.246 | 92-56-22 | 180-06-20 | -0.581 | 39226.196989 |
| 85-124 | 41473.911 | -67509.730 | 27.933 | 2-51-23 | 89-55-01 | 27.629 | -1865226.330170 |
| | | | | | | | |
| | | | | | | | |
| | | | | | | 倍面積 | 1563.707355 |
| | | | | | | 面 積 | 781.8536775 |

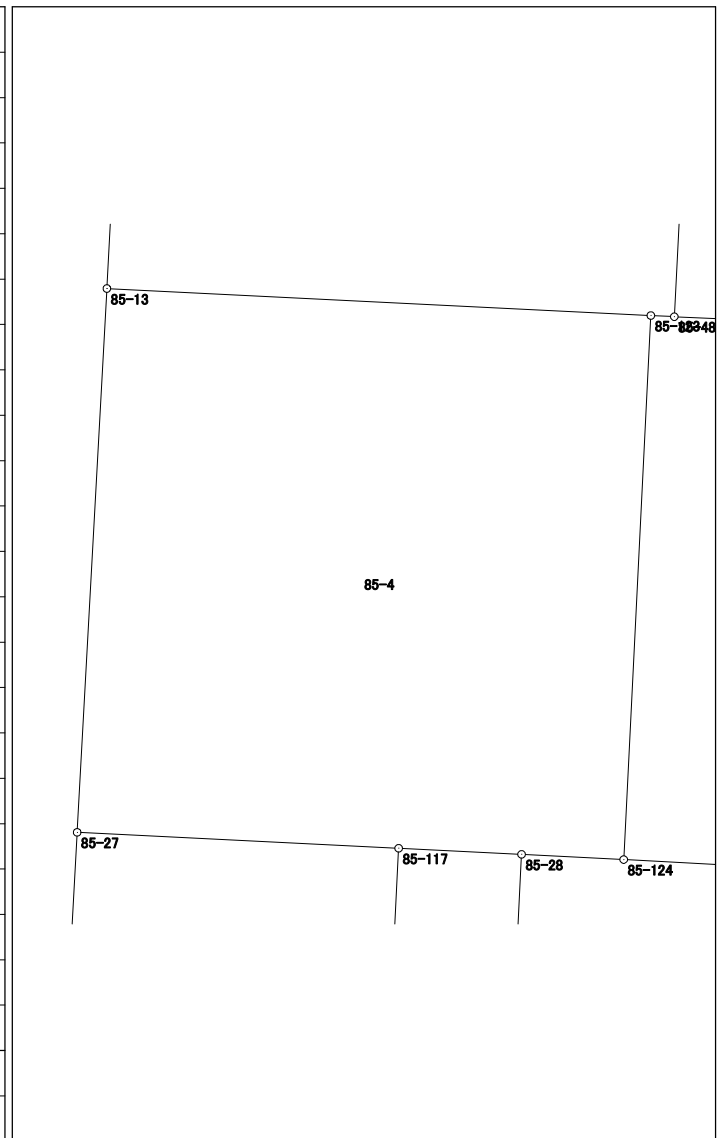


面積計算書（座標法）

世界測地系（測地成果2011）

| 所在 | 地番 | 公簿地目 | 現況地目 | 地積 | 所有者 |
|------------|------|------|------|-----------------------|-----|
| 前橋市天川原町一丁目 | 85-6 | | | 350.21 m ² | |

| 点名 | X座標 | Y座標 | 辺長 | 方向角 | 測角 | DX | 倍積 (Y×DX) |
|--------|-----------|------------|--------|-----------|-----------|---------|-----------------|
| 85-107 | 41478.023 | -67476.031 | 3.671 | 92-44-52 | 89-53-38 | -22.303 | 1504917.919393 |
| 85-111 | 41477.847 | -67472.364 | 2.805 | 92-45-30 | 180-00-38 | -0.311 | 20983.905204 |
| 85-33 | 41477.712 | -67469.562 | 2.805 | 92-49-10 | 180-03-40 | -0.273 | 18419.190426 |
| 85-110 | 41477.574 | -67466.760 | 6.530 | 92-49-04 | 179-59-54 | -0.459 | 30967.242840 |
| 85-34 | 41477.253 | -67460.238 | 22.139 | 2-52-17 | 90-03-13 | 21.790 | -1469958.586020 |
| 85-20 | 41499.364 | -67459.129 | 15.819 | 272-50-53 | 89-58-36 | 22.897 | -1544611.676713 |
| 85-108 | 41500.150 | -67474.928 | 22.154 | 182-51-14 | 90-00-21 | -21.341 | 1439982.438448 |
| | | | | | | | |
| | | | | | | | |
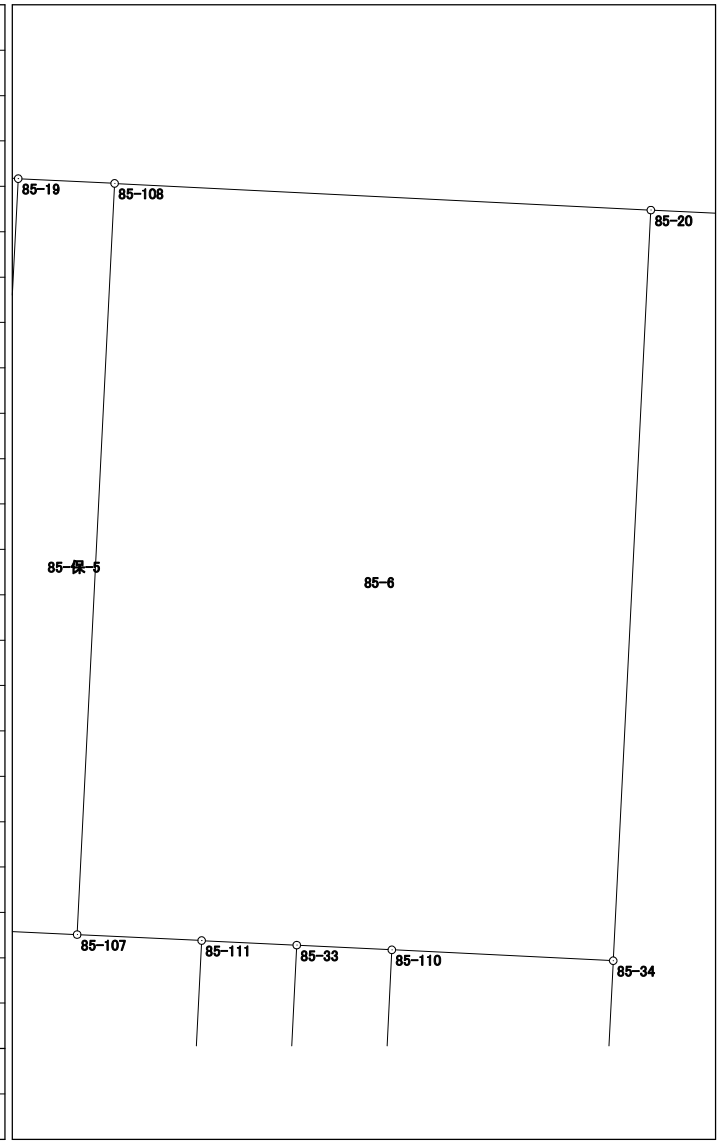


| | |
|-----|-------------|
| 倍面積 | 700.433578 |
| 面積 | 350.2167890 |

面積計算書 (座標法)

世界測地系 (測地成果2011)

| 所在 | 地番 | 公簿地目 | 現況地目 | 地積 | 所有者 |
|------------|------|------|------|-----------------------|-----|
| 前橋市天川原町一丁目 | 85-7 | | | 464.10 m ² | |

| 点名 | X座標 | Y座標 | 辺長 | 方向角 | 測角 | DX | 倍積 (Y×DX) |
|--------|-----------|------------|--------|-----------|-----------|---------|-----------------|
| 85-105 | 41473.456 | -67441.732 | 22.176 | 3-03-10 | 90-12-14 | 21.217 | -1430911.227844 |
| 85-6 | 41495.601 | -67440.551 | 3.996 | 318-12-21 | 135-09-11 | 25.124 | -1694376.403324 |
| 85-5 | 41498.580 | -67443.214 | 15.934 | 272-49-13 | 134-36-52 | 3.763 | -253788.814282 |
| 85-20 | 41499.364 | -67459.129 | 22.139 | 182-52-17 | 90-03-04 | -21.327 | 1438700.844183 |
| 85-34 | 41477.253 | -67460.238 | 2.873 | 182-50-01 | 179-57-44 | -24.980 | 1685156.745240 |
| 85-106 | 41474.384 | -67460.380 | 18.671 | 92-50-56 | 90-00-55 | -3.797 | 256147.062860 |
| | | | | | | | |
| | | | | | | | |
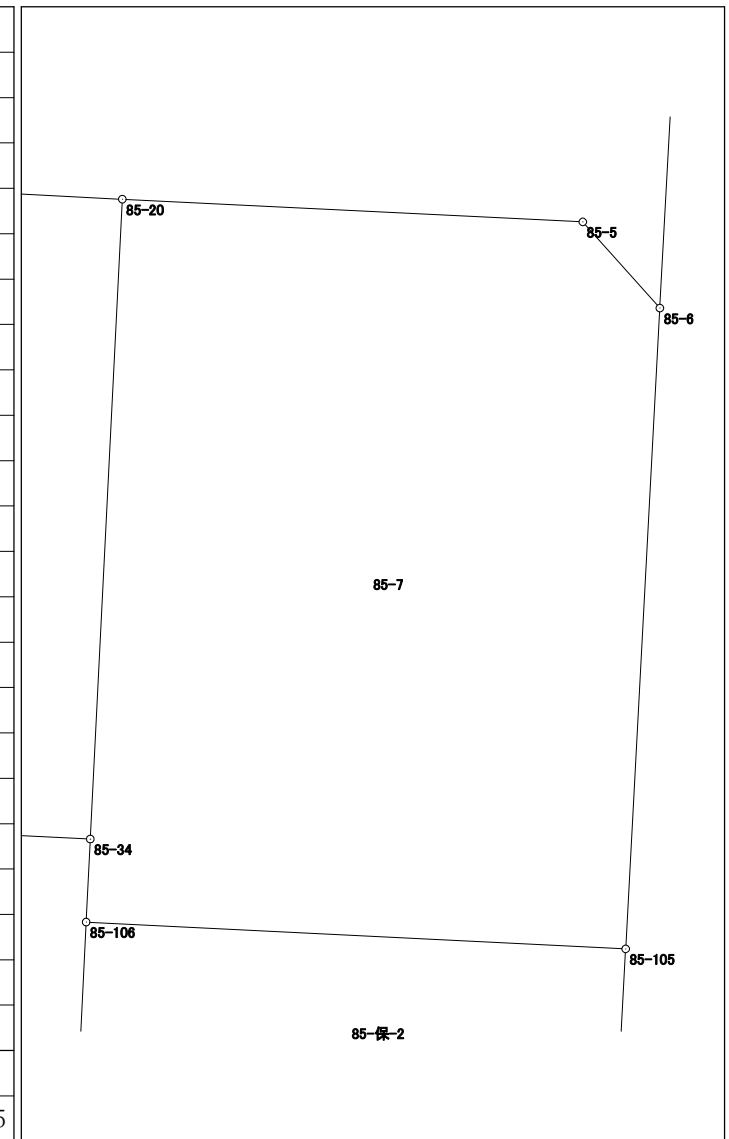


| | |
|-----|-------------|
| 倍面積 | 928.206833 |
| 面積 | 464.1034165 |

面積計算書 (座標法)

世界測地系 (測地成果2011)

| 所在 | 地番 | 公簿地目 | 現況地目 | 地積 | 所有者 |
|------------|------|------|------|-----------------------|-----|
| 前橋市天川原町一丁目 | 85-8 | | | 115.90 m ² | |

| 点名 | X座標 | Y座標 | 辺長 | 方向角 | 測角 | DX | 倍積 (Y×DX) |
|--------|-----------|------------|--------|-----------|----------|--------|----------------|
| 85-7 | 41458.514 | -67442.529 | 6.224 | 3-02-55 | 90-11-48 | 5.289 | -356703.535881 |
| 85-101 | 41464.729 | -67442.198 | 18.635 | 272-51-05 | 89-48-10 | 7.142 | -481672.178116 |
| 85-102 | 41465.656 | -67460.810 | 6.224 | 182-49-39 | 89-58-34 | -5.289 | 356800.224090 |
| 85-22 | 41459.440 | -67461.117 | 18.611 | 92-51-07 | 90-01-28 | -7.142 | 481807.297614 |
| | | | | | | | |
| | | | | | | | |
| | | | | | | 倍面積 | 231.807707 |
| | | | | | | 面積 | 115.9038535 |

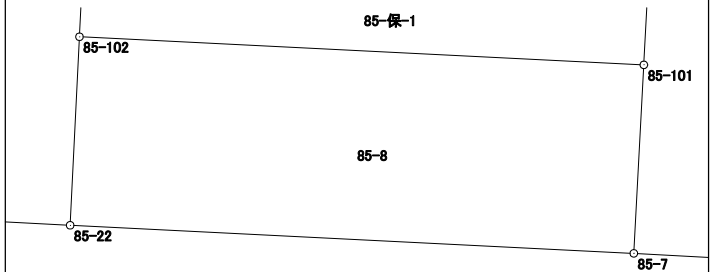


面積計算書 (座標法)

世界測地系 (測地成果2011)

| 所在 | 地番 | 公簿地目 | 現況地目 | 地積 | 所有者 |
|------------|------|------|------|-----------------------|-----|
| 前橋市天川原町一丁目 | 85-9 | | | 116.45 m ² | |

| 点名 | X座標 | Y座標 | 辺長 | 方向角 | 測角 | DX | 倍積 (Y×DX) |
|--------|-----------|------------|--------|-----------|-----------|---------|----------------|
| 85-109 | 41459.767 | -67467.640 | 6.531 | 92-52-11 | 90-02-26 | -18.134 | 1223458.183760 |
| 85-22 | 41459.440 | -67461.117 | 6.224 | 2-49-39 | 89-57-28 | 5.889 | -397278.518013 |
| 85-102 | 41465.656 | -67460.810 | 2.682 | 2-49-15 | 179-59-36 | 8.895 | -600063.904950 |
| 85-104 | 41468.335 | -67460.678 | 6.056 | 2-49-13 | 179-59-58 | 8.728 | -588796.797584 |
| 85-106 | 41474.384 | -67460.380 | 2.873 | 2-50-01 | 180-00-48 | 8.918 | -601611.668840 |
| 85-34 | 41477.253 | -67460.238 | 6.530 | 272-49-04 | 89-59-03 | 3.190 | -215198.159220 |
| 85-110 | 41477.574 | -67466.760 | 17.829 | 182-49-45 | 90-00-41 | -17.486 | 1179723.765360 |
| | | | | | | | |
| | | | | | | | |
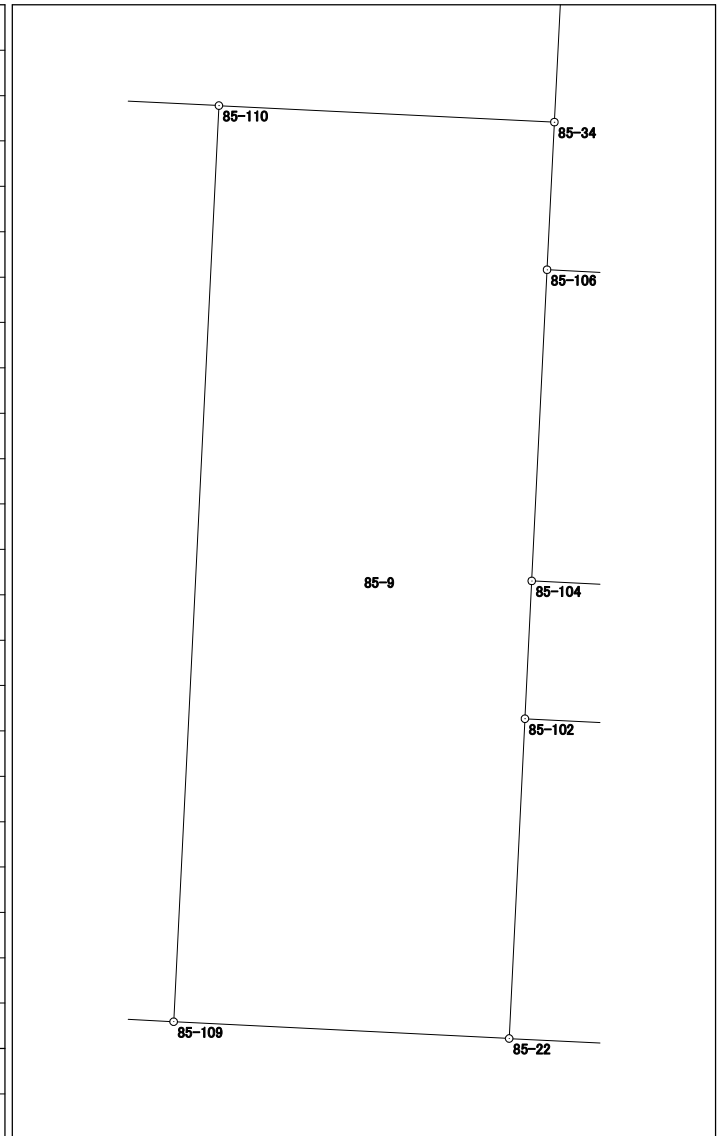


| | |
|-----|-------------|
| 倍面積 | 232.900513 |
| 面積 | 116.4502565 |

面積計算書 (座標法)

世界測地系 (測地成果2011)

| 所在 | 地番 | 公簿地目 | 現況地目 | 地積 | 所有者 |
|------------|-------|------|------|-----------------------|-----|
| 前橋市天川原町一丁目 | 85-10 | | | 116.19 m ² | |

| 点名 | X座標 | Y座標 | 辺長 | 方向角 | 測角 | DX | 倍積 (Y×DX) |
|--------|-----------|------------|--------|-----------|-----------|---------|-----------------|
| 85-107 | 41478.023 | -67476.031 | 2.843 | 272-44-30 | 179-59-38 | 0.312 | -21052.521672 |
| 85-32 | 41478.159 | -67478.871 | 5.791 | 182-52-13 | 90-07-43 | -5.648 | 381120.663408 |
| 85-31 | 41472.375 | -67479.161 | 12.020 | 182-52-32 | 180-00-19 | -17.789 | 1200386.795029 |
| 85-24 | 41460.370 | -67479.764 | 6.529 | 92-50-08 | 89-57-36 | -12.328 | 831890.530592 |
| 85-112 | 41460.047 | -67473.243 | 17.822 | 2-49-38 | 89-59-30 | 17.477 | -1179229.867911 |
| 85-111 | 41477.847 | -67472.364 | 3.671 | 272-44-52 | 89-55-14 | 17.976 | -1212883.215264 |
| | | | | | | | |
| | | | | | | | |
| | | | | | | 倍面積 | 232.384182 |
| | | | | | | 面積 | 116.1920910 |

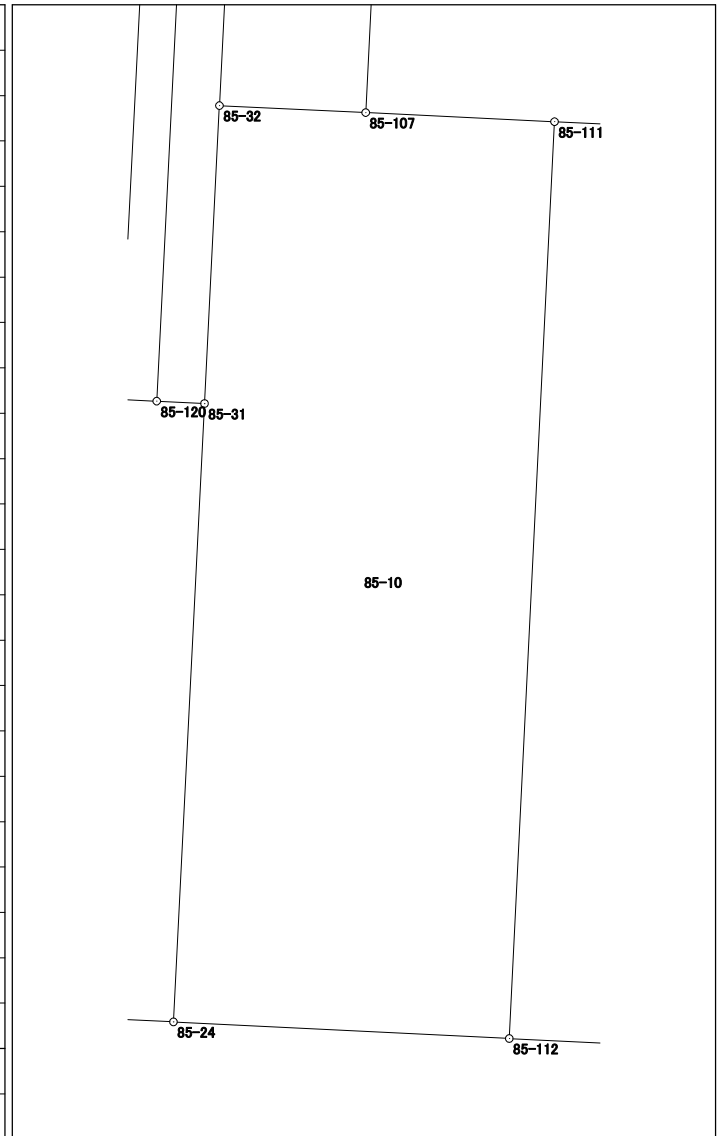


面積計算書 (座標法)

世界測地系 (測地成果2011)

| | | | | | |
|------------|-------|------|------|-----------------------|-----|
| 所在 | 地番 | 公簿地目 | 現況地目 | 地積 | 所有者 |
| 前橋市天川原町一丁目 | 85-12 | | | 149.39 m ² | |

| 点名 | X座標 | Y座標 | 辺長 | 方向角 | 測角 | DX | 倍積 (Y×DX) |
|--------|-----------|------------|--------|-----------|-----------|---------|----------------|
| 85-115 | 41473.543 | -67502.570 | 7.169 | 272-56-32 | 90-03-17 | 12.382 | -835816.821740 |
| 85-124 | 41473.911 | -67509.730 | 5.246 | 272-56-22 | 179-59-50 | 0.637 | -43003.698010 |
| 85-28 | 41474.180 | -67514.969 | 12.044 | 182-51-20 | 89-54-58 | -11.760 | 793976.035440 |
| 85-26 | 41462.151 | -67515.569 | 12.409 | 92-52-24 | 90-01-04 | -12.651 | 854139.463419 |
| 85-116 | 41461.529 | -67503.176 | 12.029 | 2-53-15 | 90-00-51 | 11.392 | -768996.180992 |
| | | | | | | | |
| | | | | | | | |
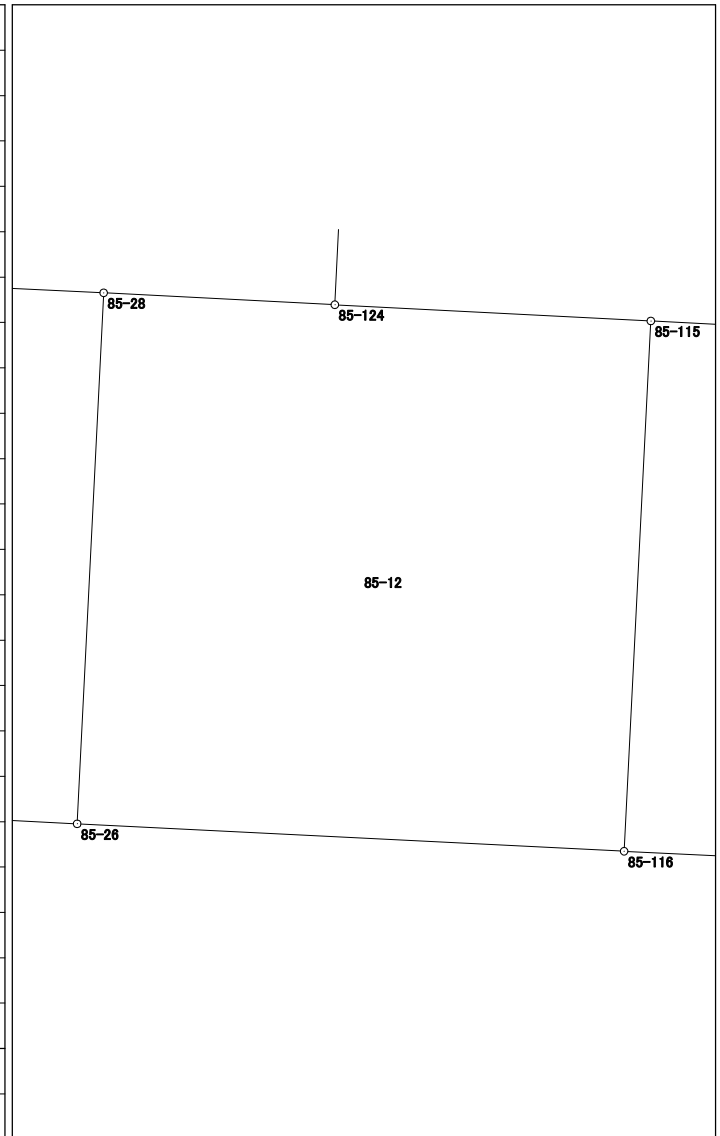


| | |
|-----|-------------|
| 倍面積 | 298.798117 |
| 面積 | 149.3990585 |

面積計算書（座標法）

世界測地系（測地成果2011）

| 所在 | 地番 | 公簿地目 | 現況地目 | 地積 | 所有者 |
|------------|-------|------|------|-----------------------|-----|
| 前橋市天川原町一丁目 | 85-13 | | | 190.16 m ² | |

| 点名 | X座標 | Y座標 | 辺長 | 方向角 | 測角 | DX | 倍積(Y×DX) |
|--------|-----------|------------|--------|-----------|-----------|---------|----------------|
| 85-117 | 41474.492 | -67521.272 | 16.508 | 272-49-47 | 89-58-28 | 12.845 | -867310.738840 |
| 85-27 | 41475.307 | -67537.760 | 7.788 | 183-07-42 | 90-17-55 | -6.961 | 470130.347360 |
| 85-9 | 41467.531 | -67538.185 | 5.989 | 138-08-01 | 135-00-19 | -12.236 | 826397.231660 |
| 85-8 | 41463.071 | -67534.188 | 12.331 | 92-49-51 | 134-41-50 | -5.069 | 342330.798972 |
| 85-118 | 41462.462 | -67521.872 | 12.045 | 2-51-19 | 90-01-28 | 11.421 | -771167.300112 |
| | | | | | | | |
| | | | | | | | |
| | | | | | | 倍面積 | 380.339040 |
| | | | | | | 面積 | 190.1695200 |

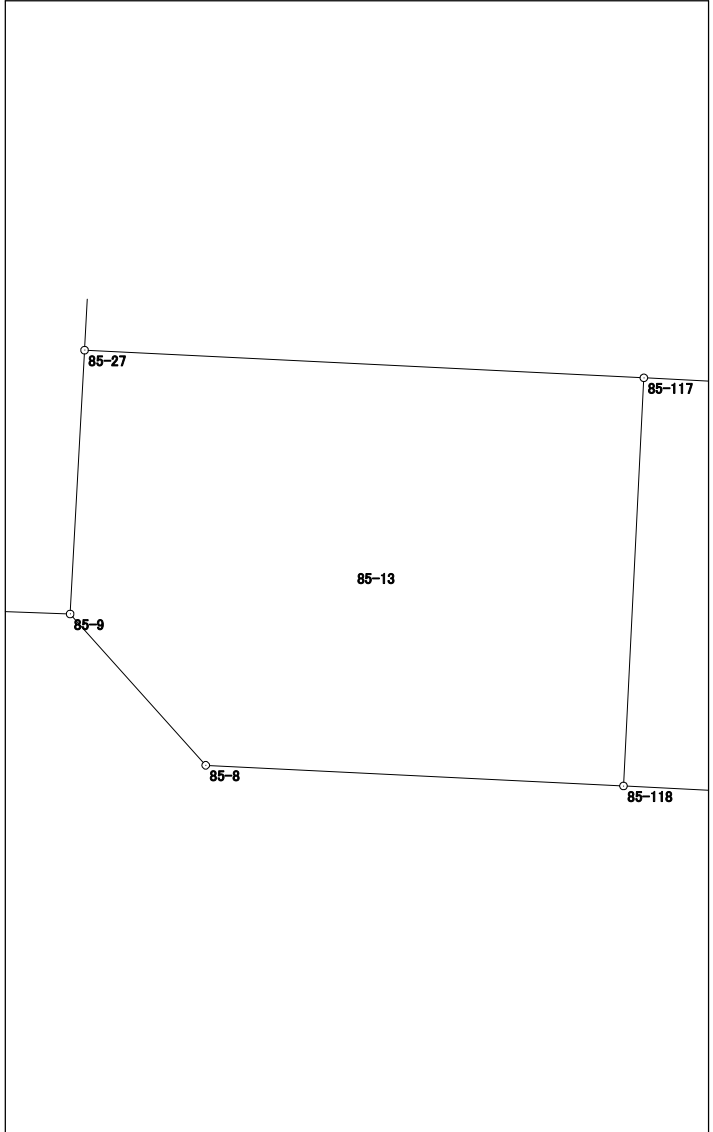


面積計算書（座標法）

世界測地系（測地成果2011）

| 所 在 | 地 番 | 公簿地目 | 現況地目 | 地 積 | 所 有 者 |
|------------|-------|------|------|-----------------------|-------|
| 前橋市天川原町一丁目 | 85-14 | | | 334.08 m ² | |

| 点 名 | X 座標 | Y 座標 | 辺 長 | 方 向 角 | 測 角 | DX | 倍 積 (Y×DX) |
|--------|-----------|------------|--------|-----------|----------|---------|-----------------|
| 85-125 | 41549.683 | -67511.061 | 22.616 | 272-38-18 | 89-20-40 | 15.879 | -1072008.137619 |
| 85-41 | 41550.724 | -67533.653 | 14.706 | 183-09-26 | 90-31-08 | -13.643 | 921361.627879 |
| 85-15 | 41536.040 | -67534.463 | 22.580 | 93-02-01 | 89-52-35 | -15.879 | 1072379.737977 |
| 85-127 | 41534.845 | -67511.915 | 14.863 | 3-17-38 | 90-15-37 | 13.643 | -921065.056345 |
| | | | | | | | |
| | | | | | | | |
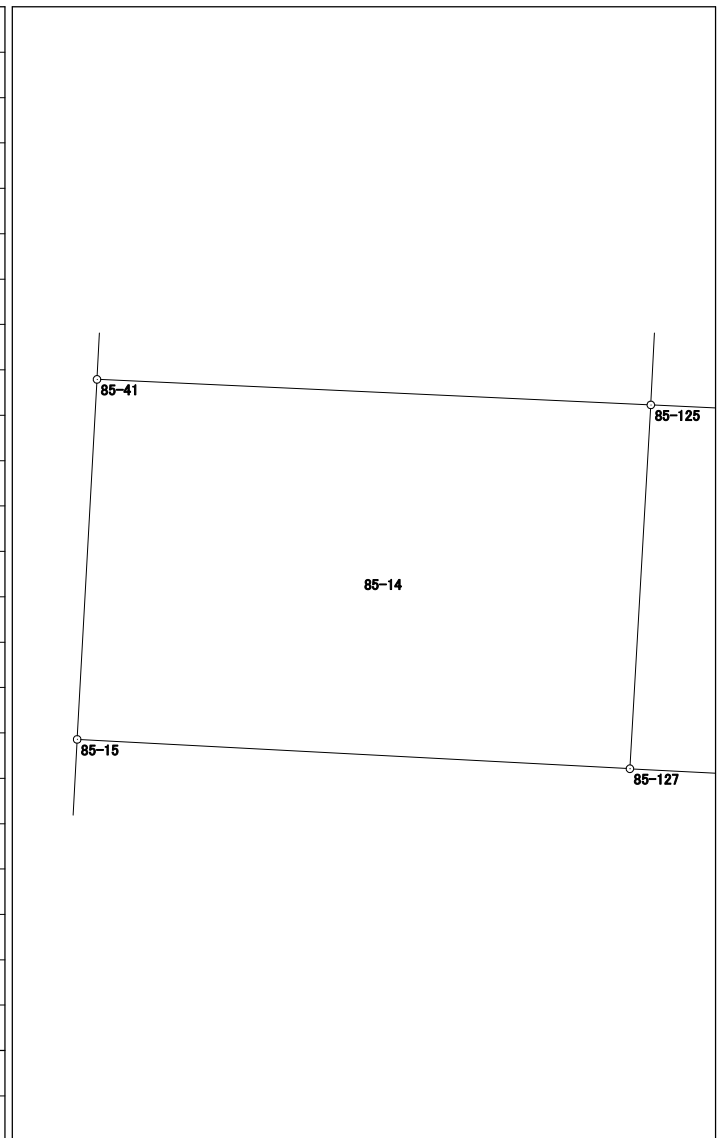


| | |
|-----|-------------|
| 倍面積 | 668.171892 |
| 面 積 | 334.0859460 |

面積計算書 (座標法)

世界測地系 (測地成果2011)

| | | | | | |
|------------|-------|------|------|-----------------------|-----|
| 所在 | 地番 | 公簿地目 | 現況地目 | 地積 | 所有者 |
| 前橋市天川原町一丁目 | 85-15 | | | 334.13 m ² | |

| 点名 | X座標 | Y座標 | 辺長 | 方向角 | 測角 | DX | 倍積 (Y×DX) |
|--------|-----------|------------|--------|-----------|----------|---------|-----------------|
| 85-37 | 41564.617 | -67510.284 | 22.595 | 271-46-13 | 88-47-31 | 15.632 | -1055320.759488 |
| 85-1 | 41565.315 | -67532.868 | 14.612 | 183-04-46 | 91-18-33 | -13.893 | 938234.135124 |
| 85-41 | 41550.724 | -67533.653 | 22.616 | 92-38-18 | 89-33-32 | -15.632 | 1055686.063696 |
| 85-125 | 41549.683 | -67511.061 | 14.954 | 2-58-42 | 90-20-24 | 13.893 | -937931.170473 |
| | | | | | | | |
| | | | | | | | |
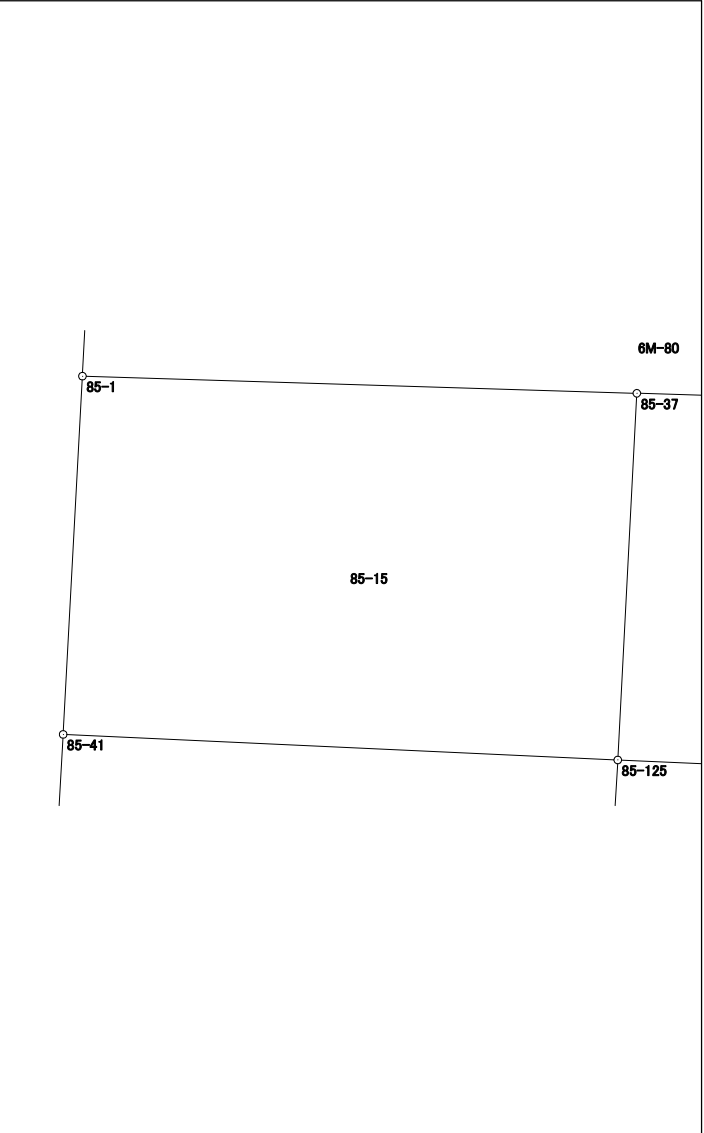


| | |
|-----|-------------|
| 倍面積 | 668.268859 |
| 面積 | 334.1344295 |

面積計算書（座標法）

世界測地系（測地成果2011）

| | | | | | |
|------------|-------|------|------|-----------------------|-------|
| 所 在 | 地 番 | 公簿地目 | 現況地目 | 地 積 | 所 有 者 |
| 前橋市天川原町一丁目 | 85-16 | | | 334.13 m ² | |

| 点 名 | X 座標 | Y 座標 | 辺 長 | 方 向 角 | 測 角 | DX | 倍 積 (Y×DX) |
|--------|-----------|------------|--------|-----------|-----------|---------|-----------------|
| 85-37 | 41564.617 | -67510.284 | 14.954 | 182-58-42 | 91-13-47 | -14.339 | 968029.962276 |
| 85-125 | 41549.683 | -67511.061 | 22.341 | 92-38-24 | 89-39-42 | -15.963 | 1077679.066743 |
| 85-42 | 41548.654 | -67488.744 | 12.453 | 3-06-42 | 90-28-18 | 11.406 | -769776.614064 |
| 85-3 | 41561.089 | -67488.068 | 4.005 | 317-05-04 | 133-58-22 | 15.368 | -1037156.629024 |
| 85-2 | 41564.022 | -67490.795 | 19.498 | 271-44-55 | 134-39-51 | 3.528 | -238107.524760 |
| | | | | | | | |
| | | | | | | | |
| 倍面積 | | | | | | | 668.261171 |
| 面 積 | | | | | | | 334.1305855 |

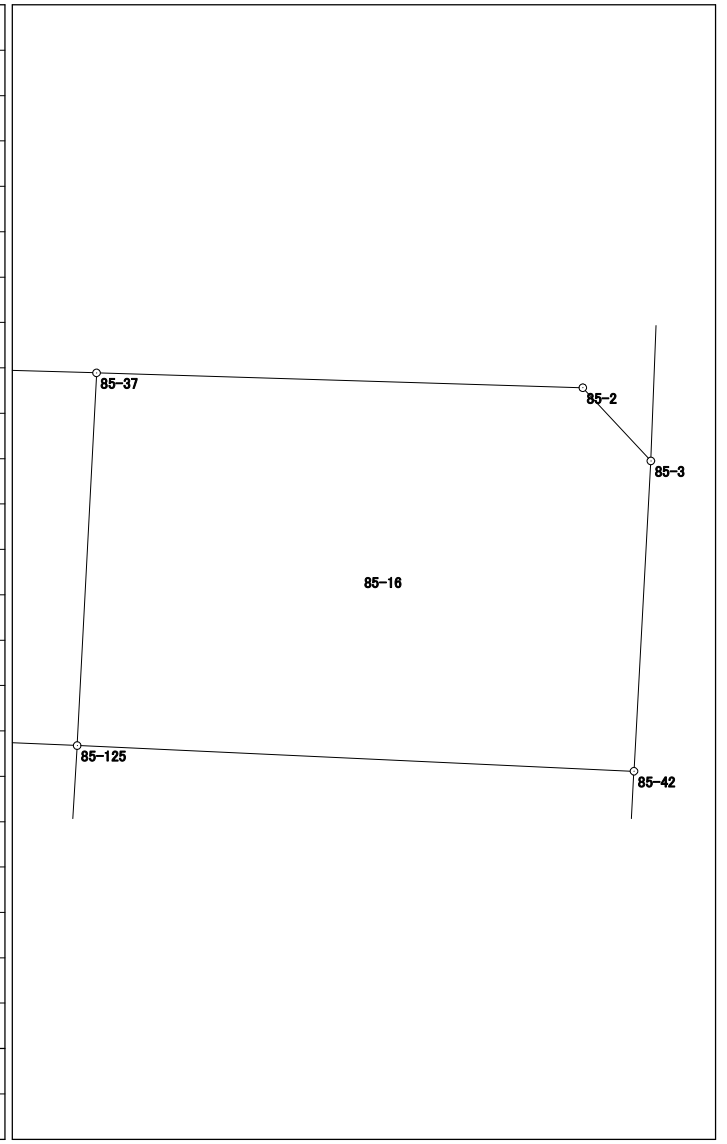


面積計算書（座標法）

世界測地系（測地成果2011）

| 所在 | 地番 | 公簿地目 | 現況地目 | 地積 | 所有者 |
|------------|-------|------|------|---------------------|-----|
| 前橋市天川原町一丁目 | 85-17 | | | 6.46 m ² | |

| 点名 | X座標 | Y座標 | 辺長 | 方向角 | 測角 | DX | 倍積 (Y×DX) |
|--------|-----------|------------|--------|-----------|----------|---------|----------------|
| 85-30 | 41473.274 | -67497.338 | 12.023 | 182-53-21 | 90-00-39 | -11.981 | 808685.606578 |
| 85-25 | 41461.266 | -67497.944 | 0.538 | 92-46-19 | 89-52-58 | -12.034 | 812270.258096 |
| 85-113 | 41461.240 | -67497.407 | 12.022 | 2-53-21 | 90-07-02 | 11.981 | -808686.433267 |
| 85-114 | 41473.247 | -67496.801 | 0.538 | 272-52-42 | 89-59-21 | 12.034 | -812256.503234 |
| | | | | | | | |
| | | | | | | | |
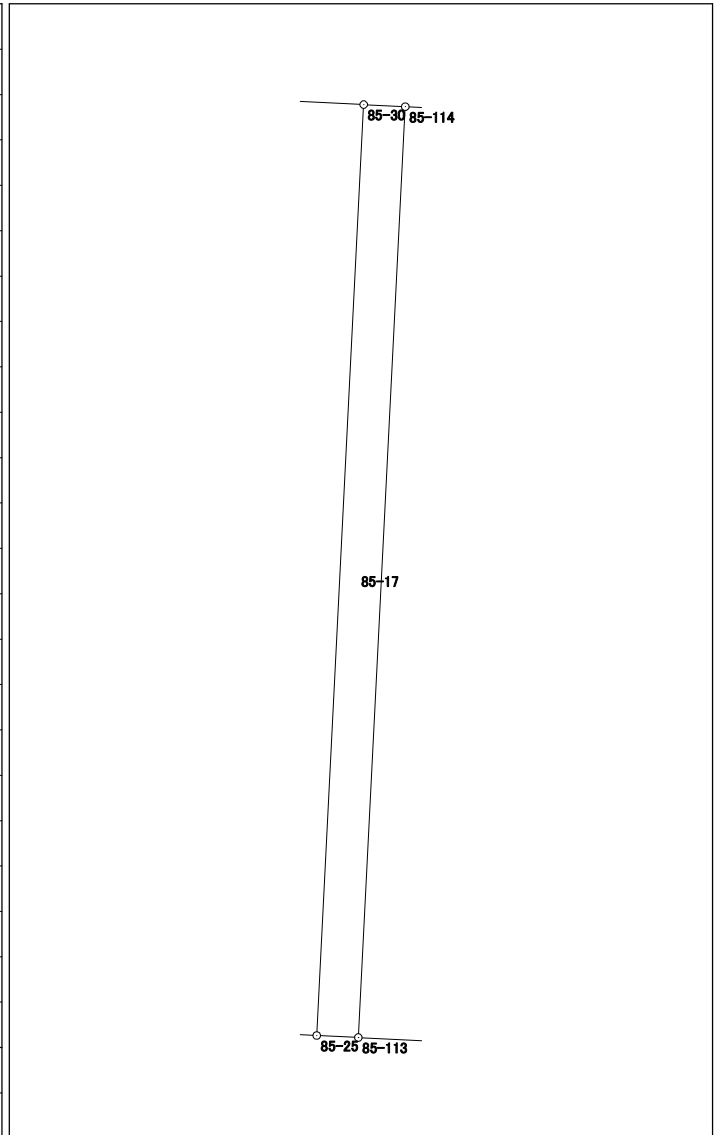


| | |
|-----|-----------|
| 倍面積 | 12.928173 |
| 面積 | 6.4640865 |

面積計算書（座標法）

世界測地系（測地成果2011）

| 所 在 | 地 番 | 公簿地目 | 現況地目 | 地 積 | 所 有 者 |
|------------|--------|------|------|----------------------|-------|
| 前橋市天川原町一丁目 | 85-保-1 | | | 50.00 m ² | |


| 点 名 | X 座標 | Y 座標 | 辺 長 | 方 向 角 | 測 角 | DX | 倍 積 (Y×DX) |
|--------|-----------|------------|--------|-----------|----------|--------|----------------|
| 85-102 | 41465.656 | -67460.810 | 18.635 | 92-51-05 | 90-01-50 | -3.606 | 243263.680860 |
| 85-101 | 41464.729 | -67442.198 | 2.683 | 3-03-20 | 90-12-15 | 1.752 | -118158.730896 |
| 85-103 | 41467.408 | -67442.055 | 18.646 | 272-50-59 | 89-47-39 | 3.606 | -243196.050330 |
| 85-104 | 41468.335 | -67460.678 | 2.682 | 182-49-15 | 89-58-16 | -1.752 | 118191.107856 |
| | | | | | | | |
| | | | | | | | |
| | | | | | | 倍面積 | 100.007490 |
| | | | | | | 面 積 | 50.0037450 |

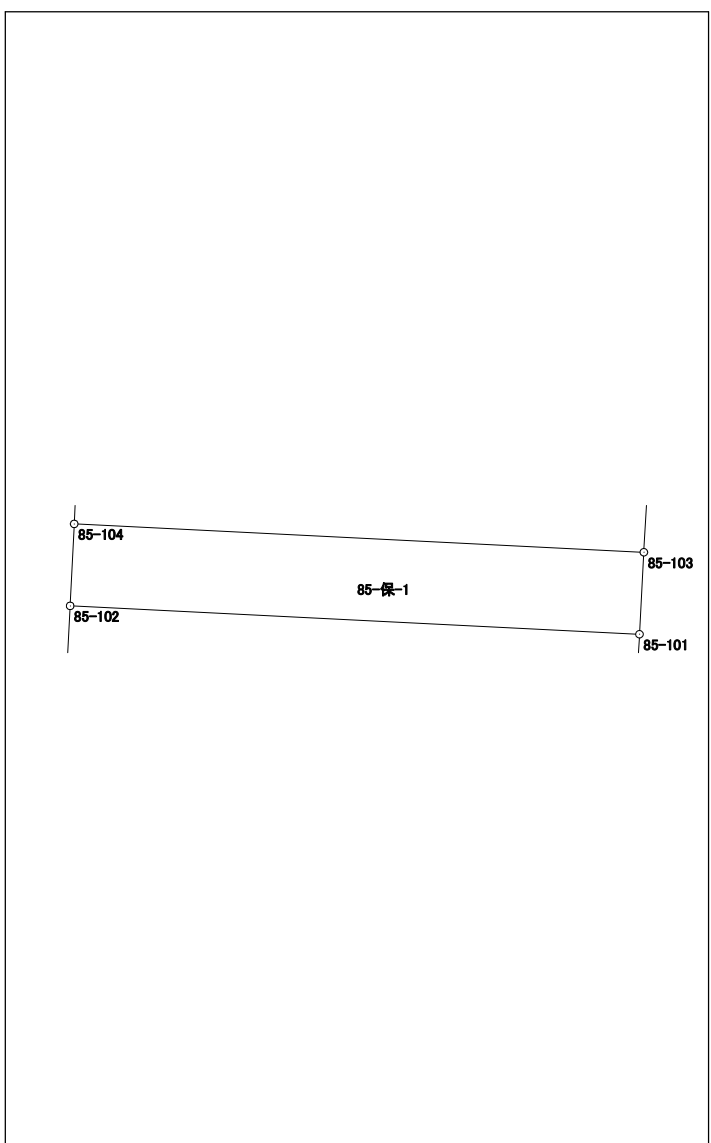

面積計算書 (座標法)

| 所 在 | 地 番 | 公簿地目 | 現況地目 | 地 積 | 所 有 者 |
|------------|--------|------|------|-----------------------|-------|
| 前橋市天川原町一丁目 | 85-保-2 | | | 113.00 m ² | |

| 点 名 | X 座標 | Y 座標 | 辺 長 | 方 向 角 | 測 角 | DX | 倍 積 (Y×DX) |
|--------|-----------|------------|--------|-----------|----------|--------|----------------|
| 85-104 | 41468.335 | -67460.678 | 18.646 | 92-50-59 | 90-01-46 | -6.976 | 470605.689728 |
| 85-103 | 41467.408 | -67442.055 | 6.057 | 3-03-25 | 90-12-26 | 5.121 | -345370.763655 |
| 85-105 | 41473.456 | -67441.732 | 18.671 | 272-50-56 | 89-47-31 | 6.976 | -470473.522432 |
| 85-106 | 41474.384 | -67460.380 | 6.056 | 182-49-13 | 89-58-17 | -5.121 | 345464.605980 |
| | | | | | | | |
| | | | | | | | |
| | | | | | | 倍面積 | 226.009621 |
| | | | | | | 面 積 | 113.0048105 |

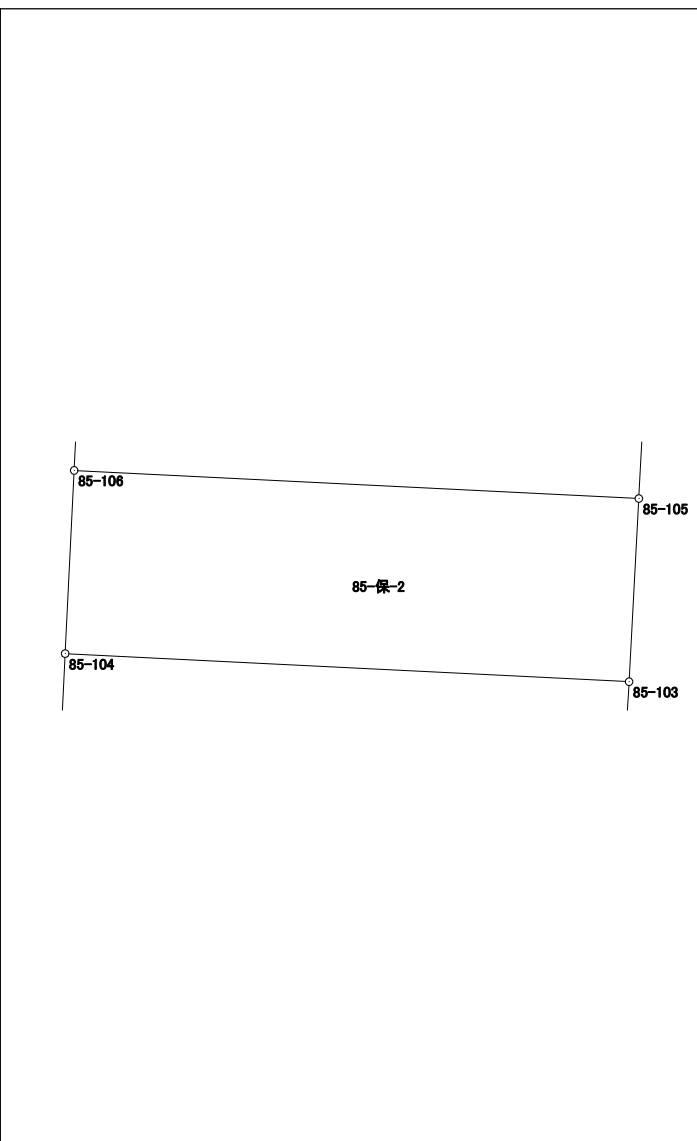


面積計算書（座標法）

世界測地系（測地成果2011）

| 所在 | 地番 | 公簿地目 | 現況地目 | 地積 | 所有者 |
|------------|--------|------|------|----------------------|-----|
| 前橋市天川原町一丁目 | 85-保-3 | | | 50.00 m ² | |

| 点名 | X座標 | Y座標 | 辺長 | 方向角 | 測角 | DX | 倍積 (Y×DX) |
|--------|-----------|------------|--------|-----------|----------|---------|-----------------|
| 85-33 | 41477.712 | -67469.562 | 17.826 | 182-49-35 | 90-00-25 | -17.666 | 1191917.282292 |
| 85-23 | 41459.908 | -67470.441 | 2.805 | 92-52-54 | 90-03-19 | -17.945 | 1210757.063745 |
| 85-109 | 41459.767 | -67467.640 | 17.829 | 2-49-45 | 89-56-51 | 17.666 | -1191883.328240 |
| 85-110 | 41477.574 | -67466.760 | 2.805 | 272-49-10 | 89-59-25 | 17.945 | -1210691.008200 |
| | | | | | | | |
| | | | | | | | |
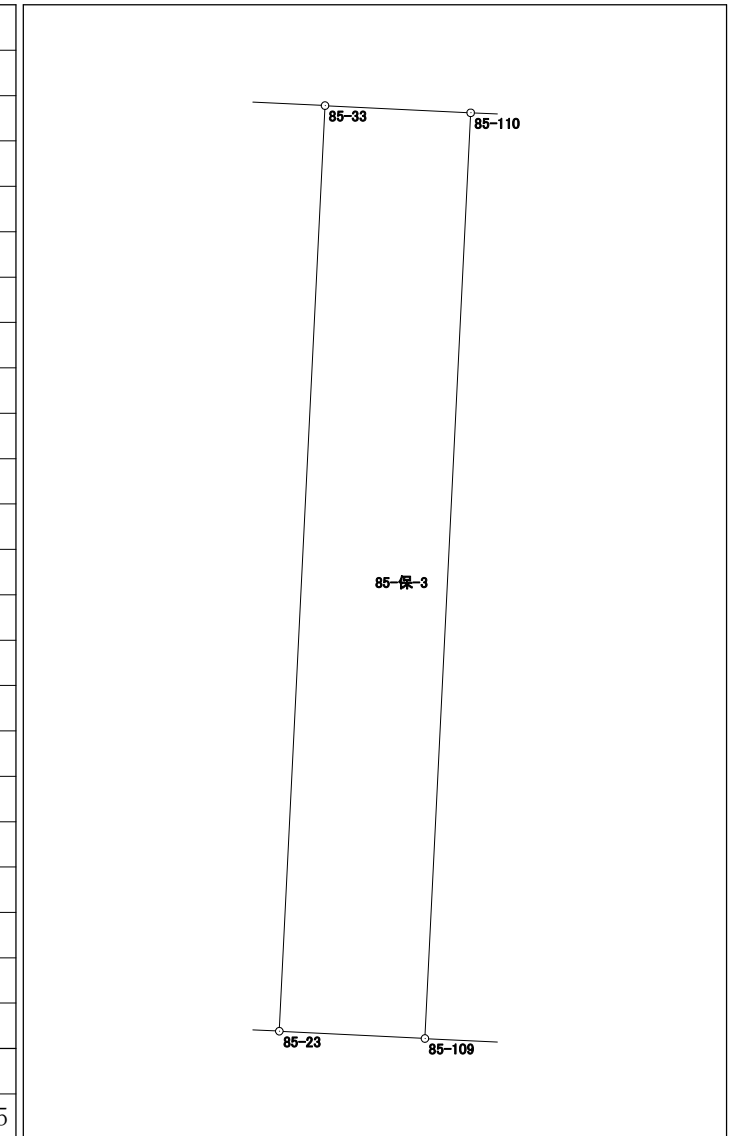


| | |
|-----|------------|
| 倍面積 | 100.009597 |
| 面積 | 50.0047985 |

面積計算書（座標法）

世界測地系（測地成果2011）

| | | | | | |
|------------|--------|------|------|----------------------|-----|
| 所在 | 地番 | 公簿地目 | 現況地目 | 地積 | 所有者 |
| 前橋市天川原町一丁目 | 85-保-4 | | | 50.00 m ² | |

| 点名 | X座標 | Y座標 | 辺長 | 方向角 | 測角 | Dx | 倍積 (Y×Dx) |
|--------|-----------|------------|--------|-----------|----------|------------|-----------------|
| 85-23 | 41459.908 | -67470.441 | 17.826 | 2-49-35 | 89-59-11 | 17.665 | -1191865.340265 |
| 85-33 | 41477.712 | -67469.562 | 2.805 | 272-45-30 | 89-55-55 | 17.939 | -1210336.472718 |
| 85-111 | 41477.847 | -67472.364 | 17.822 | 182-49-38 | 90-04-08 | -17.665 | 1191899.310060 |
| 85-112 | 41460.047 | -67473.243 | 2.805 | 92-50-24 | 90-00-46 | -17.939 | 1210402.506177 |
| | | | | | | | |
| | | | | | | | |
| 倍面積 | | | | | | 100.003254 | |
| 面積 | | | | | | 50.0016270 | |

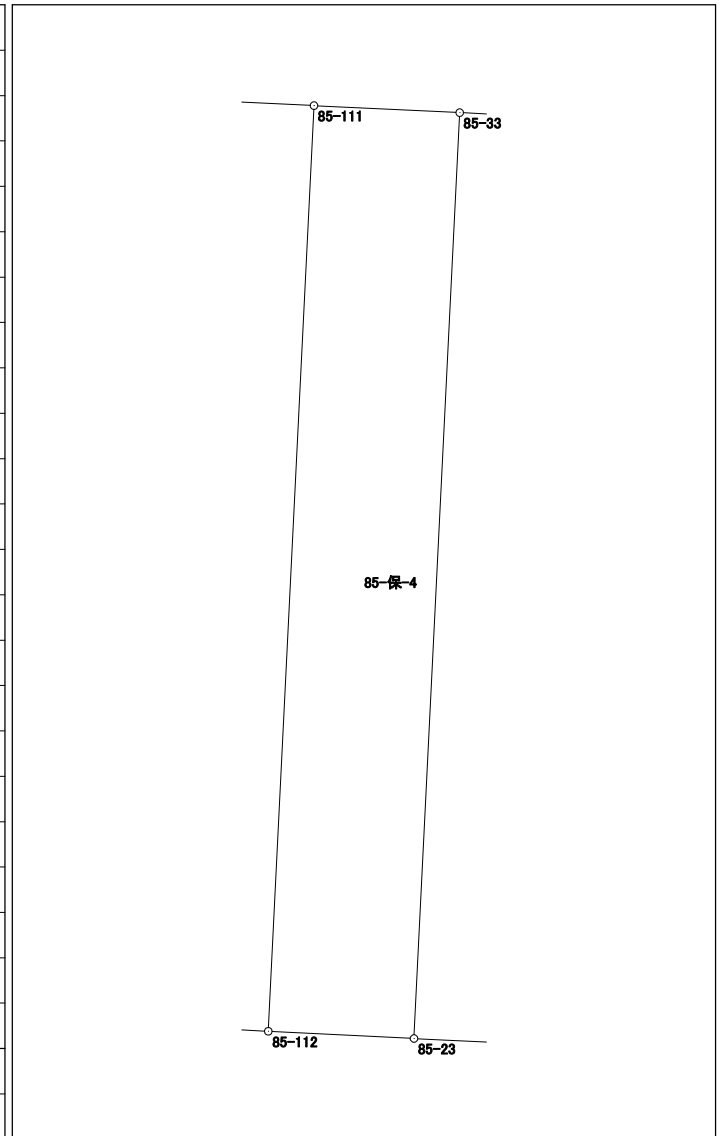


面積計算書（座標法）

世界測地系（測地成果2011）

| | | | | | |
|------------|--------|------|------|----------------------|-------|
| 所 在 | 地 番 | 公簿地目 | 現況地目 | 地 積 | 所 有 者 |
| 前橋市天川原町一丁目 | 85-保-5 | | | 63.00 m ² | |

| 点 名 | X 座標 | Y 座標 | 辺 長 | 方 向 角 | 測 角 | DX | 倍 積 (Y×DX) |
|--------|-----------|------------|--------|-----------|----------|---------|-----------------|
| 85-19 | 41500.291 | -67477.768 | 22.159 | 182-51-11 | 90-00-39 | -21.991 | 1483903.596088 |
| 85-32 | 41478.159 | -67478.871 | 2.843 | 92-44-30 | 89-53-19 | -22.268 | 1502619.499428 |
| 85-107 | 41478.023 | -67476.031 | 22.154 | 2-51-14 | 90-06-44 | 21.991 | -1483865.397721 |
| 85-108 | 41500.150 | -67474.928 | 2.843 | 272-50-32 | 89-59-18 | 22.268 | -1502531.696704 |
| | | | | | | | |
| | | | | | | | |
| | | | | | | 倍面積 | 126.001091 |
| | | | | | | 面 積 | 63.0005455 |

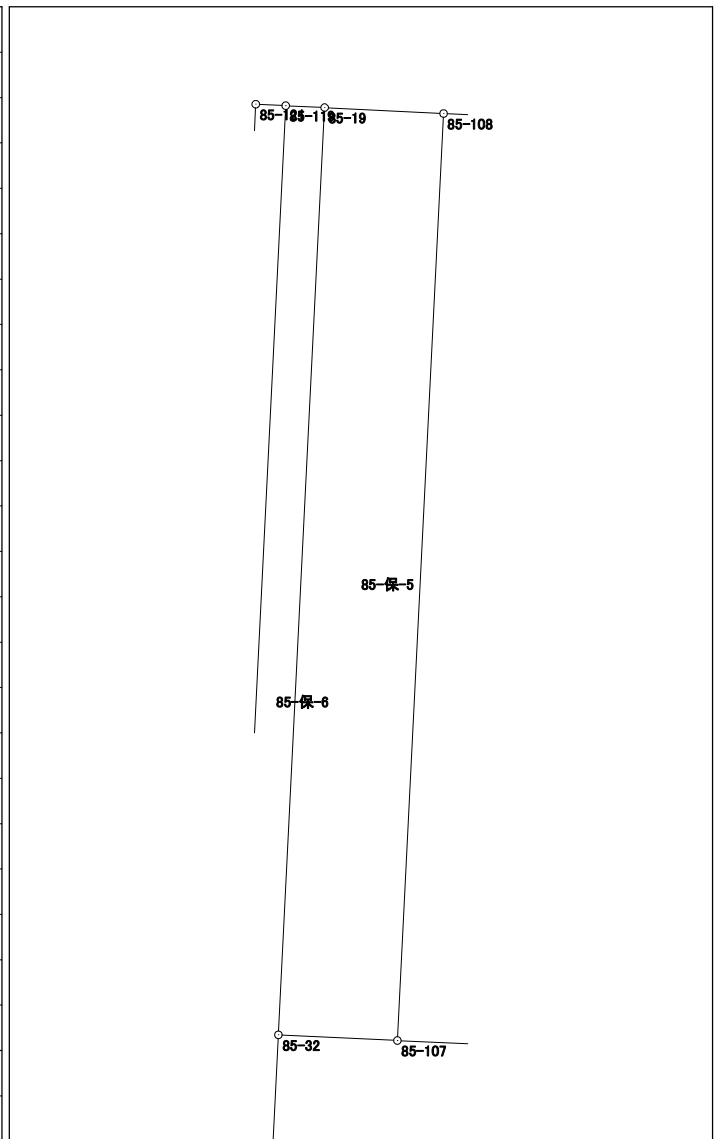


面積計算書（座標法）

世界測地系（測地成果2011）

| 所 在 | 地 番 | 公簿地目 | 現況地目 | 地 積 | 所 有 者 |
|------------|--------|------|------|----------------------|-------|
| 前橋市天川原町一丁目 | 85-保-6 | | | 26.00 m ² | |

| 点 名 | X 座標 | Y 座標 | 辺 長 | 方 向 角 | 測 角 | DX | 倍 積 (Y×DX) |
|--------|-----------|------------|--------|-----------|-----------|---------|-----------------|
| 85-32 | 41478.159 | -67478.871 | 22.159 | 2-51-11 | 179-58-58 | 27.916 | -1883740.162836 |
| 85-19 | 41500.291 | -67477.768 | 0.930 | 272-50-05 | 89-58-54 | 22.178 | -1496521.938704 |
| 85-119 | 41500.337 | -67478.697 | 27.951 | 182-51-17 | 90-01-12 | -27.870 | 1880631.285390 |
| 85-120 | 41472.421 | -67480.089 | 0.929 | 92-50-16 | 89-58-59 | -27.962 | 1886878.248618 |
| 85-31 | 41472.375 | -67479.161 | 5.791 | 2-52-13 | 90-01-57 | 5.738 | -387195.425818 |
| | | | | | | | |
| | | | | | | | |
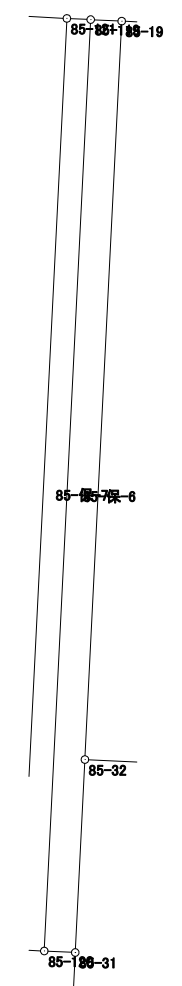


| | |
|-----|------------|
| 倍面積 | 52.006650 |
| 面 積 | 26.0033250 |

面積計算書（座標法）

世界測地系（測地成果2011）

| | | | | | |
|------------|--------|------|------|----------------------|-----|
| 所在 | 地番 | 公簿地目 | 現況地目 | 地積 | 所有者 |
| 前橋市天川原町一丁目 | 85-保-7 | | | 20.00 m ² | |

| 点名 | X座標 | Y座標 | 辺長 | 方向角 | 測角 | DX | 倍積 (Y×DX) |
|--------|-----------|------------|--------|-----------|----------|---------|-----------------|
| 85-120 | 41472.421 | -67480.089 | 27.951 | 2-51-17 | 90-03-08 | 27.881 | -1881412.361409 |
| 85-119 | 41500.337 | -67478.697 | 0.716 | 272-48-09 | 89-56-52 | 27.951 | -1886097.059847 |
| 85-121 | 41500.372 | -67479.412 | 27.951 | 182-51-17 | 90-03-08 | -27.881 | 1881393.485972 |
| 85-122 | 41472.456 | -67480.804 | 0.716 | 92-48-09 | 89-56-52 | -27.951 | 1886155.952604 |
| | | | | | | | |
| | | | | | | | |
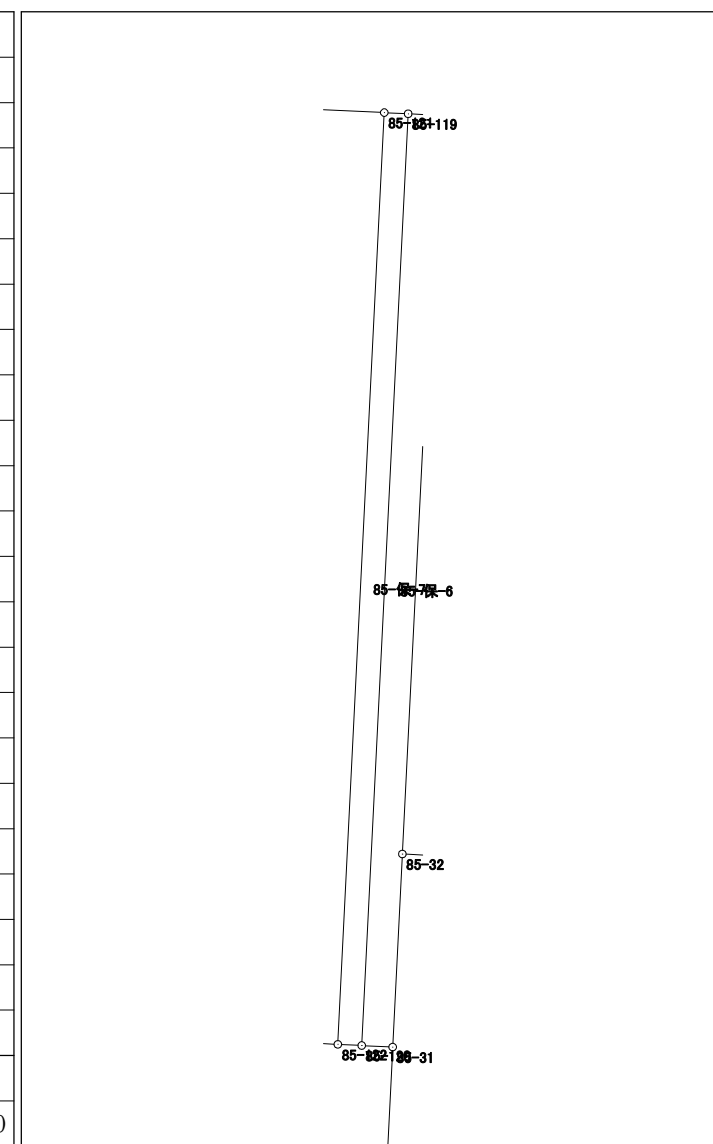


| | |
|-----|------------|
| 倍面積 | 40.017320 |
| 面積 | 20.0086600 |

面積計算書 (座標法)

世界測地系 (測地成果2011)

| 所在 | 地番 | 公簿地目 | 現況地目 | 地積 | 所有者 |
|------------|--------|------|------|----------------------|-----|
| 前橋市天川原町一丁目 | 85-保-9 | | | 63.00 m ² | |

| 点名 | X座標 | Y座標 | 辺長 | 方向角 | 測角 | DX | 倍積 (Y×DX) |
|--------|-----------|------------|--------|-----------|----------|---------|----------------|
| 85-25 | 41461.266 | -67497.944 | 12.023 | 2-53-21 | 90-00-41 | 11.745 | -792763.352280 |
| 85-30 | 41473.274 | -67497.338 | 5.239 | 272-56-36 | 90-03-15 | 12.277 | -828664.818626 |
| 85-115 | 41473.543 | -67502.570 | 12.029 | 182-53-15 | 89-56-39 | -11.745 | 792817.684650 |
| 85-116 | 41461.529 | -67503.176 | 5.239 | 92-52-40 | 89-59-25 | -12.277 | 828736.491752 |
| | | | | | | | |
| | | | | | | | |
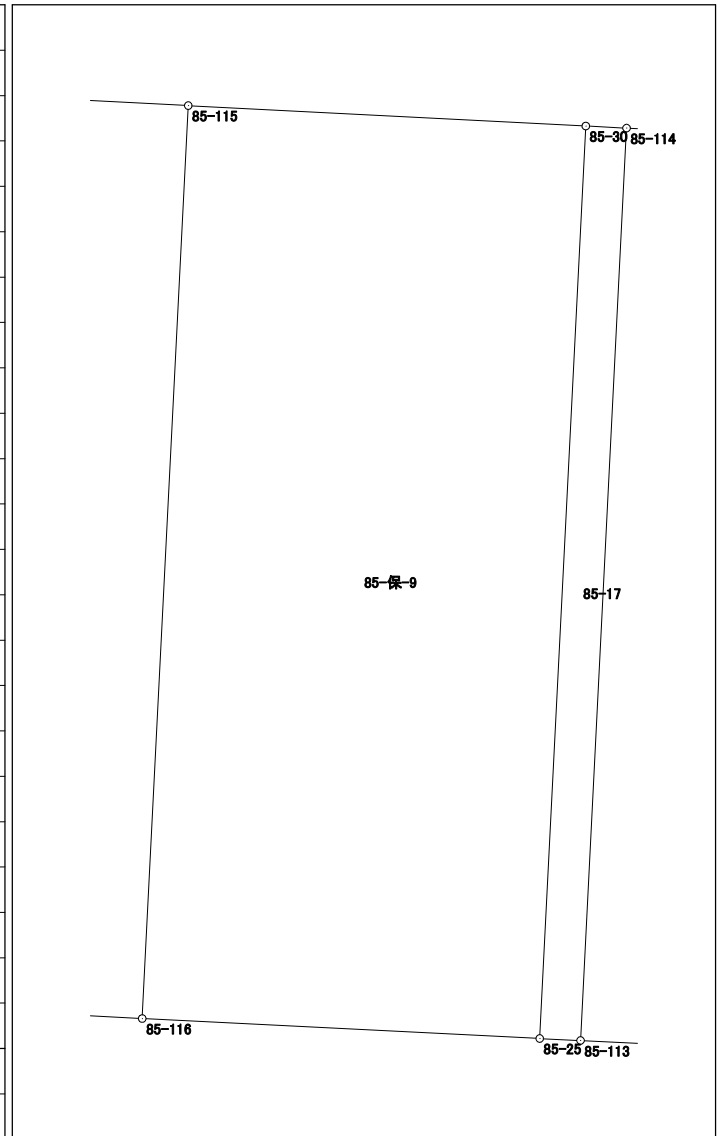

| | |
|-----|------------|
| 倍面積 | 126.005496 |
| 面積 | 63.0027480 |

