


# 9 2 街区 画地出来形確認図 (3930.90m<sup>2</sup>)



S=1/500

⊕ 4-309

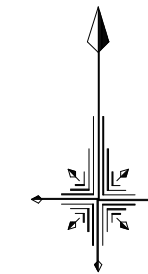

⊕ 4-310




# 面積計算書（座標法）

世界測地系（測地成果2011）

所 在	地 番	公簿地目	現況地目	地 積	所 有 者
前橋市六供町四丁目	92-2			146.46 m <sup>2</sup>	

点 名	X 座標	Y 座標	辺 長	方 向 角	測 角	DX	倍 積 (Y×DX)
92-43	41342.958	-67370.996	9.648	2-55-02	93-37-42	9.715	-654509.226140
92-44	41352.593	-67370.505	13.138	3-01-40	180-06-38	22.755	-1533015.841275
92-28	41365.713	-67369.811	6.446	269-17-52	86-16-12	13.041	-878569.705251
92-107	41365.634	-67376.257	22.787	182-58-51	93-40-59	-22.835	1538536.828595
92-108	41342.878	-67377.442	6.446	89-17-20	86-18-29	-22.676	1527850.874792
						倍面積	292.930721
						面 積	146.4653605

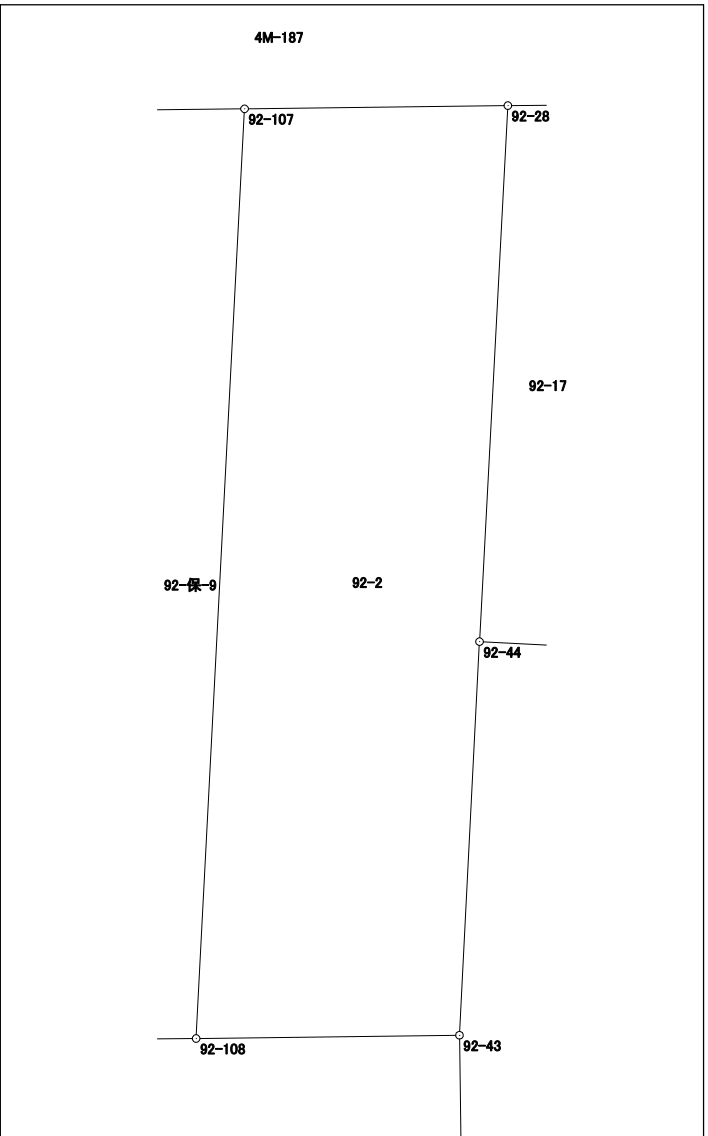


# 面積計算書（座標法）

世界測地系（測地成果2011）

所 在	地 番	公簿地目	現況地目	地 積	所 有 者
前橋市六供町四丁目	92-3			113.19 m <sup>2</sup>	

点 名	X 座標	Y 座標	辺 長	方 向 角	測 角	DX	倍 積 (Y×DX)
92-112	41352.075	-67360.421	13.776	3-01-15	90-04-44	13.327	-897712.330667
92-111	41365.832	-67359.695	8.395	269-19-27	86-18-12	13.658	-919998.714310
92-113	41365.733	-67368.089	13.246	183-01-29	93-42-02	-13.327	897814.522103
92-114	41352.505	-67368.788	8.378	92-56-31	89-55-02	-13.658	920122.906504
倍面積							226.383630
面 積							113.1918150

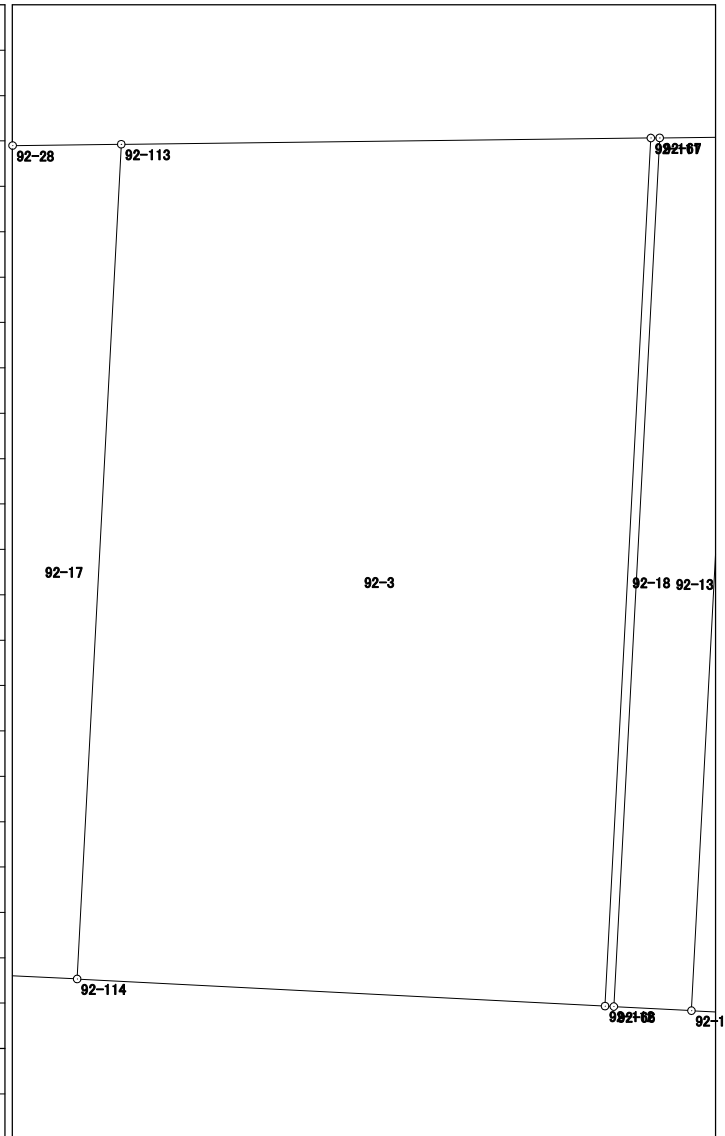


# 面積計算書 (座標法)

世界測地系 (測地成果2011)

所在	地番	公簿地目	現況地目	地積	所有者
前橋市六供町四丁目	92-6			96.72 m <sup>2</sup>	

点名	X座標	Y座標	辺長	方向角	測角	DX	倍積 (Y×DX)
92-128	41339.596	-67319.876	8.798	78-04-28	75-03-43	-14.713	990477.335588
92-90	41341.414	-67311.268	3.461	349-10-26	91-05-58	5.217	-351162.885156
B344	41344.813	-67311.918	11.263	341-26-05	172-15-39	14.076	-947482.557768
B343	41355.490	-67315.504	0.146	338-20-38	176-54-33	10.813	-727882.544752
92-95	41355.626	-67315.558	2.349	281-23-28	123-02-50	0.600	-40389.334800
92-51	41356.090	-67317.861	1.146	271-51-03	170-27-35	0.501	-33726.248361
92-129	41356.127	-67319.006	16.554	183-00-45	91-09-42	-16.494	1110359.684964
						倍面積	193.449715
						面積	96.7248575

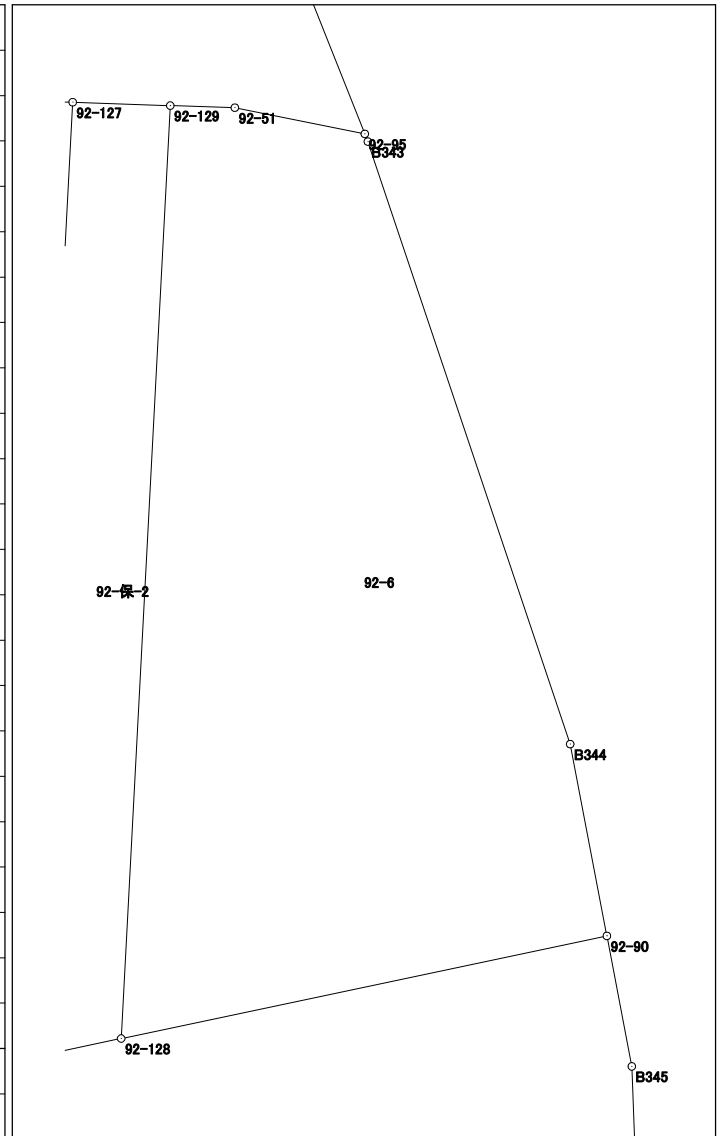




# 面積計算書（座標法）

世界測地系（測地成果2011）

所在	地番	公簿地目	現況地目	地積	所有者
前橋市六供町四丁目	92-8			407.86 m <sup>2</sup>	

点名	X座標	Y座標	辺長	方向角	測角	DX	倍積 (Y×DX)
92-68	41354.201	-67348.166	2.767	182-41-34	90-55-15	-2.393	161164.161238
92-45	41351.437	-67348.296	18.093	183-02-18	180-20-44	-20.832	1402999.702272
92-36	41333.369	-67349.255	23.360	78-01-19	74-59-01	-13.220	890357.151100
92-35	41338.217	-67326.404	15.297	2-58-58	104-57-39	20.124	-1354876.554096
92-69	41353.493	-67325.608	10.570	271-49-37	88-50-39	15.613	-1051154.717704
92-71	41353.830	-67336.173	11.999	271-46-19	179-56-42	0.708	-47674.010484
						倍面積	815.732326
						面積	407.8661630

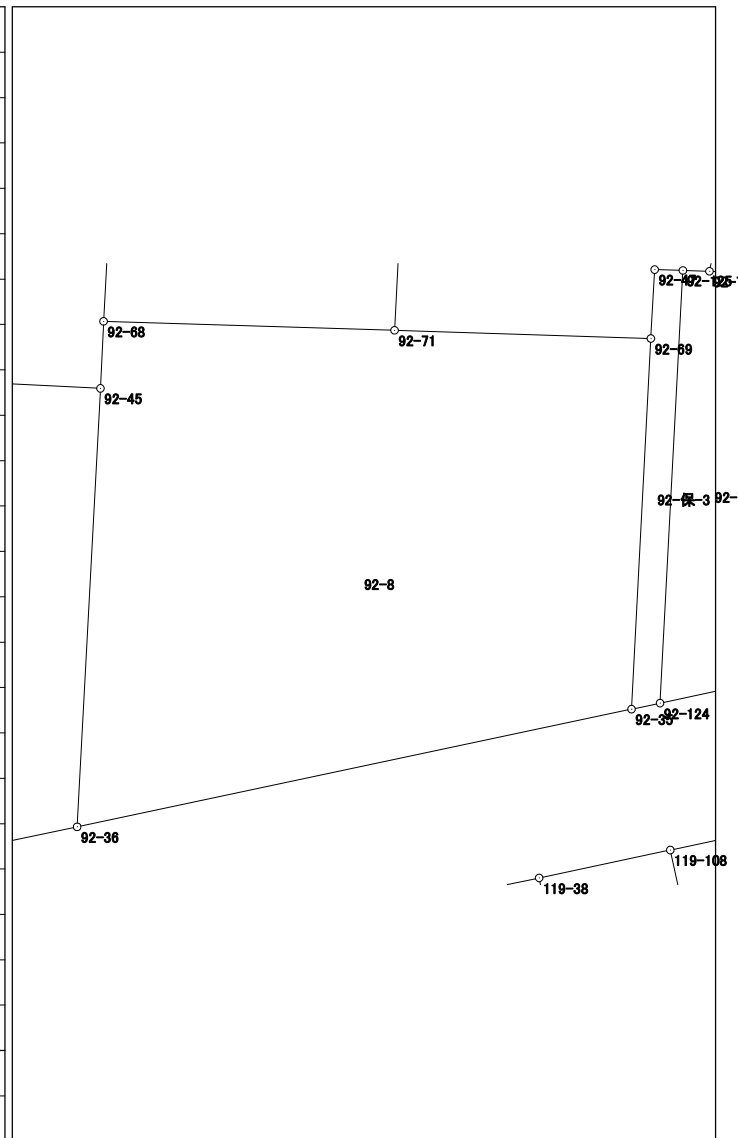






# 面積計算書 (座標法)

世界測地系 (測地成果2011)

所在	地番	公簿地目	現況地目	地積	所有者
前橋市六供町四丁目	92-9-2			193.90 m <sup>2</sup>	

点名	X座標	Y座標	辺長	方向角	測角	DX	倍積 (Y×DX)
92-43	41342.958	-67370.996	6.446	269-17-20	90-03-57	14.080	-948583.623680
92-108	41342.878	-67377.442	2.771	269-17-49	180-00-29	-0.114	7681.028388
92-110	41342.844	-67380.213	3.346	269-16-51	179-59-02	-0.076	5120.896188
92-41	41342.802	-67383.559	16.669	179-19-59	90-03-08	-16.710	1125979.270890
92-37	41326.134	-67383.365	12.840	78-01-33	78-41-34	-14.004	943636.643460
92-115	41328.798	-67370.804	14.161	359-13-23	101-11-50	16.824	-1133446.406496

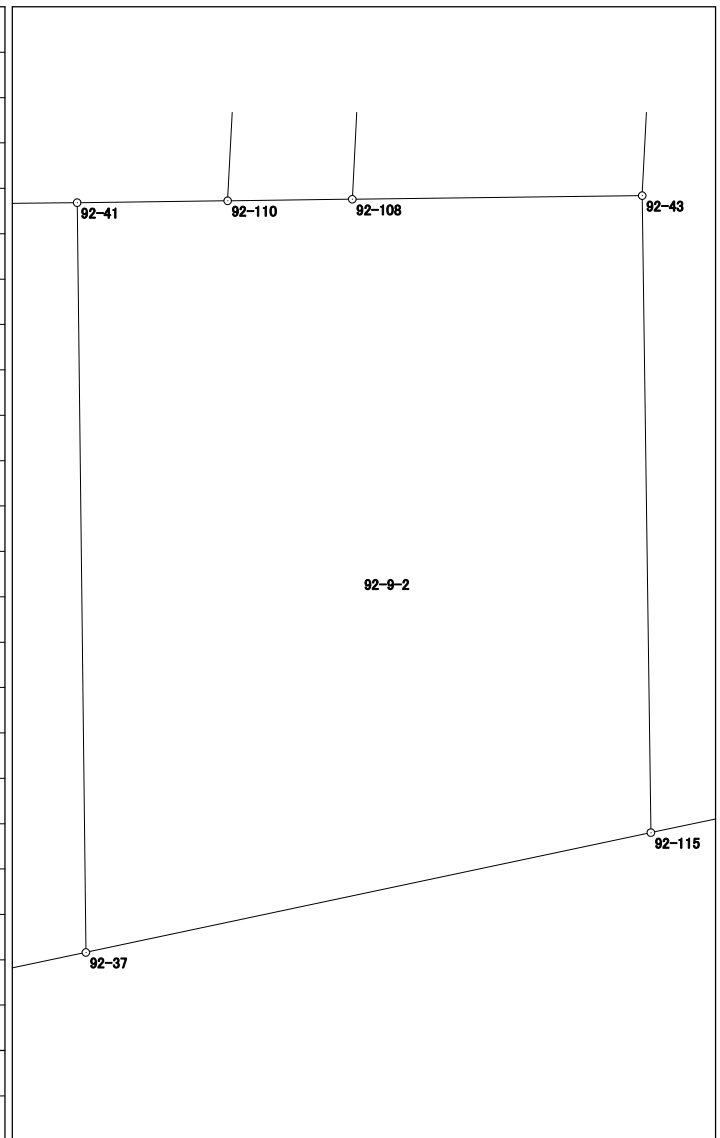


倍面積	387.808750
面積	193.9043750

# 面積計算書 (座標法)

世界測地系 (測地成果2011)

所在	地番	公簿地目	現況地目	地積	所有者
前橋市六供町四丁目	92-10			174.27 m <sup>2</sup>	

点名	X座標	Y座標	辺長	方向角	測角	DX	倍積 (Y×DX)
92-105	41324.053	-67393.216	10.068	78-04-18	78-43-47	-16.552	1115492.511232
92-37	41326.134	-67383.365	16.669	359-19-59	101-15-41	18.749	-1263370.710385
92-41	41342.802	-67383.559	9.872	269-19-36	89-59-37	16.552	-1115332.668568
92-106	41342.686	-67393.430	18.634	179-20-31	90-00-55	-18.749	1263559.419070
						倍面積	348.551349
						面積	174.2756745

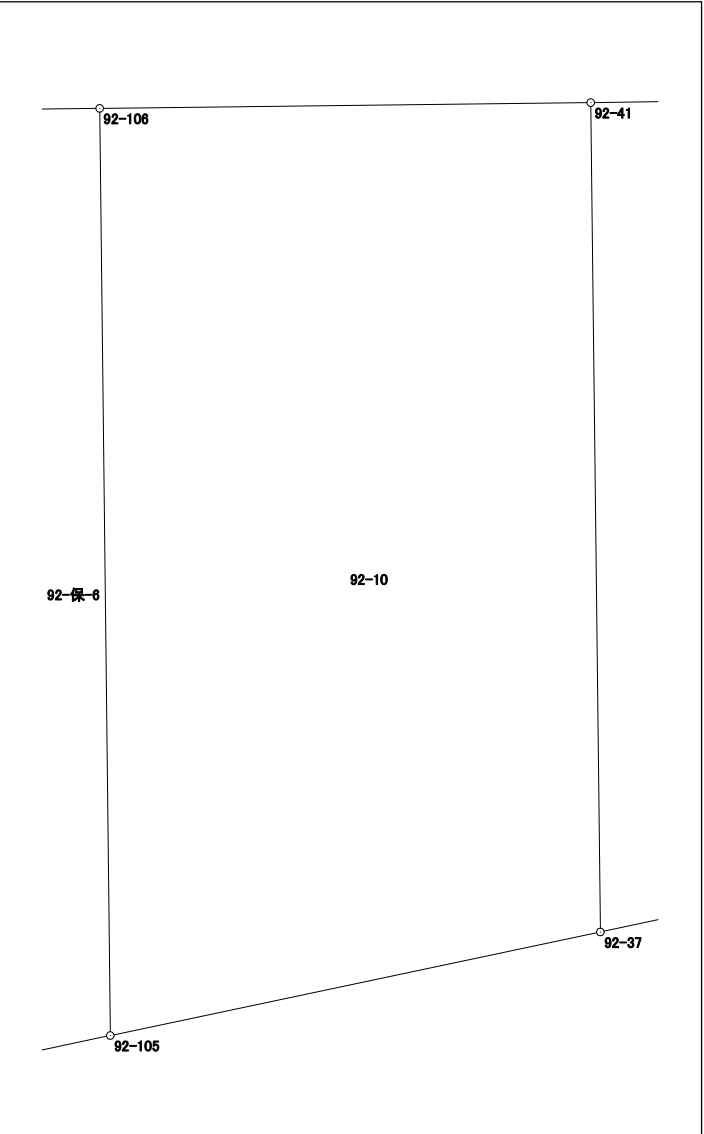


# 面積計算書（座標法）

世界測地系（測地成果2011）

所 在	地 番	公簿地目	現況地目	地 積	所 有 者
前橋市六供町四丁目	92-11-1			84.85 m <sup>2</sup>	

点 名	X 座標	Y 座標	辺 長	方 向 角	測 角	DX	倍 積 (Y×DX)
92-101	41342.612	-67399.812	4.176	269-19-40	89-58-52	19.855	-1338223.267260
92-135	41342.563	-67403.988	20.735	179-20-42	90-01-02	-20.783	1400857.082604
92-136	41321.829	-67403.751	4.258	78-05-09	78-44-27	-19.855	1338301.476105
92-102	41322.708	-67399.585	19.905	359-20-48	101-15-39	20.783	-1400765.575055
						倍面積	169.716394
						面 積	84.8581970

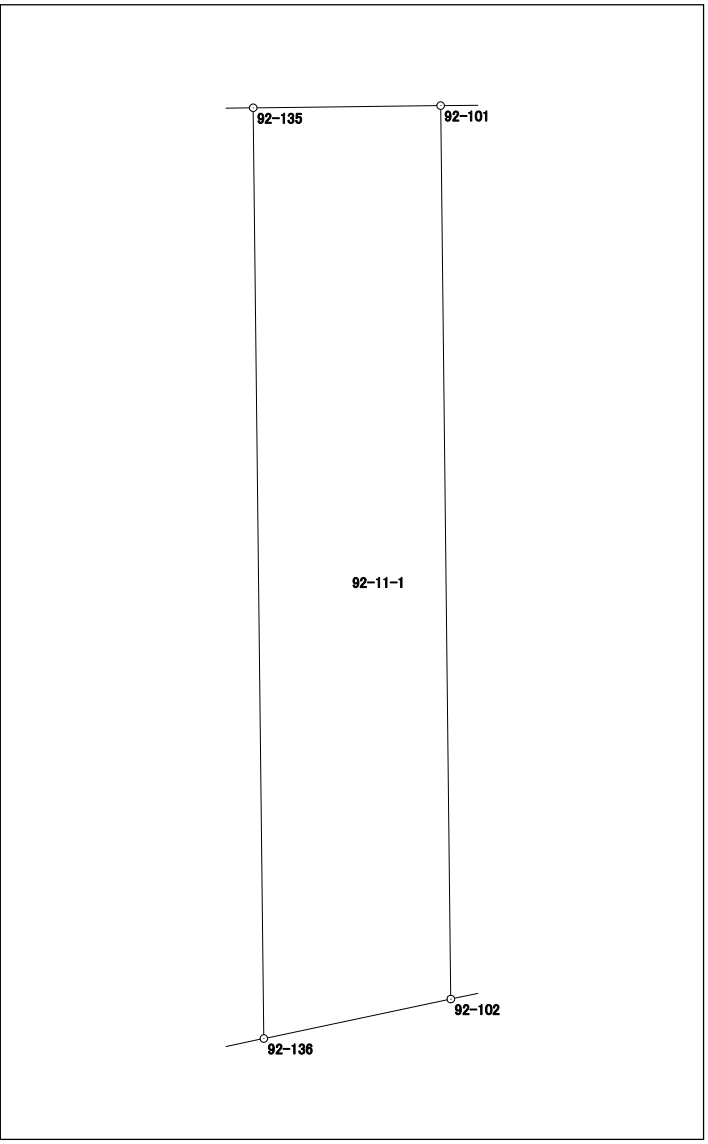


# 面積計算書（座標法）

世界測地系（測地成果2011）

所在	地番	公簿地目	現況地目	地積	所有者
前橋市六供町四丁目	92-11-2			161.99 m <sup>2</sup>	

点名	X座標	Y座標	辺長	方向角	測角	DX	倍積 (Y×DX)
92-39	41342.448	-67413.759	19.393	168-49-34	79-30-02	-19.140	1290299.347260
92-14	41323.423	-67410.001	4.012	123-21-26	134-31-52	-21.231	1431181.731231
92-8	41321.217	-67406.650	2.963	78-04-46	134-43-20	-1.594	107446.200100
92-136	41321.829	-67403.751	20.735	359-20-42	101-15-56	21.346	-1438800.468846
92-135	41342.563	-67403.988	9.772	269-19-32	89-58-50	20.619	-1389802.828572
						倍面積	323.981173
						面積	161.9905865

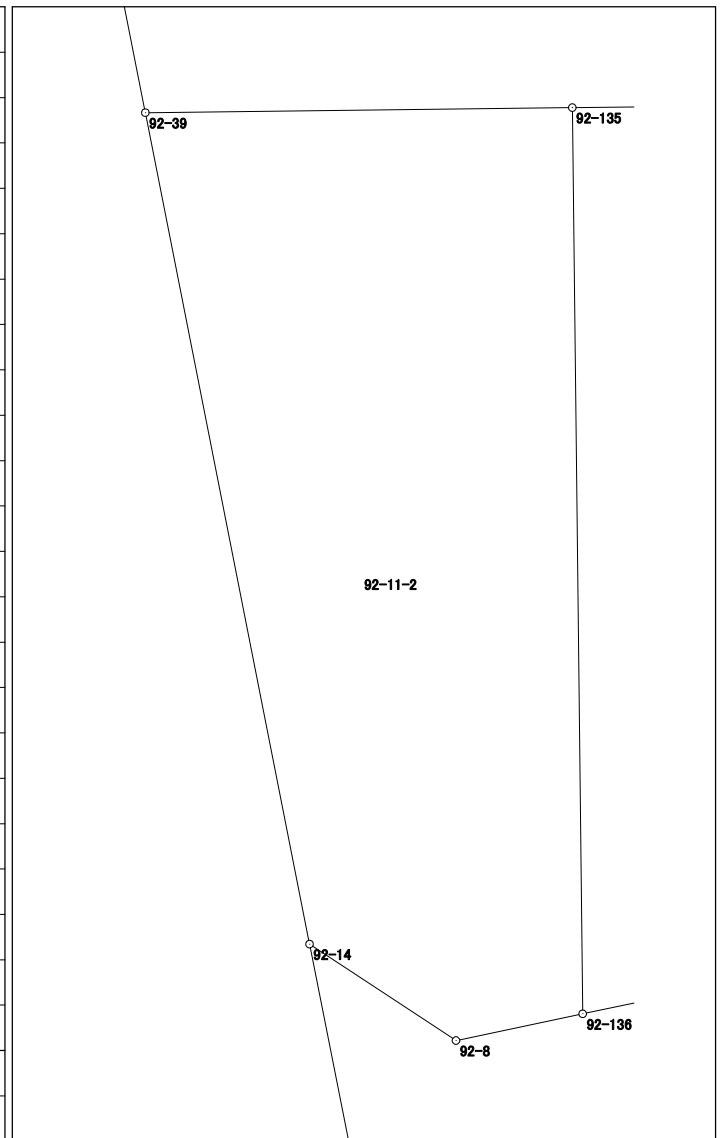


# 面積計算書（座標法）

世界測地系（測地成果2011）

所在	地番	公簿地目	現況地目	地積	所有者
前橋市六供町四丁目	92-13			17.04 m <sup>2</sup>	

点名	X座標	Y座標	辺長	方向角	測角	DX	倍積 (Y×DX)
92-67	41365.834	-67359.555	13.785	183-01-23	93-40-19	-13.780	928214.667900
92-66	41352.068	-67360.282	1.233	93-01-21	89-59-58	-13.831	931660.060342
92-116	41352.003	-67359.051	13.864	3-01-35	90-00-14	13.780	-928207.722780
92-117	41365.848	-67358.319	1.236	269-21-04	86-19-29	13.831	-931632.910089
						倍面積	34.095373
						面積	17.0476865

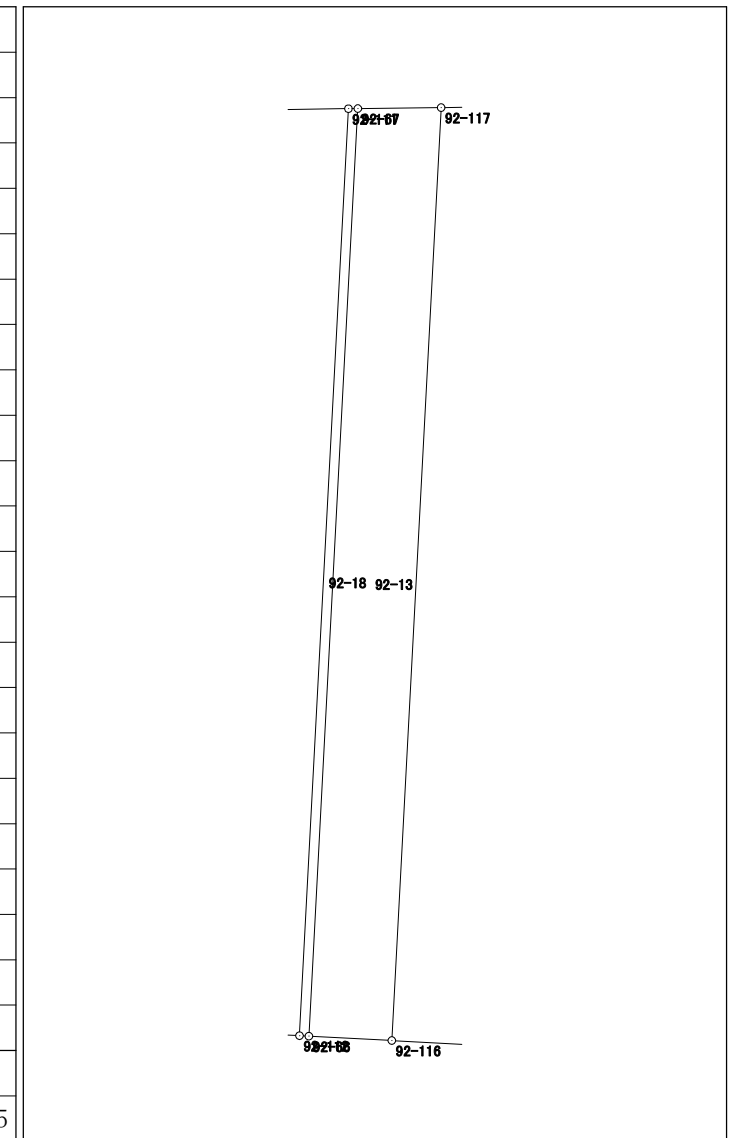


# 面積計算書 (座標法)

世界測地系 (測地成果2011)

所在	地番	公簿地目	現況地目	地積	所有者
前橋市六供町四丁目	92-14			141.91 m <sup>2</sup>	

点名	X座標	Y座標	辺長	方向角	測角	DX	倍積 (Y×DX)
92-122	41393.913	-67331.984	5.588	272-53-33	89-55-07	17.702	-1191910.780768
92-5	41394.195	-67337.565	3.963	228-02-54	135-09-21	-2.367	159388.016355
92-4	41391.546	-67340.512	14.512	182-58-28	134-55-34	-17.141	1154283.716192
92-55	41377.054	-67341.265	8.395	93-49-54	90-51-26	-15.053	1013688.062045
92-123	41376.493	-67332.889	17.443	2-58-26	89-08-32	16.859	-1135165.175651

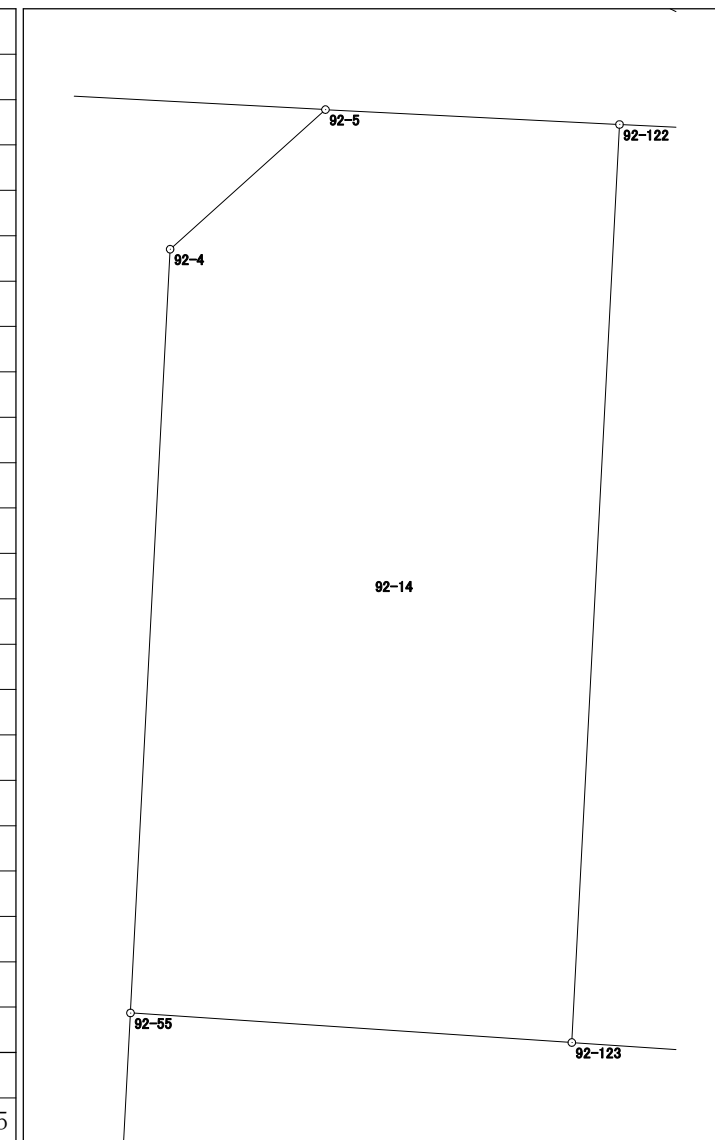


倍面積	283.838173
面積	141.9190865

# 面積計算書 (座標法)

世界測地系 (測地成果2011)

所在	地番	公簿地目	現況地目	地積	所有者
前橋市六供町四丁目	92-15			47.91 m <sup>2</sup>	

点名	X座標	Y座標	辺長	方向角	測角	DX	倍積 (Y×DX)
92-77	41375.869	-67323.569	1.379	338-25-21	64-35-32	0.888	-59783.329272
B342	41377.151	-67324.076	16.342	343-57-30	185-32-09	16.988	-1143701.403088
92-120	41392.857	-67328.592	16.616	182-58-25	19-00-55	-0.888	59787.789696
92-121	41376.263	-67329.454	5.898	93-49-49	90-51-24	-16.988	1143792.764552
						倍面積	95.821888
						面積	47.9109440

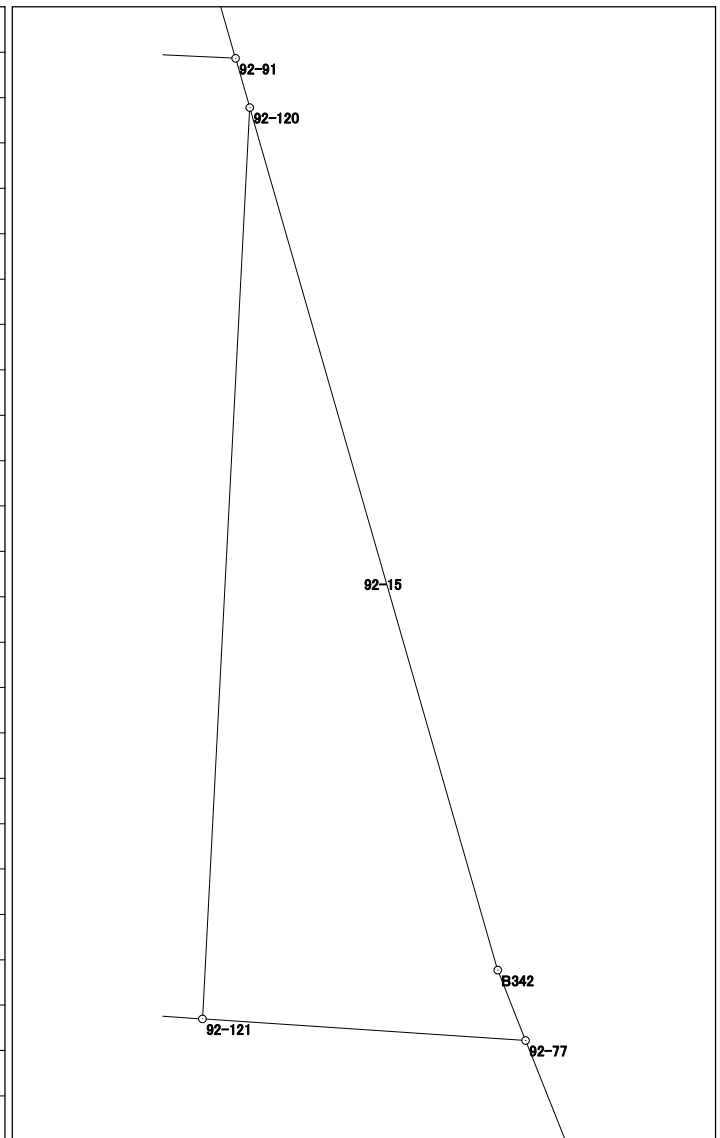


## 面積計算書 (座標法)

世界測地系 (測地成果2011)

所 在	地 番	公簿地目	現況地目	地 積	所 有 者
前橋市六供町四丁目	92-16			104.78 m <sup>2</sup>	

点 名	X 座標	Y 座標	辺 長	方 向 角	測 角	DX	倍 積 (Y×DX)
92-118	41351.822	-67355.621	7.335	93-00-31	89-58-51	-14.451	973356.079071
92-45	41351.437	-67348.296	2.767	2-41-34	89-41-03	2.379	-160221.596184
92-68	41354.201	-67348.166	11.788	2-59-26	180-17-52	14.536	-978972.940976
92-29	41365.973	-67347.551	7.326	269-20-07	86-20-41	11.687	-787090.828537
92-119	41365.888	-67354.877	14.086	183-01-40	93-41-33	-14.151	953138.864427

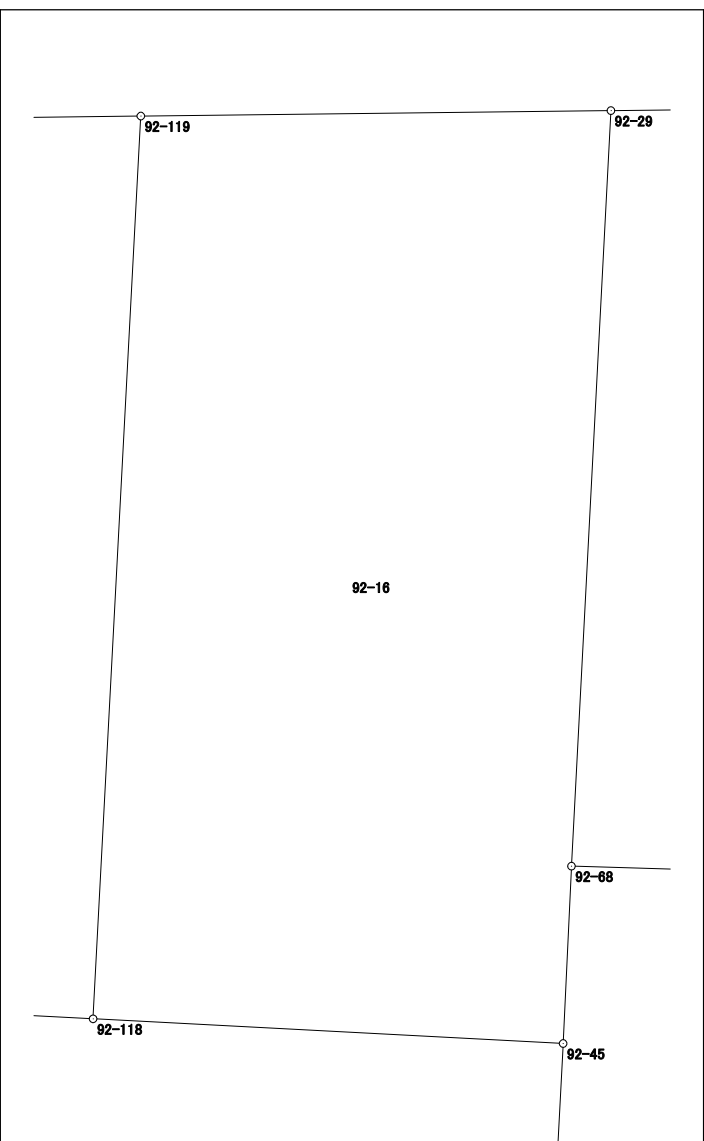

倍面積	209.577801
面積	104.7889005




# 面積計算書 (座標法)

世界測地系 (測地成果2011)

所在	地番	公簿地目	現況地目	地積	所有者
前橋市六供町四丁目	92-17			22.67 m <sup>2</sup>	

点名	X座標	Y座標	辺長	方向角	測角	DX	倍積 (Y×DX)
92-113	41365.733	-67368.089	1.722	269-20-04	86-18-35	13.208	-889797.719512
92-28	41365.713	-67369.811	13.138	183-01-40	93-41-36	-13.140	885239.316540
92-44	41352.593	-67370.505	1.719	92-56-02	89-54-22	-13.208	889829.630040
92-114	41352.505	-67368.788	13.246	3-01-29	90-05-27	13.140	-885225.874320
倍面積							45.352748
面積							22.6763740

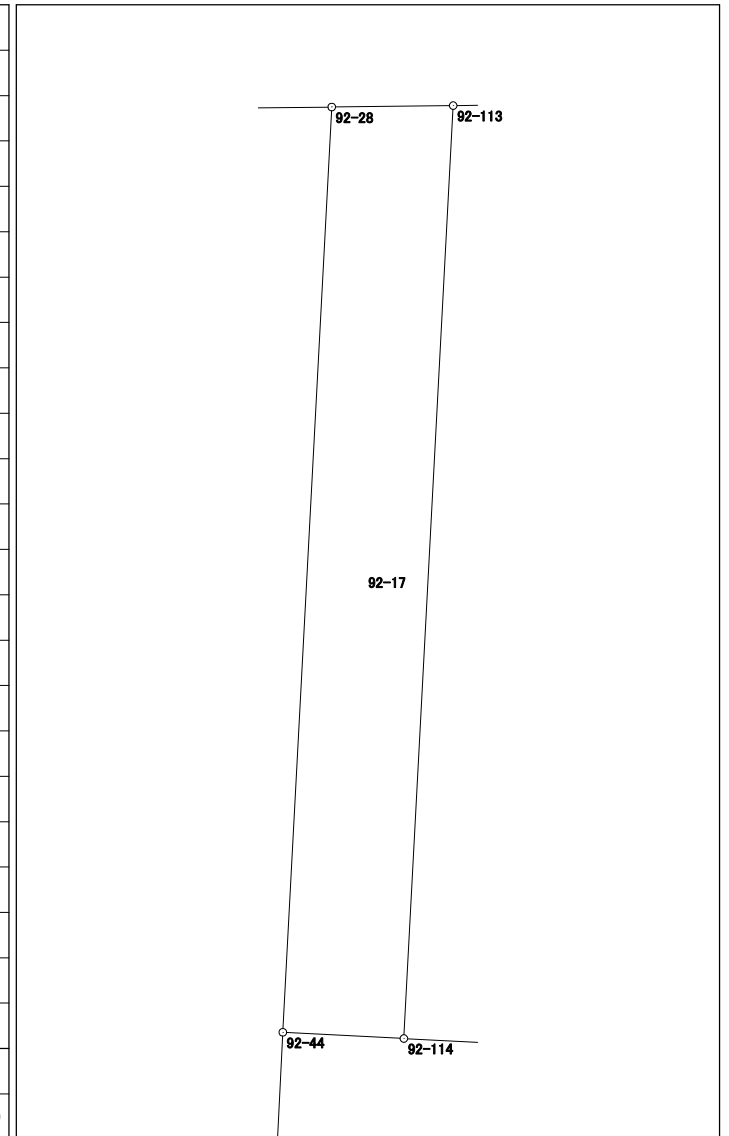


# 面積計算書（座標法）

世界測地系（測地成果2011）

所 在	地 番	公簿地目	現況地目	地 積	所 有 者
前橋市六供町四丁目	92-18			1.92 m <sup>2</sup>	

点 名	X 座標	Y 座標	辺 長	方 向 角	測 角	DX	倍 積 (Y×DX)
92-66	41352.068	-67360.282	13.785	3-01-23	90-08-24	13.759	-926810.120038
92-67	41365.834	-67359.555	0.140	269-10-54	86-09-31	13.764	-927136.915020
92-111	41365.832	-67359.695	13.776	183-01-15	93-50-21	-13.759	926802.043505
92-112	41352.075	-67360.421	0.139	92-52-59	89-51-44	-13.764	927148.834644
						倍面積	3.843091
						面 積	1.9215455

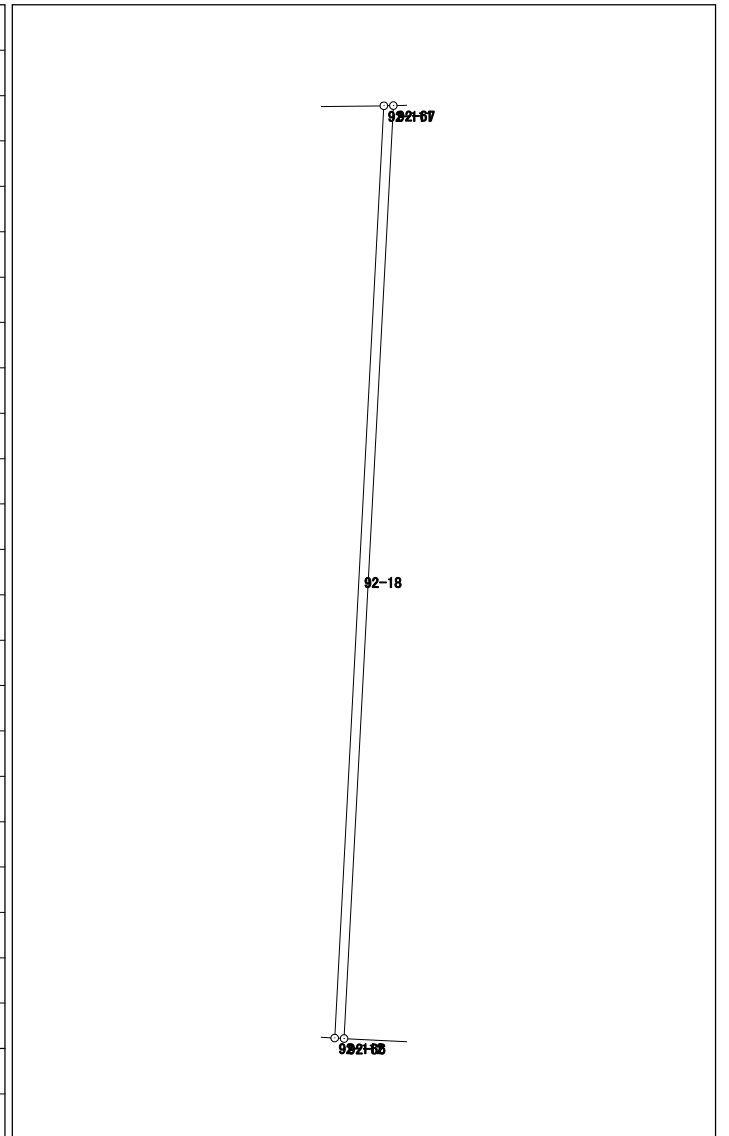


# 面積計算書 (座標法)

世界測地系 (測地成果2011)

所在	地番	公簿地目	現況地目	地積	所有者
前橋市六供町四丁目	92-19			168.43 m <sup>2</sup>	

点名	X座標	Y座標	辺長	方向角	測角	DX	倍積 (Y×DX)
92-29	41365.973	-67347.551	11.788	182-59-26	93-38-34	-11.837	797192.961187
92-68	41354.201	-67348.166	11.999	91-46-19	88-46-53	-12.143	817808.779738
92-71	41353.830	-67336.173	15.900	2-59-19	91-13-00	15.507	-1044182.034711
92-72	41369.708	-67335.344	6.297	273-04-37	90-05-18	16.216	-1091909.938304
92-70	41370.046	-67341.632	4.013	182-58-15	89-53-38	-3.670	247143.789440
92-3	41366.038	-67341.840	5.711	269-20-52	266-22-37	-4.073	274283.314320
						倍面積	336.871670
						面積	168.4358350

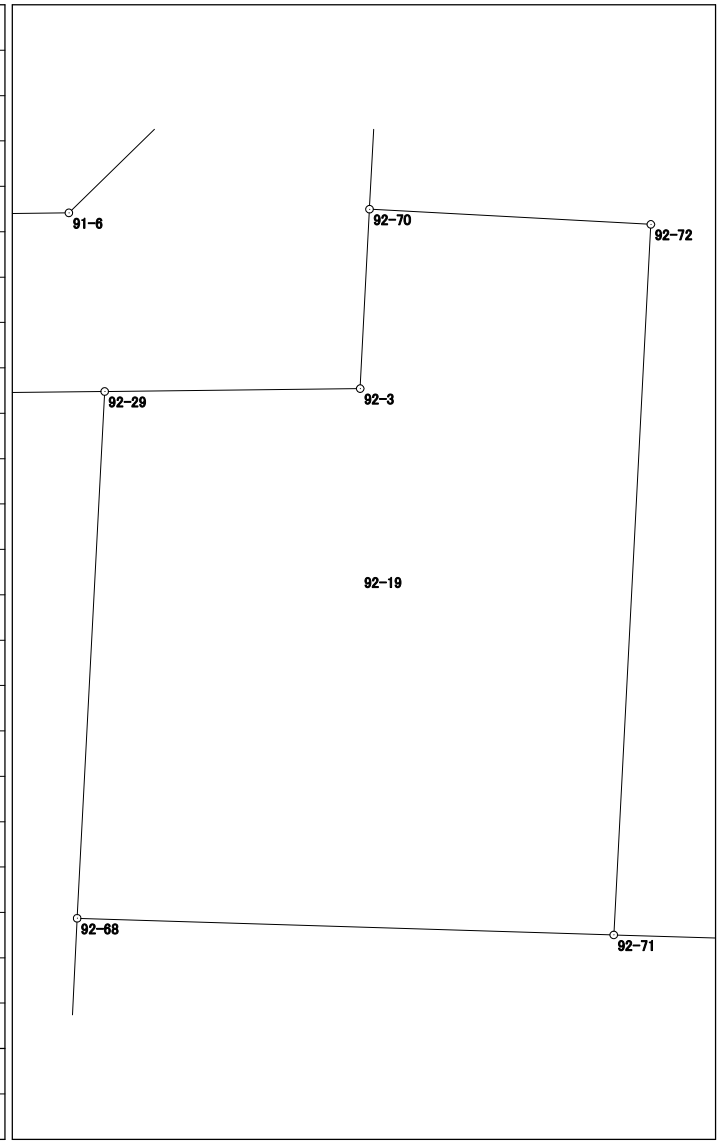


# 面積計算書 (座標法)

世界測地系 (測地成果2011)

所在	地番	公簿地目	現況地目	地積	所有者
前橋市六供町四丁目	92-保-1			47.04 m <sup>2</sup>	

点名	X座標	Y座標	辺長	方向角	測角	DX	倍積 (Y×DX)
92-79	41368.341	-67320.785	12.315	191-16-18	87-07-06	-12.019	809128.514915
92-73	41356.264	-67323.192	2.458	91-47-42	80-31-24	-12.154	818246.075568
92-127	41356.187	-67320.735	1.730	91-59-15	180-11-33	-0.137	9222.940695
92-129	41356.127	-67319.006	1.146	91-51-03	179-51-48	-0.097	6529.943582
92-51	41356.090	-67317.861	2.349	101-23-28	189-32-25	-0.501	33726.248361
92-95	41355.626	-67315.558	4.402	338-17-43	56-54-15	3.626	-244086.213308
92-92	41359.716	-67317.186	9.206	338-31-57	180-14-14	12.657	-852033.623202
92-93	41368.283	-67320.555	0.237	284-09-12	125-37-15	8.625	-580639.786875
						倍面積	94.099736
						面積	47.0498680

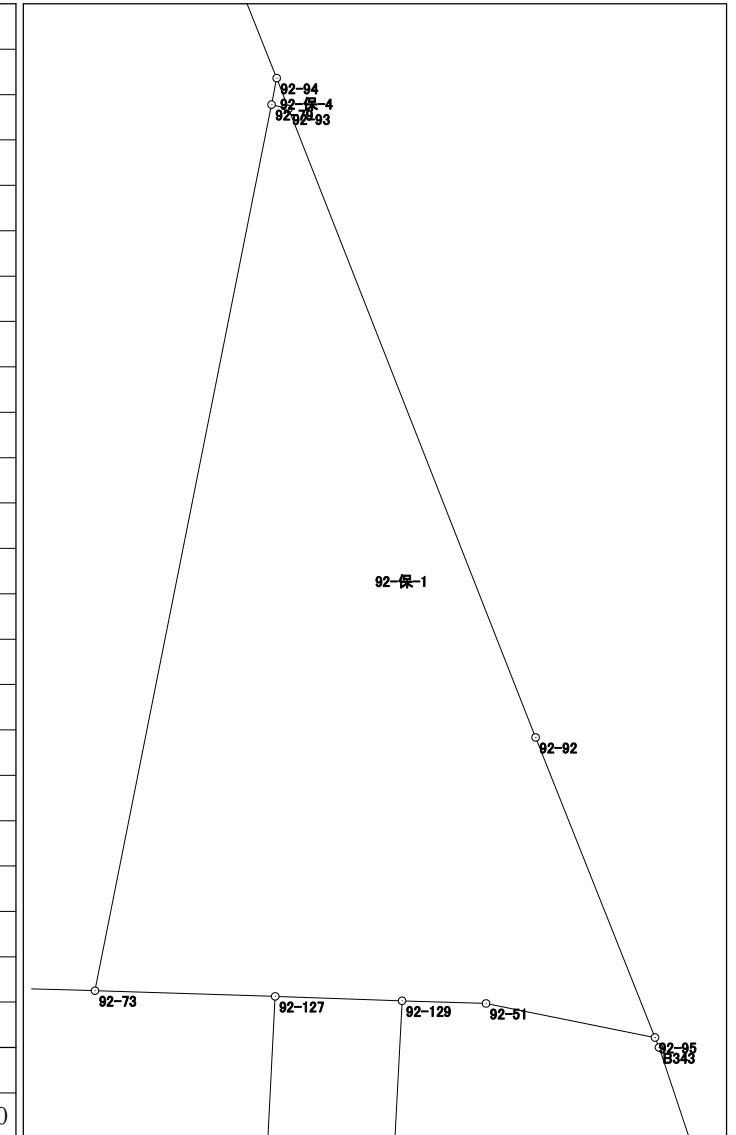


# 面積計算書 (座標法)

世界測地系 (測地成果2011)

所在	地番	公簿地目	現況地目	地積	所有者
前橋市六供町四丁目	92-保-2			29.00 m <sup>2</sup>	

点名	X座標	Y座標	辺長	方向角	測角	DX	倍積 (Y×DX)
92-127	41356.187	-67320.735	16.984	183-00-50	91-01-35	-16.901	1137787.742235
92-126	41339.226	-67321.628	1.791	78-04-30	75-03-40	-16.591	1116933.130148
92-128	41339.596	-67319.876	16.554	3-00-45	104-56-15	16.901	-1137773.224276
92-129	41356.127	-67319.006	1.730	271-59-15	88-58-30	16.591	-1116889.628546
						倍面積	58.019561
						面積	29.0097805

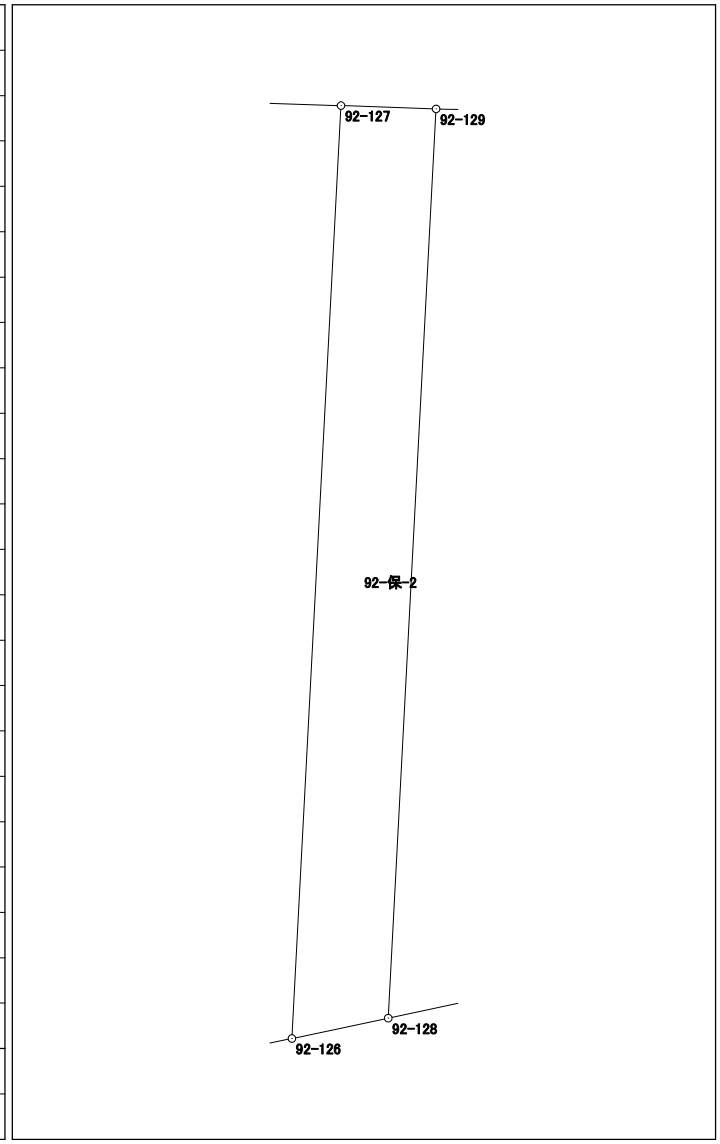


# 面積計算書（座標法）

世界測地系（測地成果2011）

所 在	地 番	公簿地目	現況地目	地 積	所 有 者
前橋市六供町四丁目	92-保-3			21.00 m <sup>2</sup>	


点 名	X 座標	Y 座標	辺 長	方 向 角	測 角	DX	倍 積 (Y×DX)
92-69	41353.493	-67325.608	15.297	182-58-58	179-47-50	-18.115	1219603.388920
92-35	41338.217	-67326.404	1.203	78-03-18	75-04-20	-15.027	1011713.872908
92-124	41338.466	-67325.227	17.856	3-01-04	104-57-46	18.080	-1217240.104160
92-125	41356.297	-67324.287	1.164	271-43-26	88-42-22	17.866	-1202815.711542
92-47	41356.332	-67325.450	2.843	183-11-08	91-27-42	-2.804	188780.561800
						倍面積	42.007926
						面 積	21.0039630

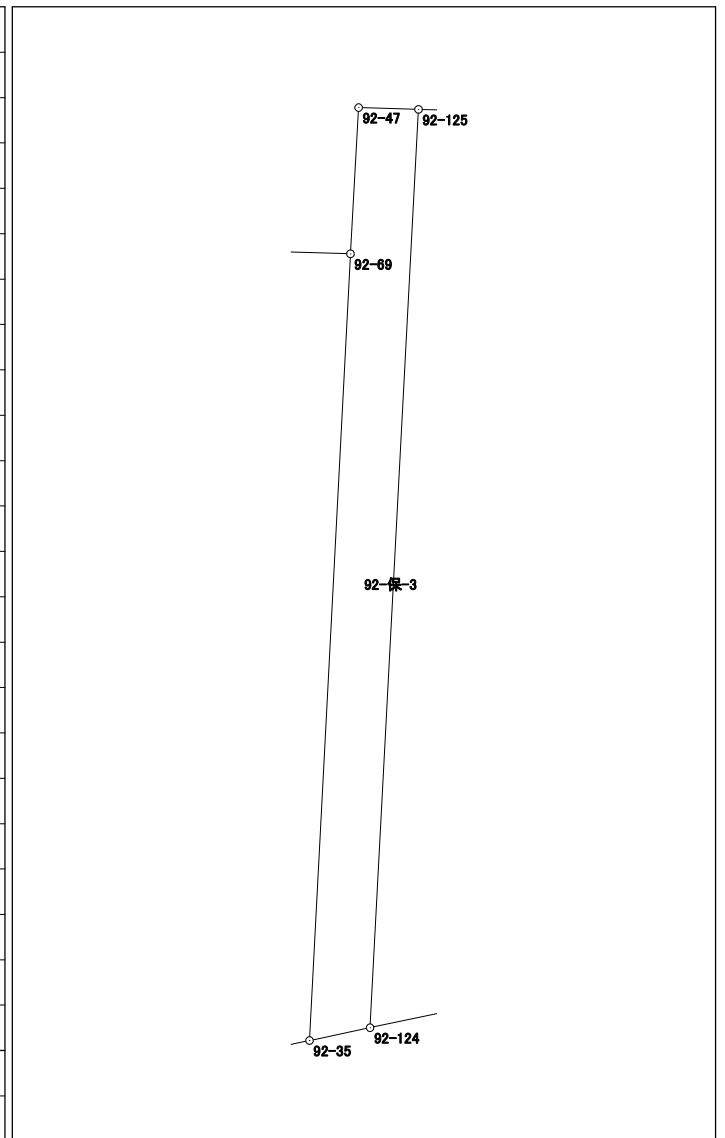

# 面積計算書（座標法）

所在	地番	公簿地目	現況地目	地積	所有者
前橋市六供町四丁目	92-保-4			0.04 m <sup>2</sup>	

点名	X座標	Y座標	辺長	方向角	測角	DX	倍積 (Y×DX)
92-94	41368.702	-67320.715	0.368	190-58-26	31-52-26	0.058	-3904.601470
92-79	41368.341	-67320.785	0.237	104-09-12	93-10-46	-0.419	28207.408915
92-93	41368.283	-67320.555	0.449	339-06-00	54-56-48	0.361	-24302.720355

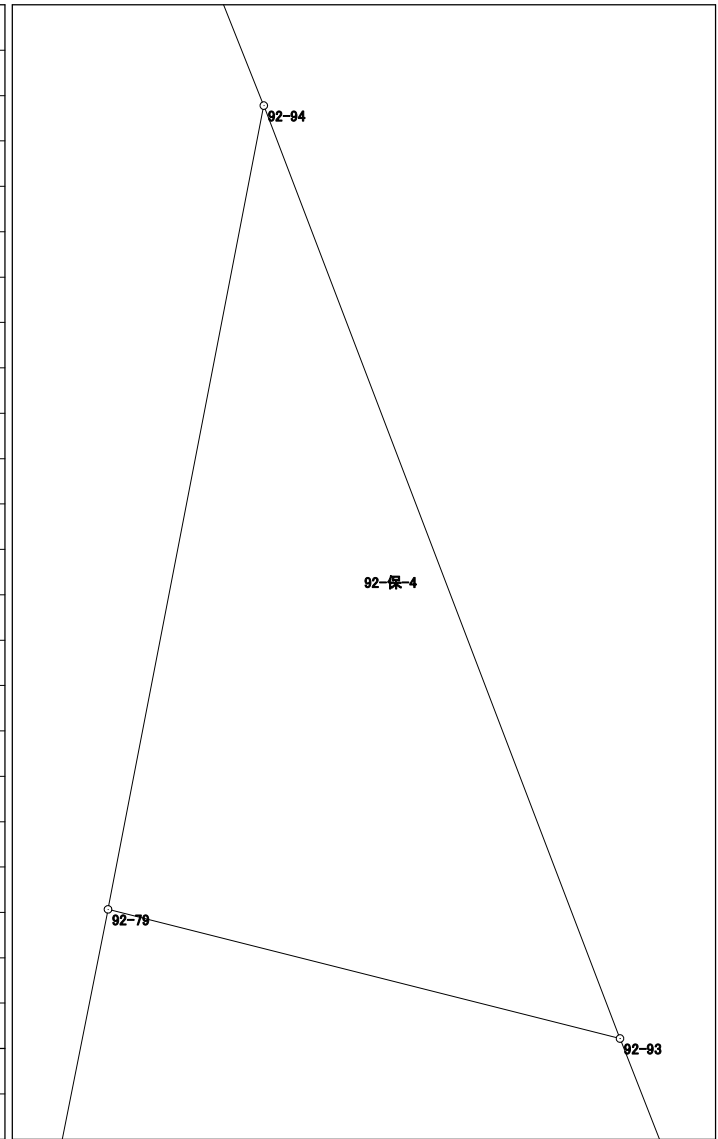

倍面積	0.087090
面積	0.0435450


# 面積計算書（座標法）

世界測地系（測地成果2011）

所在	地番	公簿地目	現況地目	地積	所有者
前橋市六供町四丁目	92-保-5			76.00 m <sup>2</sup>	

点名	X座標	Y座標	辺長	方向角	測角	DX	倍積(Y×DX)
92-130	41329.462	-67367.674	10.429	78-01-27	90-39-47	-0.864	58205.670336
92-131	41331.626	-67357.472	6.491	348-09-00	90-07-33	8.517	-573683.589024
92-133	41337.979	-67358.805	9.622	269-17-07	101-08-07	6.233	-419847.431565
92-134	41337.859	-67368.426	5.369	179-13-16	89-56-09	-5.489	369785.290314
92-132	41332.490	-67368.353	3.103	167-21-40	168-08-24	-8.397	565692.060141

倍面積	152.000202
面積	76.0001010

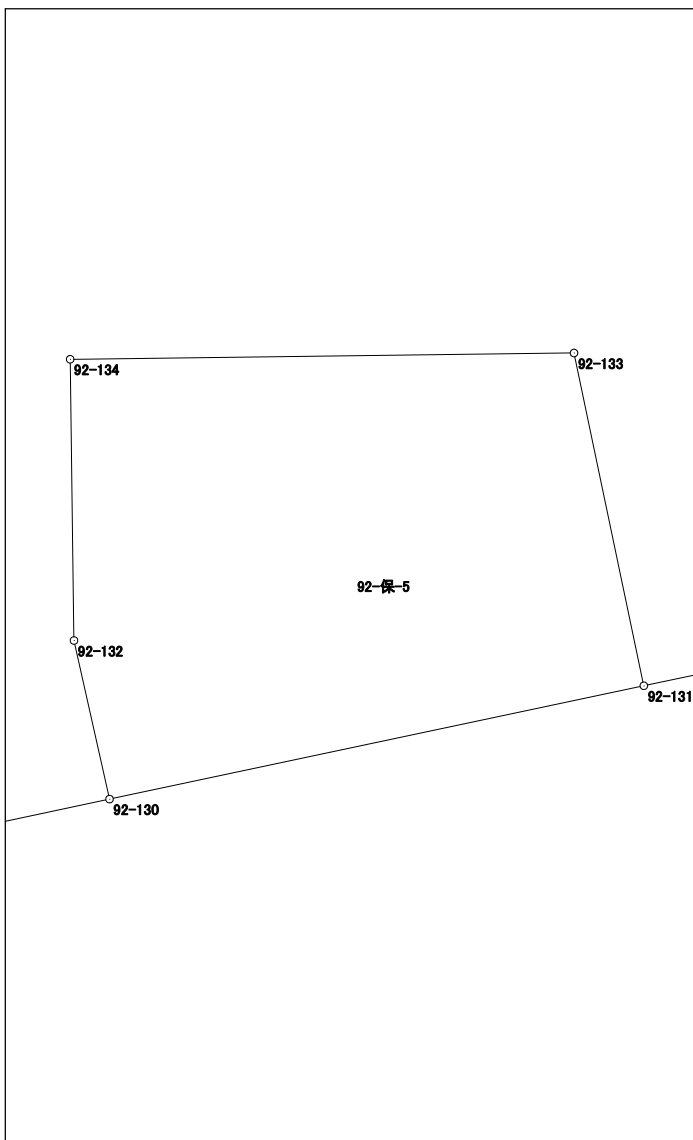




# 面積計算書 (座標法)

世界測地系 (測地成果2011)

所在	地番	公簿地目	現況地目	地積	所有者
前橋市六供町四丁目	92-保-6			44.00 m <sup>2</sup>	

点名	X座標	Y座標	辺長	方向角	測角	DX	倍積 (Y×DX)
92-104	41342.659	-67395.762	19.099	179-20-35	90-00-23	-19.125	1288943.948250
92-103	41323.561	-67395.543	2.378	78-03-42	78-43-07	-18.606	1253961.473058
92-105	41324.053	-67393.216	18.634	359-20-31	101-16-49	19.125	-1288895.256000
92-106	41342.686	-67393.430	2.332	269-20-12	89-59-41	18.606	-1253922.158580

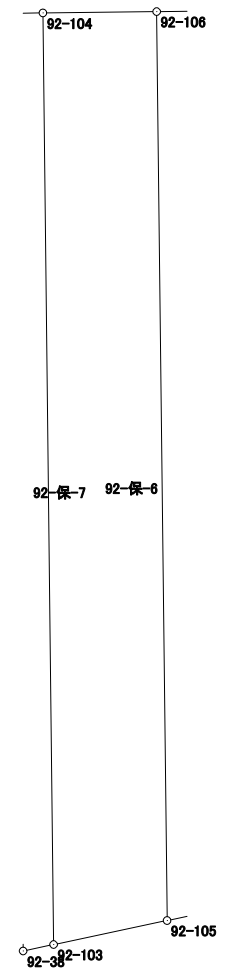


倍面積	88.006728
面積	44.0033640

# 面積計算書（座標法）

世界測地系（測地成果2011）

所 在	地 番	公簿地目	現況地目	地 積	所 有 者
前橋市六供町四丁目	92-保-7			12.00 m <sup>2</sup>	

点 名	X 座標	Y 座標	辺 長	方 向 角	測 角	DX	倍 積 (Y×DX)
92-38	41323.429	-67396.168	0.639	78-04-28	78-43-49	-19.091	1286660.243288
92-103	41323.561	-67395.543	19.099	359-20-35	101-16-07	19.230	-1296016.291890
92-104	41342.659	-67395.762	0.626	269-21-34	90-00-59	19.091	-1286652.492342
92-40	41342.652	-67396.388	19.224	179-20-39	89-59-05	-19.230	1296032.541240

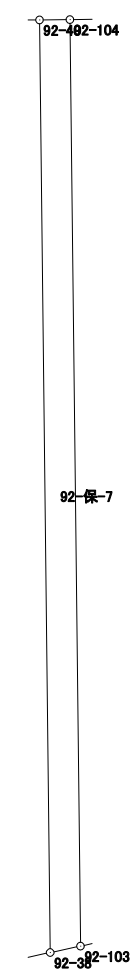


倍面積	24.000296
面 積	12.0001480

# 面積計算書（座標法）

世界測地系（測地成果2011）

所 在	地 番	公簿地目	現況地目	地 積	所 有 者
前橋市六供町四丁目	92-保-8			67.00 m <sup>2</sup>	

点 名	X 座標	Y 座標	辺 長	方 向 角	測 角	DX	倍 積 (Y×DX)
92-38	41323.429	-67396.168	19.224	359-20-39	101-15-32	19.944	-1344149.174592
92-40	41342.652	-67396.388	3.424	269-19-50	89-59-11	19.183	-1292864.911004
92-101	41342.612	-67399.812	19.905	179-20-48	90-00-58	-19.944	1344221.850528
92-102	41322.708	-67399.585	3.492	78-05-07	78-44-19	-19.183	1292926.239055
						倍面積	134.003987
						面 積	67.0019935

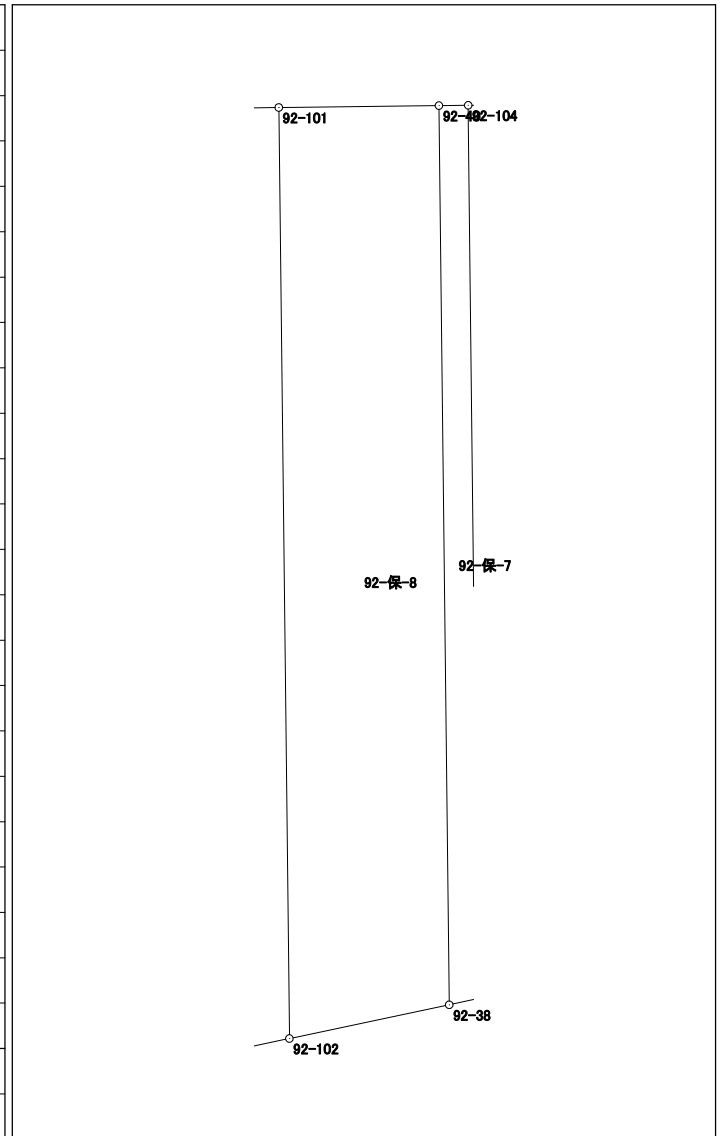


# 面積計算書 (座標法)

世界測地系 (測地成果2011)

所在	地番	公簿地目	現況地目	地積	所有者
前橋市六供町四丁目	92-保-9			63.00 m <sup>2</sup>	

点名	X座標	Y座標	辺長	方向角	測角	DX	倍積 (Y×DX)
92-108	41342.878	-67377.442	22.787	2-58-51	93-41-02	22.790	-1535531.903180
92-107	41365.634	-67376.257	2.770	269-19-03	86-20-12	22.723	-1530990.687811
92-109	41365.601	-67379.027	22.788	182-59-00	93-39-57	-22.790	1535568.025330
92-110	41342.844	-67380.213	2.771	89-17-49	86-18-49	-22.723	1531080.579999
倍面積							126.014338
面積							63.0071690

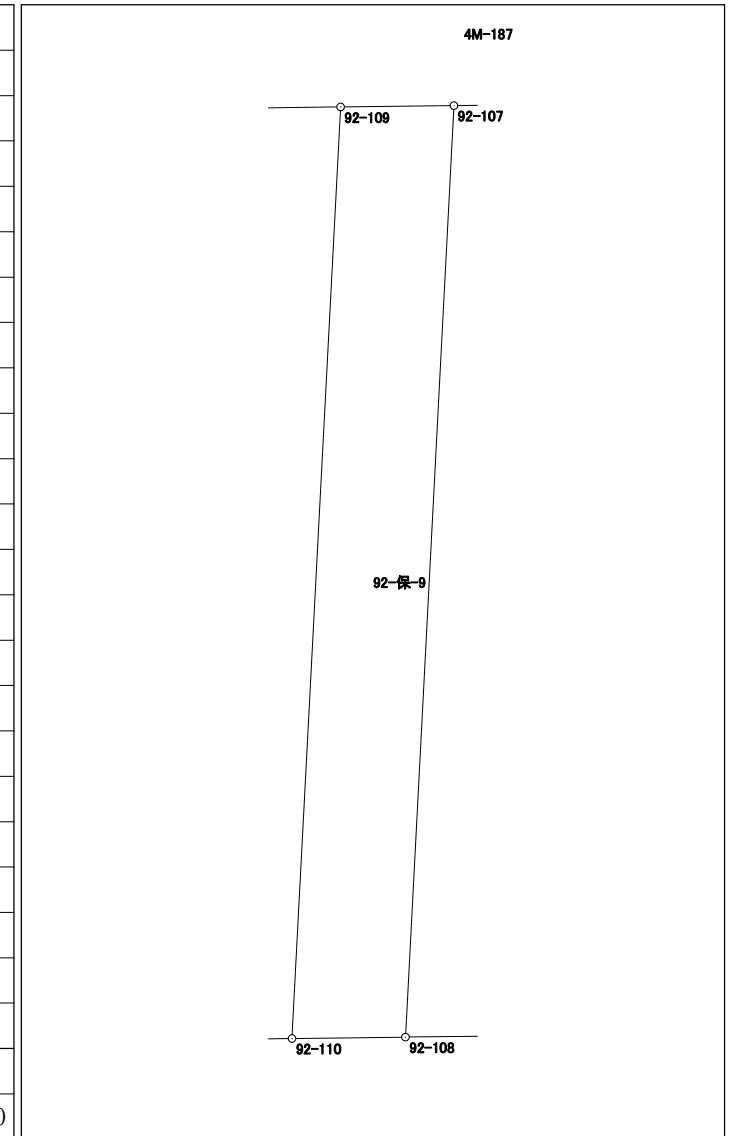


# 面積計算書 (座標法)

世界測地系 (測地成果2011)

所在	地番	公簿地目	現況地目	地積	所有者
前橋市六供町四丁目	92-保-10			48.00 m <sup>2</sup>	

点名	X座標	Y座標	辺長	方向角	測角	DX	倍積 (Y×DX)
92-116	41352.003	-67359.051	3.435	93-01-14	89-59-39	-14.026	944778.049326
92-118	41351.822	-67355.621	14.086	3-01-40	90-00-26	13.885	-935232.797585
92-119	41365.888	-67354.877	3.442	269-20-03	86-18-23	14.026	-944719.504802
92-117	41365.848	-67358.319	13.864	183-01-35	93-41-32	-13.885	935270.259315
						倍面積	96.006254
						面積	48.0031270

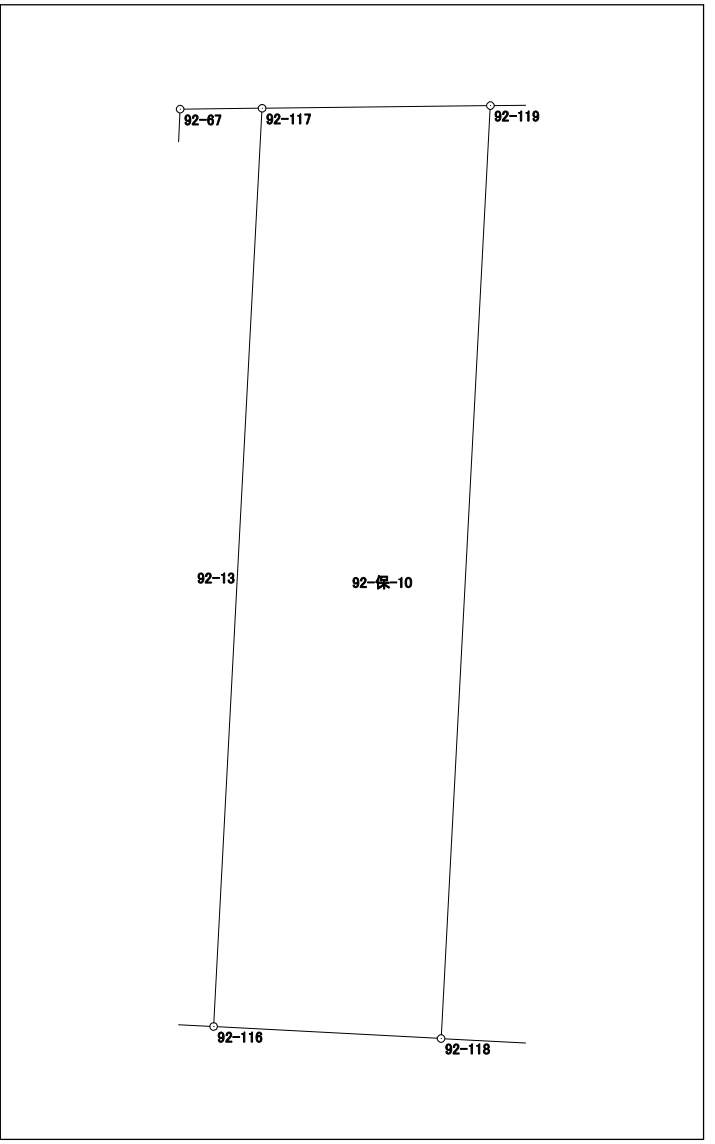


# 面積計算書（座標法）

世界測地系（測地成果2011）

所 在	地 番	公簿地目	現況地目	地 積	所 有 者
前橋市六供町四丁目	92-保-11			60.00 m <sup>2</sup>	

点 名	X 座標	Y 座標	辺 長	方 向 角	測 角	DX	倍 積 (Y×DX)
92-121	41376.263	-67329.454	16.616	2-58-25	89-08-35	16.364	-1101779.185256
92-120	41392.857	-67328.592	0.933	343-57-12	160-58-47	17.491	-1177644.402672
92-91	41393.754	-67328.850	3.138	272-54-16	108-57-04	1.056	-71099.265600
92-122	41393.913	-67331.984	17.443	182-58-26	90-04-10	-17.261	1162217.375824
92-123	41376.493	-67332.889	3.443	93-49-50	90-51-24	-17.650	1188425.490850
						倍面積	120.013146
						面 積	60.0065730

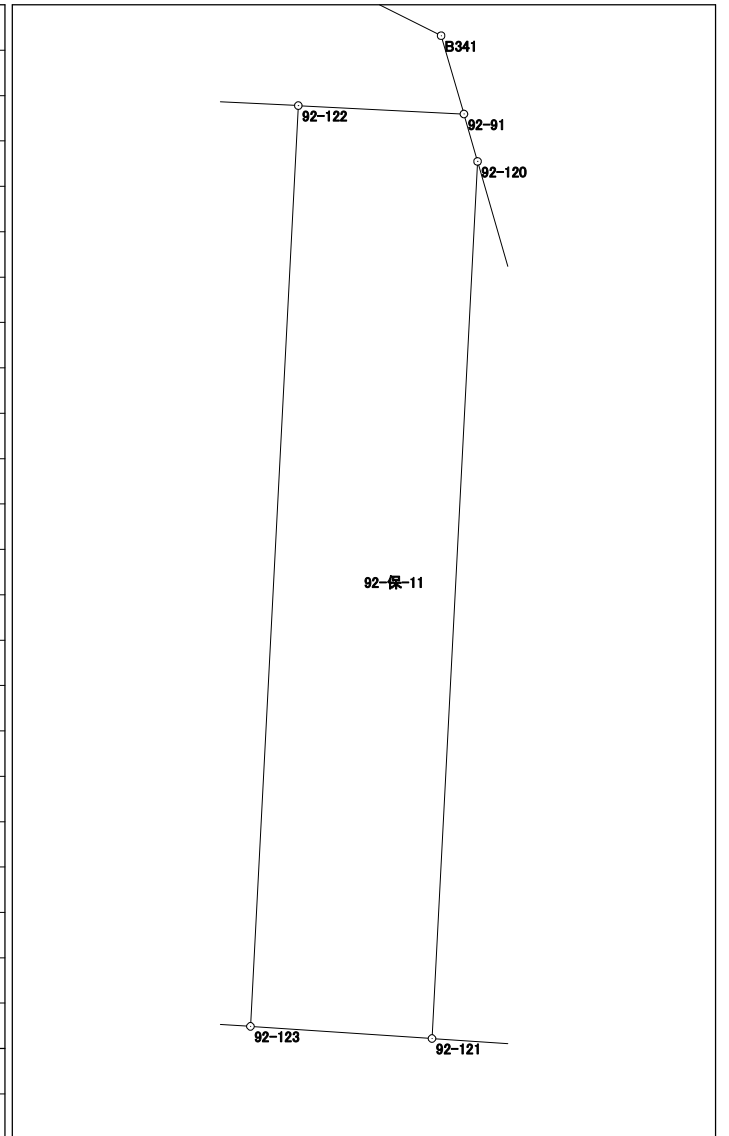


# 面積計算書（座標法）

世界測地系（測地成果2011）

所在	地番	公簿地目	現況地目	地積	所有者
前橋市六供町四丁目	92-保-12			340.68 m <sup>2</sup>	

点名	X座標	Y座標	辺長	方向角	測角	DX	倍積 (Y×DX)
92-55	41377.054	-67341.265	7.018	182-59-52	89-09-58	-6.447	434149.135455
92-70	41370.046	-67341.632	6.297	93-04-37	90-04-45	-7.346	494691.628672
92-72	41369.708	-67335.344	15.900	182-59-19	269-54-42	-16.216	1091909.938304
92-71	41353.830	-67336.173	10.570	91-49-37	88-50-18	-16.215	1091856.045195
92-69	41353.493	-67325.608	2.843	3-11-08	91-21-31	2.502	-168448.671216
92-47	41356.332	-67325.450	1.164	91-43-26	268-32-18	2.804	-188780.561800
92-125	41356.297	-67324.287	1.095	91-43-34	180-00-08	-0.068	4578.051516
92-73	41356.264	-67323.192	12.315	11-16-18	99-32-44	12.044	-810840.524448
92-79	41368.341	-67320.785	0.368	10-58-26	179-42-08	12.438	-837335.923830
92-94	41368.702	-67320.715	7.714	338-17-13	147-18-47	7.528	-506790.342520
92-77	41375.869	-67323.569	5.898	273-49-49	115-32-36	7.561	-509033.505209
92-121	41376.263	-67329.454	3.443	273-49-50	180-00-01	0.624	-42013.579296
92-123	41376.493	-67332.889	8.395	273-49-54	180-00-04	0.791	-53260.315199

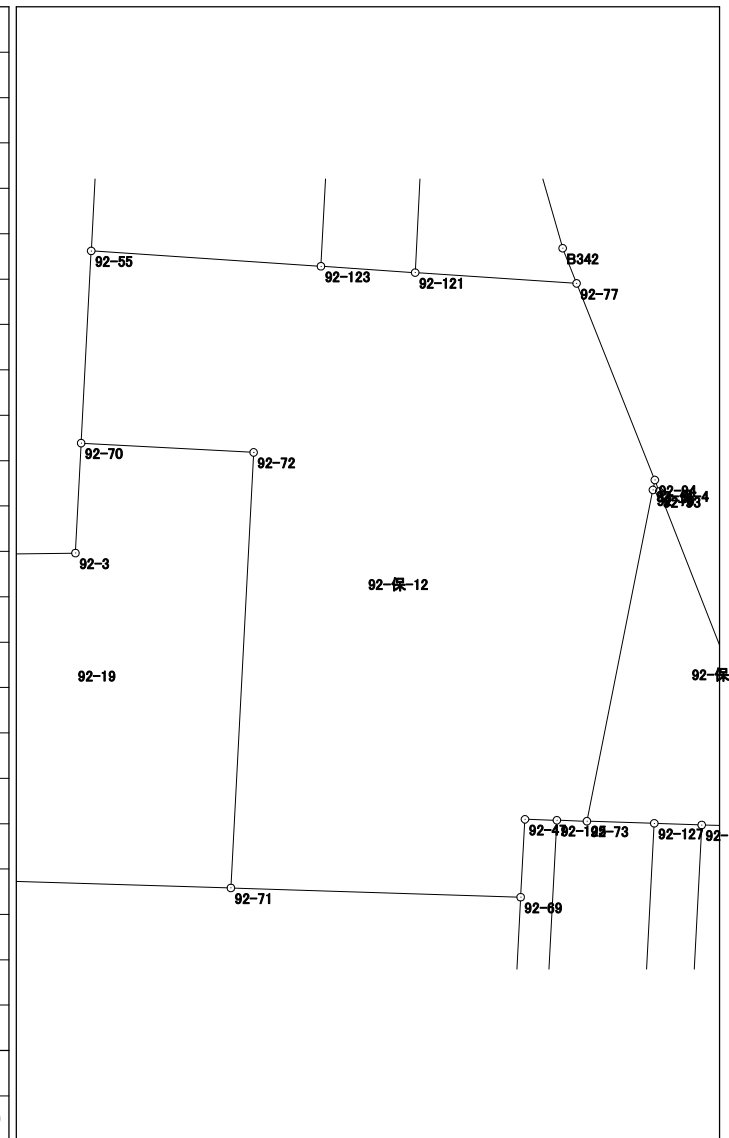

倍面積	681.375624
面積	340.6878120