



99街区 画地出来形確認図 (4079.32m²)

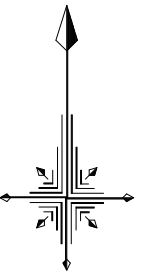

S=1/500

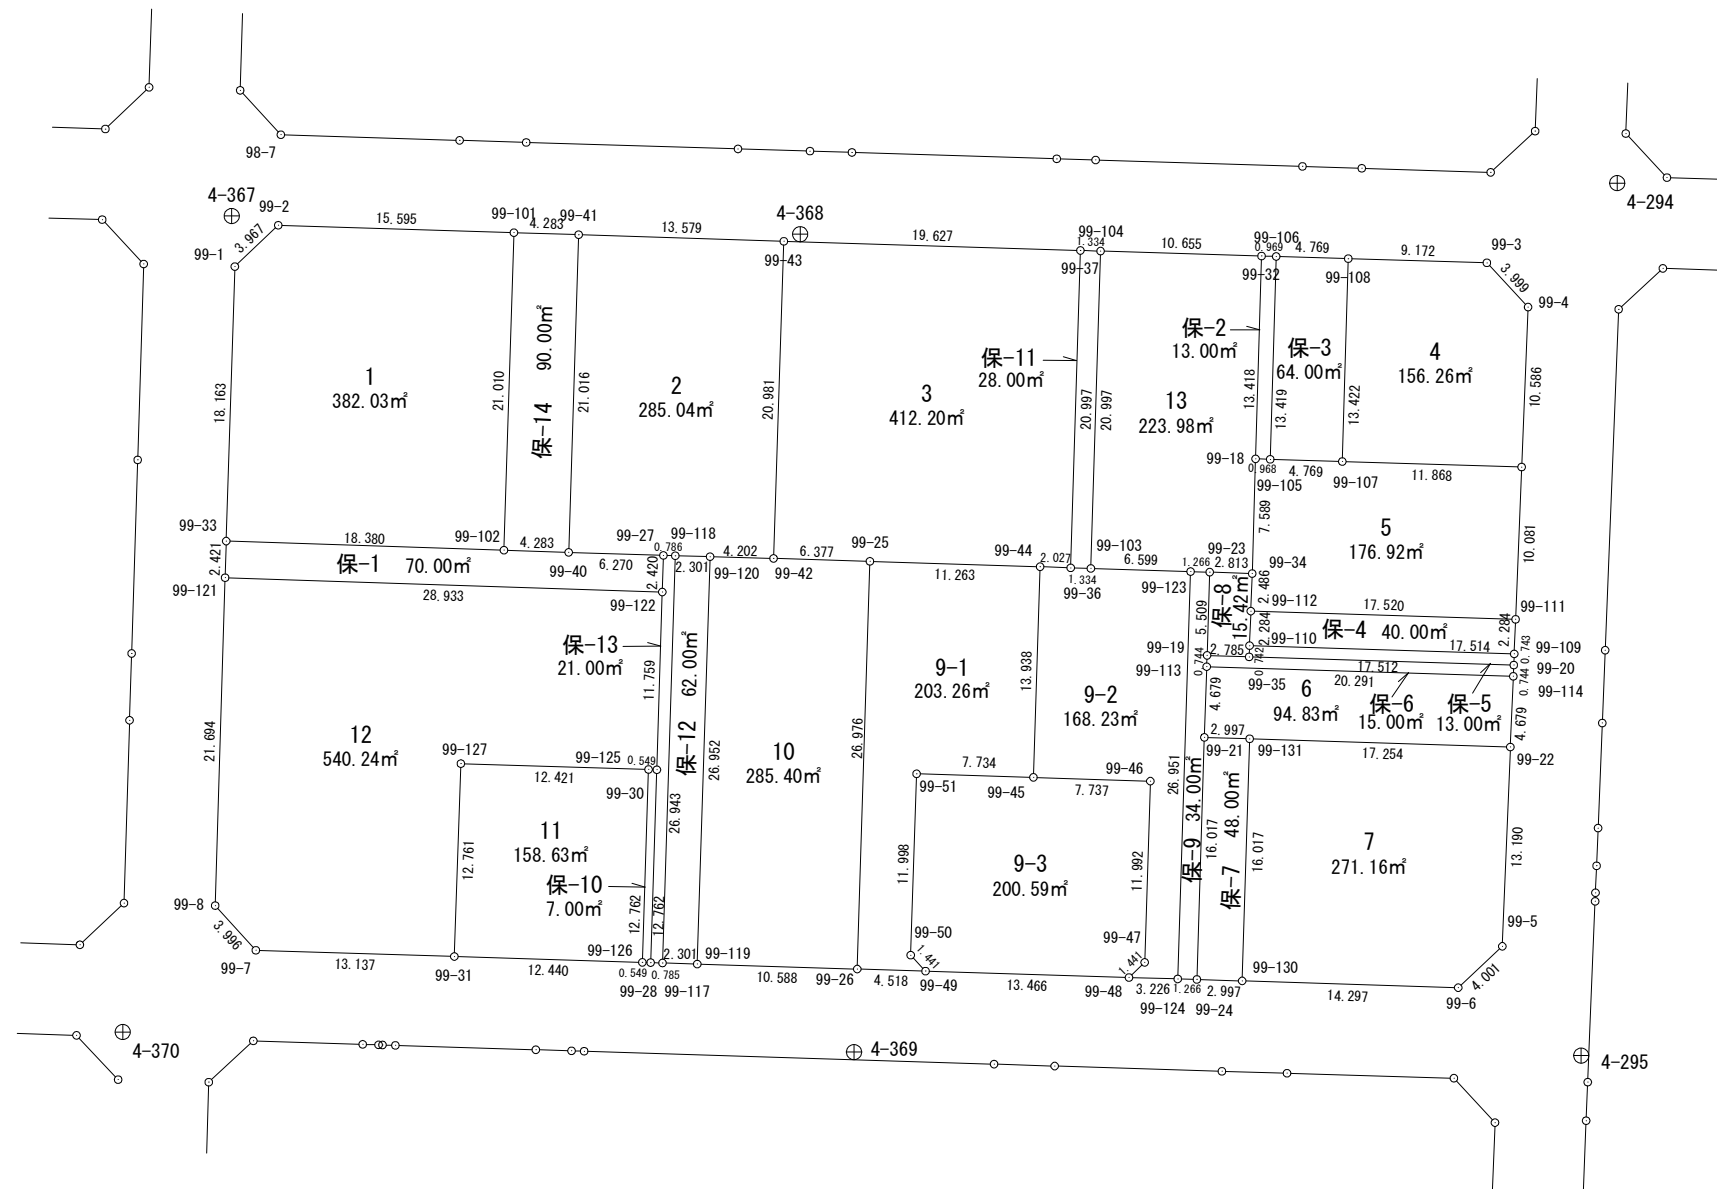


面積計算書 (座標法)

世界測地系 (測地成果2011)

所在	地番	公簿地目	現況地目	地積	所有者
前橋市六供町四丁目	99-1			382.03 m ²	

点名	X座標	Y座標	辺長	方向角	測角	DX	倍積 (Y×DX)
99-101	41356.239	-67664.147	15.595	271-48-02	90-00-02	21.490	-1454102.519030
99-2	41356.729	-67679.734	3.967	226-27-02	134-39-00	-2.243	151805.643362
99-1	41353.996	-67682.609	18.163	181-47-31	135-20-29	-20.887	1413686.654183
99-33	41335.842	-67683.177	18.380	91-52-48	90-05-17	-18.757	1269533.350989
99-102	41335.239	-67664.807	21.010	1-48-00	89-55-12	20.397	-1380159.068379
						倍面積	764.061125
						面積	382.0305625

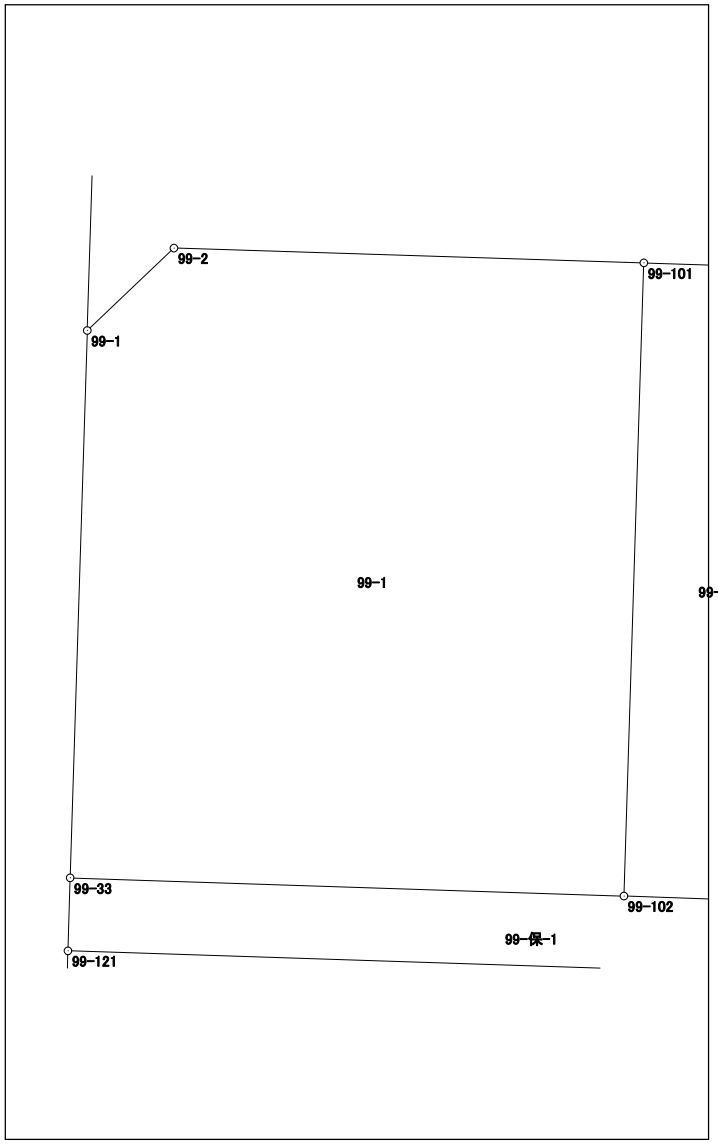


面積計算書（座標法）

世界測地系（測地成果2011）

所在	地番	公簿地目	現況地目	地積	所有者
前橋市六供町四丁目	99-3			412.20 m ²	

点名	X座標	Y座標	辺長	方向角	測角	DX	倍積 (Y×DX)
99-43	41355.666	-67646.294	20.981	181-51-16	90-05-17	-20.365	1377616.777310
99-42	41334.696	-67646.973	6.377	91-42-59	89-51-43	-21.161	1431477.595653
99-25	41334.505	-67640.599	11.263	91-48-41	180-05-42	-0.547	36999.407653
99-44	41334.149	-67629.342	2.027	92-07-12	180-18-31	-0.431	29148.246402
99-36	41334.074	-67627.316	20.997	1-44-48	89-37-36	20.912	-1414222.432192
99-37	41355.061	-67626.676	19.627	271-45-59	90-01-11	21.592	-1460195.188192

倍面積	824.406634
面積	412.2033170

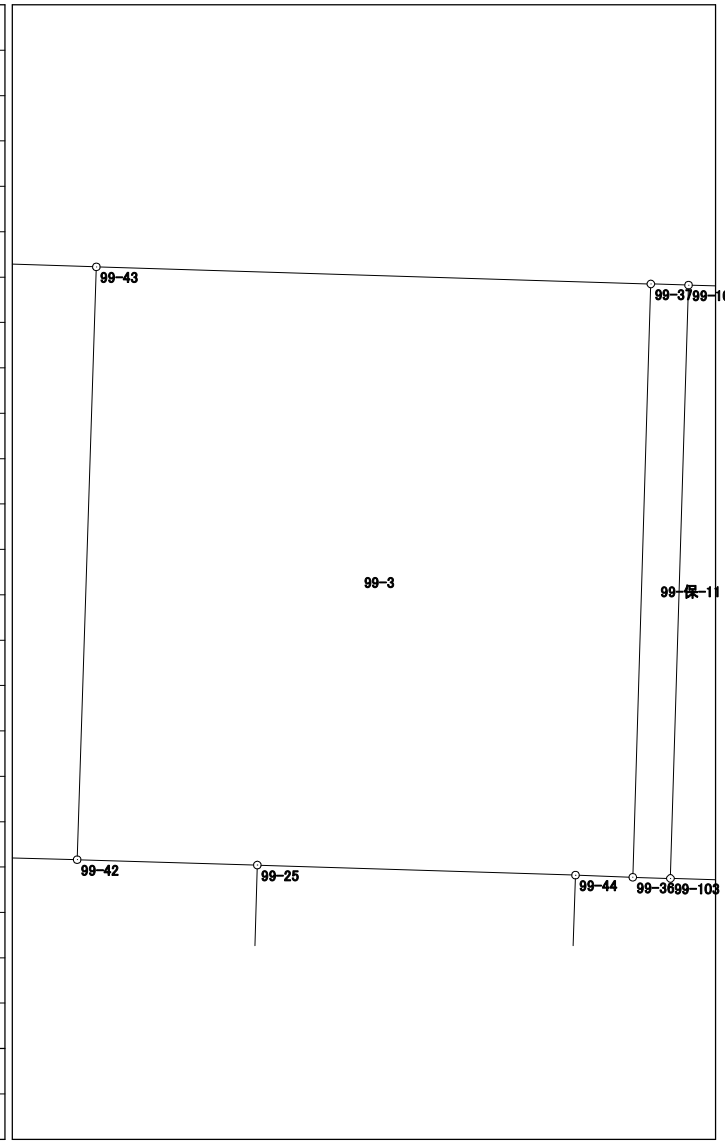


面積計算書 (座標法)

世界測地系 (測地成果2011)

所在	地番	公簿地目	現況地目	地積	所有者
前橋市六供町四丁目	99-4			156.26 m ²	

点名	X座標	Y座標	辺長	方向角	測角	DX	倍積 (Y×DX)
99-107	41341.104	-67609.352	11.868	91-45-28	90-04-17	-13.780	931656.870560
99-17	41340.740	-67597.490	10.586	2-18-04	90-32-36	10.213	-690373.165370
99-4	41351.317	-67597.065	3.999	317-04-02	134-45-58	13.505	-912898.362825
99-3	41354.245	-67599.789	9.172	271-43-05	134-39-03	3.203	-216522.124167
99-108	41354.520	-67608.957	13.422	181-41-11	89-58-06	-13.141	888449.303937

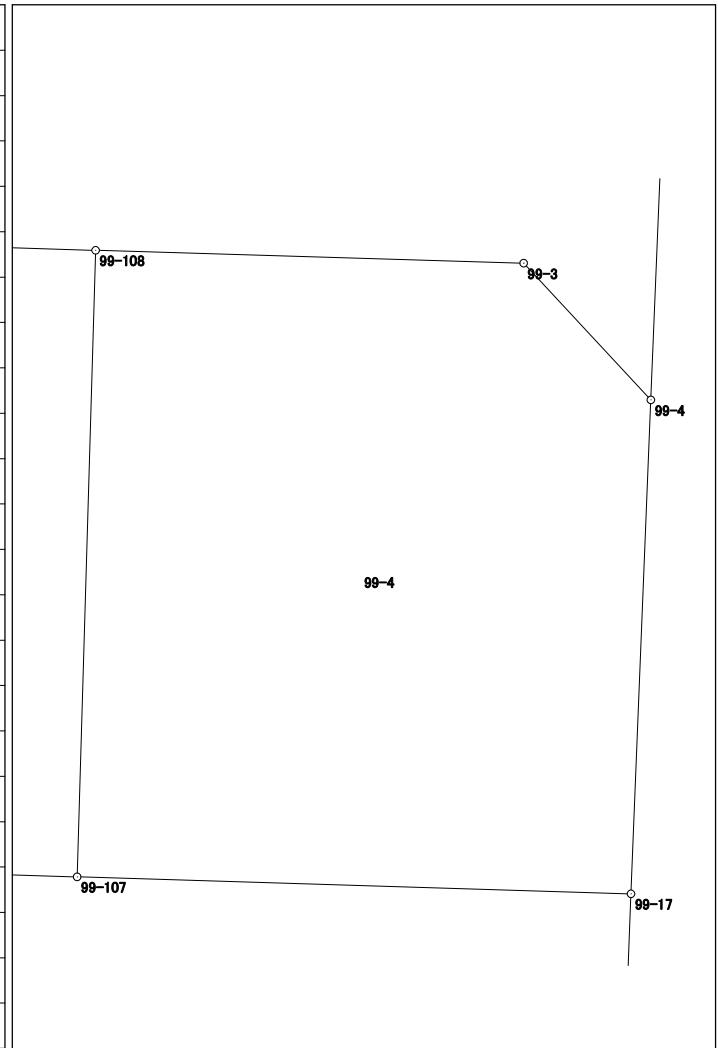


倍面積	312.522135
面積	156.2610675

面積計算書 (座標法)

世界測地系 (測地成果2011)

所在	地番	公簿地目	現況地目	地積	所有者
前橋市六供町四丁目	99-6			94.83 m ²	

点名	X座標	Y座標	辺長	方向角	測角	DX	倍積 (Y×DX)
99-113	41327.539	-67618.321	4.679	181-53-55	90-05-38	-4.037	272975.161877
99-21	41322.863	-67618.476	2.997	91-47-49	89-53-54	-4.770	322540.130520
99-131	41322.769	-67615.480	17.254	91-48-25	180-00-36	-0.638	43138.676240
99-22	41322.225	-67598.235	4.679	2-23-19	90-34-54	4.131	-279248.308785
99-114	41326.900	-67598.040	20.291	271-48-17	89-24-58	5.314	-359215.984560

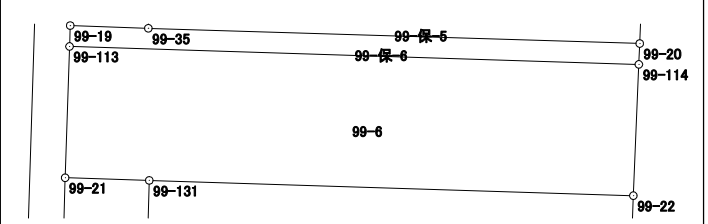


倍面積	189.675292
面積	94.8376460

面積計算書 (座標法)

世界測地系 (測地成果2011)

所在	地番	公簿地目	現況地目	地積	所有者
前橋市六供町四丁目	99-7			271.16 m ²	

点名	X座標	Y座標	辺長	方向角	測角	DX	倍積 (Y×DX)
99-131	41322.769	-67615.480	16.017	181-46-16	89-57-51	-15.465	1045673.398200
99-130	41306.760	-67615.975	14.297	91-47-59	90-01-43	-16.458	1112823.716550
99-6	41306.311	-67601.685	4.001	46-52-25	135-04-26	2.286	-154537.451910
99-5	41309.046	-67598.765	13.190	2-18-11	135-25-46	15.914	-1075766.746210
99-22	41322.225	-67598.235	17.254	271-48-25	89-30-14	13.723	-927650.578905
						倍面積	542.337725
						面積	271.1688625

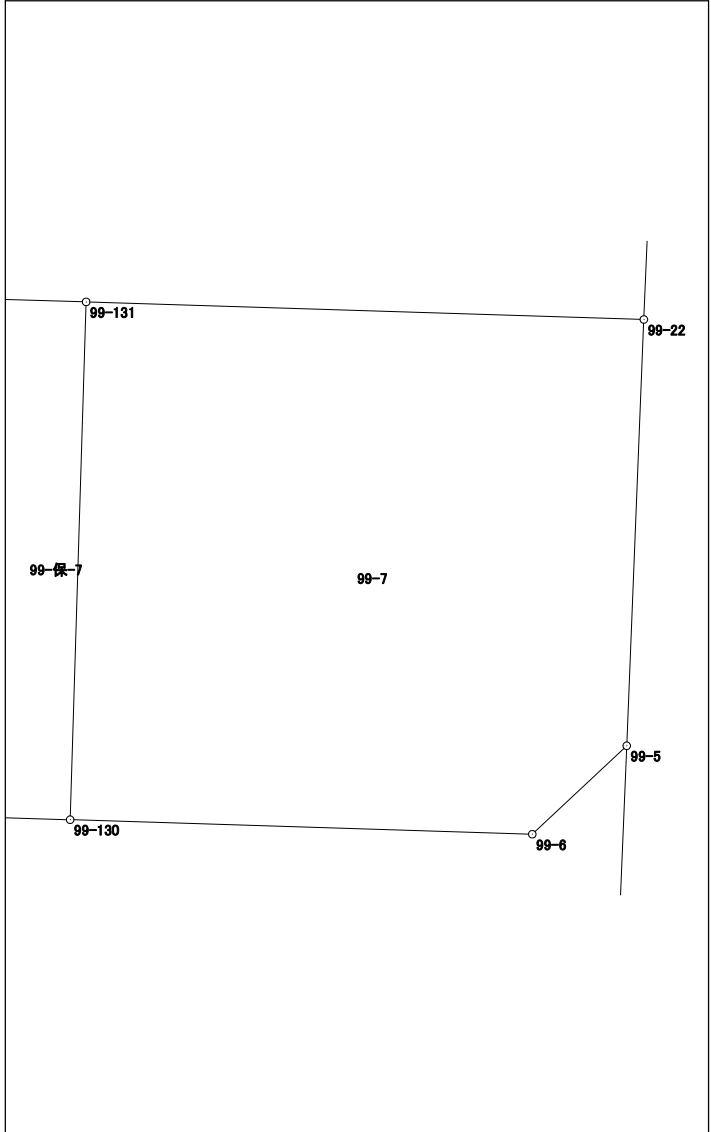


面積計算書（座標法）

世界測地系（測地成果2011）

所 在	地 番	公簿地目	現況地目	地 積	所 有 者
前橋市六供町四丁目	99-9-2			168.23 m ²	

点 名	X 座標	Y 座標	辺 長	方 向 角	測 角	DX	倍 積 (Y×DX)
99-44	41334.149	-67629.342	13.938	181-48-33	89-41-21	-13.856	937072.162752
99-45	41320.218	-67629.782	7.737	91-50-39	90-02-06	-14.180	958990.308760
99-46	41319.969	-67622.049	11.992	181-47-31	269-56-52	-12.235	827355.769515
99-47	41307.983	-67622.424	1.441	226-00-43	224-13-12	-12.987	878212.420488
99-48	41306.982	-67623.461	3.226	91-38-03	45-37-20	-1.093	73912.442873
99-124	41306.890	-67620.236	26.951	1-48-19	90-10-16	26.846	-1815332.855656
99-123	41333.828	-67619.387	6.599	271-46-49	89-58-30	27.143	-1835393.021341
99-103	41334.033	-67625.983	1.334	271-45-42	179-58-53	0.246	-16635.991818
99-36	41334.074	-67627.316	2.027	272-07-12	180-21-30	0.116	-7844.768656

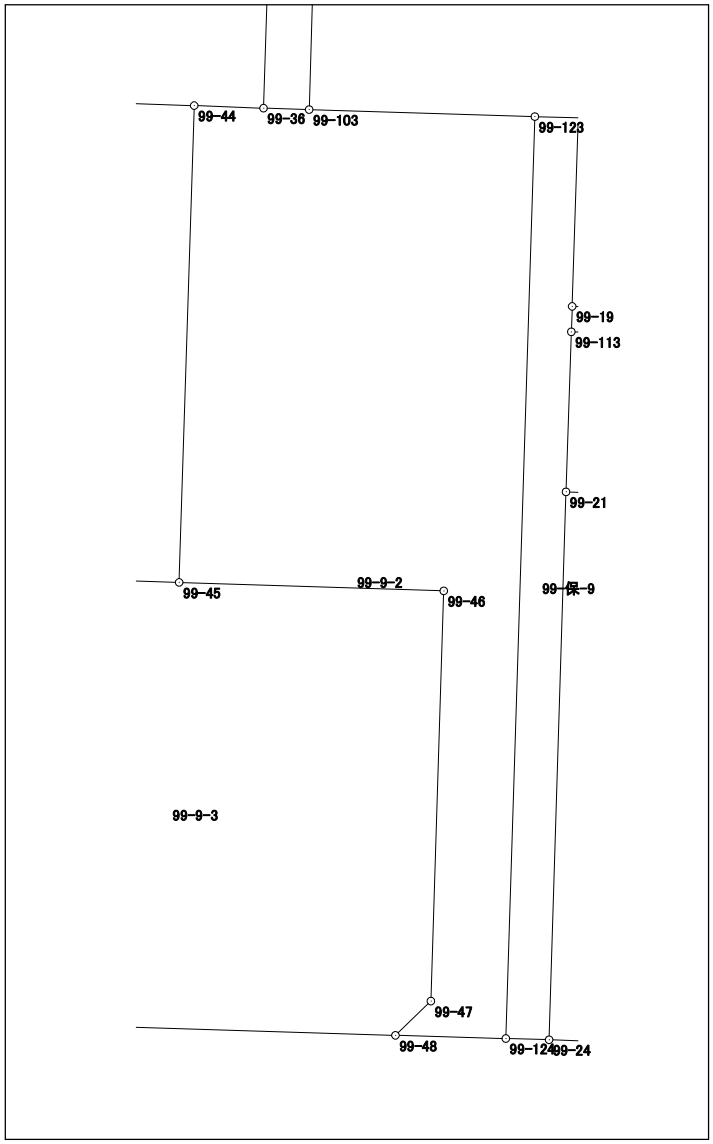


倍面積	336.466917
面 積	168.2334585

面積計算書（座標法）

世界測地系（測地成果2011）

所 在	地 番	公簿地目	現況地目	地 積	所 有 者
前橋市六供町四丁目	99-10			285.40 m ²	

点 名	X 座標	Y 座標	辺 長	方 向 角	測 角	DX	倍 積 (Y×DX)
99-119	41307.872	-67652.019	10.588	91-47-10	89-59-15	-27.269	1844802.906111
99-26	41307.542	-67641.436	26.976	1-46-41	89-59-31	26.633	-1801494.364988
99-25	41334.505	-67640.599	6.377	271-42-59	89-56-18	27.154	-1836712.825246
99-42	41334.696	-67646.973	4.202	271-34-06	179-51-07	0.306	-20699.973738
99-120	41334.811	-67651.173	26.952	181-47-55	90-13-49	-26.824	1814675.064552

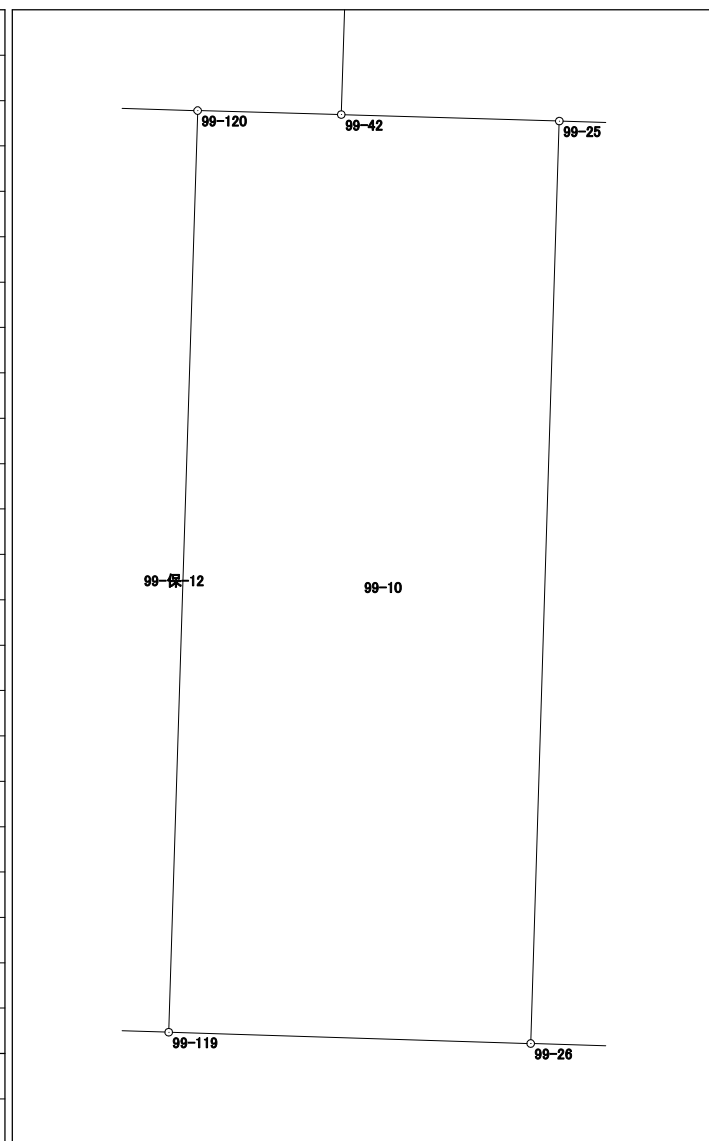

倍面積	570.806691
面 積	285.4033455


面積計算書 (座標法)

世界測地系 (測地成果2011)

所在	地番	公簿地目	現況地目	地積	所有者
前橋市六供町四丁目	99-11			158.63 m ²	

点名	X座標	Y座標	辺長	方向角	測角	Dx	倍積 (Y×Dx)
99-31	41308.372	-67668.087	12.440	91-46-58	89-50-50	-13.141	889226.331267
99-126	41307.985	-67655.653	12.762	1-51-00	90-04-02	12.368	-836765.116304
99-125	41320.740	-67655.241	12.421	271-46-51	89-55-51	13.141	-889057.521981
99-127	41321.126	-67667.656	12.761	181-56-08	90-09-17	-12.368	836913.569408

倍面積	317.262390
面積	158.6311950

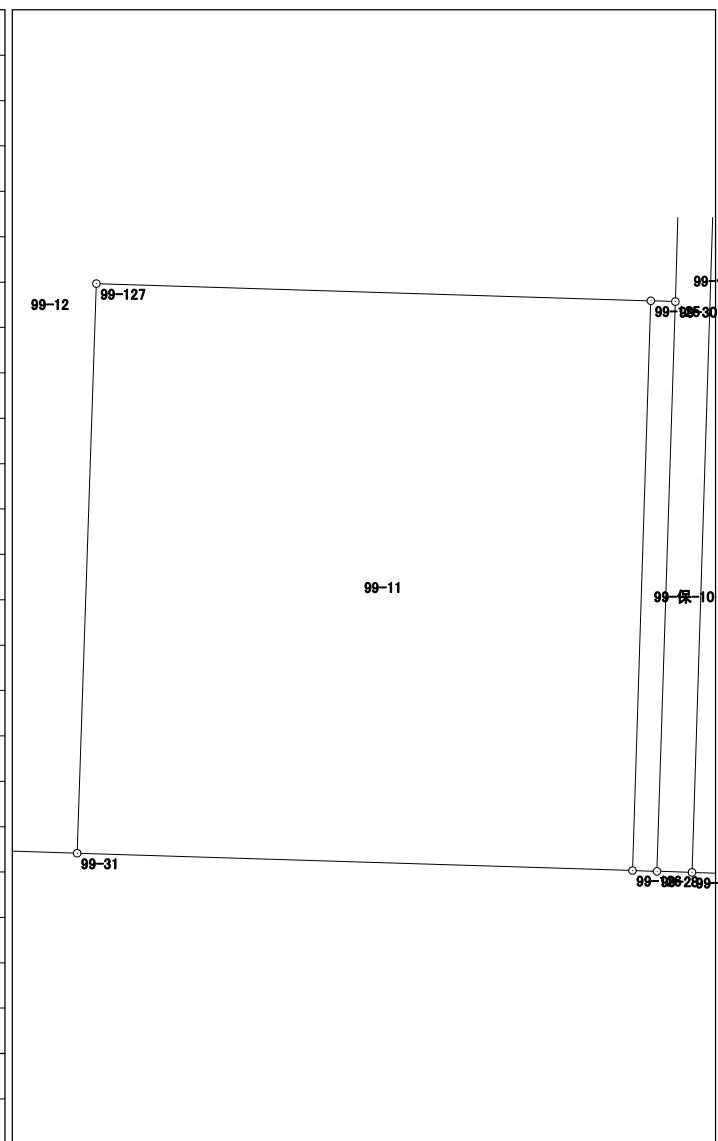


面積計算書（座標法）

世界測地系（測地成果2011）

所在	地番	公簿地目	現況地目	地積	所有者
前橋市六供町四丁目	99-12			540.24 m ²	

点名	X座標	Y座標	辺長	方向角	測角	DX	倍積 (Y×DX)
99-8	41311.738	-67683.908	3.996	137-41-16	135-56-59	-24.639	1667663.809212
99-7	41308.783	-67681.218	13.137	91-47-34	134-06-18	-3.366	227814.979788
99-31	41308.372	-67668.087	12.761	1-56-08	90-08-34	12.343	-835227.197841
99-127	41321.126	-67667.656	12.421	91-46-51	269-50-43	12.368	-836913.569408
99-125	41320.740	-67655.241	0.549	91-46-25	179-59-34	-0.403	27265.062123
99-30	41320.723	-67654.692	11.759	1-45-16	89-58-51	11.736	-793995.465312
99-122	41332.476	-67654.332	28.933	271-52-25	90-07-09	12.699	-859142.362068
99-121	41333.422	-67683.250	21.694	181-44-17	89-51-52	-20.738	1403615.238500

倍面積	1080.494994
面積	540.2474970

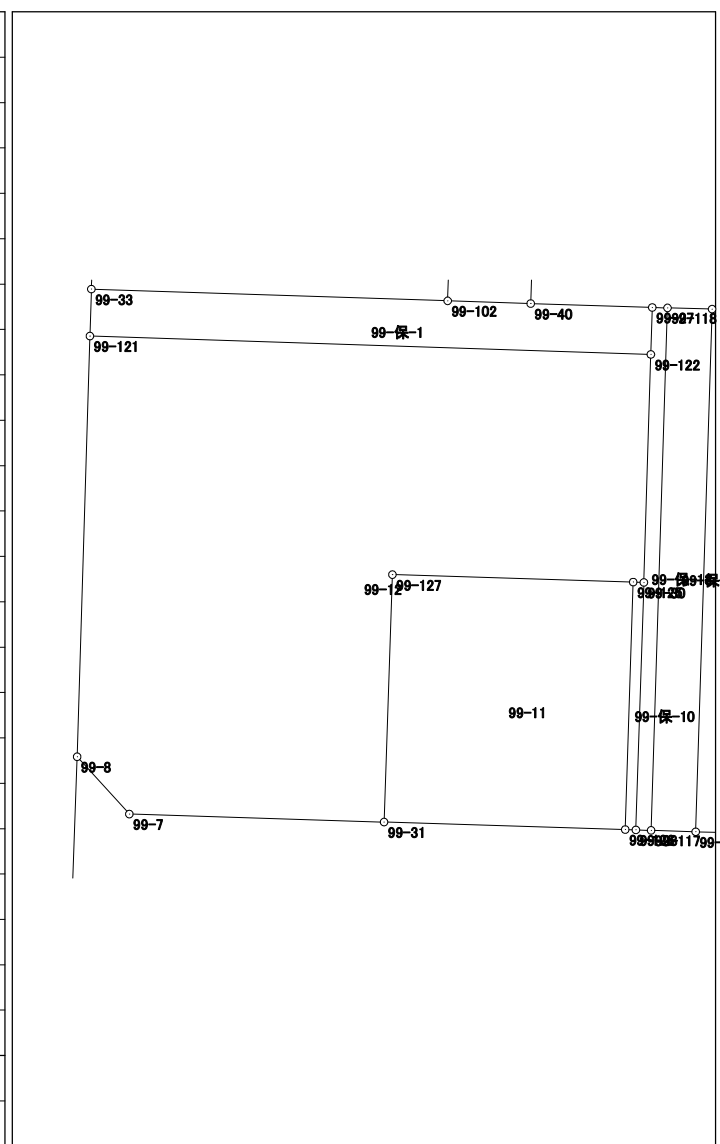


面積計算書（座標法）

世界測地系（測地成果2011）

所 在	地 番	公簿地目	現況地目	地 積	所 有 者
前橋市六供町四丁目	99-13			223.98 m ²	

点 名	X 座標	Y 座標	辺 長	方 向 角	測 角	DX	倍 積 (Y×DX)
99-103	41334.033	-67625.983	6.599	91-46-49	90-02-01	-21.192	1433129.831736
99-123	41333.828	-67619.387	1.266	91-45-57	179-59-08	-0.244	16499.130428
99-23	41333.789	-67618.122	2.813	91-56-08	180-10-11	-0.134	9060.828348
99-34	41333.694	-67615.311	7.589	1-41-29	89-45-21	7.491	-506506.294701
99-18	41341.280	-67615.087	13.418	1-40-58	179-59-29	20.998	-1419781.596826
99-32	41354.692	-67614.693	10.655	271-45-51	90-04-53	13.740	-929025.881820
99-104	41355.020	-67625.343	20.997	181-44-48	89-58-57	-20.659	1397071.961037
倍面積							447.978202
面 積							223.9891010

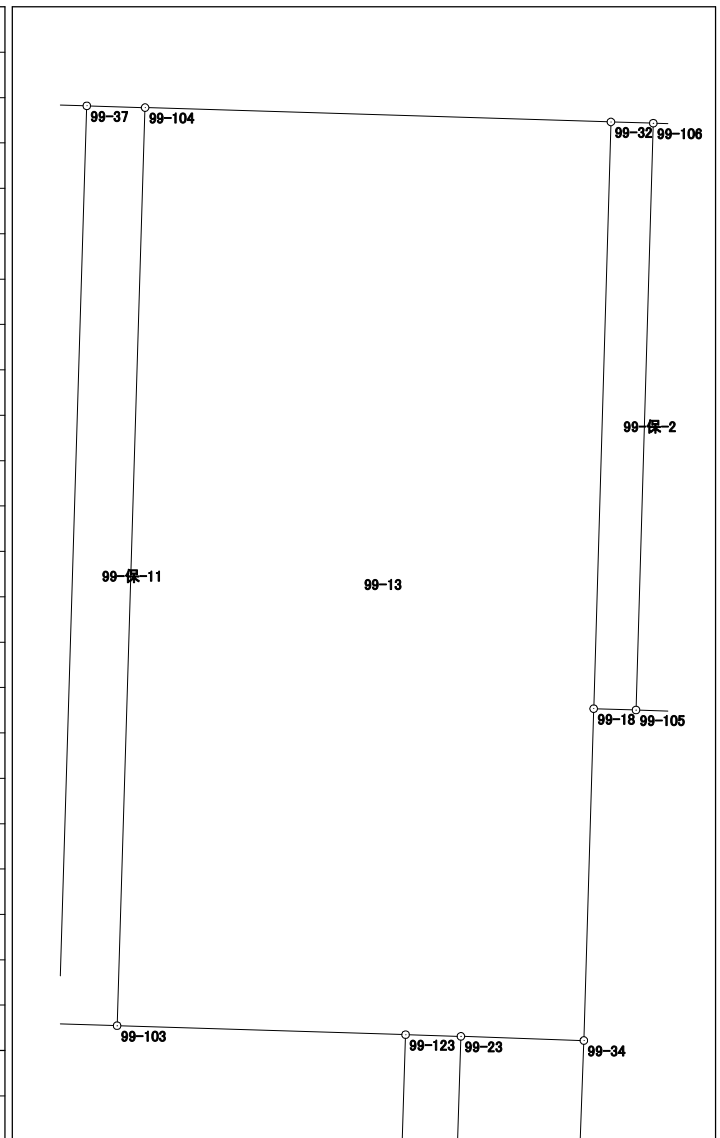


面積計算書 (座標法)

世界測地系 (測地成果2011)

所在	地番	公簿地目	現況地目	地積	所有者
前橋市六供町四丁目	99-保-1			70.00 m ²	

点名	X座標	Y座標	辺長	方向角	測角	DX	倍積 (Y×DX)
99-33	41335.842	-67683.177	2.421	181-43-40	89-50-52	-1.817	122980.332609
99-121	41333.422	-67683.250	28.933	91-52-25	90-08-45	-3.366	227821.819500
99-122	41332.476	-67654.332	2.420	1-43-43	89-51-18	1.473	-99654.831036
99-27	41334.895	-67654.259	6.270	271-51-19	90-07-36	2.622	-177389.467098
99-40	41335.098	-67660.526	4.283	271-53-11	180-01-52	0.344	-23275.220944
99-102	41335.239	-67664.807	18.380	271-52-48	179-59-37	0.744	-50342.616408
						倍面積	140.016623
						面積	70.0083115

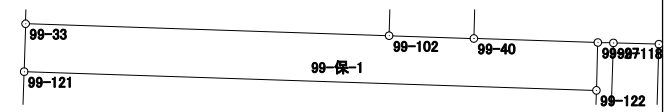


面積計算書（座標法）

世界測地系（測地成果2011）

所 在	地 番	公簿地目	現況地目	地 積	所 有 者
前橋市六供町四丁目	99-保-2			13.00 m ²	

点 名	X 座標	Y 座標	辺 長	方 向 角	測 角	DX	倍 積 (Y×DX)
99-32	41354.692	-67614.693	13.418	181-40-58	89-58-07	-13.383	904887.436419
99-18	41341.280	-67615.087	0.968	91-46-30	90-05-32	-13.442	908881.999454
99-105	41341.250	-67614.119	13.419	1-41-13	89-54-43	13.383	-904879.754577
99-106	41354.663	-67613.724	0.969	271-42-51	90-01-38	13.442	-908863.678008
倍面積						26.003288	
面 積						13.0016440	

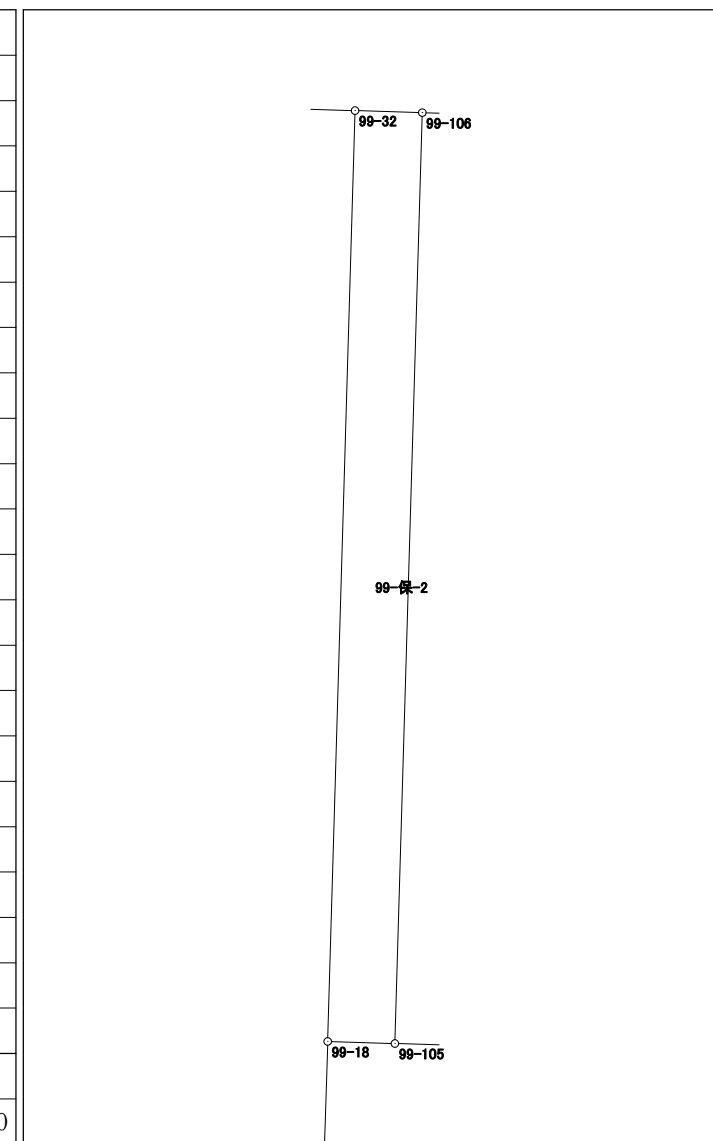


面積計算書（座標法）

世界測地系（測地成果2011）

所在	地番	公簿地目	現況地目	地積	所有者
前橋市六供町四丁目	99-保-3			64.00 m ²	

点名	X座標	Y座標	辺長	方向角	測角	DX	倍積 (Y×DX)
99-105	41341.250	-67614.119	4.769	91-45-15	90-04-02	-13.559	916779.839521
99-107	41341.104	-67609.352	13.422	1-41-11	89-55-56	13.270	-897176.101040
99-108	41354.520	-67608.957	4.769	271-43-06	90-01-55	13.559	-916709.847963
99-106	41354.663	-67613.724	13.419	181-41-13	89-58-07	-13.270	897234.117480

倍面積	128.007998
面積	64.0039990

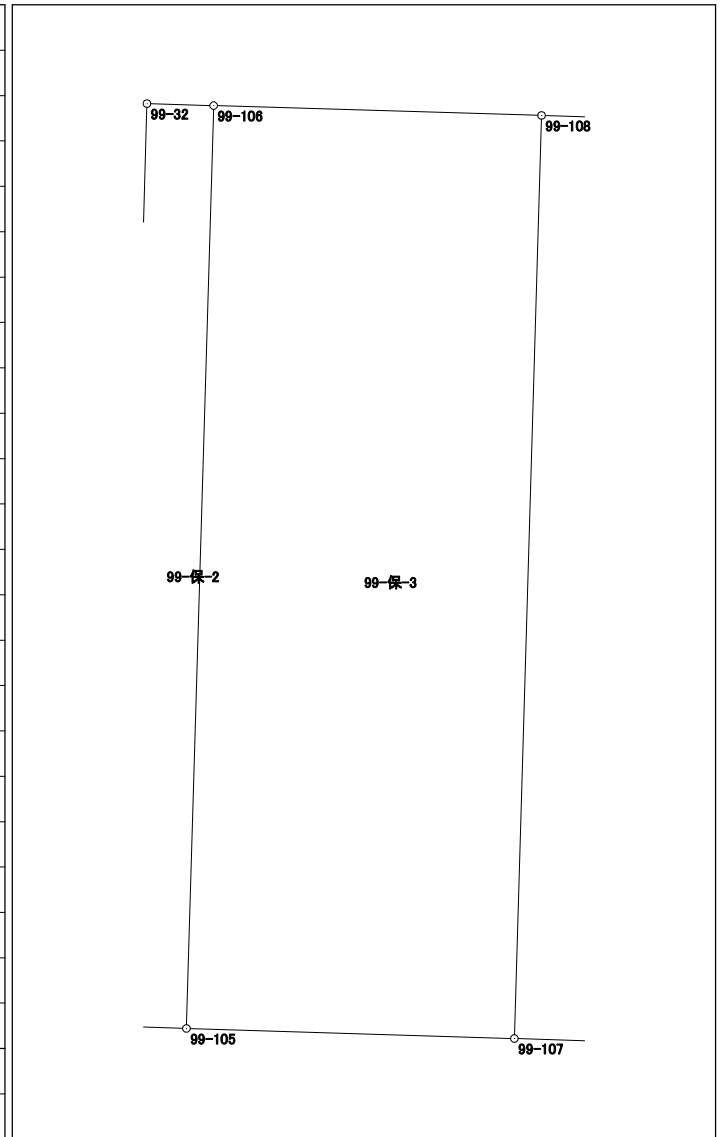

面積計算書（座標法）

世界測地系（測地成果2011）

所 在	地 番	公簿地目	現況地目	地 積	所 有 者
前橋市六供町四丁目	99-保-4			40.00 m ²	


点 名	X 座標	Y 座標	辺 長	方 向 角	測 角	DX	倍 積 (Y×DX)	
99-110	41328.928	-67615.486	17.514	91-46-36	89-40-07	-2.825	191013.747950	
99-109	41328.385	-67597.980	2.284	2-15-31	90-28-55	1.739	-117552.887220	
99-111	41330.667	-67597.890	17.520	271-46-34	89-31-03	2.825	-190964.039250	
99-112	41331.210	-67615.402	2.284	182-06-29	90-19-55	-1.739	117583.184078	
倍面積						80.005558		
面 積						40.0027790		

面積計算書（座標法）

世界測地系（測地成果2011）

所在	地番	公簿地目	現況地目	地積	所有者
前橋市六供町四丁目	99-保-6			15.00 m ²	

点名	X座標	Y座標	辺長	方向角	測角	DX	倍積 (Y×DX)
99-19	41328.283	-67618.296	0.744	181-55-28	89-55-42	-0.647	43749.037512
99-113	41327.539	-67618.321	20.291	91-48-17	89-52-49	-1.383	93516.137943
99-114	41326.900	-67598.040	0.744	2-23-21	90-35-04	0.104	-7030.196160
99-20	41327.643	-67598.009	17.512	271-46-37	89-23-16	1.286	-86931.039574
99-35	41328.186	-67615.513	2.785	271-59-46	180-13-09	0.640	-43273.928320
						倍面積	30.011401
						面積	15.0057005

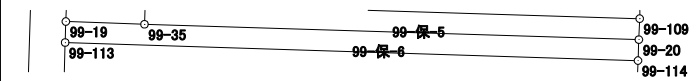


面積計算書（座標法）

世界測地系（測地成果2011）

所 在	地 番	公簿地目	現況地目	地 積	所 有 者
前橋市六供町四丁目	99-保-7			48.00 m ²	

点 名	X 座標	Y 座標	辺 長	方 向 角	測 角	DX	倍 積 (Y×DX)
99-21	41322.863	-67618.476	16.017	181-46-16	89-58-27	-15.915	1076148.045540
99-24	41306.854	-67618.971	2.997	91-47-49	90-01-33	-16.103	1088868.290013
99-130	41306.760	-67615.975	16.017	1-46-16	89-58-27	15.915	-1076108.242125
99-131	41322.769	-67615.480	2.997	271-47-49	90-01-33	16.103	-1088812.074440

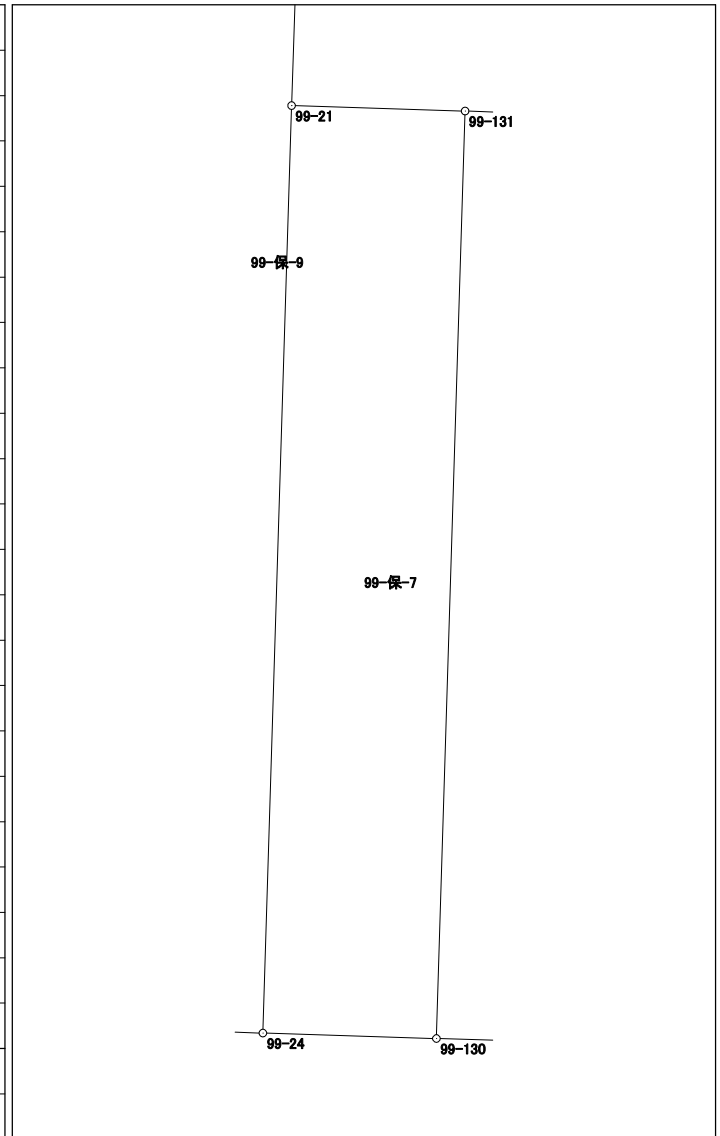

倍面積	96.018988
面 積	48.0094940


面積計算書 (座標法)

世界測地系 (測地成果2011)

所在	地番	公簿地目	現況地目	地積	所有者
前橋市六供町四丁目	99-保-8			15.42 m ²	

点名	X座標	Y座標	辺長	方向角	測角	DX	倍積 (Y×DX)
99-23	41333.789	-67618.122	5.509	181-48-36	89-52-28	-5.411	365881.658142
99-19	41328.283	-67618.296	2.785	91-59-46	90-11-10	-5.603	378865.312488
99-35	41328.186	-67615.513	0.742	2-05-02	90-05-16	0.645	-43612.005885
99-110	41328.928	-67615.486	2.284	2-06-29	180-01-27	3.024	-204469.229664
99-112	41331.210	-67615.402	2.486	2-05-53	179-59-24	4.766	-322255.005932
99-34	41333.694	-67615.311	2.813	271-56-08	89-50-15	2.579	-174379.887069

倍面積	30.842080
面積	15.4210400

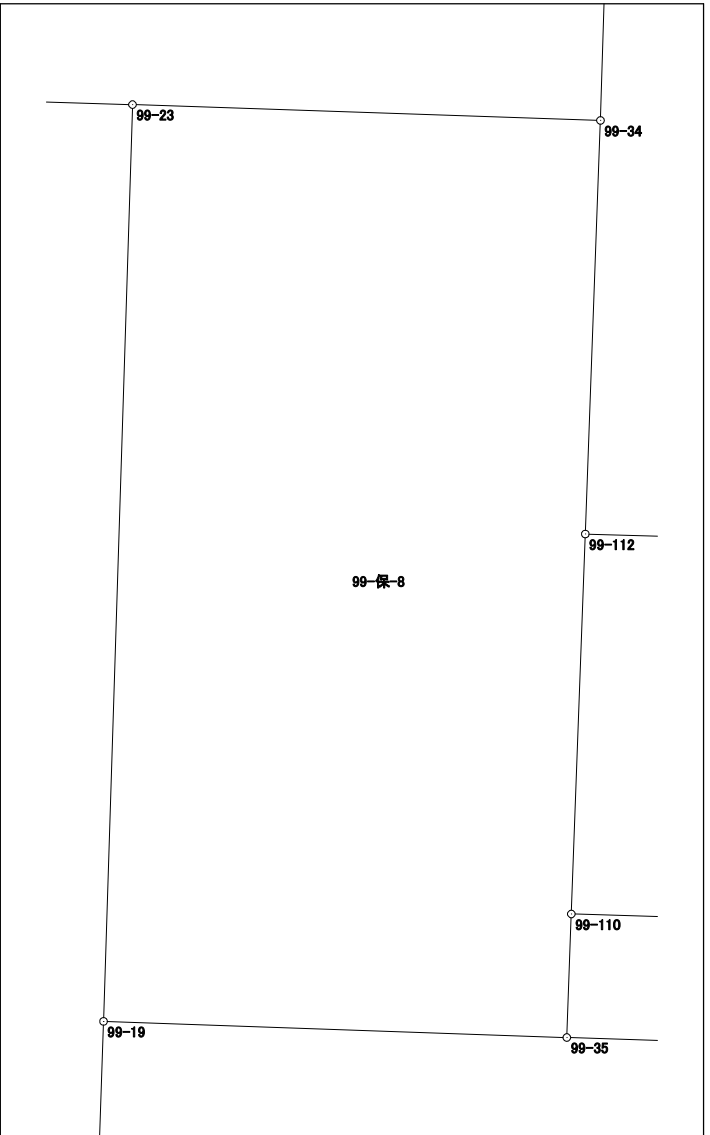


面積計算書 (座標法)

世界測地系 (測地成果2011)

所在	地番	公簿地目	現況地目	地積	所有者
前橋市六供町四丁目	99-保-9			34.00 m ²	

点名	X座標	Y座標	辺長	方向角	測角	DX	倍積 (Y×DX)
99-24	41306.854	-67618.971	16.017	1-46-16	90-08-28	15.973	-1080077.823783
99-21	41322.863	-67618.476	4.679	1-53-55	180-07-39	20.685	-1398688.176060
99-113	41327.539	-67618.321	0.744	1-55-28	180-01-33	5.420	-366491.299820
99-19	41328.283	-67618.296	5.509	1-48-36	179-53-08	6.250	-422614.350000
99-23	41333.789	-67618.122	1.266	271-45-57	89-57-21	5.545	-374942.486490
99-123	41333.828	-67619.387	26.951	181-48-19	90-02-22	-26.899	1818893.890913
99-124	41306.890	-67620.236	1.266	91-37-48	89-49-29	-26.974	1823988.245864

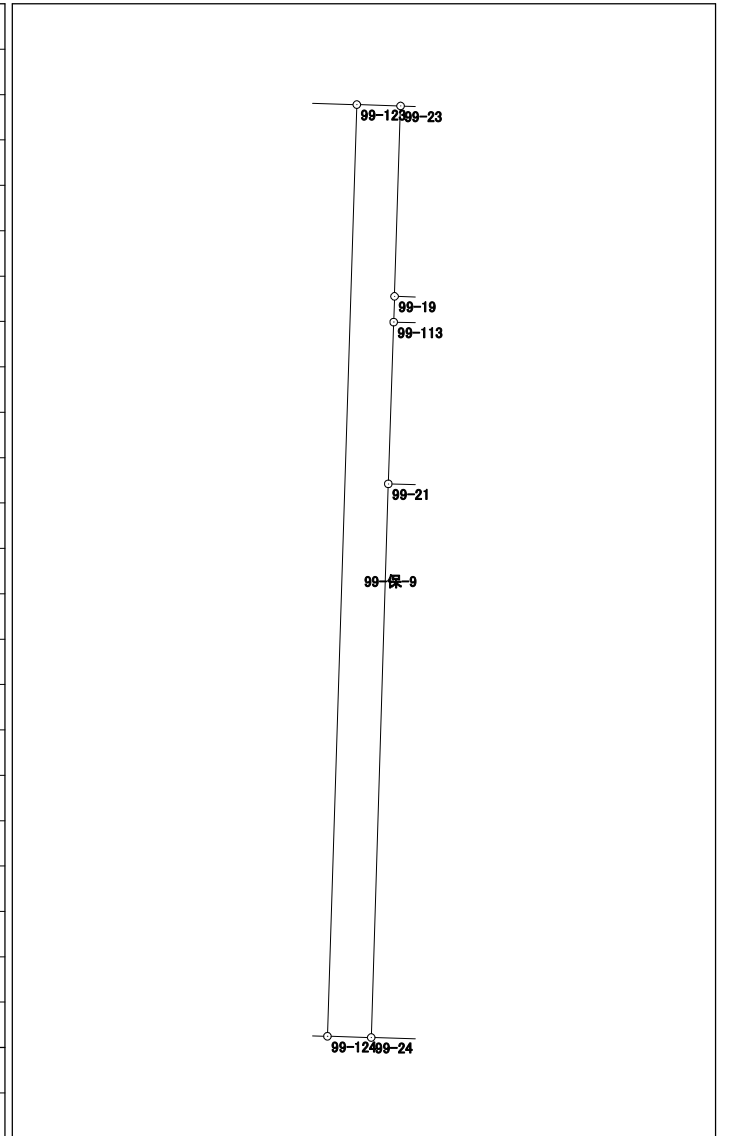


倍面積	68.000624
面積	34.0003120

面積計算書（座標法）

世界測地系（測地成果2011）

所在	地番	公簿地目	現況地目	地積	所有者
前橋市六供町四丁目	99-保-11			28.00 m ²	

点名	X座標	Y座標	辺長	方向角	測角	DX	倍積 (Y×DX)
99-37	41355.061	-67626.676	20.997	181-44-48	89-59-06	-20.946	1416508.355496
99-36	41334.074	-67627.316	1.334	91-45-42	90-00-54	-21.028	1422067.200848
99-103	41334.033	-67625.983	20.997	1-44-48	89-59-06	20.946	-1416493.839918
99-104	41355.020	-67625.343	1.334	271-45-42	90-00-54	21.028	-1422025.712604
						倍面積	56.003822
						面積	28.0019110

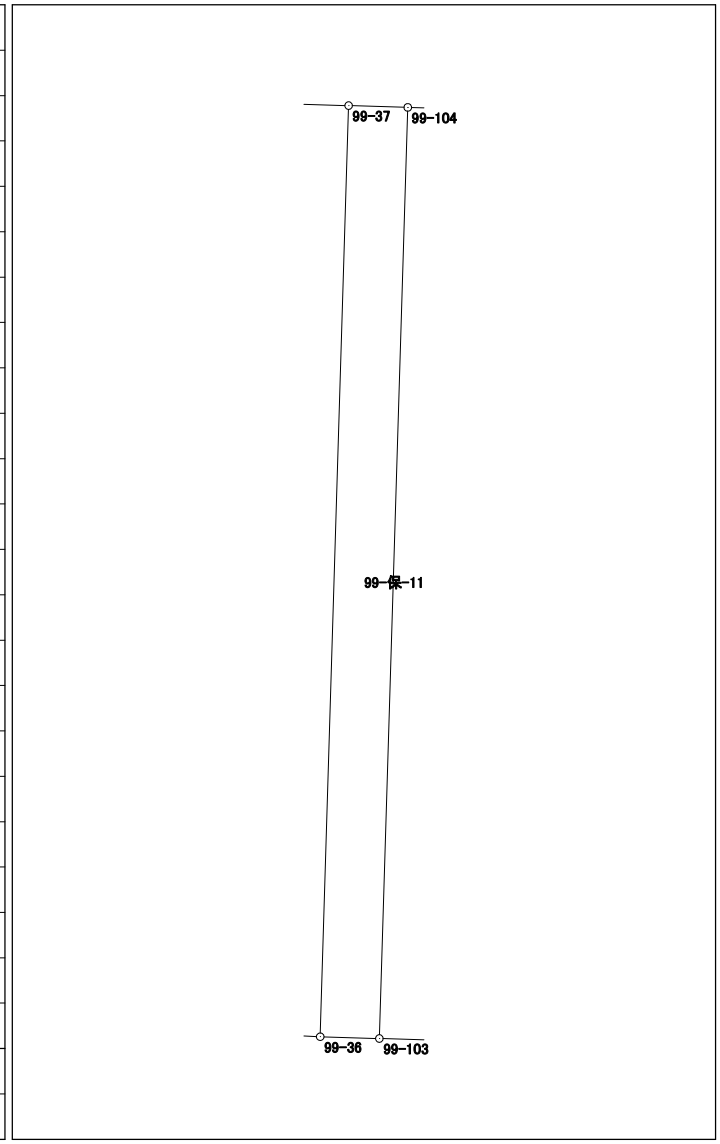


面積計算書 (座標法)

世界測地系 (測地成果2011)

所 在	地 番	公簿地目	現況地目	地 積	所 有 者
前橋市六供町四丁目	99-保-12			62.00 m ²	

点 名	X 座標	Y 座標	辺 長	方 向 角	測 角	DX	倍 積 (Y×DX)
99-117	41307.944	-67654.319	2.301	91-47-35	89-59-37	-27.002	1826801.921638
99-119	41307.872	-67652.019	26.952	1-47-55	90-00-20	26.867	-1817606.794473
99-120	41334.811	-67651.173	2.301	271-34-08	89-46-13	27.002	-1826716.973346
99-118	41334.874	-67653.473	26.943	181-47-58	90-13-50	-26.867	1817645.859091
						倍面積	124.012910
						面 積	62.0064550

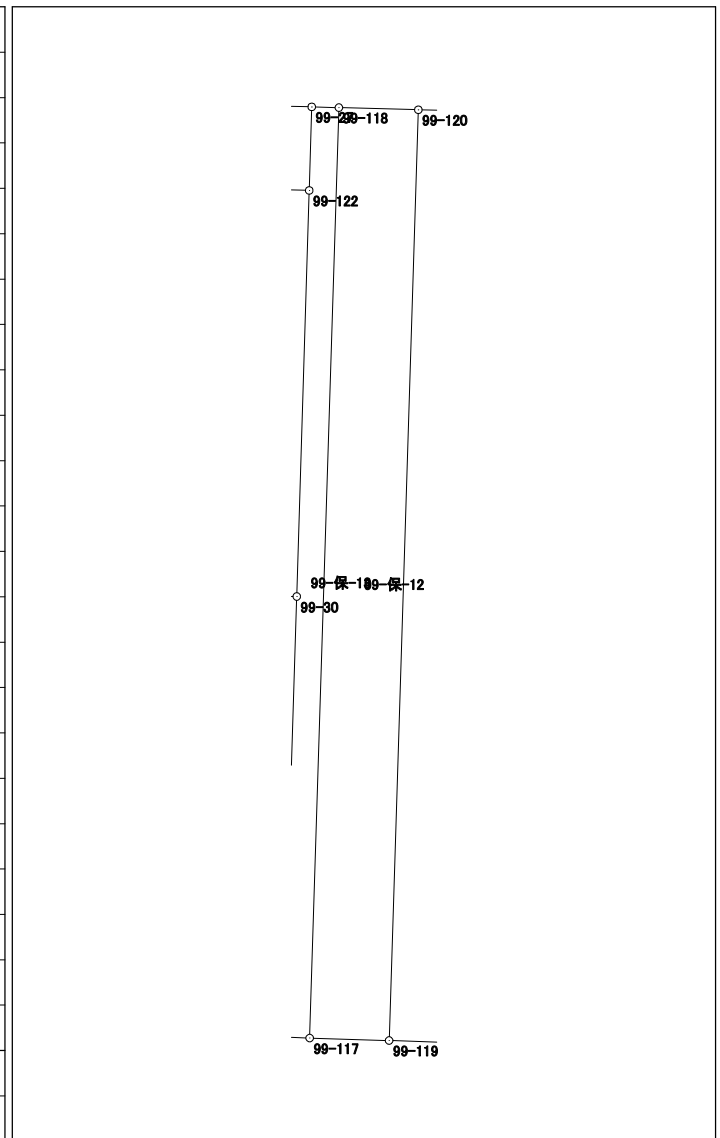


面積計算書 (座標法)

世界測地系 (測地成果2011)

所 在	地 番	公簿地目	現況地目	地 積	所 有 者
前橋市六供町四丁目	99-保-13			21.00 m ²	

点 名	X 座標	Y 座標	辺 長	方 向 角	測 角	DX	倍 積 (Y×DX)
99-27	41334.895	-67654.259	2.420	181-43-43	90-11-53	-2.398	162234.913082
99-122	41332.476	-67654.332	11.759	181-45-16	180-01-33	-14.172	958797.193104
99-30	41320.723	-67654.692	12.762	181-51-00	180-05-44	-24.508	1658081.191536
99-28	41307.968	-67655.104	0.785	91-45-04	89-54-04	-12.779	864564.574016
99-117	41307.944	-67654.319	26.943	1-47-58	90-02-54	26.906	-1820307.107014
99-118	41334.874	-67653.473	0.786	271-31-50	89-43-52	26.951	-1823328.750823
						倍面積	42.013901
						面 積	21.0069505

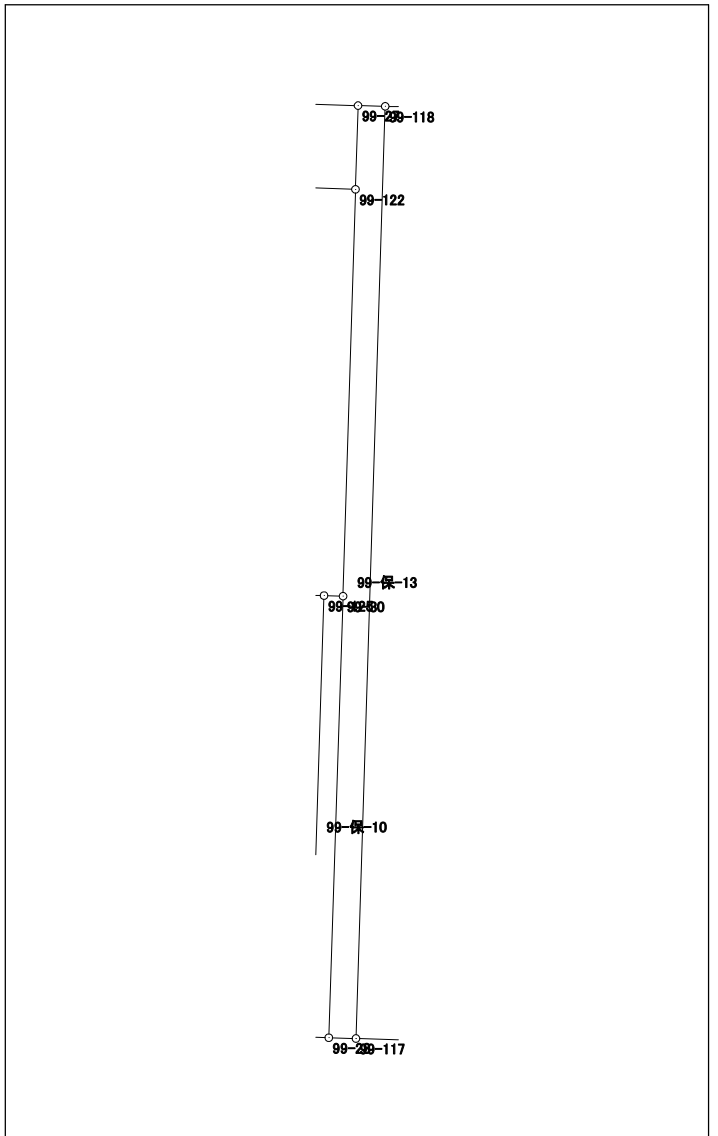


面積計算書 (座標法)

世界測地系 (測地成果2011)

所在	地番	公簿地目	現況地目	地積	所有者
前橋市六供町四丁目	99-保-14			90.00 m ²	

点名	X座標	Y座標	辺長	方向角	測角	DX	倍積 (Y×DX)
99-40	41335.098	-67660.526	21.016	1-47-59	89-54-48	20.865	-1411736.874990
99-41	41356.104	-67659.866	4.283	271-48-22	90-00-23	21.141	-1430397.227106
99-101	41356.239	-67664.147	21.010	181-48-00	89-59-38	-20.865	1411812.427155
99-102	41335.239	-67664.807	4.283	91-53-11	90-05-11	-21.141	1430501.684787

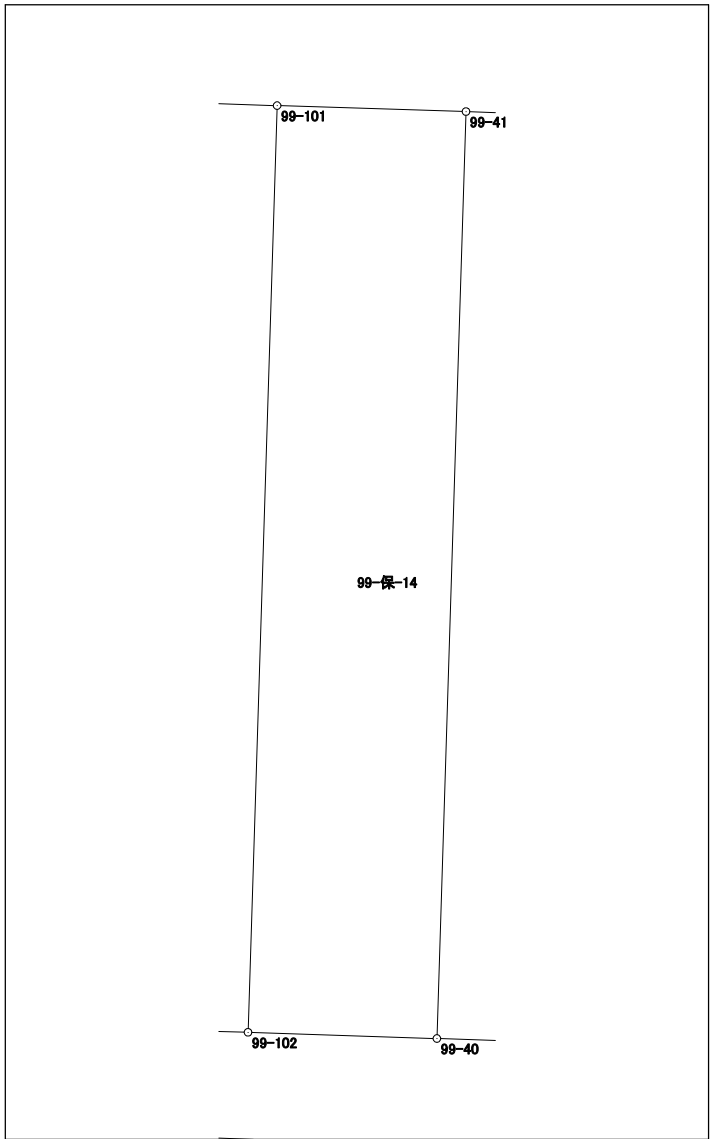

倍面積	180.009846
面積	90.0049230