


9 街区画地出来形確認図 (1/3)


(19932.61m<sup>2</sup>)




S=1/500

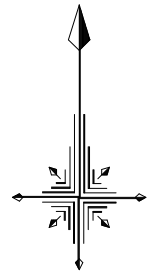


# 9 街区 画地出来形確認図 (2/3) (19932.61m<sup>2</sup>)

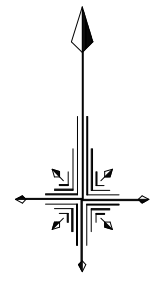

S=1/500

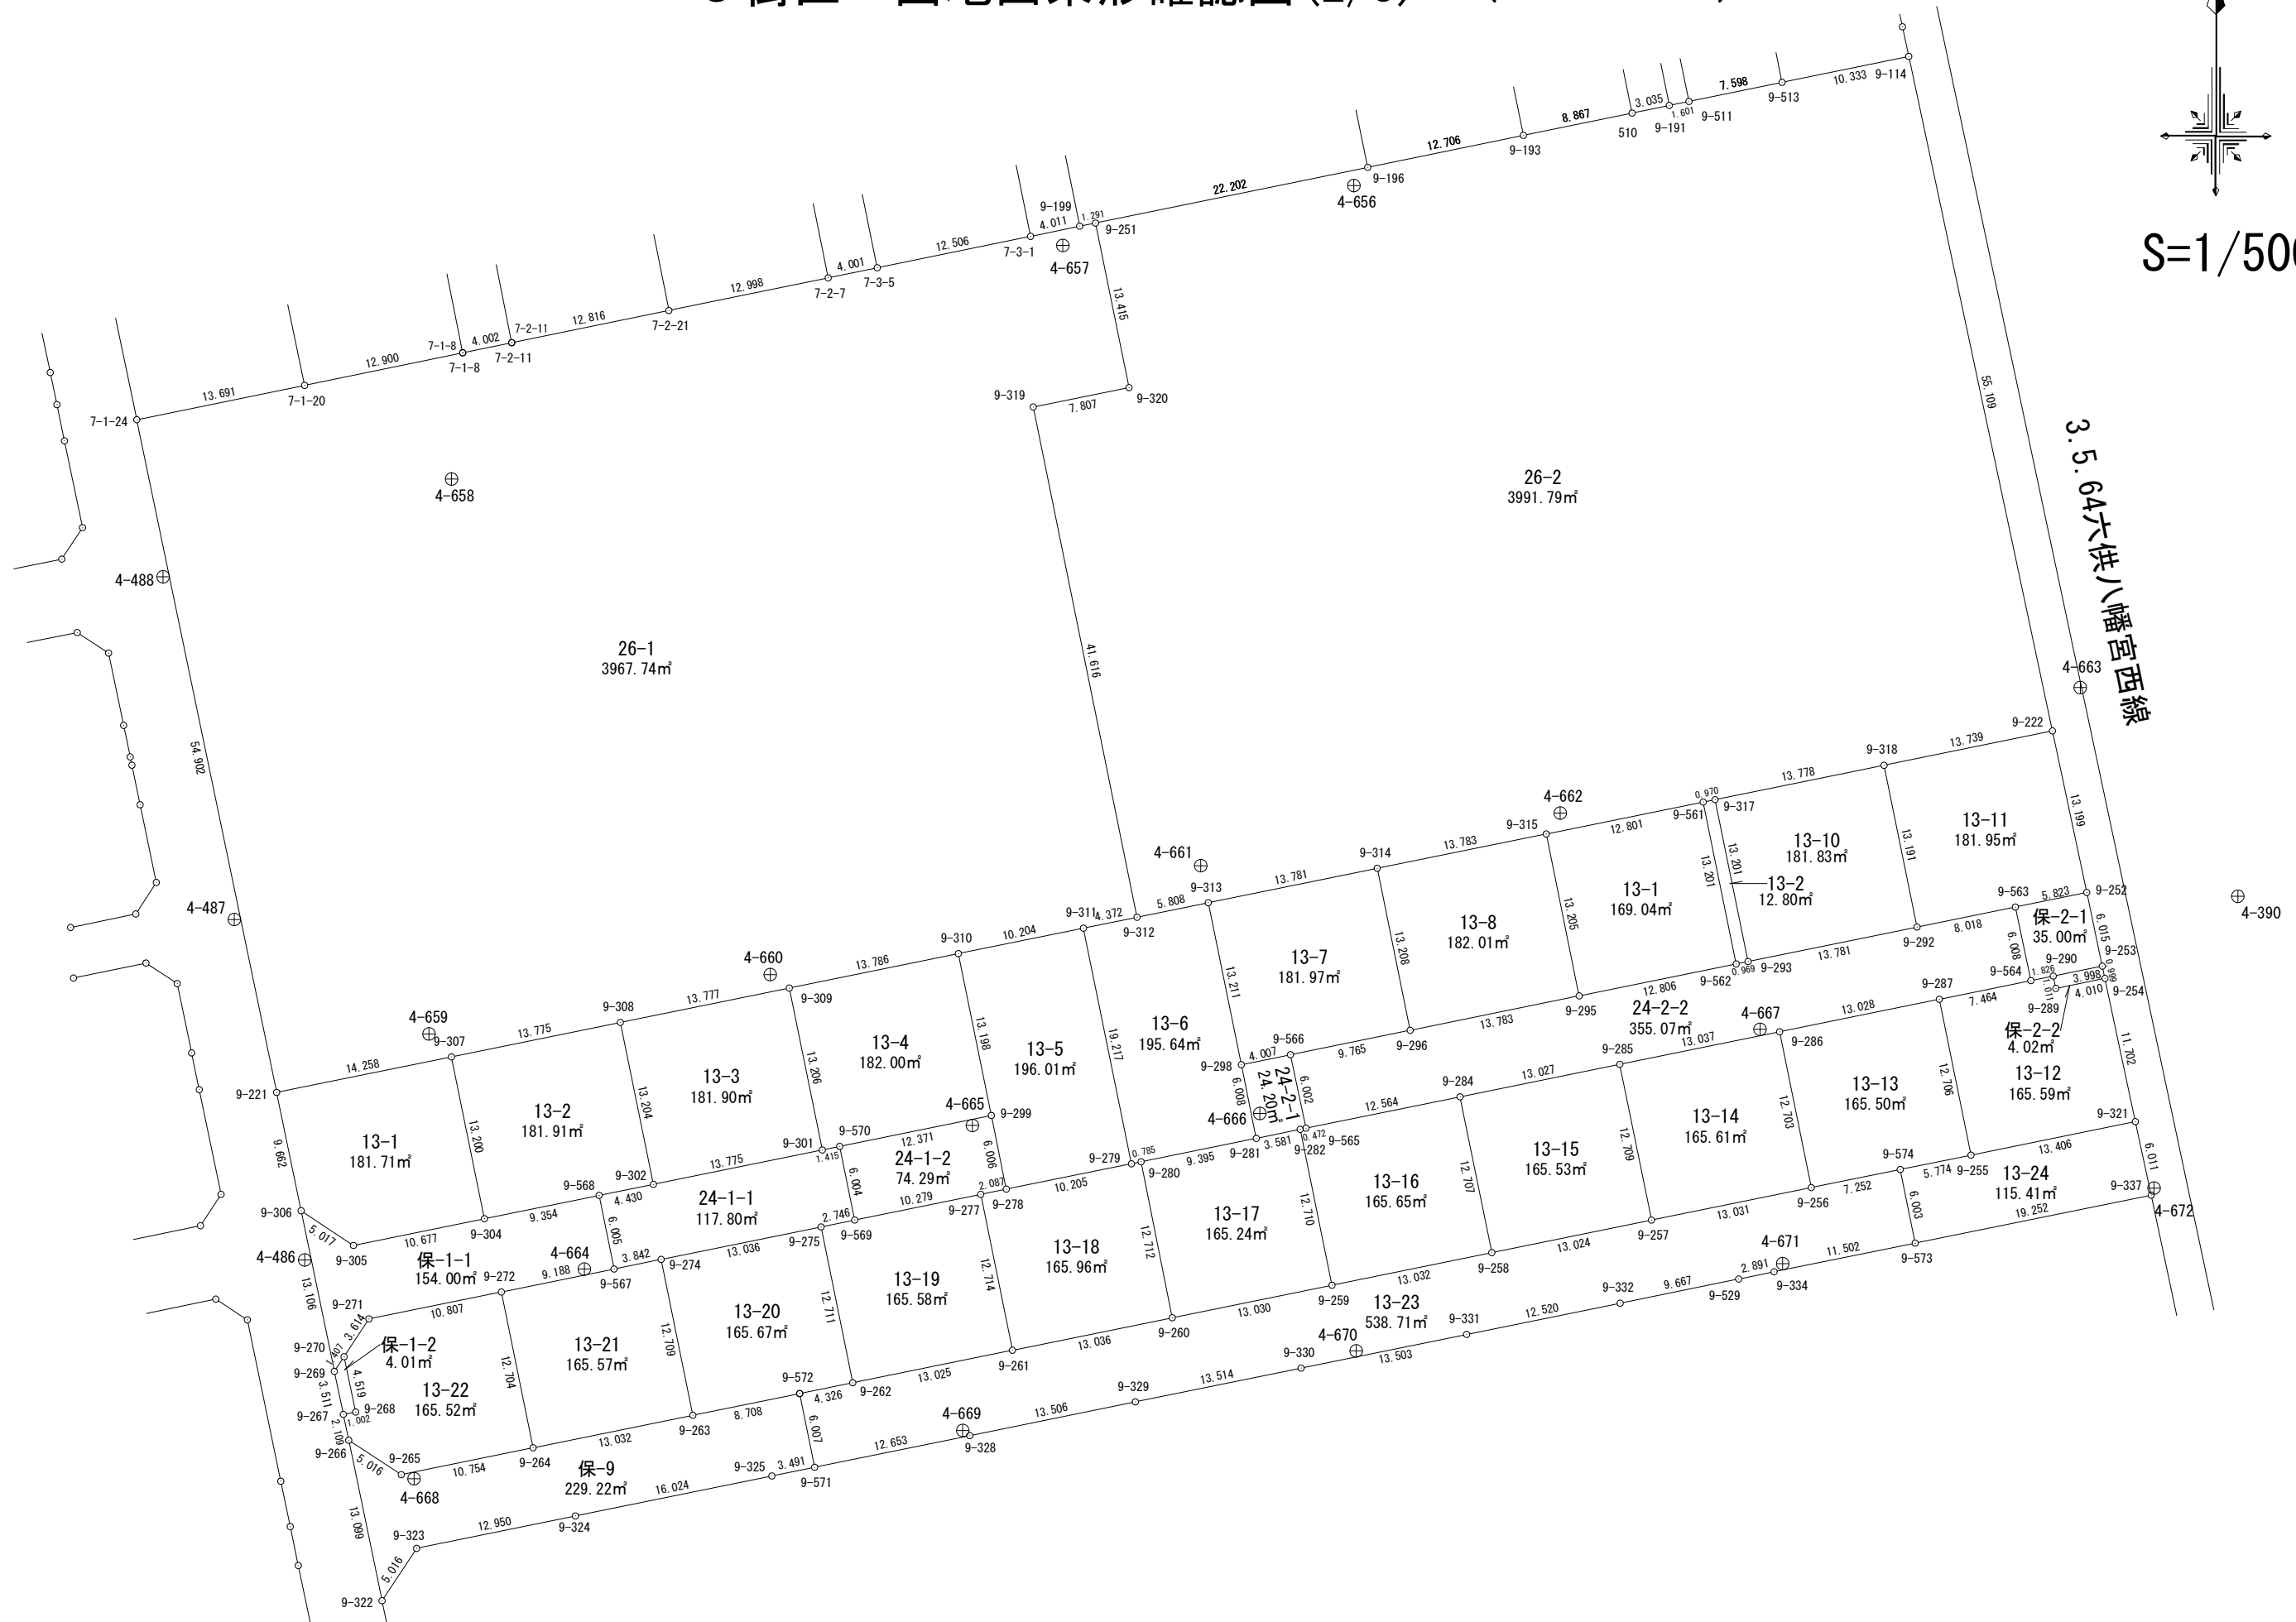

# 9 街区 画地出来形確認図 (3/3) (19932.61m<sup>2</sup>)

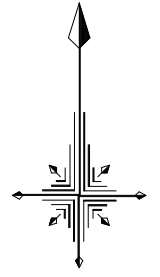

S=1/500




# 面積計算書（座標法）

世界測地系（測地成果2011）

所 在	地 番	公簿地目	現況地目	地 積	所 有 者
前橋市六供町一丁目	9-1			181.65 m <sup>2</sup>	

点 名	X 座標	Y 座標	辺 長	方 向 角	測 角	DX	倍 積 (Y×DX)
9-517	41934.735	-68305.736	6.894	348-23-07	90-00-16	8.919	-609218.859384
9-520	41941.488	-68307.124	10.240	348-22-58	179-59-51	16.783	-1146398.462092
9-185	41951.518	-68309.186	8.552	258-37-47	90-14-49	8.344	-569971.847984
9-177	41949.832	-68317.570	3.001	213-52-31	135-14-44	-4.178	285430.807460
9-176	41947.340	-68319.243	15.067	168-37-12	134-44-41	-17.263	1179395.091909
9-518	41932.569	-68316.270	10.754	78-22-51	89-45-39	-12.605	861126.583350
倍面積							363.313259
面 積							181.6566295

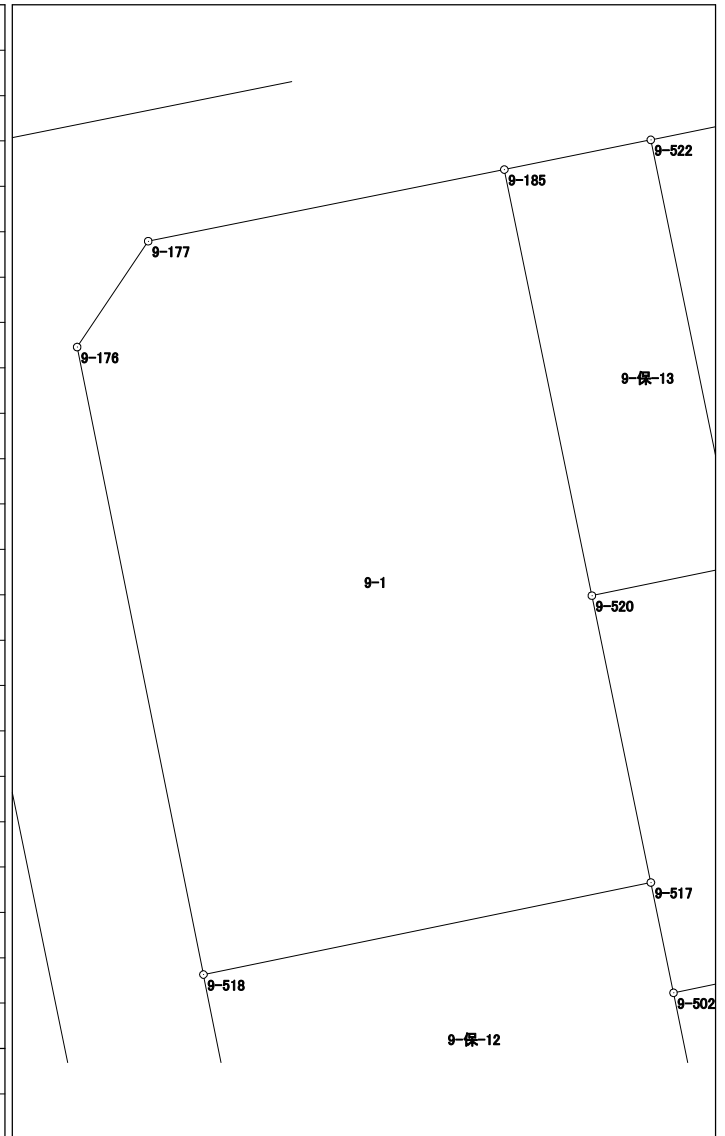


# 面積計算書 (座標法)

世界測地系 (測地成果2011)

所在	地番	公簿地目	現況地目	地積	所有者
前橋市六供町一丁目	9-2			89.61 m <sup>2</sup>	

点名	X座標	Y座標	辺長	方向角	測角	DX	倍積 (Y×DX)	
9-521	41942.199	-68303.679	8.930	78-20-43	89-57-30	-8.215	561114.722985	
9-519	41944.003	-68294.933	8.430	348-20-41	89-59-58	10.060	-687047.025980	
9-179	41952.259	-68296.636	2.504	303-31-53	135-11-12	9.639	-658311.274404	
9-178	41953.642	-68298.723	7.158	258-31-31	134-59-38	-0.041	2800.247643	
9-522	41952.218	-68305.738	10.228	168-23-13	89-51-42	-11.443	781622.559934	
							倍面積	179.230178
							面積	89.6150890

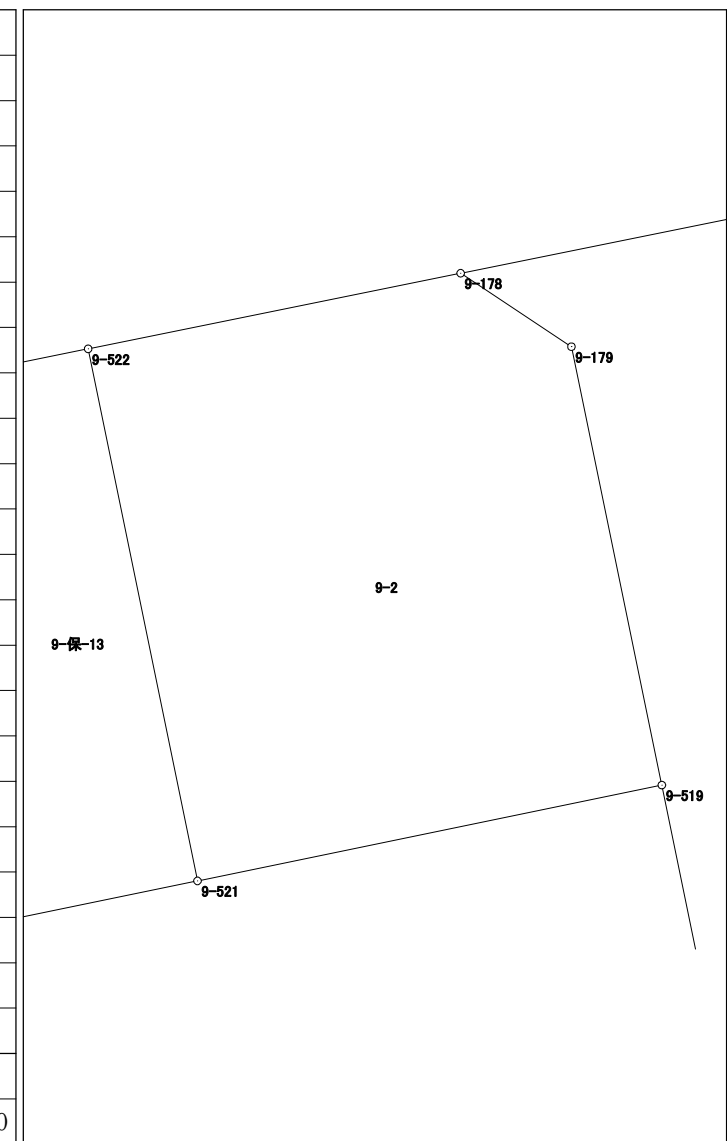


# 面積計算書 (座標法)

世界測地系 (測地成果2011)

所 在	地 番	公簿地目	現況地目	地 積	所 有 者
前橋市六供町一丁目	9-3			118.84 m <sup>2</sup>	

点 名	X 座標	Y 座標	辺 長	方 向 角	測 角	D X	倍 積 (Y×DX)
9-502	41932.139	-68305.202	12.454	78-20-40	89-58-05	-0.080	5464.416160
9-501	41934.655	-68293.005	9.545	348-20-47	90-00-07	11.864	-810228.211320
9-519	41944.003	-68294.933	8.930	258-20-43	89-59-56	7.544	-515216.974552
9-521	41942.199	-68303.679	3.518	258-20-19	179-59-36	-2.515	171783.752685
9-520	41941.488	-68307.124	6.894	168-23-07	90-02-48	-7.464	509844.373536
9-517	41934.735	-68305.736	2.650	168-22-35	179-59-28	-9.349	638590.325864

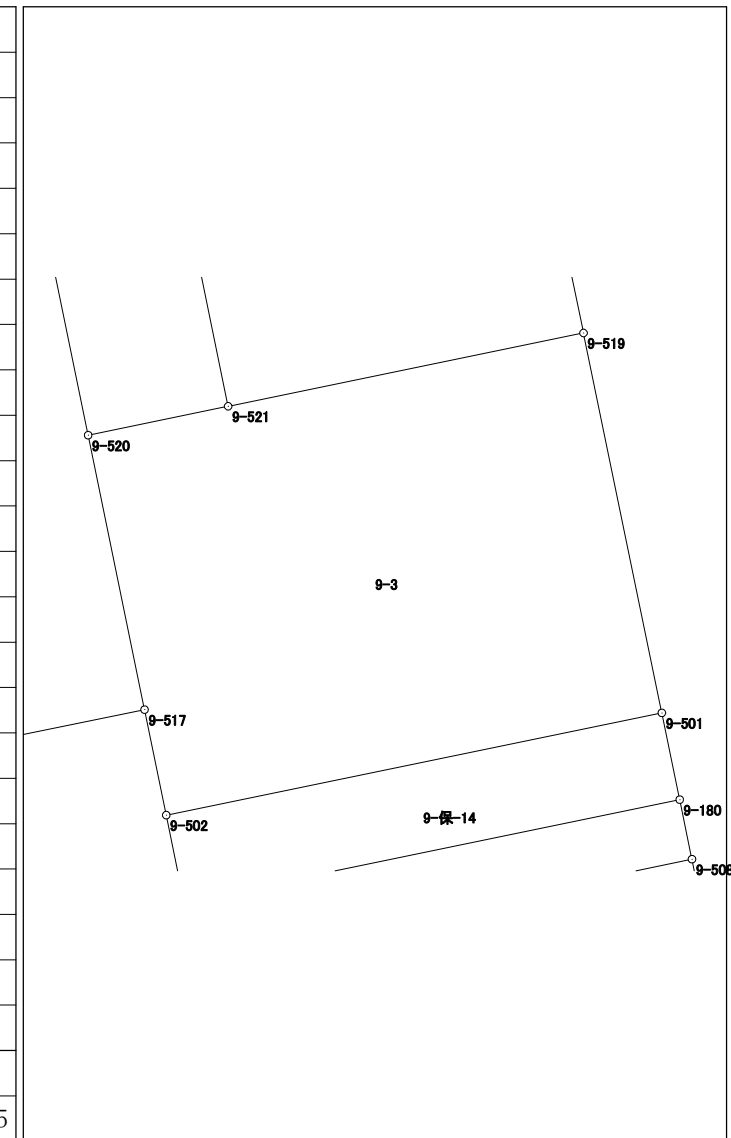


倍面積	237.682373
面積	118.8411865

# 面積計算書 (座標法)

世界測地系 (測地成果2011)

所在	地番	公簿地目	現況地目	地積	所有者
前橋市六供町一丁目	9-4			447.08 m <sup>2</sup>	

点名	X座標	Y座標	辺長	方向角	測角	Dx	倍積 (Y×Dx)
9-507	41927.001	-68311.937	10.379	168-20-37	89-59-15	-14.219	971327.432203
9-503	41916.836	-68309.840	2.666	168-20-10	179-59-33	-12.776	872726.515840
9-194	41914.225	-68309.301	7.734	78-39-55	90-19-45	-1.091	74525.447391
9-197	41915.745	-68301.718	2.287	168-29-54	269-49-59	-0.721	49245.538678
9-506	41913.504	-68301.262	12.306	168-29-34	179-59-40	-14.300	976708.046600
9-196	41901.445	-68298.807	12.706	78-23-25	89-53-51	-9.502	648975.264114
9-193	41904.002	-68286.361	11.868	348-26-28	90-03-03	14.184	-968573.744424
9-192	41915.629	-68288.739	0.345	258-27-43	90-01-15	11.558	-789281.245362
9-173	41915.560	-68289.077	15.819	348-22-39	269-54-56	15.426	-1053427.301802
9-508	41931.055	-68292.264	20.086	258-21-22	89-58-43	11.441	-781331.792424
						倍面積	894.160814
						面積	447.0804070

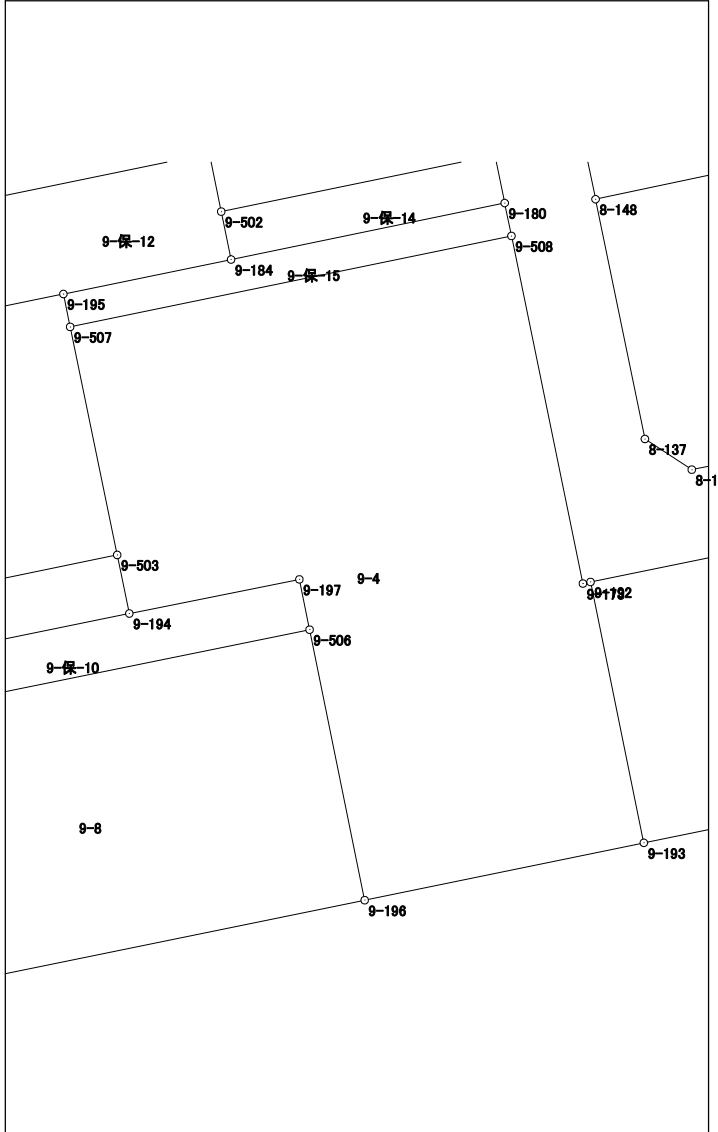


# 面積計算書 (座標法)

世界測地系 (測地成果2011)

所在	地番	公簿地目	現況地目	地積	所有者
前橋市六供町一丁目	9-5			105.20 m <sup>2</sup>	

点名	X座標	Y座標	辺長	方向角	測角	DX	倍積 (Y×DX)
9-509	41917.405	-68280.052	8.867	258-26-44	90-00-13	9.847	-672353.672044
9-192	41915.629	-68288.739	11.868	168-26-28	89-59-44	-13.403	915273.968817
9-193	41904.002	-68286.361	8.867	78-25-08	89-58-40	-9.847	672415.796767
9-510	41905.782	-68277.675	11.864	348-26-31	90-01-23	13.403	-915125.678025

倍面積	210.415515
面積	105.2077575

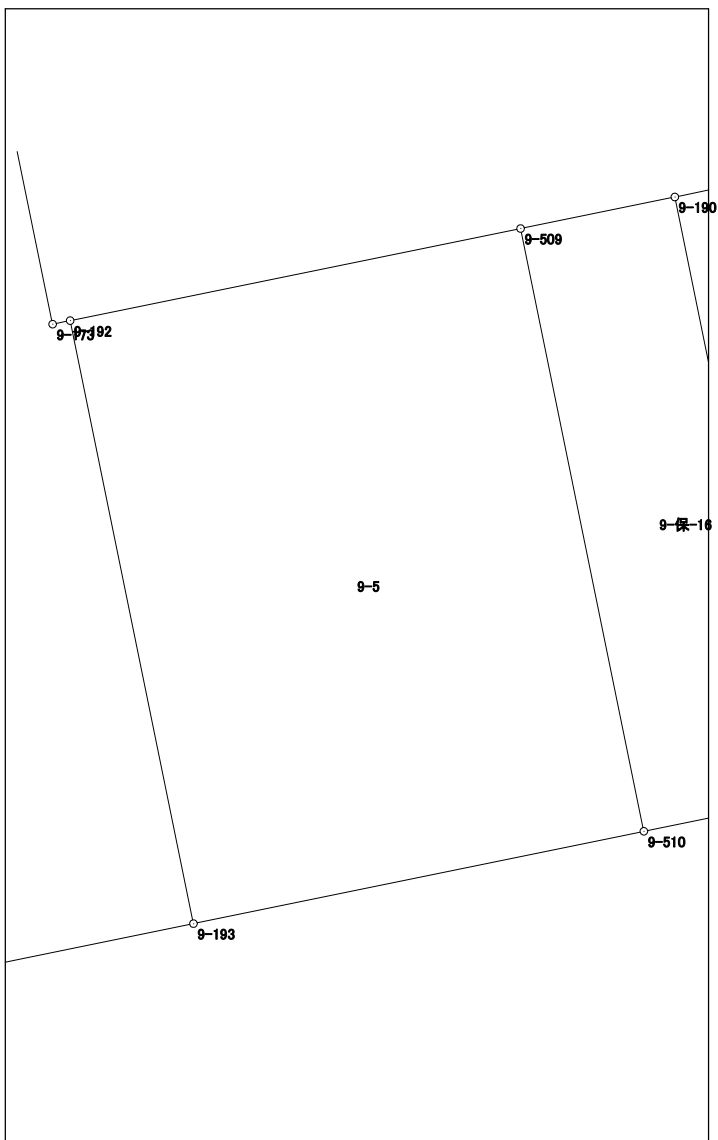




# 面積計算書 (座標法)

世界測地系 (測地成果2011)

所在	地番	公簿地目	現況地目	地積	所有者
前橋市六供町一丁目	9-6			90.11 m <sup>2</sup>	

点名	X座標	Y座標	辺長	方向角	測角	DX	倍積 (Y×DX)
9-511	41906.712	-68273.133	7.598	78-25-15	89-58-14	-10.097	689353.823901
9-513	41908.237	-68265.690	2.422	348-26-56	90-01-41	3.898	-266099.659620
9-516	41910.610	-68266.175	9.438	348-26-54	179-59-58	11.620	-793252.953500
9-514	41919.857	-68268.065	7.597	258-26-08	89-59-14	7.724	-527302.534060
9-512	41918.334	-68275.508	11.862	168-27-01	90-00-53	-13.145	897481.552660
						倍面積	180.229381
						面積	90.1146905

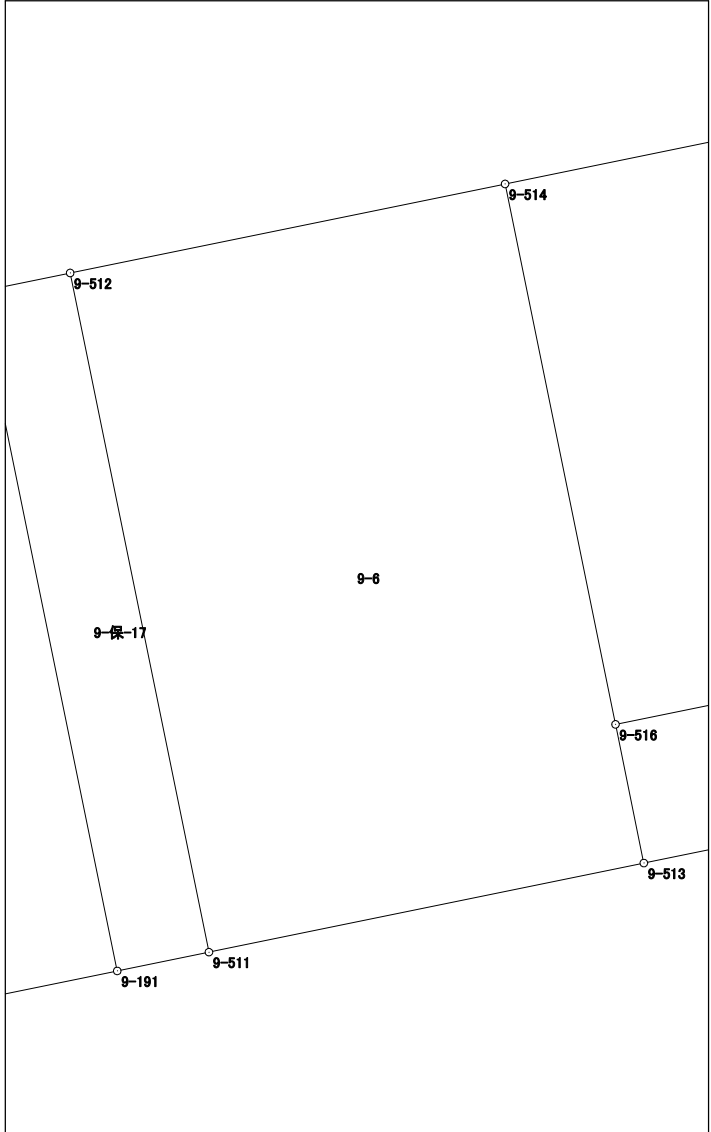


# 面積計算書（座標法）

世界測地系（測地成果2011）

所在	地番	公簿地目	現況地目	地積	所有者
前橋市六供町一丁目	9-7			97.06 m <sup>2</sup>	

点名	X座標	Y座標	辺長	方向角	測角	DX	倍積 (Y×DX)
9-515	41912.680	-68256.068	9.437	348-04-07	89-38-36	11.303	-771498.336604
9-171	41921.913	-68258.019	10.254	258-26-01	90-21-54	7.177	-489887.802363
9-514	41919.857	-68268.065	9.438	168-26-54	90-00-53	-11.303	771633.938695
9-516	41910.610	-68266.175	10.317	78-25-31	89-58-37	-7.177	489946.337975

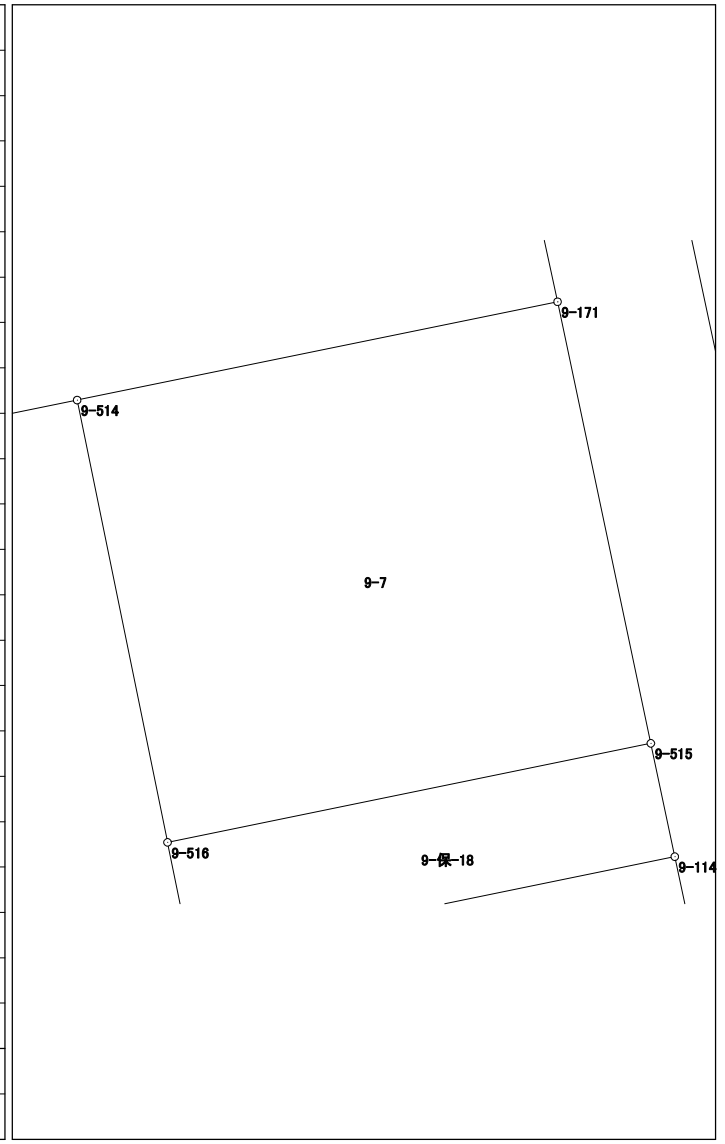

倍面積	194.137703
面積	97.0688515

# 面積計算書（座標法）

世界測地系（測地成果2011）

所在	地番	公簿地目	現況地目	地積	所有者
前橋市六供町一丁目	9-8			289.34 m <sup>2</sup>	

点名	X座標	Y座標	辺長	方向角	測角	DX	倍積 (Y×DX)	
9-505	41908.815	-68324.279	12.317	168-30-27	90-01-20	-16.759	1145046.591761	
9-199	41896.745	-68321.825	1.291	78-55-30	90-25-03	-11.822	807700.615150	
9-251	41896.993	-68320.558	22.202	78-25-57	179-30-27	4.700	-321106.622600	
9-196	41901.445	-68298.807	12.306	348-29-34	90-03-37	16.511	-1127681.602377	
9-506	41913.504	-68301.262	23.490	258-29-07	89-59-33	7.370	-503380.300940	
倍面積							578.680994	
面積							289.3404970	


# 面積計算書 (座標法)

世界測地系 (測地成果2011)

所在	地番	公簿地目	現況地目	地積	所有者
前橋市六供町一丁目	9-9			107.46 m <sup>2</sup>	

点名	X座標	Y座標	辺長	方向角	測角	DX	倍積 (Y×DX)
9-553	41772.239	-68247.446	5.499	347-57-38	89-48-09	7.502	-511992.339892
9-362	41777.617	-68248.593	1.945	348-00-51	180-03-13	7.281	-496918.005633
9-558	41779.520	-68248.997	2.967	347-59-49	179-58-58	4.805	-327936.430585
9-542	41782.422	-68249.614	10.314	258-03-33	90-03-44	0.768	-52415.703552
9-541	41780.288	-68259.705	10.393	168-10-47	90-07-14	-12.307	840072.189435
9-554	41770.115	-68257.576	10.350	78-09-29	89-58-42	-8.049	549405.229224

倍面積	214.938997
面積	107.4694985

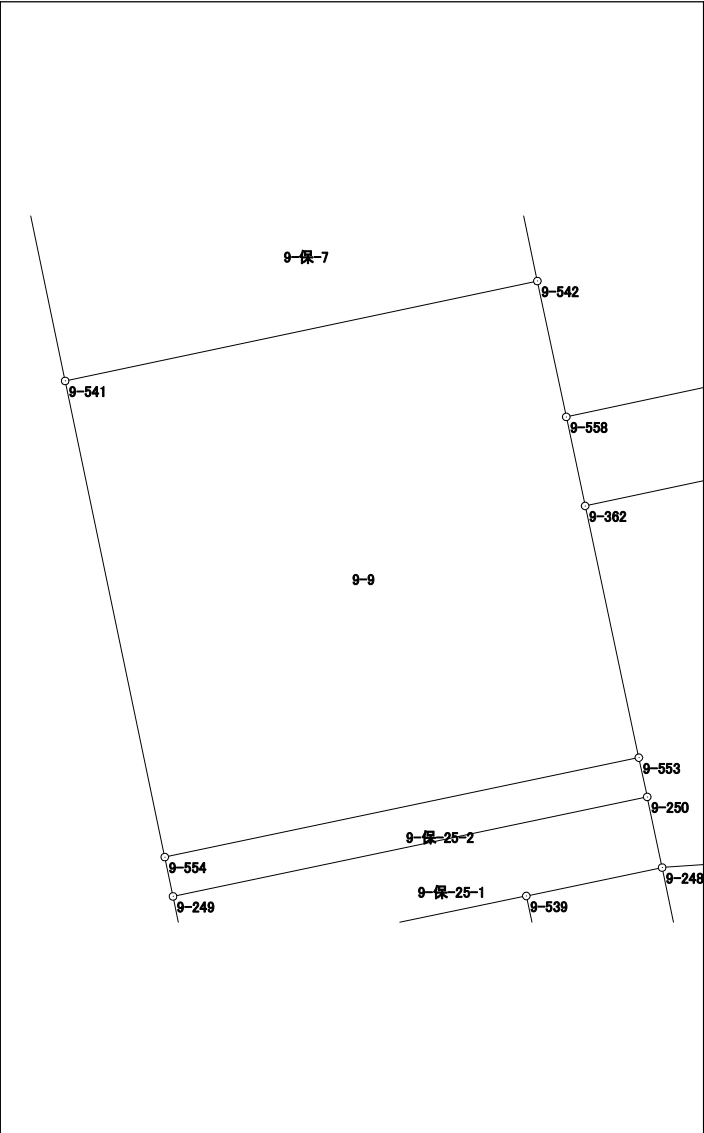


## 面積計算書（座標法）

世界測地系（測地成果2011）

所 在	地 番	公簿地目	現況地目	地 積	所 有 者
前橋市六供町一丁目	9-10			83.12 m <sup>2</sup>	


点 名	X 座標	Y 座標	辺 長	方向 角	測 角	DX	倍 積 (Y×DX)
9-247	41767.772	-68257.083	9.394	168-10-07	90-18-37	-9.697	661888.933851
9-165	41758.578	-68255.157	3.004	123-05-13	134-55-06	-10.834	739476.370938
9-166	41756.938	-68252.640	5.315	77-58-39	134-53-26	-0.533	36378.657120
9-540	41758.045	-68247.442	11.494	347-54-08	89-55-29	12.346	-842582.918932
9-539	41769.284	-68249.851	4.997	258-21-02	90-26-54	10.230	-698195.975730
9-575	41768.275	-68254.745	2.391	257-51-30	179-30-28	-1.512	103201.174440
						倍面積	166.241687
						面 積	83.1208435

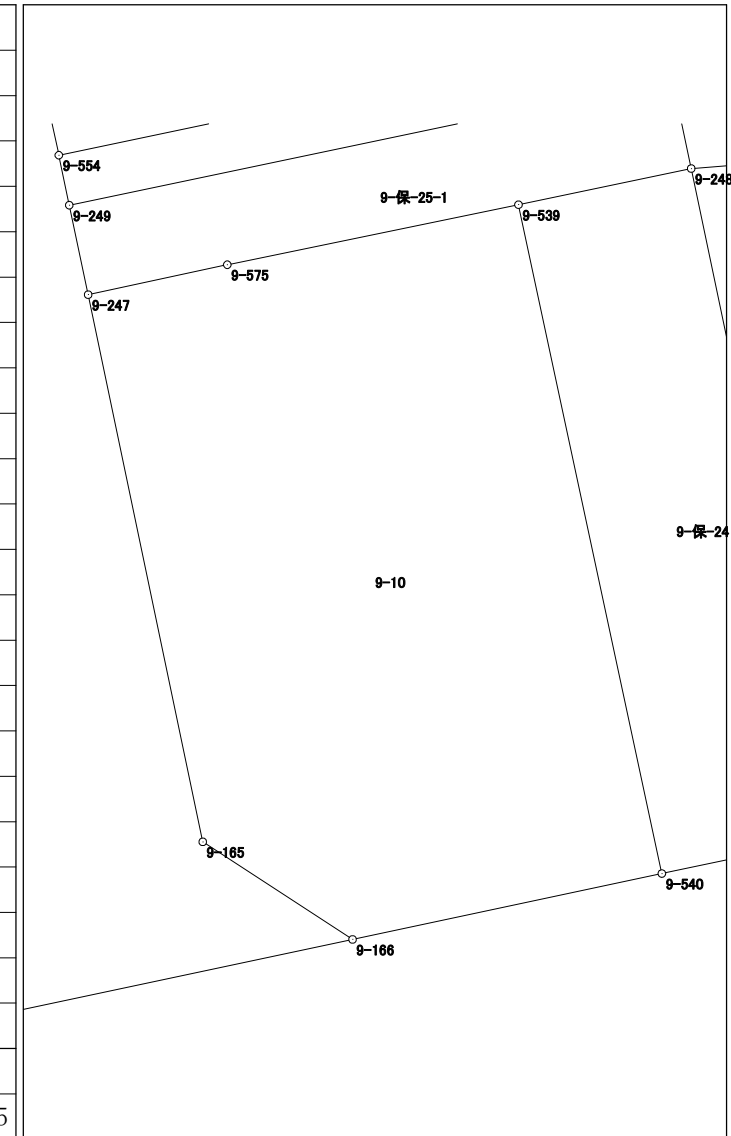

# 面積計算書（座標法）

世界測地系（測地成果2011）

所 在	地 番	公簿地目	現況地目	地 積	所 有 者
前橋市六供町一丁目	9-11			68.01 m <sup>2</sup>	

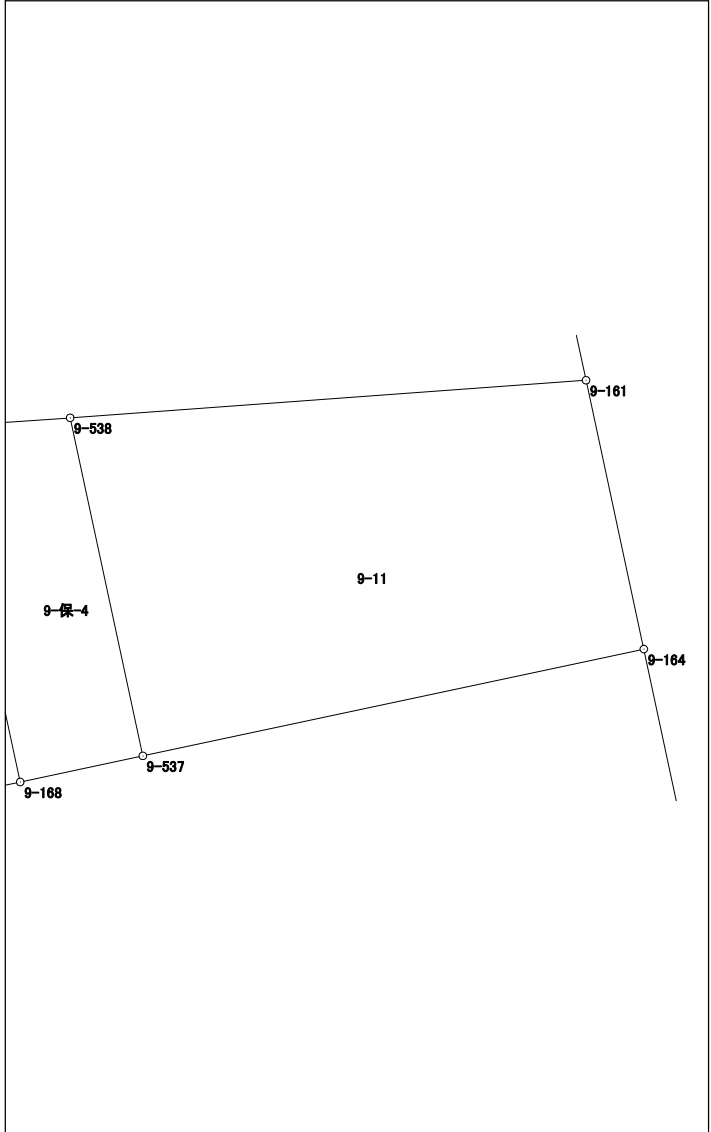
点 名	X 座標	Y 座標	辺 長	方 向 角	測 角	DX	倍 積 (Y×DX)	
9-537	41760.788	-68234.571	10.596	77-58-20	90-06-20	-4.783	326365.953093	
9-164	41762.996	-68224.208	5.687	347-51-37	89-53-17	7.768	-529965.647744	
9-161	41768.556	-68225.404	10.698	265-50-06	97-58-29	4.783	-326322.107332	
9-538	41767.779	-68236.074	7.151	167-52-00	82-01-54	-7.768	530057.822832	
						倍面積	136.020849	
						面 積	68.0104245	

# 面積計算書（座標法）

世界測地系（測地成果2011）

所在	地番	公簿地目	現況地目	地積	所有者
前橋市六供町一丁目	9-12			48.06 m <sup>2</sup>	

点名	X座標	Y座標	辺長	方向角	測角	Dx	倍積 (Y×Dx)
9-543	41767.461	-68240.402	5.959	265-45-22	97-54-13	7.127	-486349.345054
9-162	41767.020	-68246.345	8.549	167-49-31	82-04-09	-8.798	600431.343310
9-163	41758.663	-68244.542	5.899	77-57-51	90-08-20	-7.127	486378.850834
9-544	41759.893	-68238.773	7.741	347-51-09	89-53-18	8.798	-600364.724854

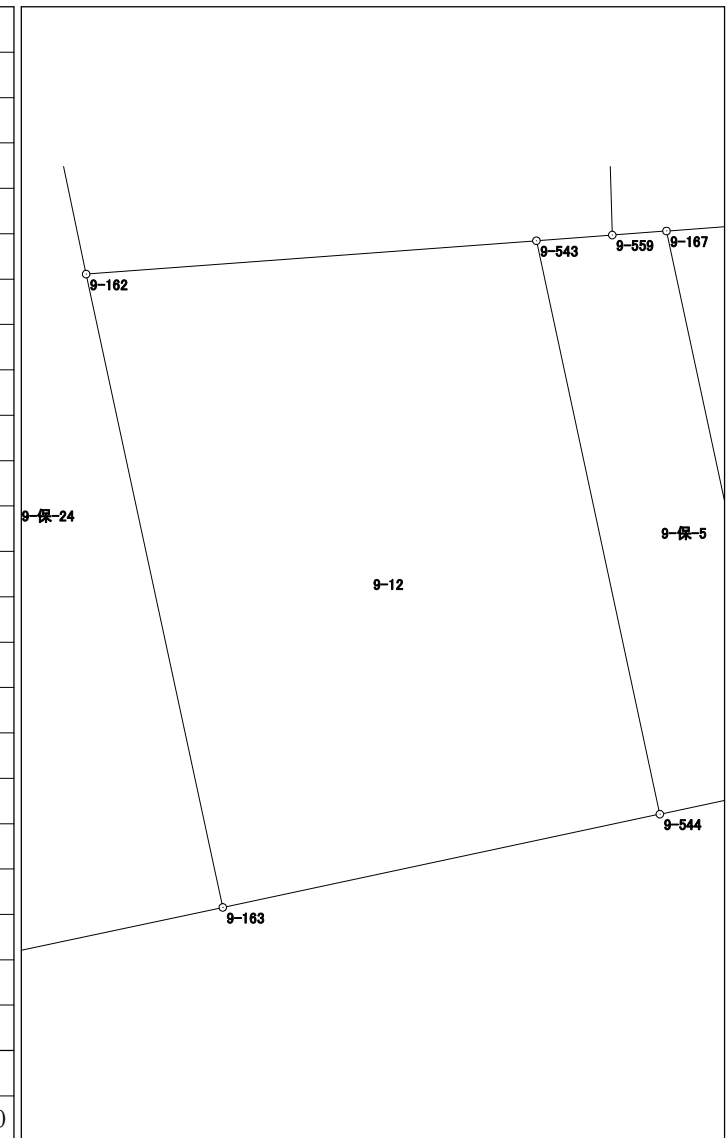

倍面積	96.124236
面積	48.0621180

## 面積計算書（座標法）

世界測地系（測地成果2011）

所在	地番	公簿地目	現況地目	地積	所有者
前橋市六供町一丁目	9-13-1			181.71 m <sup>2</sup>	

点名	X座標	Y座標	辺長	方向角	測角	DX	倍積 (Y×DX)
9-221	41827.527	-68386.003	9.662	168-17-45	89-47-22	-12.302	841284.608906
9-306	41818.066	-68384.043	5.017	123-30-46	135-13-01	-12.231	836405.229933
9-305	41815.296	-68379.860	10.677	78-27-16	134-56-30	-0.633	43284.451380
9-304	41817.433	-68369.399	13.200	348-29-55	90-02-39	15.072	-1030463.581728
9-307	41830.368	-68372.031	14.258	258-30-23	90-00-28	10.094	-690147.280914
						倍面積	363.427577
						面積	181.7137885




# 面積計算書 (座標法)

世界測地系 (測地成果2011)

所在	地番	公簿地目	現況地目	地積	所有者
前橋市六供町一丁目	9-13-2			181.91 m <sup>2</sup>	


点名	X座標	Y座標	辺長	方向角	測角	DX	倍積 (Y×DX)
9-307	41830.368	-68372.031	13.200	168-29-55	90-01-05	-15.686	1072483.678266
9-304	41817.433	-68369.399	9.354	78-29-35	89-59-40	-11.069	756780.877531
9-568	41819.299	-68360.233	4.430	78-30-09	180-00-34	2.749	-187922.280517
9-302	41820.182	-68355.892	13.204	348-27-43	89-57-34	13.820	-944678.427440
9-308	41833.119	-68358.533	13.775	258-28-50	90-01-07	10.186	-696300.017138
						倍面積	363.830702
						面積	181.9153510

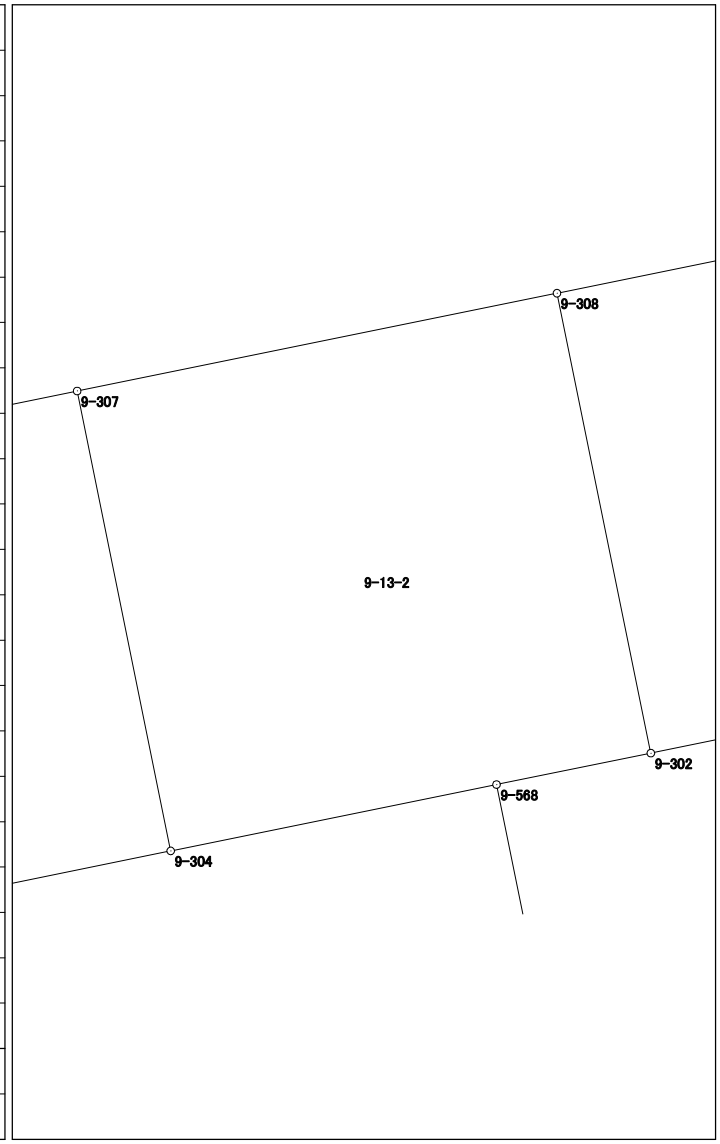

# 面積計算書（座標法）

世界測地系（測地成果2011）

所 在	地 番	公簿地目	現況地目	地 積	所 有 者
前橋市六供町一丁目	9-13-3			181.90 m <sup>2</sup>	

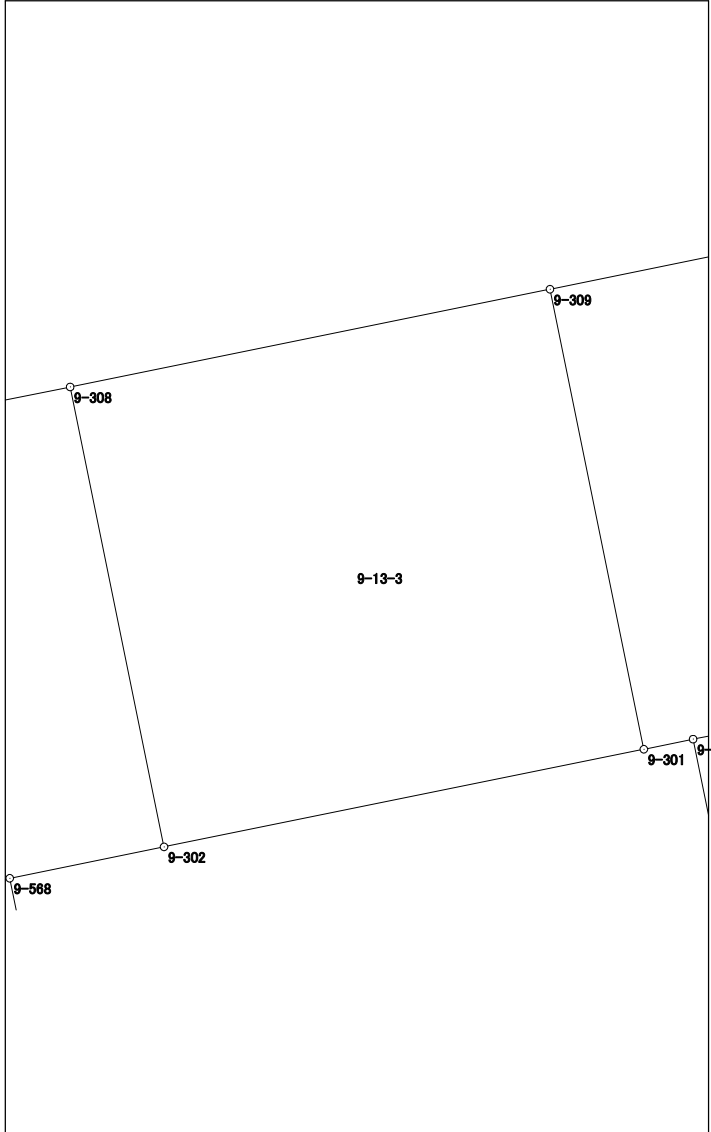
点 名	X 座標	Y 座標	辺 長	方 向 角	測 角	DX	倍 積 (Y×DX)	
9-308	41833.119	-68358.533	13.204	168-27-43	89-58-03	-15.685	1072203.590105	
9-302	41820.182	-68355.892	13.775	78-30-06	90-02-23	-10.191	696614.895372	
9-301	41822.928	-68342.393	13.206	348-28-05	89-57-59	15.685	-1071950.434205	
9-309	41835.867	-68345.033	13.777	258-29-40	90-01-35	10.191	-696504.231303	
倍面積							363.819969	
面 積							181.9099845	

# 面積計算書（座標法）

世界測地系（測地成果2011）

所在	地番	公簿地目	現況地目	地積	所有者
前橋市六供町一丁目	9-13-4			182.00 m <sup>2</sup>	

点名	X座標	Y座標	辺長	方向角	測角	DX	倍積 (Y×DX)
9-309	41835.867	-68345.033	13.206	168-28-05	89-58-43	-15.690	1072333.567770
9-301	41822.928	-68342.393	1.415	78-27-35	89-59-30	-12.656	864941.325808
9-570	41823.211	-68341.007	12.371	78-27-34	179-59-59	2.758	-188484.497306
9-299	41825.686	-68328.886	13.198	348-28-13	90-00-39	15.407	-1052743.146602
9-310	41838.618	-68331.524	13.786	258-29-22	90-01-09	10.181	-695683.245844
						倍面積	364.003826
						面積	182.0019130

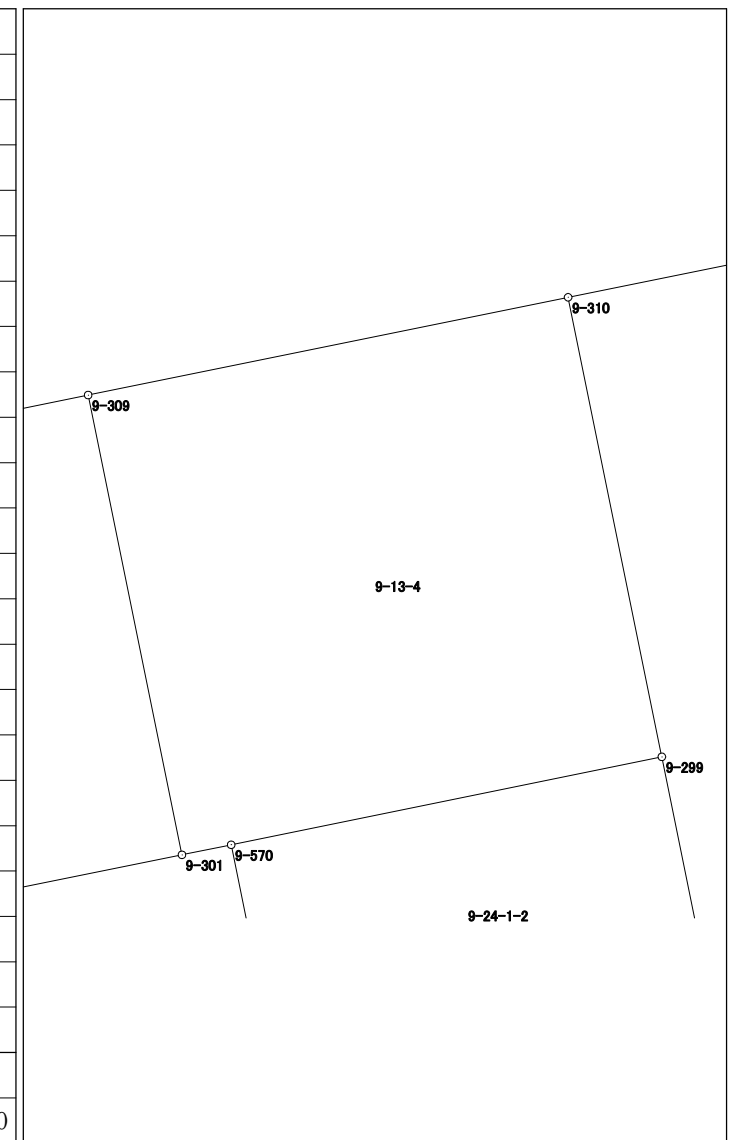


# 面積計算書（座標法）

世界測地系（測地成果2011）

所 在	地 番	公簿地目	現況地目	地 積	所 有 者
前橋市六供町一丁目	9-13-5			196.01 m <sup>2</sup>	

点 名	X 座標	Y 座標	辺 長	方 向 角	測 角	DX	倍 積 (Y×DX)
9-310	41838.618	-68331.524	13.198	168-28-13	89-57-47	-14.965	1022581.256660
9-299	41825.686	-68328.886	6.006	168-30-18	180-02-05	-18.818	1285812.976748
9-278	41819.800	-68327.689	10.205	78-34-40	90-04-22	-3.865	264086.517985
9-279	41821.821	-68317.686	19.217	348-28-36	89-53-56	20.851	-1424492.070786
9-311	41840.651	-68321.525	10.204	258-30-26	90-01-50	16.797	-1147596.655425
倍面積						392.025182	
面 積						196.0125910	

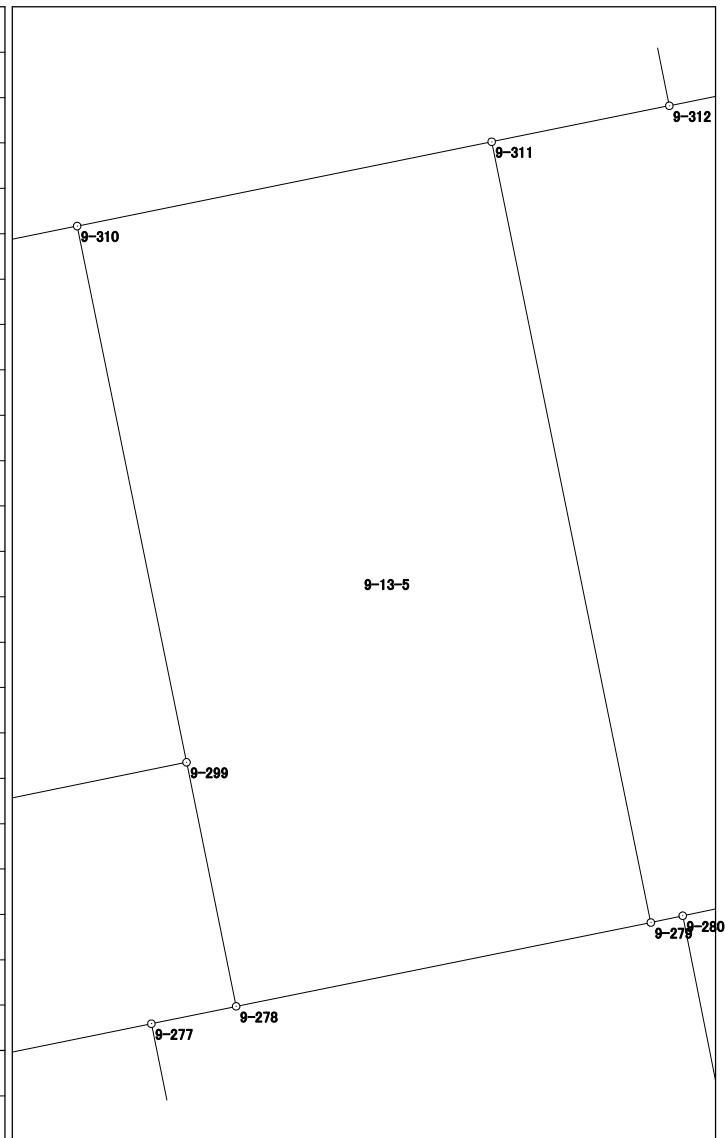




# 面積計算書 (座標法)

所在	地番	公簿地目	現況地目	地積	所有者
前橋市六供町一丁目	9-13-7			181.97 m <sup>2</sup>	

点名	X座標	Y座標	辺長	方向角	測角	D <sub>X</sub>	倍積 (Y×D <sub>X</sub> )
9-313	41842.684	-68311.550	13.211	168-27-04	89-57-13	-15.692	1071944.842600
9-298	41829.740	-68308.905	4.007	78-28-57	90-01-53	-12.144	829543.342320
9-566	41830.540	-68304.979	9.765	78-28-50	179-59-53	2.750	-187838.692250
9-296	41832.490	-68295.411	13.208	348-29-31	90-00-41	14.892	-1017055.260612
9-314	41845.432	-68298.046	13.781	258-29-51	90-00-20	10.194	-696230.280924
						倍面積	363.951134
						面積	181.9755670

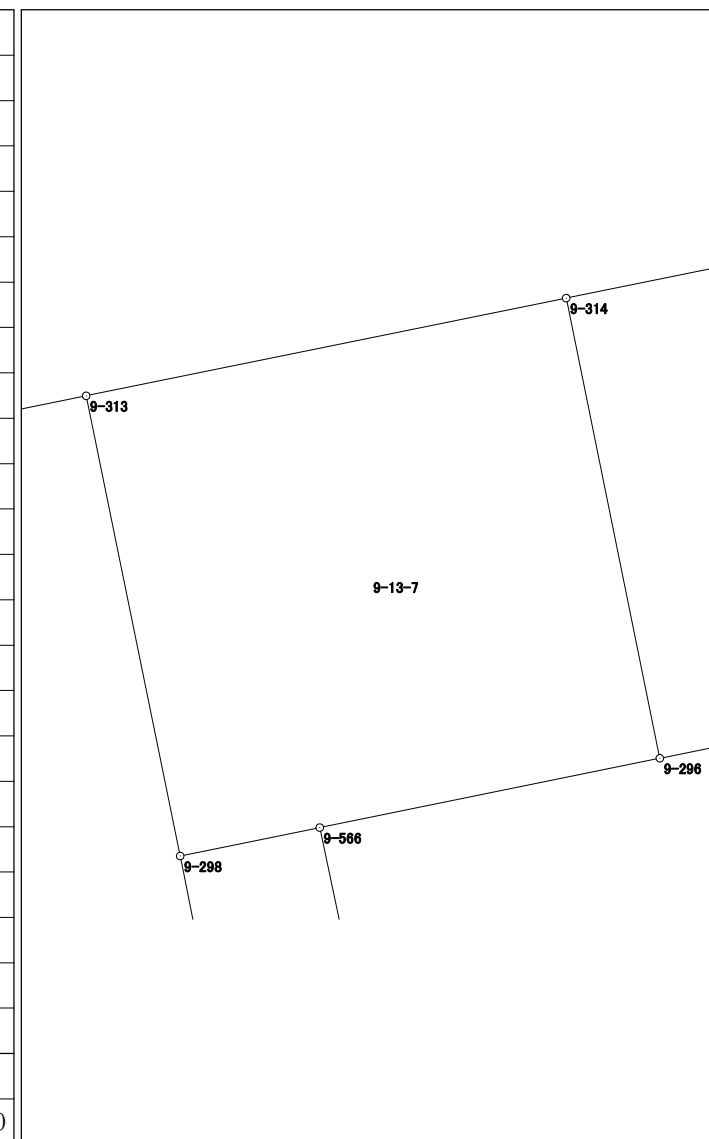




# 面積計算書（座標法）

世界測地系（測地成果2011）

所在	地番	公簿地目	現況地目	地積	所有者
前橋市六供町一丁目	9-13-9-1			169.04 m <sup>2</sup>	

点名	X座標	Y座標	辺長	方向角	測角	DX	倍積 (Y×DX)
9-561	41850.728	-68271.995	12.801	258-30-52	90-02-44	10.386	-709072.940070
9-315	41848.179	-68284.540	13.205	168-29-21	89-58-29	-15.488	1057590.955520
9-295	41835.240	-68281.905	12.806	78-30-02	90-00-41	-10.386	709175.865330
9-562	41837.793	-68269.356	13.201	348-28-08	89-58-06	15.488	-1057355.785728

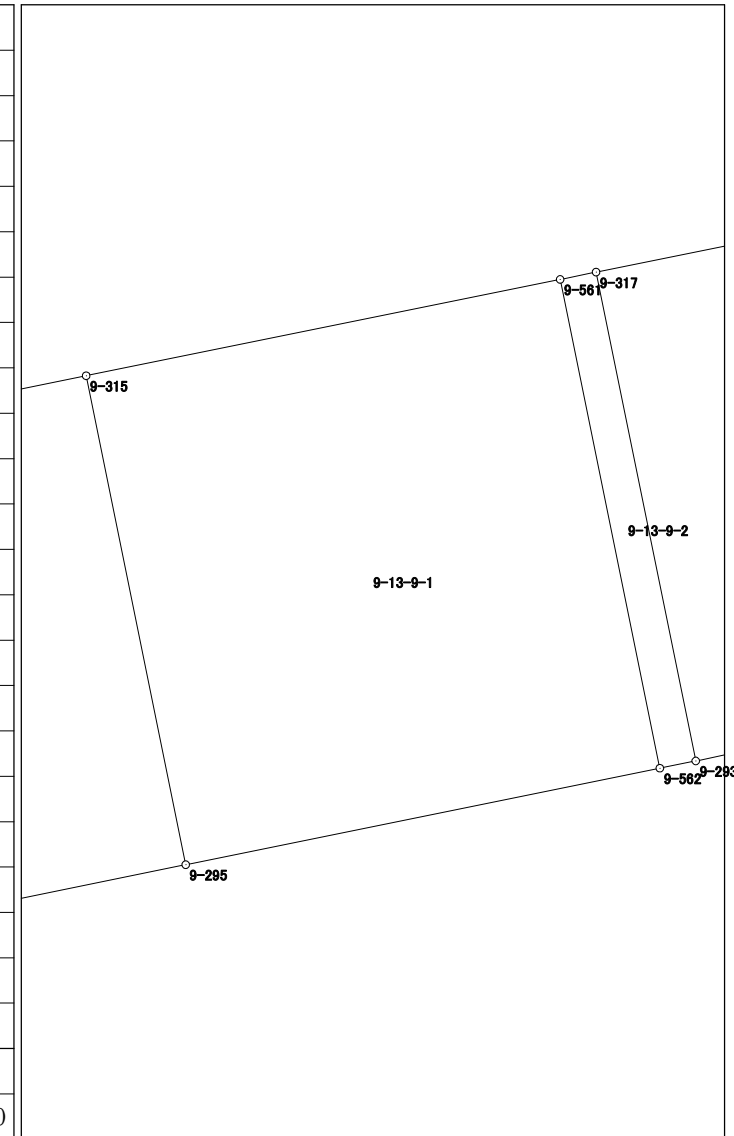


倍面積	338.095052
面積	169.0475260



# 面積計算書 (座標法)


所 在	地 番	公簿地目	現況地目	地 積	所 有 者
前橋市六供町一丁目	9-13-9-2			12.80 m <sup>2</sup>	

点 名	X 座標	Y 座標	辺 長	方 向 角	測 角	DX	倍 積 (Y×DX)
9-317	41850.921	-68271.044	0.970	258-31-41	90-03-18	12.742	-869909.642648
9-561	41850.728	-68271.995	13.201	168-28-08	89-56-27	-13.128	896274.750360
9-562	41837.793	-68269.356	0.969	78-30-58	90-02-50	-12.742	869888.134152
9-293	41837.986	-68268.406	13.201	348-28-23	89-57-25	13.128	-896227.633968
倍面積							25.607896
面 積							12.8039480

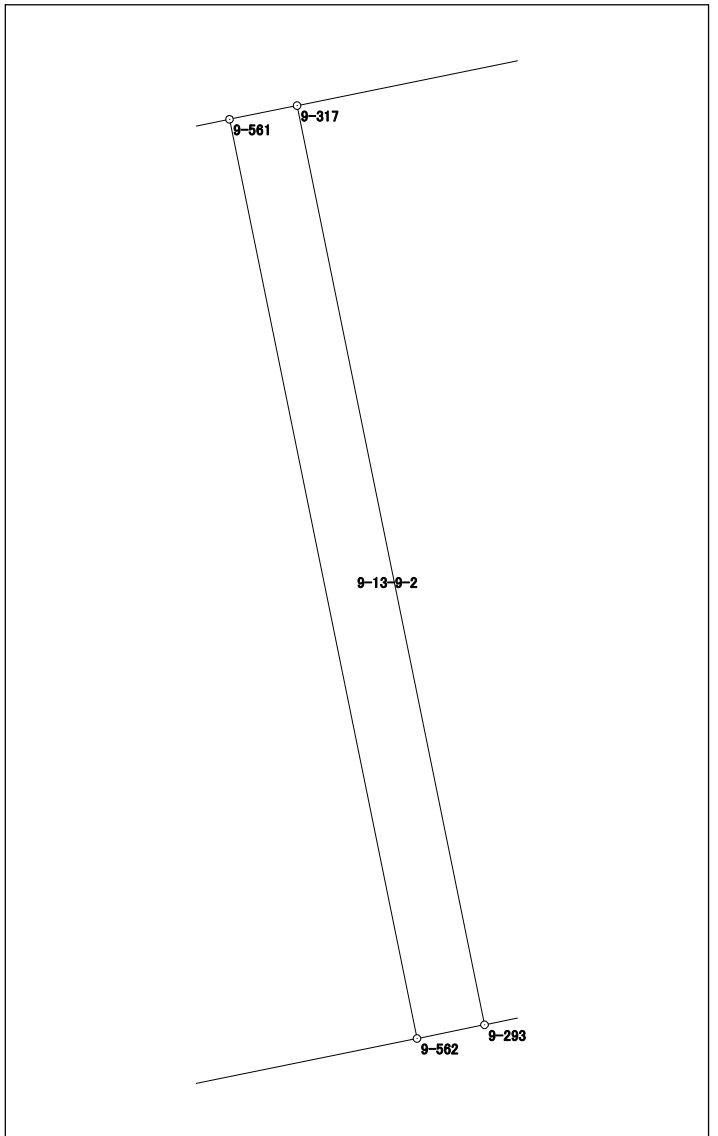

# 面積計算書（座標法）

所 在	地 番	公簿地目	現況地目	地 積	所 有 者
前橋市六供町一丁目	9-13-10			181.83 m <sup>2</sup>	

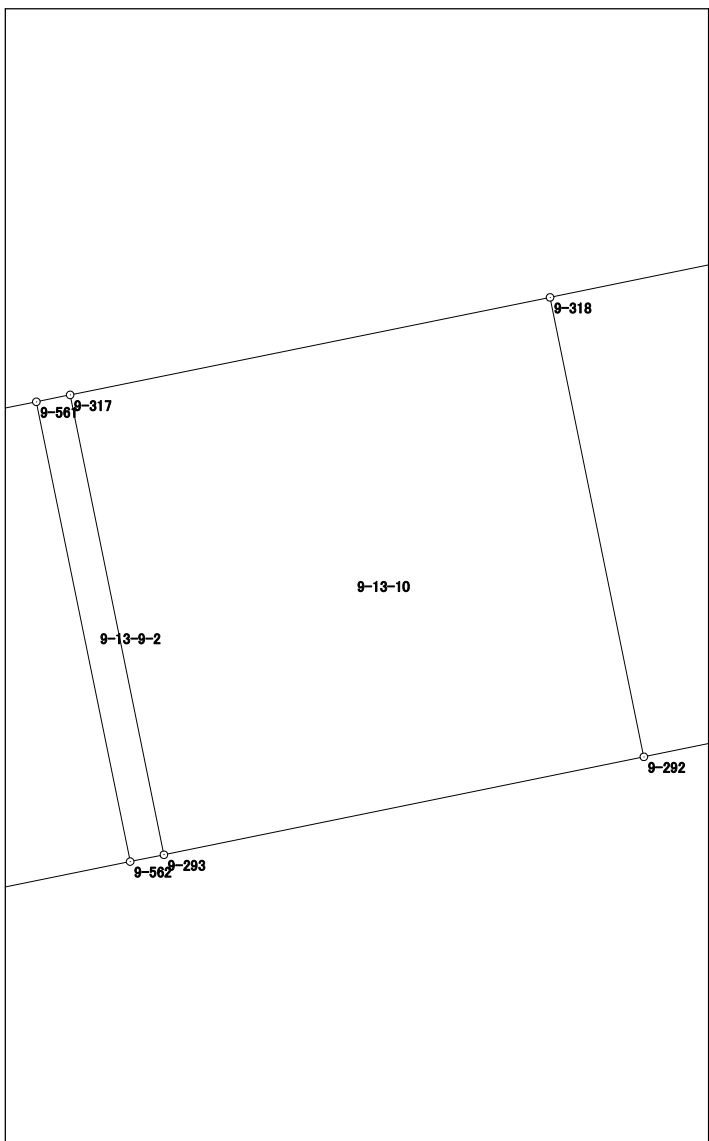点 名	X 座標	Y 座標	辺 長	方 向 角	測 角	DX	倍 積 (Y×DX)	
9-317	41850.921	-68271.044	13.201	168-28-23	89-57-24	-15.678	1070353.427832	
9-293	41837.986	-68268.406	13.781	78-28-21	89-59-58	-10.181	695040.641486	
9-292	41840.740	-68254.903	13.191	348-27-33	89-59-12	15.678	-1070100.369234	
9-318	41853.664	-68257.542	13.778	258-30-59	90-03-26	10.181	-694930.035102	
倍面積						363.664982		
面 積						181.8324910		

# 面積計算書 (座標法)

世界測地系 (測地成果2011)

所 在	地 番	公簿地目	現況地目	地 積	所 有 者
前橋市六供町一丁目	9-13-11			181.95 m <sup>2</sup>	


点 名	X 座標	Y 座標	辺 長	方 向 角	測 角	DX	倍 積 (Y×DX)	
9-318	41853.664	-68257.542	13.191	168-27-33	89-59-50	-15.672	1069732.198224	
9-292	41840.740	-68254.903	8.018	78-29-48	90-02-15	-11.325	772986.776475	
9-563	41842.339	-68247.046	5.823	78-29-22	179-59-34	2.761	-188430.094006	
9-252	41843.501	-68241.340	13.199	348-00-51	89-31-29	14.073	-960360.377820	
9-222	41856.412	-68244.081	13.739	258-27-43	90-26-52	10.163	-693564.595203	
倍面積							363.907670	
面 積							181.9538350	



# 面積計算書（座標法）

世界測地系（測地成果2011）

所在	地番	公簿地目	現況地目	地積	所有者
前橋市六供町一丁目	9-13-13			165.50 m <sup>2</sup>	

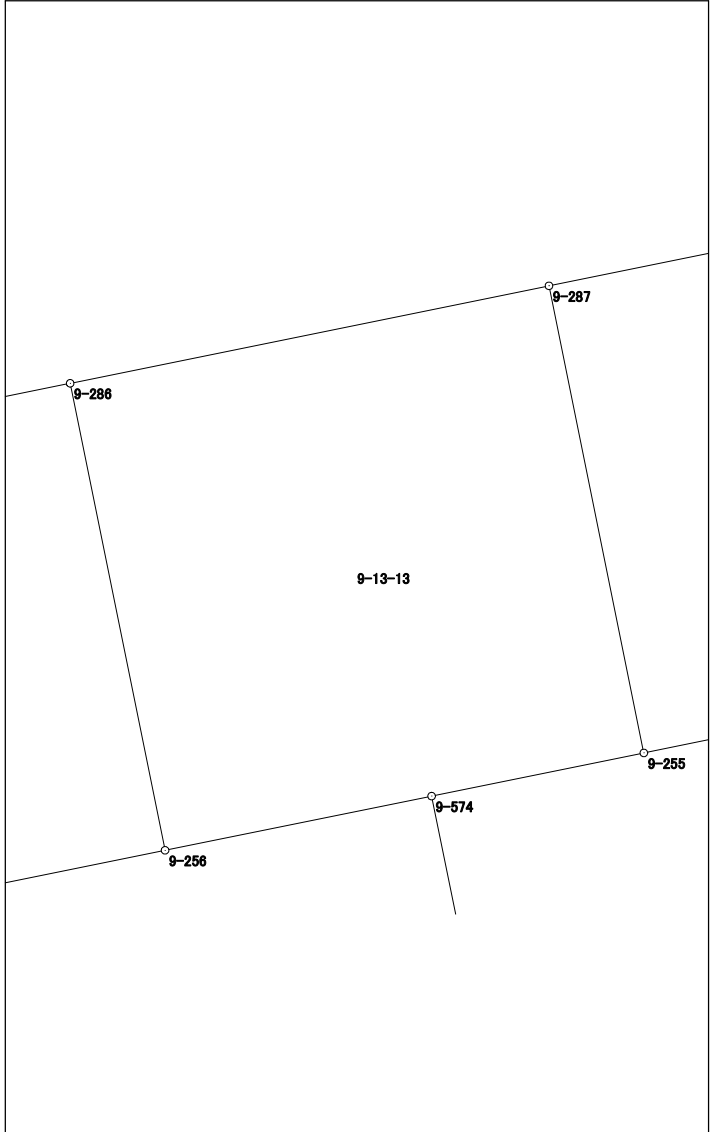
点名	X座標	Y座標	辺長	方向角	測角	DX	倍積 (Y×DX)		
9-286	41832.370	-68265.886	12.703	168-30-44	90-01-11	-15.048	1027265.052528		
9-256	41819.921	-68263.356	7.252	78-30-26	89-59-42	-11.004	751169.969424		
9-574	41821.366	-68256.249	5.774	78-30-05	179-59-39	2.596	-177193.222404		
9-255	41822.517	-68250.591	12.706	348-31-10	90-01-05	13.603	-928412.789373		
9-287	41834.969	-68253.120	13.028	258-29-33	89-58-23	9.853	-672497.991360		
							倍面積		331.018815
							面積		165.5094075

# 面積計算書 (座標法)

世界測地系 (測地成果2011)

所 在	地 番	公簿地目	現況地目	地 積	所 有 者
前橋市六供町一丁目	9-13-14			165.61 m <sup>2</sup>	

点 名	X 座標	Y 座標	辺 長	方 向 角	測 角	DX	倍 積 (Y×DX)
9-285	41829.774	-68278.662	12.709	168-29-06	89-58-15	-15.049	1027525.584438
9-257	41817.321	-68276.125	13.031	78-29-27	90-00-21	-9.853	672724.659625
9-256	41819.921	-68263.356	12.703	348-30-44	90-01-17	15.049	-1027295.244444
9-286	41832.370	-68265.886	13.037	258-30-51	90-00-07	9.853	-672623.774758

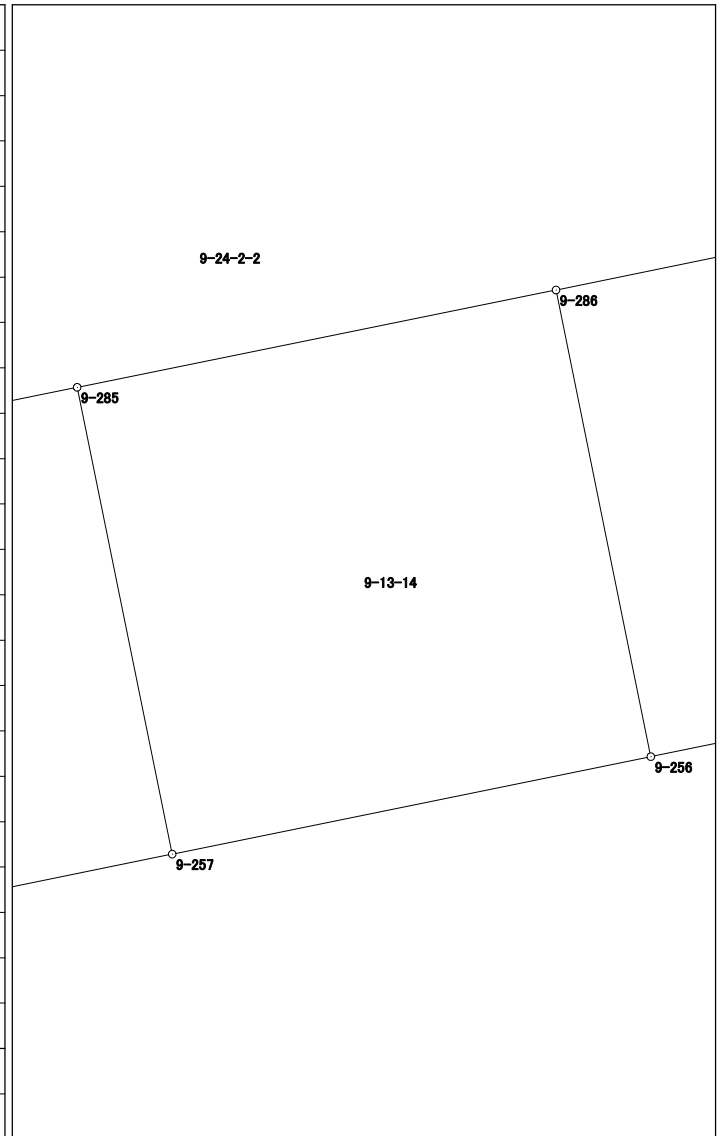

倍面積	331.224861
面積	165.6124305



# 面積計算書（座標法）

世界測地系（測地成果2011）

所在	地番	公簿地目	現況地目	地積	所有者
前橋市六供町一丁目	9-13-16			165.65 m <sup>2</sup>	

点名	X座標	Y座標	辺長	方向角	測角	DX	倍積 (Y×DX)
9-282	41824.573	-68304.202	12.710	168-26-59	89-55-34	-12.547	857012.822494
9-259	41812.120	-68301.657	13.032	78-28-59	90-02-00	-9.851	672839.623107
9-258	41814.722	-68288.887	12.707	348-28-12	89-59-13	15.053	-1027952.616011
9-284	41827.173	-68291.427	12.564	258-29-42	90-01-30	9.945	-679158.241515
9-565	41824.667	-68303.739	0.472	258-31-25	180-01-43	-2.600	177589.721400
倍面積							331.309475
面積							165.6547375

The diagram shows a polygon with vertices labeled 9-282, 9-259, 9-258, 9-284, and 9-565. The area enclosed by these vertices is labeled '9-13-16'. The vertices are connected by straight lines, and the polygon is oriented with one side roughly horizontal at the top.




# 面積計算書 (座標法)

世界測地系 (測地成果2011)

所在	地番	公簿地目	現況地目	地積	所有者
前橋市六供町一丁目	9-13-17			165.24 m <sup>2</sup>	

点名	X座標	Y座標	辺長	方向角	測角	DX	倍積 (Y×DX)
9-280	41821.985	-68316.918	12.712	168-41-24	90-09-07	-14.332	979118.068776
9-260	41809.520	-68314.425	13.030	78-29-24	89-48-00	-9.865	673921.802625
9-259	41812.120	-68301.657	12.710	348-26-59	89-57-35	15.053	-1028144.842821
9-282	41824.573	-68304.202	3.581	258-23-09	89-56-10	11.732	-801344.897864
9-281	41823.852	-68307.710	9.395	258-32-17	180-09-08	-2.588	176780.353480
倍面積							330.484196
面積							165.2420980

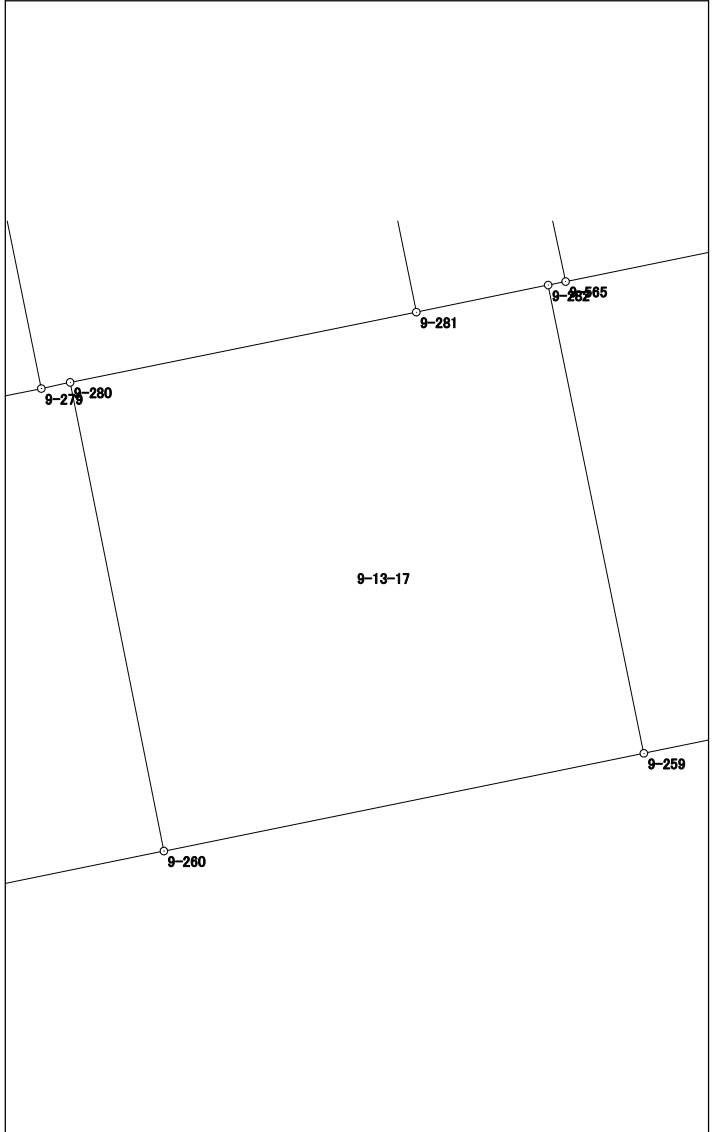


# 面積計算書（座標法）

所在	地番	公簿地目	現況地目	地積	所有者
前橋市六供町一丁目	9-13-18			165.96 m <sup>2</sup>	

点名	X座標	Y座標	辺長	方向角	測角	DX	倍積 (Y×DX)
9-277	41819.381	-68329.734	12.714	168-29-57	90-04-42	-12.878	879950.314452
9-261	41806.922	-68327.199	13.036	78-30-14	90-00-17	-9.861	673774.509339
9-260	41809.520	-68314.425	12.712	348-41-24	90-11-10	15.063	-1029020.183775
9-280	41821.985	-68316.918	0.785	257-56-46	89-15-22	12.301	-840366.408318
9-279	41821.821	-68317.686	10.205	258-34-40	180-37-54	-2.185	149274.143910
9-278	41819.800	-68327.689	2.087	258-25-15	179-50-35	-2.440	166719.561160

倍面積	331.936768
面積	165.9683840

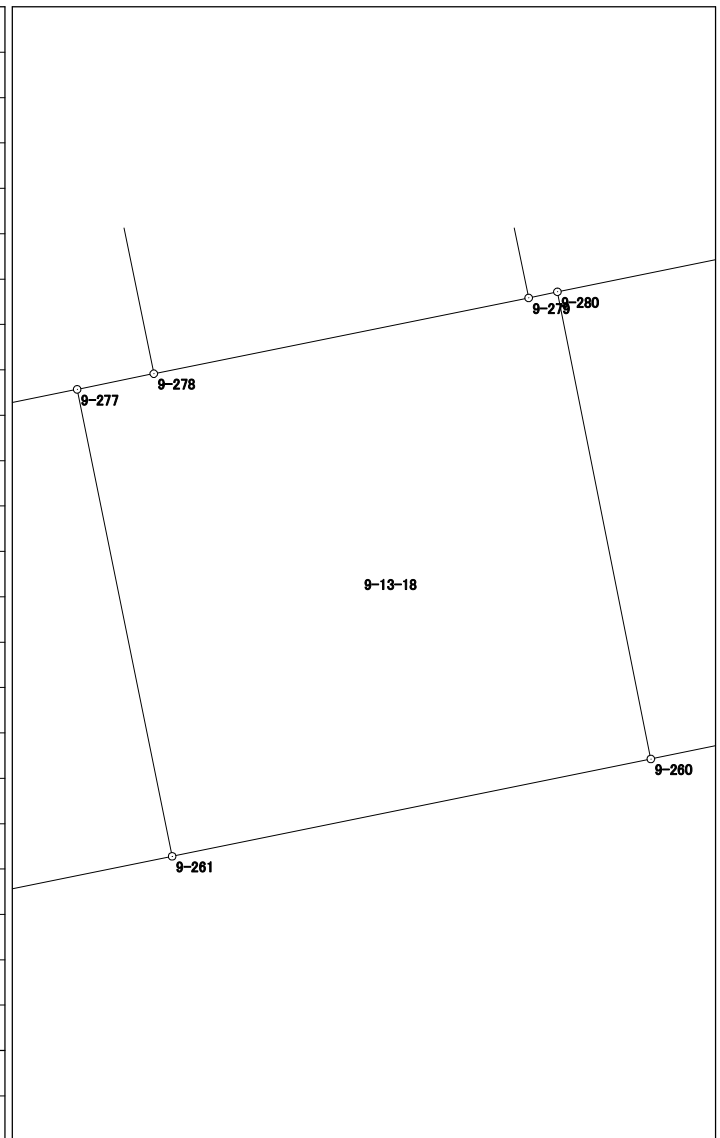


# 面積計算書 (座標法)

世界測地系 (測地成果2011)

所在	地番	公簿地目	現況地目	地積	所有者
前橋市六供町一丁目	9-13-19			165.58 m <sup>2</sup>	

点名	X座標	Y座標	辺長	方向角	測角	DX	倍積 (Y×DX)
9-275	41816.779	-68342.497	12.711	168-29-47	90-01-38	-13.005	888794.173485
9-262	41804.323	-68339.962	13.025	78-29-24	89-59-37	-9.857	673627.005434
9-261	41806.922	-68327.199	12.714	348-29-57	90-00-33	15.058	-1028870.962542
9-277	41819.381	-68329.734	10.279	258-28-45	89-58-48	10.406	-711039.212004
9-569	41817.328	-68339.806	2.746	258-28-09	179-59-24	-2.602	177820.175212
						倍面積	331.179585
						面積	165.5897925

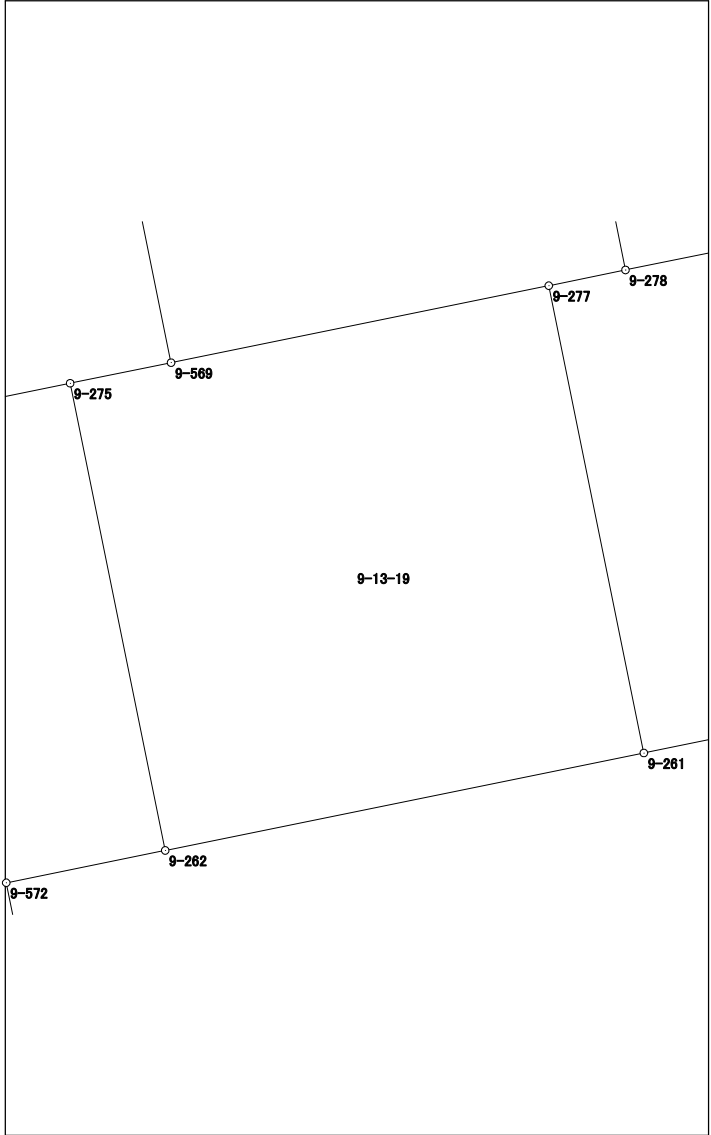


# 面積計算書 (座標法)

世界測地系 (測地成果2011)

所 在	地 番	公簿地目	現況地目	地 積	所 有 者
前橋市六供町一丁目	9-13-20			165.67 m <sup>2</sup>	

点 名	X 座標	Y 座標	辺 長	方 向 角	測 角	DX	倍 積 (Y×DX)
9-274	41814.183	-68355.272	12.709	168-29-06	89-58-18	-15.049	1028678.488328
9-263	41801.730	-68352.735	8.708	78-31-39	90-02-33	-10.721	732809.671935
9-572	41803.462	-68344.201	4.326	78-31-07	179-59-28	2.593	-177216.513193
9-262	41804.323	-68339.962	12.711	348-29-47	89-58-40	13.317	-910083.273954
9-275	41816.779	-68342.497	13.036	258-30-48	90-01-01	9.860	-673857.020420
						倍面積	331.352696
						面 積	165.6763480

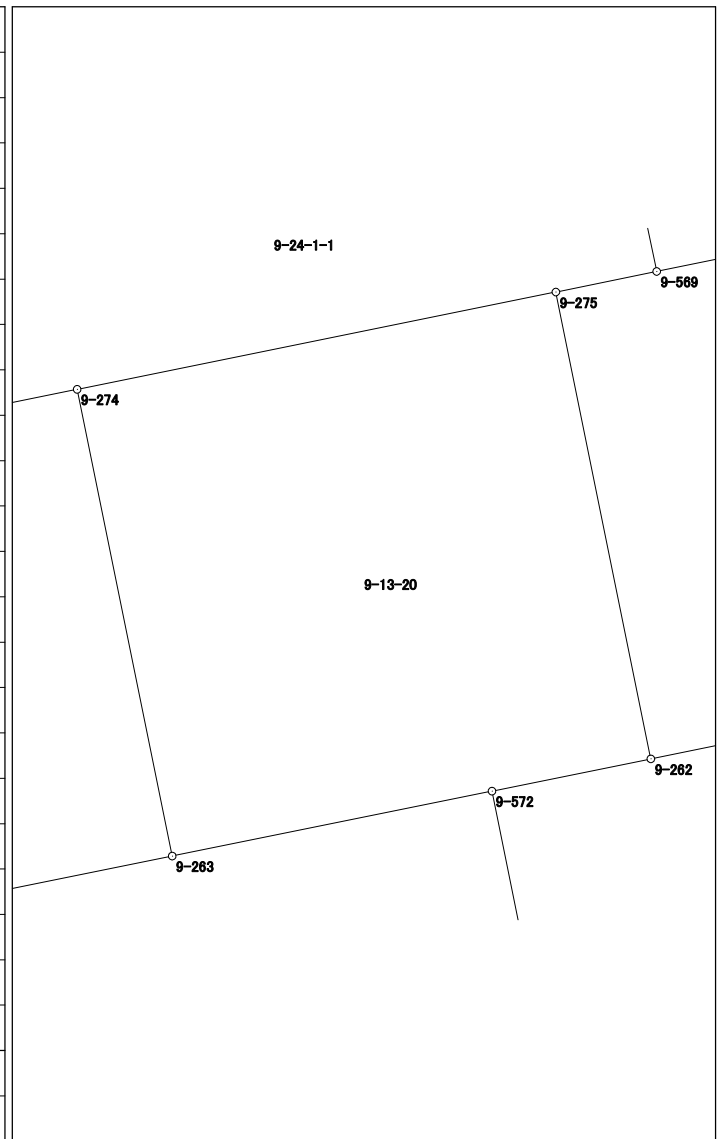


# 面積計算書 (座標法)

世界測地系 (測地成果2011)

所 在	地 番	公簿地目	現況地目	地 積	所 有 者
前橋市六供町一丁目	9-13-21			165.57 m <sup>2</sup>	

点 名	X 座標	Y 座標	辺 長	方 向 角	測 角	DX	倍 積 (Y×DX)
9-272	41811.579	-68368.039	12.704	168-29-41	90-01-16	-14.285	976637.437115
9-264	41799.130	-68365.505	13.032	78-29-30	89-59-49	-9.849	673331.858745
9-263	41801.730	-68352.735	12.709	348-29-06	89-59-36	15.053	-1028913.719955
9-274	41814.183	-68355.272	3.842	258-28-04	89-58-58	11.685	-798731.353320
9-567	41813.415	-68359.036	9.188	258-28-25	180-00-21	-2.604	178006.929744
						倍面積	331.152329
						面積	165.5761645

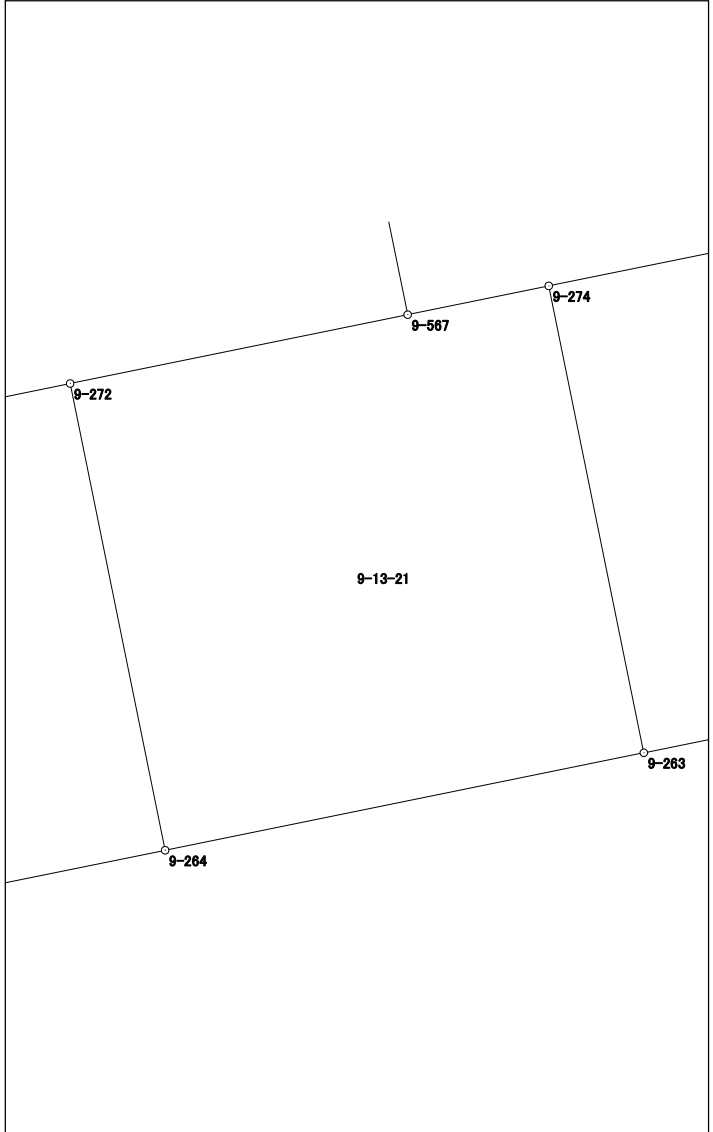




# 面積計算書（座標法）

世界測地系（測地成果2011）

所在	地番	公簿地目	現況地目	地積	所有者
前橋市六供町一丁目	9-13-23			538.71 m <sup>2</sup>	

点名	X座標	Y座標	辺長	方向角	測角	DX	倍積 (Y×DX)
9-571	41797.575	-68343.005	12.653	78-28-47	89-57-49	-3.360	229632.496800
9-328	41800.102	-68330.607	13.506	78-28-52	180-00-05	5.224	-356959.090968
9-329	41802.799	-68317.373	13.514	78-30-05	180-01-13	5.391	-368298.957843
9-330	41805.493	-68304.130	13.503	78-29-46	179-59-41	5.387	-367954.348310
9-331	41808.186	-68290.898	12.520	78-29-27	179-59-41	5.191	-354498.051518
9-332	41810.684	-68278.630	9.667	78-28-38	179-59-11	4.429	-302406.052270
9-529	41812.615	-68269.158	2.891	78-29-17	180-00-39	2.508	-171219.048264
9-334	41813.192	-68266.325	11.502	78-30-41	180-01-24	2.868	-195787.820100
9-573	41815.483	-68255.053	6.003	348-30-31	89-59-50	8.174	-557916.803222
9-574	41821.366	-68256.249	7.252	258-30-26	89-59-55	4.438	-302921.233062
9-256	41819.921	-68263.356	13.031	258-29-27	179-59-01	-4.045	276125.275020
9-257	41817.321	-68276.125	13.024	258-29-21	179-59-54	-5.199	354967.573875
9-258	41814.722	-68288.887	13.032	258-28-59	179-59-38	-5.201	355170.501287
9-259	41812.120	-68301.657	13.030	258-29-24	180-00-25	-5.202	355305.219714
9-260	41809.520	-68314.425	13.036	258-30-14	180-00-50	-5.198	355098.381150
9-261	41806.922	-68327.199	13.025	258-29-24	179-59-10	-5.197	355096.453203
9-262	41804.323	-68339.962	4.326	258-31-07	180-01-43	-3.460	236456.268520
9-572	41803.462	-68344.201	6.007	168-30-58	89-59-51	-6.748	461186.668348

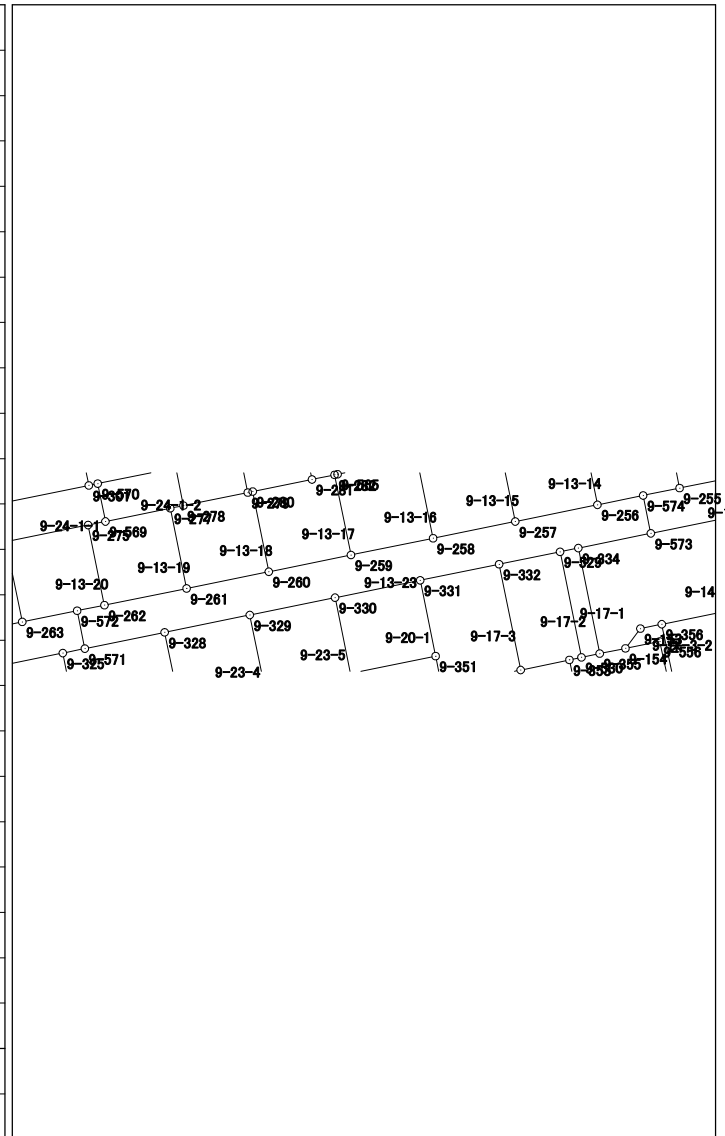

倍面積	1077.432360
面積	538.7161800

# 面積計算書 (座標法)

世界測地系 (測地成果2011)

所在	地番	公簿地目	現況地目	地積	所有者
前橋市六供町一丁目	9-13-24			115.41 m <sup>2</sup>	

点名	X座標	Y座標	辺長	方向角	測角	DX	倍積 (Y×DX)	
9-573	41815.483	-68255.053	19.252	78-30-45	90-00-14	-2.049	139854.603597	
9-337	41819.317	-68236.187	6.011	347-49-22	89-18-37	9.710	-662573.375770	
9-321	41825.193	-68237.455	13.406	258-29-08	90-39-46	3.200	-218359.856000	
9-255	41822.517	-68250.591	5.774	258-30-05	180-00-57	-3.827	261195.011757	
9-574	41821.366	-68256.249	6.003	168-30-31	90-00-26	-7.034	480114.455466	
						倍面積	230.839050	
						面積	115.4195250	






# 面積計算書（座標法）

世界測地系（測地成果2011）

所 在	地 番	公簿地目	現況地目	地 積	所 有 者
前橋市六供町一丁目	9-15-1			139.58 m <sup>2</sup>	

点 名	X 座標	Y 座標	辺 長	方 向 角	測 角	DX	倍 積 (Y×DX)
9-551	41784.434	-68283.161	17.490	78-12-09	89-49-28	-4.252	290340.000572
9-342	41788.010	-68266.040	7.989	347-57-21	89-45-12	11.389	-777481.929560
9-353	41795.823	-68267.707	7.740	258-15-58	90-18-37	6.239	-425922.223973
9-352	41794.249	-68275.285	9.692	258-10-10	179-54-12	-3.561	243128.289885
9-552	41792.262	-68284.771	7.992	168-22-41	90-12-31	-9.815	670215.027365
						倍面積	279.164289
						面 積	139.5821445

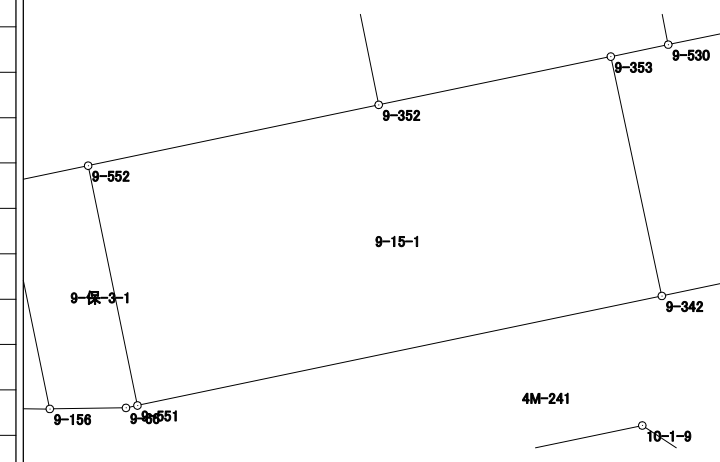


# 面積計算書（座標法）

世界測地系（測地成果2011）

所 在	地 番	公簿地目	現況地目	地 積	所 有 者
前橋市六供町一丁目	9-15-2			135.09 m <sup>2</sup>	

点 名	X 座標	Y 座標	辺 長	方 向 角	測 角	DX	倍 積 (Y×DX)
9-353	41795.823	-68267.707	7.989	167-57-21	89-43-44	-8.204	560068.268228
9-342	41788.010	-68266.040	4.618	78-05-30	90-08-09	-6.860	468305.034400
9-56	41788.963	-68261.521	2.176	168-15-04	270-09-34	-1.177	80343.810217
9-341	41786.833	-68261.078	9.743	77-59-53	89-44-49	-0.104	7099.152112
9-555	41788.859	-68251.548	10.057	347-48-47	89-48-54	11.856	-809190.353088
9-556	41798.689	-68253.671	5.430	258-34-12	90-45-25	8.754	-597492.635934
9-154	41797.613	-68258.993	4.089	258-34-29	180-00-17	-1.886	128736.460798
9-355	41796.803	-68263.001	2.891	258-14-35	179-40-06	-1.399	95499.938399
9-530	41796.214	-68265.831	1.916	258-13-37	179-59-02	-0.980	66900.514380

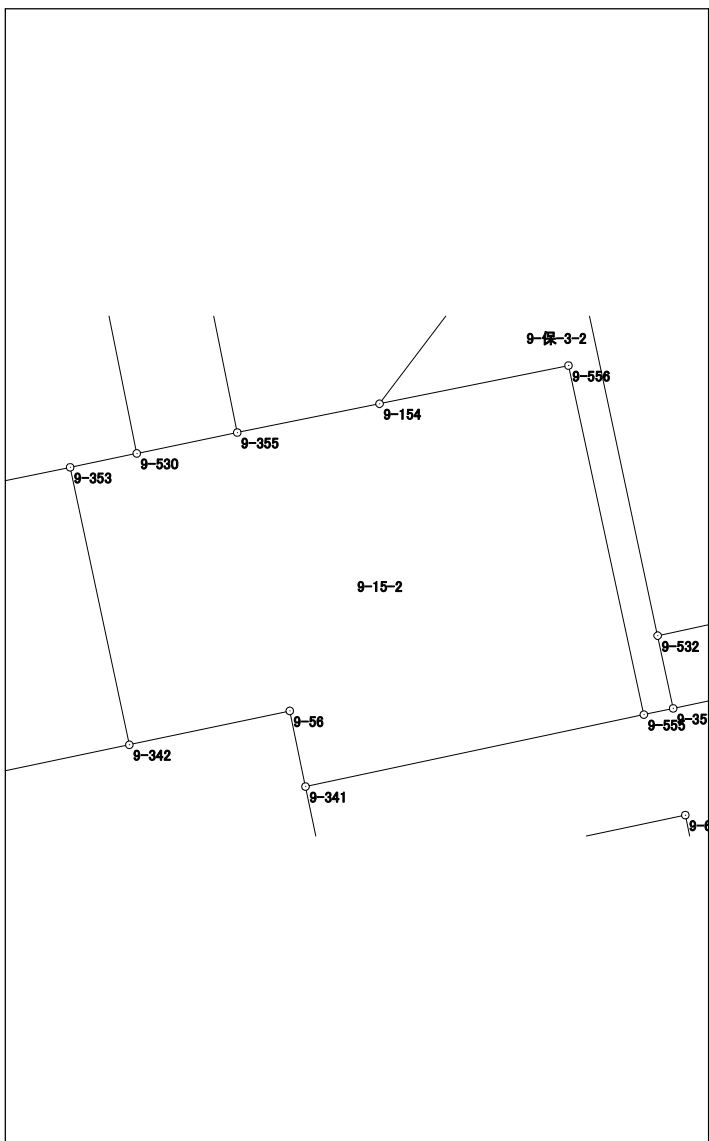


倍面積	270.189512
面 積	135.0947560

# 面積計算書 (座標法)

世界測地系 (測地成果2011)

所在	地番	公簿地目	現況地目	地積	所有者
前橋市六供町一丁目	9-15-3			140.32 m <sup>2</sup>	

点名	X座標	Y座標	辺長	方向角	測角	DX	倍積 (Y×DX)
9-531	41793.255	-68240.882	7.442	347-55-56	89-51-57	9.450	-644876.334900
9-358	41800.533	-68242.438	9.297	78-25-18	270-29-22	9.144	-624008.853072
9-364	41802.399	-68233.330	1.001	123-03-18	224-38-00	1.320	-90067.995600
9-338	41801.853	-68232.491	3.706	347-56-39	44-53-21	3.078	-210019.607298
9-151	41805.477	-68233.265	20.504	258-25-31	90-28-52	-0.490	33434.299850
9-356	41801.363	-68253.352	10.511	167-57-28	89-31-57	-14.394	982438.748688
9-532	41791.083	-68251.159	10.504	78-03-59	90-06-31	-8.108	553380.397172

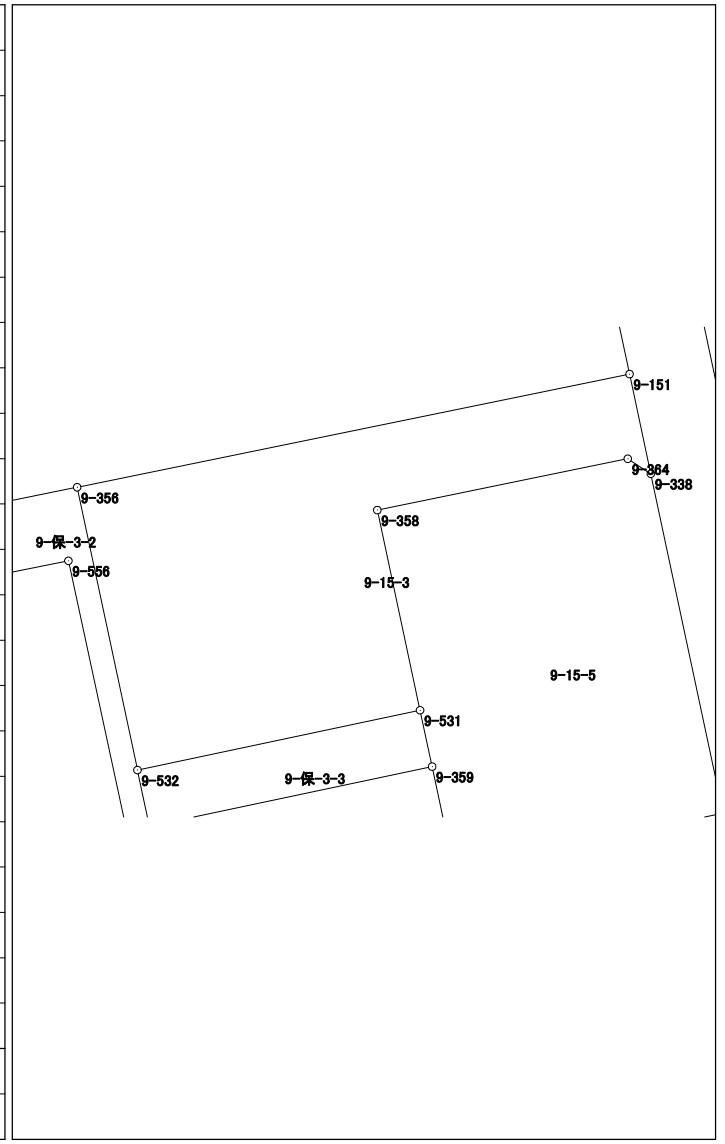


倍面積	280.654840
面積	140.3274200

# 面積計算書 (座標法)

世界測地系 (測地成果2011)

所在	地番	公簿地目	現況地目	地積	所有者
前橋市六供町一丁目	9-15-4			135.22 m <sup>2</sup>	

点名	X座標	Y座標	辺長	方向角	測角	DX	倍積 (Y×DX)
9-557	41781.763	-68238.438	3.600	347-56-39	89-56-13	5.764	-393326.356632
9-360	41785.284	-68239.190	2.199	348-01-51	180-05-12	5.672	-387052.685680
9-534	41787.435	-68239.646	3.855	348-03-17	180-01-26	5.923	-404183.423258
9-359	41791.207	-68240.444	10.505	258-03-44	90-00-27	1.599	-109116.469956
9-357	41789.034	-68250.722	0.844	258-02-17	179-58-33	-2.348	160252.695256
9-555	41788.859	-68251.548	9.743	257-59-53	179-57-36	-2.201	150221.657148
9-341	41786.833	-68261.078	3.000	168-06-48	90-06-55	-4.962	338711.469036
9-63	41783.897	-68260.460	10.303	78-03-47	89-56-59	-0.805	54949.670300
9-62	41786.028	-68250.380	3.686	168-00-26	269-56-39	-1.475	100669.310500
9-542	41782.422	-68249.614	2.967	167-59-49	179-59-23	-6.508	444168.487912
9-558	41779.520	-68248.997	10.795	78-00-26	90-00-37	-0.659	44976.089023
						倍面積	270.443649
						面積	135.2218245

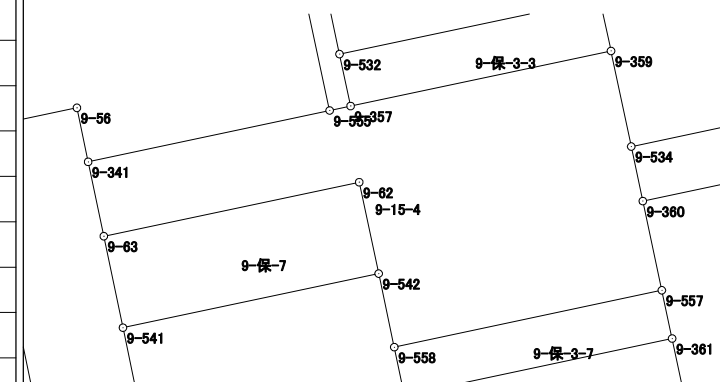


## 面積計算書 (座標法)

世界測地系 (測地成果2011)

所 在	地 番	公簿地目	現況地目	地 積	所 有 者
前橋市六供町一丁目	9-15-5			133.30 m <sup>2</sup>	

点 名	X 座標	Y 座標	辺 長	方 向 角	測 角	DX	倍 積 (Y×DX)
9-533	41789.518	-68229.861	12.612	347-57-50	89-58-53	14.418	-983738.135898
9-338	41801.853	-68232.491	1.001	303-03-18	135-05-28	12.881	-878902.716571
9-364	41802.399	-68233.330	9.297	258-25-18	135-22-00	-1.320	90067.995600
9-358	41800.533	-68242.438	7.442	167-55-56	89-30-38	-9.144	624008.853072
9-531	41793.255	-68240.882	2.094	167-55-41	179-59-45	-9.326	636414.465532
9-359	41791.207	-68240.444	3.855	168-03-17	180-07-36	-5.820	397159.384080
9-534	41787.435	-68239.646	10.004	77-58-57	89-55-40	-1.689	115256.762094

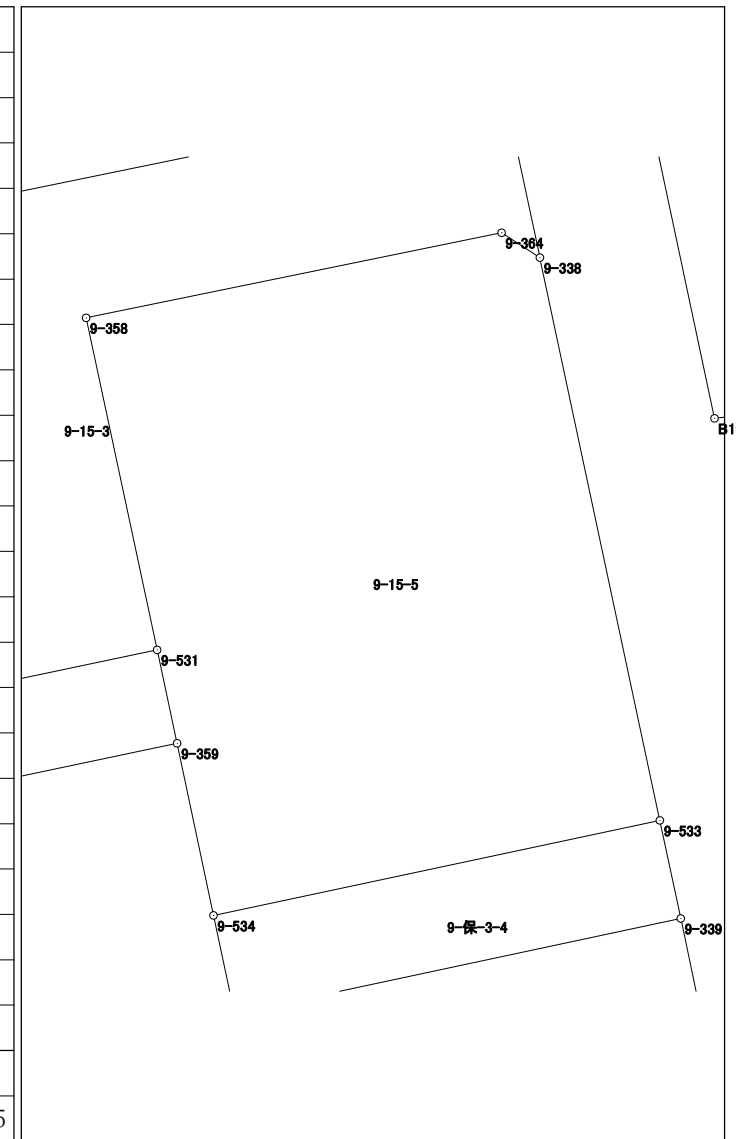


倍面積	266.607909
面 積	133.3039545

# 面積計算書（座標法）

世界測地系（測地成果2011）

所 在	地 番	公簿地目	現況地目	地 積	所 有 者
前橋市六供町一丁目	9-15-6			132.87 m <sup>2</sup>	

点 名	X 座標	Y 座標	辺 長	方 向 角	測 角	DX	倍 積 (Y×DX)
9-535	41773.693	-68226.498	13.979	348-00-22	82-06-44	14.397	-982256.891706
9-339	41787.367	-68229.403	10.006	257-59-05	89-58-43	11.591	-790847.010173
9-360	41785.284	-68239.190	3.600	167-56-39	89-57-34	-5.604	382412.420760
9-557	41781.763	-68238.438	1.946	167-57-24	180-00-45	-5.424	370125.287712
9-361	41779.860	-68238.032	7.044	168-00-43	180-03-19	-8.793	600017.015376
9-536	41772.970	-68236.569	10.097	85-53-38	97-52-55	-6.167	420814.921023
倍面積							265.742992
面 積							132.8714960

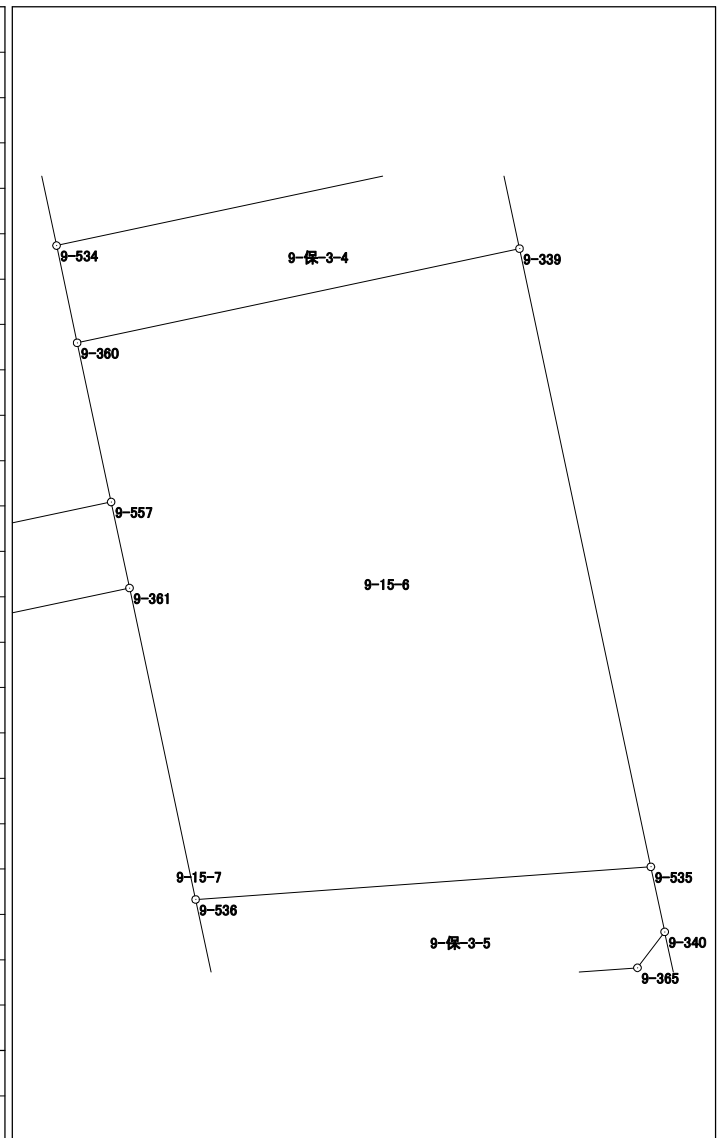


# 面積計算書（座標法）

世界測地系（測地成果2011）

所在	地番	公簿地目	現況地目	地積	所有者
前橋市六供町一丁目	9-15-7			134.44 m <sup>2</sup>	

点名	X 座標	Y 座標	辺長	方向角	測角	DX	倍積 (Y×DX)
9-362	41777.617	-68248.593	5.499	167-57-38	89-57-04	-7.621	520122.527253
9-553	41772.239	-68247.446	0.858	167-57-24	179-59-46	-6.217	424294.371782
9-250	41771.400	-68247.267	1.542	168-03-49	180-06-25	-2.348	160244.582916
9-248	41769.891	-68246.948	7.483	85-45-14	97-41-25	-0.955	65175.835340
9-560	41770.445	-68239.486	2.910	178-19-35	272-34-21	-2.355	160703.989530
9-559	41767.536	-68239.401	0.718	85-46-00	87-26-25	-2.856	194891.729256
9-167	41767.589	-68238.685	2.618	85-50-17	180-04-17	0.243	-16582.000455
9-538	41767.779	-68236.074	10.698	85-50-06	179-59-49	0.967	-65984.283558
9-161	41768.556	-68225.404	3.781	347-58-15	82-08-09	4.475	-305308.682900
9-340	41772.254	-68226.192	0.997	217-08-03	49-09-48	2.903	-198060.635376
9-365	41771.459	-68226.794	9.336	265-53-27	228-45-24	-1.464	99884.026416
9-363	41770.790	-68236.106	2.229	348-00-34	262-07-07	1.511	-103104.756166
9-536	41772.970	-68236.569	7.044	348-00-43	180-00-09	9.070	-618905.680830
9-361	41779.860	-68238.032	10.797	258-00-34	89-59-51	4.647	-317102.134704

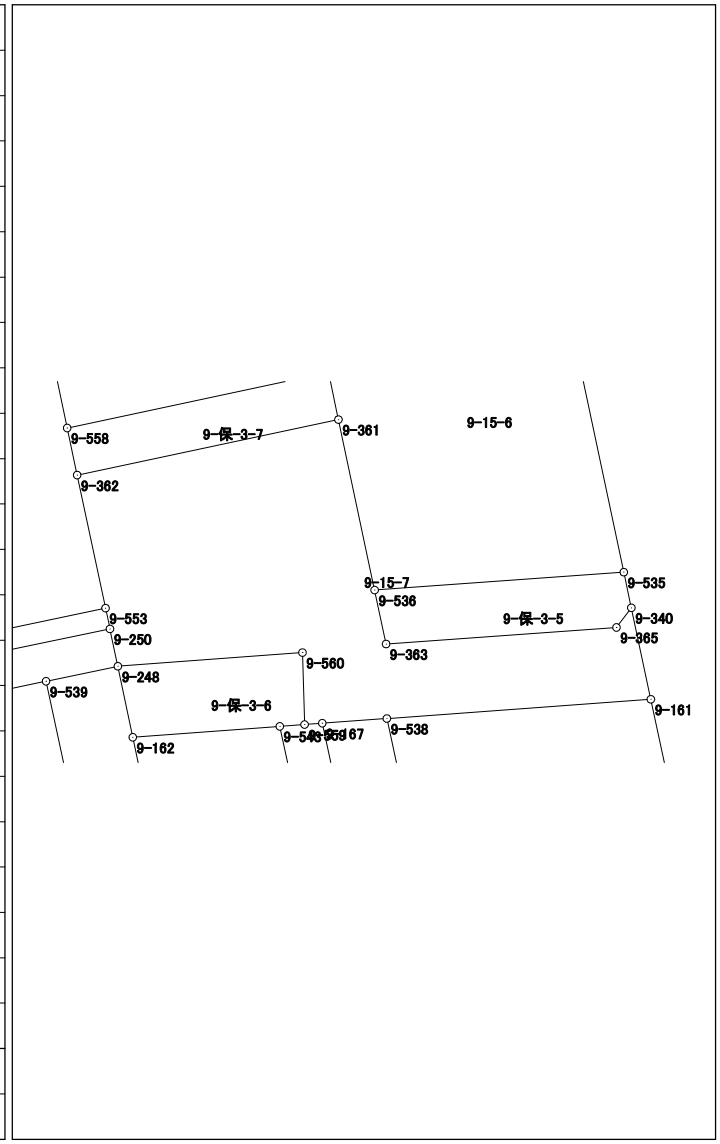

倍面積	268.888504
面積	134.4442520



# 面積計算書 (座標法)

世界測地系 (測地成果2011)

所在	地番	公簿地目	現況地目	地積	所有者
前橋市六供町一丁目	9-16			140.70 m <sup>2</sup>	


点名	X座標	Y座標	辺長	方向角	測角	DX	倍積 (Y×DX)		
9-527	41789.869	-68330.415	10.042	258-10-07	90-07-22	11.624	-794272.743960		
9-231	41787.810	-68340.244	13.980	168-12-28	90-02-21	-15.744	1075948.801536		
9-232	41774.125	-68337.387	10.082	78-12-15	89-59-47	-11.624	794353.786488		
9-528	41776.186	-68327.518	13.986	348-02-45	89-50-30	15.744	-1075748.443392		
							倍面積		281.400672
							面積		140.7003360

# 面積計算書（座標法）

世界測地系（測地成果2011）

所在	地番	公簿地目	現況地目	地積	所有者
前橋市六供町一丁目	9-17-1			48.36 m <sup>2</sup>	

点名	X座標	Y座標	辺長	方向角	測角	DX	倍積 (Y×DX)
9-334	41813.192	-68266.325	2.891	258-29-17	89-57-12	15.812	-1079427.130900
9-529	41812.615	-68269.158	16.735	168-31-59	90-02-42	-16.978	1159073.764524
9-530	41796.214	-68265.831	2.891	78-14-35	89-42-36	-15.812	1079419.319772
9-355	41796.803	-68263.001	16.723	348-32-05	90-17-30	16.978	-1158969.230978
						倍面積	96.722418
						面積	48.3612090

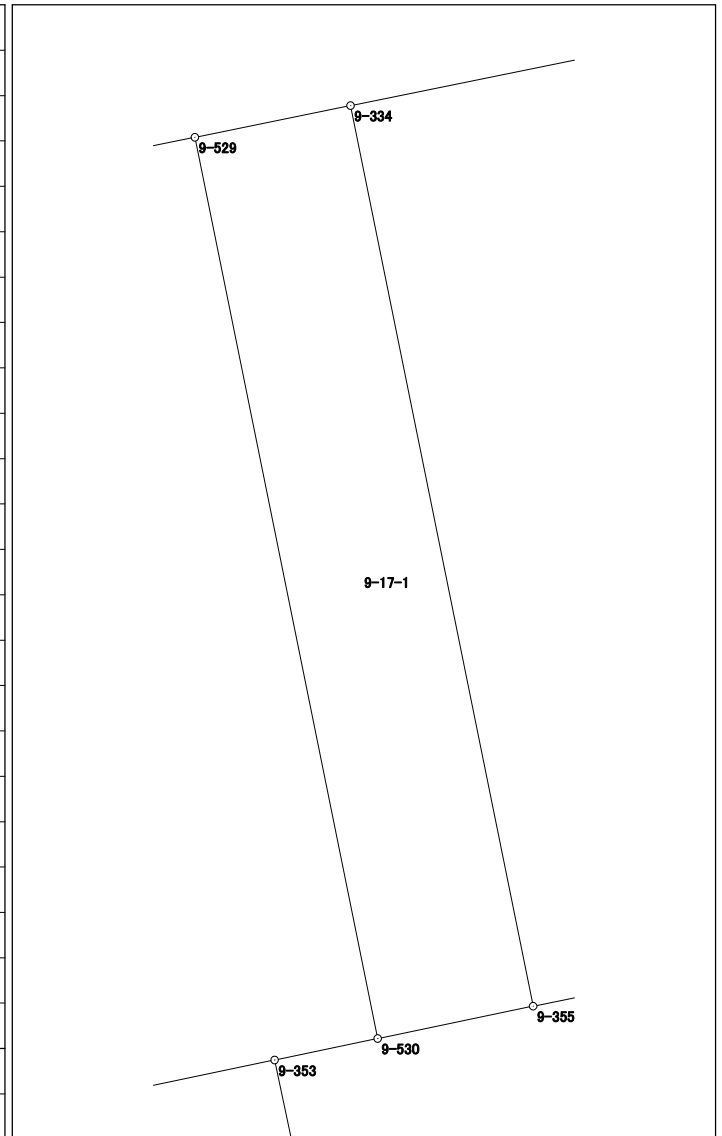


# 面積計算書 (座標法)

世界測地系 (測地成果2011)

所在	地番	公簿地目	現況地目	地積	所有者
前橋市六供町一丁目	9-17-2			161.86 m <sup>2</sup>	

点名	X座標	Y座標	辺長	方向角	測角	D <sub>X</sub>	倍積 (Y×D <sub>X</sub> )
9-529	41812.615	-68269.158	9.667	258-28-38	89-56-39	14.470	-987854.716260
9-332	41810.684	-68278.630	16.772	168-29-45	90-01-07	-18.366	1254005.318580
9-352	41794.249	-68275.285	7.740	78-15-58	89-46-13	-14.861	1014639.010385
9-353	41795.823	-68267.707	1.916	78-13-37	179-57-39	1.965	-134146.044255
9-530	41796.214	-68265.831	16.735	348-31-59	90-18-22	16.792	-1146319.834152

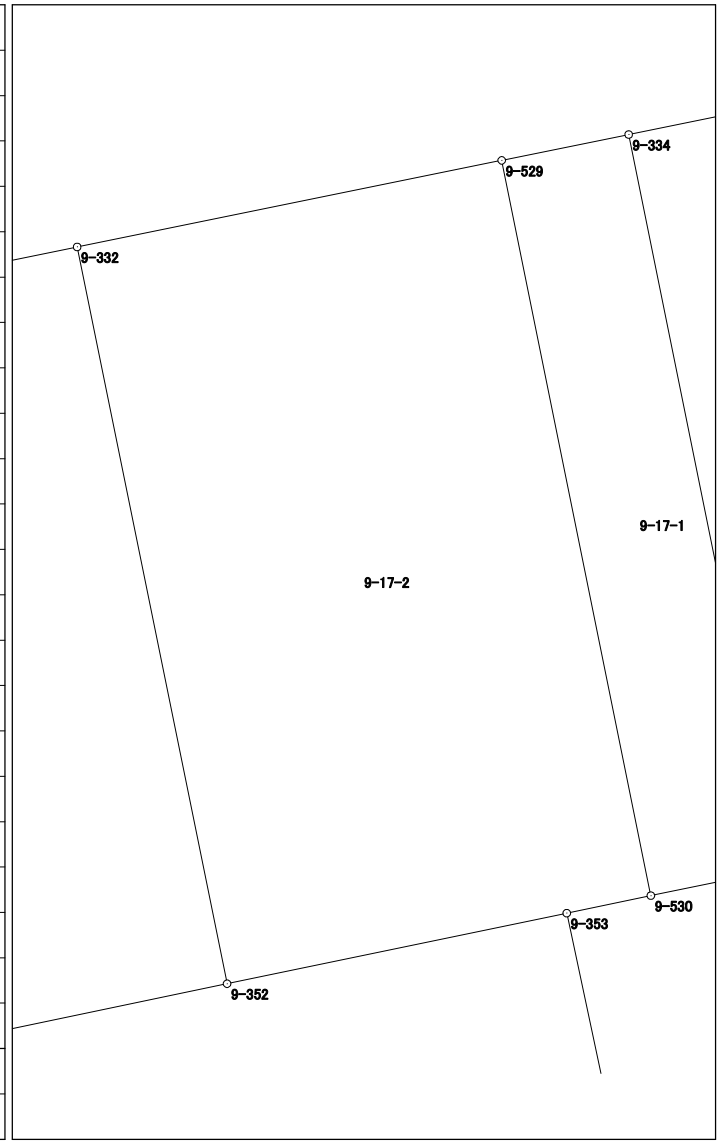


倍面積	323.734298
面積	161.8671490

# 面積計算書（座標法）

世界測地系（測地成果2011）

所在	地番	公簿地目	現況地目	地積	所有者
前橋市六供町一丁目	9-17-3			210.39 m <sup>2</sup>	

点名	X座標	Y座標	辺長	方向角	測角	DX	倍積 (Y×DX)
9-331	41808.186	-68290.898	12.022	168-29-04	89-59-37	-14.278	975057.441644
9-351	41796.406	-68288.498	4.820	168-29-56	180-00-52	-16.503	1126965.082494
9-155	41791.683	-68287.537	2.826	78-10-38	89-40-42	-4.144	282983.553328
9-552	41792.262	-68284.771	9.692	78-10-10	179-59-32	2.566	-175218.722386
9-352	41794.249	-68275.285	16.772	348-29-45	90-19-35	18.422	-1257767.300270
9-332	41810.684	-68278.630	12.520	258-29-27	89-59-42	13.937	-951599.266310
						倍面積	420.788500
						面積	210.3942500

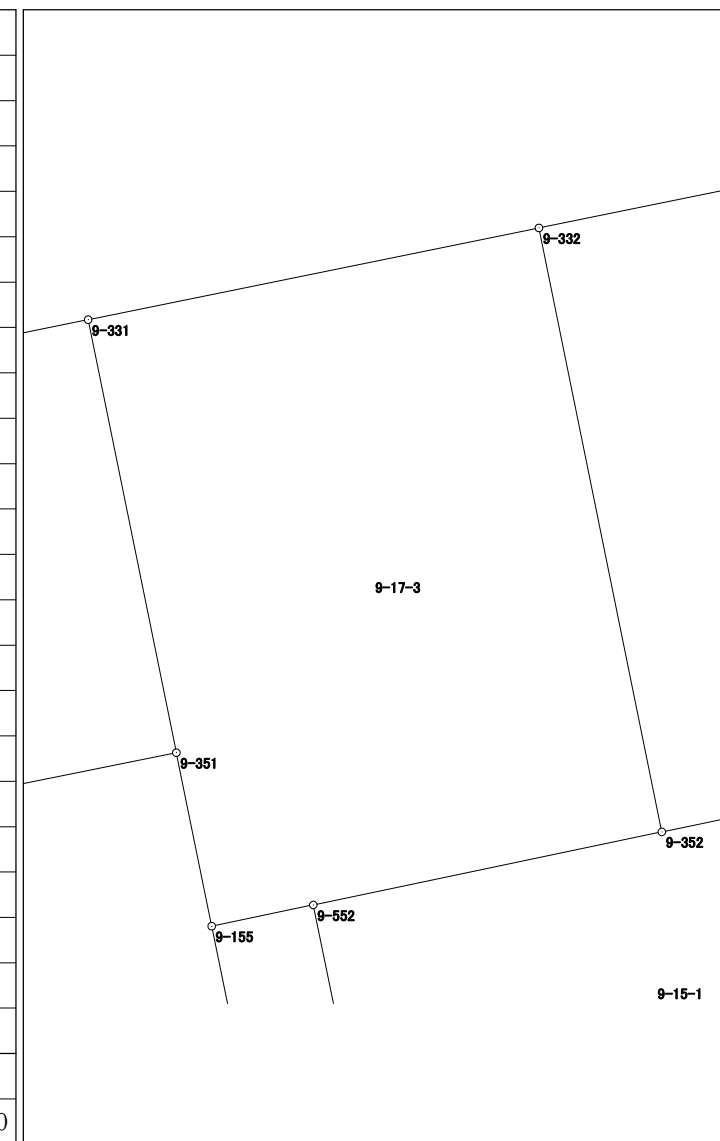


# 面積計算書（座標法）

世界測地系（測地成果2011）

所 在	地 番	公簿地目	現況地目	地 積	所 有 者
前橋市六供町一丁目	9-20-1			162.28 m <sup>2</sup>	

点 名	X 座標	Y 座標	辺 長	方 向 角	測 角	DX	倍 積 (Y×DX)
9-331	41808.186	-68290.898	13.503	258-29-46	90-00-42	9.087	-620559.390126
9-330	41805.493	-68304.130	12.015	168-28-40	89-58-54	-14.466	988087.544580
9-350	41793.720	-68301.730	13.502	78-31-31	90-02-51	-9.087	620657.820510
9-351	41796.406	-68288.498	12.022	348-29-04	89-57-33	14.466	-987861.412068
						倍面積	324.562896
						面 積	162.2814480

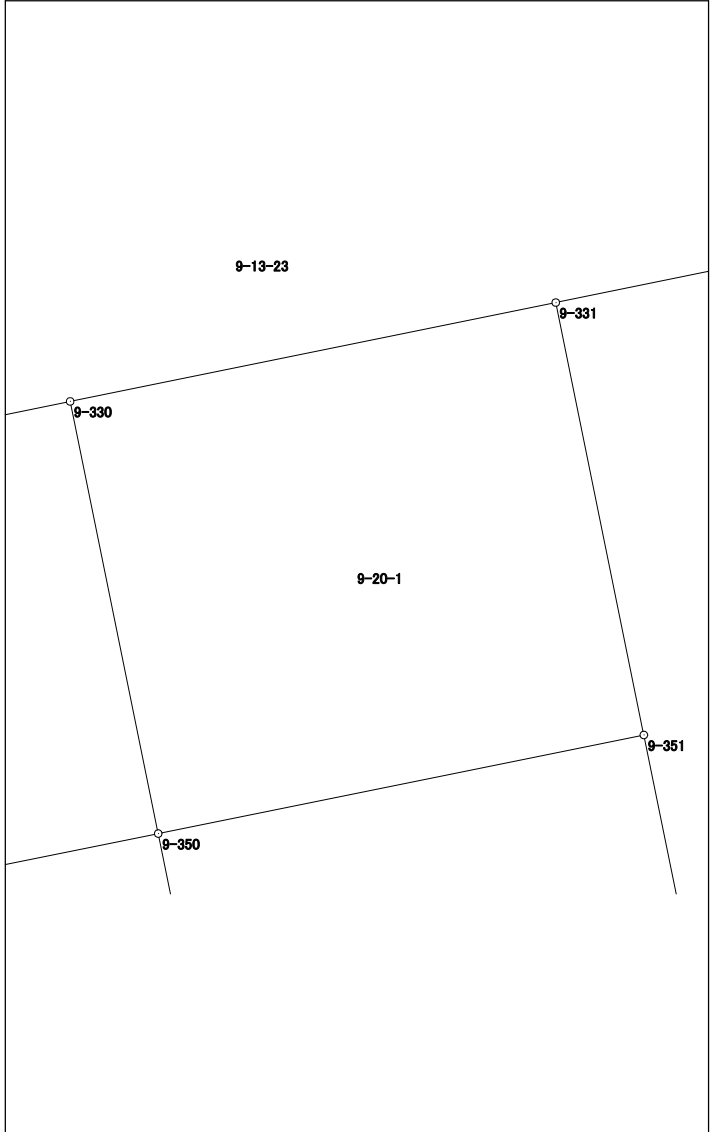


# 面積計算書（座標法）

世界測地系（測地成果2011）

所在	地番	公簿地目	現況地目	地積	所有者
前橋市六供町一丁目	9-20-2			160.66 m <sup>2</sup>	

点名	X座標	Y座標	辺長	方向角	測角	DX	倍積 (Y×DX)
9-350	41793.720	-68301.730	11.891	168-28-42	89-57-11	-14.337	979241.903010
9-230	41782.069	-68299.355	11.022	78-10-23	89-41-41	-9.392	641467.542160
9-67	41784.328	-68288.567	2.544	90-08-06	191-57-43	2.253	-153854.141451
9-156	41784.322	-68286.023	7.515	348-22-39	78-14-33	7.355	-502243.699165
9-155	41791.683	-68287.537	4.820	348-29-56	180-07-17	12.084	-825186.597108
9-351	41796.406	-68288.498	13.502	258-31-31	90-01-35	2.037	-139103.670426

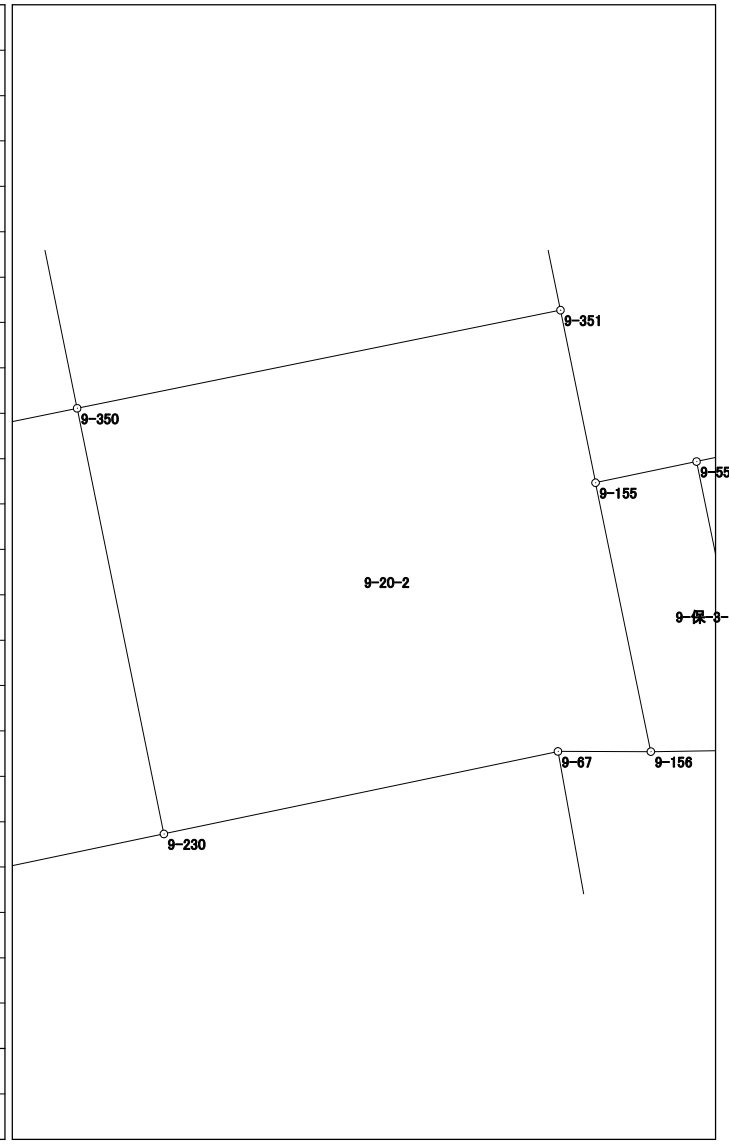


倍面積	321.337020
面積	160.6685100

# 面積計算書 (座標法)

世界測地系 (測地成果2011)

所在	地番	公簿地目	現況地目	地積	所有者
前橋市六供町一丁目	9-22			186.99 m <sup>2</sup>	

点名	X 座標	Y 座標	辺長	方向角	測角	DX	倍積 (Y×DX)
9-503	41916.836	-68309.840	10.379	348-20-37	89-56-41	13.332	-910706.786880
9-507	41927.001	-68311.937	1.496	348-21-07	180-00-30	11.630	-794467.827310
9-195	41928.466	-68312.239	3.142	258-22-44	90-01-37	0.832	-56835.782848
9-181	41927.833	-68315.317	12.574	258-32-27	180-09-43	-3.131	213895.257527
9-198	41925.335	-68327.640	11.905	168-30-08	89-57-41	-14.164	967792.692960
9-504	41913.669	-68325.267	15.749	78-23-56	89-53-48	-8.499	580696.444233

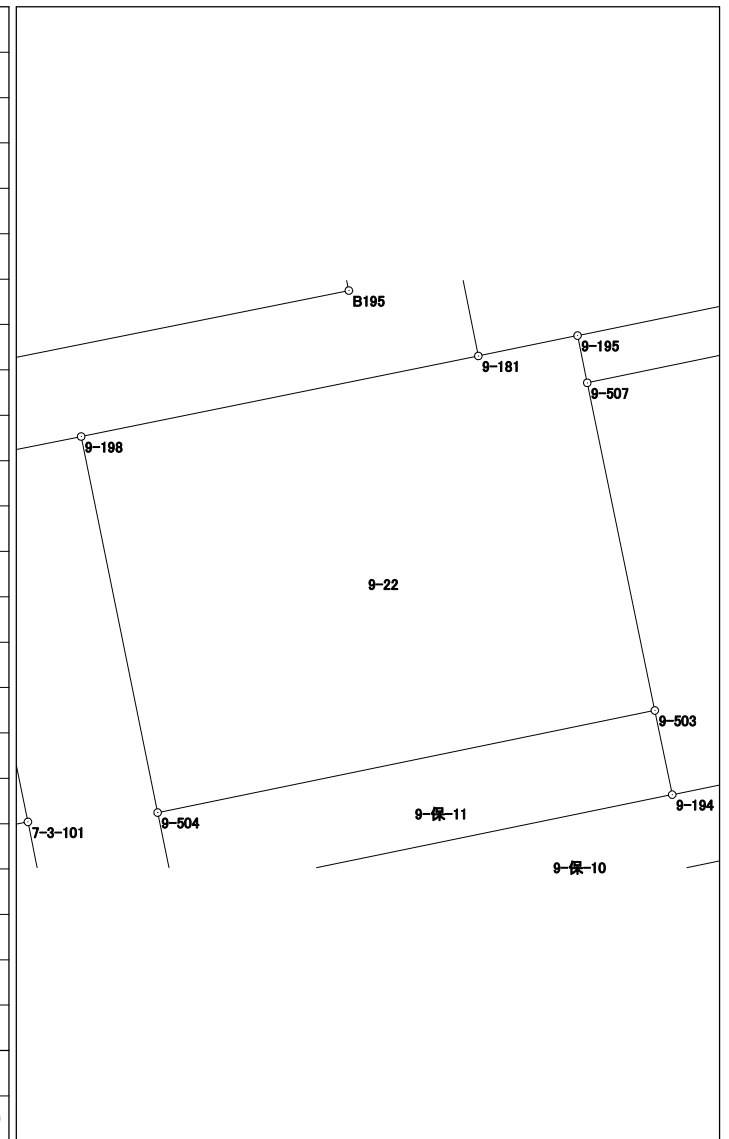

倍面積	373.997682
面積	186.9988410






# 面積計算書 (座標法)

世界測地系 (測地成果2011)

所 在	地 番	公簿地目	現況地目	地 積	所 有 者
前橋市六供町一丁目	9-23-2			162.92 m <sup>2</sup>	

点 名	X 座標	Y 座標	辺 長	方 向 角	測 角	DX	倍 積 (Y×DX)
9-324	41793.683	-68362.128	10.216	168-26-49	89-56-54	-13.204	902653.538112
9-345	41783.674	-68360.082	4.856	78-15-35	89-48-46	-9.021	616676.299722
9-523	41784.662	-68355.328	3.366	78-15-34	179-59-59	1.673	-114358.463744
9-239	41785.347	-68352.032	4.933	78-11-12	179-55-38	1.695	-115856.694240
9-549	41786.357	-68347.203	0.858	78-09-59	179-58-47	1.186	-81059.782758
9-547	41786.533	-68346.363	1.972	78-10-38	180-00-39	0.580	-39640.890540
9-346	41786.937	-68344.433	10.139	348-39-48	90-29-10	10.345	-707023.159385
9-325	41796.878	-68346.426	16.024	258-29-55	89-50-07	6.746	-461064.989796

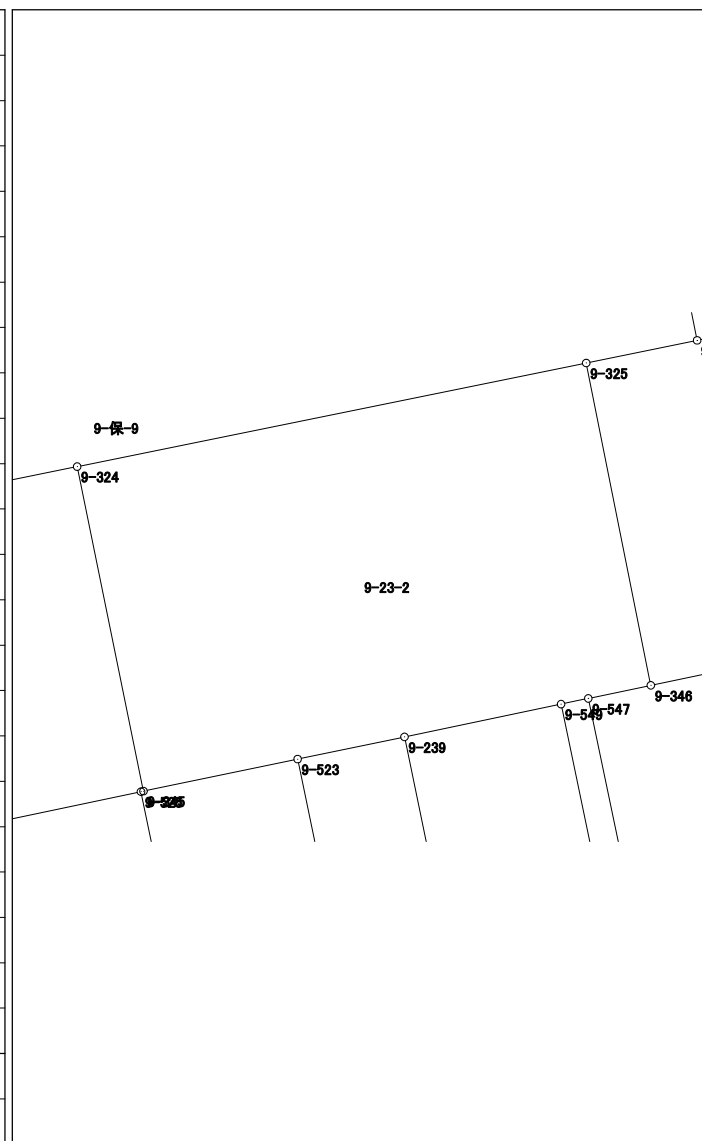


倍面積	325.857371
面 積	162.9286855

# 面積計算書（座標法）

世界測地系（測地成果2011）

所 在	地 番	公簿地目	現況地目	地 積	所 有 者
前橋市六供町一丁目	9-23-3			163.16 m <sup>2</sup>	

点 名	X 座標	Y 座標	辺 長	方 向 角	測 角	DX	倍 積 (Y×DX)
9-325	41796.878	-68346.426	10.139	168-39-48	90-10-45	-10.638	727069.279788
9-346	41786.937	-68344.433	2.705	78-13-29	89-33-41	-9.389	641685.881437
9-545	41787.489	-68341.785	1.574	78-14-00	180-00-31	0.873	-59662.378305
9-231	41787.810	-68340.244	10.042	78-10-07	179-56-07	2.380	-162649.780720
9-527	41789.869	-68330.415	1.850	78-08-59	179-58-52	2.439	-166657.882185
9-347	41790.249	-68328.604	10.055	348-30-32	90-21-33	10.233	-699206.604732
9-328	41800.102	-68330.607	12.653	258-28-47	89-58-15	7.326	-500590.026882
9-571	41797.575	-68343.005	3.491	258-29-03	180-00-16	-3.224	220337.848120

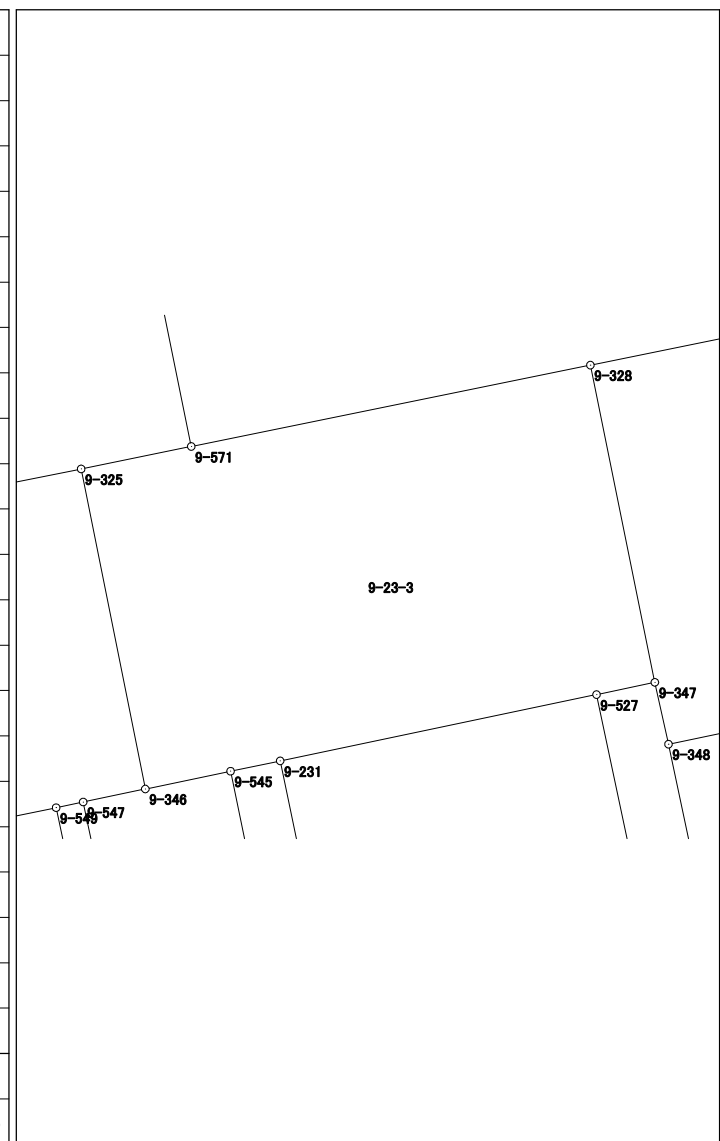


倍面積	326.336521
面 積	163.1682605

# 面積計算書 (座標法)

世界測地系 (測地成果2011)

所在	地番	公簿地目	現況地目	地積	所有者
前橋市六供町一丁目	9-23-4			162.31 m <sup>2</sup>	

点名	X座標	Y座標	辺長	方向角	測角	DX	倍積 (Y×DX)
9-328	41800.102	-68330.607	10.055	168-30-32	90-01-40	-12.550	857549.117850
9-347	41790.249	-68328.604	1.967	167-33-12	179-02-40	-11.774	804500.983496
9-348	41788.328	-68328.180	13.478	78-27-09	90-53-57	0.777	-53090.995860
9-349	41791.026	-68314.975	12.015	348-29-14	90-02-05	14.471	-988586.003225
9-329	41802.799	-68317.373	13.506	258-28-52	89-59-38	9.076	-620048.477348
						倍面積	324.624913
						面積	162.3124565

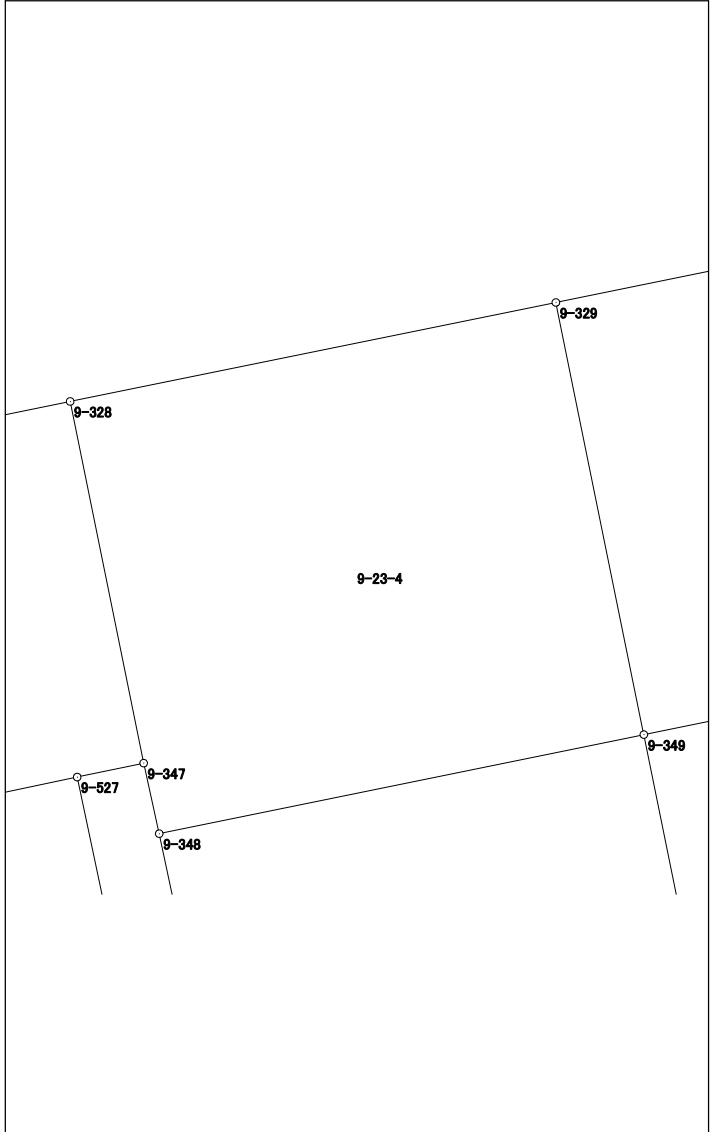


# 面積計算書 (座標法)

世界測地系 (測地成果2011)

所在	地番	公簿地目	現況地目	地積	所有者
前橋市六供町一丁目	9-23-5			162.38 m <sup>2</sup>	

点名	X座標	Y座標	辺長	方向角	測角	DX	倍積 (Y×DX)
9-329	41802.799	-68317.373	12.015	168-29-14	89-59-09	-14.467	988347.435191
9-349	41791.026	-68314.975	13.516	78-30-11	90-00-57	-9.079	620231.658025
9-350	41793.720	-68301.730	12.015	348-28-40	89-58-29	14.467	-988121.127910
9-330	41805.493	-68304.130	13.514	258-30-05	90-01-25	9.079	-620133.196270
						倍面積	324.769036
						面積	162.3845180

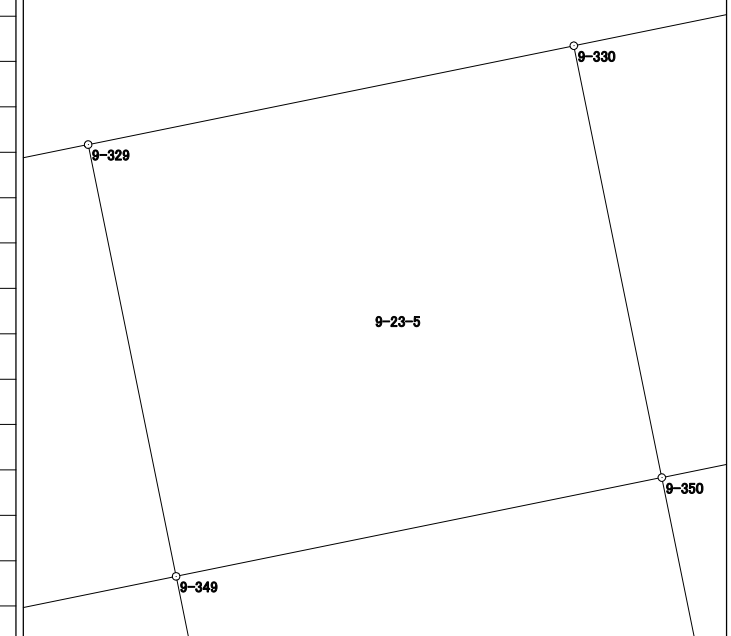


# 面積計算書（座標法）

世界測地系（測地成果2011）

所在	地番	公簿地目	現況地目	地積	所有者
前橋市六供町一丁目	9-23-6			161.09 m <sup>2</sup>	

点名	X座標	Y座標	辺長	方向角	測角	DX	倍積 (Y×DX)
9-348	41788.328	-68328.180	12.021	168-07-25	89-40-16	-14.462	988162.139160
9-344	41776.564	-68325.706	13.386	78-12-54	90-05-29	-9.030	616981.125180
9-343	41779.298	-68312.602	11.966	348-33-41	90-20-47	14.462	-987936.850124
9-349	41791.026	-68314.975	13.478	258-27-09	89-53-28	9.030	-616884.224250
倍面積							322.189966
面積							161.0949830

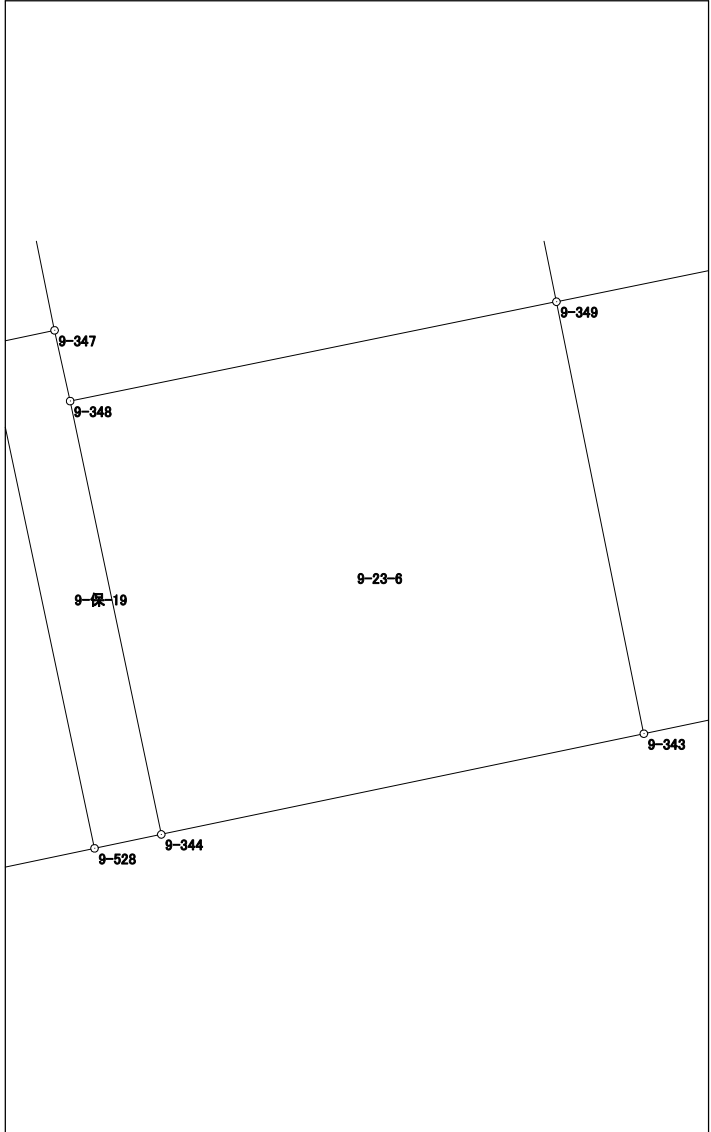


# 面積計算書 (座標法)

世界測地系 (測地成果2011)

所 在	地 番	公簿地目	現況地目	地 積	所 有 者
前橋市六供町一丁目	9-23-7			161.32 m <sup>2</sup>	

点 名	X 座標	Y 座標	辺 長	方 向 角	測 角	DX	倍 積 (Y×DX)
9-349	41791.026	-68314.975	11.966	168-33-41	90-03-30	-14.422	985238.569450
9-343	41779.298	-68312.602	13.534	78-11-07	89-37-26	-8.957	611875.976114
9-230	41782.069	-68299.355	11.891	348-28-42	90-17-35	14.422	-985013.297810
9-350	41793.720	-68301.730	13.516	258-30-11	90-01-29	8.957	-611778.595610
						倍面積	322.652144
						面 積	161.3260720

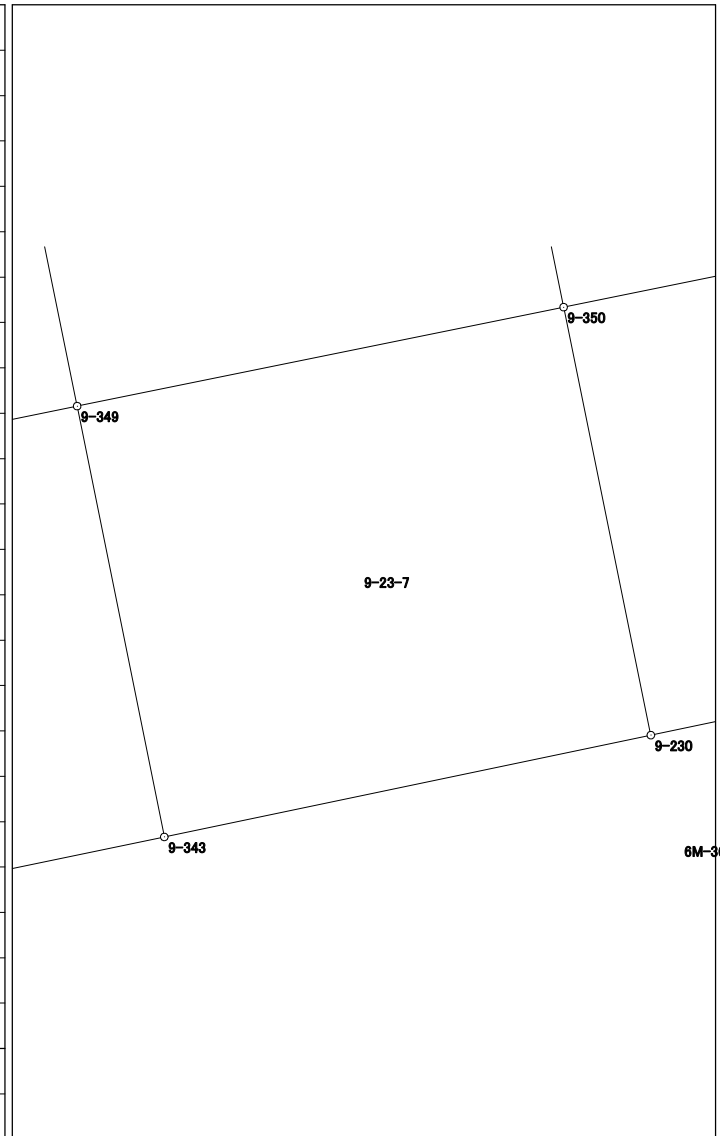

# 面積計算書 (座標法)

世界測地系 (測地成果2011)


所在	地番	公簿地目	現況地目	地積	所有者
前橋市六供町一丁目	9-24-1-1			117.80 m <sup>2</sup>	

点名	X座標	Y座標	辺長	方向角	測角	D <sub>X</sub>	倍積 (Y×D <sub>X</sub> )	
9-567	41813.415	-68359.036	3.842	78-28-04	89-58-00	-5.116	349724.828176	
9-274	41814.183	-68355.272	13.036	78-30-48	180-02-44	3.364	-229947.135008	
9-275	41816.779	-68342.497	2.746	78-28-09	179-57-21	3.145	-214937.153065	
9-569	41817.328	-68339.806	6.004	348-27-42	89-59-33	6.432	-439561.632192	
9-570	41823.211	-68341.007	1.415	258-27-35	89-59-53	5.600	-382709.639200	
9-301	41822.928	-68342.393	13.775	258-30-06	180-02-31	-3.029	207009.108397	
9-302	41820.182	-68355.892	4.430	258-30-09	180-00-03	-3.629	248063.532068	
9-568	41819.299	-68360.233	6.005	168-30-04	89-59-55	-6.767	462593.696711	
						倍面積	235.605887	
						面積	117.8029435	

# 面積計算書（座標法）

世界測地系（測地成果2011）

所在	地番	公簿地目	現況地目	地積	所有者
前橋市六供町一丁目	9-24-1-2			74.29 m <sup>2</sup>	

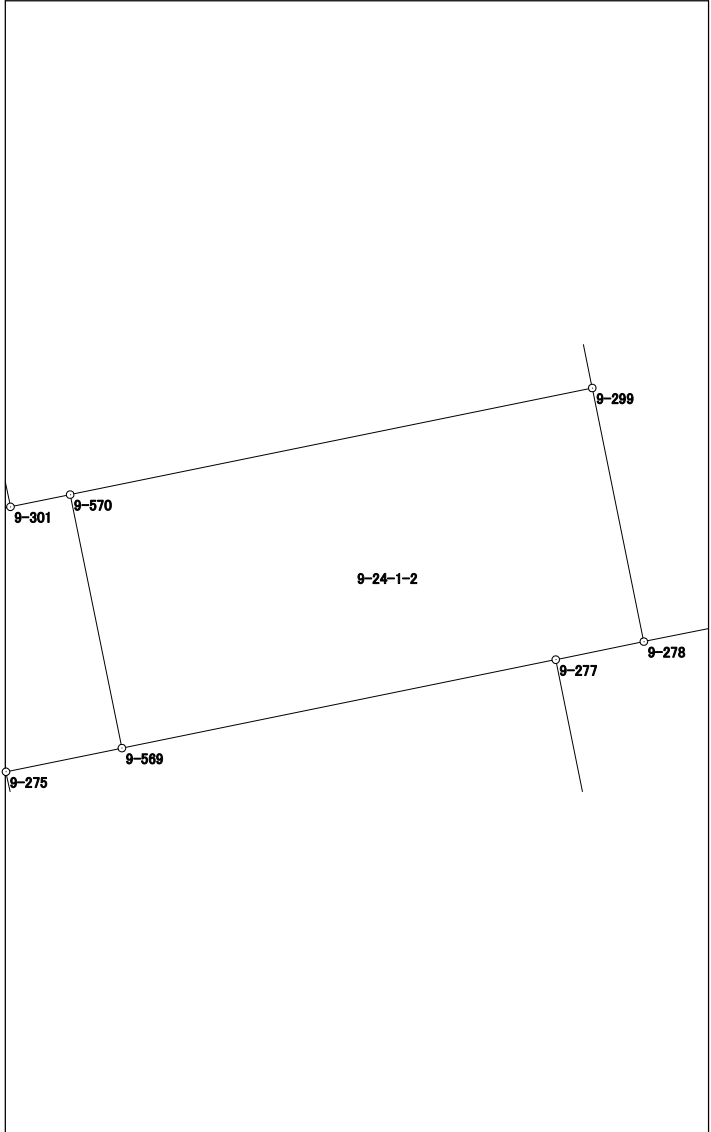点名	X座標	Y座標	辺長	方向角	測角	DX	倍積 (Y×DX)		
9-569	41817.328	-68339.806	10.279	78-28-45	90-01-03	-3.830	261741.456980		
9-277	41819.381	-68329.734	2.087	78-25-15	179-56-30	2.472	-168911.102448		
9-278	41819.800	-68327.689	6.006	348-30-18	90-05-03	6.305	-430806.079145		
9-299	41825.686	-68328.886	12.371	258-27-34	89-57-16	3.411	-233069.830146		
9-570	41823.211	-68341.007	6.004	168-27-42	90-00-08	-8.358	571194.136506		
							倍面積		148.581747
							面積		74.2908735




# 面積計算書 (座標法)

世界測地系 (測地成果2011)

所在	地番	公簿地目	現況地目	地積	所有者
前橋市六供町一丁目	9-24-2-1			24.20 m <sup>2</sup>	

点名	X座標	Y座標	辺長	方向角	測角	DX	倍積 (Y×DX)
9-281	41823.852	-68307.710	3.581	78-23-09	89-51-31	-5.167	352945.937570
9-282	41824.573	-68304.202	0.472	78-31-25	180-08-16	0.815	-55667.924630
9-565	41824.667	-68303.739	6.002	348-04-40	89-33-15	5.967	-407568.410613
9-566	41830.540	-68304.979	4.007	258-28-57	90-24-17	5.073	-346511.158467
9-298	41829.740	-68308.905	6.008	168-31-38	90-02-41	-6.688	456849.956640
						倍面積	48.400500
						面積	24.2002500

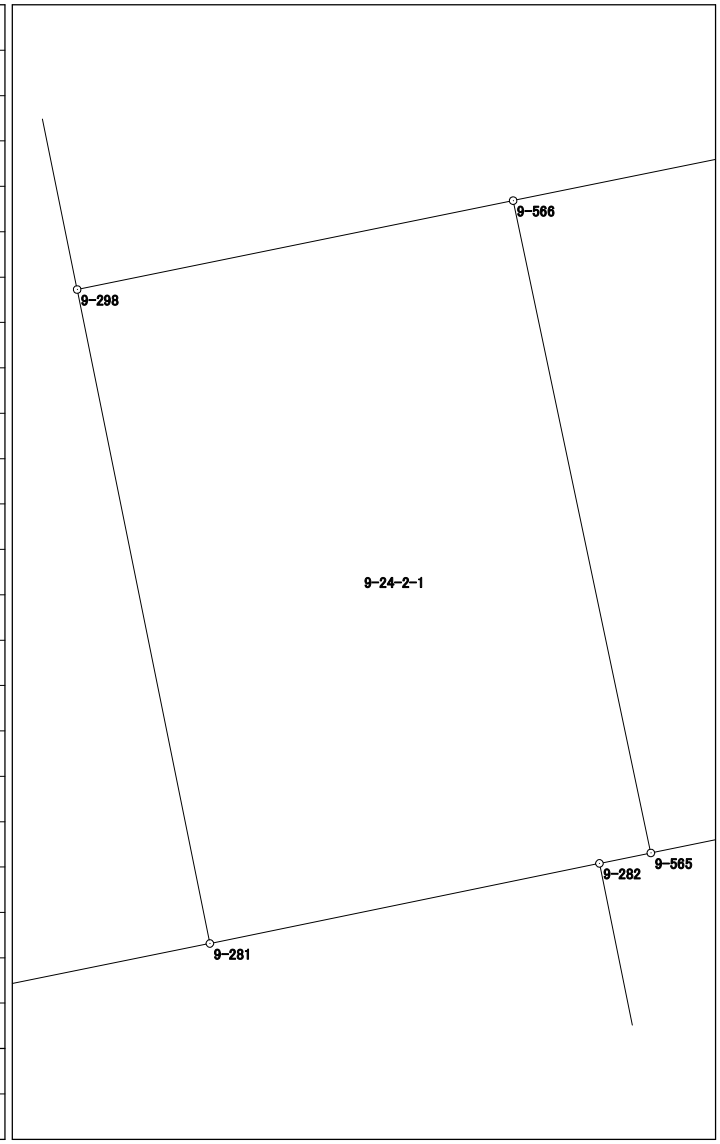


# 面積計算書 (座標法)

世界測地系 (測地成果2011)

所 在	地 番	公簿地目	現況地目	地 積	所 有 者
前橋市六供町一丁目	9-24-2-2			355.07 m <sup>2</sup>	

点 名	X 座標	Y 座標	辺 長	方 向 角	測 角	DX	倍 積 (Y×DX)
9-565	41824.667	-68303.739	12.564	78-29-42	90-25-02	-3.367	229978.689213
9-284	41827.173	-68291.427	13.027	78-28-59	179-59-17	5.107	-348764.317689
9-285	41829.774	-68278.662	13.037	78-30-51	180-01-52	5.197	-354844.206414
9-286	41832.370	-68265.886	13.028	78-29-33	179-58-42	5.195	-354641.277770
9-287	41834.969	-68253.120	7.464	78-28-40	179-59-07	4.090	-279155.260800
9-564	41836.460	-68245.806	6.008	348-05-23	89-36-43	7.370	-502971.590220
9-563	41842.339	-68247.046	8.018	258-29-48	90-24-25	4.280	-292097.356880
9-292	41840.740	-68254.903	13.781	258-28-21	179-58-33	-4.353	297113.592759
9-293	41837.986	-68268.406	0.969	258-30-58	180-02-37	-2.947	201186.992482
9-562	41837.793	-68269.356	12.806	258-30-02	179-59-04	-2.746	187467.651576
9-295	41835.240	-68281.905	13.783	258-29-28	179-59-26	-5.303	362098.942215
9-296	41832.490	-68295.411	9.765	258-28-50	179-59-22	-4.700	320988.431700
9-566	41830.540	-68304.979	6.002	168-04-40	89-35-50	-7.823	534349.850717
						倍面積	710.140889
						面 積	355.0704445

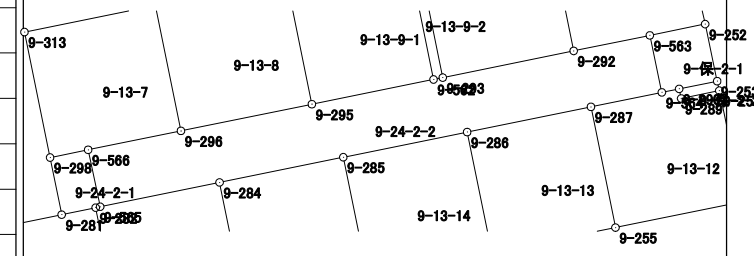


# 面積計算書（座標法）

世界測地系（測地成果2011）

所在	地番	公簿地目	現況地目	地積	所有者
前橋市六供町一丁目	9-26-1			3967.74 m <sup>2</sup>	

点名	X座標	Y座標	辺長	方向角	測角	DX	倍積 (Y×DX)
7-1-24	41881.279	-68397.179	54.902	168-15-16	89-49-14	-56.497	3864235.421963
9-221	41827.527	-68386.003	14.258	78-30-23	90-15-07	-50.911	3481599.798733
9-307	41830.368	-68372.031	13.775	78-28-50	179-58-27	5.592	-382336.397352
9-308	41833.119	-68358.533	13.777	78-29-40	180-00-50	5.499	-375903.572967
9-309	41835.867	-68345.033	13.786	78-29-22	179-59-42	5.499	-375829.336467
9-310	41838.618	-68331.524	10.204	78-30-26	180-01-04	4.784	-326898.010816
9-311	41840.651	-68321.525	4.372	78-32-09	180-01-43	2.902	-198269.065550
9-312	41841.520	-68317.240	41.616	348-30-15	89-58-06	41.650	-2845413.046000
9-319	41882.301	-68325.534	7.807	78-34-14	270-03-59	42.328	-2892083.203152
9-320	41883.848	-68317.882	13.415	348-29-36	89-55-22	14.692	-1003726.322344
9-251	41896.993	-68320.558	1.291	258-55-30	90-25-54	12.897	-881130.236526
9-199	41896.745	-68321.825	4.011	258-16-31	179-21-01	-1.063	72626.099975
7-3-1	41895.930	-68325.752	12.506	258-25-53	180-09-22	-3.323	227046.473896
7-3-5	41893.422	-68338.004	4.001	258-25-24	179-59-31	-3.311	226267.131244
7-2-7	41892.619	-68341.924	12.998	258-24-42	179-59-18	-3.414	233319.328536
7-2-21	41890.008	-68354.657	12.816	258-25-22	180-00-40	-5.183	354282.187231
7-2-11	41887.436	-68367.212	4.002	258-21-11	179-55-49	-3.380	231081.176560
7-1-8	41886.628	-68371.132	12.900	258-21-14	180-00-03	-3.412	233282.302384
7-1-20	41884.024	-68383.766	13.691	258-26-02	180-04-48	-5.349	365784.764334

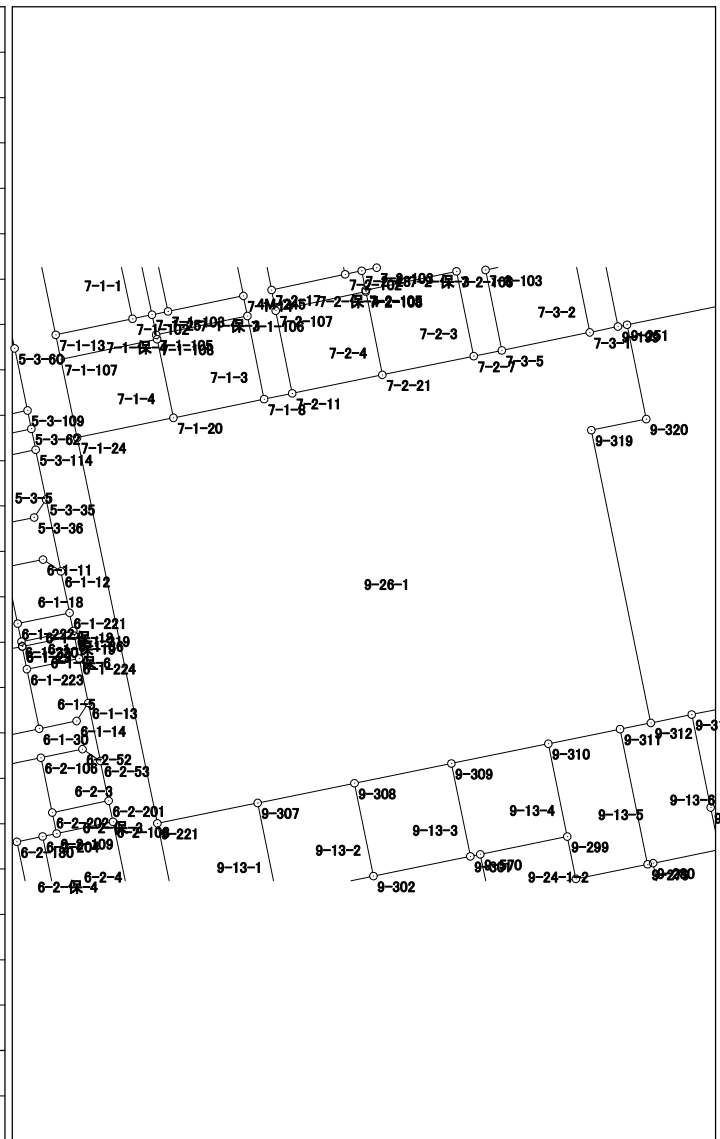


倍面積	7935.493682
面積	3967.7468410

# 面積計算書（座標法）

世界測地系（測地成果2011）

所在	地番	公簿地目	現況地目	地積	所有者
前橋市六供町一丁目	9-26-2			3991.79 m <sup>2</sup>	

点名	X座標	Y座標	辺長	方向角	測角	DX	倍積 (Y×DX)
9-251	41896.993	-68320.558	13.415	168-29-36	90-03-39	-17.597	1202236.859126
9-320	41883.848	-68317.882	7.807	258-34-14	270-04-38	-14.692	1003726.322344
9-319	41882.301	-68325.534	41.616	168-30-15	89-56-01	-42.328	2892083.203152
9-312	41841.520	-68317.240	5.808	78-26-19	89-56-04	-39.617	2706524.097080
9-313	41842.684	-68311.550	13.781	78-29-51	180-03-32	3.912	-267234.783600
9-314	41845.432	-68298.046	13.783	78-30-12	180-00-21	5.495	-375297.762770
9-315	41848.179	-68284.540	12.801	78-30-52	180-00-40	5.296	-361634.923840
9-561	41850.728	-68271.995	0.970	78-31-41	180-00-49	2.742	-187201.810290
9-317	41850.921	-68271.044	13.778	78-30-59	179-59-18	2.936	-200443.785184
9-318	41853.664	-68257.542	13.739	78-27-43	179-56-44	5.491	-374802.163122
9-222	41856.412	-68244.081	55.109	347-58-12	89-30-29	56.647	-3865822.456407
9-114	41910.311	-68255.567	10.333	258-25-17	90-27-05	51.825	-3537344.759775
9-513	41908.237	-68265.690	7.598	258-25-15	179-59-58	-3.599	245688.218310
9-511	41906.712	-68273.133	1.601	258-26-15	180-01-00	-1.846	126032.203518
9-191	41906.391	-68274.702	3.035	258-25-25	179-59-10	-0.930	63495.472860
9-510	41905.782	-68277.675	8.867	258-25-08	179-59-43	-2.389	163115.365575
9-193	41904.002	-68286.361	12.706	258-23-25	179-58-17	-4.337	296157.947657
9-196	41901.445	-68298.807	22.202	258-25-57	180-02-32	-7.009	478706.338263

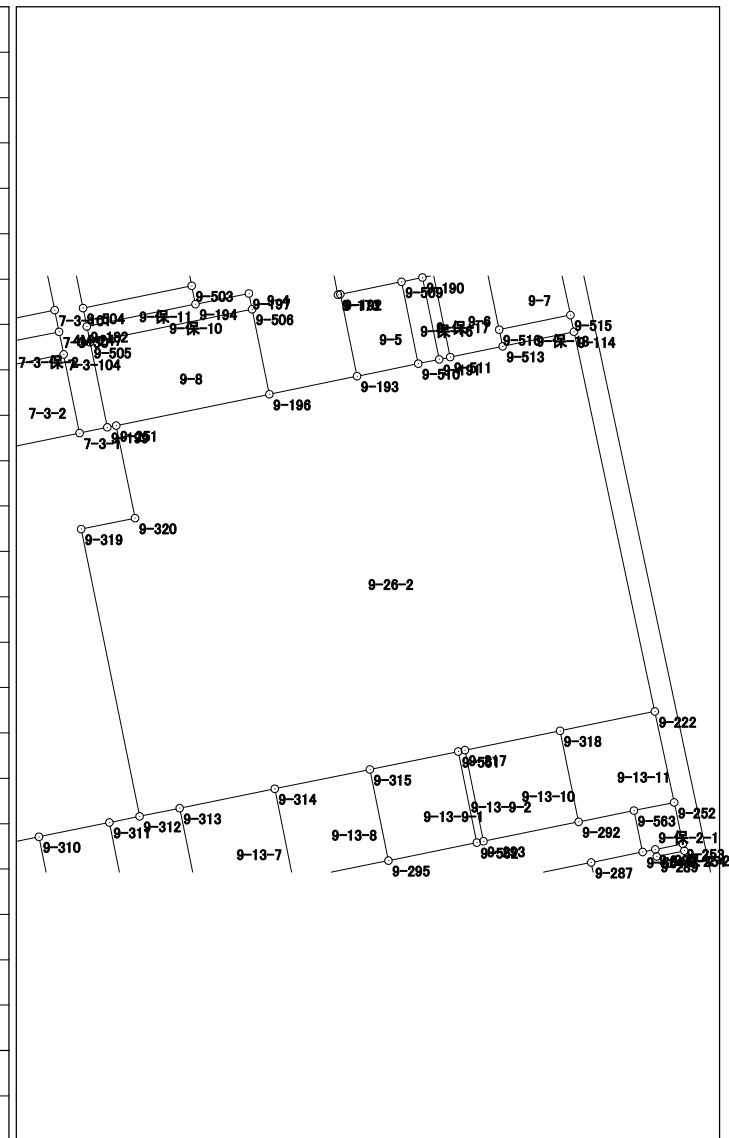


倍面積	7983.582897
面積	3991.7914485

# 面積計算書 (座標法)

世界測地系 (測地成果2011)

所在	地番	公簿地目	現況地目	地積	所有者
前橋市六供町一丁目	9-28			65.37 m <sup>2</sup>	

点名	X座標	Y座標	辺長	方向角	測角	Dx	倍積 (Y×Dx)
9-545	41787.489	-68341.785	2.705	258-13-29	90-01-01	13.133	-897532.662405
9-346	41786.937	-68344.433	1.972	258-10-38	179-57-09	-0.956	65337.277948
9-547	41786.533	-68346.363	13.979	168-12-25	90-01-47	-14.088	962863.561944
9-548	41772.849	-68343.506	4.677	78-13-00	90-00-35	-12.729	869944.487874
9-546	41773.804	-68338.928	13.980	348-12-28	89-59-28	14.640	-1000481.905920
						倍面積	130.759441
						面積	65.3797205

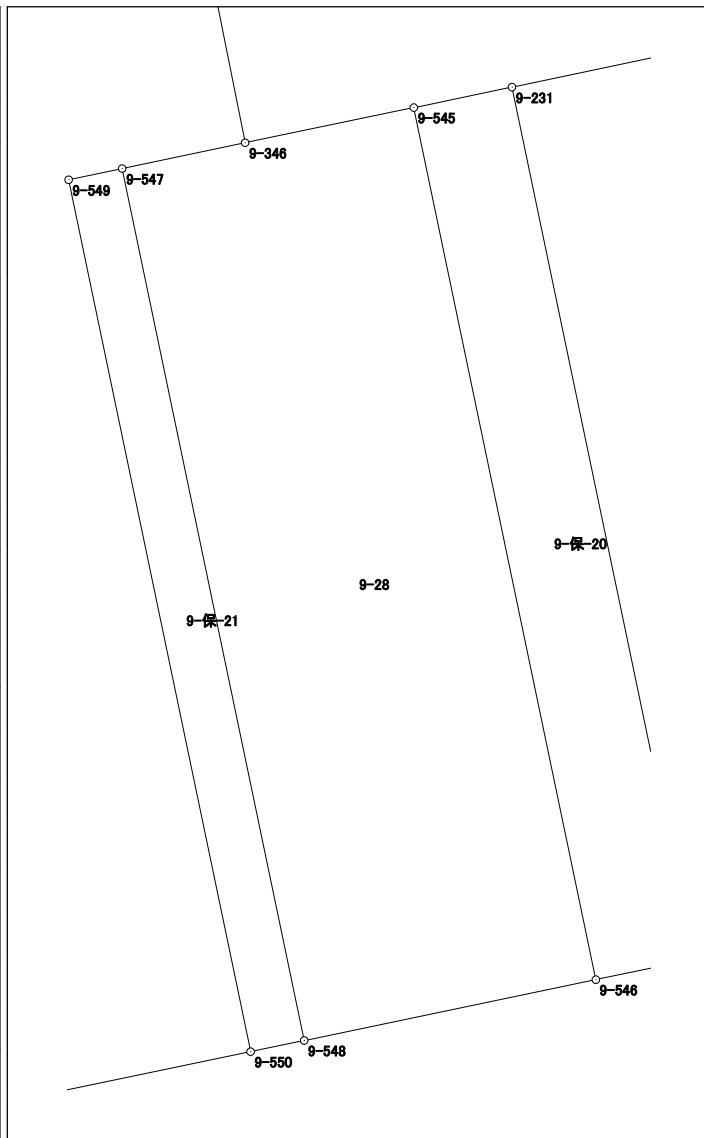


# 面積計算書（座標法）

世界測地系（測地成果2011）

所在	地番	公簿地目	現況地目	地積	所有者
前橋市六供町一丁目	9-29			68.96 m <sup>2</sup>	

点名	X座標	Y座標	辺長	方向角	測角	DX	倍積 (Y×DX)
9-549	41786.357	-68347.203	4.933	258-11-12	89-58-35	12.673	-866164.103619
9-239	41785.347	-68352.032	13.977	168-12-48	90-01-36	-14.692	1004228.054144
9-240	41771.665	-68349.177	4.934	78-12-02	89-59-14	-12.673	866189.120121
9-550	41772.674	-68344.347	13.978	348-12-37	90-00-35	14.692	-1004115.146124

倍面積	137.924522
面積	68.9622610

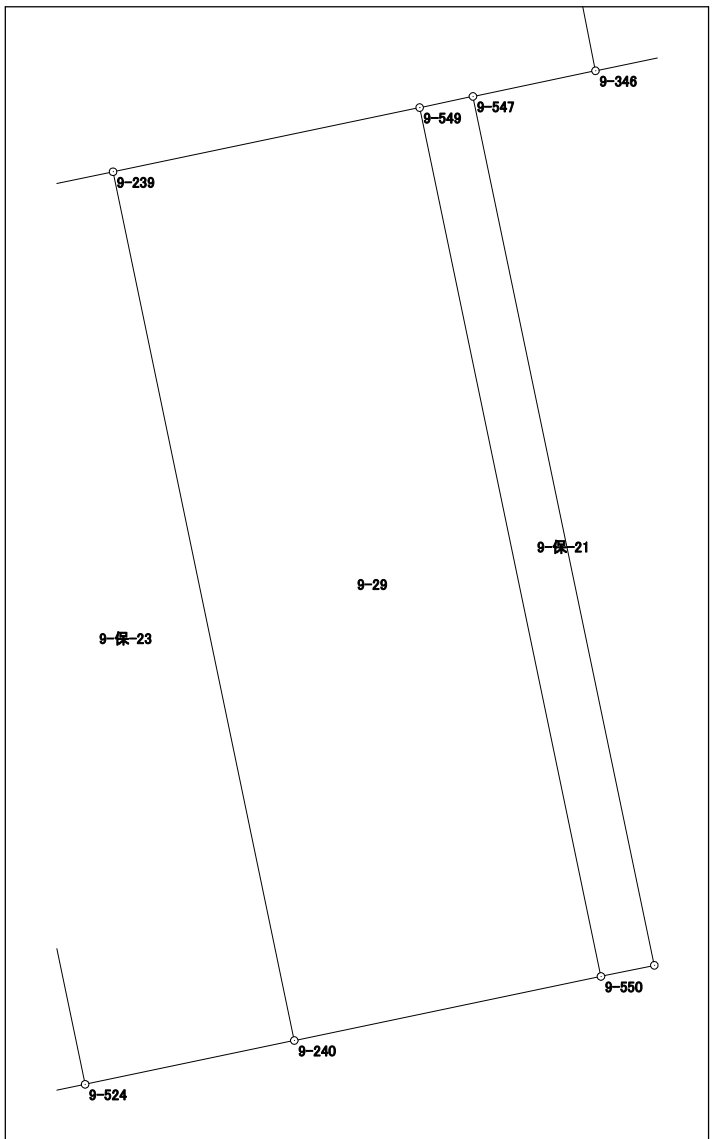


# 面積計算書 (座標法)

世界測地系 (測地成果2011)

所 在	地 番	公簿地目	現況地目	地 積	所 有 者
前橋市六供町一丁目	9-31			225.29 m <sup>2</sup>	

点 名	X 座標	Y 座標	辺 長	方 向 角	測 角	DX	倍 積 (Y×DX)
9-525	41783.658	-68360.159	16.384	258-08-54	89-56-13	10.329	-706092.082311
9-98	41780.293	-68376.194	11.148	168-18-15	90-09-21	-14.282	976548.802708
9-27	41769.376	-68373.934	3.990	123-22-32	135-04-17	-13.112	896519.022608
9-26	41767.181	-68370.602	13.589	78-10-56	134-48-24	0.588	-40201.913976
9-526	41769.964	-68357.301	13.989	348-12-41	90-01-45	16.477	-1126323.248577
						倍面積	450.580452
						面 積	225.2902260

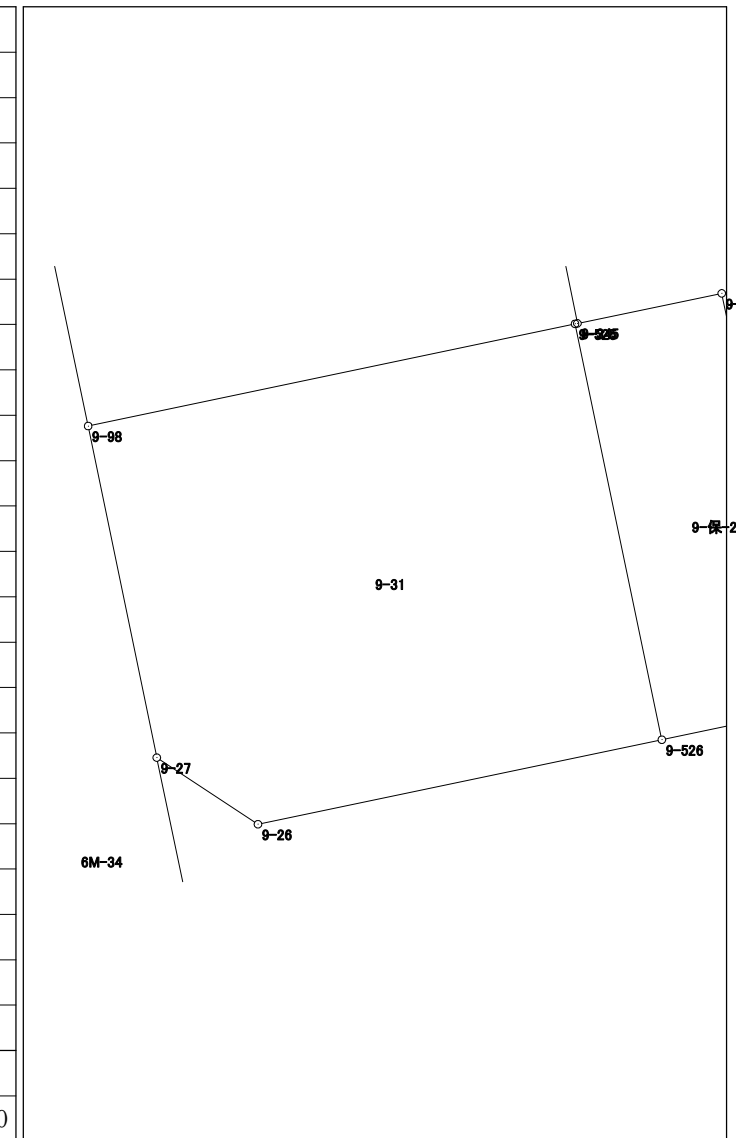


# 面積計算書 (座標法)

世界測地系 (測地成果2011)

所在	地番	公簿地目	現況地目	地積	所有者
前橋市六供町一丁目	9-保-1-1			154.00 m <sup>2</sup>	

点名	X座標	Y座標	辺長	方向角	測角	DX	倍積 (Y×DX)
9-306	41818.066	-68384.043	13.106	168-18-58	44-48-12	-10.064	688217.008752
9-269	41805.232	-68381.389	1.407	33-19-03	45-00-05	-11.658	797190.232962
9-270	41806.408	-68380.616	3.614	33-20-18	180-01-15	4.195	-286856.684120
9-271	41809.427	-68378.630	10.807	78-30-52	225-10-34	5.171	-353585.895730
9-272	41811.579	-68368.039	9.188	78-28-25	179-57-33	3.988	-272651.739532
9-567	41813.415	-68359.036	6.005	348-30-04	90-01-39	7.720	-527731.757920
9-568	41819.299	-68360.233	9.354	258-29-35	89-59-31	4.018	-274671.416194
9-304	41817.433	-68369.399	10.677	258-27-16	179-57-41	-4.003	273682.704197
9-305	41815.296	-68379.860	5.017	303-30-46	225-03-30	0.633	-43284.451380

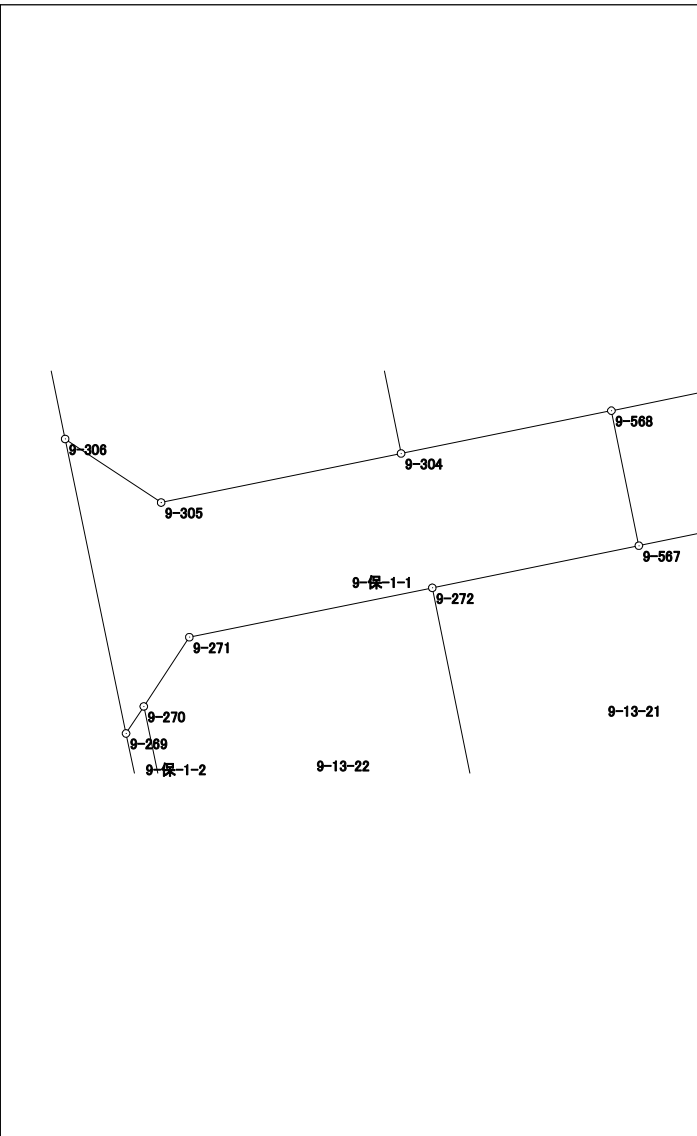

倍面積	308.001035
面積	154.0005175



## 面積計算書（座標法）

世界測地系（測地成果2011）

所 在	地 番	公簿地目	現況地目	地 積	所 有 者
前橋市六供町一丁目	9-保-1-2			4.01 m <sup>2</sup>	

点 名	X 座 標	Y 座 標	辺 長	方 向 角	測 角	DX	倍 積 (Y×DX)
9-270	41806.408	-68380.616	1.407	213-19-03	45-13-54	3.246	-221963.479536
9-269	41805.232	-68381.389	3.511	168-07-59	134-48-56	-4.612	315374.966068
9-267	41801.796	-68380.667	1.002	79-04-17	90-56-18	-3.246	221963.645082
9-268	41801.986	-68379.683	4.519	348-05-09	89-00-52	4.612	-315367.097996
倍面積							8.033618
面 積							4.0168090


The diagram shows a quadrilateral polygon with vertices labeled 9-267, 9-268, 9-269, and 9-270. The polygon is oriented with 9-267 at the bottom, 9-268 at the right, 9-269 at the left, and 9-270 at the top. The interior of the polygon is labeled '9-保-1-2'. The vertices are connected by straight lines, and each vertex is marked with a small circle and its corresponding label.

# 面積計算書 (座標法)

世界測地系 (測地成果2011)

所在	地番	公簿地目	現況地目	地積	所有者
前橋市六供町一丁目	9-保-2-1			35.00 m <sup>2</sup>	

点名	X座標	Y座標	辺長	方向角	測角	DX	倍積 (Y×DX)
9-252	41843.501	-68241.340	5.823	258-29-22	90-24-24	4.723	-322303.848820
9-563	41842.339	-68247.046	6.008	168-05-23	89-36-01	-7.041	480527.450886
9-564	41836.460	-68245.806	1.826	78-29-57	90-24-34	-5.515	376375.620090
9-290	41836.824	-68244.017	3.998	78-34-29	180-04-32	1.156	-78890.083652
9-253	41837.616	-68240.098	6.015	348-04-58	89-30-29	6.677	-455639.134346

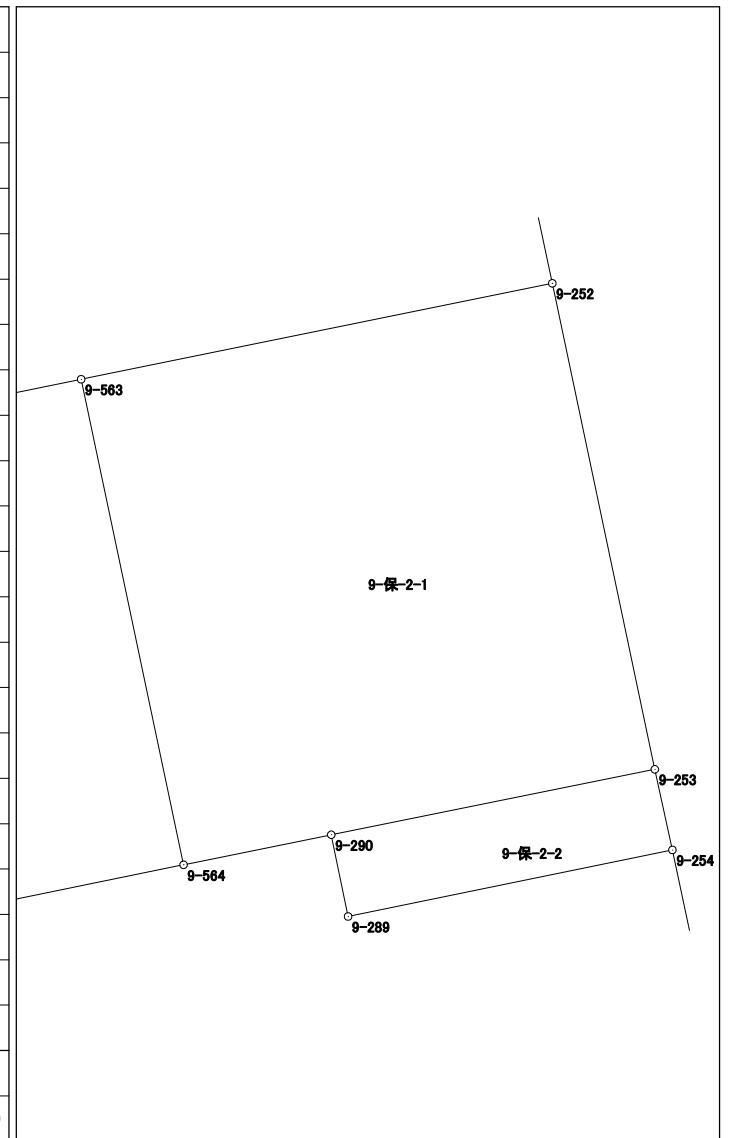


倍面積	70.004158
面積	35.0020790

# 面積計算書 (座標法)

世界測地系 (測地成果2011)

所在	地番	公簿地目	現況地目	地積	所有者
前橋市六供町一丁目	9-保-2-2			4.02 m <sup>2</sup>	

点名	X座標	Y座標	辺長	方向角	測角	DX	倍積 (Y×DX)
9-253	41837.616	-68240.098	3.998	258-34-29	90-53-09	0.184	-12556.178032
9-290	41836.824	-68244.017	1.011	168-21-24	89-46-55	-1.782	121610.838294
9-289	41835.834	-68243.813	4.010	78-24-15	90-02-51	-0.184	12556.861592
9-254	41836.640	-68239.885	0.999	347-41-20	89-17-05	1.782	-121603.475070

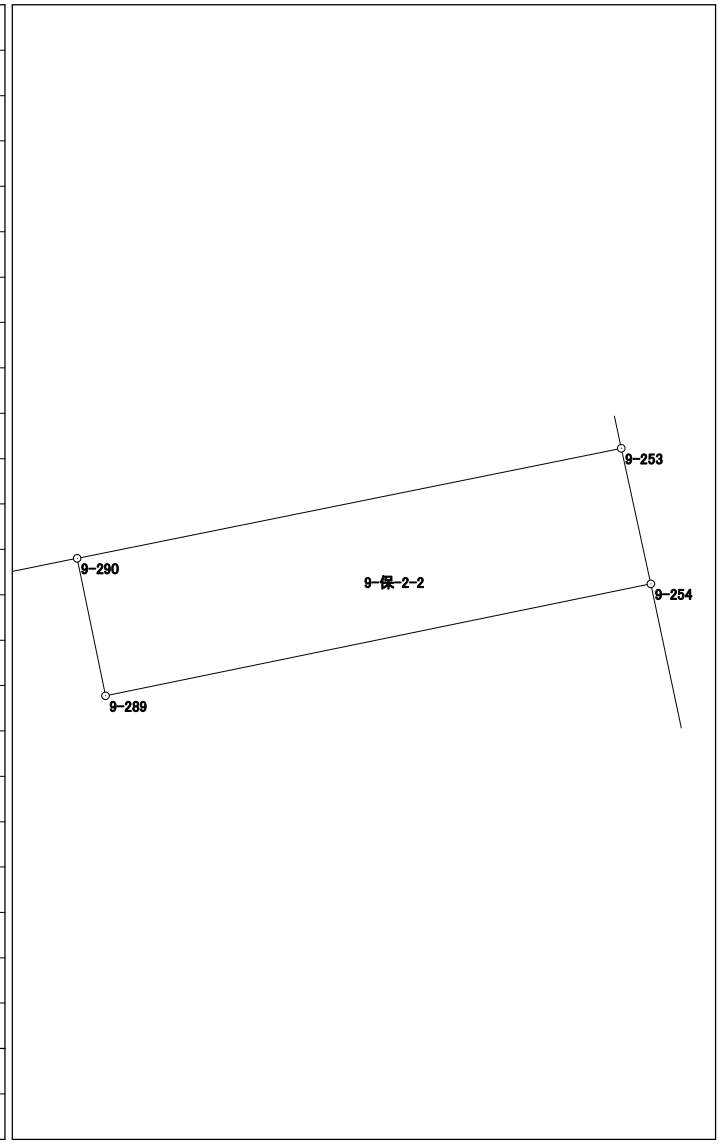


倍面積	8.046784
面積	4.0233920

## 面積計算書（座標法）

所在	地番	公簿地目	現況地目	地積	所有者
前橋市六供町一丁目	9-保-3-1			22.00 m <sup>2</sup>	

点名	X座標	Y座標	辺長	方向角	測角	DX	倍積 (Y×DX)
9-155	41791.683	-68287.537	7.515	168-22-39	90-12-01	-7.940	542203.043780
9-156	41784.322	-68286.023	2.487	89-13-00	100-50-21	-7.327	500331.690521
9-66	41784.356	-68283.536	0.383	78-15-00	169-02-00	0.112	-7647.756032
9-551	41784.434	-68283.161	7.992	348-22-41	90-07-41	7.906	-539846.670866
9-552	41792.262	-68284.771	2.826	258-10-38	89-47-57	7.249	-494996.304979

倍面積	44.002424
面積	22.0012120

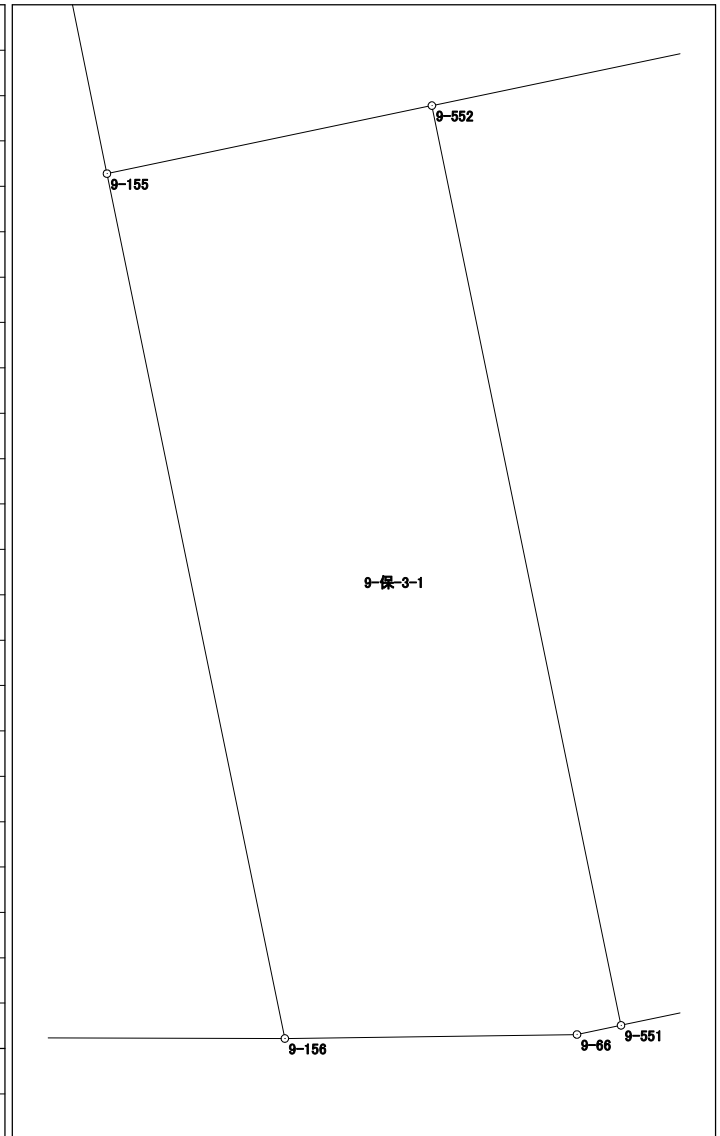


# 面積計算書 (座標法)

世界測地系 (測地成果2011)

所在	地番	公簿地目	現況地目	地積	所有者
前橋市六供町一丁目	9-保-3-2			21.00 m <sup>2</sup>	

点名	X 座標	Y 座標	辺長	方向角	測角	DX	倍積 (Y×DX)
9-556	41798.689	-68253.671	10.057	167-48-47	269-14-35	-8.754	597492.635934
9-555	41788.859	-68251.548	0.844	78-02-17	90-13-30	-9.655	658968.695940
9-357	41789.034	-68250.722	2.095	347-57-38	89-55-21	2.224	-151789.605728
9-532	41791.083	-68251.159	10.511	347-57-28	179-59-50	12.329	-841468.539311
9-356	41801.363	-68253.352	3.390	258-31-51	90-34-23	9.606	-655641.699312
9-153	41800.689	-68256.674	3.852	217-00-46	138-28-55	-3.750	255962.527500
9-154	41797.613	-68258.993	5.430	78-34-12	41-33-26	-2.000	136517.986000

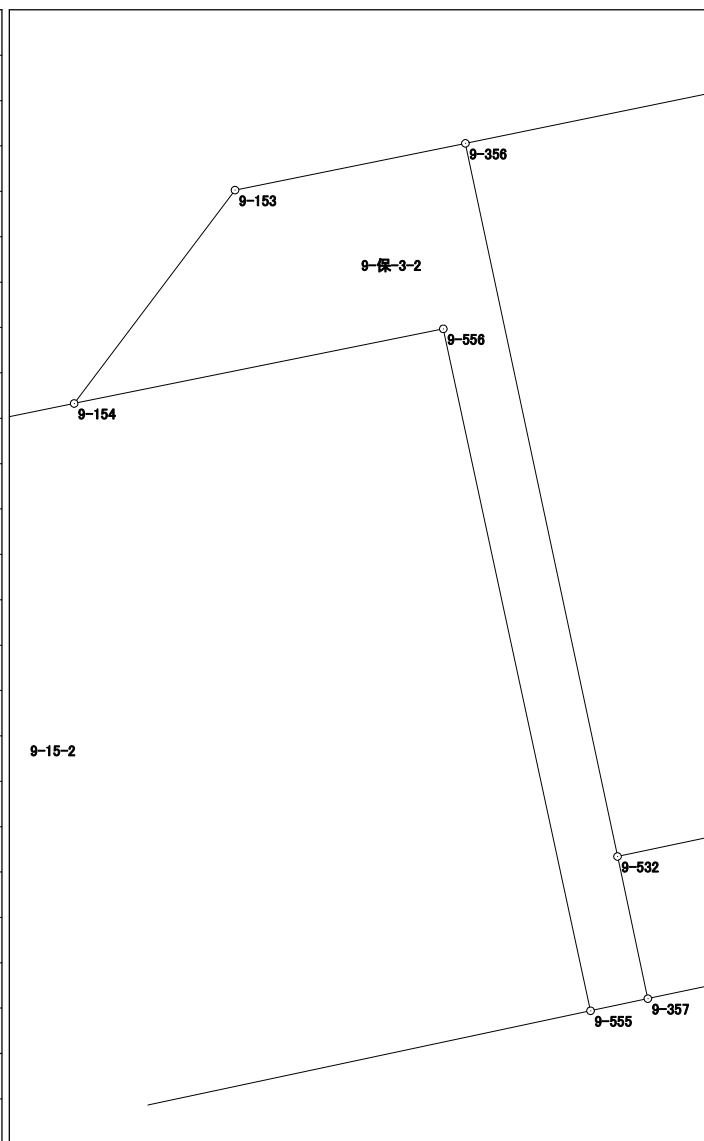

倍面積	42.001023
面積	21.0005115




# 面積計算書 (座標法)

世界測地系 (測地成果2011)

所 在	地 番	公簿地目	現況地目	地 積	所 有 者
前橋市六供町一丁目	9-保-3-4			22.00 m <sup>2</sup>	

点 名	X 座標	Y 座標	辺 長	方 向 角	測 角	DX	倍 積 (Y×DX)
9-360	41785.284	-68239.190	10.006	77-59-05	89-57-14	-0.068	4640.264920
9-339	41787.367	-68229.403	2.199	347-58-47	89-59-42	4.234	-288883.292302
9-533	41789.518	-68229.861	10.004	257-58-57	90-00-10	0.068	-4639.630548
9-534	41787.435	-68239.646	2.199	168-01-51	90-02-54	-4.234	288926.661164

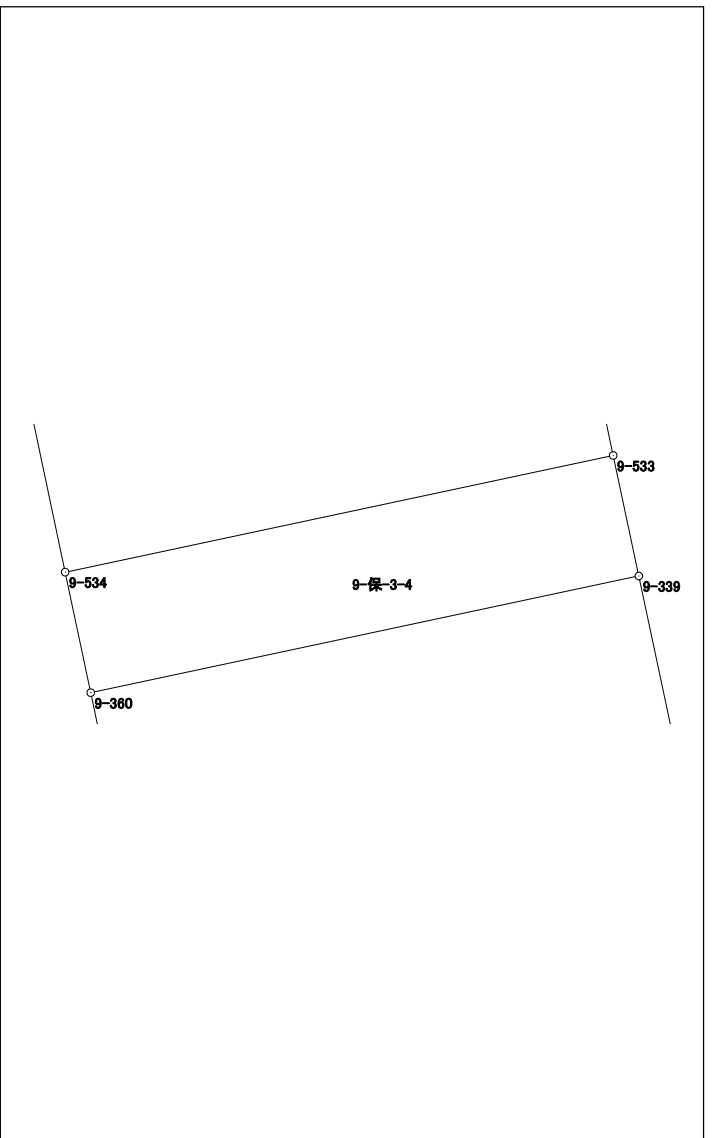

倍面積	44.003234
面 積	22.0016170





# 面積計算書（座標法）

世界測地系（測地成果2011）

所在	地番	公簿地目	現況地目	地積	所有者
前橋市六供町一丁目	9-保-3-6			21.00 m <sup>2</sup>	


点名	X座標	Y座標	辺長	方向角	測角	Dx	倍積(Y×Dx)	
9-248	41769.891	-68246.948	2.934	168-08-19	82-23-05	-3.425	233745.796900	
9-162	41767.020	-68246.345	5.959	85-45-22	97-37-03	-2.430	165838.618350	
9-543	41767.461	-68240.402	1.004	85-42-54	179-57-32	0.516	-35212.047432	
9-559	41767.536	-68239.401	2.910	358-19-35	92-36-41	2.984	-203626.372584	
9-560	41770.445	-68239.486	7.483	265-45-14	87-25-39	2.355	-160703.989530	
						倍面積	42.005704	
						面積	21.0028520	

# 面積計算書（座標法）

世界測地系（測地成果2011）

所在	地番	公簿地目	現況地目	地積	所有者
前橋市六供町一丁目	9-保-3-7			21.00 m <sup>2</sup>	

点名	X座標	Y座標	辺長	方向角	測角	DX	倍積 (Y×DX)
9-362	41777.617	-68248.593	10.797	78-00-34	89-59-43	0.340	-23204.521620
9-361	41779.860	-68238.032	1.946	347-57-24	89-56-50	4.146	-282914.880672
9-557	41781.763	-68238.438	10.795	258-00-26	90-03-02	-0.340	23201.068920
9-558	41779.520	-68248.997	1.945	168-00-51	90-00-25	-4.146	282960.341562

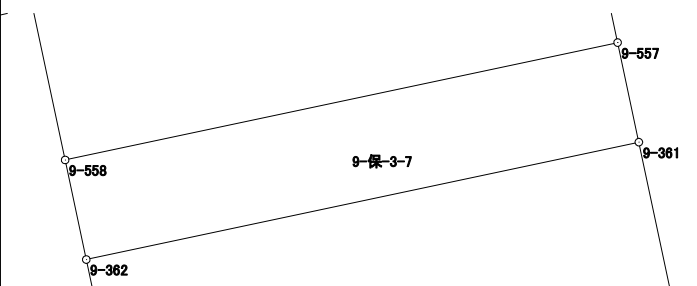

倍面積	42.008190
面積	21.0040950




# 面積計算書 (座標法)

世界測地系 (測地成果2011)

所在	地番	公簿地目	現況地目	地積	所有者
前橋市六供町一丁目	9-保-5			13.00 m <sup>2</sup>	

点名	X座標	Y座標	辺長	方向角	測角	DX	倍積 (Y×DX)
9-167	41767.589	-68238.685	0.718	265-46-00	97-54-20	7.288	-497323.536280
9-559	41767.536	-68239.401	1.004	265-42-54	179-56-54	-0.128	8734.643328
9-543	41767.461	-68240.402	7.741	167-51-09	82-08-15	-7.643	521561.392486
9-544	41759.893	-68238.773	1.704	77-58-41	90-07-32	-7.213	492206.269649
9-168	41760.248	-68237.106	7.509	347-51-40	89-52-59	7.696	-525152.767776
						倍面積	26.001407
						面積	13.0007035

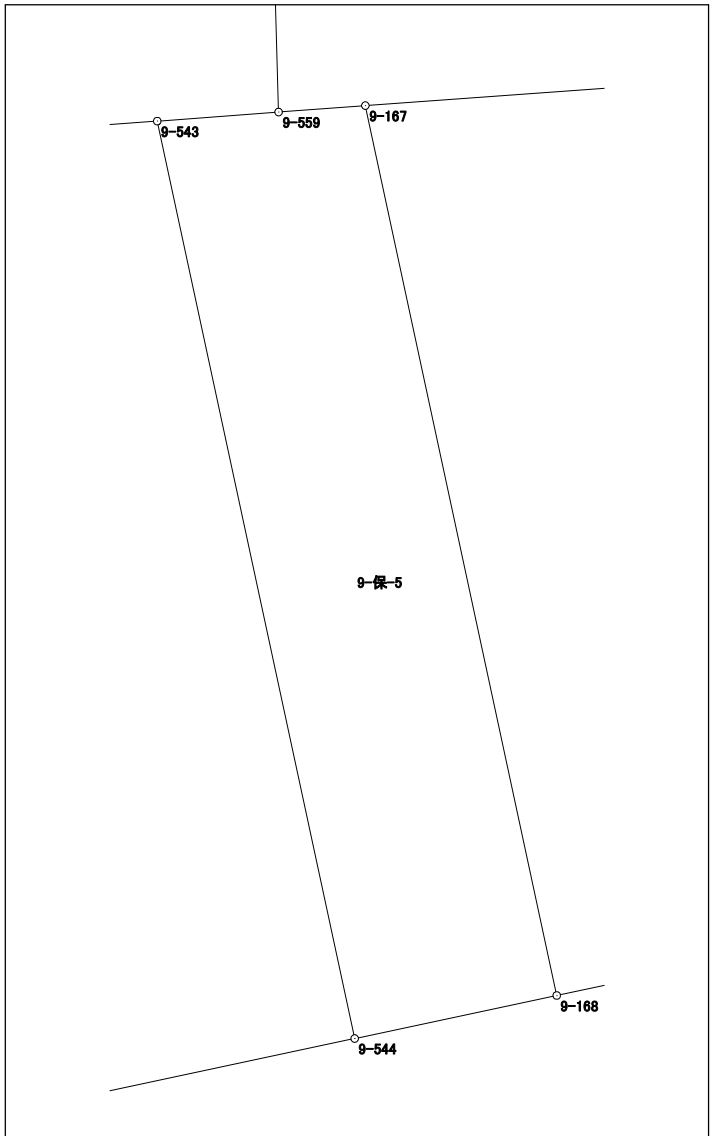




# 面積計算書 (座標法)

世界測地系 (測地成果2011)

所在	地番	公簿地目	現況地目	地積	所有者
前橋市六供町一丁目	9-保-9			229.22 m <sup>2</sup>	

点名	X座標	Y座標	辺長	方向角	測角	Dx	倍積 (Y×Dx)
9-266	41799.731	-68380.239	13.099	168-16-30	45-03-14	-10.078	689136.048642
9-322	41786.905	-68377.577	5.016	33-23-44	45-07-14	-8.638	590645.510126
9-323	41791.093	-68374.816	12.950	78-27-46	225-04-02	6.778	-463444.502848
9-324	41793.683	-68362.128	16.024	78-29-55	180-02-09	5.785	-395474.910480
9-325	41796.878	-68346.426	3.491	78-29-03	179-59-08	3.892	-266004.289992
9-571	41797.575	-68343.005	6.007	348-30-58	90-01-55	6.584	-449970.344920
9-572	41803.462	-68344.201	8.708	258-31-39	90-00-41	4.155	-283970.155155
9-263	41801.730	-68352.735	13.032	258-29-30	179-57-51	-4.332	296104.048020
9-264	41799.130	-68365.505	10.754	258-29-03	179-59-33	-4.747	324531.052235
9-265	41796.983	-68376.043	5.016	303-13-16	224-44-13	0.601	-41094.001843
						倍面積	458.453785
						面積	229.2268925

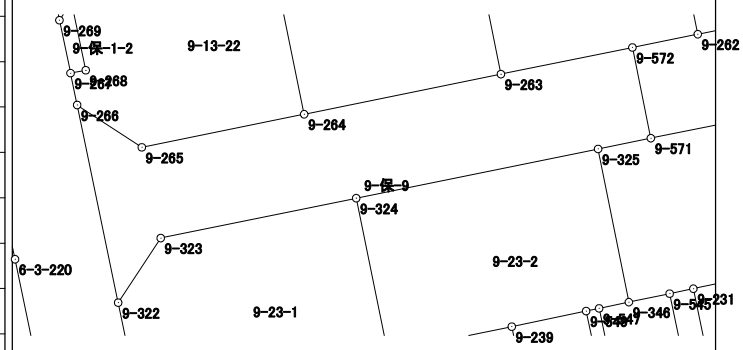


# 面積計算書（座標法）

世界測地系（測地成果2011）

所 在	地 番	公簿地目	現況地目	地 積	所 有 者
前橋市六供町一丁目	9-保-10			54.00 m <sup>2</sup>	

点 名	X 座標	Y 座標	辺 長	方 向 角	測 角	DX	倍 積 (Y×DX)
9-194	41914.225	-68309.301	15.756	258-23-49	179-43-54	-4.689	320302.312389
9-182	41911.056	-68324.735	2.287	168-29-54	90-06-05	-5.410	369636.816350
9-505	41908.815	-68324.279	23.490	78-29-07	89-59-13	2.448	-167257.834992
9-506	41913.504	-68301.262	2.287	348-29-54	90-00-47	6.930	-473327.745660
9-197	41915.745	-68301.718	7.734	258-39-55	90-10-01	0.721	-49245.538678

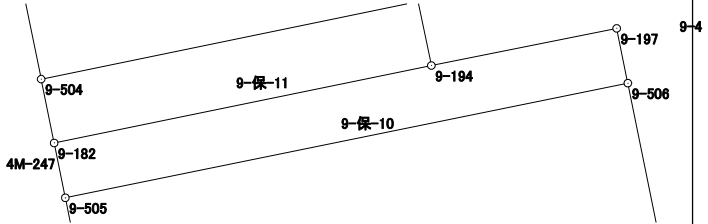

倍面積	108.009409
面 積	54.0047045






# 面積計算書（座標法）

世界測地系（測地成果2011）

所 在	地 番	公簿地目	現況地目	地 積	所 有 者
前橋市六供町一丁目	9-保-12			52.00 m <sup>2</sup>	

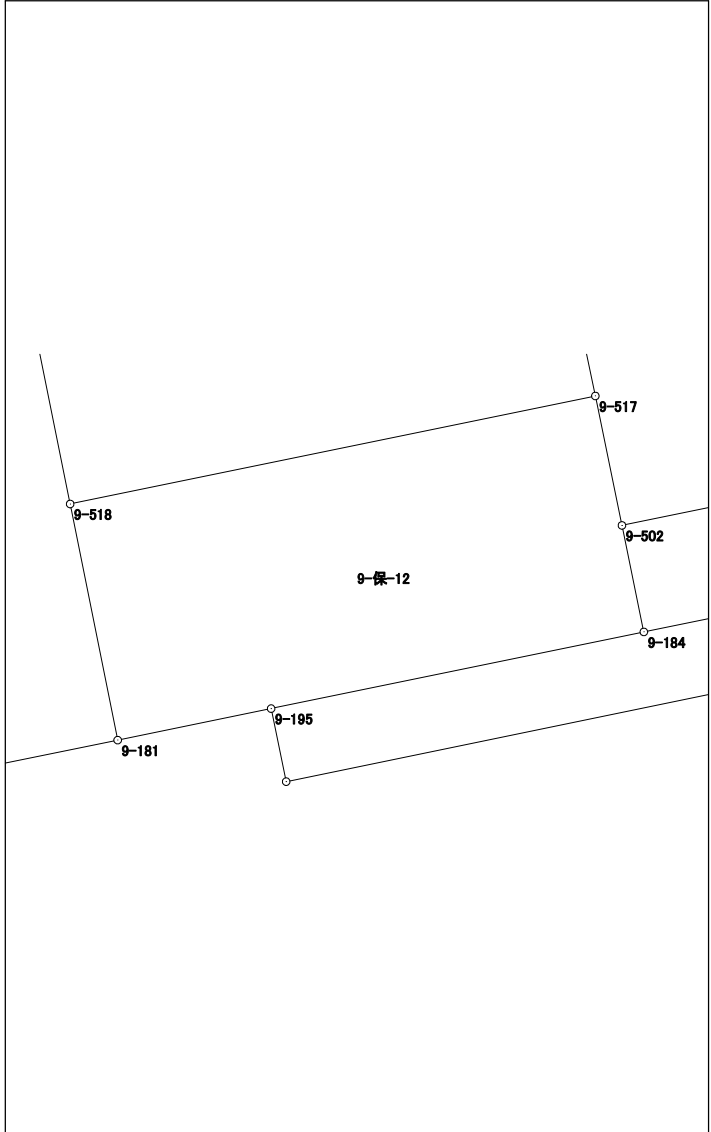点 名	X 座標	Y 座標	辺 長	方 向 角	測 角	DX	倍 積 (Y×DX)	
9-181	41927.833	-68315.317	3.142	78-22-44	89-45-23	-4.103	280297.745651	
9-195	41928.466	-68312.239	7.632	78-22-57	180-00-13	2.170	-148237.558630	
9-184	41930.003	-68304.763	2.181	348-23-10	90-00-13	3.673	-250883.394499	
9-502	41932.139	-68305.202	2.650	348-22-35	179-59-25	4.732	-323220.215864	
9-517	41934.735	-68305.736	10.754	258-22-51	90-00-16	0.430	-29371.466480	
9-518	41932.569	-68316.270	4.831	168-37-21	90-14-30	-6.902	471518.895540	
						倍面積	104.005718	
						面 積	52.0028590	




# 面積計算書（座標法）

世界測地系（測地成果2011）

所在	地番	公簿地目	現況地目	地積	所有者
前橋市六供町一丁目	9-保-14			27.15 m <sup>2</sup>	

点名	X座標	Y座標	辺長	方向角	測角	DX	倍積 (Y×DX)
9-184	41930.003	-68304.763	12.455	78-20-27	89-57-17	0.381	-26024.114703
9-180	41932.520	-68292.565	2.180	348-21-18	90-00-51	4.652	-317697.012380
9-501	41934.655	-68293.005	12.454	258-20-40	89-59-22	-0.381	26019.634905
9-502	41932.139	-68305.202	2.181	168-23-10	90-02-30	-4.652	317755.799704

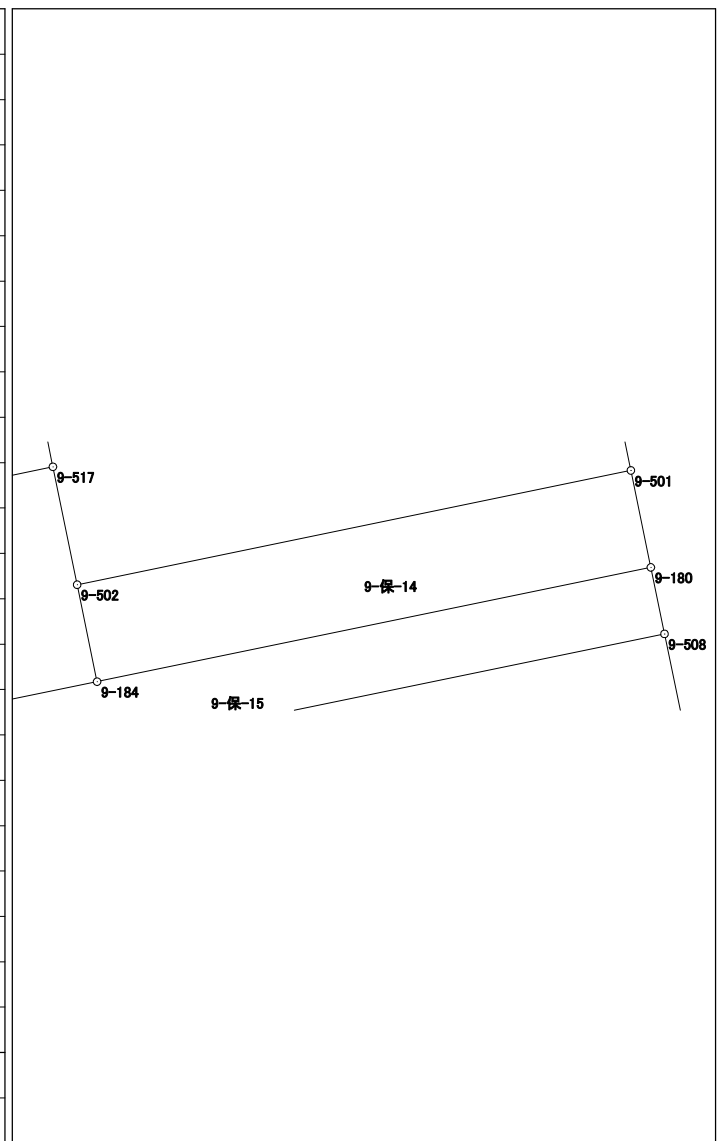

倍面積	54.307526
面積	27.1537630

# 面積計算書（座標法）

世界測地系（測地成果2011）

所 在	地 番	公簿地目	現況地目	地 積	所 有 者
前橋市六供町一丁目	9-保-15			30.00 m <sup>2</sup>	

点 名	X 座標	Y 座標	辺 長	方 向 角	測 角	DX	倍 積 (Y×DX)		
9-195	41928.466	-68312.239	1.496	168-21-07	89-58-10	-3.002	205073.341478		
9-507	41927.001	-68311.937	20.086	78-21-22	90-00-15	2.589	-176859.604893		
9-508	41931.055	-68292.264	1.496	348-23-22	90-02-00	5.519	-376905.005016		
9-180	41932.520	-68292.565	12.455	258-20-27	89-57-05	-1.052	71843.778380		
9-184	41930.003	-68304.763	7.632	258-22-57	180-02-30	-4.054	276907.509202		
倍面積							60.019151		
面 積							30.0095755		


# 面積計算書（座標法）

世界測地系（測地成果2011）

所在	地番	公簿地目	現況地目	地積	所有者
前橋市六供町一丁目	9-保-16			36.00 m <sup>2</sup>	

点名	X座標	Y座標	辺長	方向角	測角	DX	倍積 (Y×DX)
9-190	41918.013	-68277.078	3.036	258-26-45	90-00-01	11.014	-752003.737092
9-509	41917.405	-68280.052	11.864	168-26-31	89-59-46	-12.231	835133.316012
9-510	41905.782	-68277.675	3.035	78-25-25	89-58-54	-11.014	752010.312450
9-191	41906.391	-68274.702	11.862	348-26-44	90-01-19	12.231	-835067.880162

倍面積	72.011208
面積	36.0056040

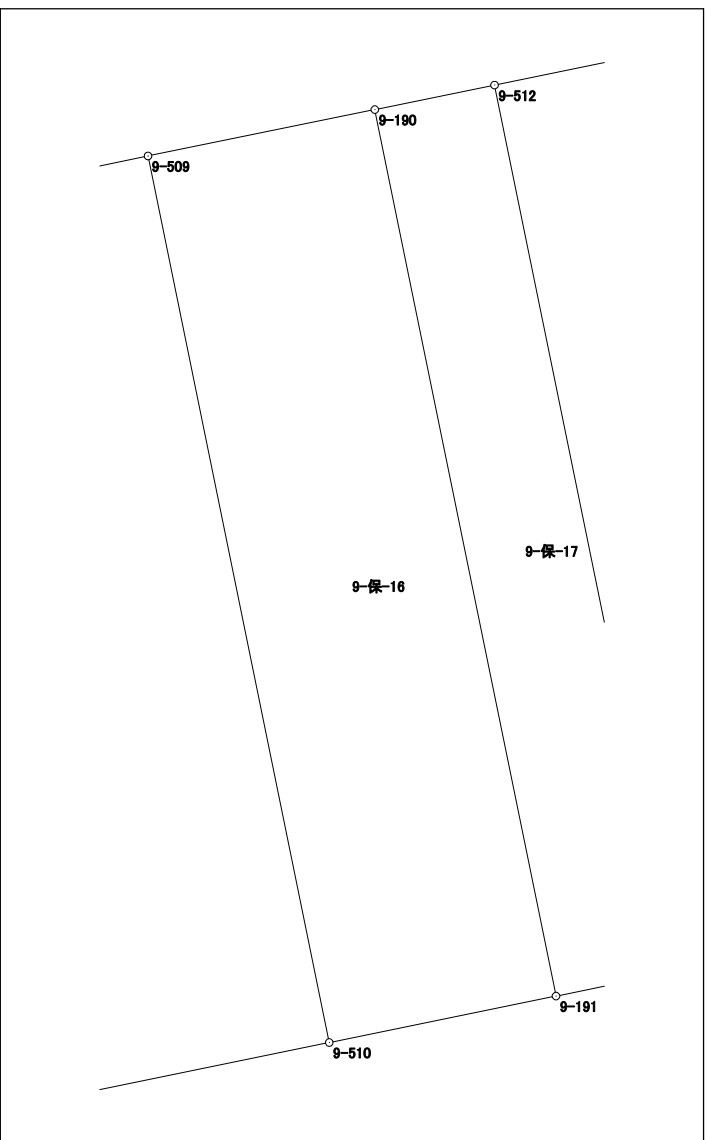


# 面積計算書 (座標法)

世界測地系 (測地成果2011)

所在	地番	公簿地目	現況地目	地積	所有者
前橋市六供町一丁目	9-保-17			19.00 m <sup>2</sup>	

点名	X座標	Y座標	辺長	方向角	測角	DX	倍積 (Y×DX)
9-190	41918.013	-68277.078	11.862	168-26-44	90-00-03	-11.943	815433.142554
9-191	41906.391	-68274.702	1.601	78-26-15	89-59-31	-11.301	771572.407302
9-511	41906.712	-68273.133	11.862	348-27-01	90-00-46	11.943	-815386.027419
9-512	41918.334	-68275.508	1.602	258-26-41	89-59-40	11.301	-771581.515908

倍面積	38.006529
面積	19.0032645

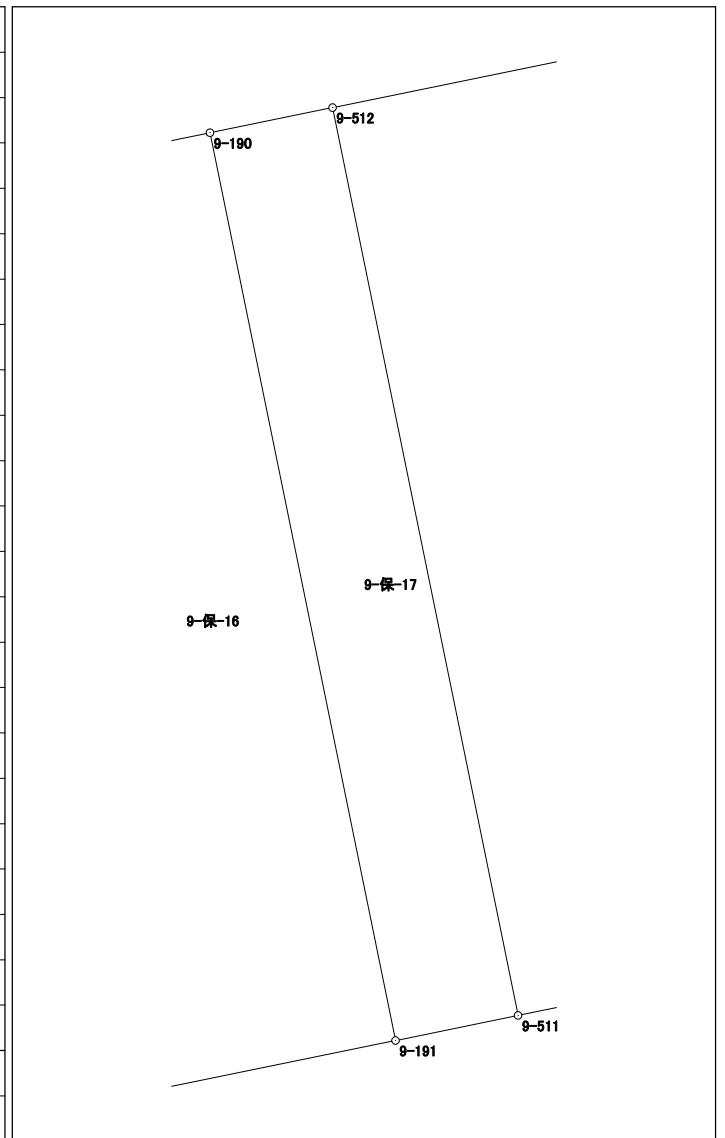


# 面積計算書（座標法）

世界測地系（測地成果2011）

所 在	地 番	公簿地目	現況地目	地 積	所 有 者
前橋市六供町一丁目	9-保-18			25.00 m <sup>2</sup>	

点 名	X 座標	Y 座標	辺 長	方 向 角	測 角	DX	倍 積 (Y×DX)
9-513	41908.237	-68265.690	10.333	78-25-17	89-58-21	-0.299	20411.441310
9-114	41910.311	-68255.567	2.421	348-03-32	89-38-15	4.443	-303259.484181
9-515	41912.680	-68256.068	10.317	258-25-31	90-21-59	0.299	-20408.564332
9-516	41910.610	-68266.175	2.422	168-26-56	90-01-25	-4.443	303306.615525

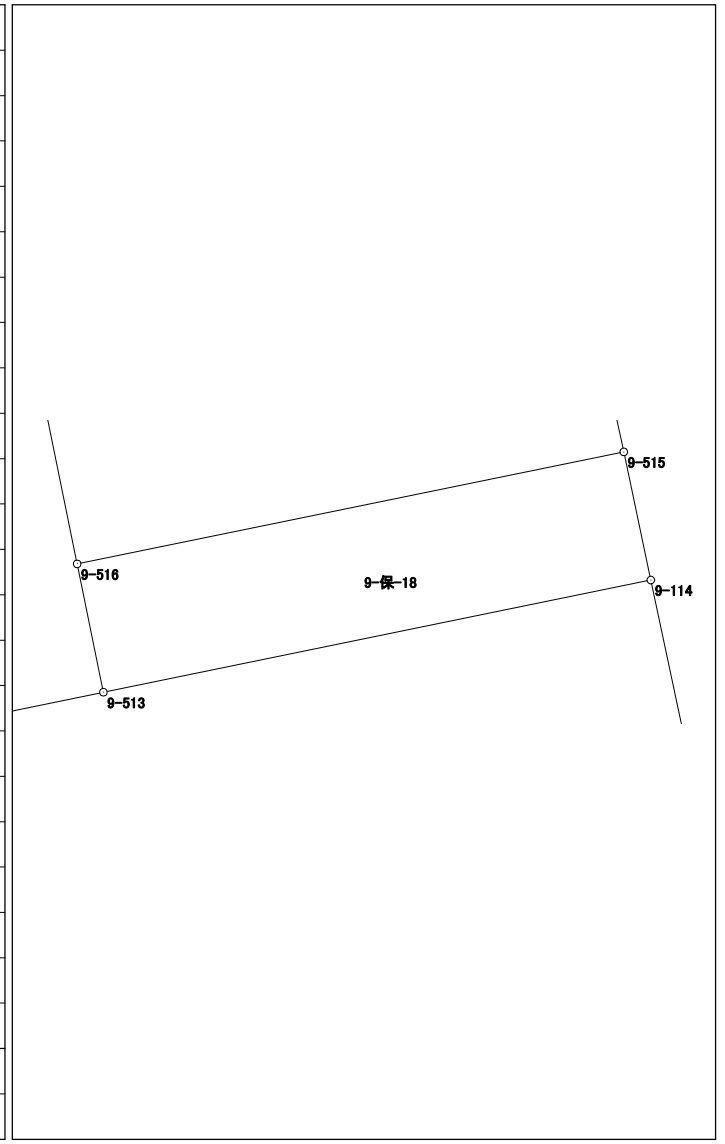

倍面積	50.008322
面 積	25.0041610


# 面積計算書（座標法）

世界測地系（測地成果2011）

所 在	地 番	公簿地目	現況地目	地 積	所 有 者
前橋市六供町一丁目	9-保-19			26.00 m <sup>2</sup>	

点 名	X 座標	Y 座標	辺 長	方 向 角	測 角	DX	倍 積 (Y×DX)
9-348	41788.328	-68328.180	1.967	347-33-12	179-25-47	13.685	-935071.143300
9-347	41790.249	-68328.604	1.850	258-08-59	90-35-47	1.541	-105294.378764
9-527	41789.869	-68330.415	13.986	168-02-45	89-53-46	-14.063	960930.626145
9-528	41776.186	-68327.518	1.851	78-13-00	90-10-15	-13.305	909097.626990
9-344	41776.564	-68325.706	12.021	348-07-25	89-54-25	12.142	-829610.722252

倍面積	52.008819
面 積	26.0044095

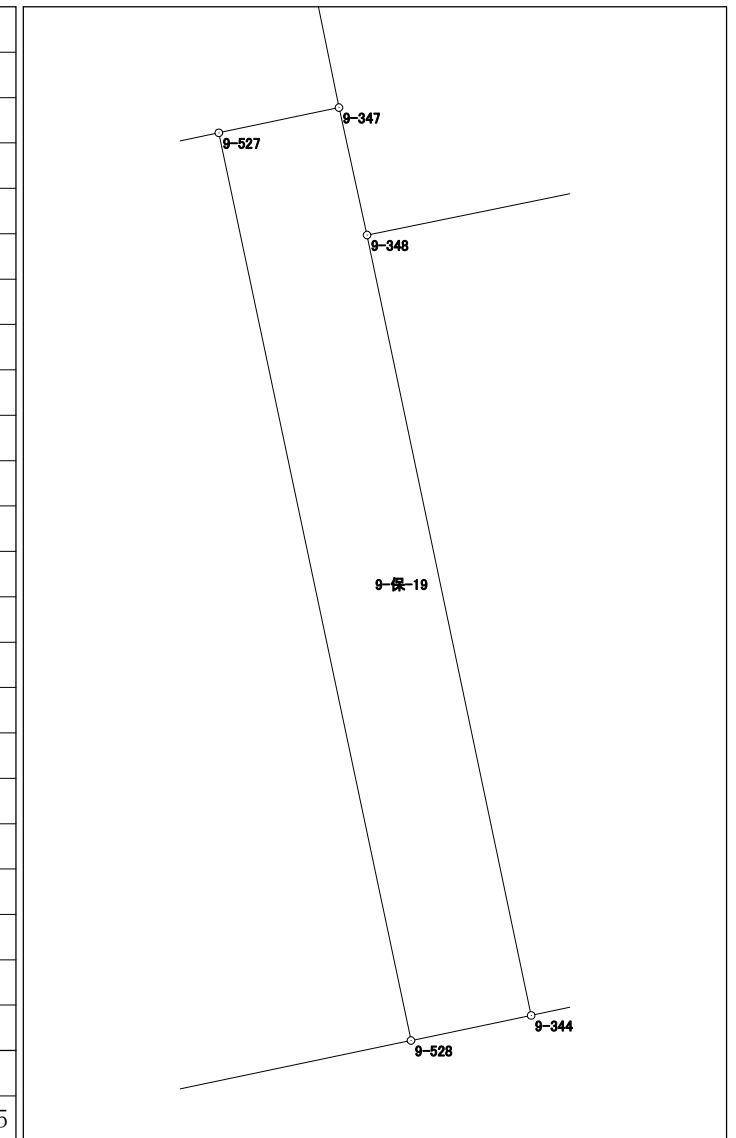




# 面積計算書（座標法）

世界測地系（測地成果2011）

所 在	地 番	公簿地目	現況地目	地 積	所 有 者
前橋市六供町一丁目	9-保-20			22.00 m <sup>2</sup>	

点 名	X 座標	Y 座標	辺 長	方 向 角	測 角	DX	倍 積 (Y×DX)
9-232	41774.125	-68337.387	13.980	348-12-28	89-58-28	14.006	-957133.442322
9-231	41787.810	-68340.244	1.574	258-14-00	90-01-32	13.364	-913299.020816
9-545	41787.489	-68341.785	13.980	168-12-28	89-58-28	-14.006	957195.040710
9-546	41773.804	-68338.928	1.574	78-14-00	90-01-32	-13.364	913281.433792
						倍面積	44.011364
						面 積	22.0056820

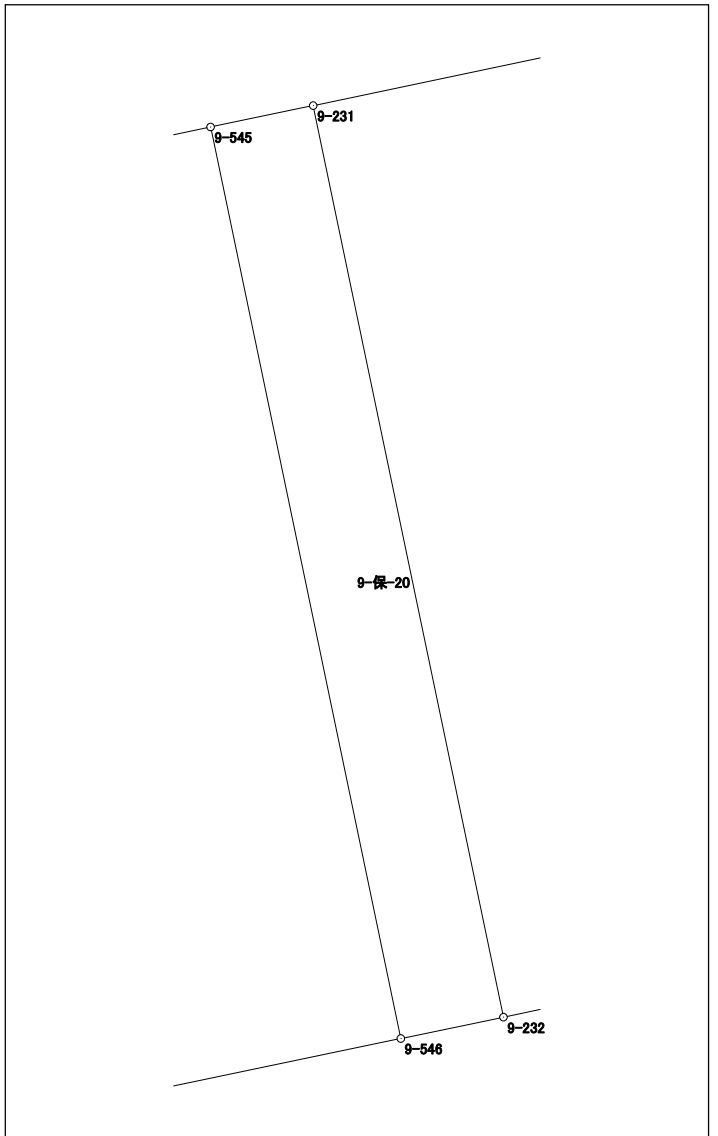


# 面積計算書（座標法）

世界測地系（測地成果2011）

所在	地番	公簿地目	現況地目	地積	所有者
前橋市六供町一丁目	9-保-21			12.00 m <sup>2</sup>	

点名	X座標	Y座標	辺長	方向角	測角	DX	倍積 (Y×DX)
9-548	41772.849	-68343.506	13.979	348-12-25	89-57-42	13.859	-947172.649654
9-547	41786.533	-68346.363	0.858	258-09-59	89-57-34	13.508	-923222.671404
9-549	41786.357	-68347.203	13.978	168-12-37	90-02-38	-13.859	947223.886377
9-550	41772.674	-68344.347	0.859	78-14-43	90-02-06	-13.508	923195.439276
倍面積							24.004595
面積							12.0022975

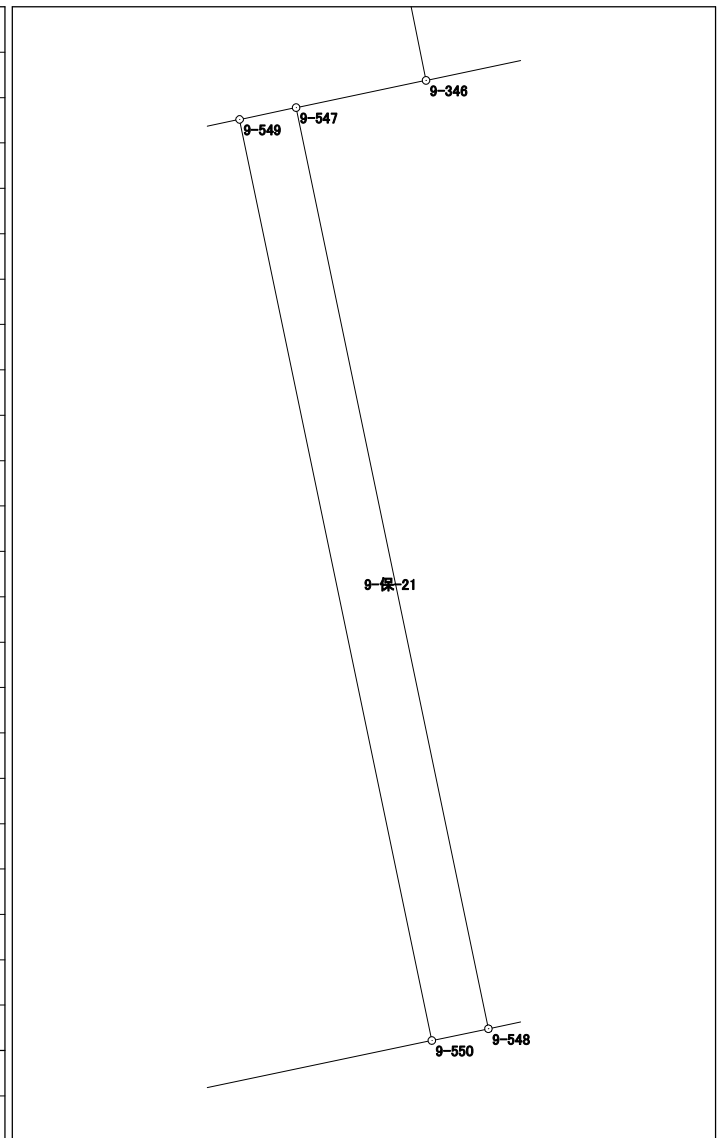


# 面積計算書 (座標法)

世界測地系 (測地成果2011)

所在	地番	公簿地目	現況地目	地積	所有者
前橋市六供町一丁目	9-保-22			69.00 m <sup>2</sup>	

点名	X座標	Y座標	辺長	方向角	測角	DX	倍積 (Y×DX)
9-523	41784.662	-68355.328	4.856	258-15-35	90-02-46	12.699	-868044.310272
9-345	41783.674	-68360.082	0.079	258-15-41	180-00-06	-1.004	68633.522328
9-525	41783.658	-68360.159	13.989	168-12-41	89-57-00	-13.710	937217.779890
9-526	41769.964	-68357.301	4.934	78-10-31	89-57-50	-12.683	866975.648583
9-524	41770.975	-68352.472	13.982	348-12-49	90-02-18	14.698	-1004644.633456
						倍面積	138.007073
						面積	69.0035365

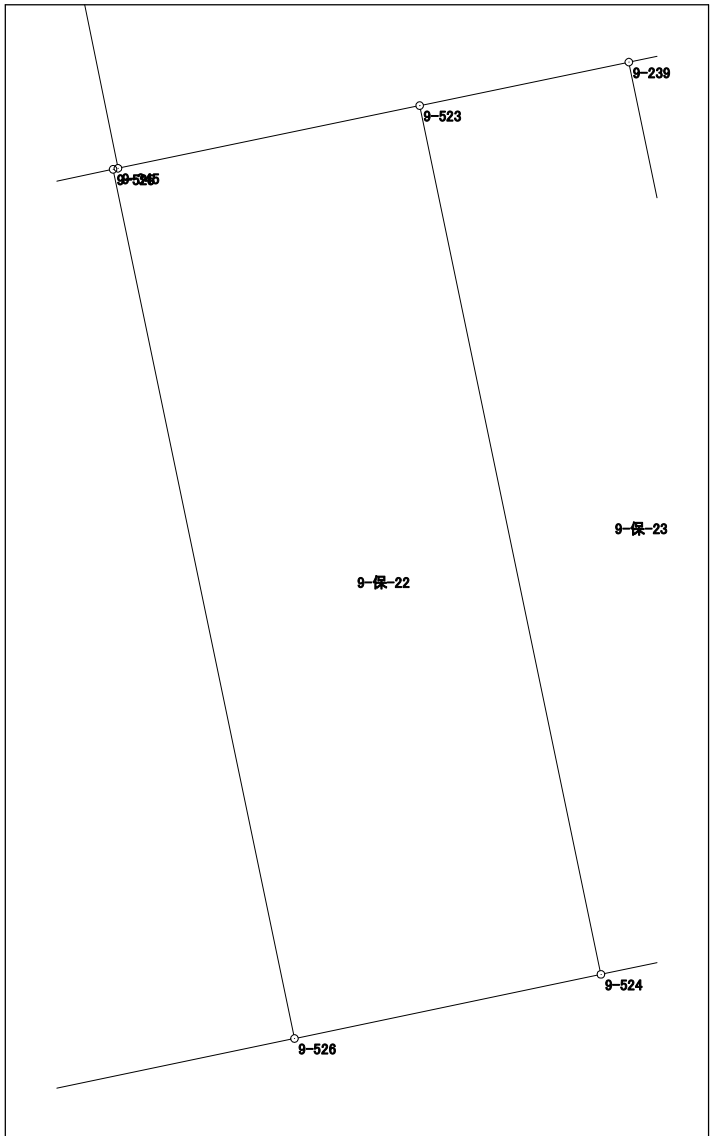


# 面積計算書 (座標法)

世界測地系 (測地成果2011)

所 在	地 番	公簿地目	現況地目	地 積	所 有 者
前橋市六供町一丁目	9-保-23			47.06 m <sup>2</sup>	

点 名	X 座標	Y 座標	辺 長	方 向 角	測 角	DX	倍 積 (Y×DX)
9-240	41771.665	-68349.177	13.977	348-12-48	90-02-26	14.372	-982314.371844
9-239	41785.347	-68352.032	3.366	258-15-34	90-02-46	12.997	-888371.359904
9-523	41784.662	-68355.328	13.982	168-12-49	89-57-15	-14.372	982402.774016
9-524	41770.975	-68352.472	3.366	78-10-22	89-57-33	-12.997	888377.078584

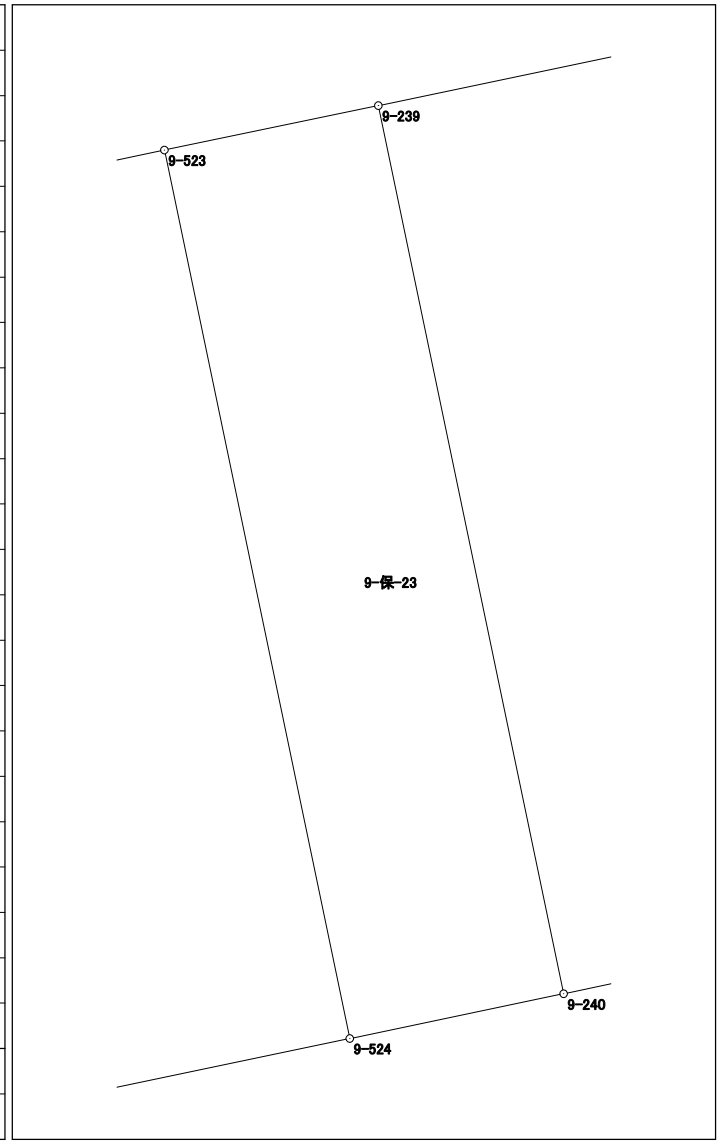


倍面積	94.120852
面 積	47.0604260

# 面積計算書（座標法）

世界測地系（測地成果2011）

所在	地番	公簿地目	現況地目	地積	所有者
前橋市六供町一丁目	9-保-24			34.00 m <sup>2</sup>	

点名	X座標	Y座標	辺長	方向角	測角	Dx	倍積 (Y×Dx)
9-163	41758.663	-68244.542	8.549	347-49-31	89-51-19	8.975	-612494.764450
9-162	41767.020	-68246.345	2.934	348-08-19	180-18-48	11.228	-766269.961660
9-248	41769.891	-68246.948	2.966	258-11-24	90-03-05	2.264	-154511.090272
9-539	41769.284	-68249.851	11.494	167-54-08	89-42-44	-11.846	808487.734946
9-540	41758.045	-68247.442	2.965	77-58-12	90-04-04	-10.621	724856.081482
						倍面積	68.000046
						面積	34.0000230

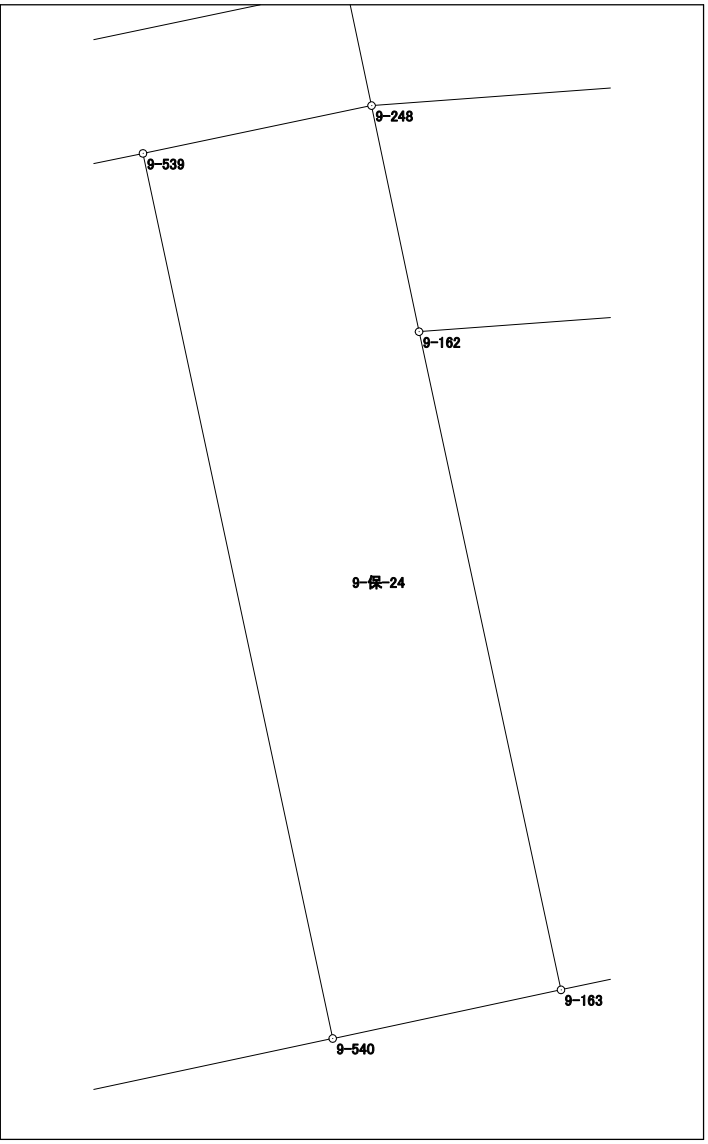

# 面積計算書 (座標法)

世界測地系 (測地成果2011)

所在	地番	公簿地目	現況地目	地積	所有者
前橋市六供町一丁目	9-保-25-1			15.88 m <sup>2</sup>	

点名	X座標	Y座標	辺長	方向角	測角	DX	倍積 (Y×DX)
9-249	41769.275	-68257.400	1.536	168-05-25	89-56-03	-3.628	247637.847200
9-247	41767.772	-68257.083	2.391	77-51-30	89-46-05	-1.000	68257.083000
9-575	41768.275	-68254.745	4.997	78-21-02	180-29-32	1.512	-103201.174440
9-539	41769.284	-68249.851	2.966	78-11-24	179-50-22	1.616	-110291.759216
9-248	41769.891	-68246.948	1.542	348-03-49	89-52-25	2.116	-144410.541968
9-250	41771.400	-68247.267	10.353	258-09-22	90-05-33	-0.616	42040.316472
						倍面積	31.771048
						面積	15.885240

