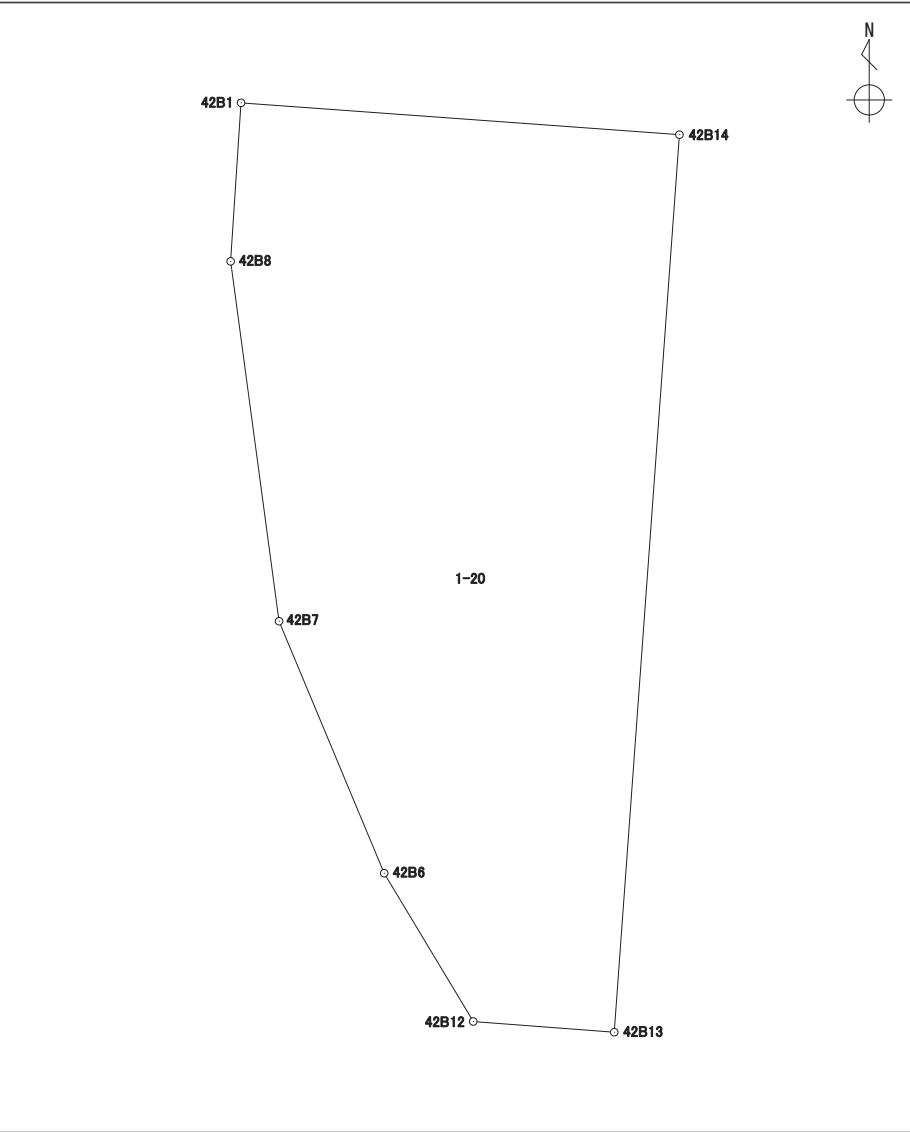


座 標 面 積 計 算 書

世界測地系（測地成果2011）

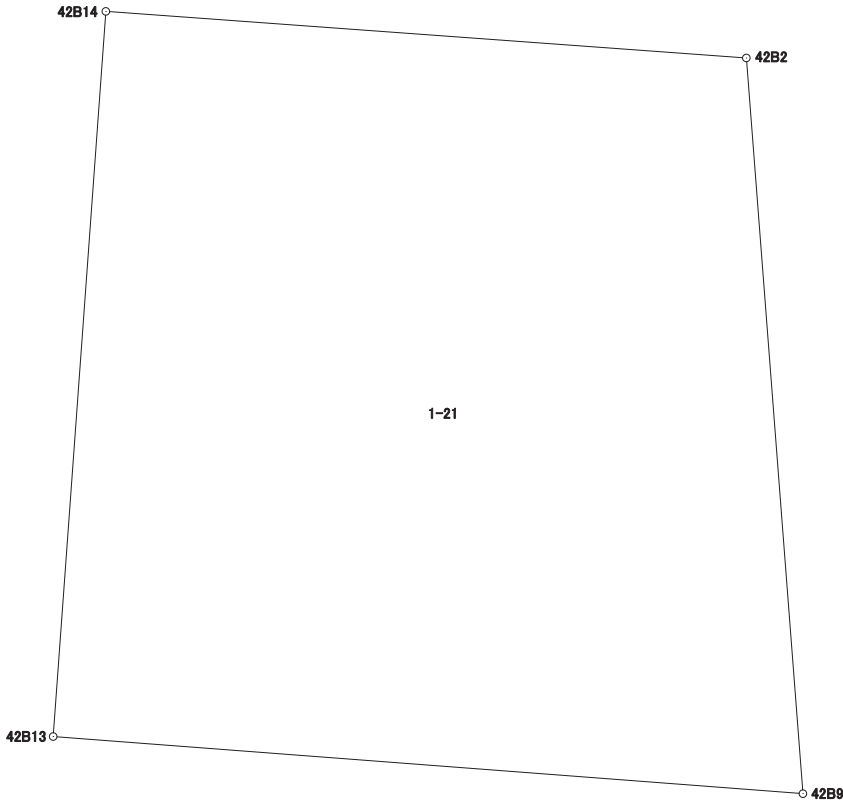
地 番 1-20

境 界 点	X	Y	辺長	方向角	備考		
42B1	43199.759	-67544.728	7.243	94° 09' 24″			
42B14	43199.234	-67537.504	14.826	184° 09' 14″			
42B13	43184.446	-67538.578	2.330	274° 21' 19″			
42B12	43184.623	-67540.902	2.850	328° 59' 54″			
42B6	43187.066	-67542.370	4.498	337° 21' 24″			
42B7	43191.218	-67544.102	5.982	352° 20' 04″			
42B8	43197.147	-67544.900	2.617	3° 46' 03″			
面積算出公式			面 積	85.0309890	街区一画地	42-保1	
$A=1/2 \sum X_n(Y_{(n+1)}-Y_{(n-1)})$			地 積	85.03			

座 標 面 積 計 算 書

世界測地系（測地成果2011）

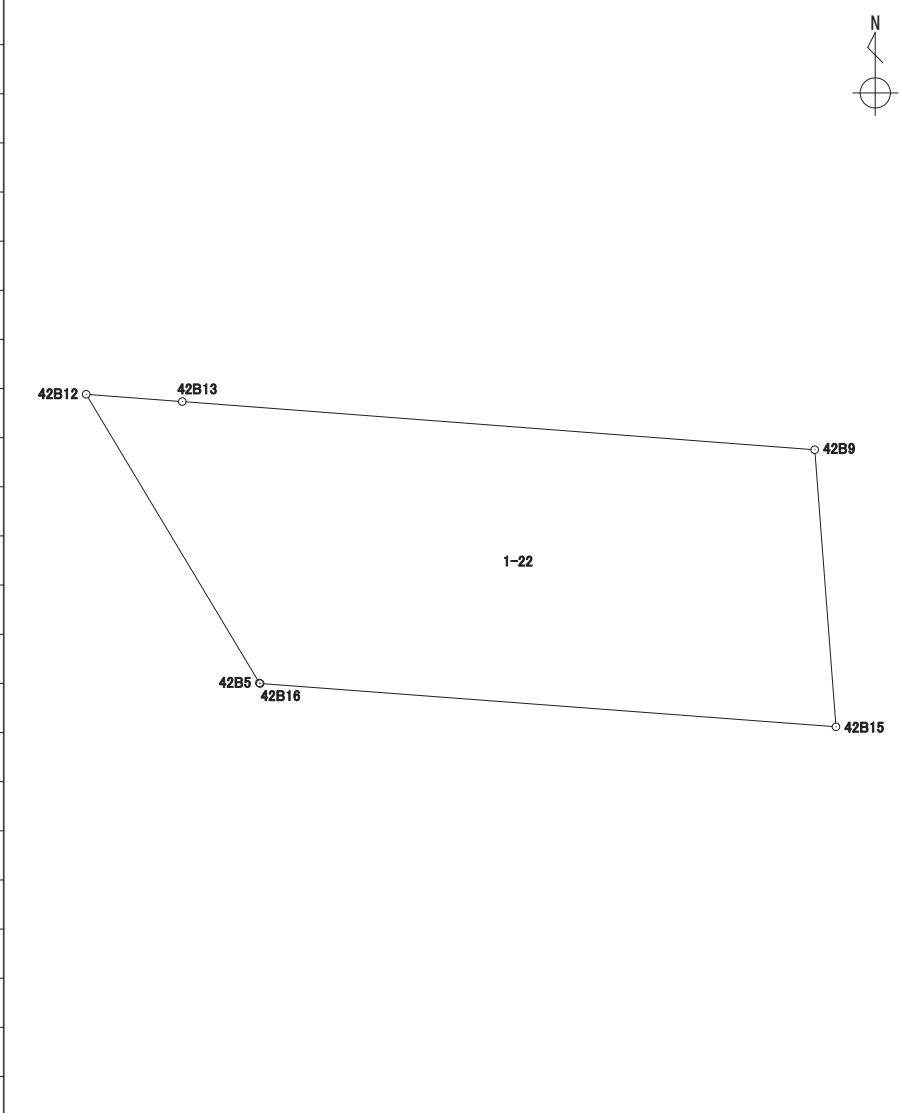
地番	1-21
----	------

境 界 点	X	Y	辺長	方向角	備考	N   1-21	
42B14	43199.234	-67537.504	13.099	94° 09' 16"			
42B2	43198.285	-67524.439	15.048	175° 36' 07"			
42B9	43183.281	-67523.285	15.337	274° 21' 23"			
42B13	43184.446	-67538.578	14.826	4° 09' 14"			
面積算出公式			面 積	211.1681040	街区一画地	42-1	
$A=1/2 \sum X_n(Y_{(n+1)}-Y_{(n-1)})$			地 積	211.16			

座 標 面 積 計 算 書

世界測地系（測地成果2011）

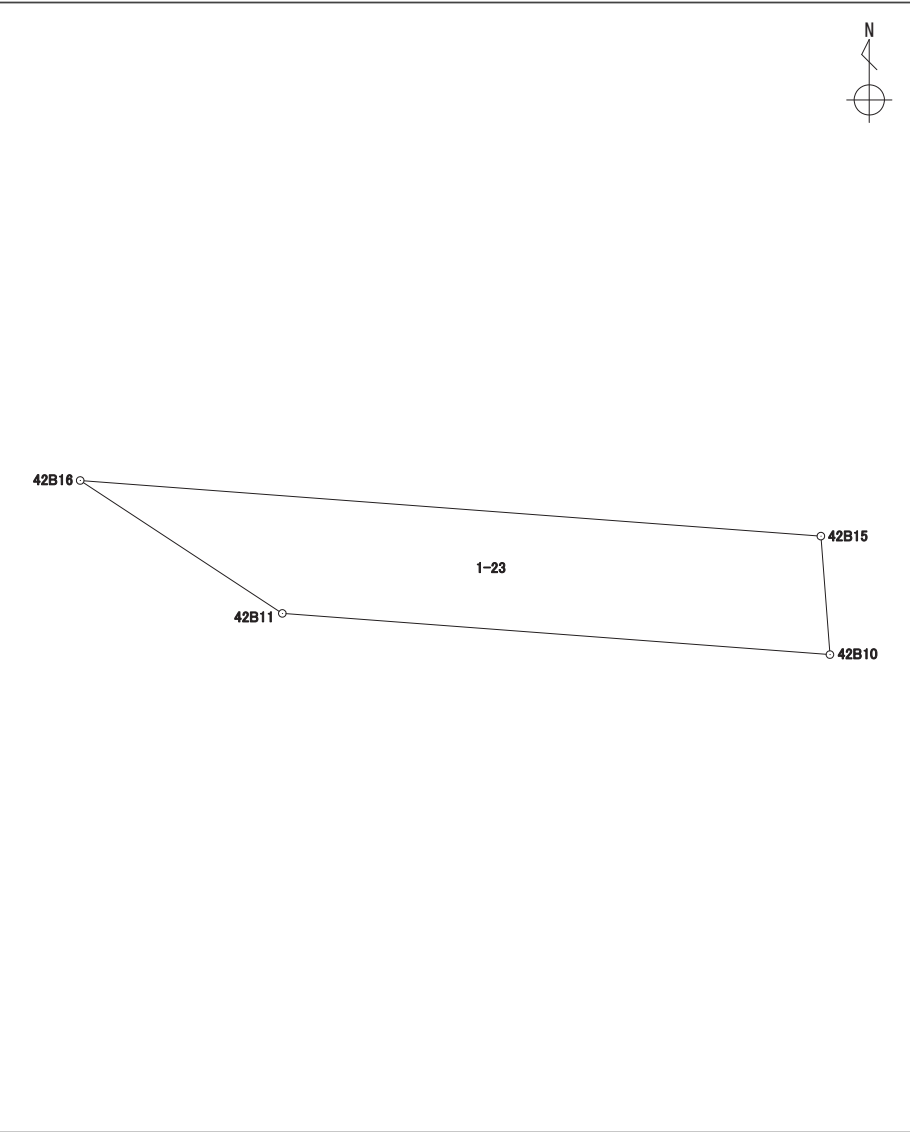
地 番	1-22
-----	------

境 界 点	X	Y	辺長	方向角	備考		
42B12	43184.623	-67540.902	2.330	94° 21' 19″			
42B13	43184.446	-67538.578	15.337	94° 21' 23″			
42B9	43183.281	-67523.285	6.717	175° 37' 13″			
42B15	43176.583	-67522.772	13.962	274° 17' 47″			
42B16	43177.629	-67536.695	0.021	303° 41' 24″			
42B5	43177.641	-67536.713	8.142	329° 02' 15″			
面積算出公式			面 積	105.1815835	街区一画地	42-2	
$A=1/2 \sum X_n(Y_{(n+1)}-Y_{(n-1)})$			地 積	105.18			

座 標 面 積 計 算 書

世界測地系（測地成果2011）

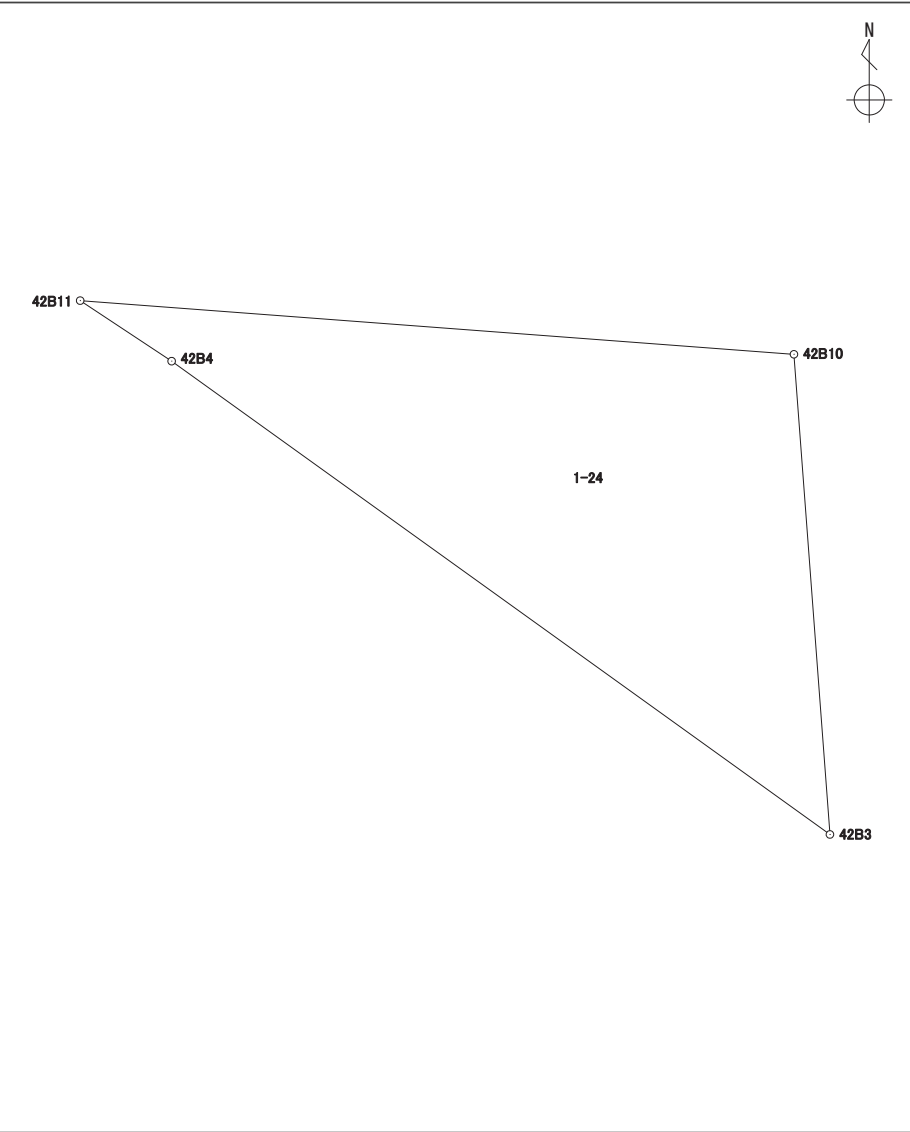
地 番 1-23

境 界 点	X	Y	辺長	方向角	備考		
42B11	43175.131	-67532.895	4.547	303° 19' 11"			
42B16	43177.629	-67536.695	13.962	94° 17' 47"			
42B15	43176.583	-67522.772	2.232	175° 37' 58"			
42B10	43174.357	-67522.602	10.322	274° 18' 01"			
面積算出公式			面 積	26.7927460	街区一画地	42－保2	
$A=1/2 \sum X_n(Y_{(n+1)}-Y_{(n-1)})$			地 積	26.79			

座 標 面 積 計 算 書

世界測地系（測地成果2011）

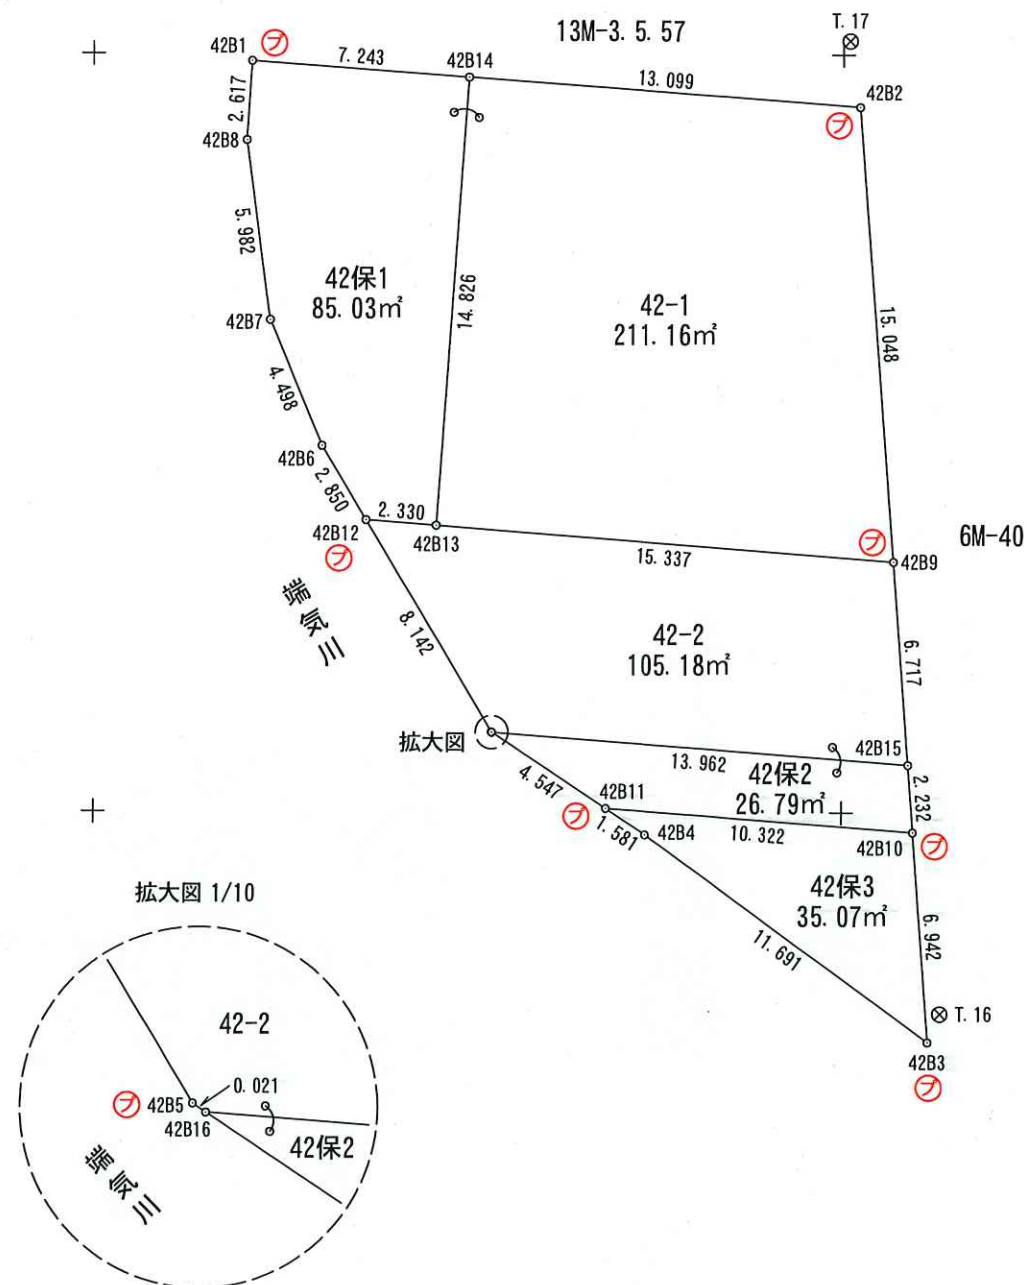
地 番	1-24
-----	------

境 界 点	X	Y	辺長	方向角	備考		
42B11	43175.131	-67532.895	10.322	94° 18' 01″			
42B10	43174.357	-67522.602	6.942	175° 42' 46″			
42B3	43167.434	-67522.083	11.691	305° 42' 37″			
42B4	43174.258	-67531.576	1.581	303° 29' 57″			
面積算出公式			面 積	35.0716330	街区一画地	42－保3	
$A=1/2 \sum X_n(Y_{(n+1)}-Y_{(n-1)})$			地 積	35.07			

4 2 街区 出来形確認図 (463.23m²)



S=1:250



凡 例	
合	合成杭
鉋	金属鉋
コ	コンクリート杭
キ	刻み
フ	プレート
⊗	基準点
○	計算点