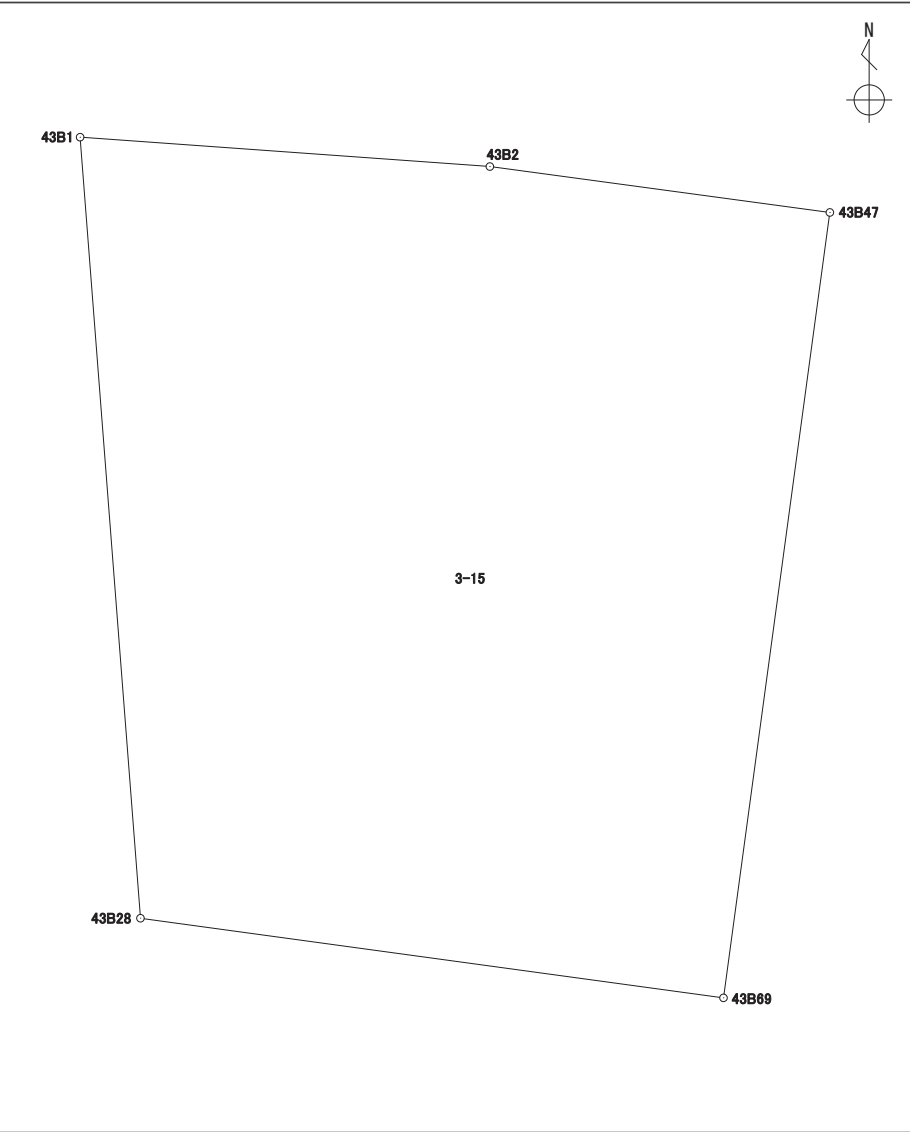


座 標 面 積 計 算 書

世界測地系（測地成果2011）

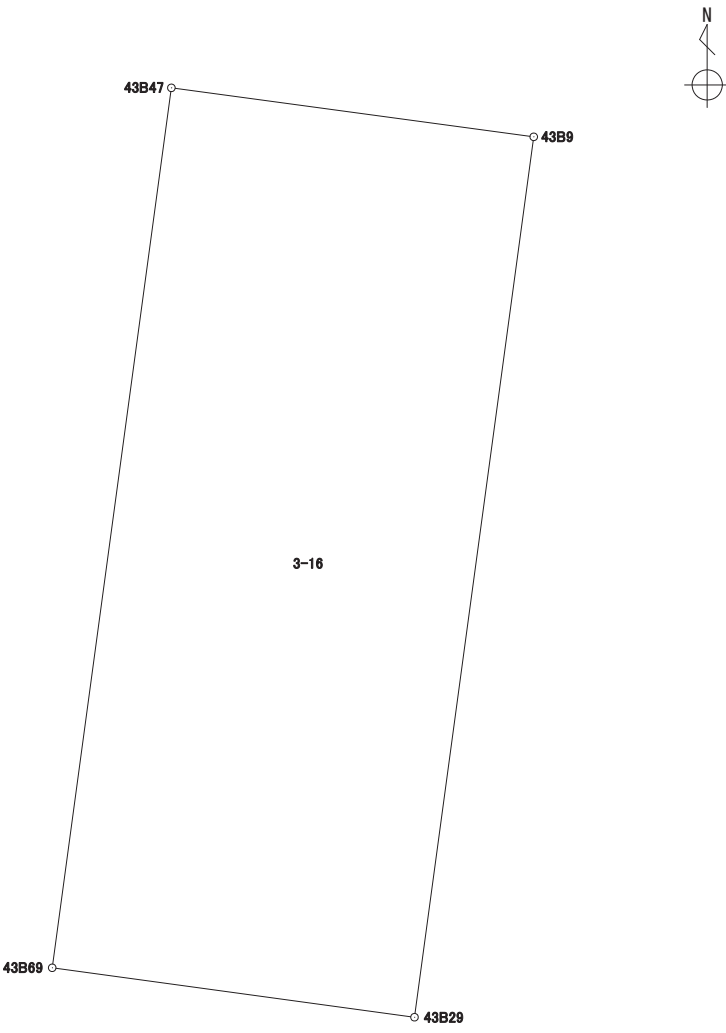
地番	3-15
----	------

境界点	X	Y	辺長	方向角	備考		
43B47	43196.750	-67507.457	11.564	187° 42' 45"			
43B69	43185.290	-67509.009	8.587	277° 46' 35"			
43B28	43186.452	-67517.518	11.430	355° 34' 46"			
43B1	43197.848	-67518.399	5.995	94° 05' 38"			
43B2	43197.420	-67512.419	5.007	97° 41' 24"			
面積算出公式			面 積	112.4635610	街区一画地	43-1	
$A=1/2 \sum X_n(Y_{(n+1)}-Y_{(n-1)})$			地 積	112.46			

座 標 面 積 計 算 書

世界測地系（測地成果2011）

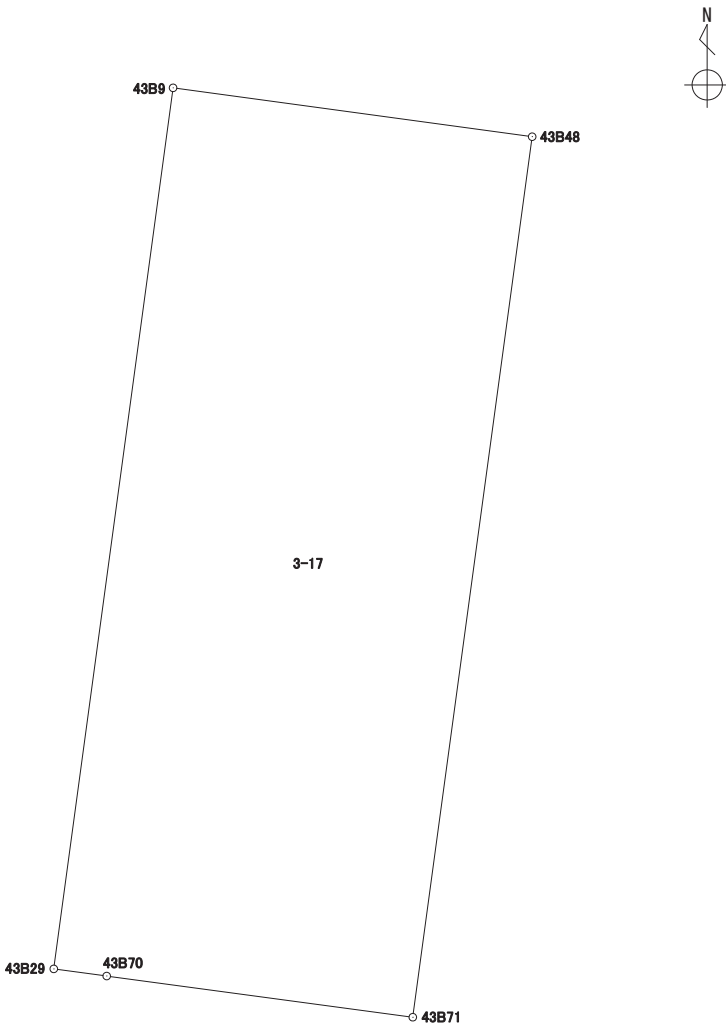
地番	3-16
----	------

境 界 点	X	Y	辺長	方向角	備考		
43B29	43184.646	-67504.290	4.762	277° 46' 16"			
43B69	43185.290	-67509.009	11.564	7° 42' 45"			
43B47	43196.750	-67507.457	4.762	97° 41' 53"			
43B9	43196.112	-67502.737	11.570	187° 42' 48"			
面積算出公式			面 積	55.0947810	街区一画地	43-保13	
$A=1/2 \sum X_n(Y_{(n+1)}-Y_{(n-1)})$			地 積	55.09			

座 標 面 積 計 算 書

世界測地系（測地成果2011）

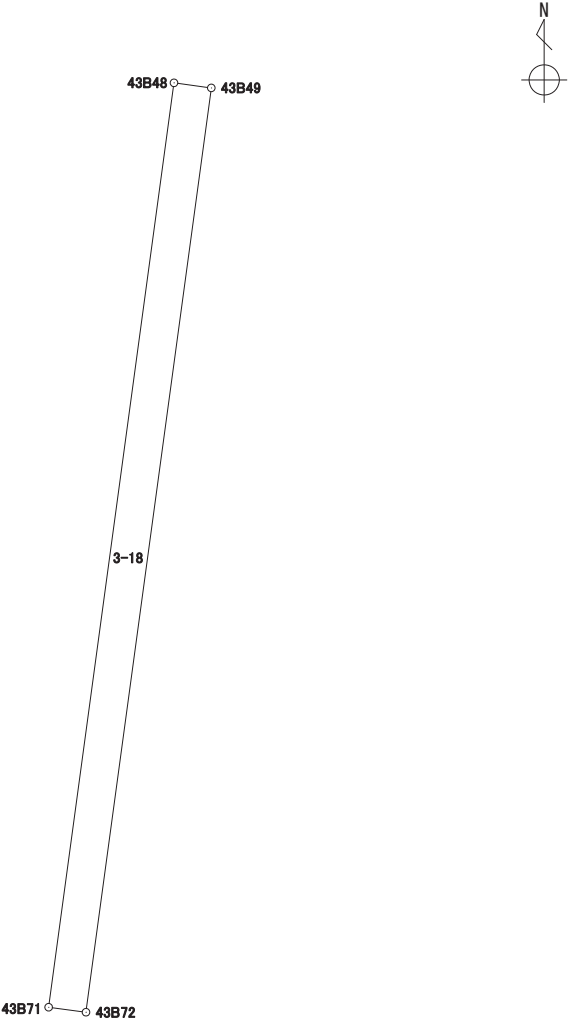
地 番 3-17

境 界 点	X	Y	辺長	方向角	備考		
43B48	43195.476	-67498.063	11.563	187° 43' 23″			
43B71	43184.017	-67499.617	4.019	277° 39' 45″			
43B70	43184.553	-67503.601	0.695	277° 41' 14″			
43B29	43184.646	-67504.290	11.570	7° 42' 48″			
43B9	43196.112	-67502.737	4.717	97° 44' 56″			
面積算出公式			面 積	54.5531865	街区一画地	43-2	
$A=1/2 \sum X_n(Y_{(n+1)}-Y_{(n-1)})$			地 積	54.55			

座 標 面 積 計 算 書

世界測地系（測地成果2011）

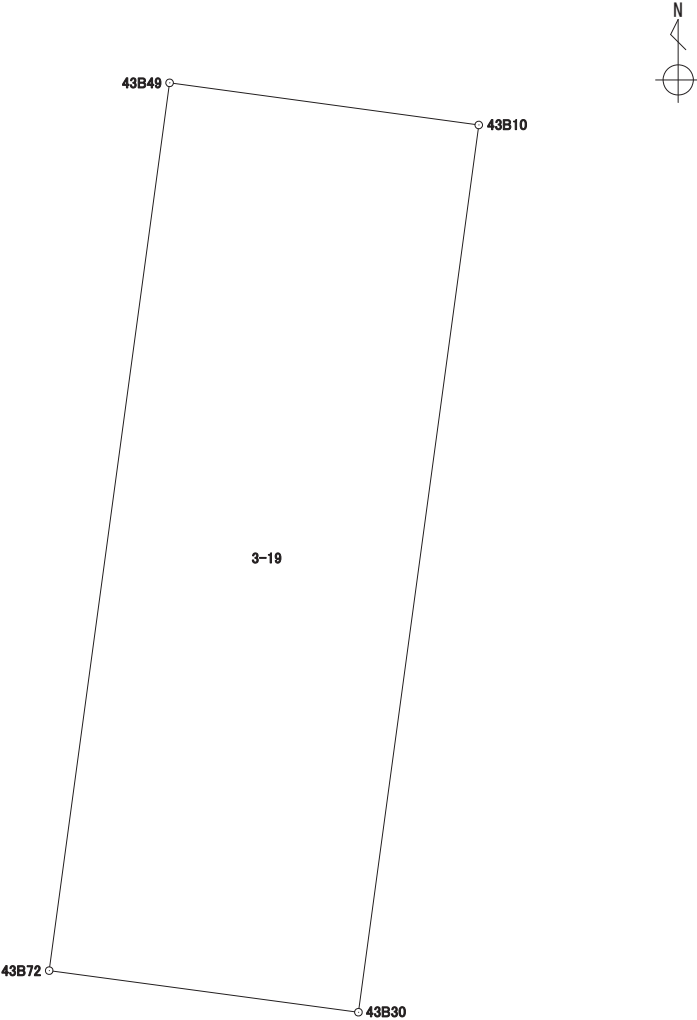
地番	3-18
----	------

境 界 点	X	Y	辺長	方向角	備考		
43B72	43183.955	-67499.154	0.467	277° 37' 37″			
43B71	43184.017	-67499.617	11.563	7° 43' 23″			
43B48	43195.476	-67498.063	0.467	97° 44' 55″			
43B49	43195.413	-67497.600	11.562	187° 43' 25″			
面積算出公式			面 積	5.4024105	街区一画地	43-保20	
$A=1/2 \sum X_n(Y_{(n+1)}-Y_{(n-1)})$			地 積	5.40			

座 標 面 積 計 算 書

世界測地系（測地成果2011）

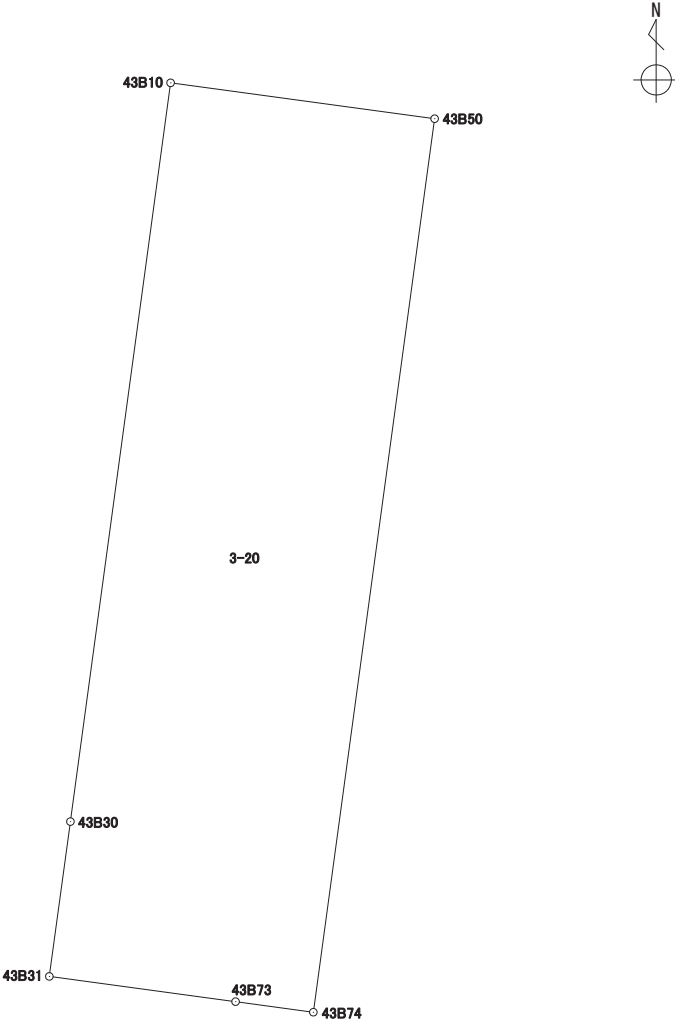
地番 3-19

境 界 点	X	Y	辺長	方向角	備考		
43B10	43194.869	-67493.609	11.555	187° 43' 24″			
43B30	43183.418	-67495.162	4.027	277° 39' 41″			
43B72	43183.955	-67499.154	11.562	7° 43' 25″			
43B49	43195.413	-67497.600	4.027	97° 45' 43″			
面積算出公式			面 積	46.5603035	街区一画地	43-保21	
$A=1/2 \sum X_n(Y_{(n+1)}-Y_{(n-1)})$			地 積	46.56			

座 標 面 積 計 算 書

世界測地系（測地成果2011）

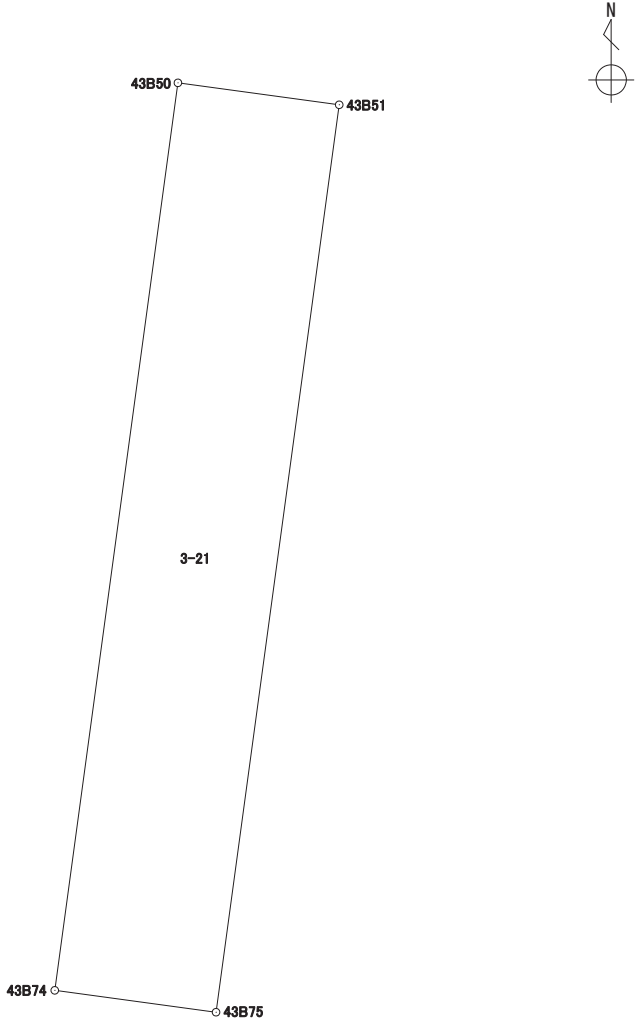
地番 3-20

境 界 点	X	Y	辺長	方向角	備考		
43B10	43194.869	-67493.609	4.130	97° 44' 09″			
43B50	43194.313	-67489.516	13.977	187° 43' 48″			
43B74	43180.463	-67491.396	1.217	277° 44' 38″			
43B73	43180.627	-67492.602	2.913	277° 42' 46″			
43B31	43181.018	-67495.489	2.422	7° 45' 32″			
43B30	43183.418	-67495.162	11.555	7° 43' 24″			
面積算出公式			面 積	57.7248370	街区一画地	43－保18	
$A=1/2 \sum X_n(Y_{(n+1)}-Y_{(n-1)})$			地 積	57.72			

座 標 面 積 計 算 書

世界測地系（測地成果2011）

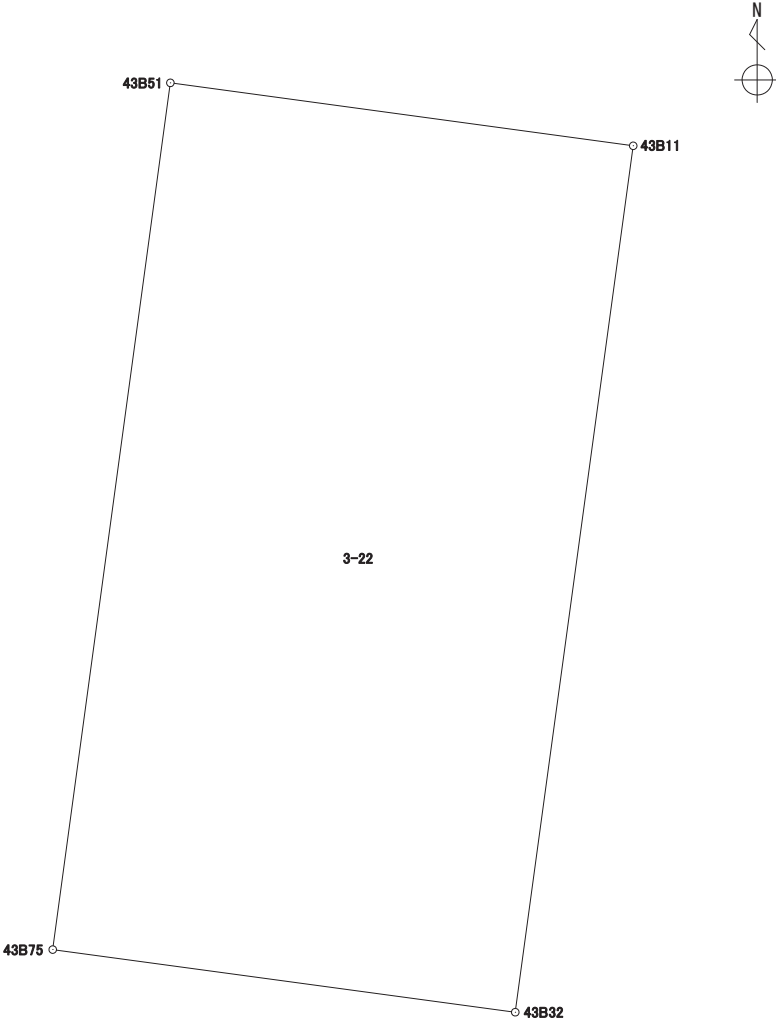
地番	3-21
----	------

境界点	X	Y	辺長	方向角	備考		
43B50	43194.313	-67489.516	2.484	97° 44' 55"			
43B51	43193.978	-67487.054	13.976	187° 43' 50"			
43B75	43180.129	-67488.934	2.484	277° 43' 33"			
43B74	43180.463	-67491.396	13.977	7° 43' 48"			
面積算出公式			面 積	34.7263290	街区一画地	43-保17	
$A=1/2 \sum X_n(Y_{(n+1)}-Y_{(n-1)})$			地 積	34.72			

座 標 面 積 計 算 書

世界測地系（測地成果2011）

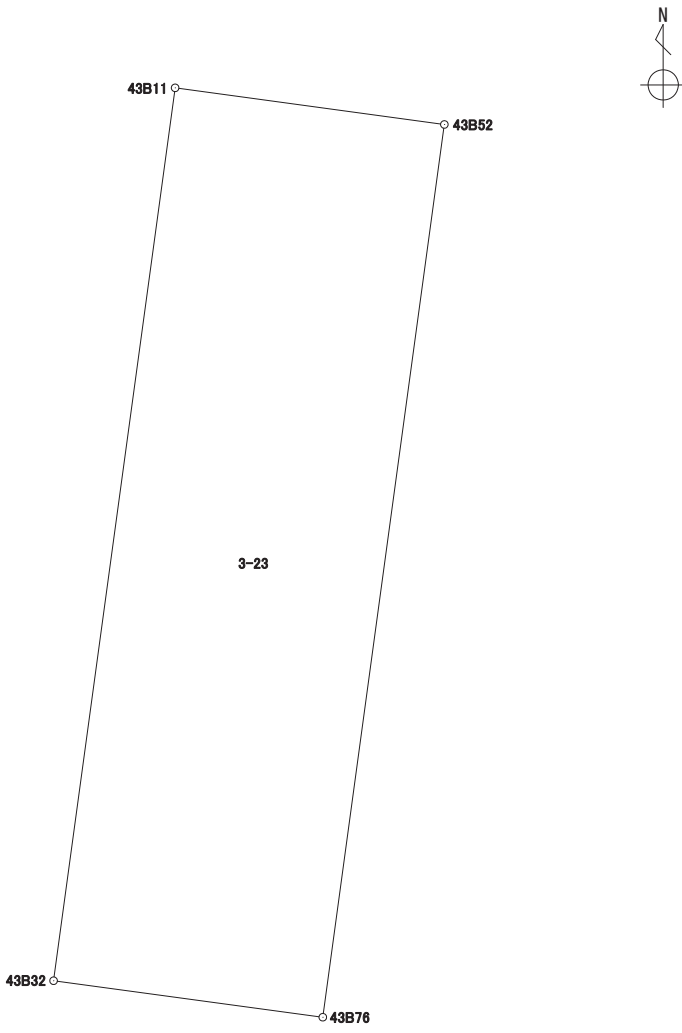
地 番 3-22

境 界 点	X	Y	辺長	方向角	備考		
43B75	43180.129	-67488.934	13.976	7° 43' 50″			
43B51	43193.978	-67487.054	7.465	97° 44' 41″			
43B11	43192.972	-67479.657	13.971	187° 45' 13″			
43B32	43179.128	-67481.542	7.459	277° 42' 43″			
面積算出公式			面 積	104.2770330	街区一画地	43-3	
$A=1/2 \sum X_n(Y_{(n+1)}-Y_{(n-1)})$			地 積	104.27			

座 標 面 積 計 算 書

世界測地系（測地成果2011）

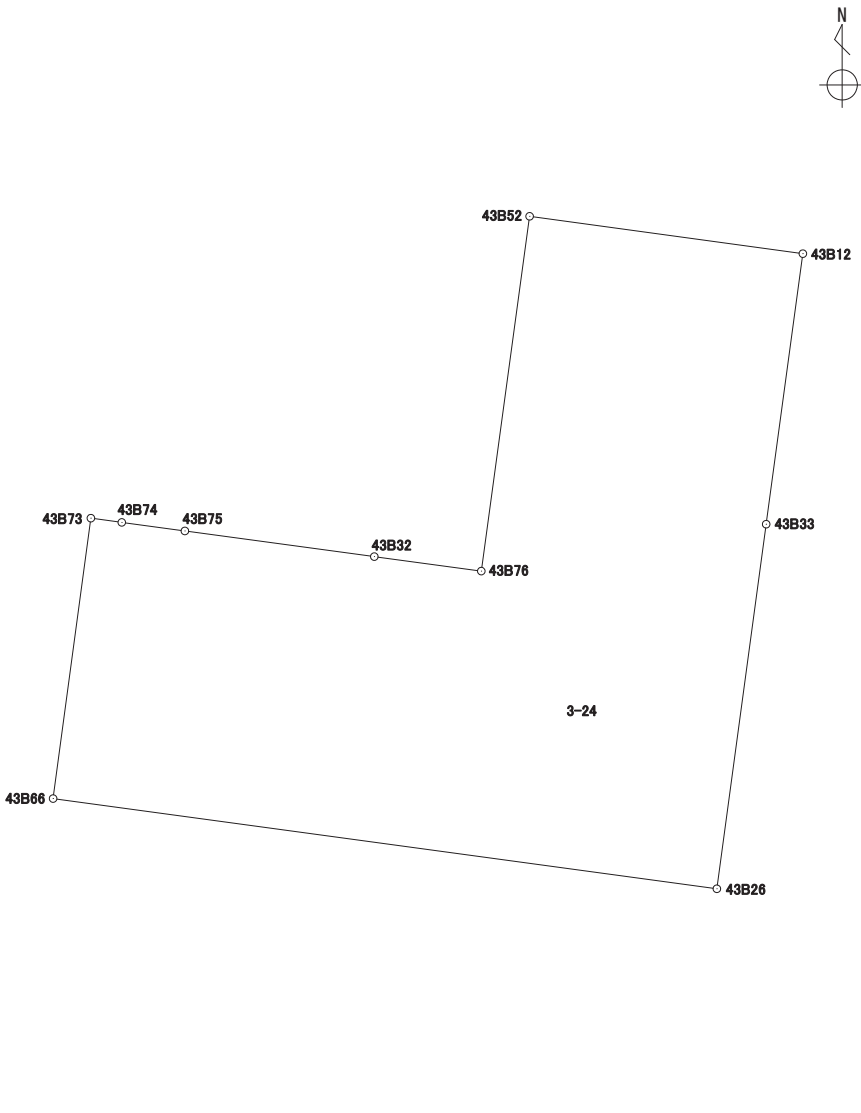
地番	3-23
----	------

境 界 点	X	Y	辺長	方向角	備考		
43B32	43179.128	-67481.542	13.971	7° 45' 13″			
43B11	43192.972	-67479.657	4.213	97° 44' 51″			
43B52	43192.404	-67475.482	13.969	187° 45' 17″			
43B76	43178.562	-67477.367	4.213	277° 43' 14″			
面積算出公式			面 積	58.8633200	街区一画地	43-保10	
$A=1/2 \sum X_n(Y_{(n+1)}-Y_{(n-1)})$			地 積	58.86			

座 標 面 積 計 算 書

世界測地系（測地成果2011）

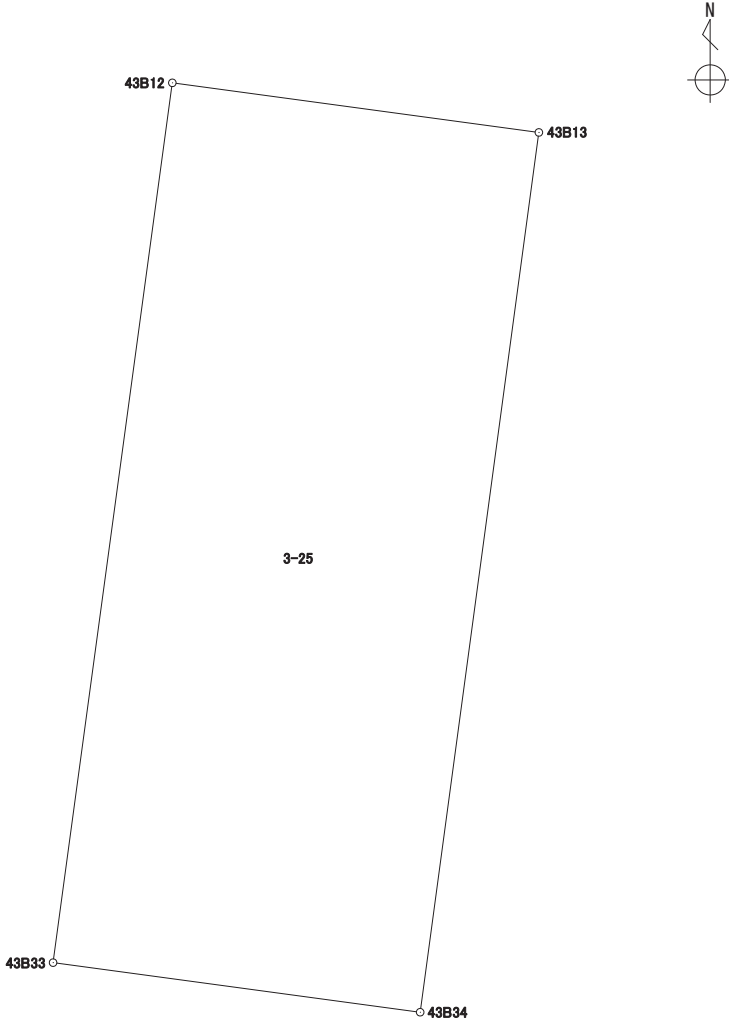
地番	3-24
----	------

境界点	X	Y	辺長	方向角	備考		
43B66	43169.689	-67494.076	11.036	7° 40' 30″			
43B73	43180.627	-67492.602	1.217	97° 44' 38″			
43B74	43180.463	-67491.396	2.484	97° 43' 33″			
43B75	43180.129	-67488.934	7.459	97° 42' 43″			
43B32	43179.128	-67481.542	4.213	97° 43' 14″			
43B76	43178.562	-67477.367	13.969	7° 45' 17″			
43B52	43192.404	-67475.482	10.760	97° 46' 56″			
43B12	43190.947	-67464.821	10.651	187° 43' 15″			
43B33	43180.392	-67466.252	14.351	187° 42' 16″			
43B26	43166.170	-67468.176	26.137	277° 44' 14″			
面積算出公式			面 積	438.9288730	街区一画地	43-4	
$A=1/2 \sum X_n(Y_{(n+1)}-Y_{(n-1)})$			地 積	438.92			

座 標 面 積 計 算 書

世界測地系（測地成果2011）

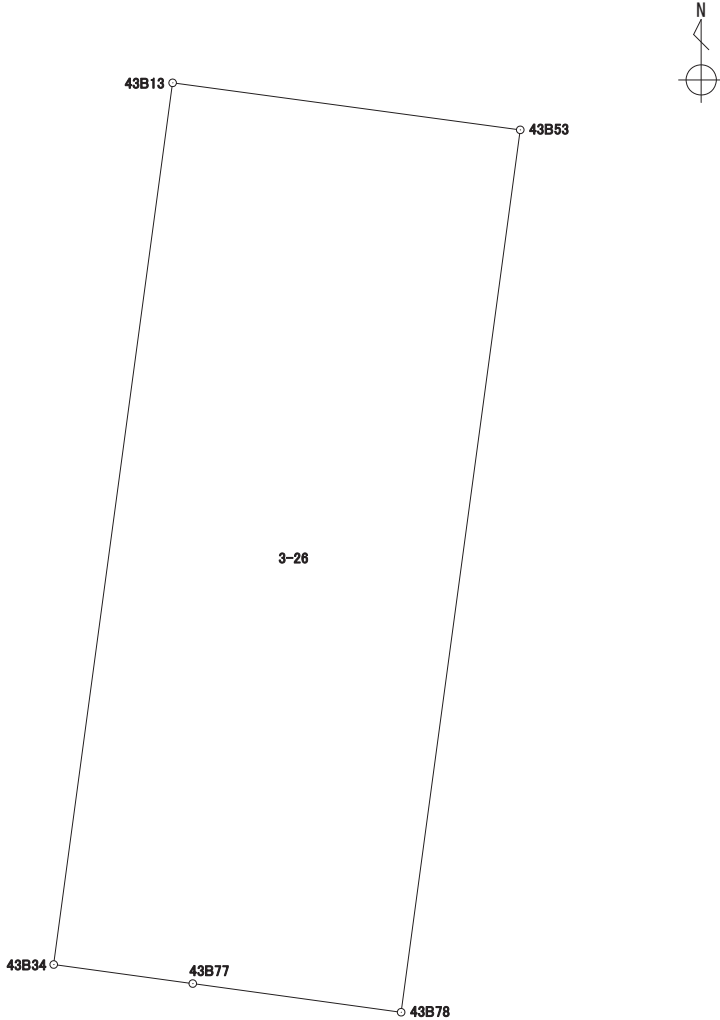
地 番 3-25

境 界 点	X	Y	辺長	方向角	備考		
43B12	43190.947	-67464.821	4.438	97° 42' 17"			
43B13	43190.352	-67460.423	10.650	187° 41' 01"			
43B34	43179.797	-67461.847	4.445	277° 41' 33"			
43B33	43180.392	-67466.252	10.651	7° 43' 15"			
面積算出公式			面 積	47.3071950	街区一画地	43-保27	
$A=1/2 \sum X_n(Y_{(n+1)}-Y_{(n-1)})$			地 積	47.30			

座 標 面 積 計 算 書

世界測地系（測地成果2011）

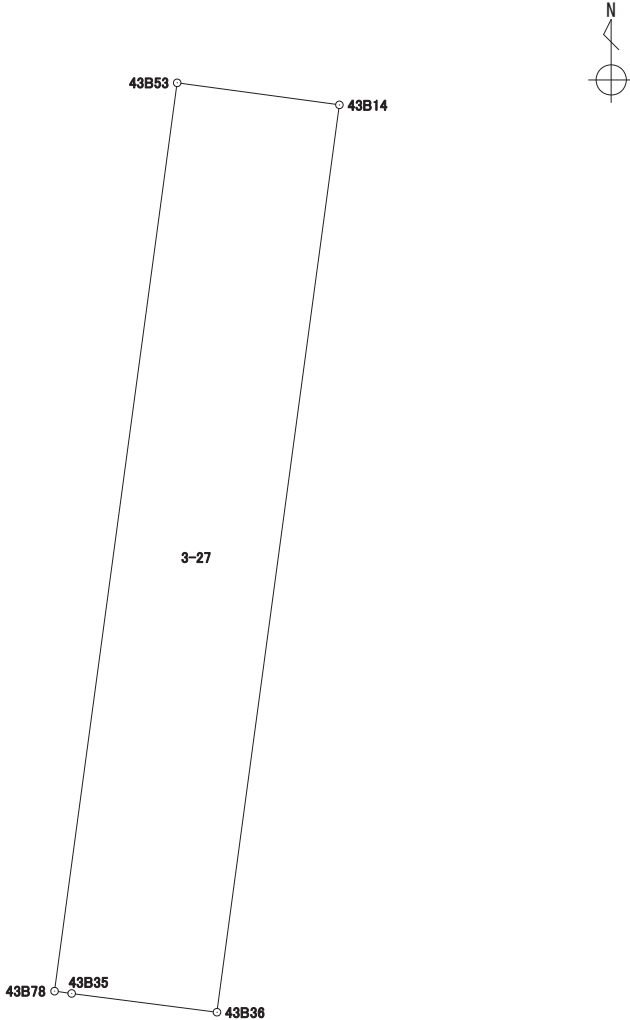
地 番 3-26

境 界 点	X	Y	辺長	方向角	備考		
43B53	43189.789	-67456.261	10.658	187° 41' 18″			
43B78	43179.226	-67457.687	2.518	277° 49' 40″			
43B77	43179.569	-67460.182	1.680	277° 47' 51″			
43B34	43179.797	-67461.847	10.650	7° 41' 01″			
43B13	43190.352	-67460.423	4.199	97° 42' 13″			
面積算出公式			面 積	44.7428565	街区一画地	43-5	
$A=1/2 \sum X_n(Y_{(n+1)}-Y_{(n-1)})$			地 積	44.74			

座 標 面 積 計 算 書

世界測地系（測地成果2011）

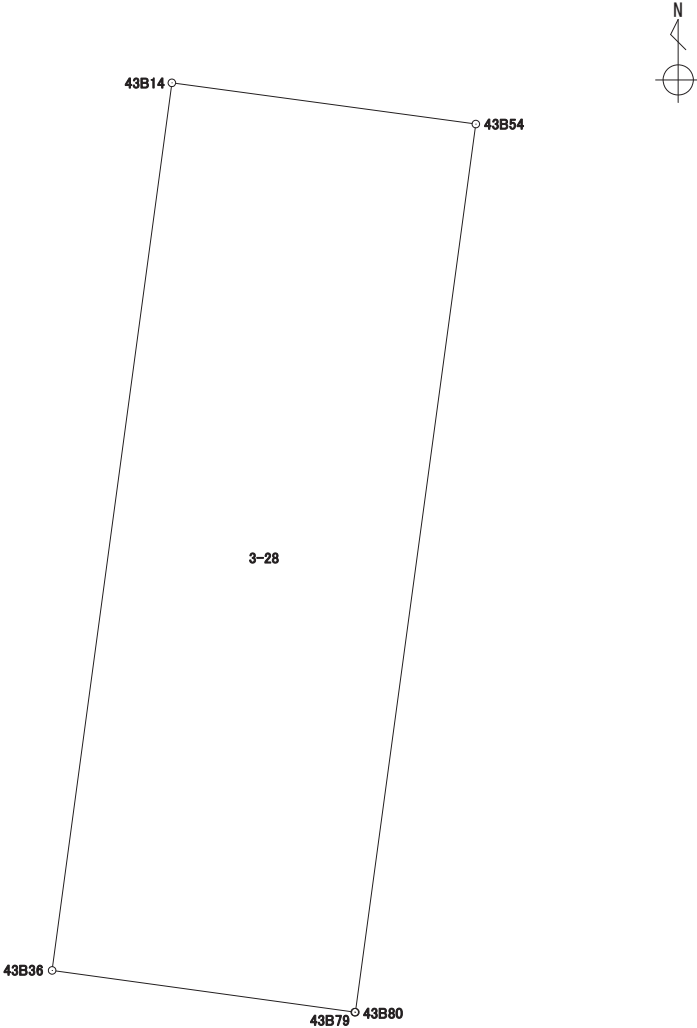
地番	3-27
----	------

境 界 点	X	Y	辺長	方向角	備考		
43B36	43178.981	-67455.798	1.704	277° 21' 01″			
43B35	43179.199	-67457.488	0.200	277° 43' 36″			
43B78	43179.226	-67457.687	10.658	7° 41' 18″			
43B53	43189.789	-67456.261	1.904	97° 43' 33″			
43B14	43189.533	-67454.374	10.647	187° 41' 08″			
面積算出公式			面 積	20.2906465	街区一画地	43-保16	
$A=1/2 \sum X_n(Y_{(n+1)}-Y_{(n-1)})$			地 積	20.29			

座 標 面 積 計 算 書

世界測地系（測地成果2011）

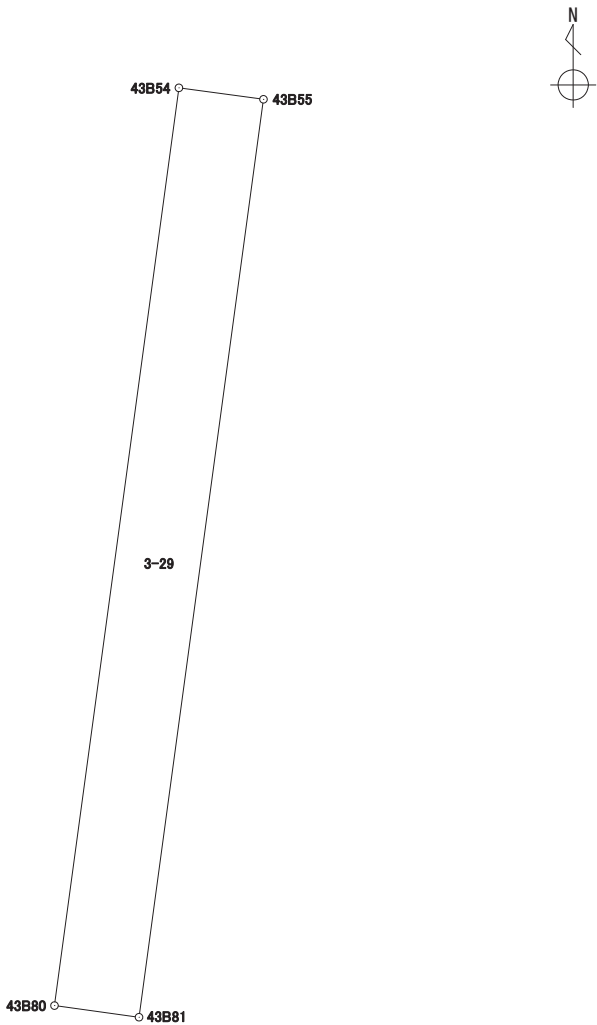
地番	3-28
----	------

境 界 点	X	Y	辺長	方向角	備考		
43B54	43189.043	-67450.760	10.655	187° 43' 24″			
43B80	43178.484	-67452.192	0.008	277° 07' 30″			
43B79	43178.485	-67452.200	3.632	277° 50' 56″			
43B36	43178.981	-67455.798	10.647	7° 41' 08″			
43B14	43189.533	-67454.374	3.647	97° 43' 17″			
面積算出公式			面 積	38.8102580	街区一画地	43-6	
$A=1/2 \sum X_n(Y_{(n+1)}-Y_{(n-1)})$			地 積	38.81			

座 標 面 積 計 算 書

世界測地系（測地成果2011）

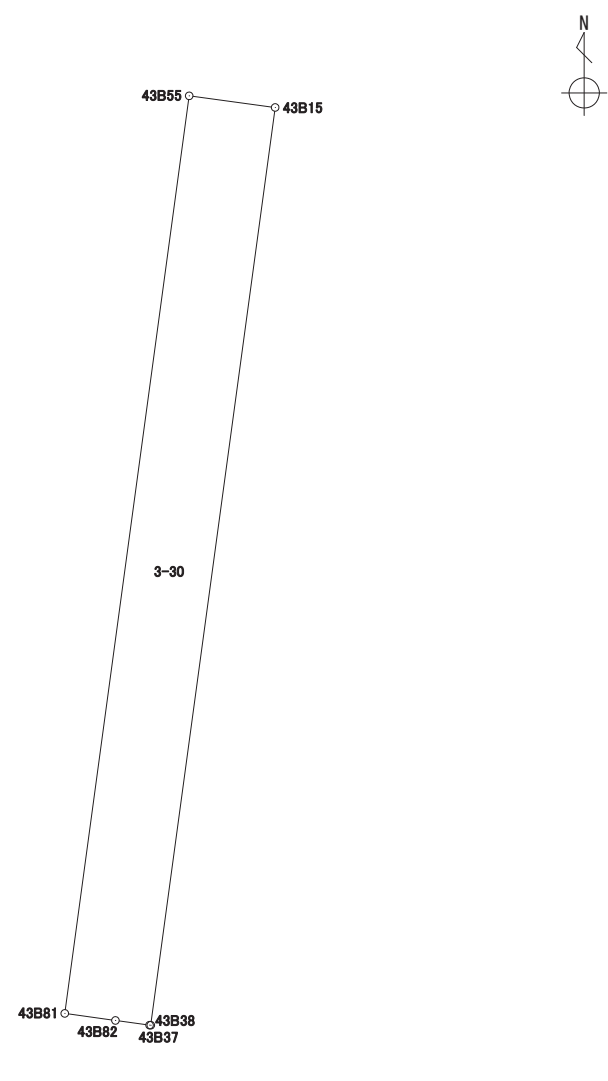
地番	3-29
----	------

境 界 点	X	Y	辺長	方向角	備考		
43B55	43188.911	-67449.787	10.657	187° 43' 19″			
43B81	43178.350	-67451.219	0.982	277° 50' 29″			
43B80	43178.484	-67452.192	10.655	7° 43' 24″			
43B54	43189.043	-67450.760	0.981	97° 43' 33″			
面積算出公式			面 積	10.4653360	街区一画地	43－保6	
$A=1/2 \sum X_n(Y_{(n+1)}-Y_{(n-1)})$			地 積	10.46			

座 標 面 積 計 算 書

世界測地系（測地成果2011）

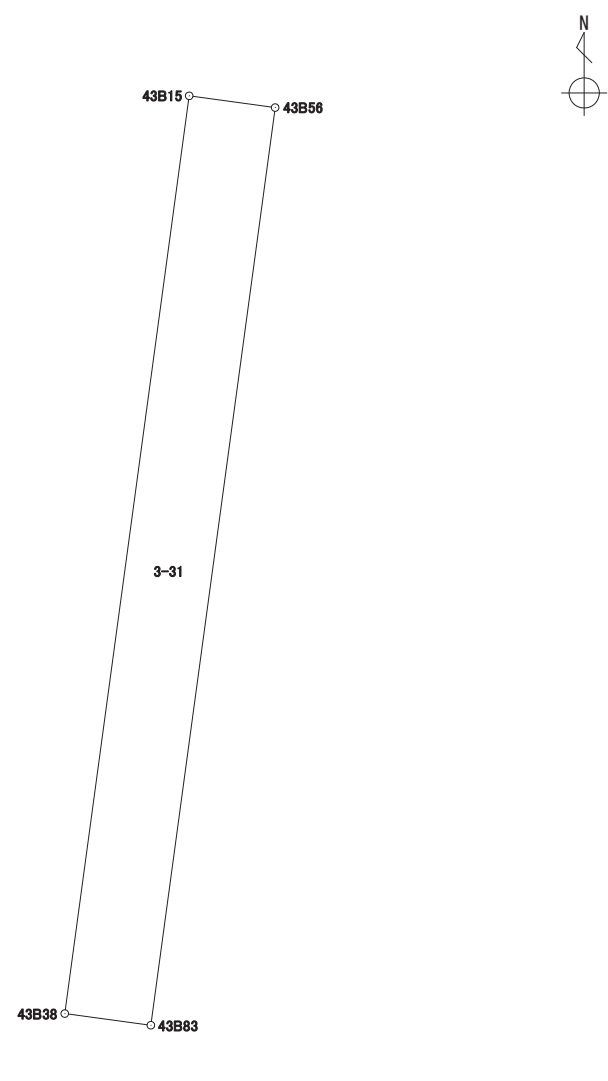
地番	3-30
----	------

境 界 点	X	Y	辺長	方向角	備考		
43B38	43178.214	-67450.229	0.014	274° 05' 08″			
43B37	43178.215	-67450.243	0.396	277° 49' 25″			
43B82	43178.269	-67450.636	0.588	277° 54' 35″			
43B81	43178.350	-67451.219	10.657	7° 43' 19″			
43B55	43188.911	-67449.787	0.999	97° 42' 30″			
43B15	43188.777	-67448.797	10.659	187° 43' 13″			
面積算出公式			面 積	10.6503325	街区一画地	43-保7	
$A=1/2 \sum X_n(Y_{(n+1)}-Y_{(n-1)})$			地 積	10.65			

座 標 面 積 計 算 書

世界測地系（測地成果2011）

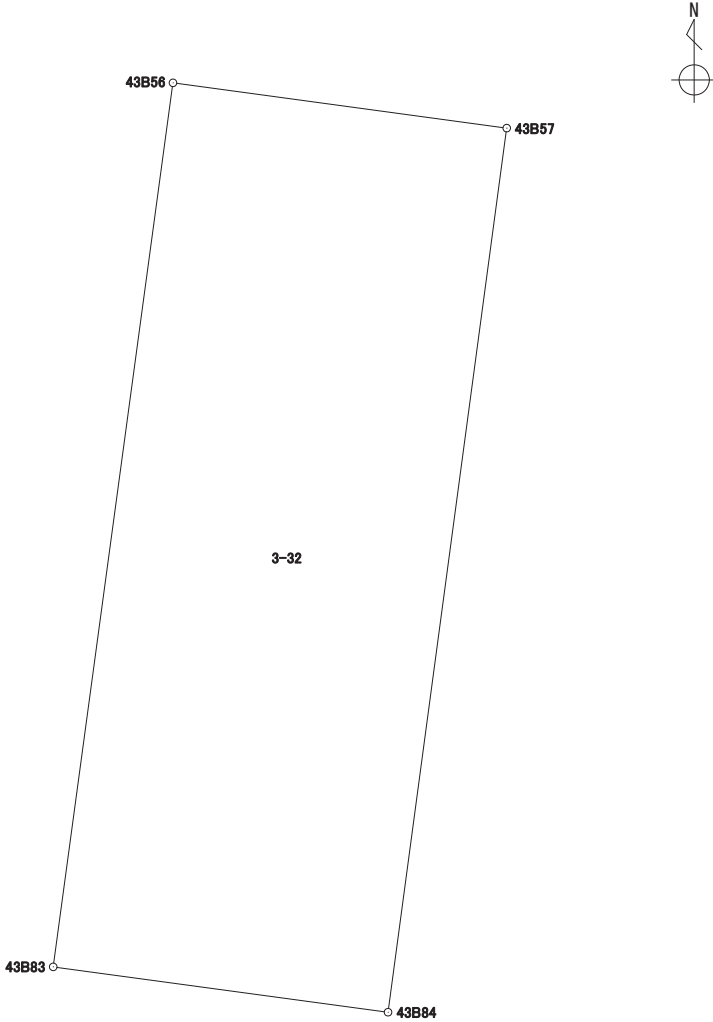
地番	3-31
----	------

境 界 点	X	Y	辺長	方向角	備考		
43B15	43188.777	-67448.797	0.999	97° 45' 55"			
43B56	43188.642	-67447.807	10.658	187° 42' 57"			
43B83	43178.080	-67449.238	1.000	277° 42' 02"			
43B38	43178.214	-67450.229	10.659	7° 43' 13"			
面積算出公式			面 積	10.6546930	街区一画地	43-保5	
$A=1/2 \sum X_n(Y_{(n+1)}-Y_{(n-1)})$			地 積	10.65			

座 標 面 積 計 算 書

世界測地系（測地成果2011）

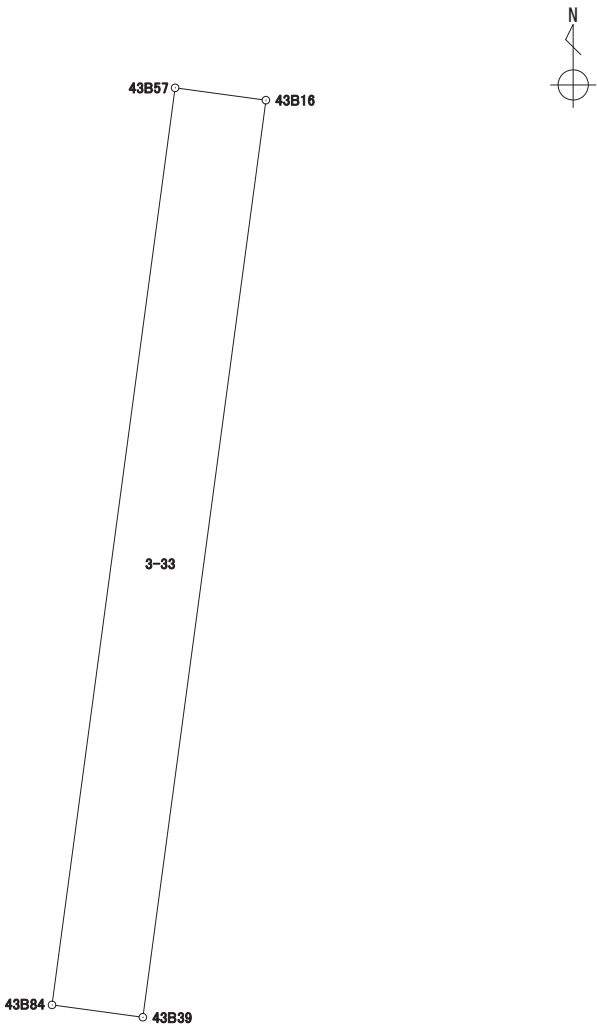
地 番 3-32

境 界 点	X	Y	辺長	方向角	備考		
43B83	43178.080	-67449.238	10.658	7° 42' 57″			
43B56	43188.642	-67447.807	4.024	97° 43' 31″			
43B57	43188.101	-67443.819	10.657	187° 38' 45″			
43B84	43177.538	-67445.237	4.037	277° 42' 53″			
面積算出公式			面 積	42.9632730	街区一画地	43-7	
$A=1/2 \sum X_n(Y_{(n+1)}-Y_{(n-1)})$			地 積	42.96			

座 標 面 積 計 算 書

世界測地系（測地成果2011）

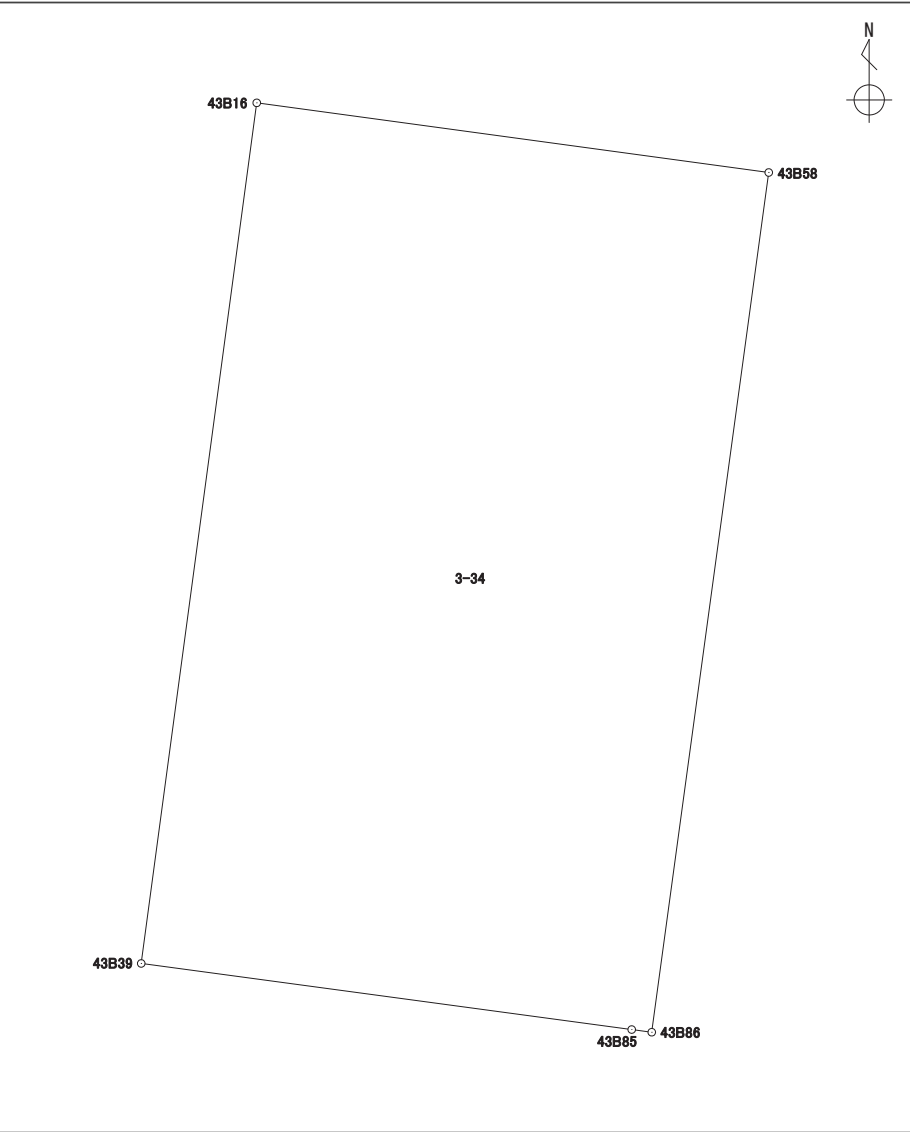
地番	3-33
----	------

境界点	X	Y	辺長	方向角	備考		
43B39	43177.396	-67444.191	1.055	277° 43' 51″			
43B84	43177.538	-67445.237	10.657	7° 38' 45″			
43B57	43188.101	-67443.819	1.055	97° 43' 51″			
43B16	43187.959	-67442.773	10.657	187° 38' 45″			
面積算出公式			面 積	11.2502540	街区一画地	43-保4	
$A=1/2 \sum X_n(Y_{(n+1)}-Y_{(n-1)})$			地 積	11.25			

座 標 面 積 計 算 書

世界測地系（測地成果2011）

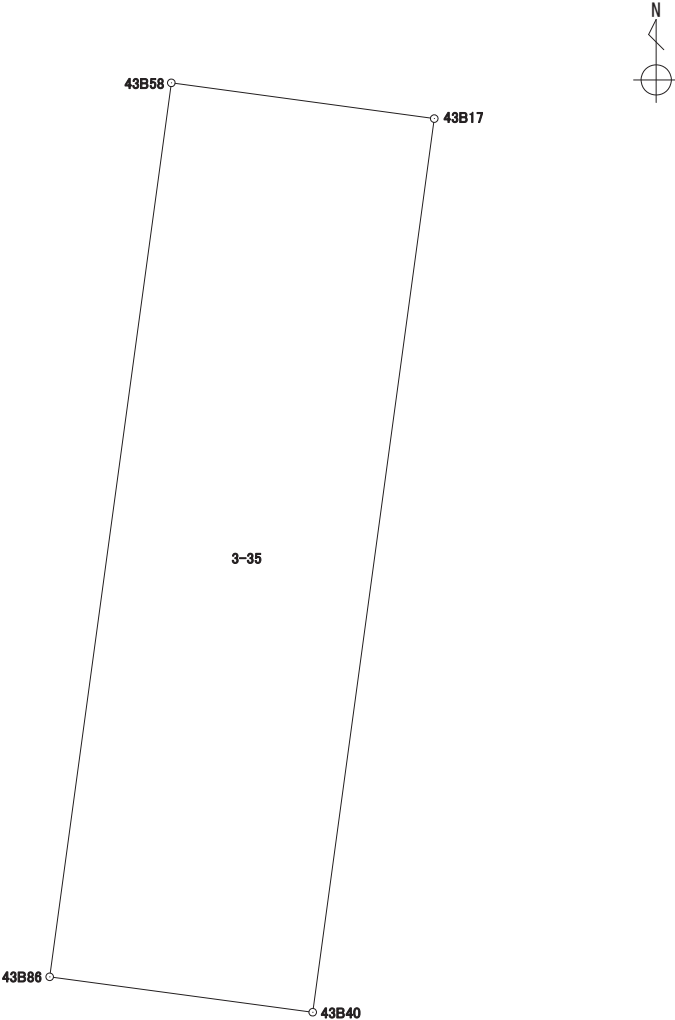
地 番 3-34

境 界 点	X	Y	辺長	方向角	備考		
43B58	43187.104	-67436.488	10.649	187° 44' 59"			
43B86	43176.552	-67437.924	0.248	277° 38' 25"			
43B85	43176.585	-67438.170	6.075	277° 40' 17"			
43B39	43177.396	-67444.191	10.657	7° 38' 45"			
43B16	43187.959	-67442.773	6.342	97° 44' 49"			
面積算出公式			面 積	67.4715130	街区一画地	43-8	
$A=1/2 \sum X_n(Y_{(n+1)}-Y_{(n-1)})$			地 積	67.47			

座 標 面 積 計 算 書

世界測地系（測地成果2011）

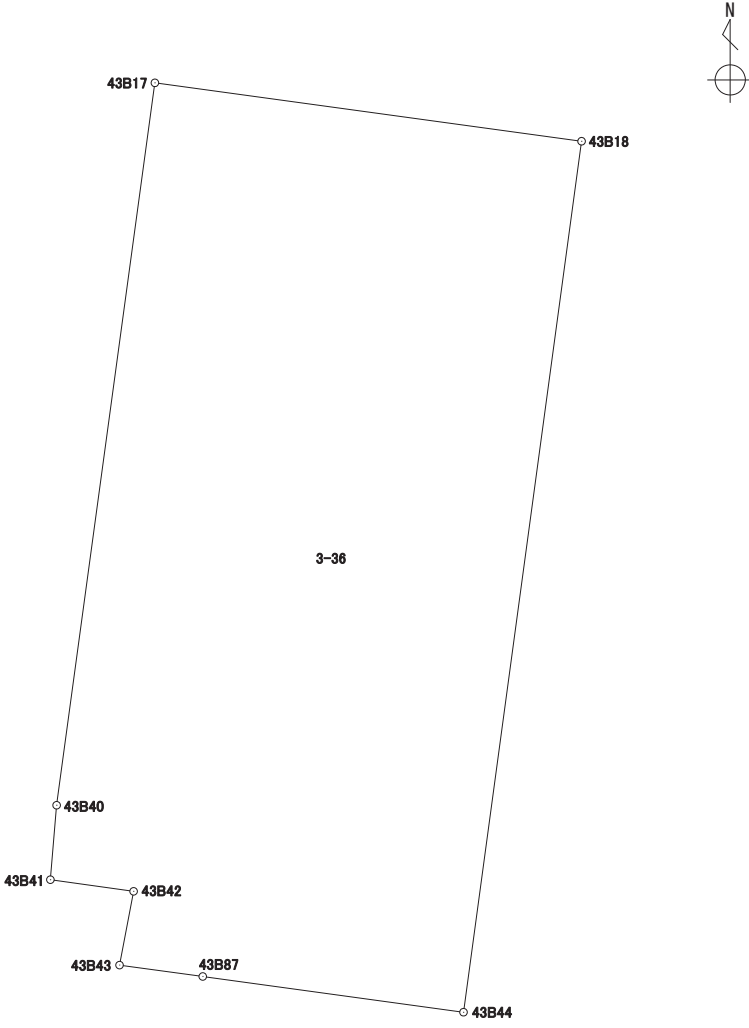
地番	3-35
----	------

境 界 点	X	Y	辺長	方向角	備考		
43B40	43176.134	-67434.819	3.133	277° 40' 02″			
43B86	43176.552	-67437.924	10.649	7° 44' 59″			
43B58	43187.104	-67436.488	3.132	97° 44' 32″			
43B17	43186.682	-67433.384	10.645	187° 44' 50″			
面積算出公式			面 積	33.3553850	街区一画地	43-保2	
$A=1/2 \sum X_n(Y_{(n+1)}-Y_{(n-1)})$			地 積	33.35			

座 標 面 積 計 算 書

世界測地系（測地成果2011）

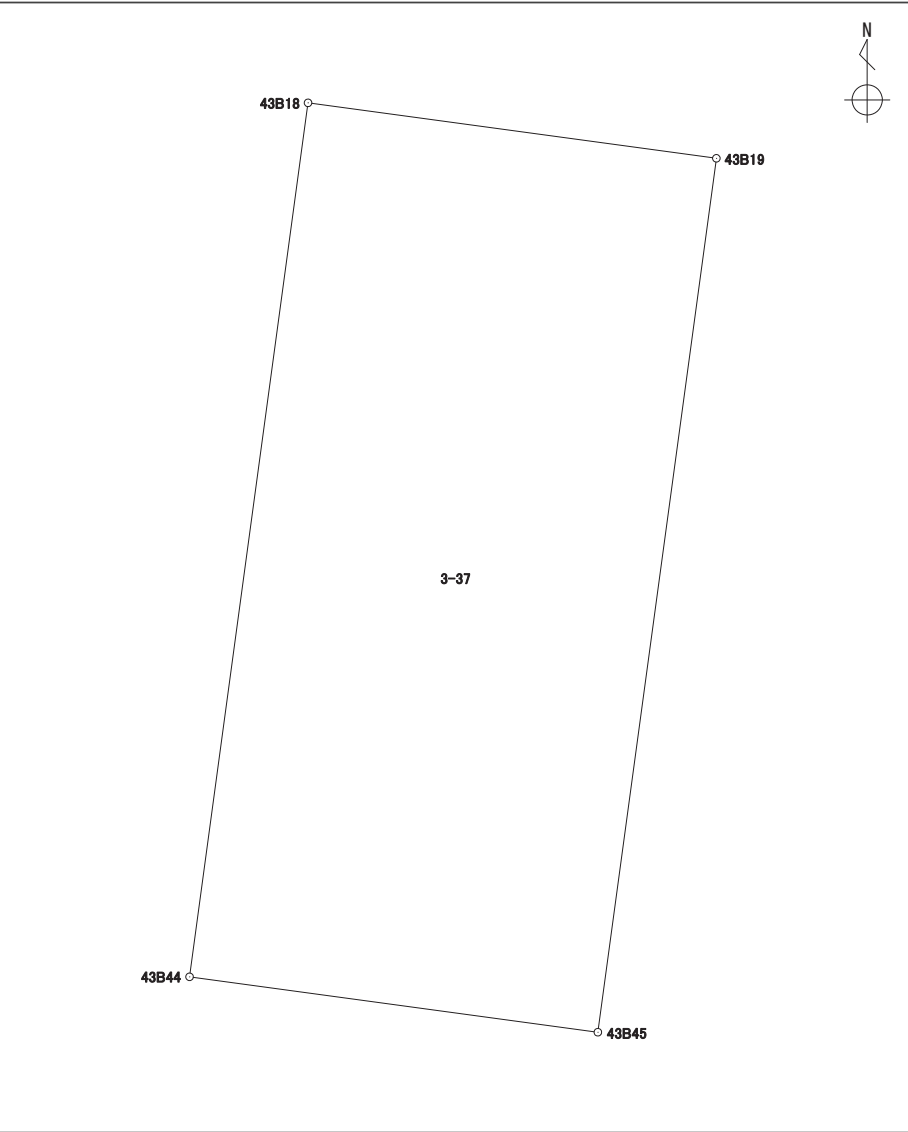
地 番 3-36

境 界 点	X	Y	辺長	方向角	備考		
43B40	43176.134	-67434.819	10.645	7° 44' 50″			
43B17	43186.682	-67433.384	6.289	97° 47' 42″			
43B18	43185.829	-67427.153	12.833	187° 43' 13″			
43B44	43173.112	-67428.877	3.843	277° 48' 20″			
43B87	43173.634	-67432.685	1.226	277° 46' 48″			
43B43	43173.800	-67433.900	1.096	10° 46' 37″			
43B42	43174.877	-67433.695	1.226	277° 57' 54″			
43B41	43175.047	-67434.910	1.090	4° 47' 08″			
面積算出公式			面 積	79.3401175	街区一画地	43-9	
$A=1/2 \sum X_n(Y_{(n+1)}-Y_{(n-1)})$			地 積	79.34			

座 標 面 積 計 算 書

世界測地系（測地成果2011）

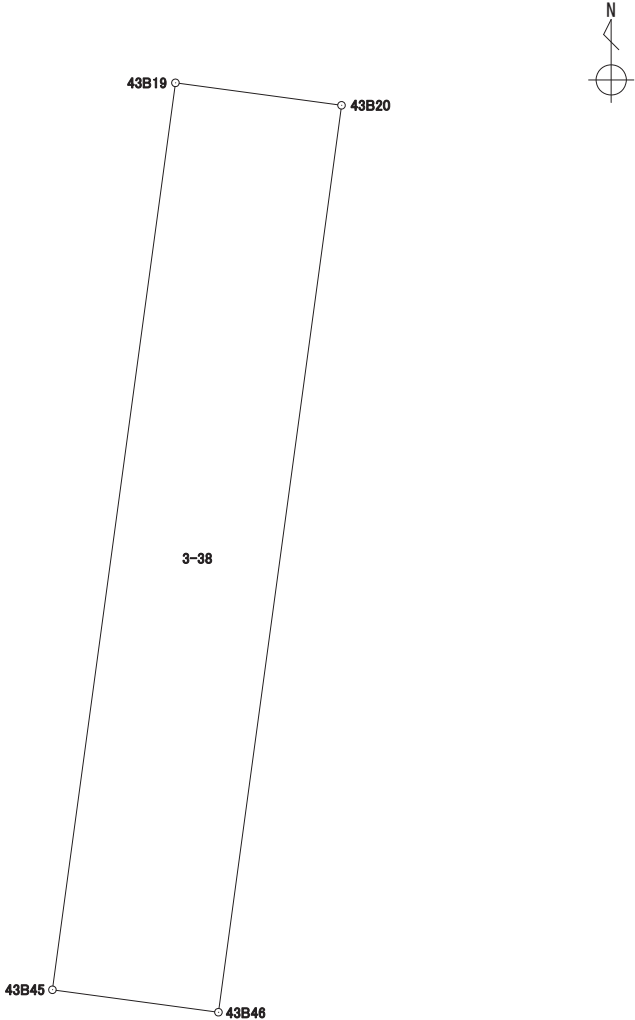
地番 3-37

境 界 点	X	Y	辺長	方向角	備考		
43B18	43185.829	-67427.153	5.997	97° 43' 58″			
43B19	43185.022	-67421.210	12.832	187° 43' 31″			
43B45	43172.306	-67422.935	5.996	277° 43' 29″			
43B44	43173.112	-67428.877	12.833	7° 43' 13″			
面積算出公式			面 積	76.9586105	街区一画地	43-10	
$A=1/2 \sum X_n(Y_{(n+1)}-Y_{(n-1)})$			地 積	76.95			

座 標 面 積 計 算 書

世界測地系（測地成果2011）

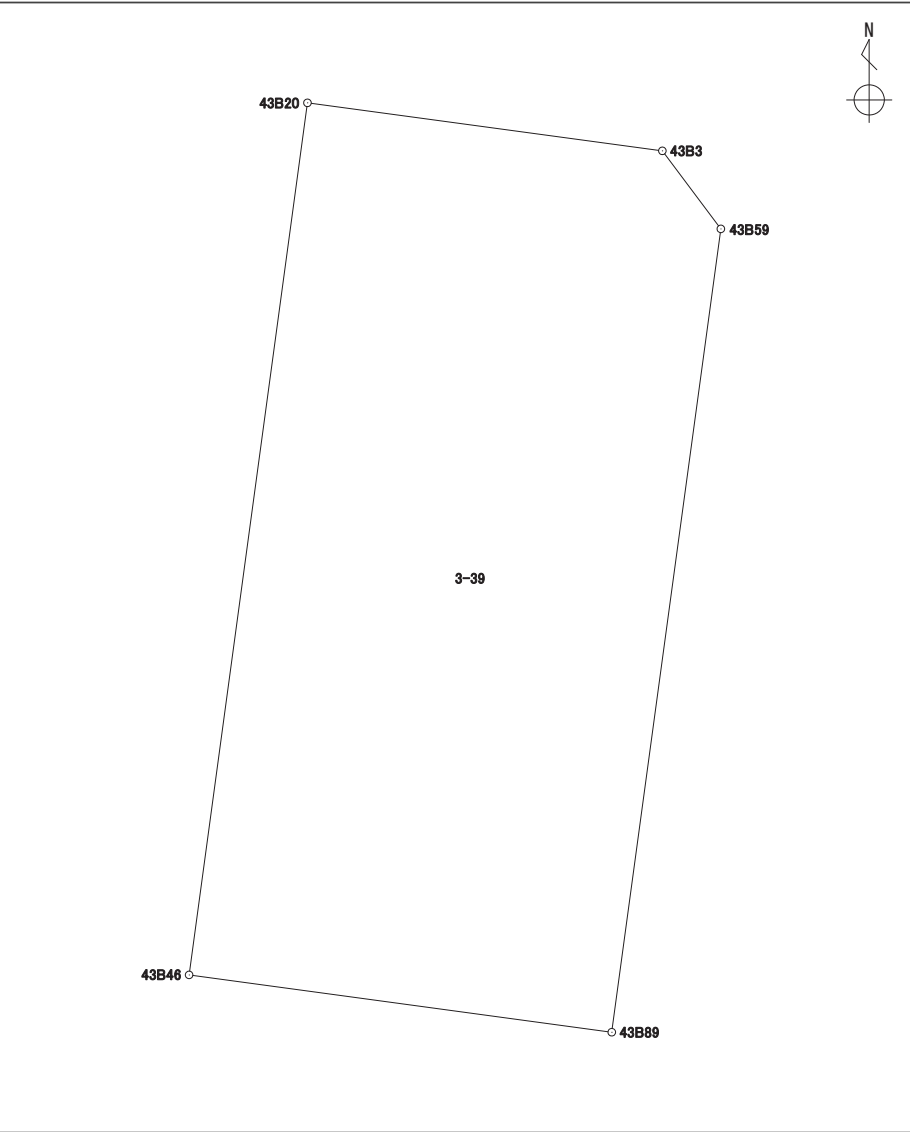
地番 3-38

境 界 点	X	Y	辺長	方向角	備考		
43B19	43185.022	-67421.210	2.350	97° 42' 09″			
43B20	43184.707	-67418.881	12.832	187° 43' 47″			
43B46	43171.991	-67420.607	2.349	277° 42' 21″			
43B45	43172.306	-67422.935	12.832	7° 43' 31″			
面積算出公式			面 積	30.1527385	街区一画地	43-保23	
$A=1/2 \sum X_n(Y_{(n+1)}-Y_{(n-1)})$			地 積	30.15			

座 標 面 積 計 算 書

世界測地系（測地成果2011）

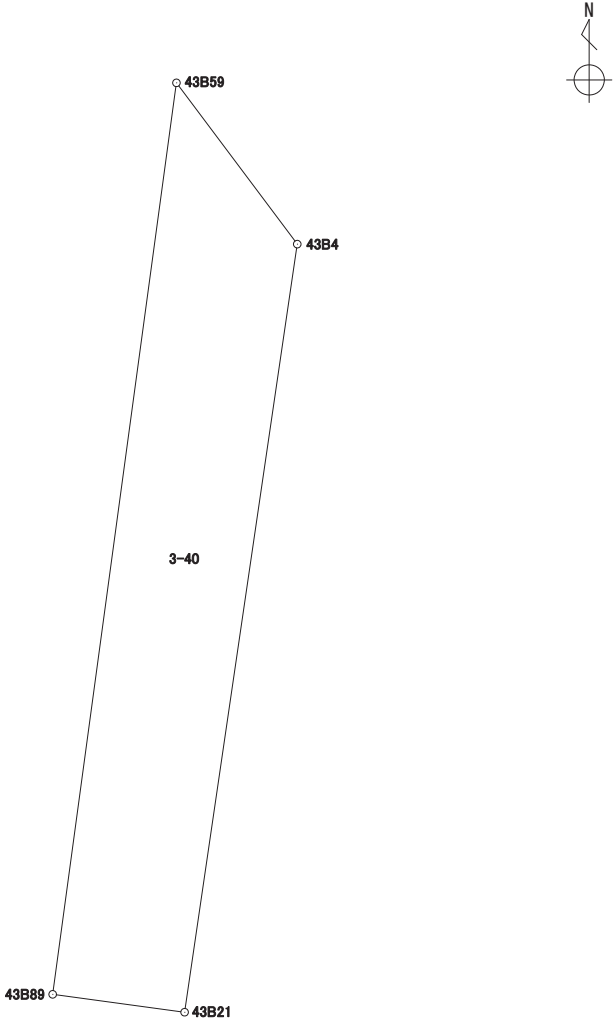
地 番 3-39

境 界 点	X	Y	辺長	方向角	備考		
43B46	43171.991	-67420.607	12.832	7° 43' 47″			
43B20	43184.707	-67418.881	5.223	97° 42' 07″			
43B3	43184.007	-67413.705	1.422	143° 08' 46″			
43B59	43182.869	-67412.852	11.821	187° 44' 05″			
43B89	43171.155	-67414.443	6.220	277° 43' 25″			
面積算出公式			面 積	79.3327560	街区一画地	43-保22	
$A=1/2 \sum X_n(Y_{(n+1)}-Y_{(n-1)})$			地 積	79.33			

座 標 面 積 計 算 書

世界測地系（測地成果2011）

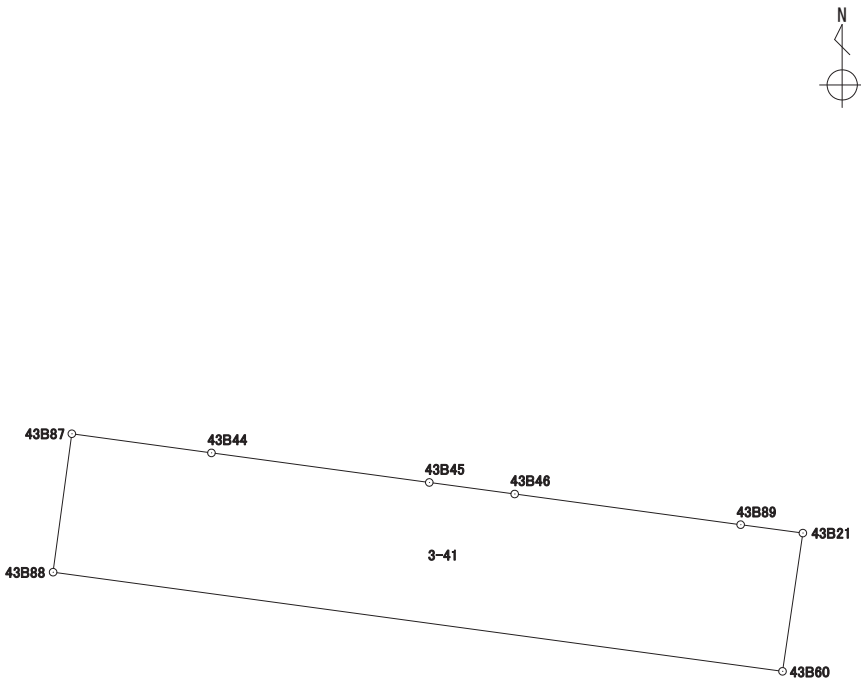
地番	3-40
----	------

境 界 点	X	Y	辺長	方向角	備考		
43B89	43171.155	-67414.443	11.821	7° 44' 05″			
43B59	43182.869	-67412.852	2.590	143° 09' 40″			
43B4	43180.796	-67411.299	9.976	188° 20' 43″			
43B21	43170.925	-67412.747	1.711	277° 43' 23″			
面積算出公式			面 積	19.2821205	街区一画地	43-11	
$A=1/2 \sum X_n(Y_{(n+1)}-Y_{(n-1)})$			地 積	19.28			

座 標 面 積 計 算 書

世界測地系（測地成果2011）

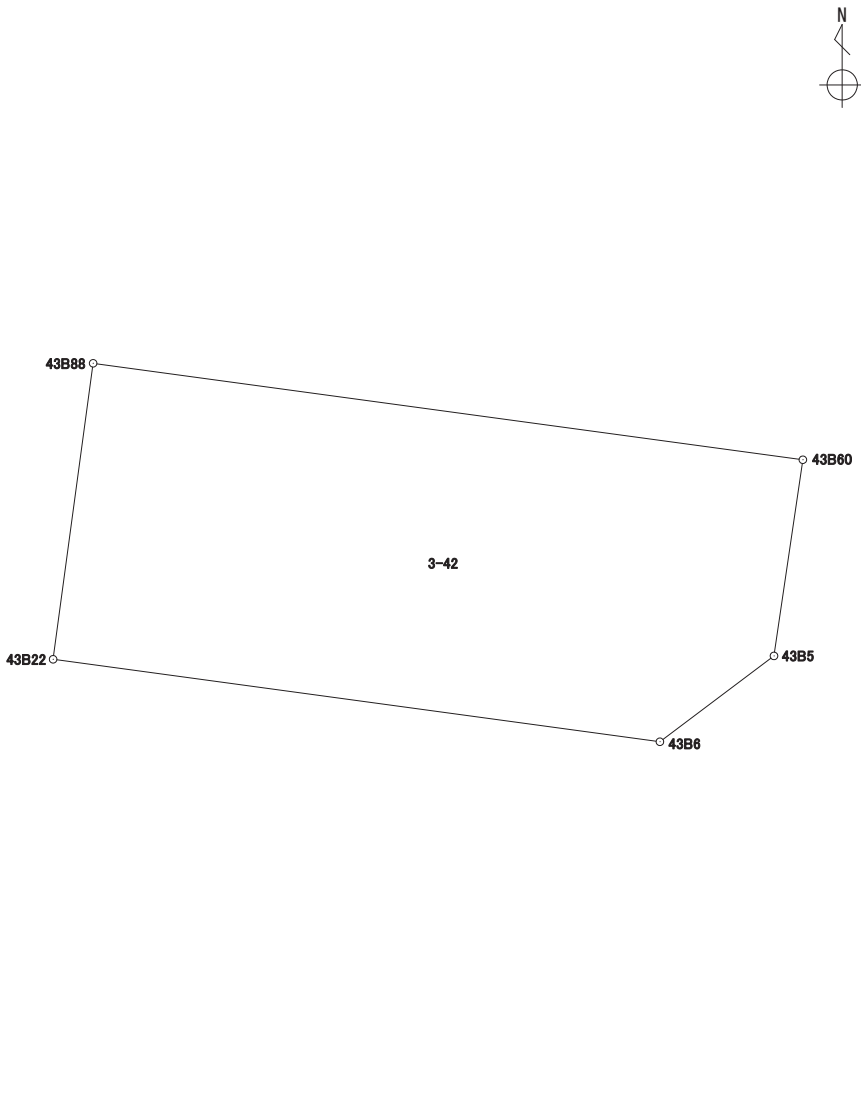
地 番	3-41
-----	------

境 界 点	X	Y	辺長	方向角	備考		
43B21	43170.925	-67412.747	3.809	188° 22' 37"			
43B60	43167.156	-67413.302	20.076	277° 44' 15"			
43B88	43169.859	-67433.196	3.809	7° 42' 32"			
43B87	43173.634	-67432.685	3.843	97° 48' 20"			
43B44	43173.112	-67428.877	5.996	97° 43' 29"			
43B45	43172.306	-67422.935	2.349	97° 42' 21"			
43B46	43171.991	-67420.607	6.220	97° 43' 25"			
43B89	43171.155	-67414.443	1.711	97° 43' 23"			
面積算出公式			面 積	76.5195610	街区一画地	43-保24	
$A=1/2 \sum X_n(Y_{(n+1)}-Y_{(n-1)})$			地 積	76.51			

座 標 面 積 計 算 書

世界測地系（測地成果2011）

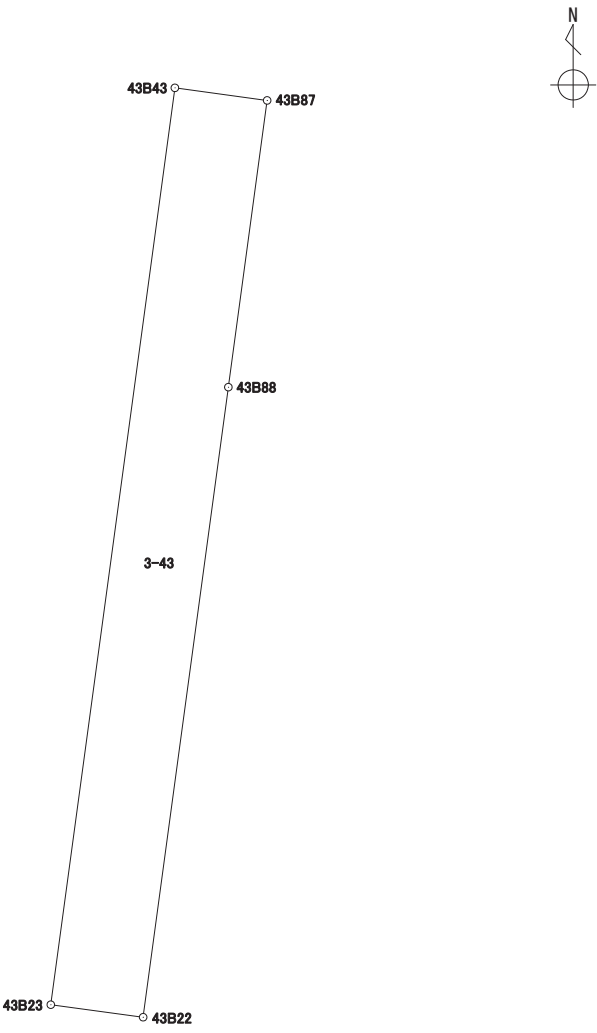
地番	3-42
----	------

境 界 点	X	Y	辺長	方向角	備考	N 	
43B88	43169.859	-67433.196	20.076	97° 44' 15"			
43B60	43167.156	-67413.302	5.556	188° 22' 20"			
43B5	43161.659	-67414.111	4.002	233° 02' 39"			
43B6	43159.253	-67417.309	17.165	277° 44' 14"			
43B22	43161.564	-67434.318	8.370	7° 42' 12"			
面積算出公式			面 積	163.6843760	街区一画地	43-12	
$A=1/2 \sum X_n(Y_{(n+1)}-Y_{(n-1)})$			地 積	163.68			

座 標 面 積 計 算 書

世界測地系（測地成果2011）

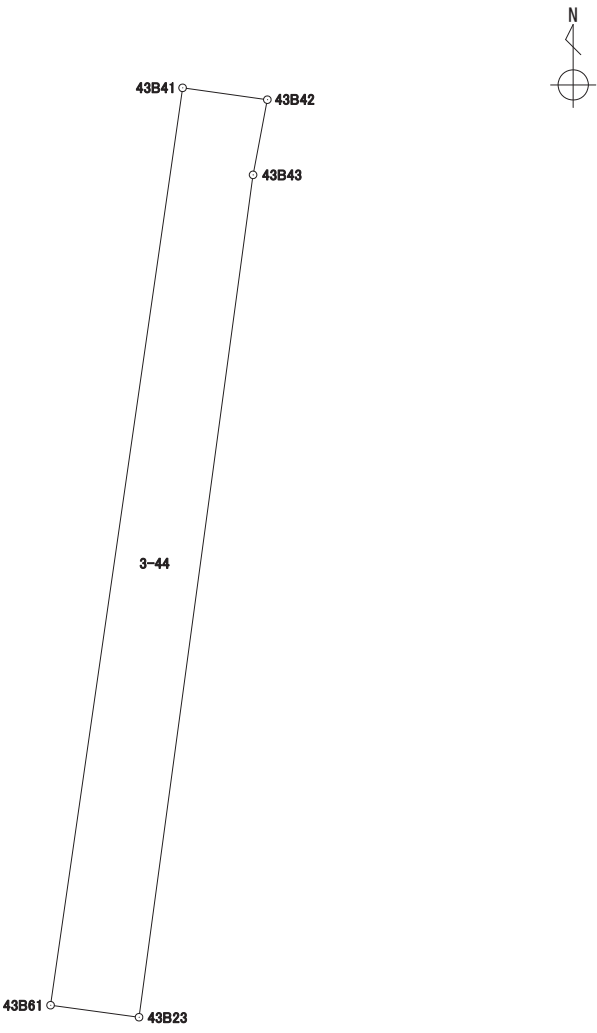
地番	3-43
----	------

境 界 点	X	Y	辺長	方向角	備考		
43B23	43161.729	-67435.534	12.181	7° 42' 33"			
43B43	43173.800	-67433.900	1.226	97° 46' 48"			
43B87	43173.634	-67432.685	3.809	187° 42' 32"			
43B88	43169.859	-67433.196	8.370	187° 42' 12"			
43B22	43161.564	-67434.318	1.227	277° 43' 38"			
面積算出公式			面 積	14.9404395	街区一画地	43-保25	
$A=1/2 \sum X_n(Y_{(n+1)}-Y_{(n-1)})$			地 積	14.94			

座 標 面 積 計 算 書

世界測地系（測地成果2011）

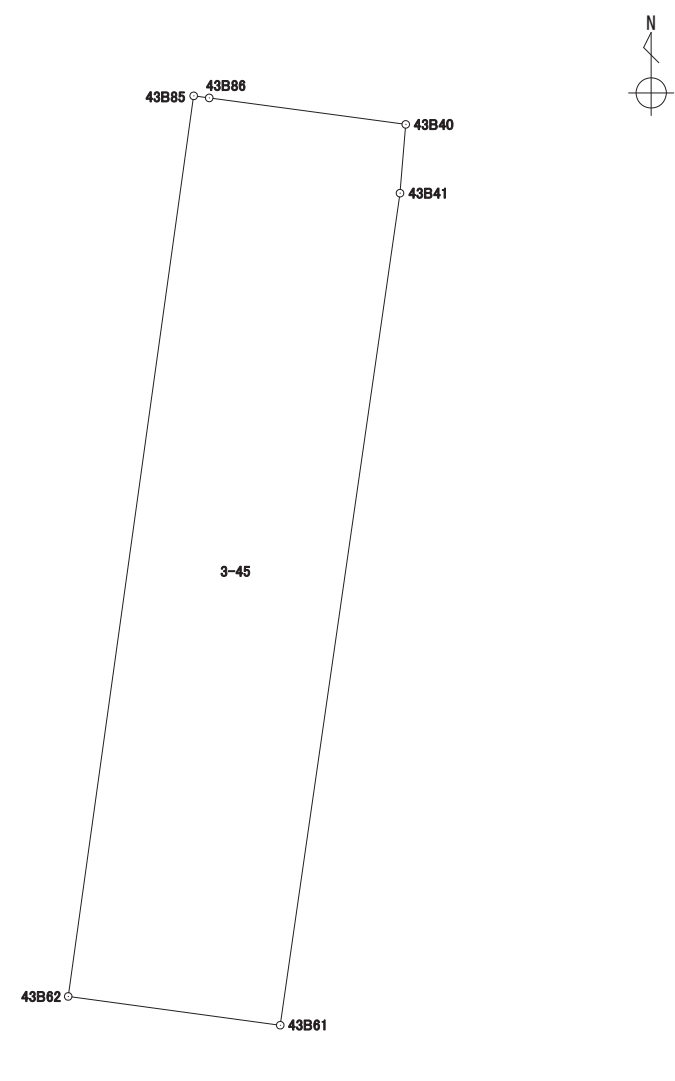
地番	3-44
----	------

境 界 点	X	Y	辺長	方向角	備考		
43B23	43161.729	-67435.534	1.279	277° 43' 29"			
43B61	43161.901	-67436.802	13.281	8° 11' 24"			
43B41	43175.047	-67434.910	1.226	97° 57' 54"			
43B42	43174.877	-67433.695	1.096	190° 46' 37"			
43B43	43173.800	-67433.900	12.181	187° 42' 33"			
面積算出公式			面 積	16.2836325	街区一画地	43-保26	
$A=1/2 \sum X_n(Y_{(n+1)}-Y_{(n-1)})$			地 積	16.28			

座 標 面 積 計 算 書

世界測地系（測地成果2011）

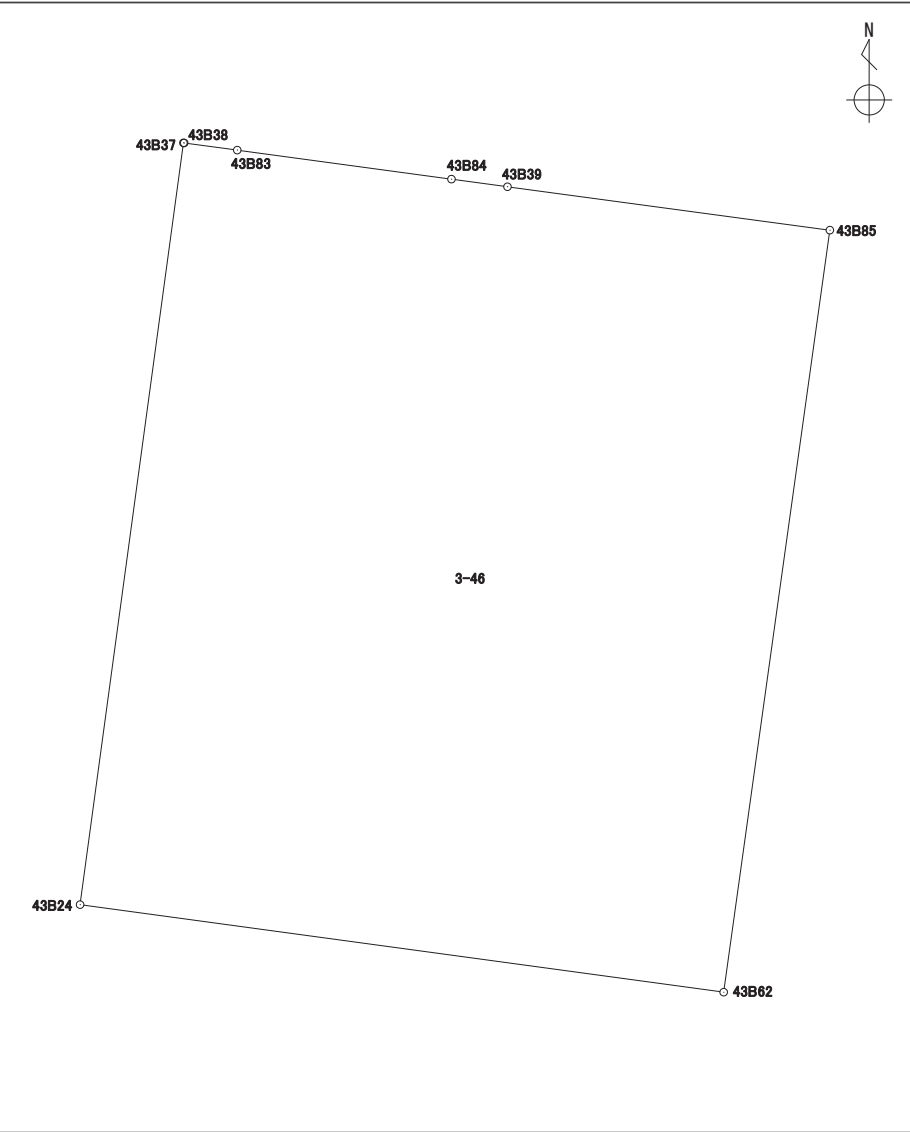
地番	3-45
----	------

境 界 点	X	Y	辺長	方向角	備考		
43B41	43175.047	-67434.910	13.281	188° 11' 24"			
43B61	43161.901	-67436.802	3.381	277° 43' 56"			
43B62	43162.356	-67440.153	14.366	7° 56' 02"			
43B85	43176.585	-67438.170	0.248	97° 38' 25"			
43B86	43176.552	-67437.924	3.133	97° 40' 02"			
43B40	43176.134	-67434.819	1.090	184° 47' 08"			
面積算出公式			面 積	49.0167205	街区一画地	43-保3	
$A=1/2 \sum X_n(Y_{(n+1)}-Y_{(n-1)})$			地 積	49.01			

座 標 面 積 計 算 書

世界測地系（測地成果2011）

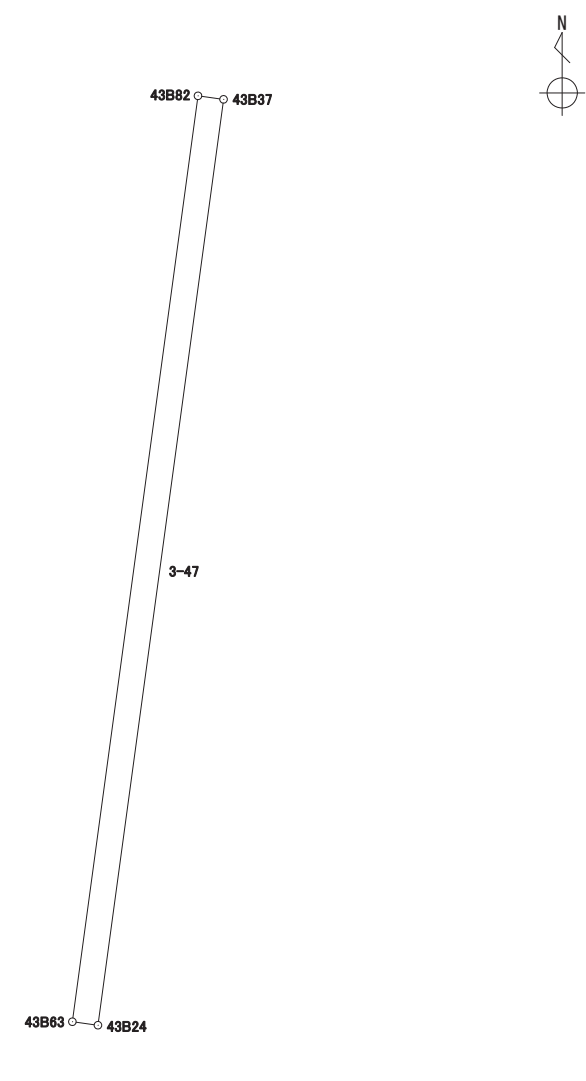
地 番 3-46

境 界 点	X	Y	辺長	方向角	備考		
43B85	43176.585	-67438.170	14.366	187° 56' 02"			
43B62	43162.356	-67440.153	12.130	277° 44' 29"			
43B24	43163.990	-67452.173	14.355	7° 43' 35"			
43B37	43178.215	-67450.243	0.014	94° 05' 08"			
43B38	43178.214	-67450.229	1.000	97° 42' 02"			
43B83	43178.080	-67449.238	4.037	97° 42' 53"			
43B84	43177.538	-67445.237	1.055	97° 43' 51"			
43B39	43177.396	-67444.191	6.075	97° 40' 17"			
面積算出公式			面 積	174.5711350	街区一画地	43-13	
$A=1/2 \sum X_n(Y_{(n+1)}-Y_{(n-1)})$			地 積	174.57			

座標面積計算書

世界測地系（測地成果2011）

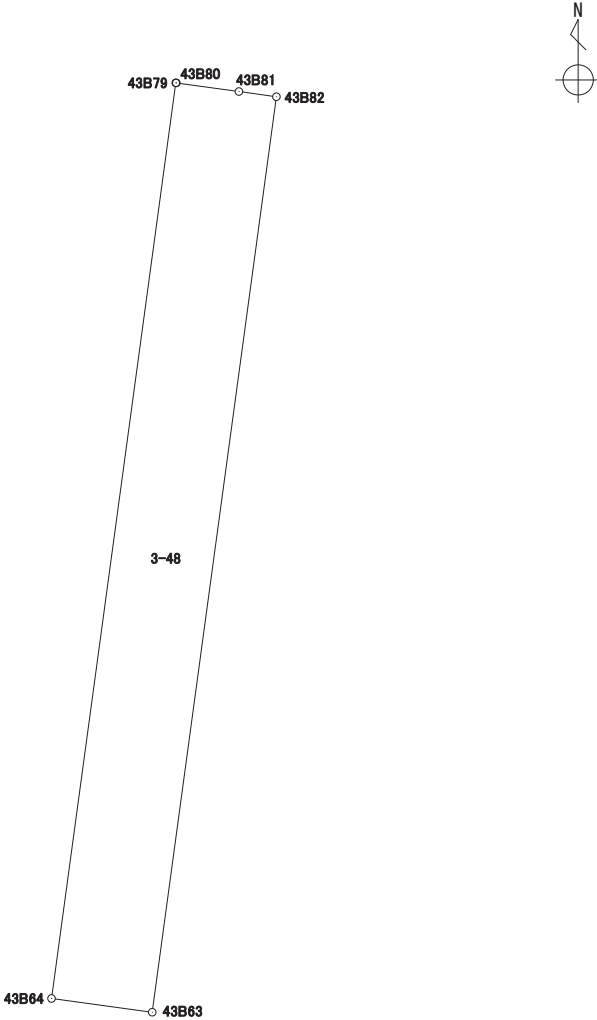
地番	3-47
----	------

境界点	X	Y	辺長	方向角	備考		
43B24	43163.990	-67452.173	0.396	277° 49' 25"			
43B63	43164.044	-67452.566	14.355	7° 43' 35"			
43B82	43178.269	-67450.636	0.396	97° 49' 25"			
43B37	43178.215	-67450.243	14.355	187° 43' 35"			
面積算出公式			面積	5.6946450	街区一画地	43-保15	
$A=1/2 \sum X_n(Y_{(n+1)}-Y_{(n-1)})$			地積	5.69			

座 標 面 積 計 算 書

世界測地系（測地成果2011）

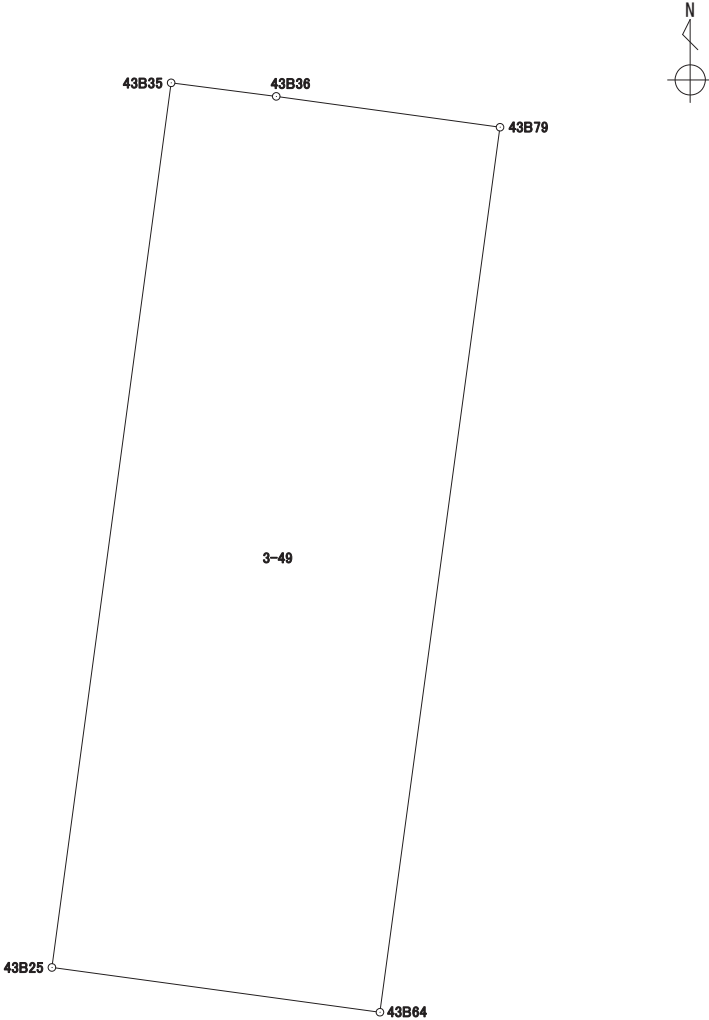
地番	3-48
----	------

境 界 点	X	Y	辺長	方向角	備考		
43B63	43164.044	-67452.566	1.579	277° 47' 11″			
43B64	43164.258	-67454.131	14.357	7° 43' 46″			
43B79	43178.485	-67452.200	0.008	97° 07' 30″			
43B80	43178.484	-67452.192	0.982	97° 50' 29″			
43B81	43178.350	-67451.219	0.588	97° 54' 35″			
43B82	43178.269	-67450.636	14.355	187° 43' 35″			
面積算出公式			面 積	22.6720620	街区一画地	43-保14	
A=1/2 Σ Xn(Y(n+1)-Y(n-1))			地 積	22.67			

座 標 面 積 計 算 書

世界測地系（測地成果2011）

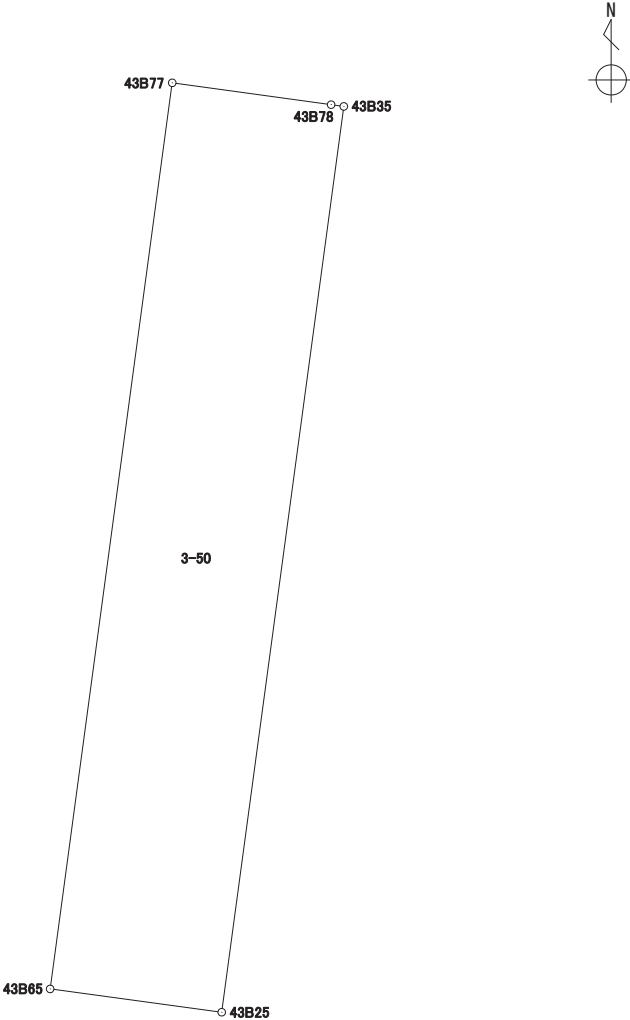
地 番 3-49

境 界 点	X	Y	辺長	方向角	備考		
43B79	43178.485	-67452.200	14.357	187° 43' 46″			
43B64	43164.258	-67454.131	5.322	277° 46' 26″			
43B25	43164.978	-67459.405	14.349	7° 40' 38″			
43B35	43179.199	-67457.488	1.704	97° 21' 01″			
43B36	43178.981	-67455.798	3.632	97° 50' 56″			
面積算出公式			面 積	76.5233900	街区一画地	43-14	
$A=1/2 \sum X_n(Y_{(n+1)}-Y_{(n-1)})$			地 積	76.52			

座 標 面 積 計 算 書

世界測地系（測地成果2011）

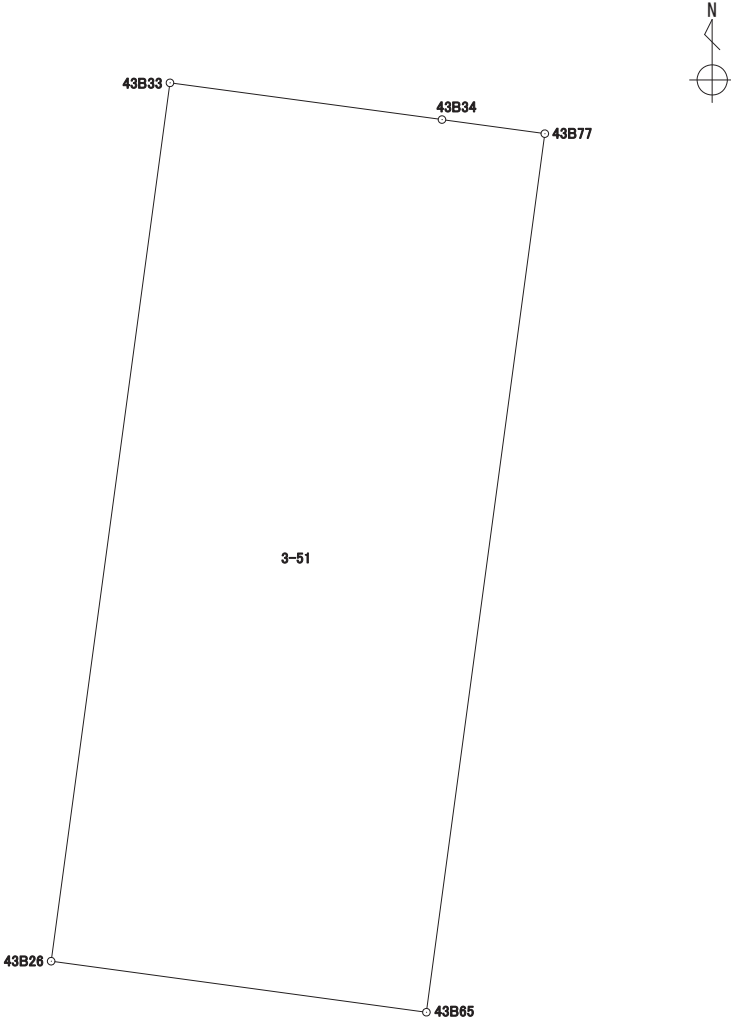
地番	3-50
----	------

境 界 点	X	Y	辺長	方向角	備考		
43B25	43164.978	-67459.405	2.718	277° 44' 12″			
43B65	43165.344	-67462.099	14.353	7° 40' 30″			
43B77	43179.569	-67460.182	2.518	97° 49' 40″			
43B78	43179.226	-67457.687	0.200	97° 43' 36″			
43B35	43179.199	-67457.488	14.349	187° 40' 38″			
面積算出公式			面 積	39.0217720	街区一画地	43-保8	
$A=1/2 \sum X_n(Y_{(n+1)}-Y_{(n-1)})$			地 積	39.02			

座 標 面 積 計 算 書

世界測地系（測地成果2011）

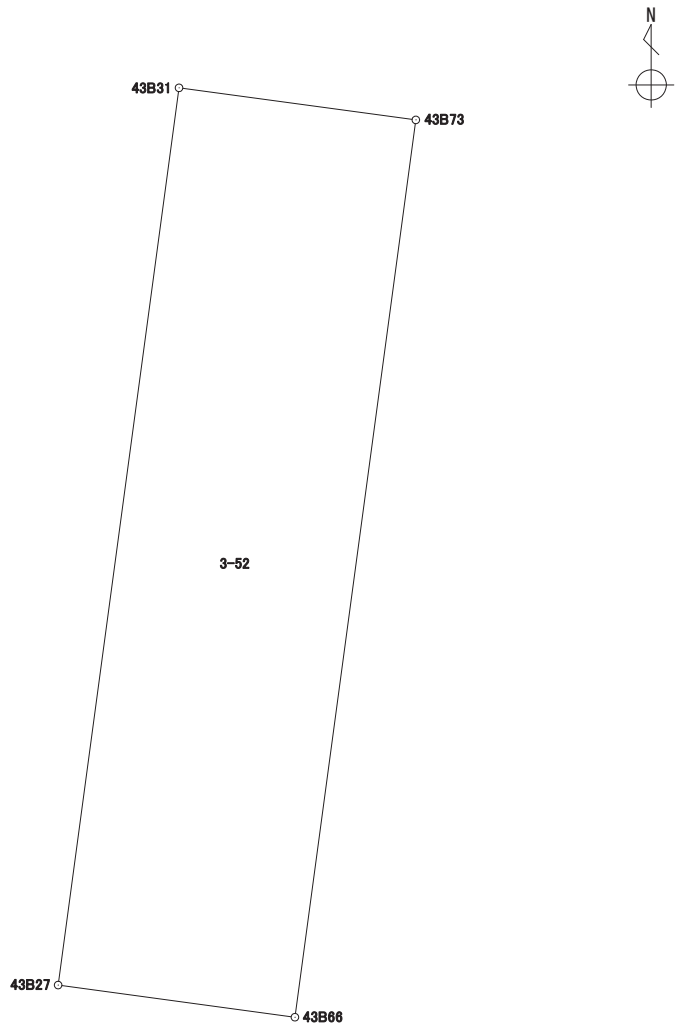
地番 3-51

境 界 点	X	Y	辺長	方向角	備考		
43B77	43179.569	-67460.182	14.353	187° 40' 30″			
43B65	43165.344	-67462.099	6.132	277° 44' 25″			
43B26	43166.170	-67468.176	14.351	7° 42' 16″			
43B33	43180.392	-67466.252	4.445	97° 41' 33″			
43B34	43179.797	-67461.847	1.680	97° 47' 51″			
面積算出公式			面 積	87.9767120	街区一画地	43-15	
$A=1/2 \sum X_n(Y_{(n+1)}-Y_{(n-1)})$			地 積	87.97			

座 標 面 積 計 算 書

世界測地系（測地成果2011）

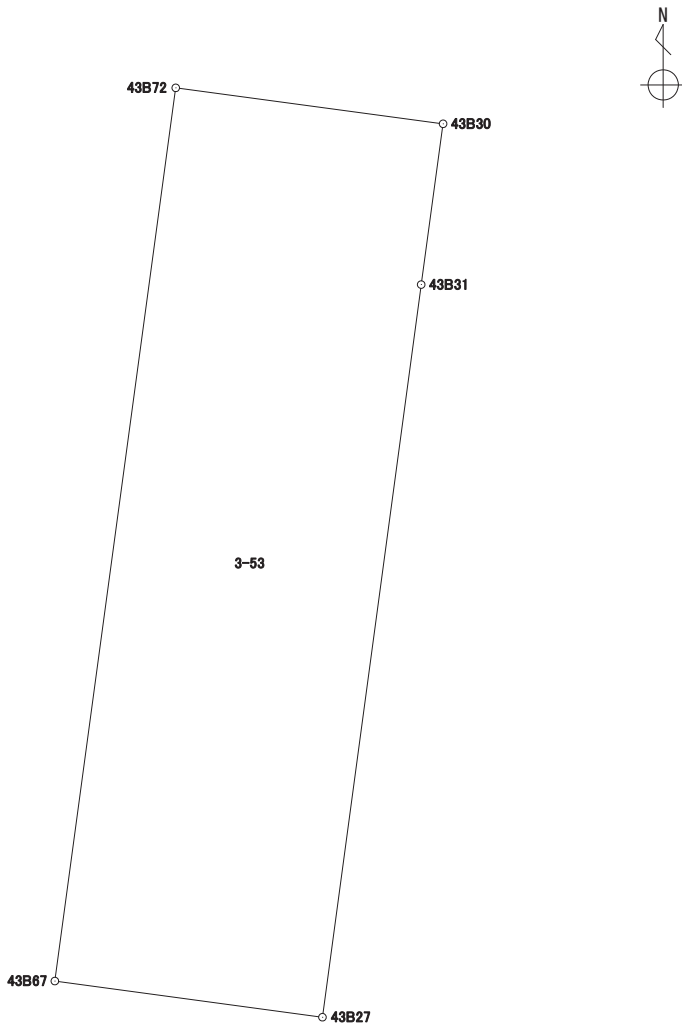
地番	3-52
----	------

境 界 点	X	Y	辺長	方向角	備考		
43B31	43181.018	-67495.489	2.913	97° 42' 46″			
43B73	43180.627	-67492.602	11.036	187° 40' 30″			
43B66	43169.689	-67494.076	2.913	277° 43' 57″			
43B27	43170.081	-67496.963	11.035	7° 40' 32″			
面積算出公式			面 積	32.1536335	街区一画地	43-保11	
A=1/2 Σ Xn(Y(n+1)-Y(n-1))			地 積	32.15			

座 標 面 積 計 算 書

世界測地系（測地成果2011）

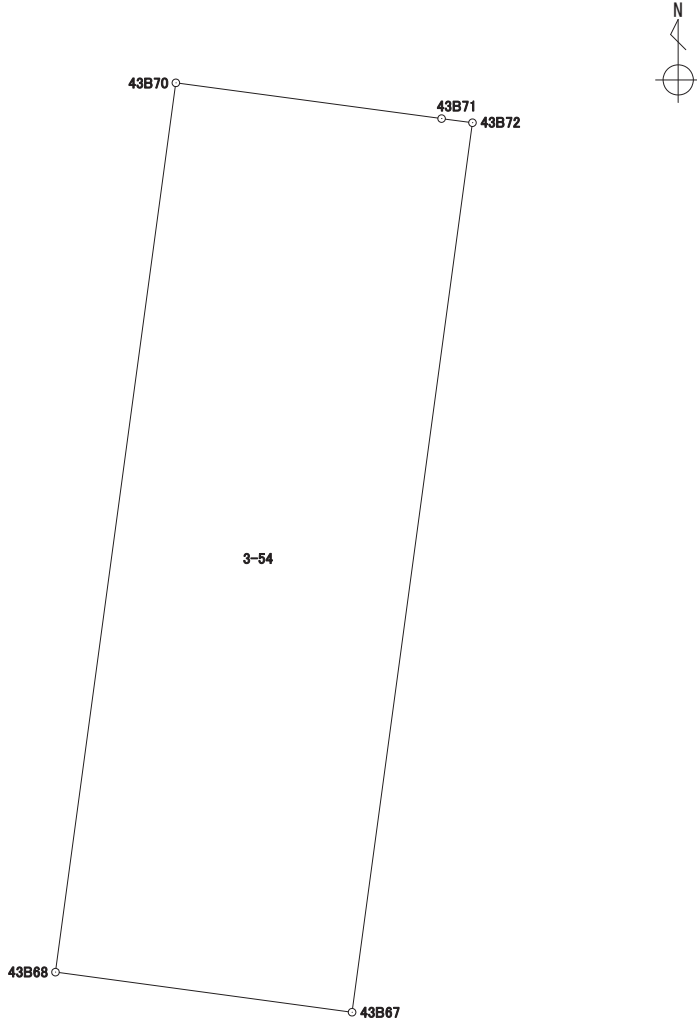
地番	3-53
----	------

境 界 点	X	Y	辺長	方向角	備考		
43B27	43170.081	-67496.963	4.032	277° 41' 46″			
43B67	43170.621	-67500.959	13.455	7° 42' 33″			
43B72	43183.955	-67499.154	4.027	97° 39' 41″			
43B30	43183.418	-67495.162	2.422	187° 45' 32″			
43B31	43181.018	-67495.489	11.035	187° 40' 32″			
面積算出公式			面 積	54.2135030	街区一画地	43-保19	
$A=1/2 \sum X_n(Y_{(n+1)}-Y_{(n-1)})$			地 積	54.21			

座 標 面 積 計 算 書

世界測地系（測地成果2011）

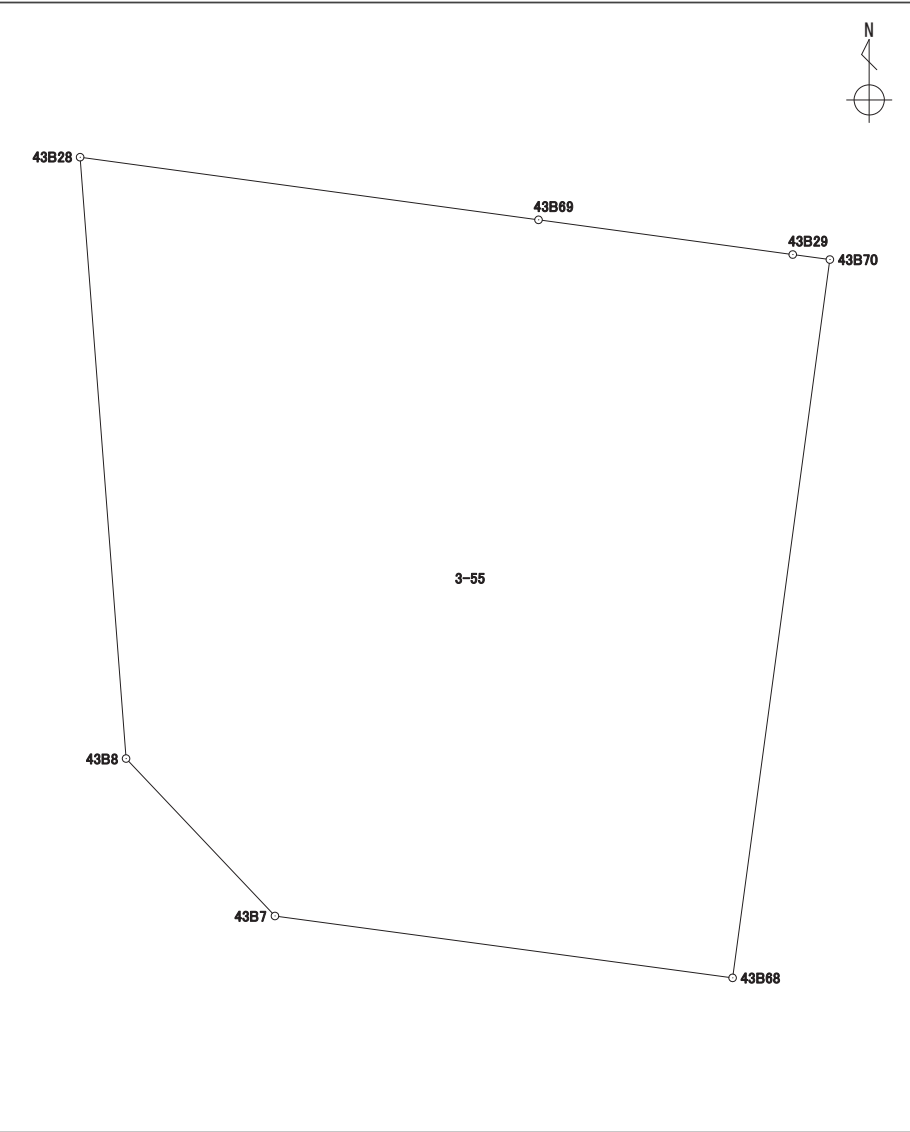
地番 3-54

境 界 点	X	Y	辺長	方向角	備考		
43B67	43170.621	-67500.959	4.487	277° 41' 48″			
43B68	43171.222	-67505.406	13.452	7° 42' 39″			
43B70	43184.553	-67503.601	4.019	97° 39' 45″			
43B71	43184.017	-67499.617	0.467	97° 37' 37″			
43B72	43183.955	-67499.154	13.455	187° 42' 33″			
面積算出公式			面 積	60.3711450	街区一画地	43-保12	
A=1/2 Σ Xn(Y(n+1)-Y(n-1))			地 積	60.37			

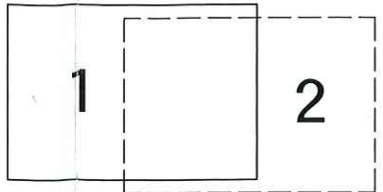
座 標 面 積 計 算 書

世界測地系（測地成果2011）

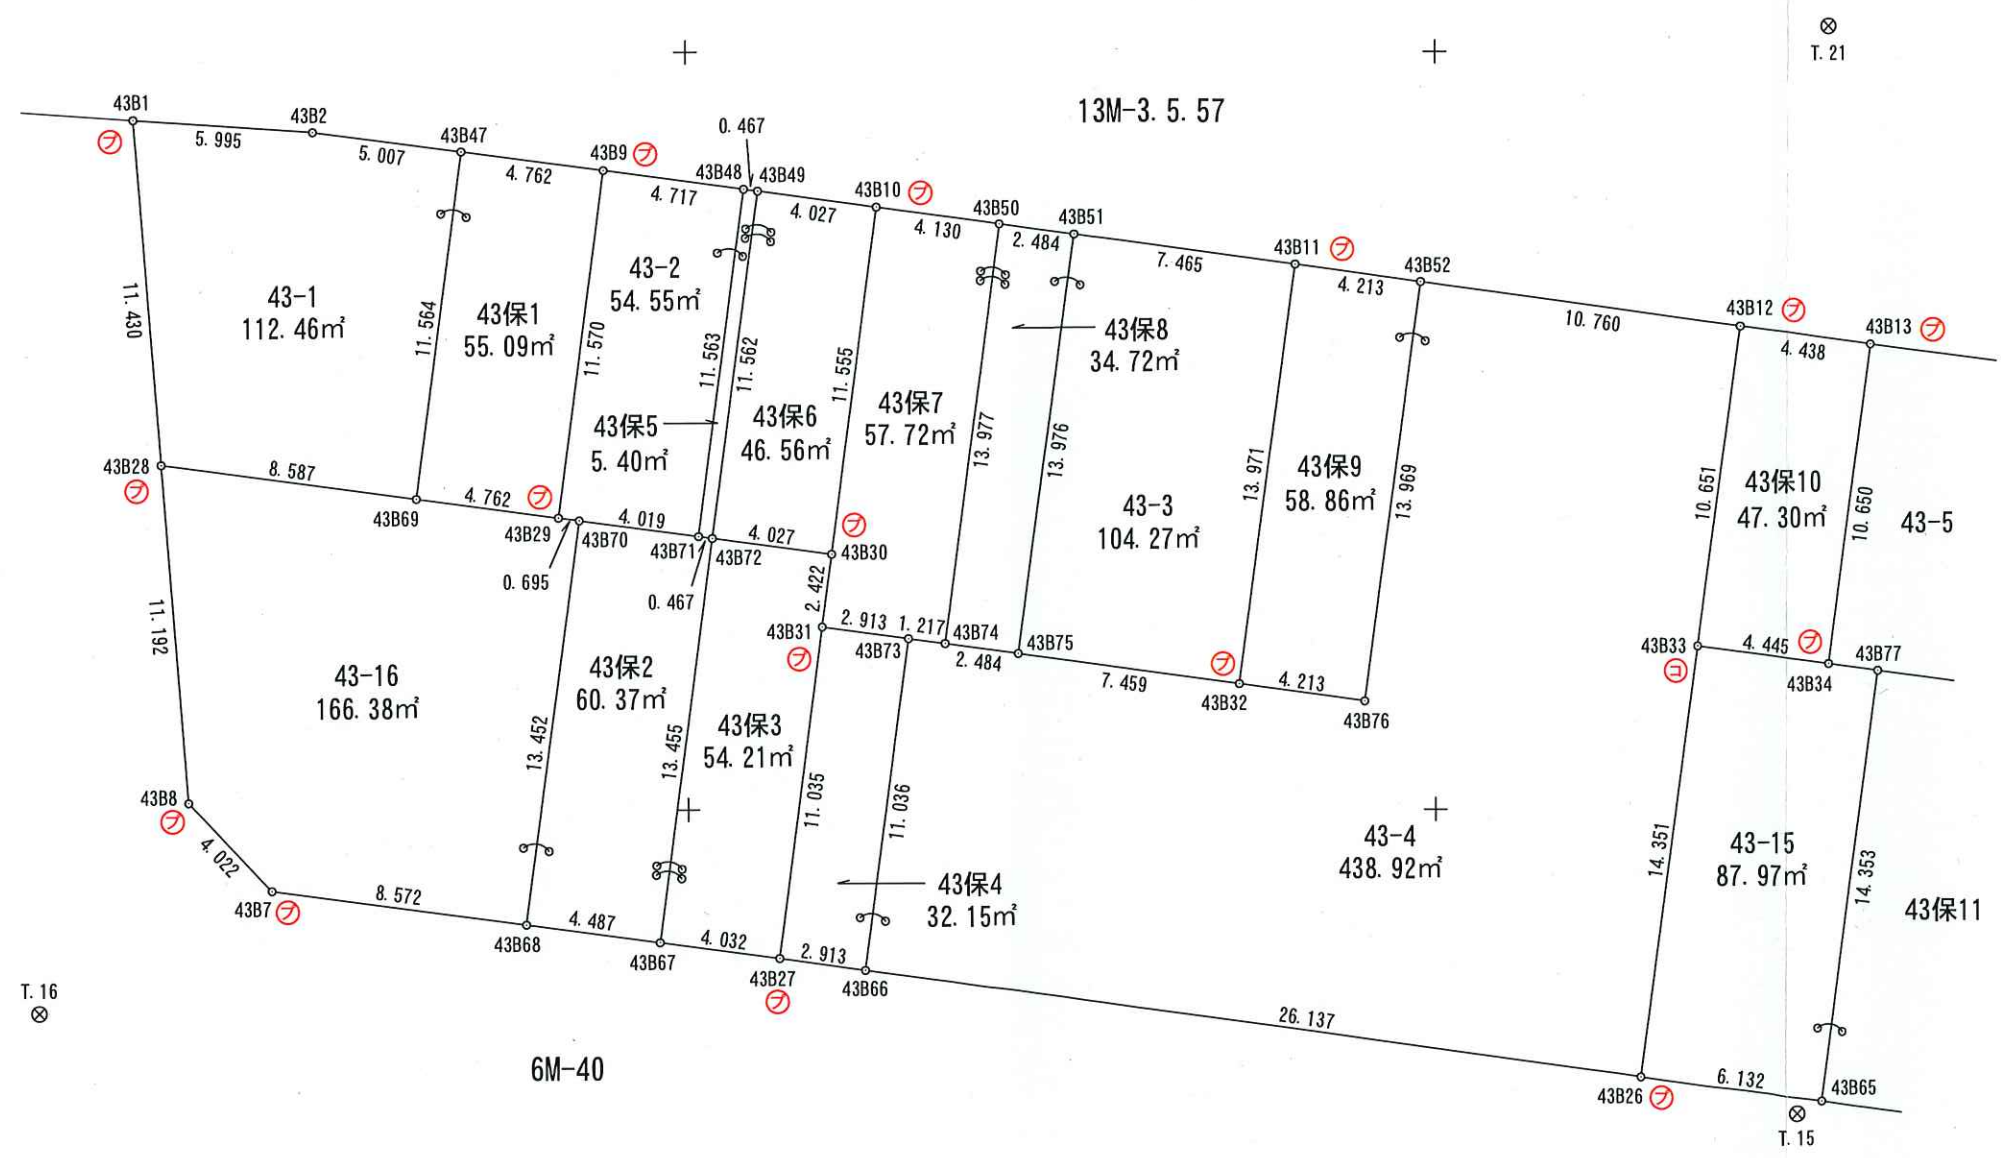
地 番 3-55

境 界 点	X	Y	辺長	方向角	備考		
43B70	43184.553	-67503.601	13.452	187° 42' 39"			
43B68	43171.222	-67505.406	8.572	277° 41' 46"			
43B7	43172.370	-67513.901	4.022	316° 35' 30"			
43B8	43175.292	-67516.665	11.192	355° 37' 45"			
43B28	43186.452	-67517.518	8.587	97° 46' 35"			
43B69	43185.290	-67509.009	4.762	97° 46' 16"			
43B29	43184.646	-67504.290	0.695	97° 41' 14"			
面積算出公式			面 積	166.3827290	街区一画地	43-16	
$A=1/2 \sum X_n(Y_{n+1}-Y_{n-1})$			地 積	166.38			

4 3 街 区 出 来 形 確 認 図 (2 6 3 1 . 5 1 m²)



S=1:250



凡 例	
⊕	合 成 杭
⊖	金 属 杭
⊙	コンクリート杭
⊕	刻 み
⊖	プ レ ー ト
⊗	基 準 点
○	計 算 点

4 3 街区 出来形確認図 (2631.51m²)

X=43200

X=43175

X=43150

Y=-67475

Y=-67450

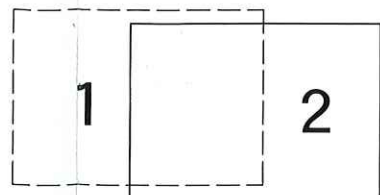
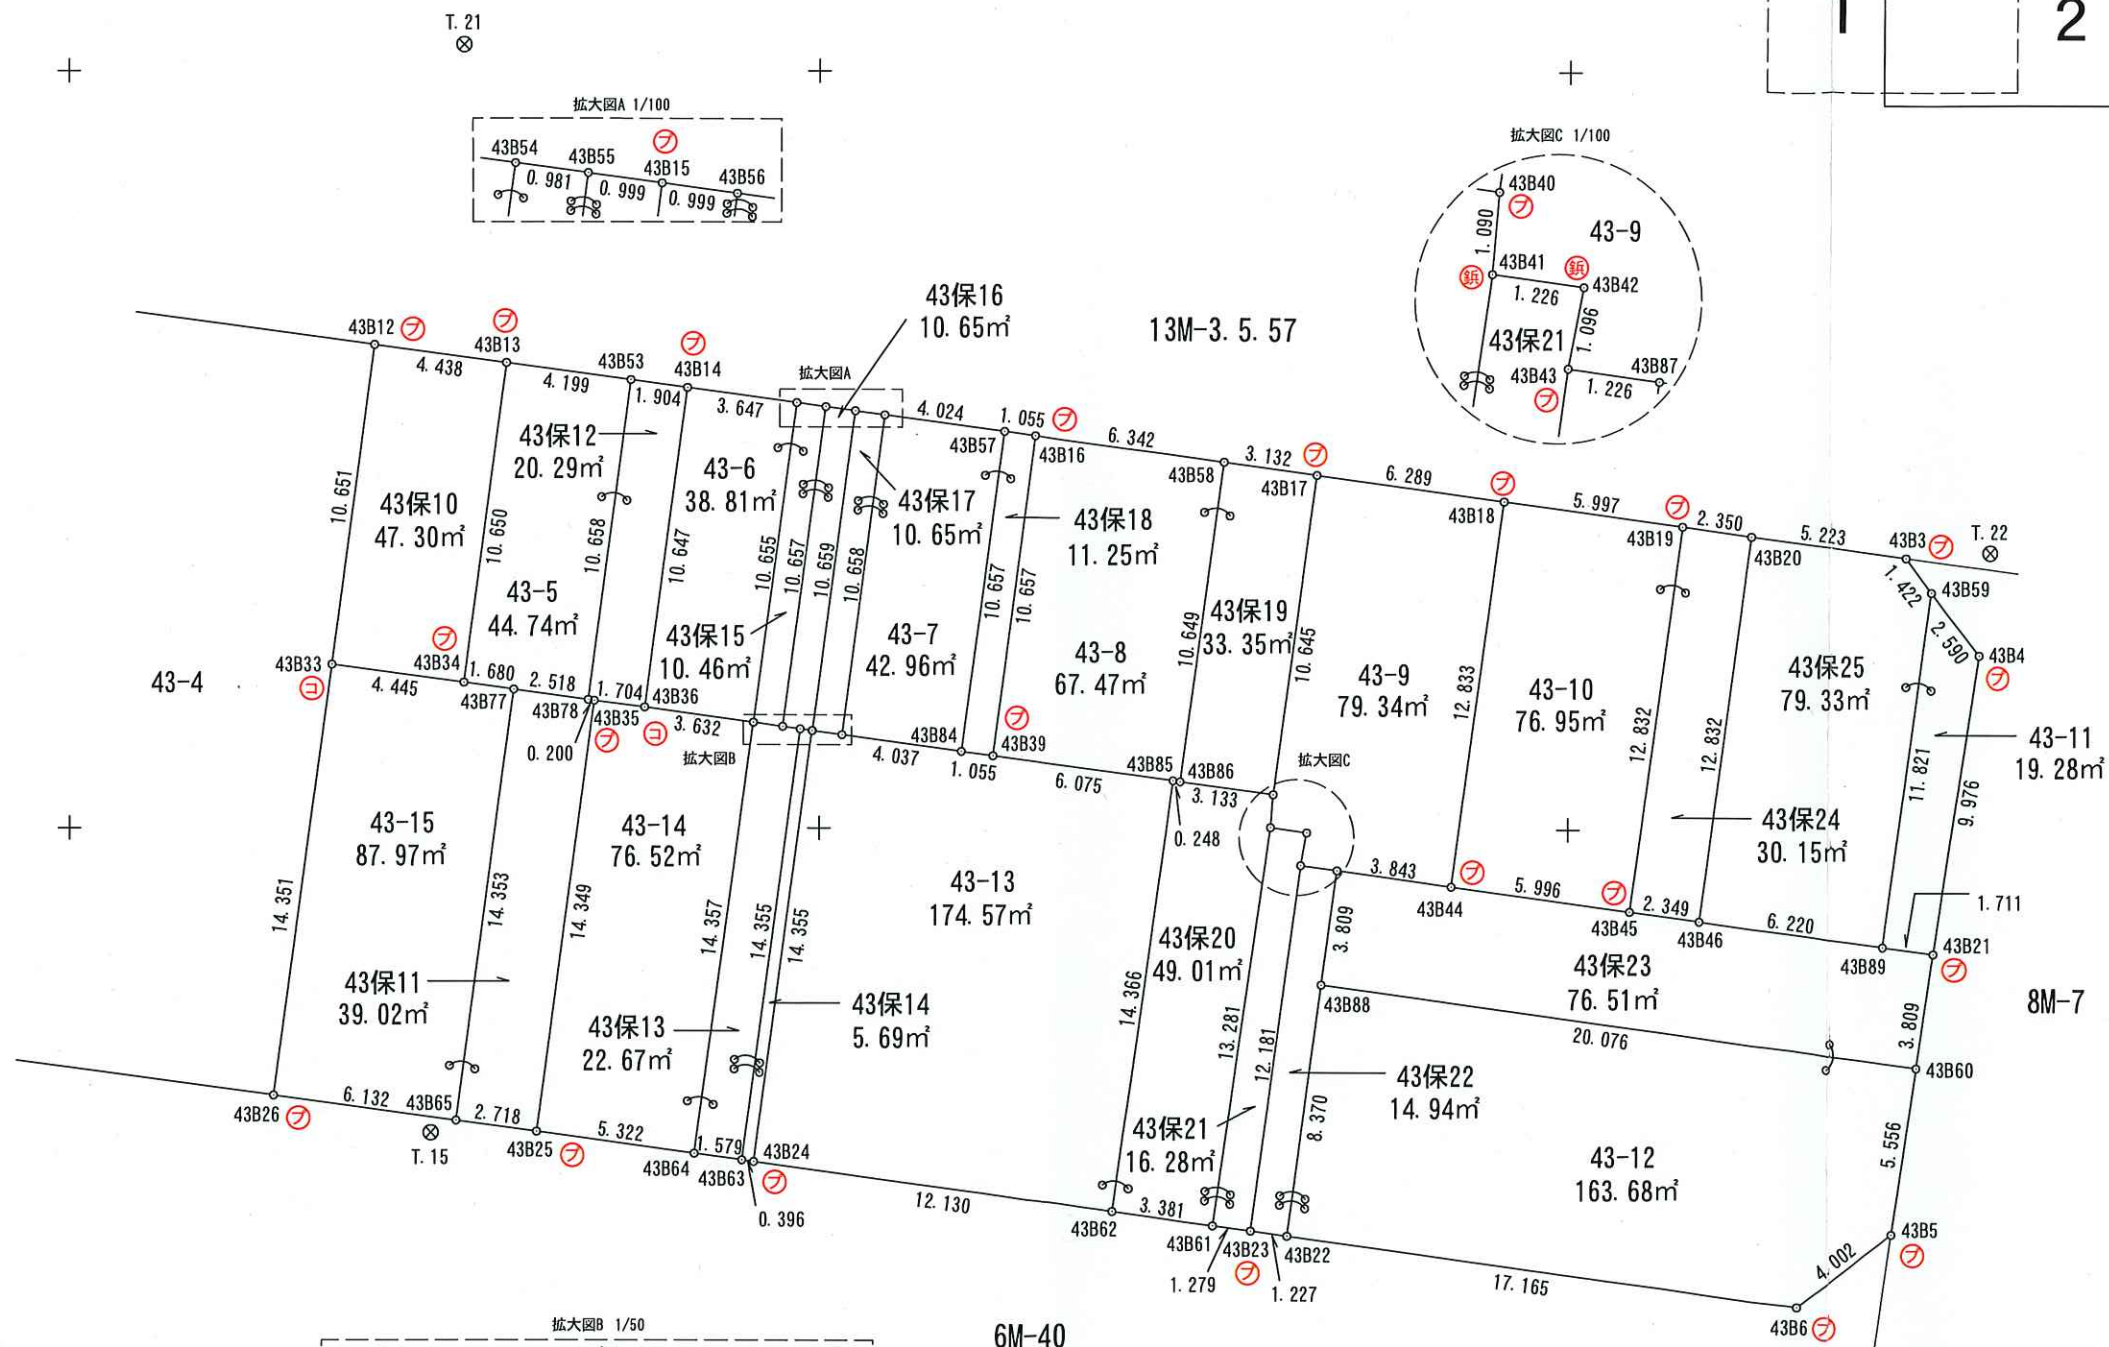
Y=-67425

Y=-67400

X=43200

X=43175

X=43150



S=1:250

凡 例	
合	合 成 杭
鉄	金 属 鉄
コ	コンクリート杭
キ	刻 み
フ	プ レ ー ト
⊗	基 準 点
○	計 算 点