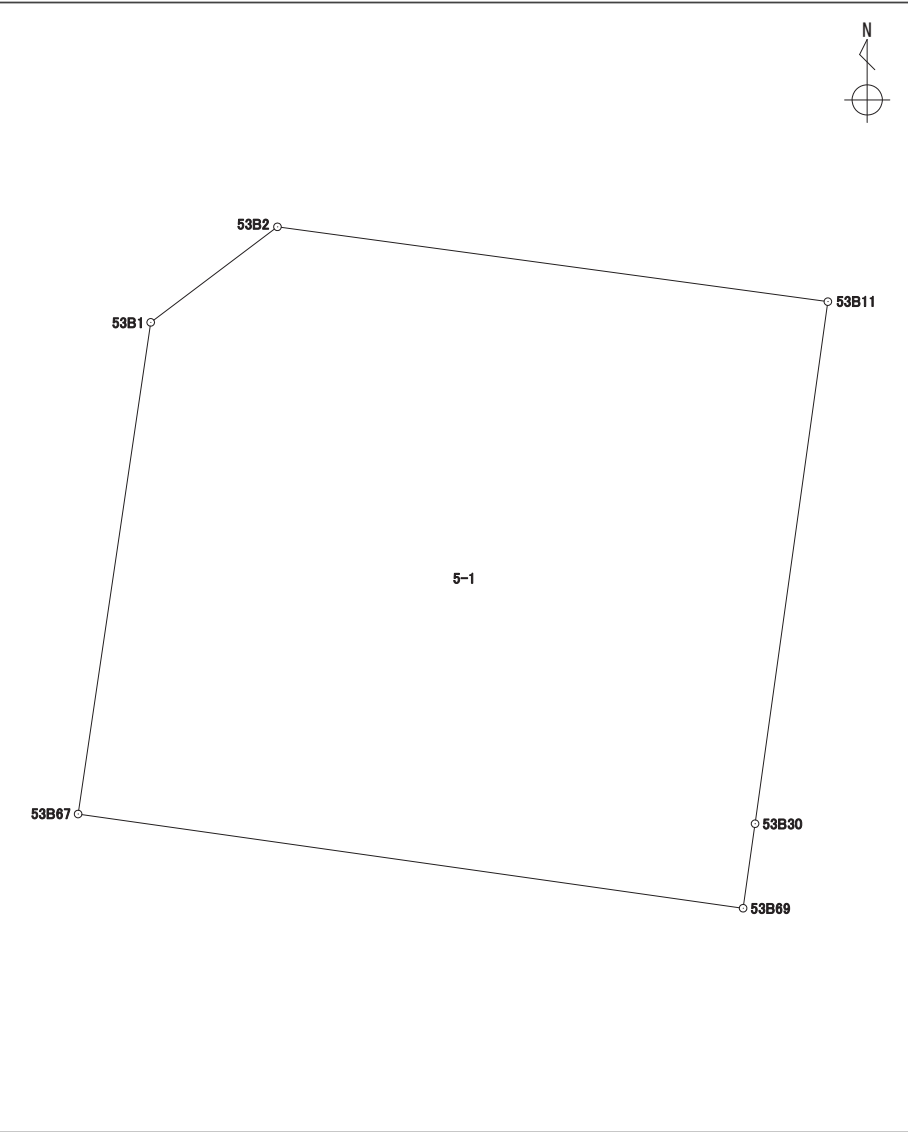


座 標 面 積 計 算 書

世界測地系（測地成果2011）

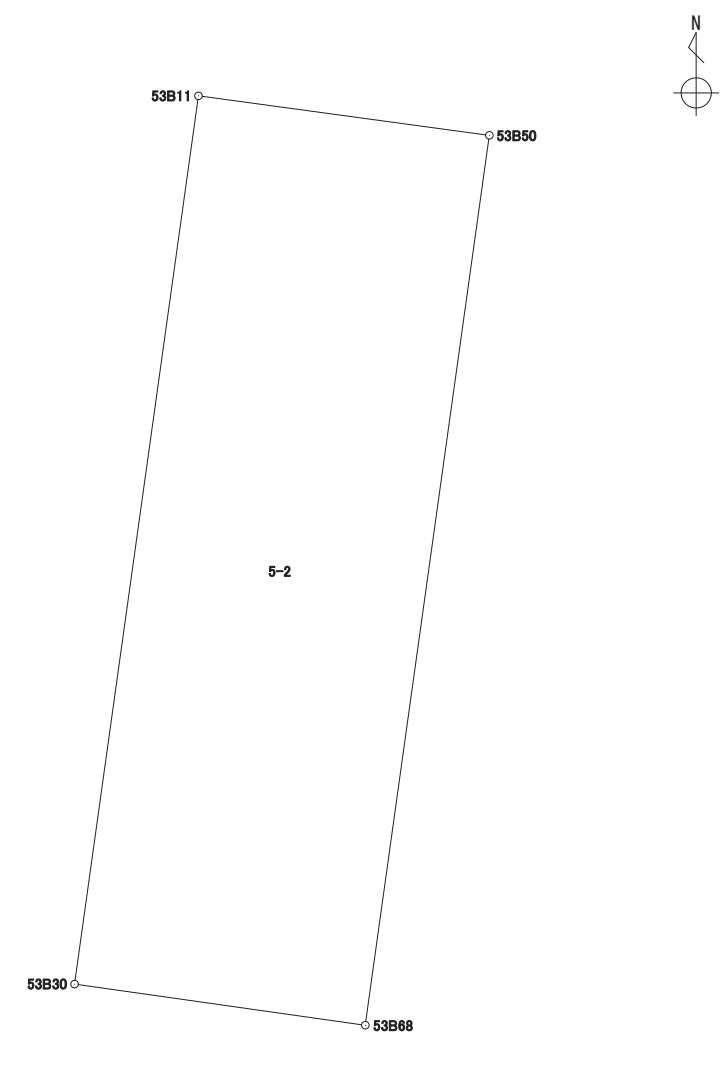
地番	5-1
----	-----

境 界 点	X	Y	辺長	方向角	備考		
53B69	43134.289	-67392.925	16.956	278° 03' 42″			
53B67	43136.667	-67409.714	12.544	8° 24' 07″			
53B1	43149.077	-67407.881	4.006	53° 00' 15″			
53B2	43151.488	-67404.681	14.022	97° 44' 16″			
53B11	43149.600	-67390.786	13.305	187° 56' 24″			
53B30	43136.422	-67392.624	2.154	188° 01' 56″			
面積算出公式			面 積	256.4608905	街区一画地	53-1	
$A=1/2 \sum X_n(Y_{(n+1)}-Y_{(n-1)})$			地 積	256.46			

座 標 面 積 計 算 書

世界測地系（測地成果2011）

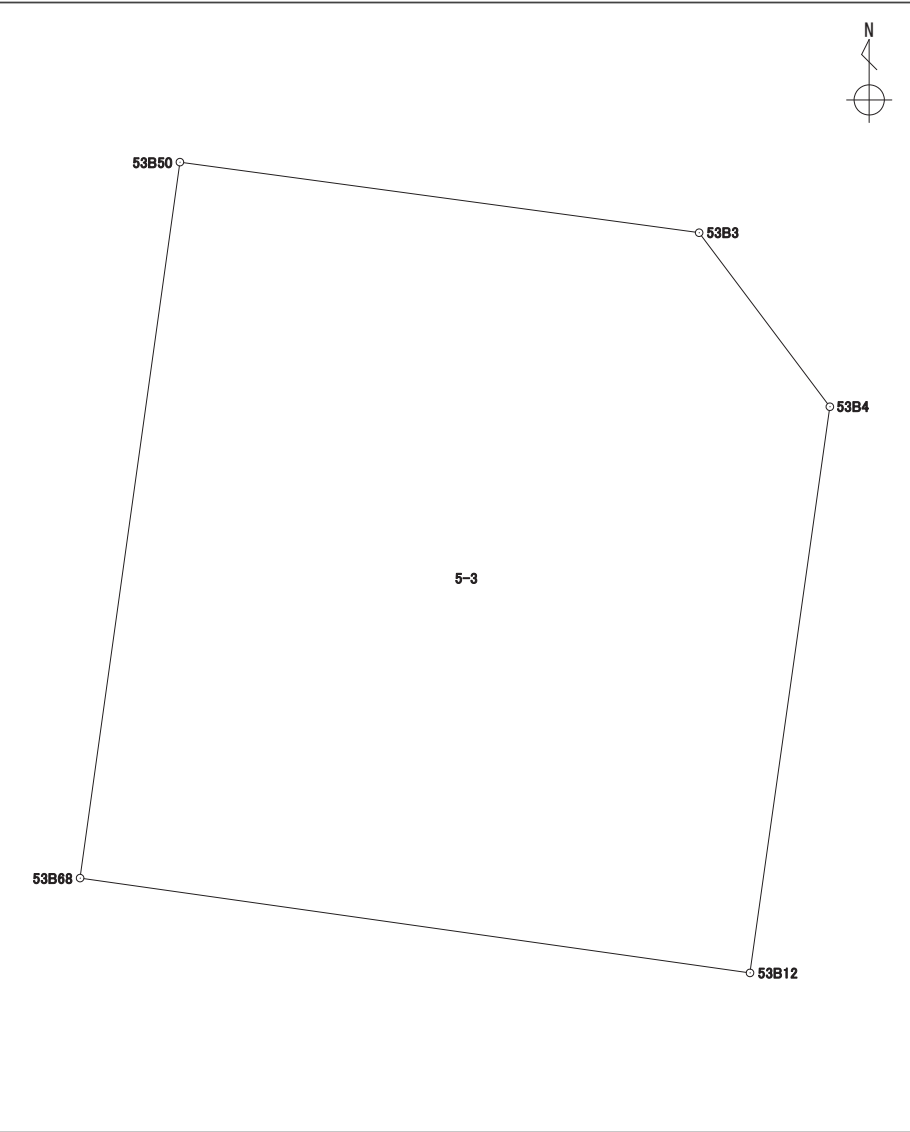
地番	5-2
----	-----

境 界 点	X	Y	辺長	方向角	備考		
53B11	43149.600	-67390.786	4.356	97° 43' 49"			
53B50	43149.014	-67386.469	13.329	187° 56' 19"			
53B68	43135.812	-67388.310	4.356	278° 02' 54"			
53B30	43136.422	-67392.624	13.305	7° 56' 24"			
面積算出公式			面 積	58.0214660	街区一画地	53-保7	
$A=1/2 \sum X_n(Y_{(n+1)}-Y_{(n-1)})$			地 積	58.02			

座 標 面 積 計 算 書

世界測地系（測地成果2011）

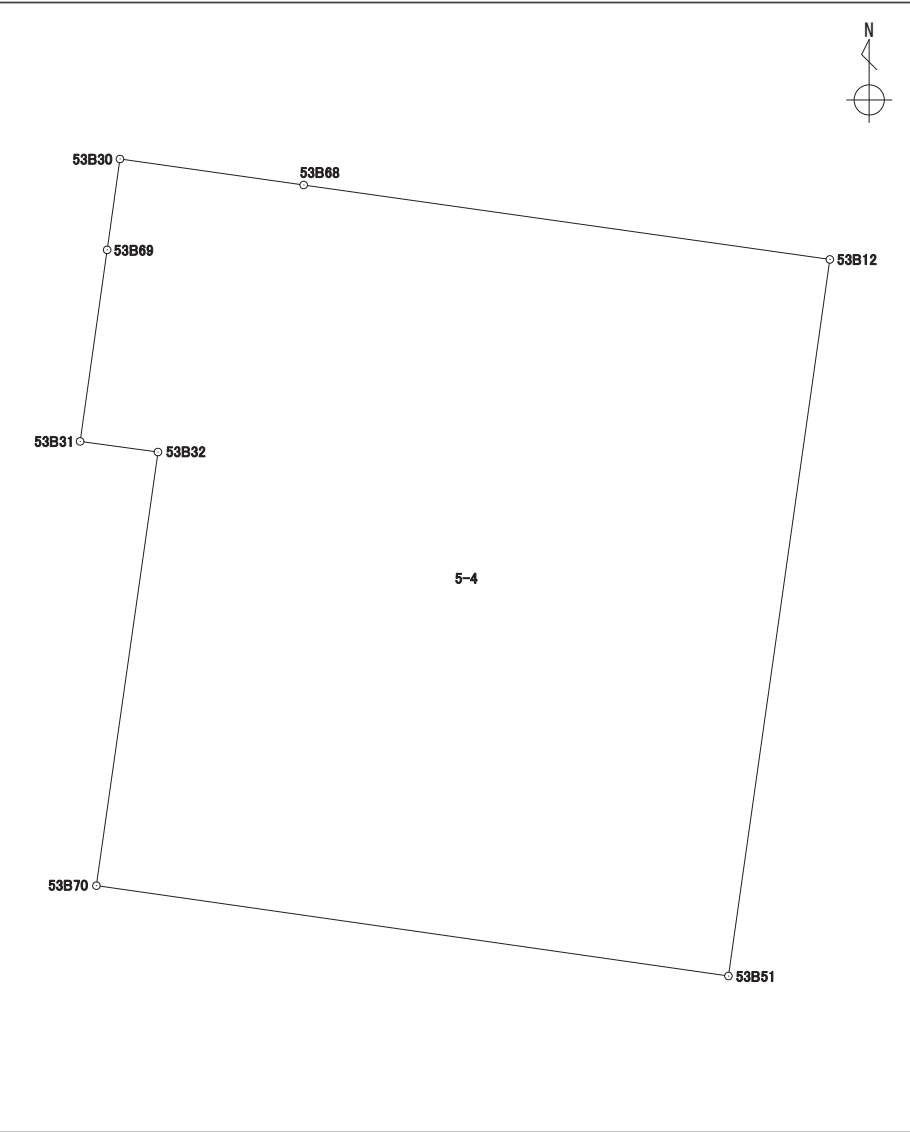
地番	5-3
----	-----

境 界 点	X	Y	辺長	方向角	備考		
53B68	43135.812	-67388.310	13.329	7° 56' 19"			
53B50	43149.014	-67386.469	9.663	97° 44' 13"			
53B3	43147.713	-67376.893	4.013	143° 04' 54"			
53B4	43144.504	-67374.482	10.543	188° 01' 51"			
53B12	43134.064	-67375.955	12.478	278° 03' 10"			
面積算出公式			面 積	162.8544805	街区一画地	53-2	
$A=1/2 \sum X_n(Y_{(n+1)}-Y_{(n-1)})$			地 積	162.85			

座 標 面 積 計 算 書

世界測地系（測地成果2011）

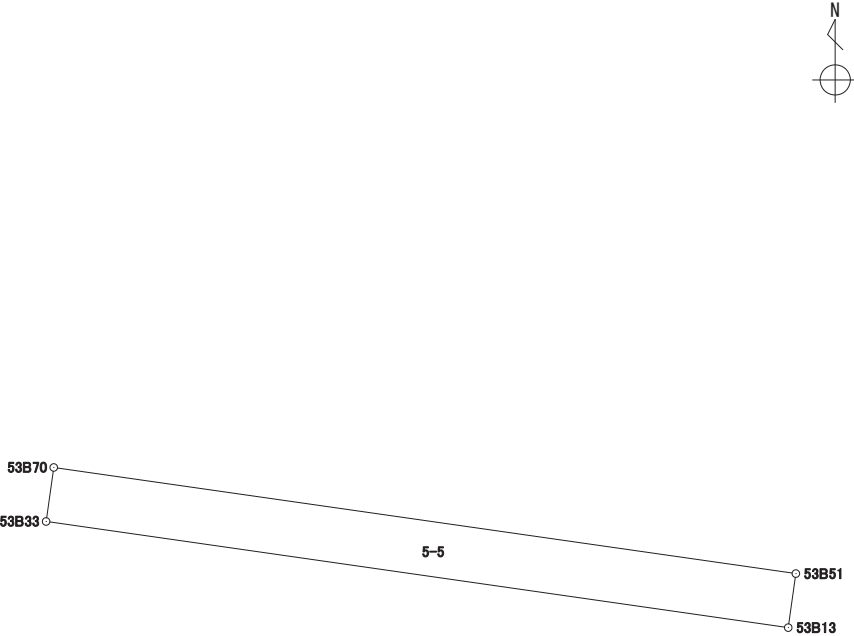
地 番	5-4
-----	-----

境 界 点	X	Y	辺長	方向角	備考		
53B51	43117.241	-67378.337	14.990	278° 08' 16"			
53B70	43119.363	-67393.177	10.282	8° 05' 04"			
53B32	43129.543	-67391.731	1.846	277° 47' 00"			
53B31	43129.793	-67393.560	4.540	8° 02' 21"			
53B69	43134.289	-67392.925	2.154	8° 01' 56"			
53B30	43136.422	-67392.624	4.356	98° 02' 54"			
53B68	43135.812	-67388.310	12.478	98° 03' 10"			
53B12	43134.064	-67375.955	16.990	188° 03' 33"			
面積算出公式			面 積	266.8460995	街区一画地	53-3	
$A=1/2 \sum X_n(Y_{(n+1)}-Y_{(n-1)})$			地 積	266.84			

座 標 面 積 計 算 書

世界測地系（測地成果2011）

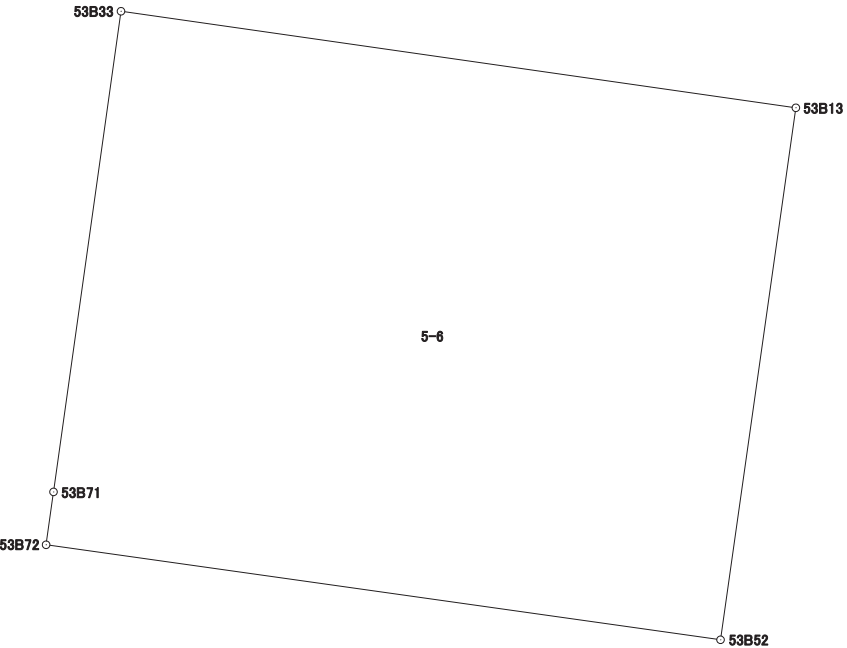
地番	5-5
----	-----

境界点	X	Y	辺長	方向角	備考	N 	
53B33	43118.283	-67393.330	1.090	8° 03' 48"			
53B70	43119.363	-67393.177	14.990	98° 08' 16"			
53B51	43117.241	-67378.337	1.090	188° 00' 40"			
53B13	43116.161	-67378.489	14.991	278° 08' 14"			
面積算出公式			面 積	16.3513450	街区一画地	53-保24	
$A=1/2 \sum X_n(Y_{n+1}-Y_{n-1})$			地 積	16.35			

座 標 面 積 計 算 書

世界測地系（測地成果2011）

地番	5-6
----	-----

境 界 点	X	Y	辺長	方向角	備考	N  	
53B52	43104.464	-67380.145	14.978	278° 01' 01"			
53B72	43106.553	-67394.977	1.173	7° 59' 06"			
53B71	43107.715	-67394.814	10.671	7° 59' 36"			
53B33	43118.283	-67393.330	14.991	98° 08' 14"			
53B13	43116.161	-67378.489	11.813	188° 03' 29"			
面積算出公式			面 積	177.2654880	街区一画地	53-4	
A=1/2 Σ Xn(Y(n+1)-Y(n-1))			地 積	177.26			

座標面積計算書

世界測地系 (測地成果2011)

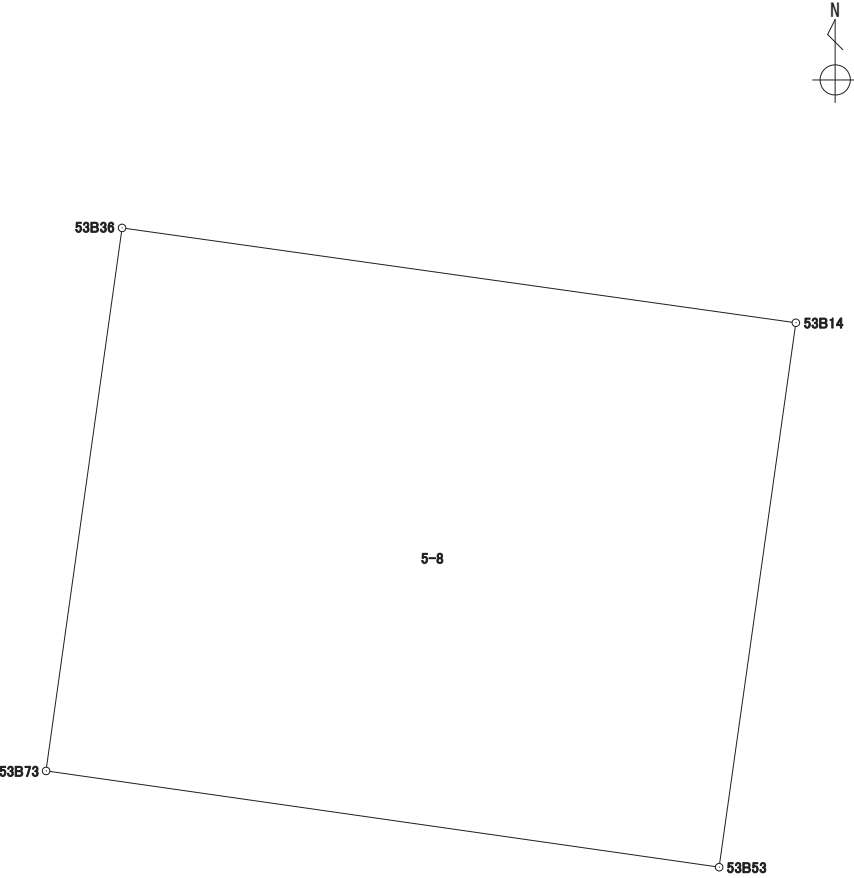
地番	5-7
----	-----

[illegible]

座 標 面 積 計 算 書

世界測地系（測地成果2011）

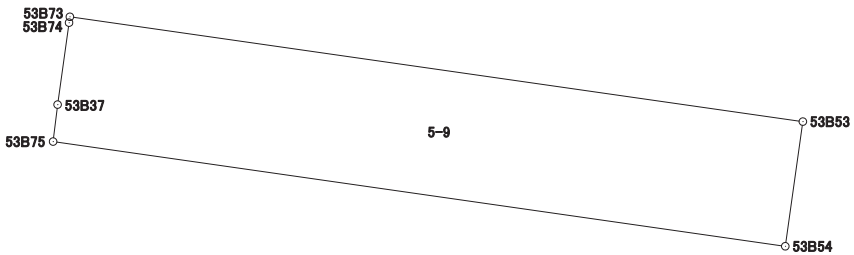
地 番 5-8

境 界 点	X	Y	辺長	方向角	備考	N 	
53B53	43091.703	-67381.945	12.491	278° 08' 12″			
53B73	43093.471	-67394.311	10.072	7° 58' 00″			
53B36	43103.446	-67392.915	12.501	98° 00' 53″			
53B14	43101.703	-67380.536	10.098	188° 01' 13″			
面積算出公式			面 積	126.0324325	街区一画地	53-5	
A=1/2 Σ Xn(Y(n+1)-Y(n-1))			地 積	126.03			

座 標 面 積 計 算 書

世界測地系（測地成果2011）

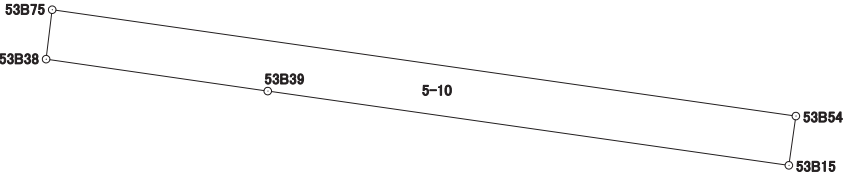
地番	5-9
----	-----

境 界 点	X	Y	辺長	方向角	備考	N 	
53B54	43089.600	-67382.241	12.478	278° 08' 09"			
53B75	43091.366	-67394.594	0.628	6° 56' 39"			
53B37	43091.990	-67394.518	1.395	7° 57' 00"			
53B74	43093.372	-67394.325	0.099	8° 02' 57"			
53B73	43093.471	-67394.311	12.491	98° 08' 12"			
53B53	43091.703	-67381.945	2.123	188° 00' 43"			
面積算出公式			面 積	26.5243610	街区一画地	53-保11	
$A=1/2 \sum X_n(Y_{(n+1)}-Y_{(n-1)})$			地 積	26.52			

座 標 面 積 計 算 書

世界測地系（測地成果2011）

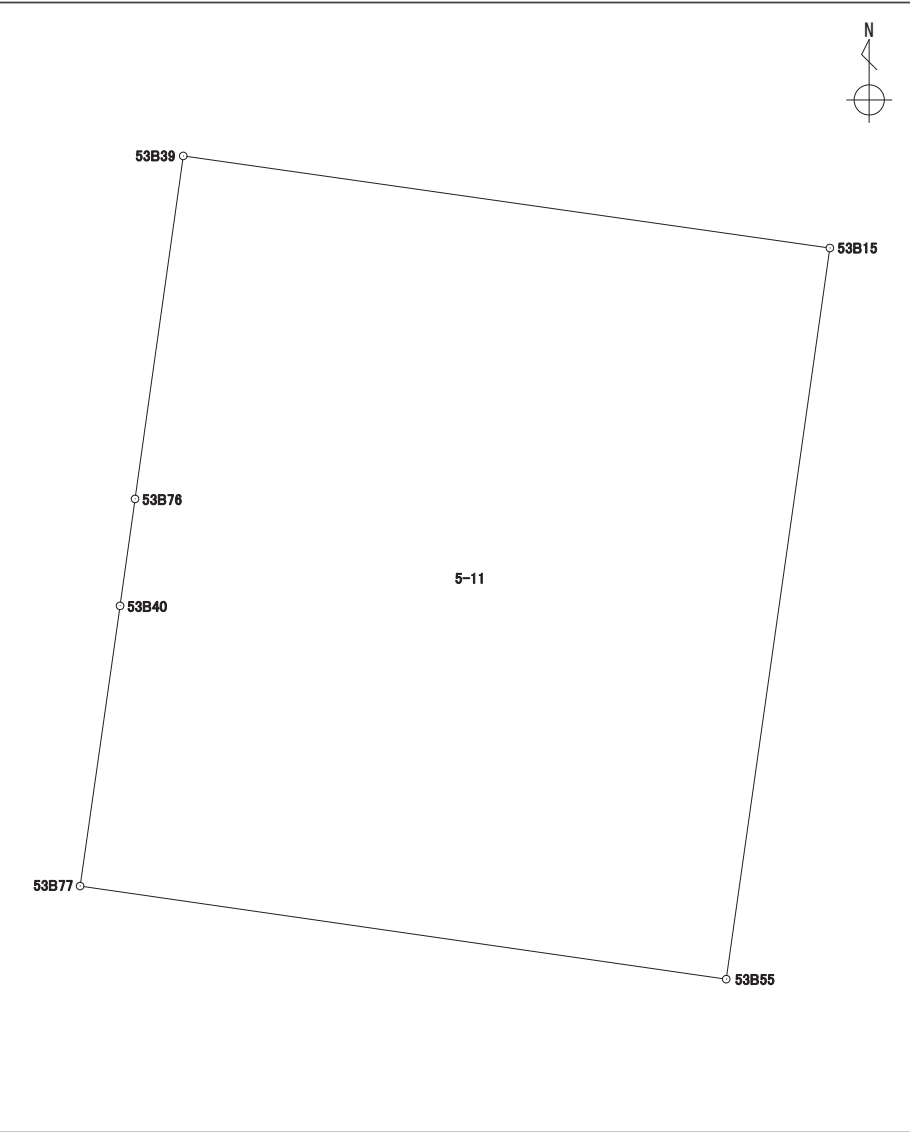
地番	5-10
----	------

境界点	X	Y	辺長	方向角	備考	N 	
53B39	43090.015	-67391.013	3.719	278° 11' 28"			
53B38	43090.545	-67394.695	0.827	7° 00' 48"			
53B75	43091.366	-67394.594	12.478	98° 08' 09"			
53B54	43089.600	-67382.241	0.826	188° 04' 17"			
53B15	43088.782	-67382.357	8.743	278° 06' 25"			
面積算出公式			面 積	10.3324725	街区一画地	53-保12	
$A=1/2 \sum X_n(Y_{n+1}-Y_{n-1})$			地 積	10.33			

座 標 面 積 計 算 書

世界測地系（測地成果2011）

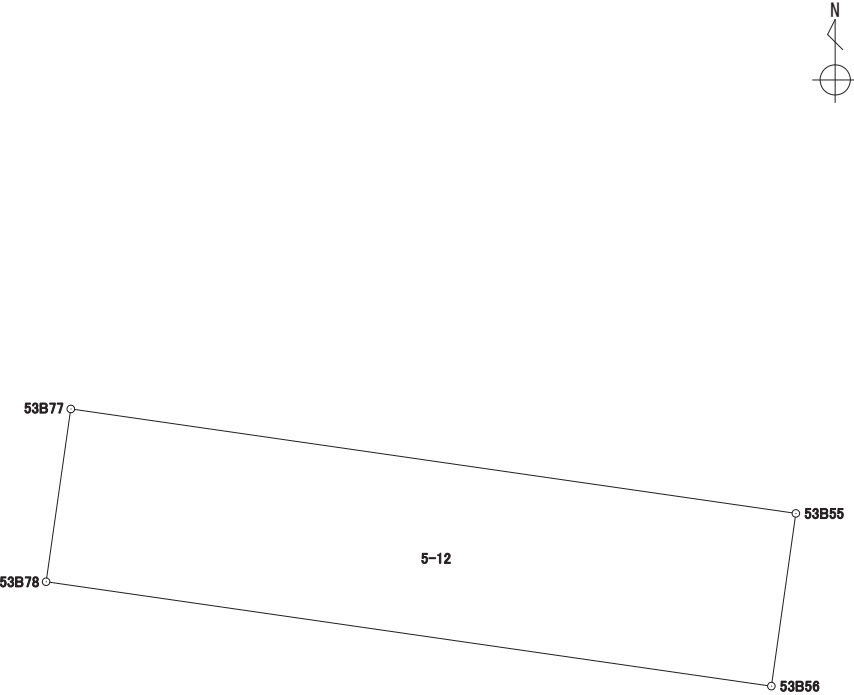
地番 5-11

境 界 点	X	Y	辺長	方向角	備考		
53B55	43078.996	-67383.744	8.739	278° 11' 49"			
53B77	43080.242	-67392.394	3.788	8° 07' 02"			
53B40	43083.993	-67391.859	1.445	7° 59' 44"			
53B76	43085.424	-67391.658	4.636	7° 59' 50"			
53B39	43090.015	-67391.013	8.743	98° 06' 25"			
53B15	43088.782	-67382.357	9.883	188° 04' 01"			
面積算出公式			面 積	86.3133715	街区一画地	53-6	
$A=1/2 \sum X_n(Y_{(n+1)}-Y_{(n-1)})$			地 積	86.31			

座 標 面 積 計 算 書

世界測地系（測地成果2011）

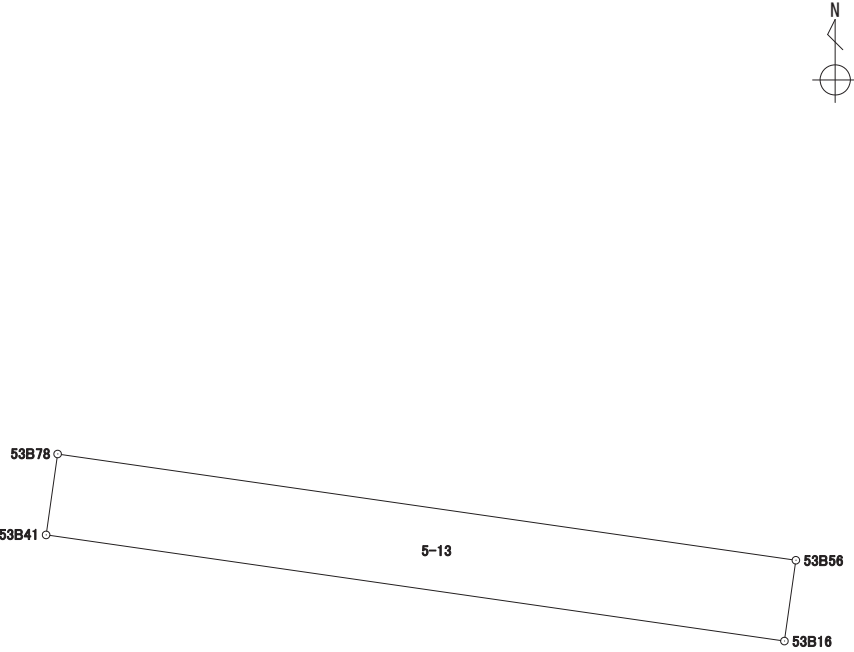
地番	5-12
----	------

境界点	X	Y	辺長	方向角	備考	N 	
53B56	43076.936	-67384.036	8.742	278° 11' 15"			
53B78	43078.181	-67392.689	2.082	8° 08' 44"			
53B77	43080.242	-67392.394	8.739	98° 11' 49"			
53B55	43078.996	-67383.744	2.080	188° 04' 04"			
面積算出公式			面 積	18.1919700	街区一画地	53-保13	
$A=1/2 \sum X_n(Y_{(n+1)}-Y_{(n-1)})$			地 積	18.19			

座 標 面 積 計 算 書

世界測地系（測地成果2011）

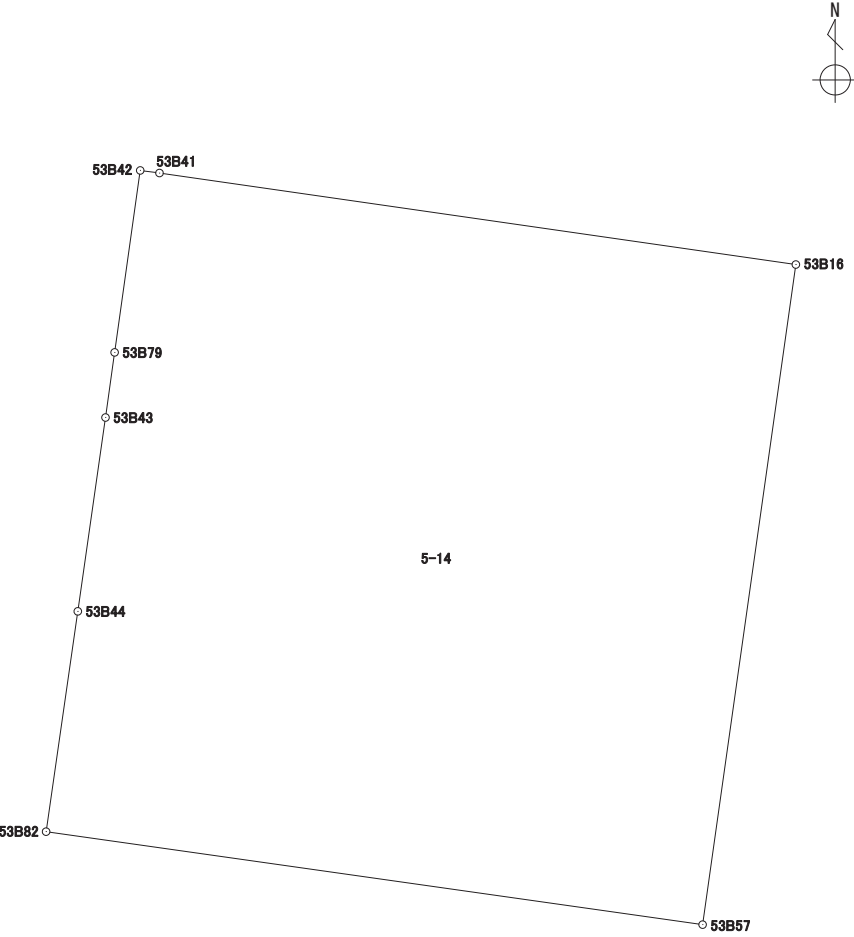
地番	5-13
----	------

境界点	X	Y	辺長	方向角	備考	N 	
53B78	43078.181	-67392.689	8.742	98° 11' 15"			
53B56	43076.936	-67384.036	0.956	188° 03' 14"			
53B16	43075.989	-67384.170	8.742	278° 10' 49"			
53B41	43077.233	-67392.824	0.957	8° 06' 17"			
面積算出公式			面 積	8.3665765	街区一画地	53-保14	
$A=1/2 \sum X_n(Y_{n+1}-Y_{n-1})$			地 積	8.36			

座標面積計算書

世界測地系（測地成果2011）

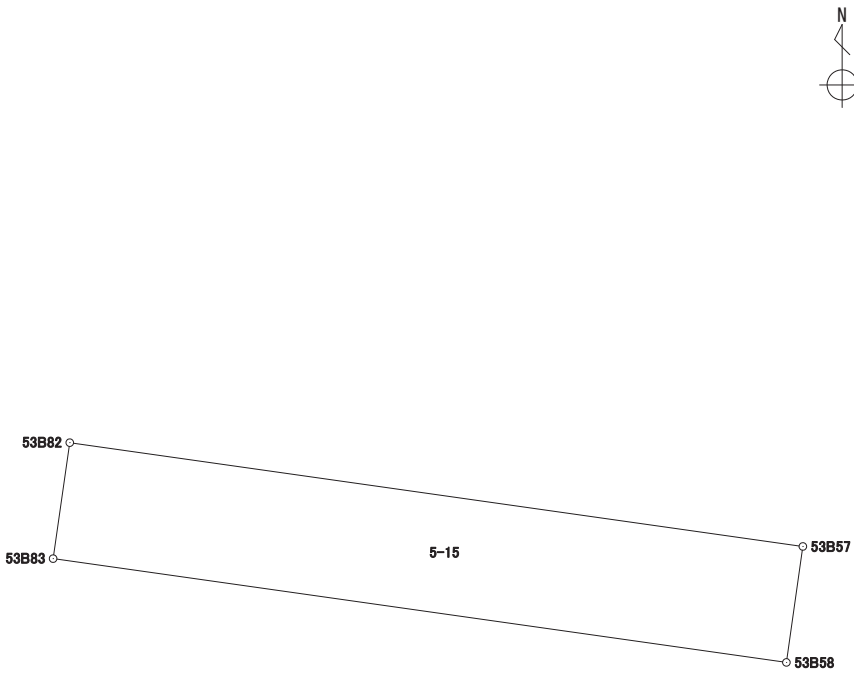
地番	5-14
----	------

境界点	X	Y	辺長	方向角	備考		
53B57	43067.014	-67385.438	9.017	278° 03' 30″			
53B82	43068.278	-67394.366	3.025	8° 11' 20″			
53B44	43071.273	-67393.935	2.662	8° 08' 21″			
53B43	43073.909	-67393.558	0.893	7° 58' 33″			
53B79	43074.794	-67393.434	2.498	8° 00' 25″			
53B42	43077.268	-67393.086	0.264	97° 36' 32″			
53B41	43077.233	-67392.824	8.742	98° 10' 49″			
53B16	43075.989	-67384.170	9.064	188° 02' 30″			
面積算出公式			面積	81.7422565	街区一画地	53-7	
$A=1/2 \sum X_n(Y_{(n+1)}-Y_{(n-1)})$			地積	81.74			

座 標 面 積 計 算 書

世界測地系（測地成果2011）

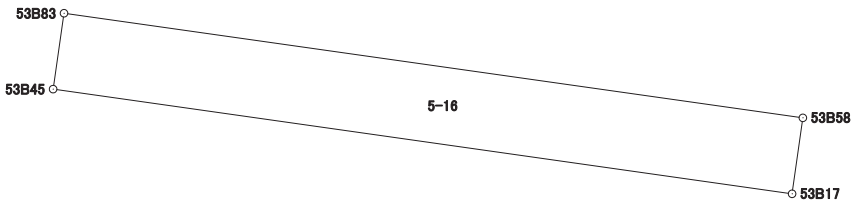
地番	5-15
----	------

境界点	X	Y	辺長	方向角	備考	N 	
53B58	43065.602	-67385.638	9.020	278° 03' 20″			
53B83	43066.866	-67394.569	1.426	8° 10' 52″			
53B82	43068.278	-67394.366	9.017	98° 03' 30″			
53B57	43067.014	-67385.438	1.426	188° 03' 43″			
面積算出公式			面 積	12.8631500	街区一画地	53-保15	
$A=1/2 \sum X_n(Y_{(n+1)}-Y_{(n-1)})$			地 積	12.86			

座 標 面 積 計 算 書

世界測地系（測地成果2011）

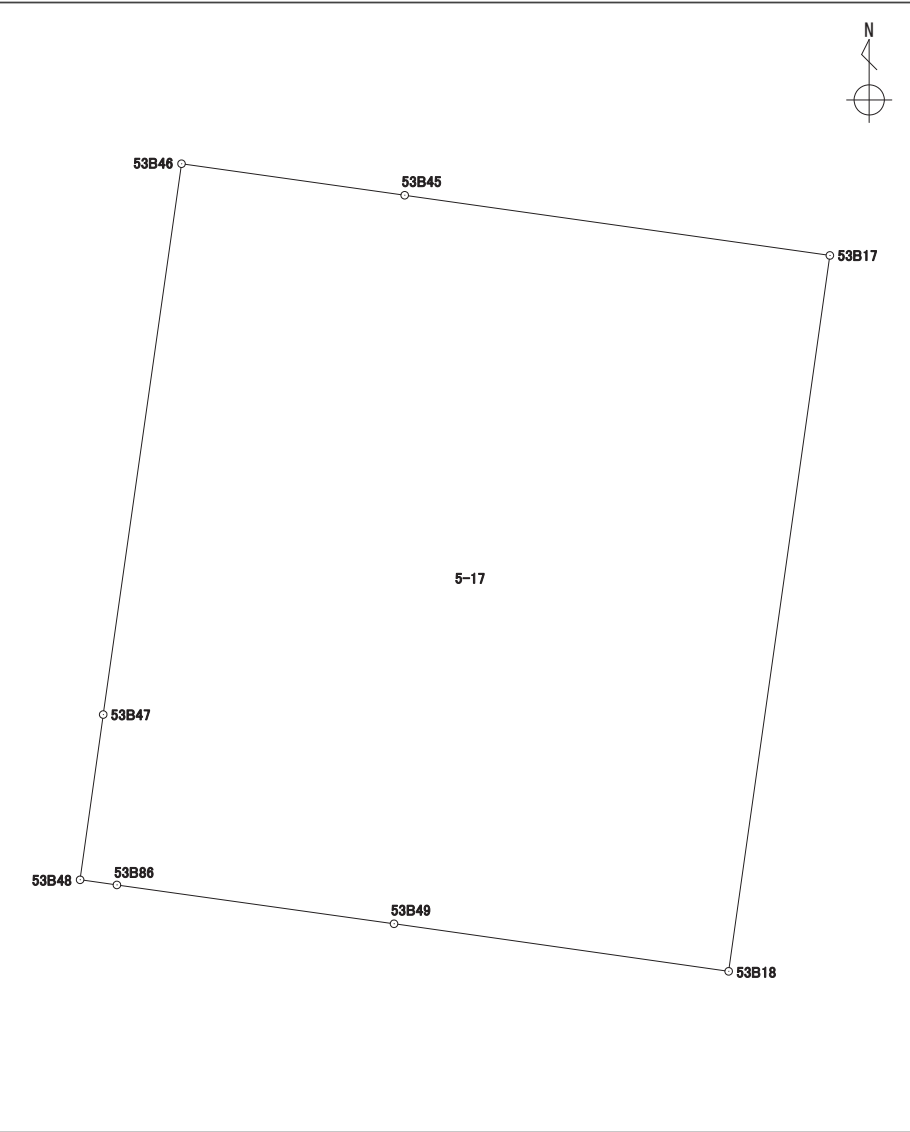
地番	5-16
----	------

境界点	X	Y	辺長	方向角	備考	N 	
53B45	43065.949	-67394.701	0.926	8° 11' 29"			
53B83	43066.866	-67394.569	9.020	98° 03' 20"			
53B58	43065.602	-67385.638	0.927	188° 03' 37"			
53B17	43064.684	-67385.768	9.022	278° 03' 36"			
面積算出公式			面 積	8.3607595	街区一画地	53-保16	
$A=1/2 \sum X_n(Y_{(n+1)}-Y_{(n-1)})$			地 積	8.36			

座 標 面 積 計 算 書

世界測地系（測地成果2011）

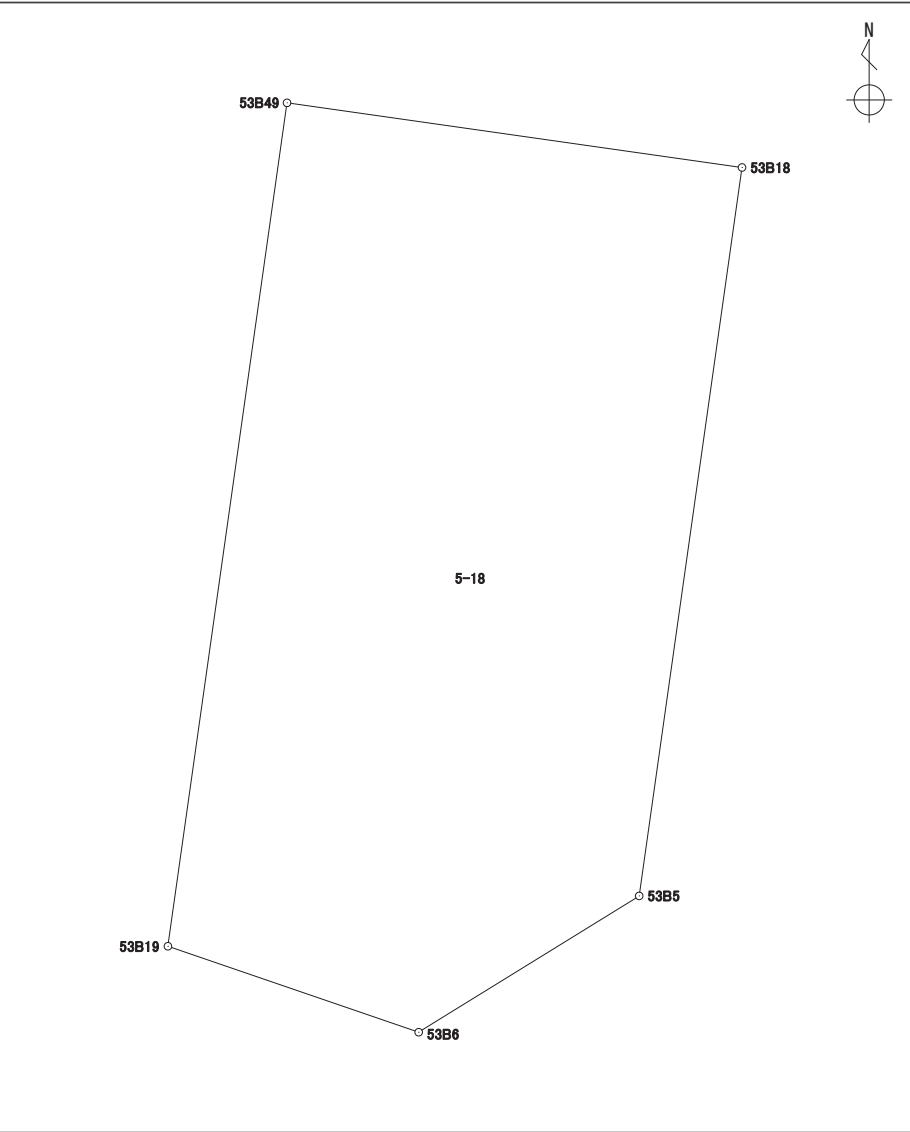
地 番	5-17
-----	------

境 界 点	X	Y	辺長	方向角	備考		
53B18	43049.646	-67387.894	7.101	278° 05' 12″			
53B49	43050.645	-67394.925	5.879	277° 58' 38″			
53B86	43051.461	-67400.748	0.780	277° 57' 13″			
53B48	43051.569	-67401.521	3.504	7° 58' 14″			
53B47	43055.040	-67401.035	11.687	8° 05' 29″			
53B46	43066.611	-67399.390	4.735	98° 02' 10″			
53B45	43065.949	-67394.701	9.022	98° 03' 36″			
53B17	43064.684	-67385.768	15.187	188° 02' 49″			
面積算出公式			面 積	209.0146345	街区一画地	53-8	
$A=1/2 \sum X_n(Y_{(n+1)}-Y_{(n-1)})$			地 積	209.01			

座 標 面 積 計 算 書

世界測地系（測地成果2011）

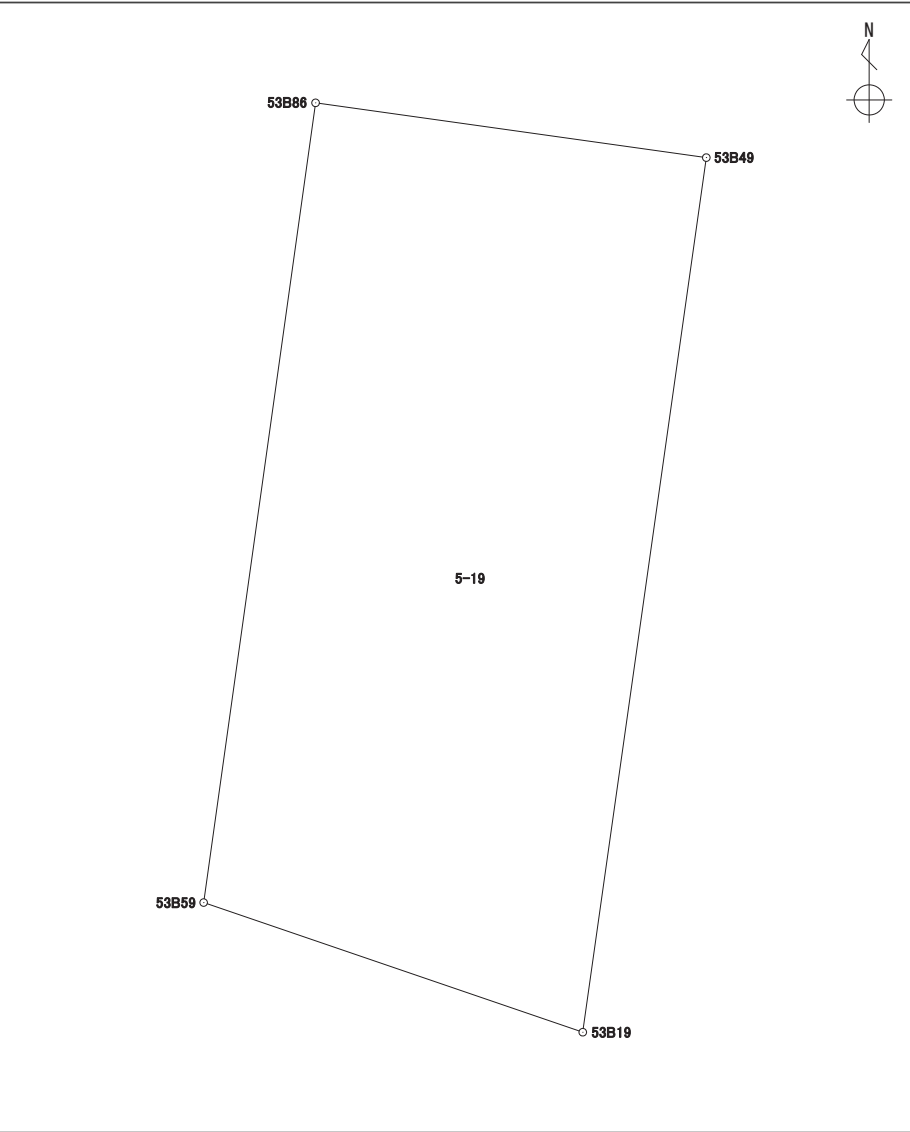
地 番	5-18
-----	------

境 界 点	X	Y	辺長	方向角	備考		
53B19	43037.613	-67396.766	13.161	8° 02' 27"			
53B49	43050.645	-67394.925	7.101	98° 05' 12"			
53B18	43049.646	-67387.894	11.366	188° 02' 10"			
53B5	43038.391	-67389.483	4.006	238° 17' 08"			
53B6	43036.285	-67392.891	4.096	288° 55' 02"			
面積算出公式			面 積	93.4438240	街区一画地	53-9	
$A=1/2 \sum X_n(Y_{(n+1)}-Y_{(n-1)})$			地 積	93.44			

座 標 面 積 計 算 書

世界測地系（測地成果2011）

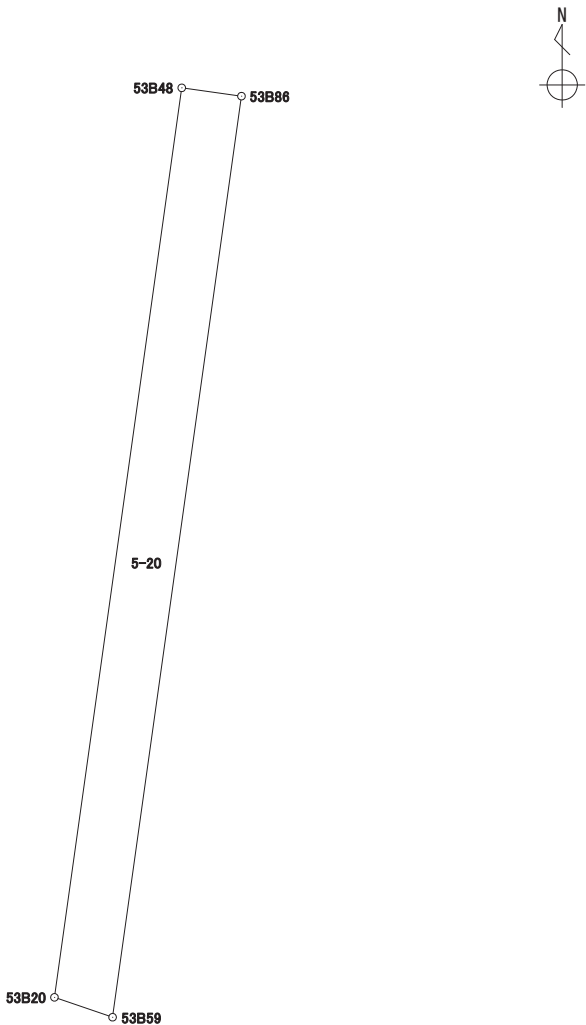
地番	5-19
----	------

境 界 点	X	Y	辺長	方向角	備考		
53B59	43039.545	-67402.416	12.032	7° 58' 07"			
53B86	43051.461	-67400.748	5.879	97° 58' 38"			
53B49	43050.645	-67394.925	13.161	188° 02' 27"			
53B19	43037.613	-67396.766	5.971	288° 52' 41"			
面積算出公式			面 積	73.9677840	街区一画地	53-10	
$A=1/2 \sum X_n(Y_{(n+1)}-Y_{(n-1)})$			地 積	73.96			

座 標 面 積 計 算 書

世界測地系（測地成果2011）

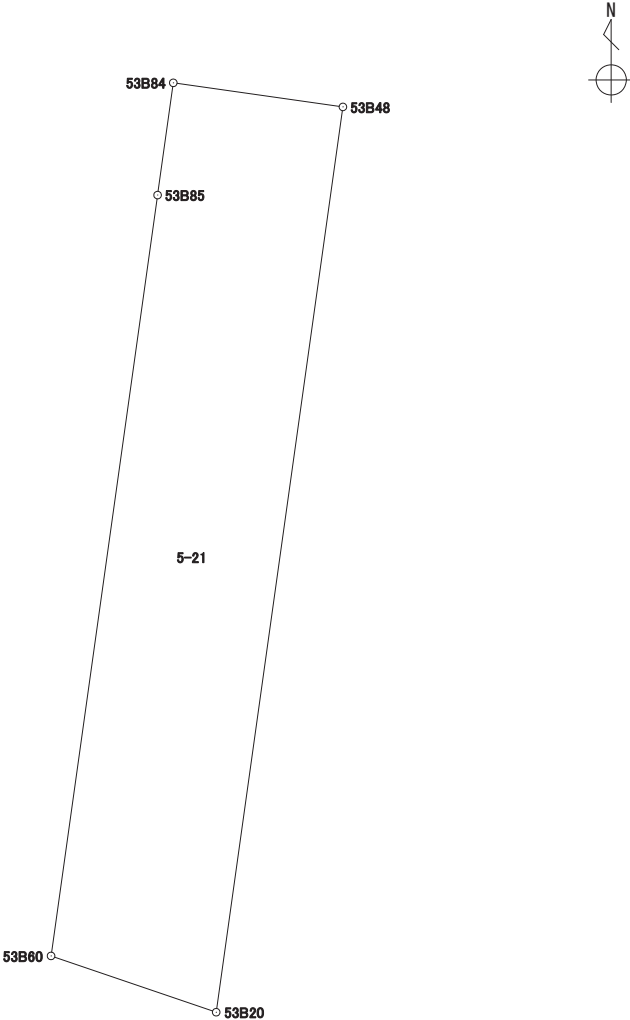
地番	5-20
----	------

境 界 点	X	Y	辺長	方向角	備考		
53B48	43051.569	-67401.521	0.780	97° 57' 13″			
53B86	43051.461	-67400.748	12.032	187° 58' 07″			
53B59	43039.545	-67402.416	0.794	288° 52' 05″			
53B20	43039.802	-67403.168	11.881	7° 58' 04″			
面積算出公式			面 積	9.3316375	街区一画地	53-保2	
$A=1/2 \sum X_n(Y_{(n+1)}-Y_{(n-1)})$			地 積	9.33			

座 標 面 積 計 算 書

世界測地系（測地成果2011）

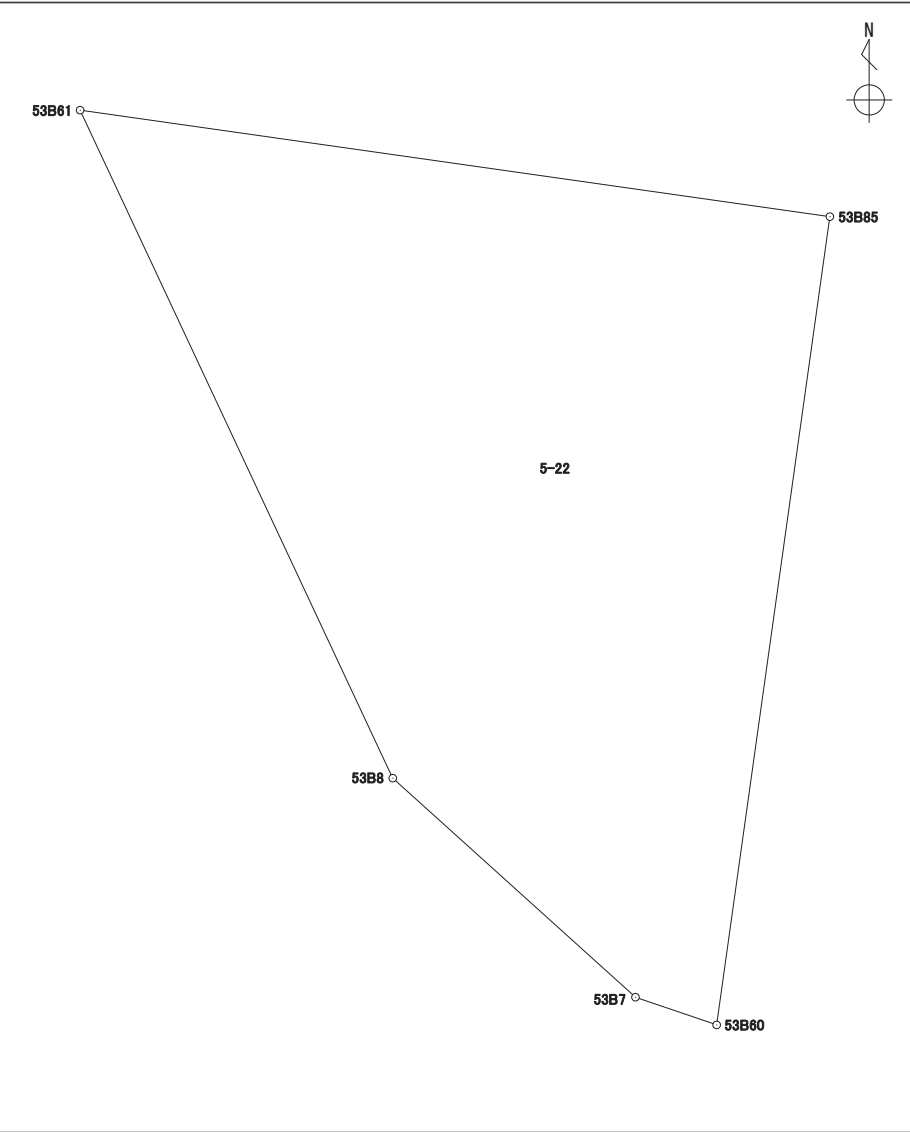
地番	5-21
----	------

境 界 点	X	Y	辺長	方向角	備考		
53B84	43051.882	-67403.726	2.227	98° 04' 45″			
53B48	43051.569	-67401.521	11.881	187° 58' 04″			
53B20	43039.802	-67403.168	2.268	288° 49' 35″			
53B60	43040.534	-67405.315	9.985	7° 58' 22″			
53B85	43050.423	-67403.930	1.473	7° 57' 35″			
面積算出公式			面 積	25.9928455	街区一画地	53-保3	
$A=1/2 \sum X_n(Y_{(n+1)}-Y_{(n-1)})$			地 積	25.99			

座 標 面 積 計 算 書

世界測地系（測地成果2011）

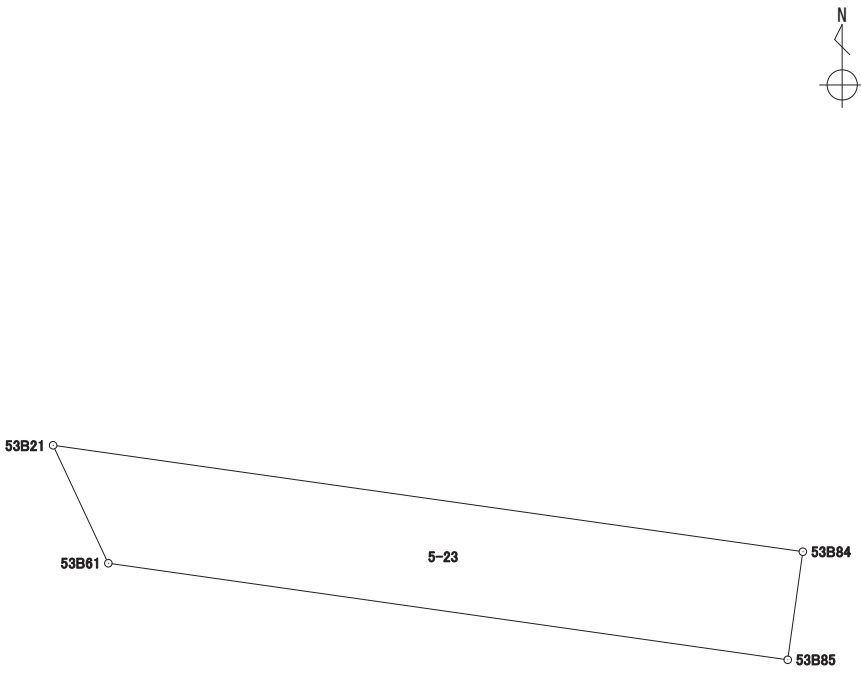
地番	5-22
----	------

境 界 点	X	Y	辺長	方向角	備考		
53B61	43051.726	-67413.105	9.267	98° 04' 58″			
53B85	43050.423	-67403.930	9.985	187° 58' 22″			
53B60	43040.534	-67405.315	1.050	288° 49' 54″			
53B7	43040.873	-67406.309	4.000	312° 03' 42″			
53B8	43043.553	-67409.279	9.024	334° 54' 52″			
面積算出公式			面 積	57.5201990	街区一画地	53-11	
$A=1/2 \sum X_n(Y_{(n+1)}-Y_{(n-1)})$			地 積	57.52			

座 標 面 積 計 算 書

世界測地系（測地成果2011）

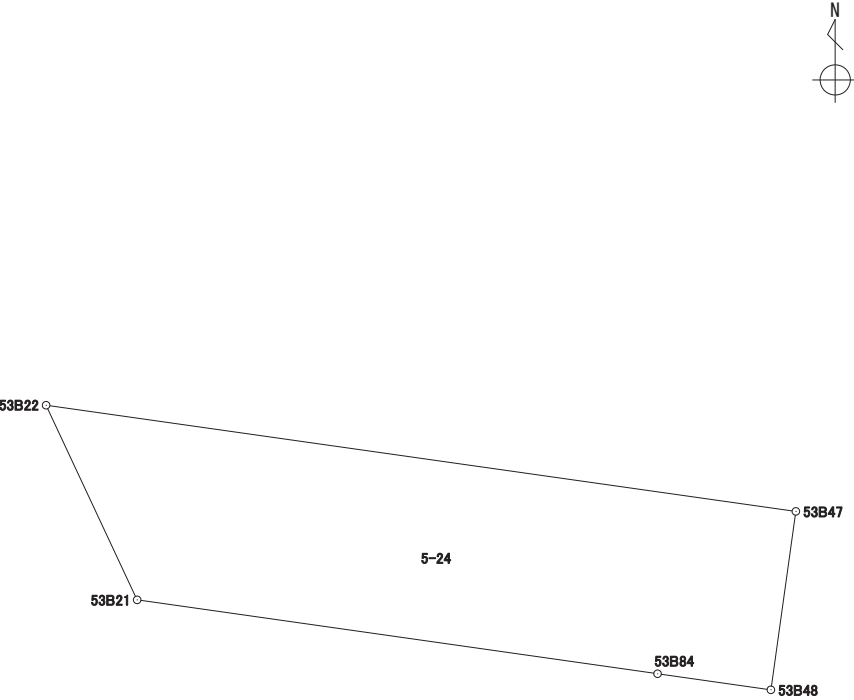
地番	5-23
----	------

境 界 点	X	Y	辺長	方向角	備考	N 	
53B84	43051.882	-67403.726	1.473	187° 57' 35″			
53B85	43050.423	-67403.930	9.267	278° 04' 58″			
53B61	43051.726	-67413.105	1.759	334° 54' 23″			
53B21	43053.319	-67413.851	10.226	98° 04' 40″			
面積算出公式			面 積	14.3546300	街区一画地	53-保4	
$A=1/2 \sum X_n(Y_{n+1}-Y_{n-1})$			地 積	14.35			

座 標 面 積 計 算 書

世界測地系（測地成果2011）

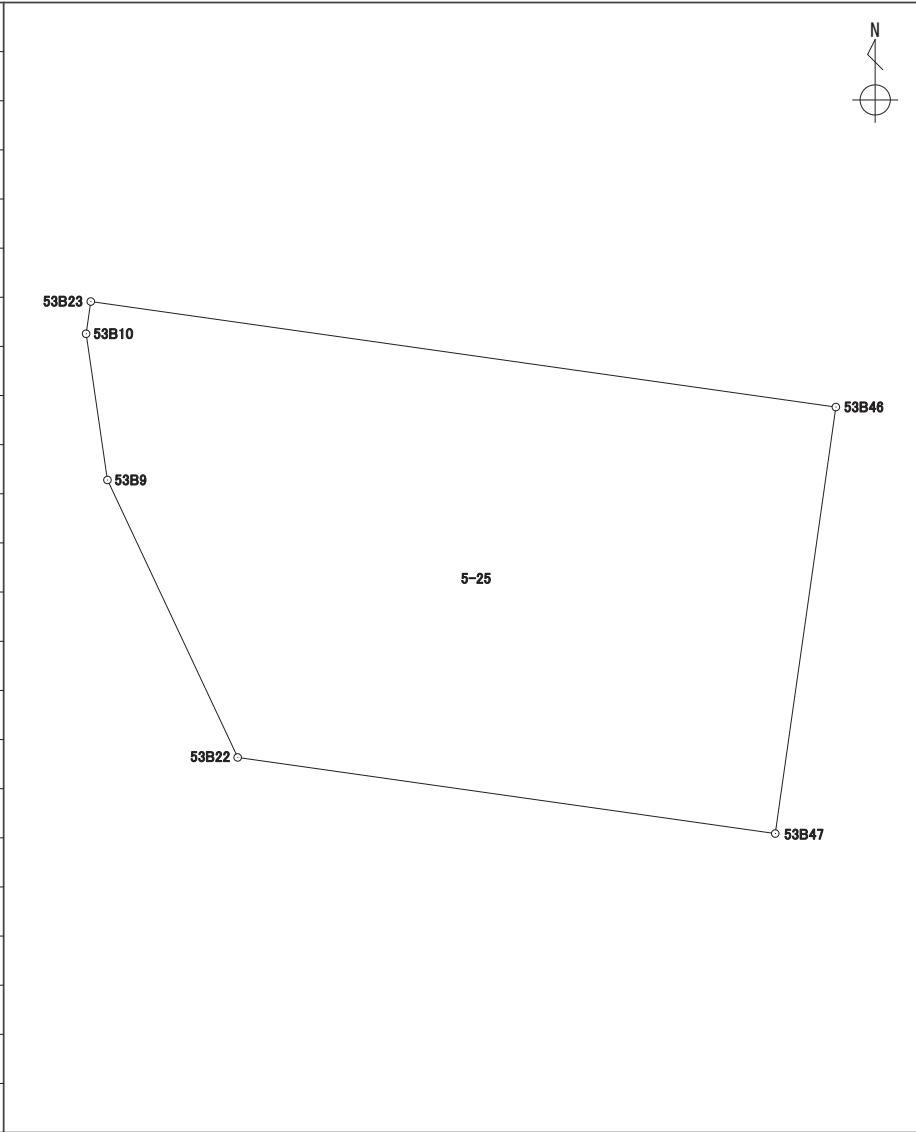
地番	5-24
----	------

境 界 点	X	Y	辺長	方向角	備考	N 	
53B22	43057.105	-67415.623	14.733	98° 03' 25″			
53B47	43055.040	-67401.035	3.504	187° 58' 14″			
53B48	43051.569	-67401.521	2.227	278° 04' 45″			
53B84	43051.882	-67403.726	10.226	278° 04' 40″			
53B21	43053.319	-67413.851	4.180	334° 55' 07″			
面積算出公式			面 積	47.6091890	街区一画地	53-12	
$A=1/2 \sum X_n(Y_{(n+1)}-Y_{(n-1)})$			地 積	47.60			

座 標 面 積 計 算 書

世界測地系（測地成果2011）

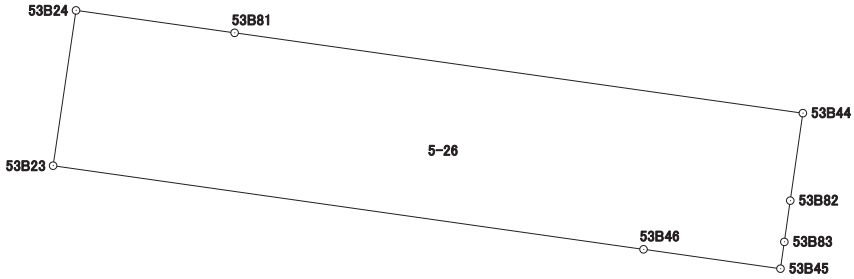
地番	5-25
----	------

境界点	X	Y	辺長	方向角	備考	N 	
53B23	43069.475	-67419.609	20.420	98° 03' 44"			
53B46	43066.611	-67399.390	11.687	188° 05' 29"			
53B47	43055.040	-67401.035	14.733	278° 03' 25"			
53B22	43057.105	-67415.623	8.317	334° 51' 19"			
53B9	43064.634	-67419.157	4.009	351° 40' 55"			
53B10	43068.601	-67419.737	0.883	8° 19' 55"			
面積算出公式			面 積	212.8037405	街区一画地	53-13	
A=1/2 Σ Xn(Y(n+1)-Y(n-1))			地 積	212.80			

座 標 面 積 計 算 書

世界測地系（測地成果2011）

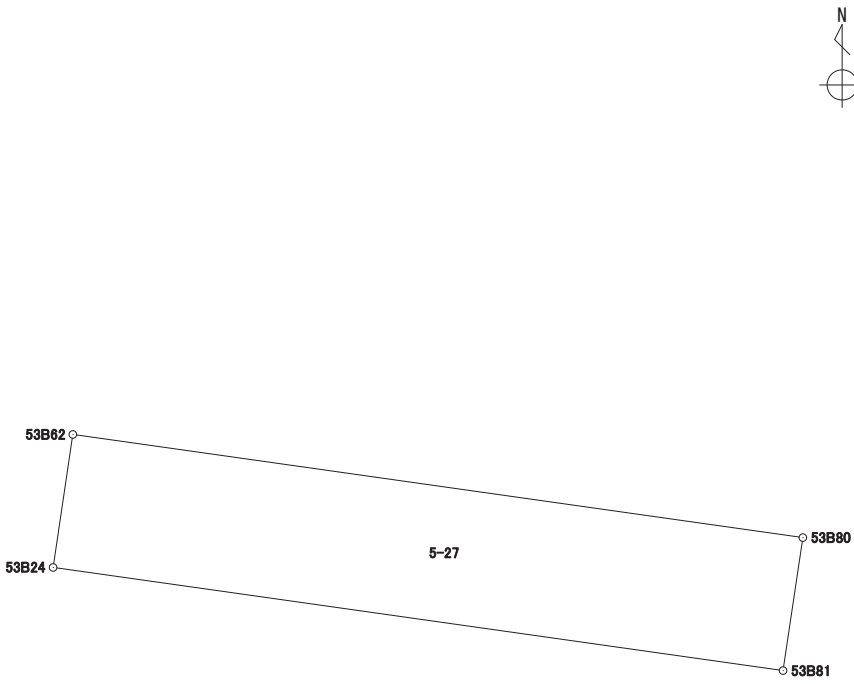
地番	5-26
----	------

境 界 点	X	Y	辺長	方向角	備考	N  	
53B24	43074.791	-67418.823	5.482	98° 02' 29"			
53B81	43074.024	-67413.394	19.652	98° 02' 49"			
53B44	43071.273	-67393.935	3.025	188° 11' 20"			
53B82	43068.278	-67394.366	1.426	188° 10' 52"			
53B83	43066.866	-67394.569	0.926	188° 11' 29"			
53B45	43065.949	-67394.701	4.735	278° 02' 10"			
53B46	43066.611	-67399.390	20.420	278° 03' 44"			
53B23	43069.475	-67419.609	5.373	8° 24' 38"			
面積算出公式			面 積	135.2175335	街区一画地	53-14	
$A=1/2 \sum X_n(Y_{(n+1)}-Y_{(n-1)})$			地 積	135.21			

座 標 面 積 計 算 書

世界測地系（測地成果2011）

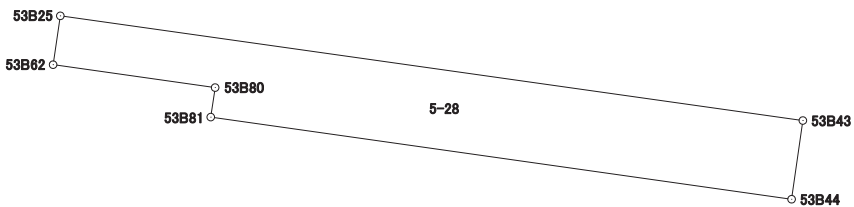
地番	5-27
----	------

境 界 点	X	Y	辺長	方向角	備考	N 	
53B62	43075.780	-67418.676	5.482	98° 02' 29"			
53B80	43075.013	-67413.247	0.999	188° 27' 15"			
53B81	43074.024	-67413.394	5.482	278° 02' 29"			
53B24	43074.791	-67418.823	0.999	8° 27' 15"			
面積算出公式			面 積	5.4820300	街区一画地	53-保23	
$A=1/2 \sum X_n(Y_{n+1}-Y_{n-1})$			地 積	5.48			

座 標 面 積 計 算 書

世界測地系（測地成果2011）

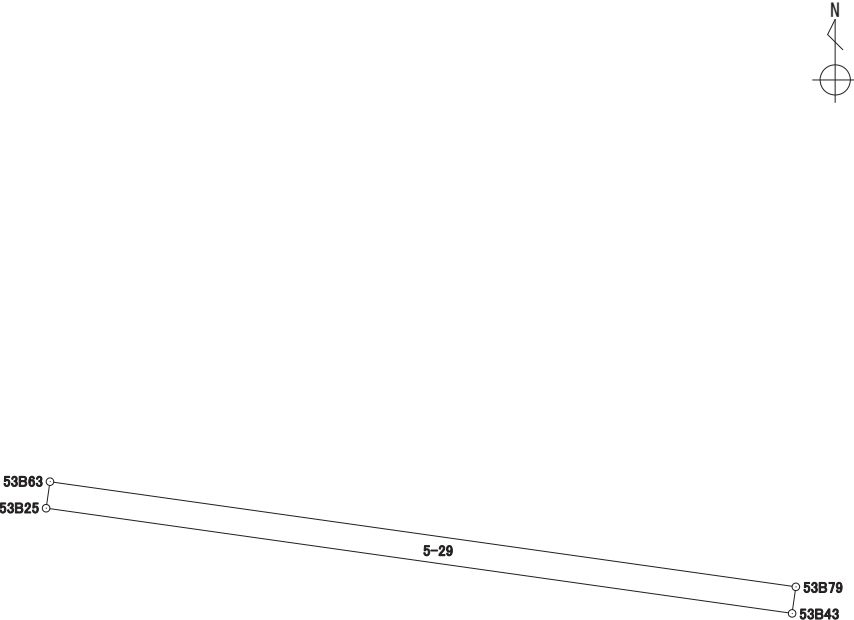
地番	5-28
----	------

境界点	X	Y	辺長	方向角	備考	N 	
53B25	43077.416	-67418.434	25.121	98° 01' 29"			
53B43	43073.909	-67393.558	2.662	188° 08' 21"			
53B44	43071.273	-67393.935	19.652	278° 02' 49"			
53B81	43074.024	-67413.394	0.999	8° 27' 15"			
53B80	43075.013	-67413.247	5.482	278° 02' 29"			
53B62	43075.780	-67418.676	1.653	8° 24' 51"			
面積算出公式			面 積	61.3097185	街区一画地	53-15	
$A=1/2 \sum X_n(Y_{(n+1)}-Y_{(n-1)})$			地 積	61.30			

座 標 面 積 計 算 書

世界測地系（測地成果2011）

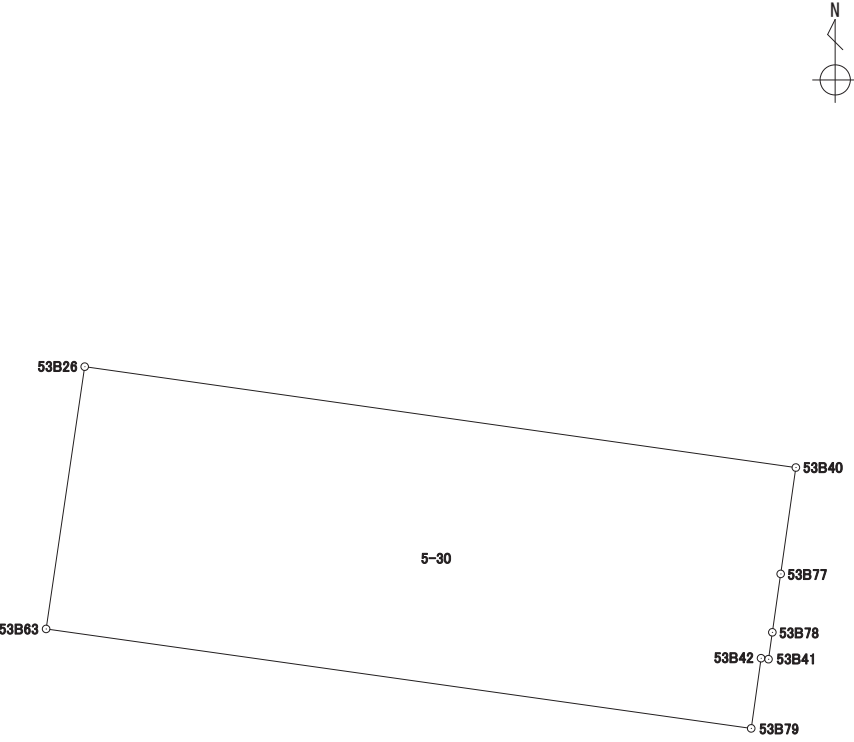
地番	5-29
----	------

境 界 点	X	Y	辺長	方向角	備考		
53B25	43077.416	-67418.434	0.894	8° 21' 24"			
53B63	43078.301	-67418.304	25.116	98° 01' 36"			
53B79	43074.794	-67393.434	0.893	187° 58' 33"			
53B43	43073.909	-67393.558	25.121	278° 01' 29"			
面積算出公式			面 積	22.4579940	街区一画地	53-保22	
$A=1/2 \sum X_n(Y_{n+1}-Y_{n-1})$			地 積	22.45			

座 標 面 積 計 算 書

世界測地系（測地成果2011）

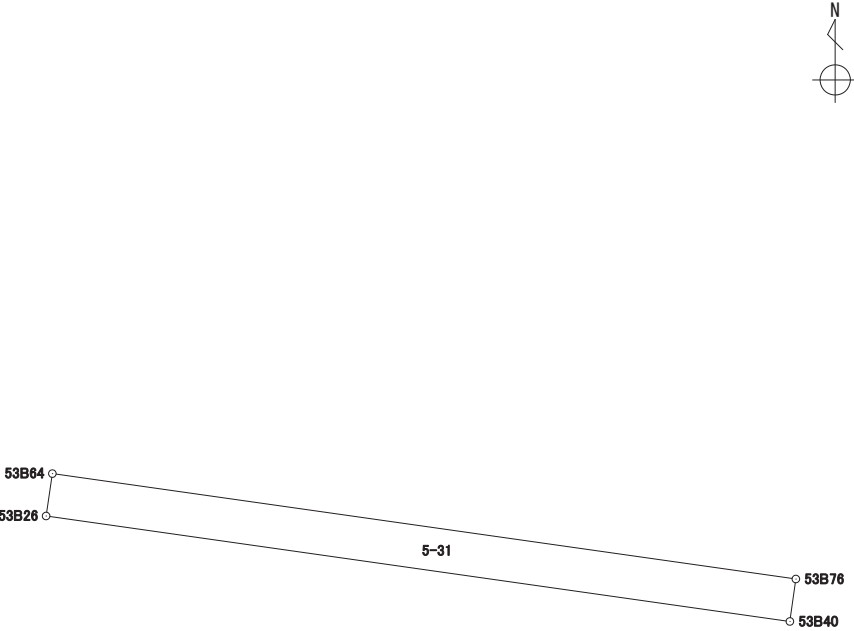
地番	5-30
----	------

境 界 点	X	Y	辺長	方向角	備考		
53B79	43074.794	-67393.434	25.116	278° 01' 36"			
53B63	43078.301	-67418.304	9.347	8° 22' 41"			
53B26	43087.549	-67416.942	25.333	98° 04' 08"			
53B40	43083.993	-67391.859	3.788	188° 07' 02"			
53B77	43080.242	-67392.394	2.082	188° 08' 44"			
53B78	43078.181	-67392.689	0.957	188° 06' 17"			
53B41	43077.233	-67392.824	0.264	277° 36' 32"			
53B42	43077.268	-67393.086	2.498	188° 00' 25"			
面積算出公式			面 積	236.1123990	街区一画地	53-16	
$A=1/2 \sum X_n(Y_{(n+1)}-Y_{(n-1)})$			地 積	236.11			

座 標 面 積 計 算 書

世界測地系（測地成果2011）

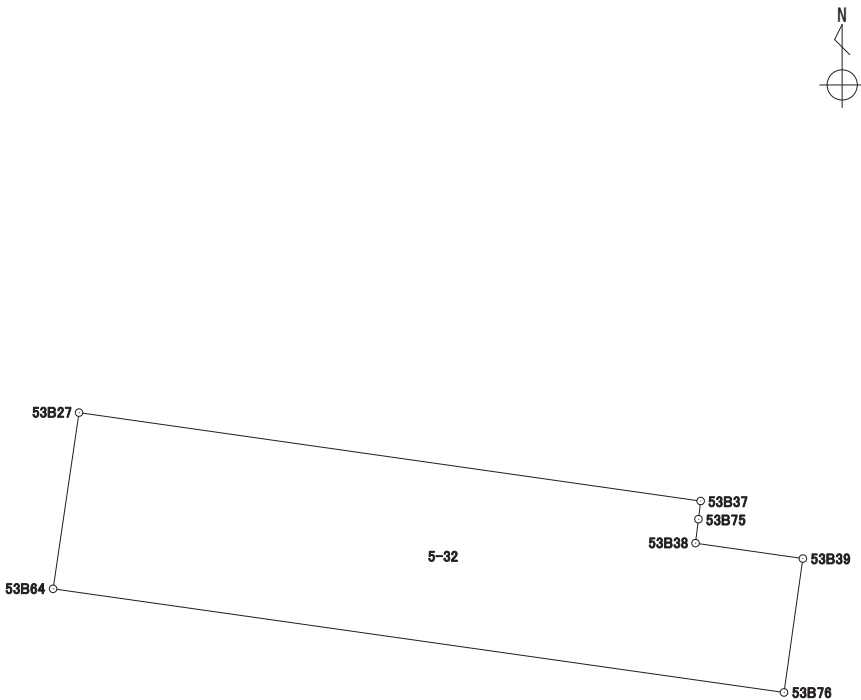
地番	5-31
----	------

境 界 点	X	Y	辺長	方向角	備考	N 	
53B26	43087.549	-67416.942	1.444	8° 23' 58″			
53B64	43088.978	-67416.731	25.323	98° 04' 04″			
53B76	43085.424	-67391.658	1.445	187° 59' 44″			
53B40	43083.993	-67391.859	25.333	278° 04' 08″			
面積算出公式			面 積	36.5938700	街区一画地	53-保21	
A=1/2 Σ Xn(Y(n+1)-Y(n-1))			地 積	36.59			

座 標 面 積 計 算 書

世界測地系（測地成果2011）

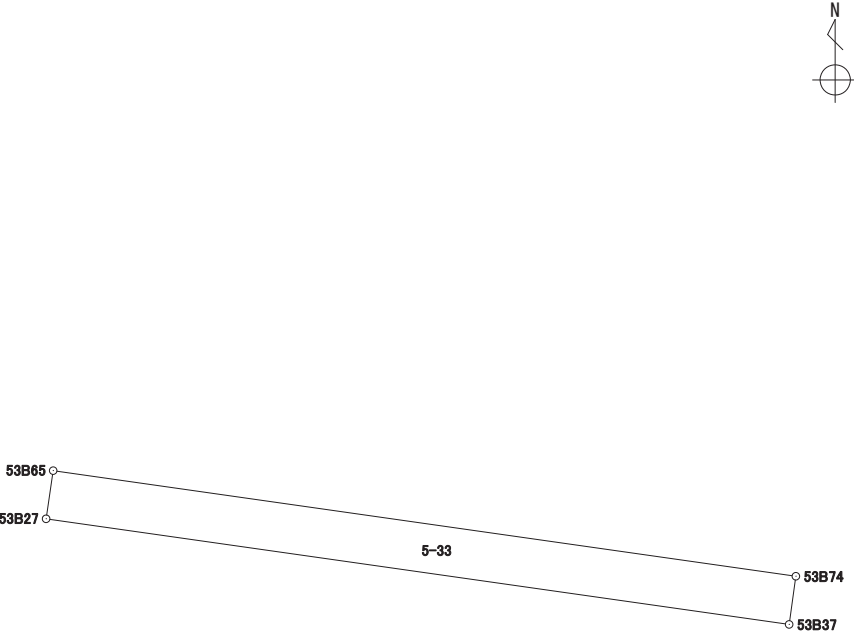
地番	5-32
----	------

境 界 点	X	Y	辺長	方向角	備考	N 	
53B76	43085.424	-67391.658	25.323	278° 04' 04″			
53B64	43088.978	-67416.731	6.108	8° 22' 41″			
53B27	43095.021	-67415.841	21.537	98° 05' 25″			
53B37	43091.990	-67394.518	0.628	186° 56' 39″			
53B75	43091.366	-67394.594	0.827	187° 00' 48″			
53B38	43090.545	-67394.695	3.719	98° 11' 28″			
53B39	43090.015	-67391.013	4.636	187° 59' 50″			
面積算出公式			面 積	148.9845075	街区一画地	53-17	
$A=1/2 \sum X_n(Y_{(n+1)}-Y_{(n-1)})$			地 積	148.98			

座 標 面 積 計 算 書

世界測地系（測地成果2011）

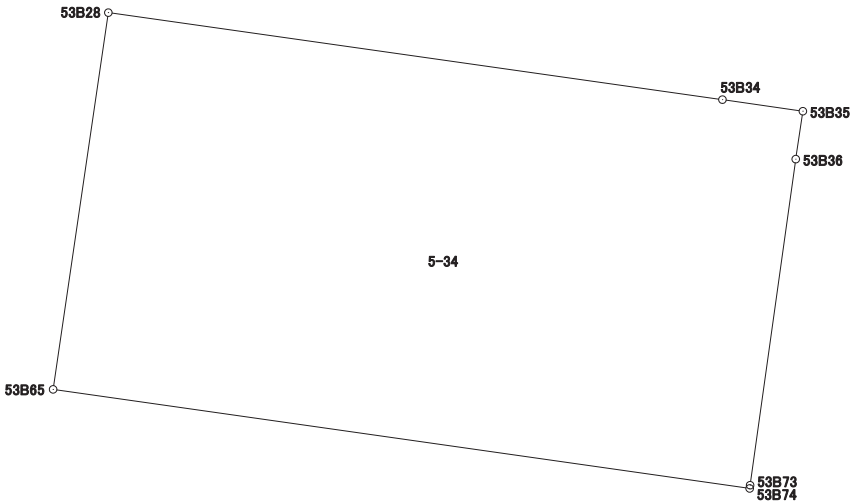
地番	5-33
----	------

境 界 点	X	Y	辺長	方向角	備考	N 	
53B37	43091.990	-67394.518	21.537	278° 05' 25"			
53B27	43095.021	-67415.841	1.395	8° 21' 44"			
53B65	43096.402	-67415.638	21.527	98° 05' 29"			
53B74	43093.372	-67394.325	1.395	187° 57' 00"			
面積算出公式			面 積	30.0508560	街区一画地	53-保20	
$A=1/2 \sum X_n(Y_{(n+1)}-Y_{(n-1)})$			地 積	30.05			

座 標 面 積 計 算 書

世界測地系（測地成果2011）

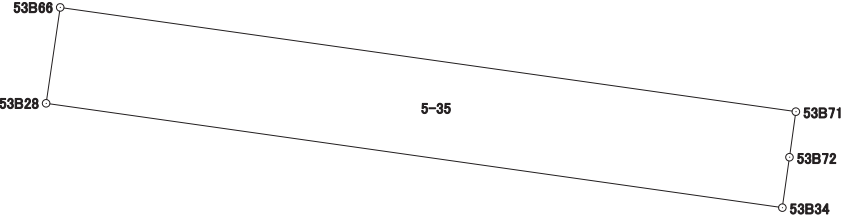
地番	5-34
----	------

境 界 点	X	Y	辺長	方向角	備考	N  	
53B74	43093.372	-67394.325	21.527	278° 05' 29"			
53B65	43096.402	-67415.638	11.649	8° 20' 30"			
53B28	43107.928	-67413.948	18.977	98° 03' 49"			
53B34	43105.266	-67395.158	2.485	98° 12' 42"			
53B35	43104.911	-67392.698	1.480	188° 25' 32"			
53B36	43103.446	-67392.915	10.072	187° 58' 00"			
53B73	43093.471	-67394.311	0.099	188° 02' 57"			
面積算出公式			面 積	250.4448575	街区一画地	53-18	
$A=1/2 \sum X_n(Y_{(n+1)}-Y_{(n-1)})$			地 積	250.44			

座 標 面 積 計 算 書

世界測地系（測地成果2011）

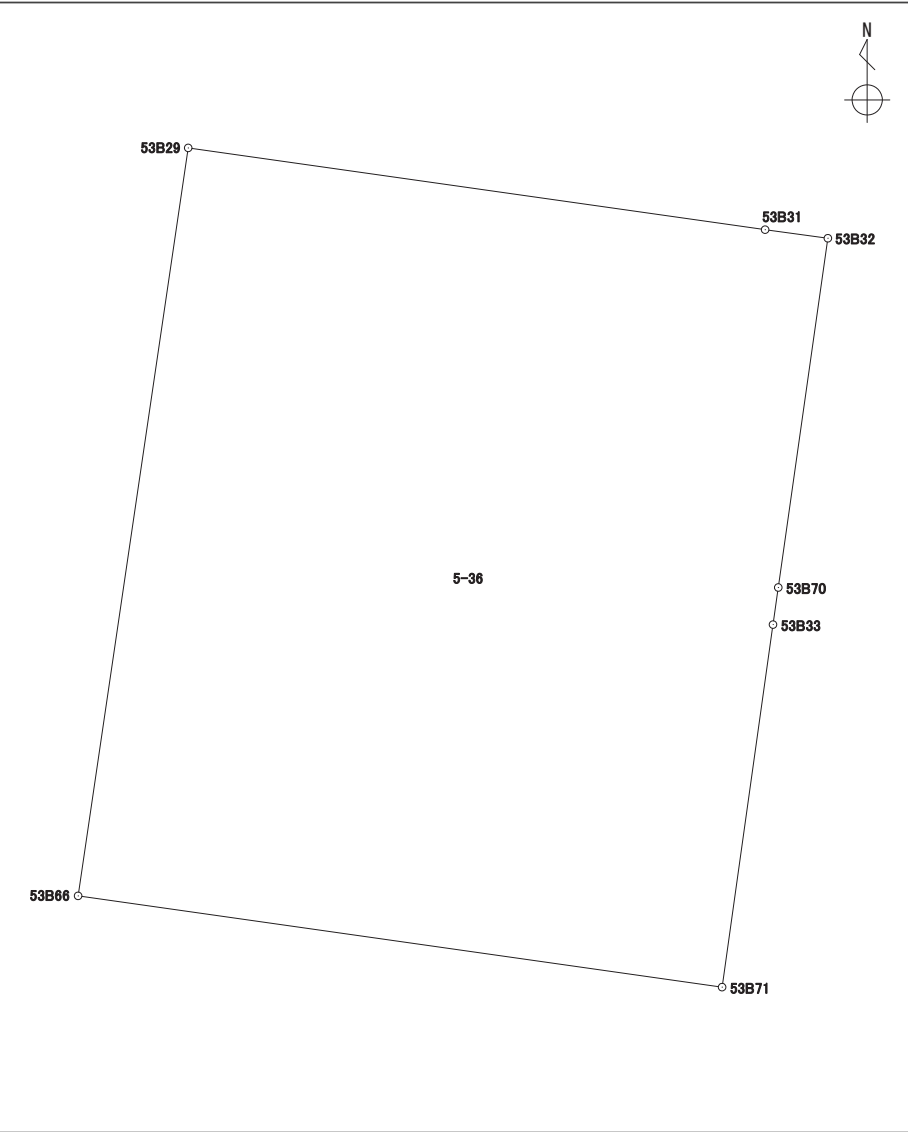
地番	5-35
----	------

境界点	X	Y	辺長	方向角	備考	N 	
53B28	43107.928	-67413.948	2.473	8° 22' 09"			
53B66	43110.375	-67413.588	18.961	98° 03' 51"			
53B71	43107.715	-67394.814	1.173	187° 59' 06"			
53B72	43106.553	-67394.977	1.299	188° 00' 19"			
53B34	43105.266	-67395.158	18.977	278° 03' 49"			
面積算出公式			面 積	46.9152785	街区一画地	53-保5	
$A=1/2 \sum X_n(Y_{(n+1)}-Y_{(n-1)})$			地 積	46.91			

座 標 面 積 計 算 書

世界測地系（測地成果2011）

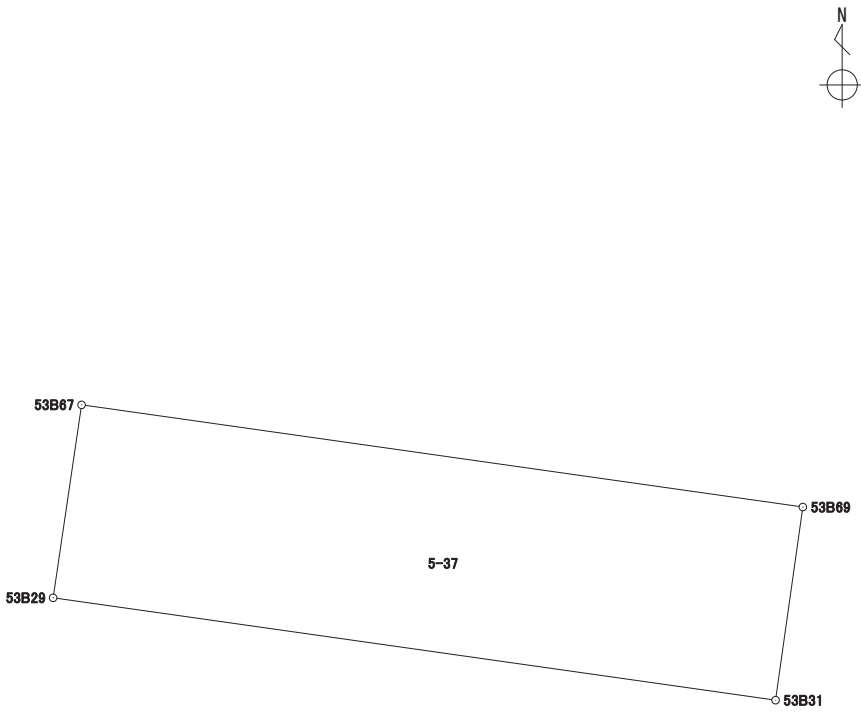
地 番	5-36
-----	------

境 界 点	X	Y	辺長	方向角	備考		
53B71	43107.715	-67394.814	18.961	278° 03' 51″			
53B66	43110.375	-67413.588	22.036	8° 22' 34″			
53B29	43132.176	-67410.378	16.985	98° 03' 53″			
53B31	43129.793	-67393.560	1.846	97° 47' 00″			
53B32	43129.543	-67391.731	10.282	188° 05' 04″			
53B70	43119.363	-67393.177	1.090	188° 03' 48″			
53B33	43118.283	-67393.330	10.671	187° 59' 36″			
面積算出公式			面 積	416.3141450	街区一画地	53-19	
$A=1/2 \sum X_n(Y_{n+1}-Y_{n-1})$			地 積	416.31			

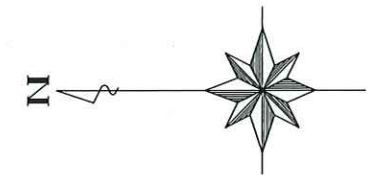
座 標 面 積 計 算 書

世界測地系（測地成果2011）

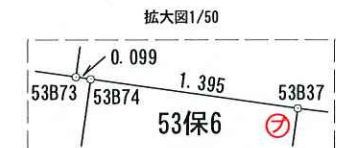
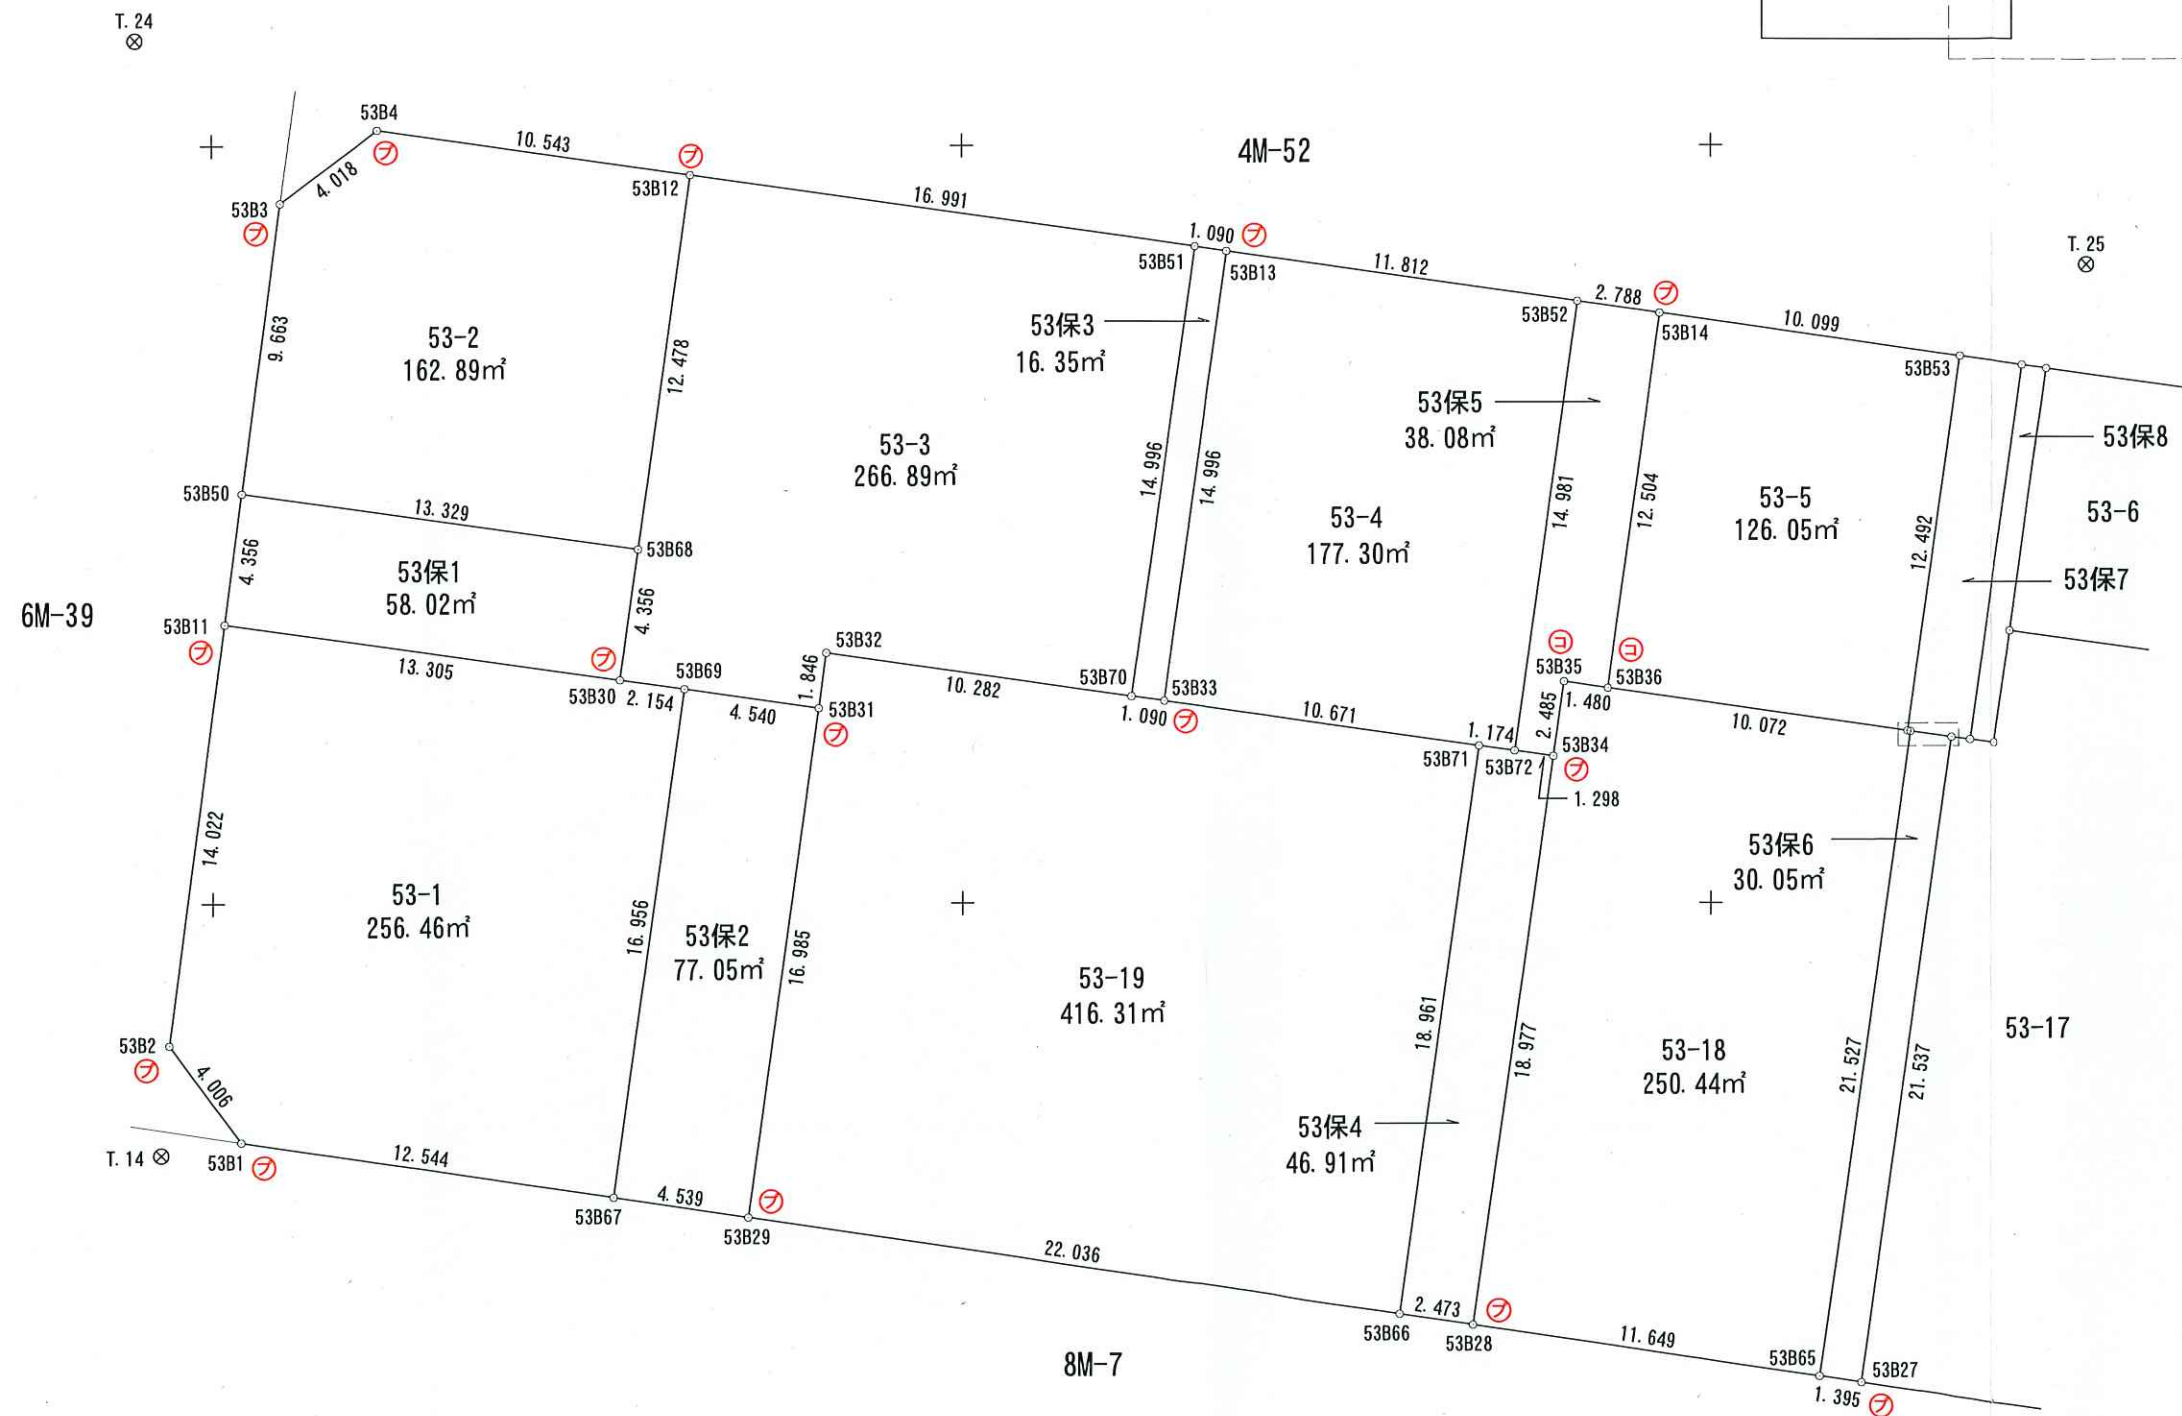
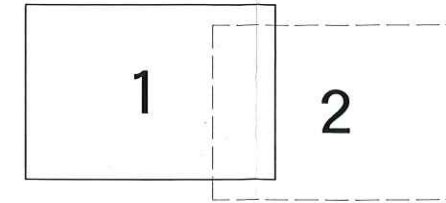
地番	5-37
----	------

境 界 点	X	Y	辺長	方向角	備考	N 	
53B29	43132.176	-67410.378	4.539	8° 24' 37"			
53B67	43136.667	-67409.714	16.956	98° 03' 42"			
53B69	43134.289	-67392.925	4.540	188° 02' 21"			
53B31	43129.793	-67393.560	16.985	278° 03' 53"			
面積算出公式			面 積	77.0526620	街区一画地	53-保6	
$A=1/2 \sum X_n(Y_{(n+1)}-Y_{(n-1)})$			地 積	77.05			

53街区 出来形確認図 (3565.68m²)

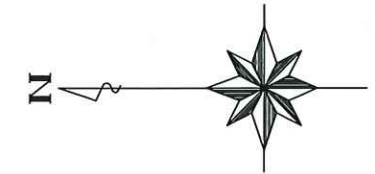


S=1:250

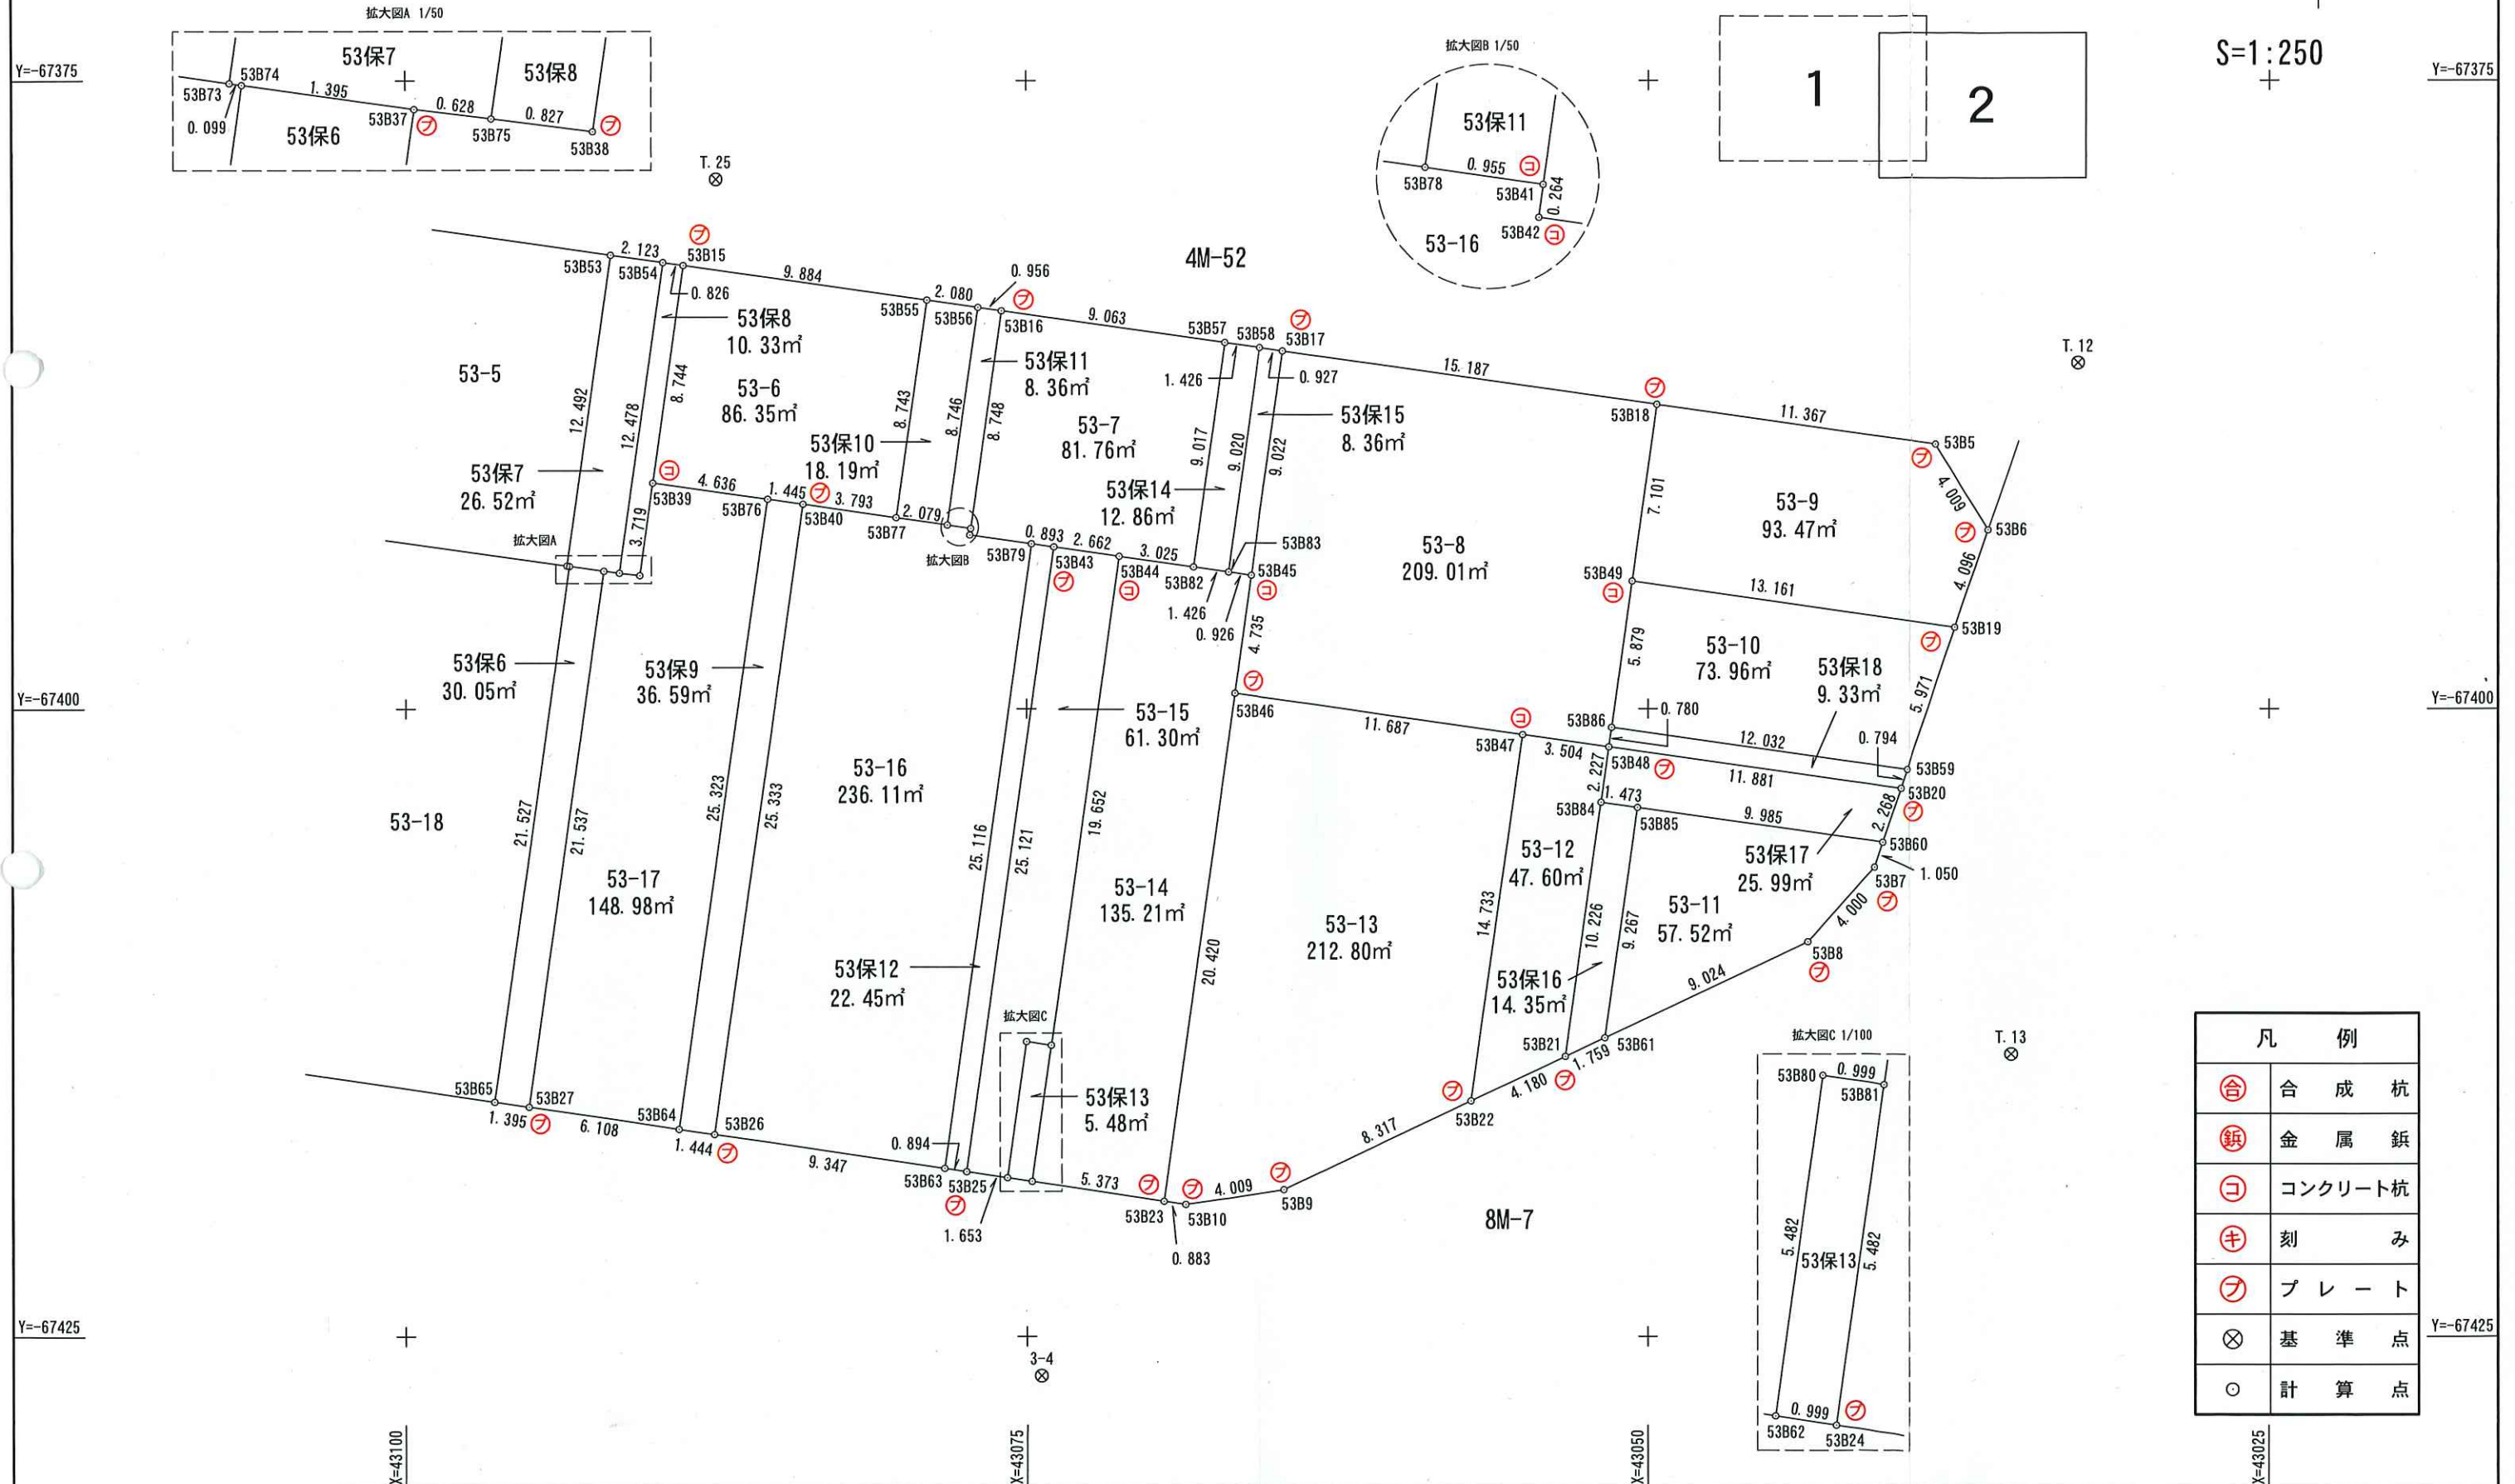


凡 例	
⊕	合 成 杭
⊖	金 属 杭
⊙	コンクリート杭
⊕	刻 み
⊖	プ レ ー ト
⊗	基 準 点
○	計 算 点

53街区 出来形確認図 (3565.68m²)



S=1:250



凡 例	
⊕	合 成 杭
⊖	金 属 杭
⊙	コンクリート杭
⊗	刻 み
⊚	プ レ ート
⊗	基 準 点
○	計 算 点