



157-2街区 画地出来形確認図 (1374.64m²)

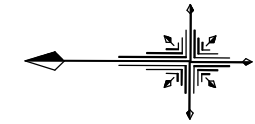

S=1/500

3. 4. 3 2 本町六供線

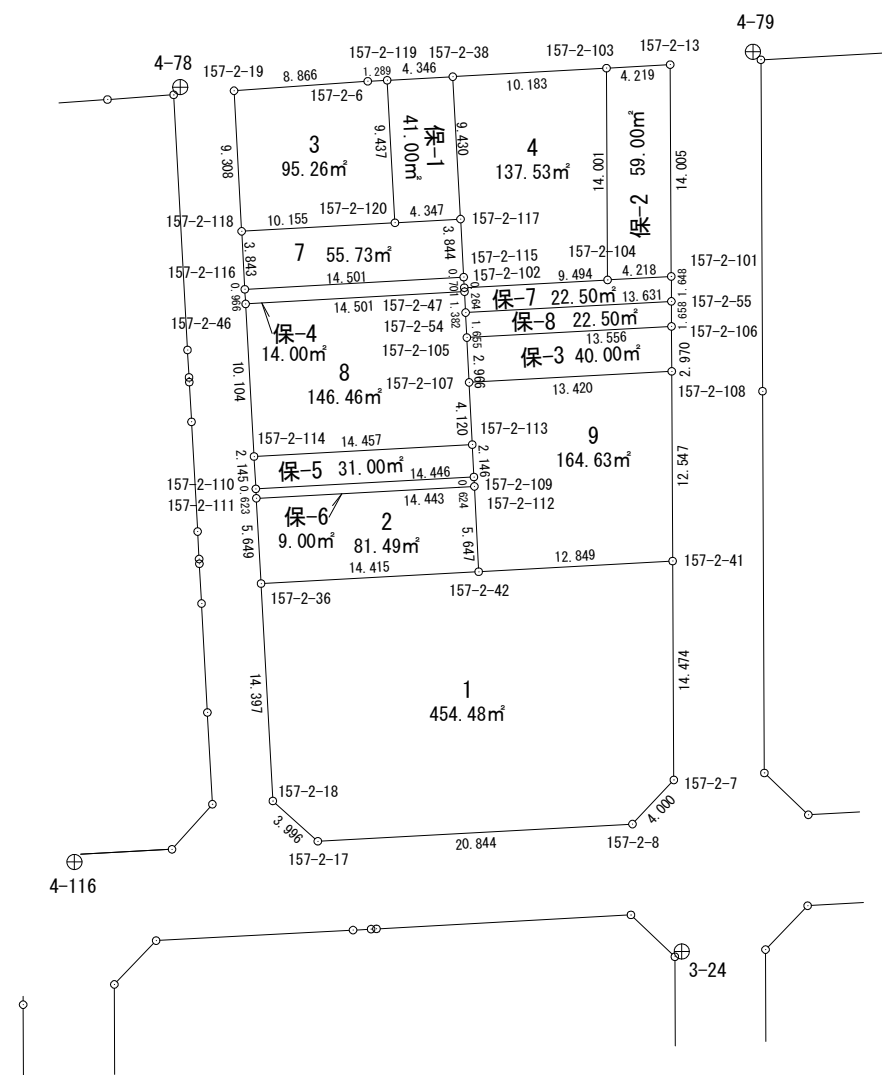


面積計算書（座標法）

世界測地系（測地成果2011）

所在	地番	公簿地目	現況地目	地積	所有者
前橋市六供町三丁目	157-2-2			81.49 m ²	

点名	X座標	Y座標	辺長	方向角	測角	DX	倍積 (Y×DX)
157-2-112	40860.759	-67863.819	14.443	356-53-18	89-46-16	14.706	-998005.322214
157-2-111	40875.181	-67864.603	5.649	266-50-01	89-56-43	14.110	-957569.548330
157-2-36	40874.869	-67870.243	14.415	176-52-56	90-02-55	-14.706	998099.793558
157-2-42	40860.475	-67869.459	5.647	87-07-02	90-14-06	-14.110	957638.066490
倍面積						162.989504	
面積						81.4947520	

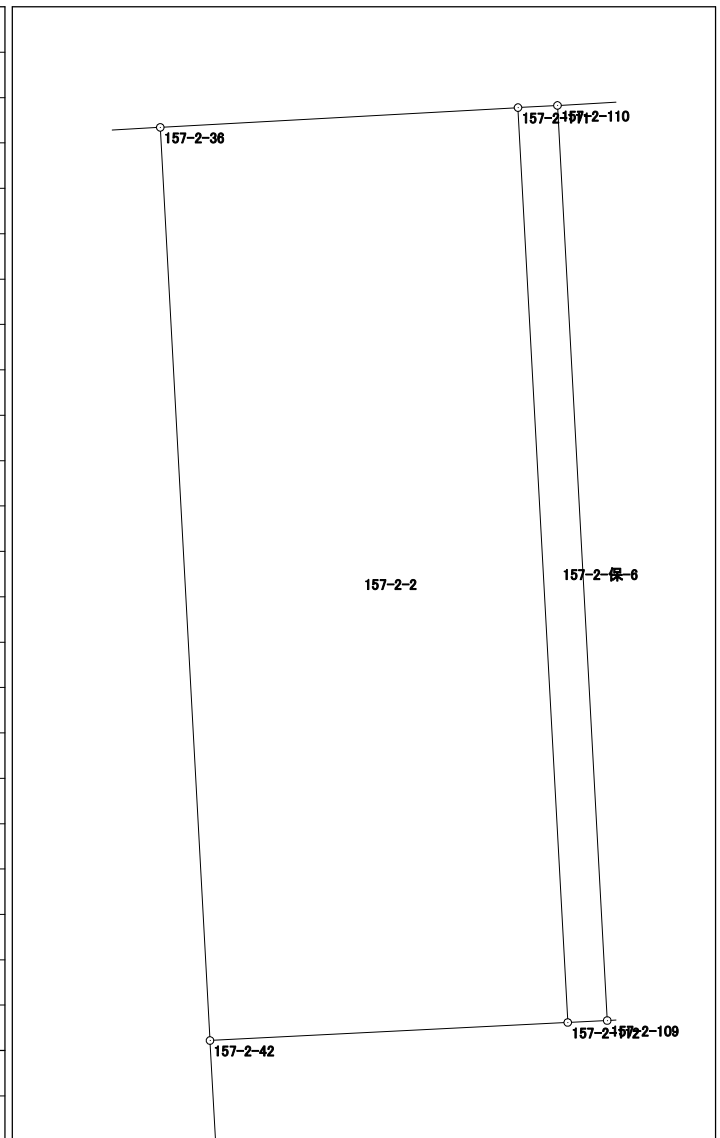


面積計算書（座標法）

世界測地系（測地成果2011）

所在	地番	公簿地目	現況地目	地積	所有者
前橋市六供町三丁目	157-2-3			95.26 m ²	

点名	X座標	Y座標	辺長	方向角	測角	DX	倍積(Y×DX)
157-2-120	40866.014	-67846.383	9.437	86-53-24	90-04-46	-9.627	653157.129141
157-2-119	40866.526	-67836.960	1.289	356-55-52	90-02-28	1.799	-122038.691040
157-2-6	40867.813	-67837.029	8.866	355-57-28	179-01-36	10.131	-687256.940799
157-2-19	40876.657	-67837.654	9.308	266-53-46	90-56-18	8.340	-565766.034360
157-2-118	40876.153	-67846.948	10.155	176-48-38	89-54-52	-10.643	722095.067564

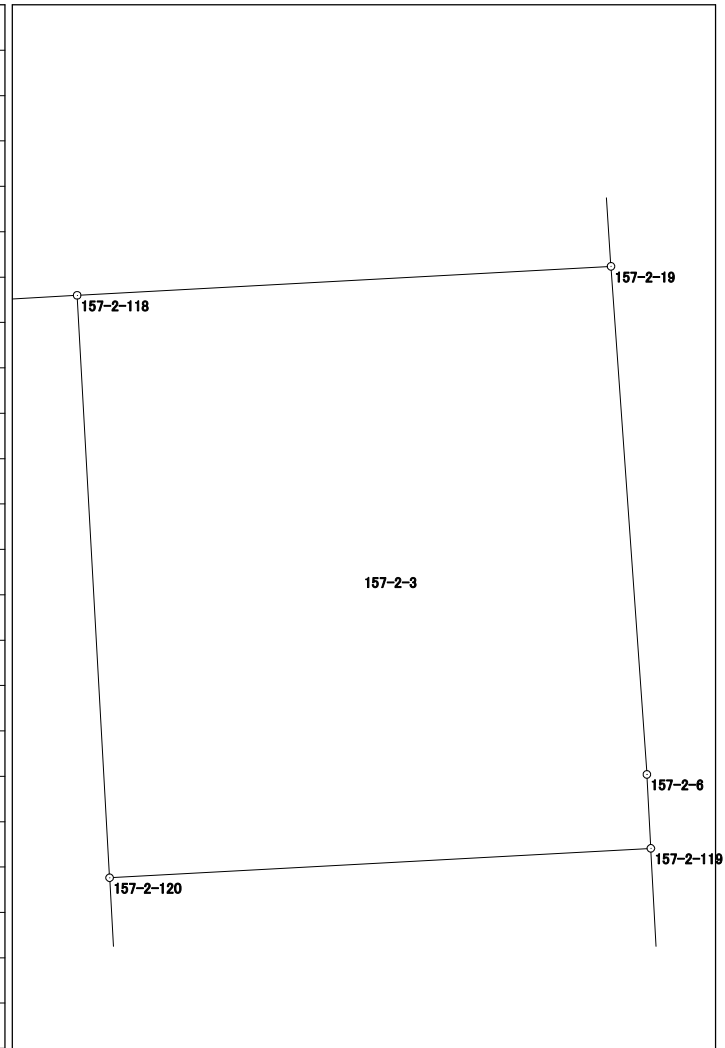


倍面積	190.530506
面積	95.2652530

面積計算書（座標法）

世界測地系（測地成果2011）

所在	地番	公簿地目	現況地目	地積	所有者
前橋市六供町三丁目	157-2-4			137.53 m ²	

点名	X座標	Y座標	辺長	方向角	測角	Dx	倍積 (Y×Dx)
157-2-38	40862.186	-67836.725	9.430	266-53-15	90-03-46	9.655	-654963.579875
157-2-117	40861.674	-67846.141	3.844	266-52-59	179-59-44	-0.721	48917.067661
157-2-115	40861.465	-67849.979	0.701	266-53-34	180-00-35	-0.247	16758.944813
157-2-102	40861.427	-67850.679	9.494	176-52-42	89-59-08	-9.518	645802.762722
157-2-104	40851.947	-67850.162	14.001	89-42-19	92-49-37	-9.408	638334.324096
157-2-103	40852.019	-67836.161	10.183	356-49-29	87-07-10	10.239	-694574.452479

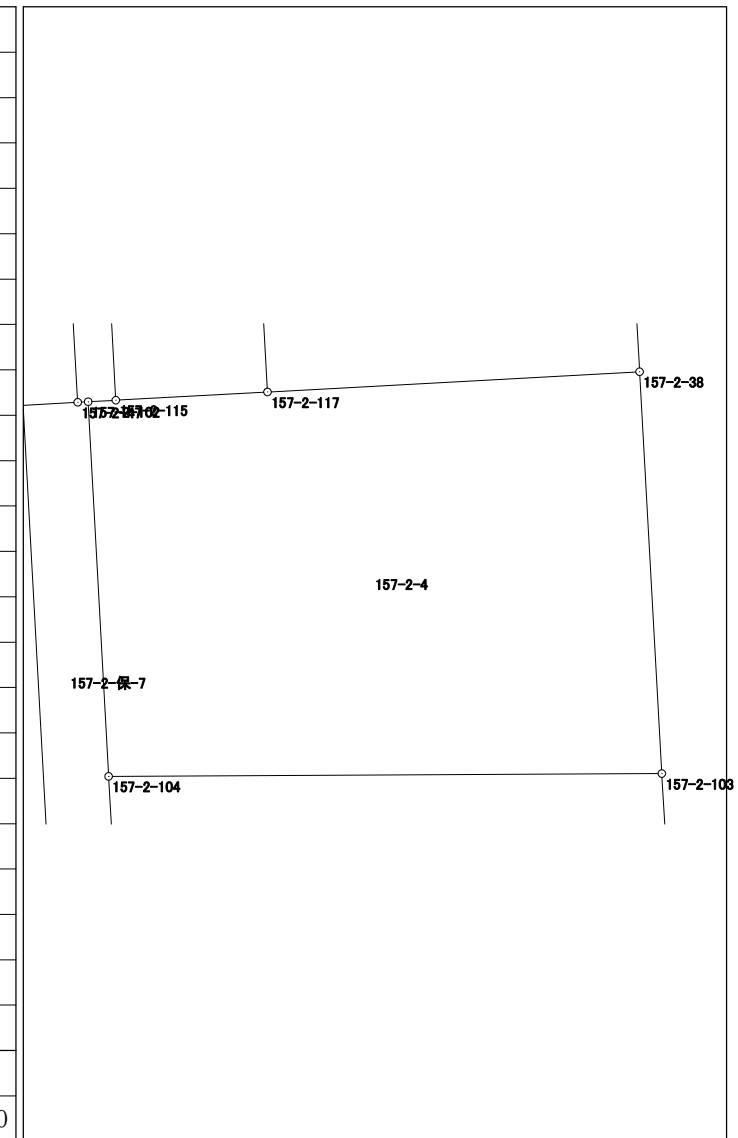


倍面積	275.066938
面積	137.5334690

面積計算書 (座標法)

世界測地系 (測地成果2011)

所 在	地 番	公簿地目	現況地目	地 積	所 有 者
前橋市六供町三丁目	157-2-7			55.73 m ²	

点 名	X 座標	Y 座標	辺 長	方 向 角	測 角	DX	倍 積 (Y×DX)
157-2-120	40866.014	-67846.383	10.155	356-48-38	180-00-08	14.479	-982347.779457
157-2-118	40876.153	-67846.948	3.843	266-52-56	90-04-18	9.930	-673720.193640
157-2-116	40875.944	-67850.785	14.501	176-48-50	89-55-54	-14.688	996592.330080
157-2-115	40861.465	-67849.979	3.844	86-52-59	90-04-09	-14.270	968219.200330
157-2-117	40861.674	-67846.141	4.347	356-48-30	89-55-31	4.549	-308632.095409
						倍面積	111.461904
						面 積	55.7309520

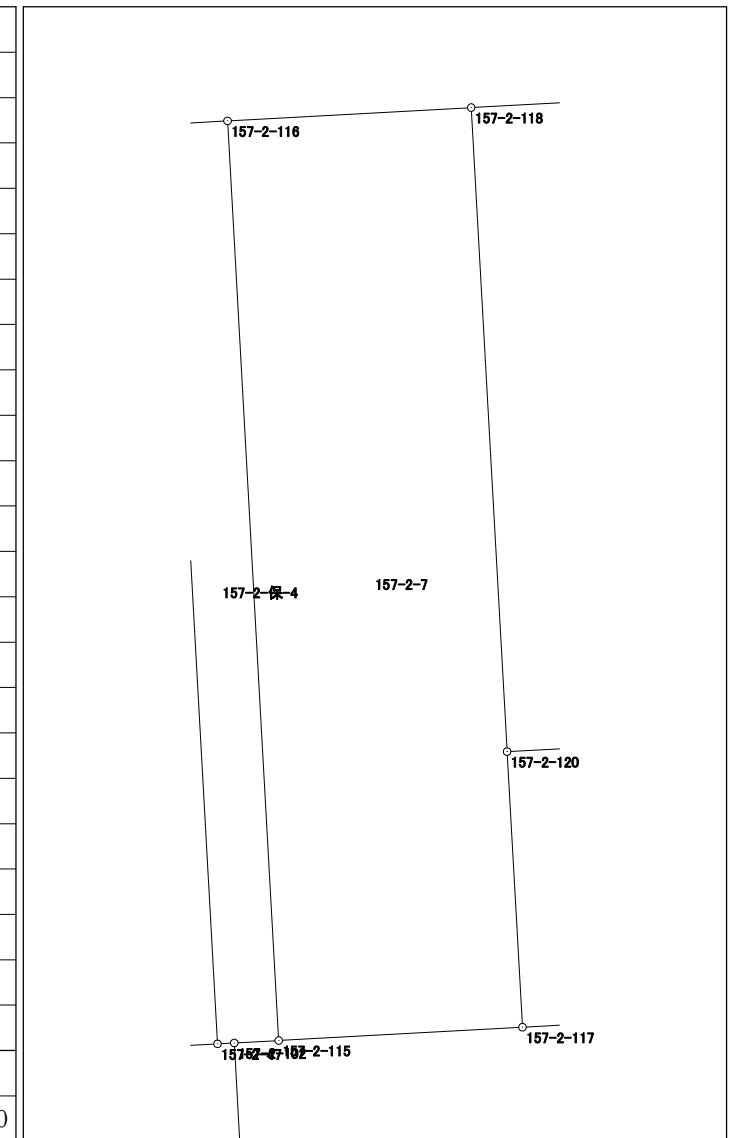


面積計算書 (座標法)

所在	地番	公簿地目	現況地目	地積	所有者
前橋市六供町三丁目	157-2-8			146.46 m ²	

点名	X座標	Y座標	辺長	方向角	測角	DX	倍積 (Y×DX)
157-2-114	40875.334	-67861.839	14.457	176-53-01	90-02-57	-14.994	1017520.413966
157-2-113	40860.898	-67861.053	4.120	87-07-13	90-14-12	-14.229	965594.923137
157-2-107	40861.105	-67856.938	2.966	87-06-03	179-58-50	0.357	-24224.926866
157-2-105	40861.255	-67853.976	1.655	87-07-32	180-01-29	0.233	-15809.976408
157-2-54	40861.338	-67852.323	1.382	86-53-21	179-45-49	0.158	-10720.667034
157-2-47	40861.413	-67850.943	14.501	356-48-36	89-55-15	14.554	-987502.624422
157-2-46	40875.892	-67851.750	10.104	266-50-04	90-01-28	13.921	-944564.211750

倍面積	292.930623
面積	146.4653115

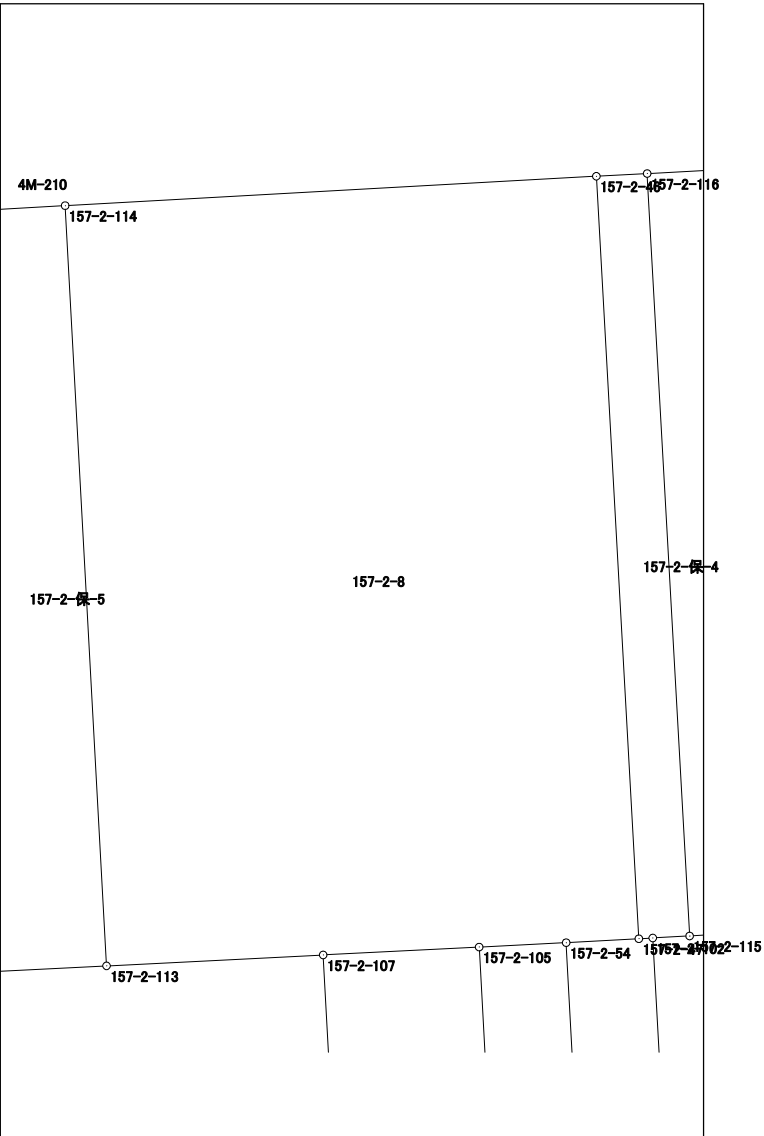


面積計算書 (座標法)

世界測地系 (測地成果2011)

所在	地番	公簿地目	現況地目	地積	所有者
前橋市六供町三丁目	157-2-9			164.63 m ²	

点名	X座標	Y座標	辺長	方向角	測角	DX	倍積 (Y×DX)
157-2-112	40860.759	-67863.819	5.647	267-07-02	179-57-57	-0.315	21377.102985
157-2-42	40860.475	-67869.459	12.849	176-51-33	89-44-31	-13.114	890040.085326
157-2-41	40847.645	-67868.755	12.547	89-43-34	92-52-01	-12.770	866684.001350
157-2-108	40847.705	-67856.208	13.420	356-52-54	87-09-20	13.460	-913344.559680
157-2-107	40861.105	-67856.938	4.120	267-07-13	90-14-19	13.193	-895236.583034
157-2-113	40860.898	-67861.053	2.146	267-06-54	179-59-41	-0.315	21376.231695
157-2-109	40860.790	-67863.196	0.624	267-09-05	180-02-11	-0.139	9432.984244

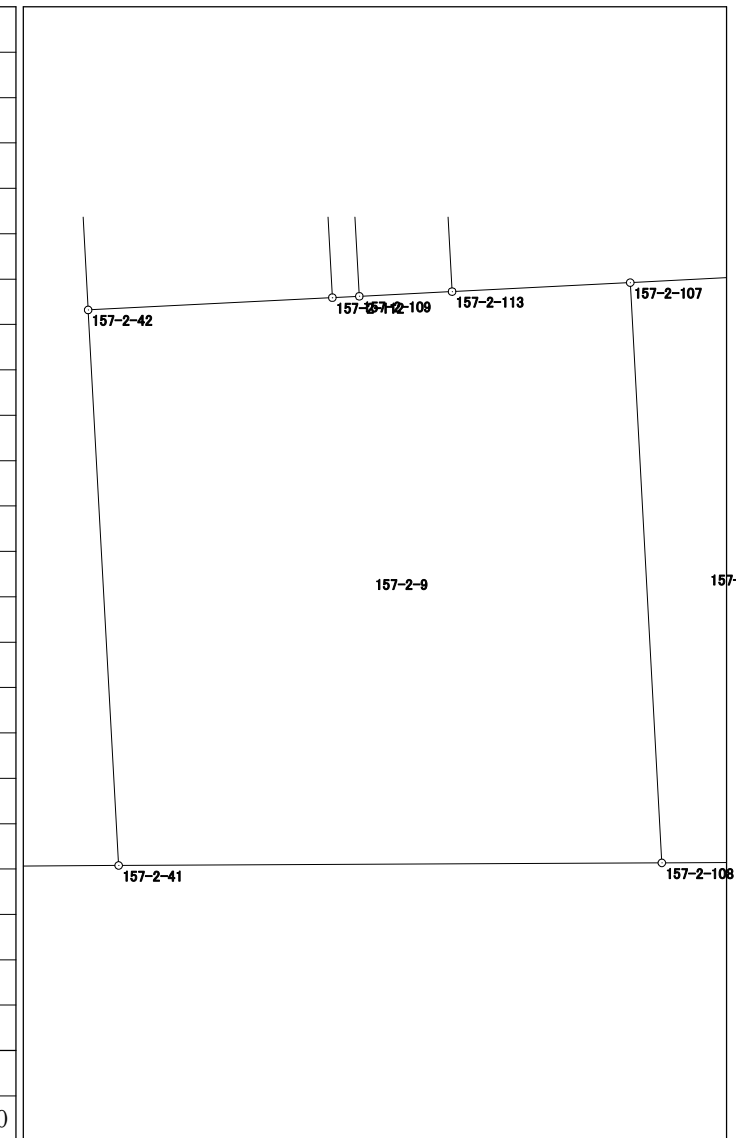


倍面積	329.262886
面積	164.6314430

面積計算書（座標法）

世界測地系（測地成果2011）

所在	地番	公簿地目	現況地目	地積	所有者
前橋市六供町三丁目	157-2-保-1			41.00 m ²	

点名	X座標	Y座標	辺長	方向角	測角	DX	倍積 (Y×DX)
157-2-119	40866.526	-67836.960	9.437	266-53-24	89-59-22	3.828	-259679.882880
157-2-120	40866.014	-67846.383	4.347	176-48-30	89-55-06	-4.852	329190.650316
157-2-117	40861.674	-67846.141	9.430	86-53-15	90-04-45	-3.828	259715.027748
157-2-38	40862.186	-67836.725	4.346	356-54-02	90-00-47	4.852	-329143.789700

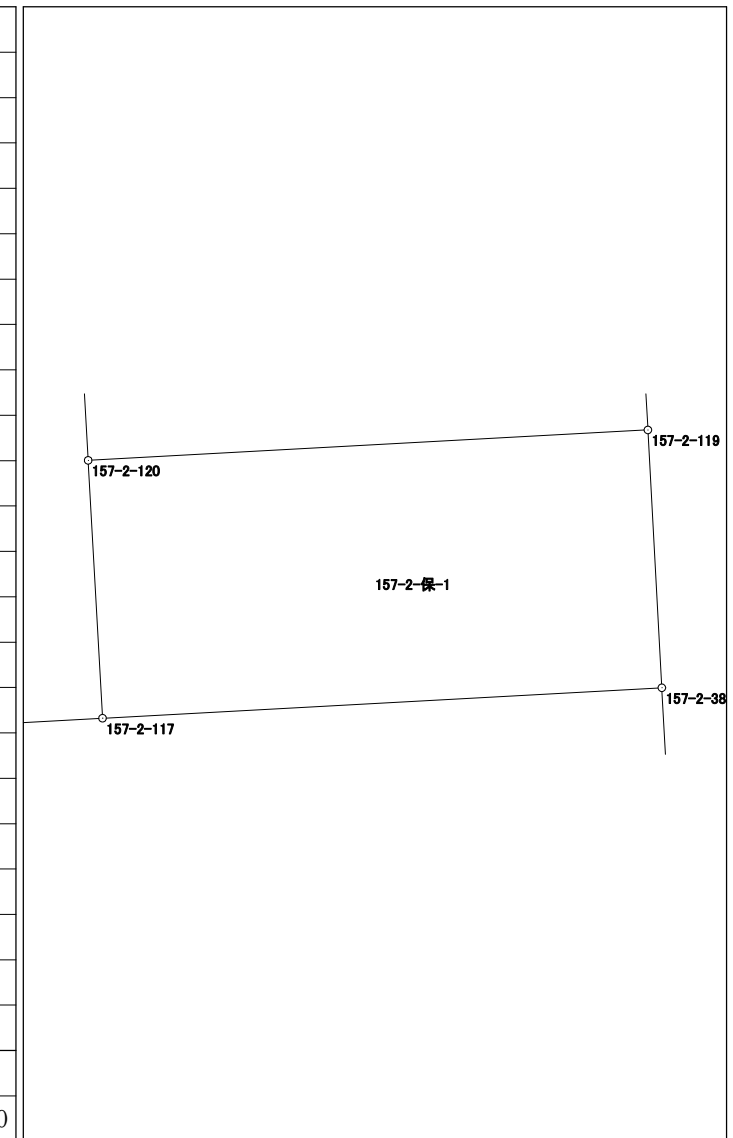


倍面積	82.005484
面積	41.0027420

面積計算書 (座標法)

世界測地系 (測地成果2011)

所 在	地 番	公簿地目	現況地目	地 積	所 有 者
前橋市六供町三丁目	157-2-保-3			40.00 m ²	

点 名	X 座標	Y 座標	辺 長	方 向 角	測 角	DX	倍 積 (Y×DX)
157-2-107	40861.105	-67856.938	13.420	176-52-54	89-46-51	-13.550	919461.509900
157-2-108	40847.705	-67856.208	2.970	89-43-48	92-50-54	-13.386	908323.200288
157-2-106	40847.719	-67853.238	13.556	356-52-45	87-08-57	13.550	-919411.374900
157-2-105	40861.255	-67853.976	2.966	267-06-03	90-13-18	13.386	-908293.322736
倍面積						80.012552	
面 積						40.0062760	

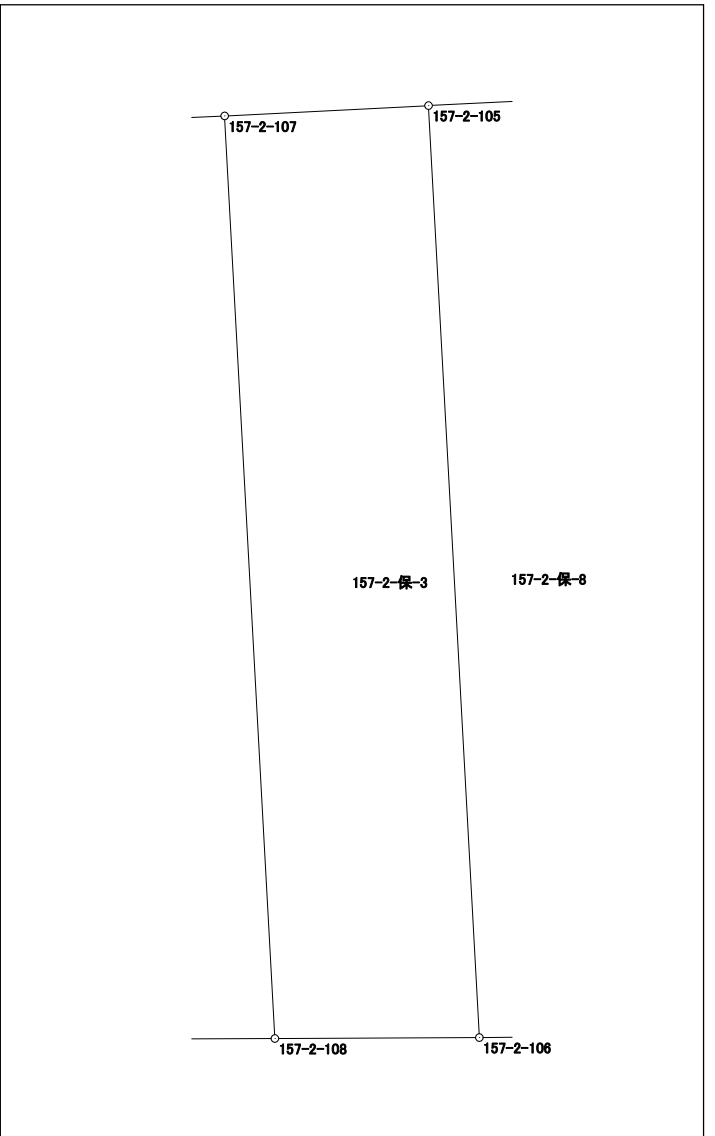


面積計算書 (座標法)

世界測地系 (測地成果2011)

所在	地番	公簿地目	現況地目	地積	所有者
前橋市六供町三丁目	157-2-保-4			14.00 m ²	

点名	X座標	Y座標	辺長	方向角	測角	DX	倍積 (Y×DX)
157-2-115	40861.465	-67849.979	14.501	356-48-50	89-55-16	14.517	-984978.145143
157-2-116	40875.944	-67850.785	0.966	266-54-56	90-06-06	14.427	-978883.275195
157-2-46	40875.892	-67851.750	14.501	176-48-36	89-53-40	-14.531	985953.779250
157-2-47	40861.413	-67850.943	0.264	86-57-52	90-09-16	-14.465	981463.890495
157-2-102	40861.427	-67850.679	0.701	86-53-34	179-55-42	0.052	-3528.235308
						倍面積	28.014099
						面積	14.0070495

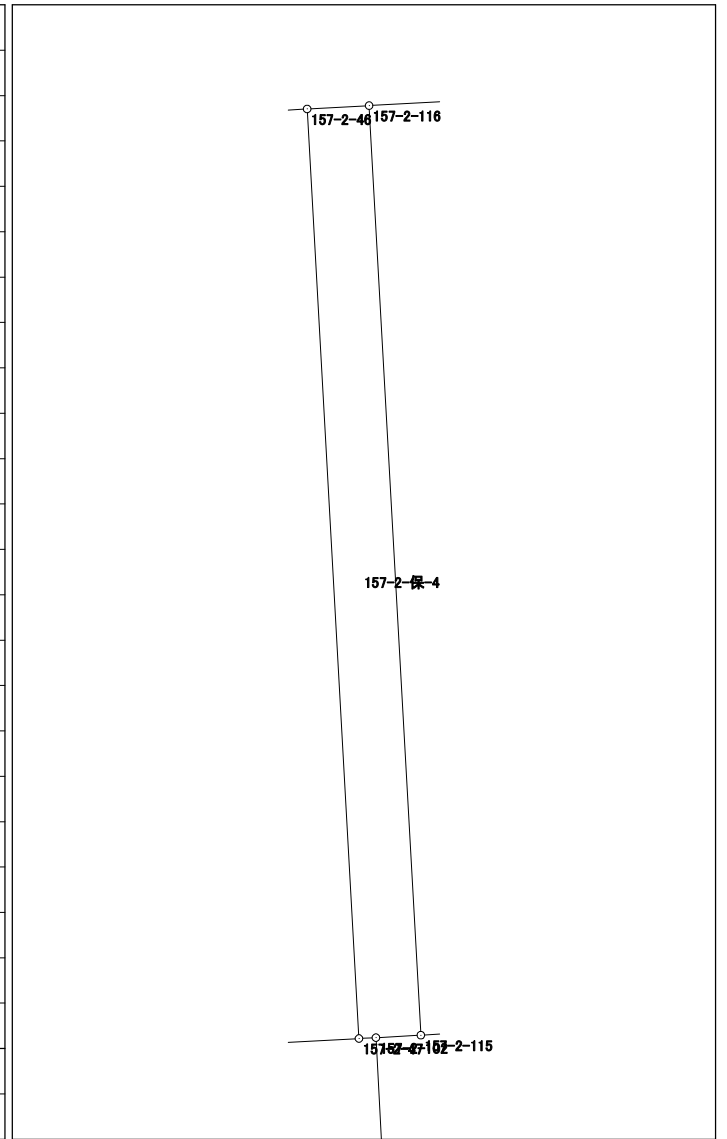


面積計算書 (座標法)

世界測地系 (測地成果2011)

所在	地番	公簿地目	現況地目	地積	所有者
前橋市六供町三丁目	157-2-保-6			9.00 m ²	

点名	X座標	Y座標	辺長	方向角	測角	DX	倍積 (Y×DX)
157-2-111	40875.181	-67864.603	14.443	176-53-18	90-01-02	-14.456	981050.700968
157-2-112	40860.759	-67863.819	0.624	87-09-05	90-15-47	-14.391	976628.219229
157-2-109	40860.790	-67863.196	14.446	356-53-06	89-44-01	14.456	-981030.361376
157-2-110	40875.215	-67863.981	0.623	266-52-16	89-59-10	14.391	-976630.550571

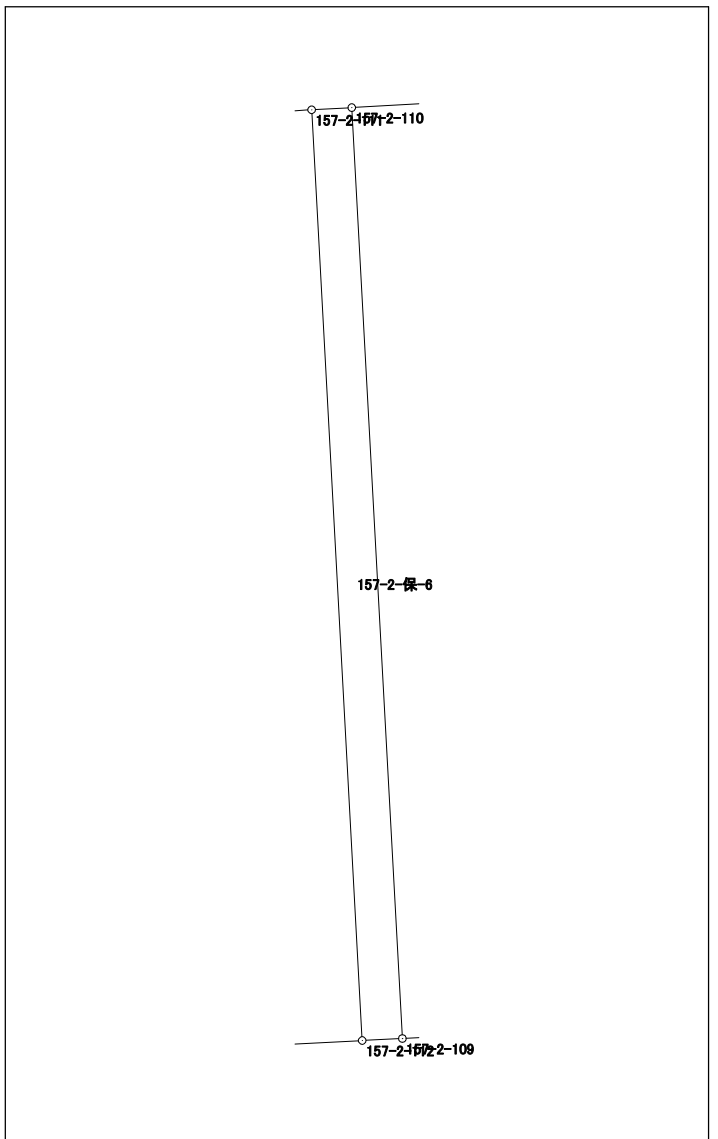


倍面積	18.008250
面積	9.0041250

面積計算書 (座標法)

世界測地系 (測地成果2011)

所在	地番	公簿地目	現況地目	地積	所有者
前橋市六供町三丁目	157-2-保-7			22.50 m ²	

点名	X座標	Y座標	辺長	方向角	測角	DX	倍積 (Y×DX)
157-2-104	40851.947	-67850.162	9.494	356-52-42	180-00-14	13.692	-929004.418104
157-2-102	40861.427	-67850.679	0.264	266-57-52	90-05-10	9.466	-642274.527414
157-2-47	40861.413	-67850.943	1.382	266-53-21	179-55-29	-0.089	6038.733927
157-2-54	40861.338	-67852.323	13.631	176-52-32	89-59-11	-13.686	928626.892578
157-2-55	40847.727	-67851.580	1.648	89-43-19	92-50-47	-13.603	922985.042740
157-2-101	40847.735	-67849.932	4.218	356-52-28	87-09-09	4.220	-286326.713040

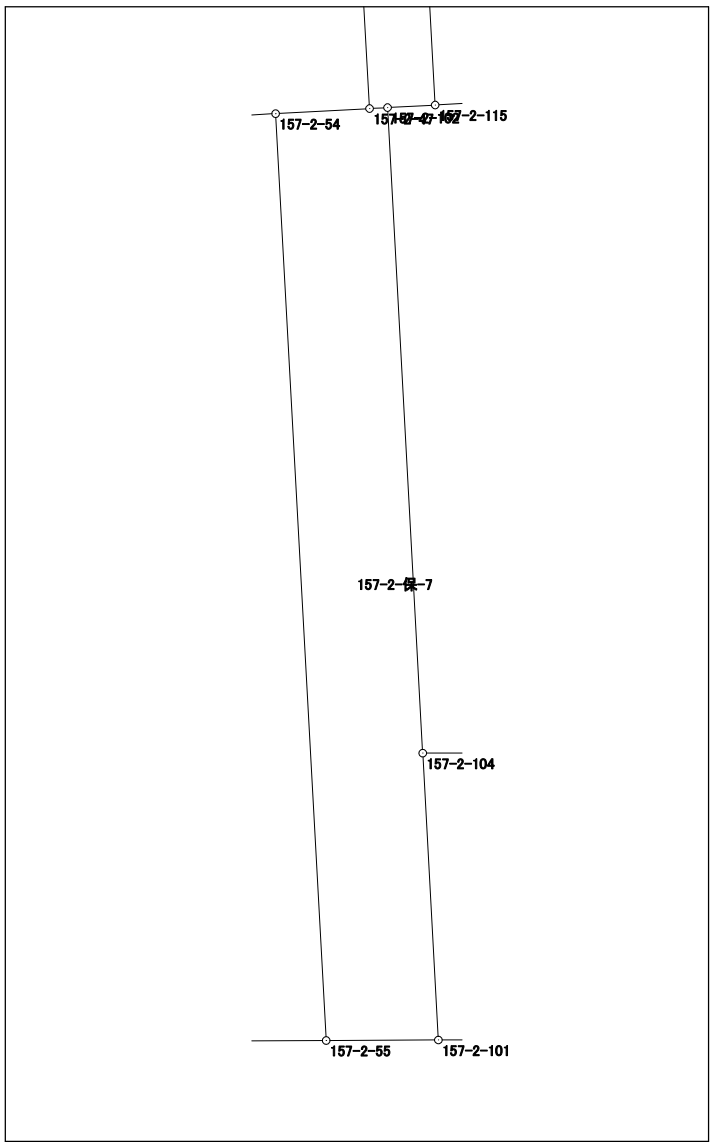

倍面積	45.010687
面積	22.5053435

面積計算書（座標法）

世界測地系（測地成果2011）

所 在	地 番	公簿地目	現況地目	地 積	所 有 者
前橋市六供町三丁目	157-2-保-8			22.50 m ²	

点 名	X 座標	Y 座標	辺 長	方 向 角	測 角	DX	倍 積 (Y×DX)
157-2-105	40861.255	-67853.976	13.556	176-52-45	89-45-13	-13.619	924103.299144
157-2-106	40847.719	-67853.238	1.658	89-43-25	92-50-40	-13.528	917918.603664
157-2-55	40847.727	-67851.580	13.631	356-52-32	87-09-07	13.619	-924070.668020
157-2-54	40861.338	-67852.323	1.655	267-07-32	90-15-00	13.528	-917906.225544
						倍面積	45.009244
						面 積	22.5046220

