



45-1街区 画地出来形確認図 (6157.89㎡)
 45-2街区 (967.42㎡)

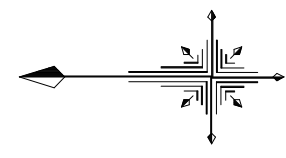

S=1/500

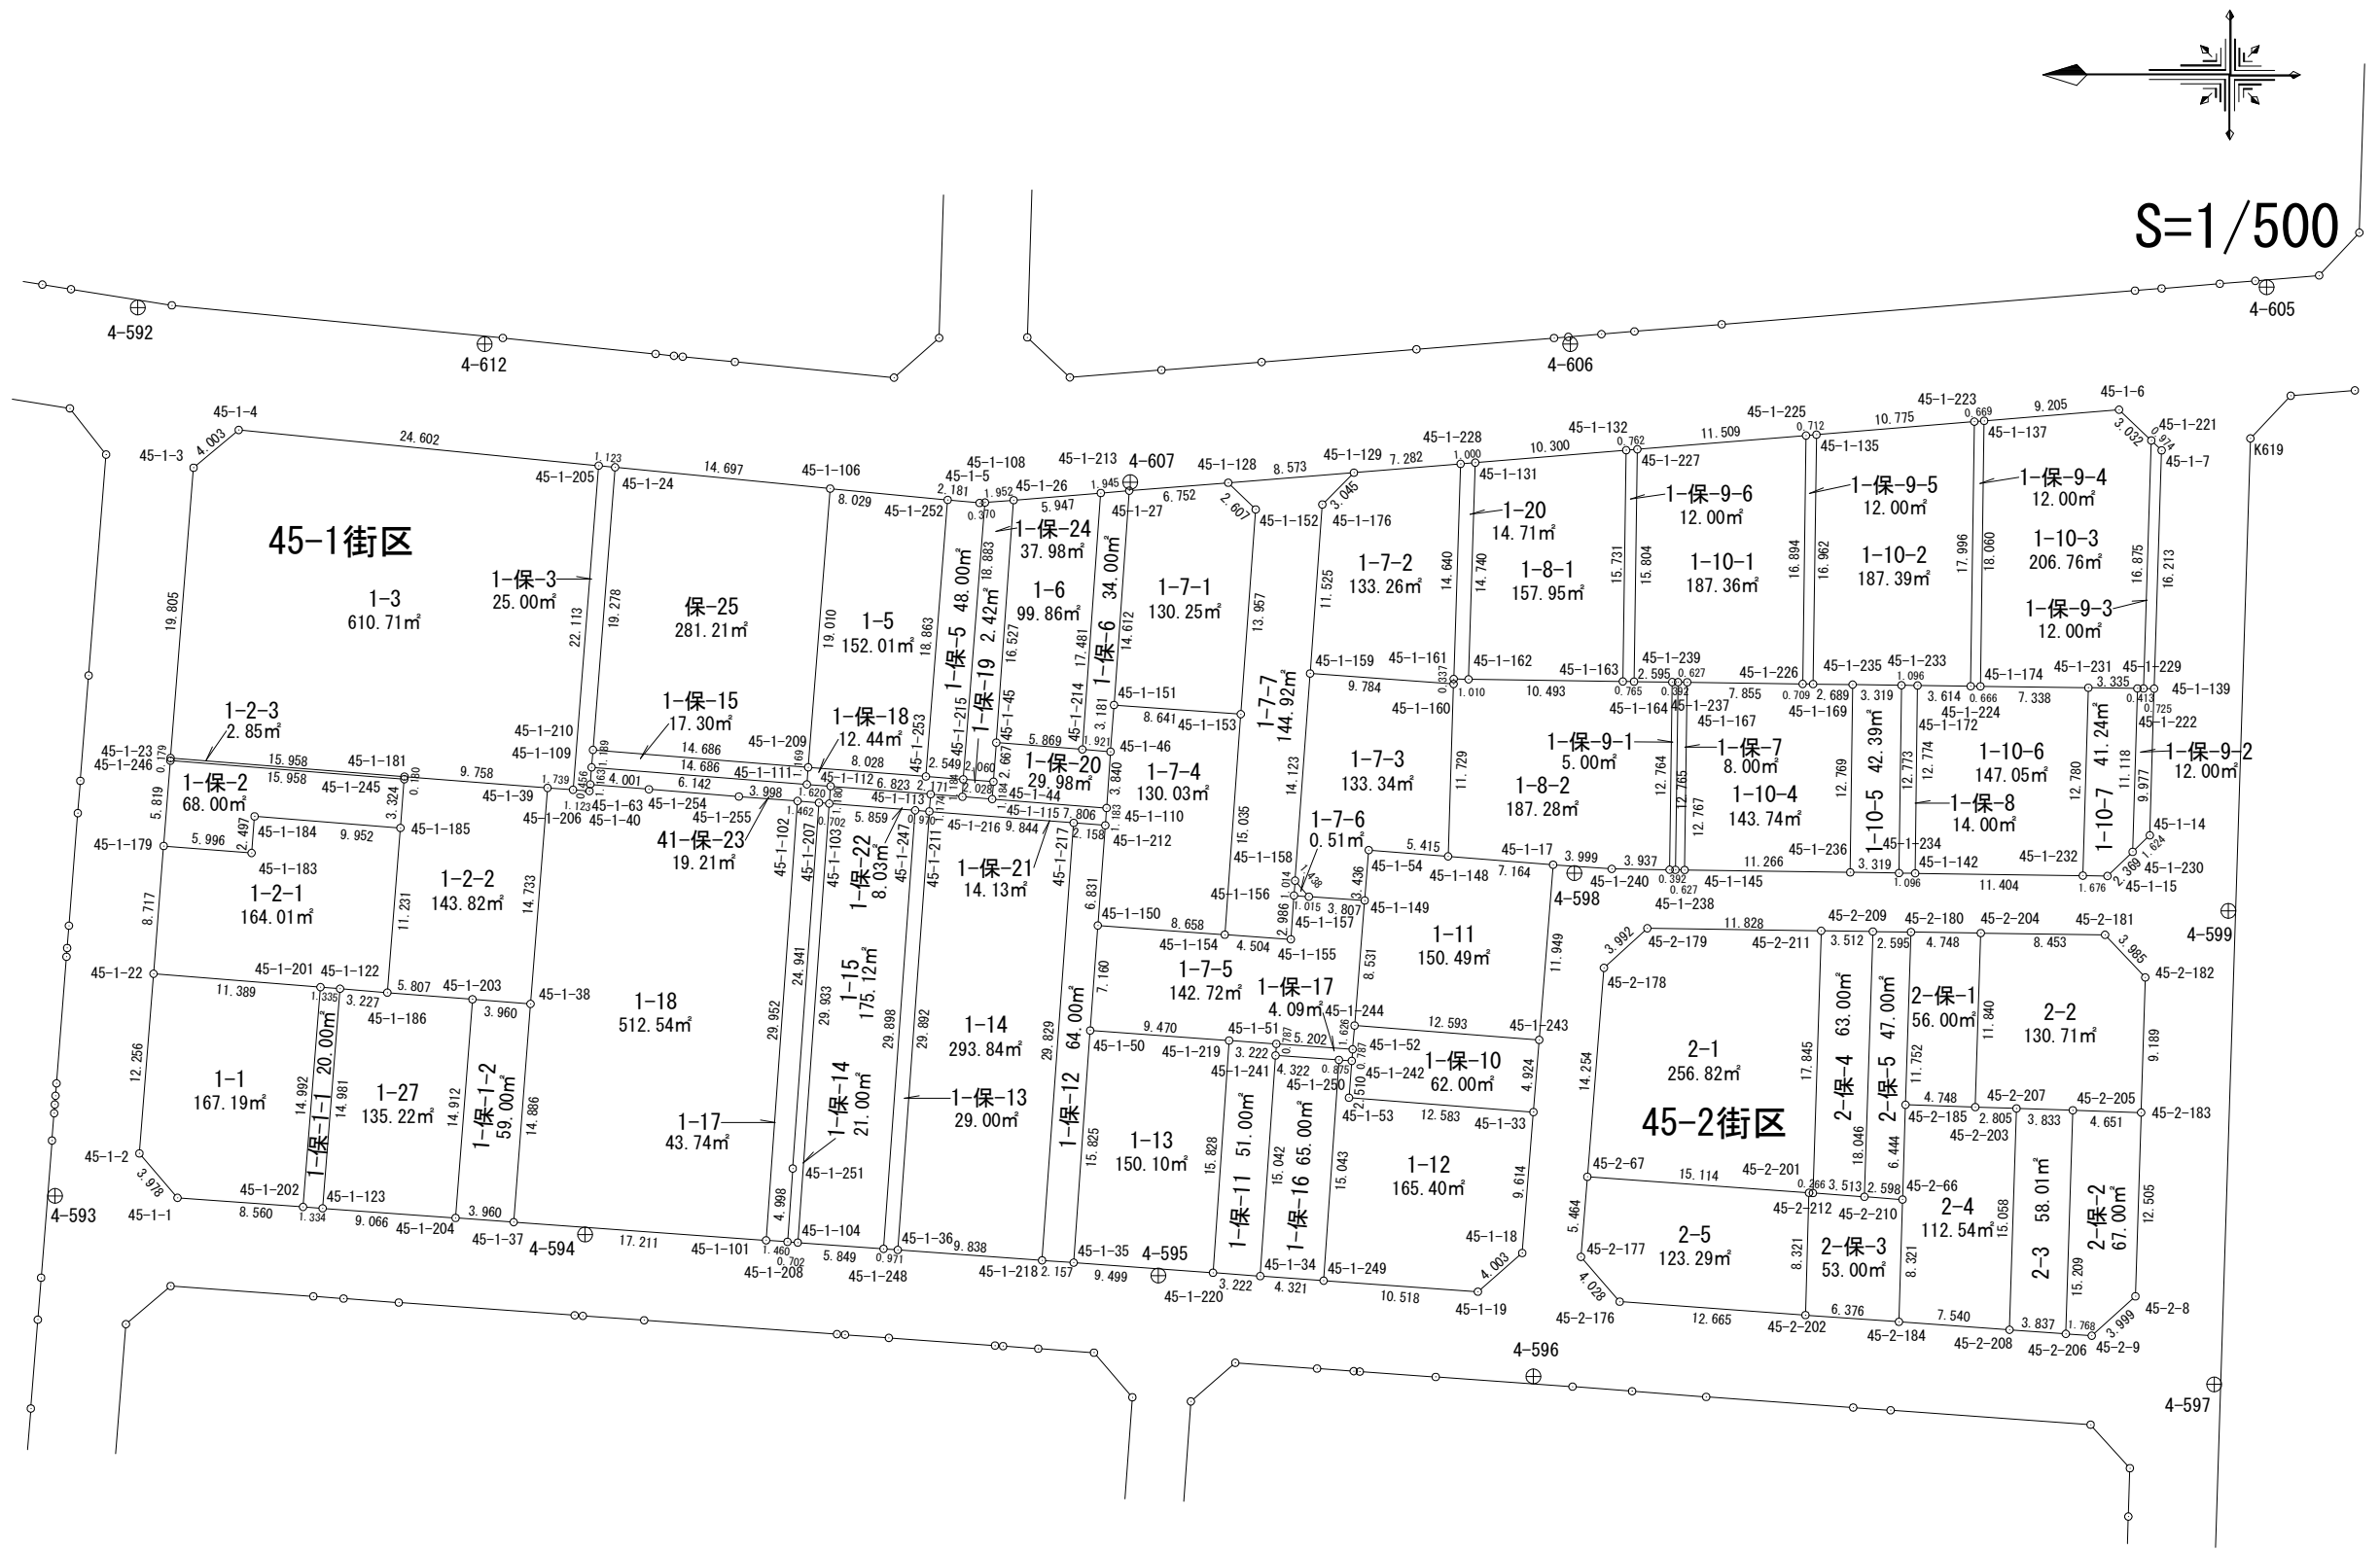


面積計算書 (座標法)

世界測地系 (測地成果2011)

所 在	地 番	公簿地目	現況地目	地 積	所 有 者
前橋市六供町二丁目	45-2-1			256.82 m ²	

点 名	X 座標	Y 座標	辺 長	方 向 角	測 角	DX	倍 積 (Y×DX)
45-2-211	41305.946	-68581.148	11.828	0-49-25	89-00-33	11.262	-772360.888776
45-2-179	41317.773	-68580.978	3.992	317-36-34	136-47-09	14.775	-1013283.949950
45-2-178	41320.721	-68583.669	14.254	274-32-49	136-56-15	4.078	-279684.202182
45-2-67	41321.851	-68597.878	15.114	184-07-27	89-34-38	-13.945	956597.408710
45-2-201	41306.776	-68598.965	0.266	184-06-04	179-58-37	-15.340	1052308.123100
45-2-212	41306.511	-68598.984	17.845	91-48-52	87-42-48	-0.830	56937.156720

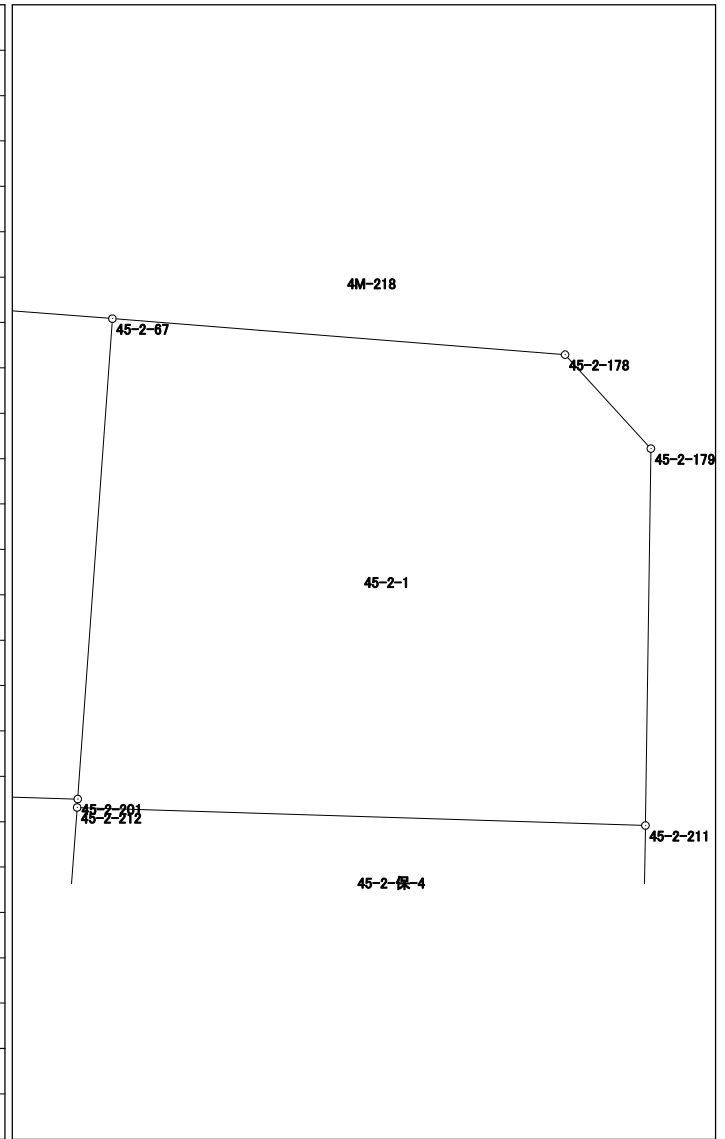


倍面積	513.647622
面積	256.8238110

面積計算書 (座標法)

世界測地系 (測地成果2011)

所 在	地 番	公簿地目	現況地目	地 積	所 有 者
前橋市六供町二丁目	45-2-2			130.71 m ²	

点 名	X 座標	Y 座標	辺 長	方 向 角	測 角	DX	倍 積 (Y×DX)
45-2-203	41295.469	-68593.137	2.805	181-54-01	90-04-15	-2.425	166338.357225
45-2-207	41292.666	-68593.230	3.833	181-52-08	179-58-07	-6.634	455047.487820
45-2-205	41288.835	-68593.355	4.651	181-52-21	180-00-13	-8.480	581671.650400
45-2-183	41284.186	-68593.507	9.189	91-44-23	89-52-02	-4.928	338028.802496
45-2-182	41283.907	-68584.322	3.985	46-43-06	134-58-43	2.453	-168237.341866
45-2-181	41286.639	-68581.421	8.453	0-48-00	134-04-54	11.184	-767014.612464
45-2-204	41295.091	-68581.303	11.840	271-49-46	91-01-46	8.830	-605572.905490
						倍面積	261.438121
						面 積	130.7190605

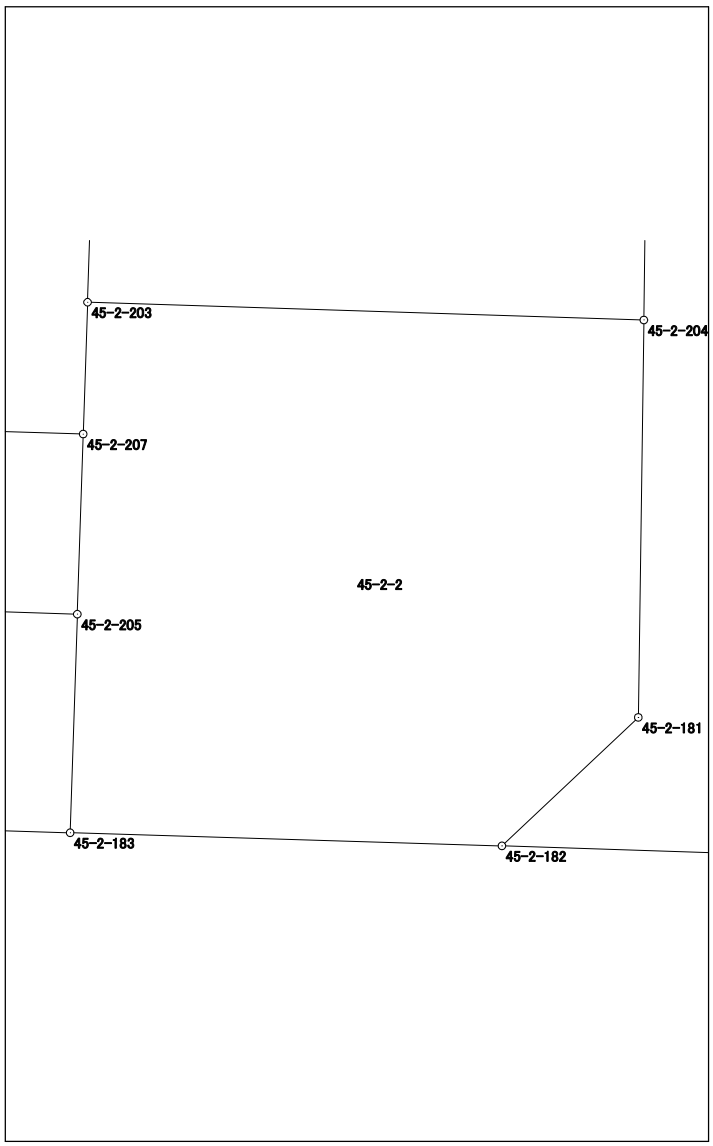


面積計算書（座標法）

世界測地系（測地成果2011）

所在	地番	公簿地目	現況地目	地積	所有者
前橋市六供町二丁目	45-2-3			58.01 m ²	

点名	X座標	Y座標	辺長	方向角	測角	DX	倍積 (Y×DX)
45-2-206	41289.310	-68608.557	15.209	91-47-23	87-39-53	-4.302	295154.012214
45-2-205	41288.835	-68593.355	3.833	1-52-08	90-04-45	3.356	-230199.299380
45-2-207	41292.666	-68593.230	15.058	271-47-33	89-55-25	4.302	-295088.075460
45-2-208	41293.137	-68608.281	3.837	184-07-30	92-19-57	-3.356	230249.391036

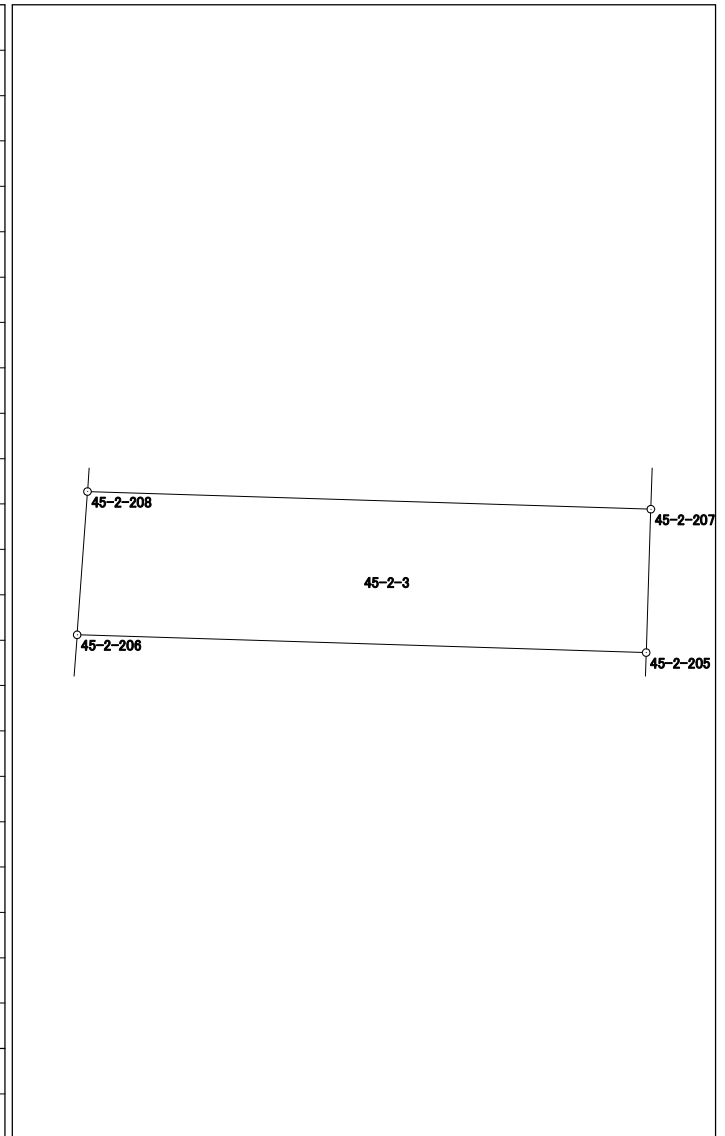


倍面積	116.028410
面積	58.0142050

面積計算書 (座標法)

世界測地系 (測地成果2011)

所在	地番	公簿地目	現況地目	地積	所有者
前橋市六供町二丁目	45-2-5			123.29 m ²	

点名	X座標	Y座標	辺長	方向角	測角	DX	倍積 (Y×DX)
45-2-201	41306.776	-68598.965	15.114	4-07-27	92-27-27	14.833	-1017528.447845
45-2-67	41321.851	-68597.878	5.464	274-33-20	90-25-53	15.509	-1063884.489902
45-2-177	41322.285	-68603.325	4.028	229-08-17	134-34-57	-2.201	150995.918325
45-2-176	41319.650	-68606.371	12.665	184-07-30	134-59-13	-15.267	1047413.466057
45-2-202	41307.018	-68607.282	8.321	91-40-00	87-32-30	-12.874	883250.148468
						倍面積	246.595103
						面積	123.297515

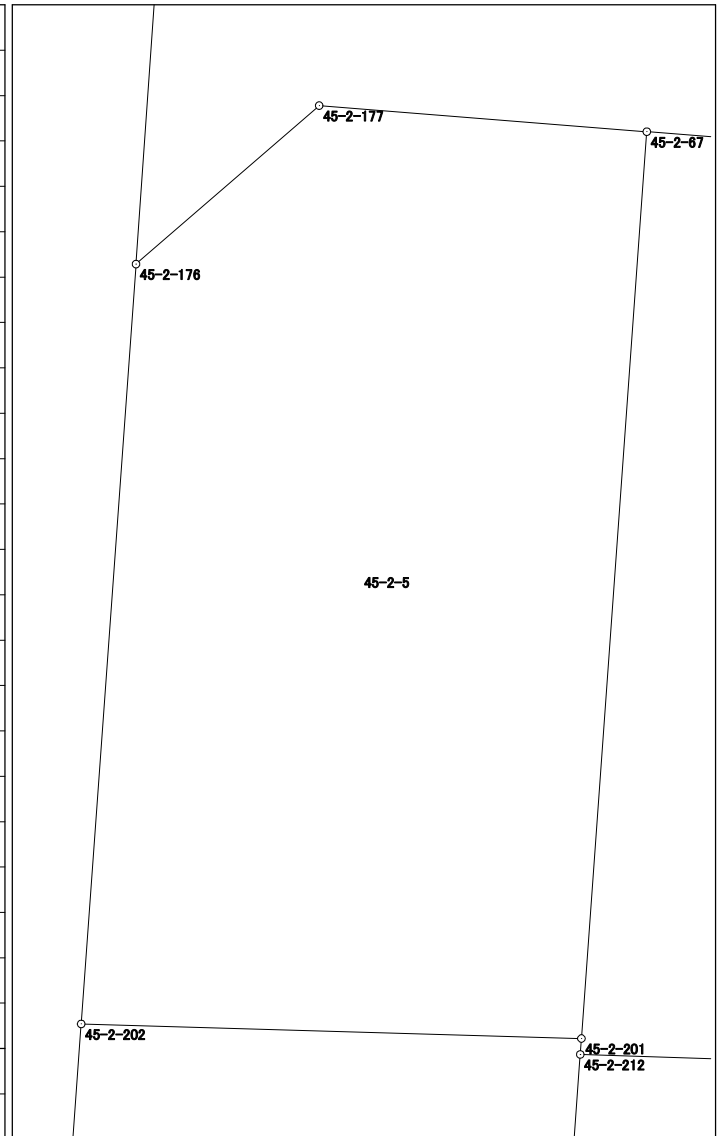


面積計算書 (座標法)

世界測地系 (測地成果2011)

所 在	地 番	公簿地目	現況地目	地 積	所 有 者
前橋市六供町二丁目	45-2-保-2			67.00 m ²	

点 名	X 座標	Y 座標	辺 長	方 向 角	測 角	DX	倍 積 (Y×DX)
45-2-8	41284.577	-68606.006	12.505	91-47-30	133-49-56	-3.361	230584.786166
45-2-183	41284.186	-68593.507	4.651	1-52-21	90-04-51	4.258	-292071.152806
45-2-205	41288.835	-68593.355	15.209	271-47-23	89-55-02	5.124	-351472.351020
45-2-206	41289.310	-68608.557	1.768	184-07-13	92-19-50	-1.288	88367.821416
45-2-9	41287.547	-68608.684	3.999	137-57-34	133-50-21	-4.733	324724.901372

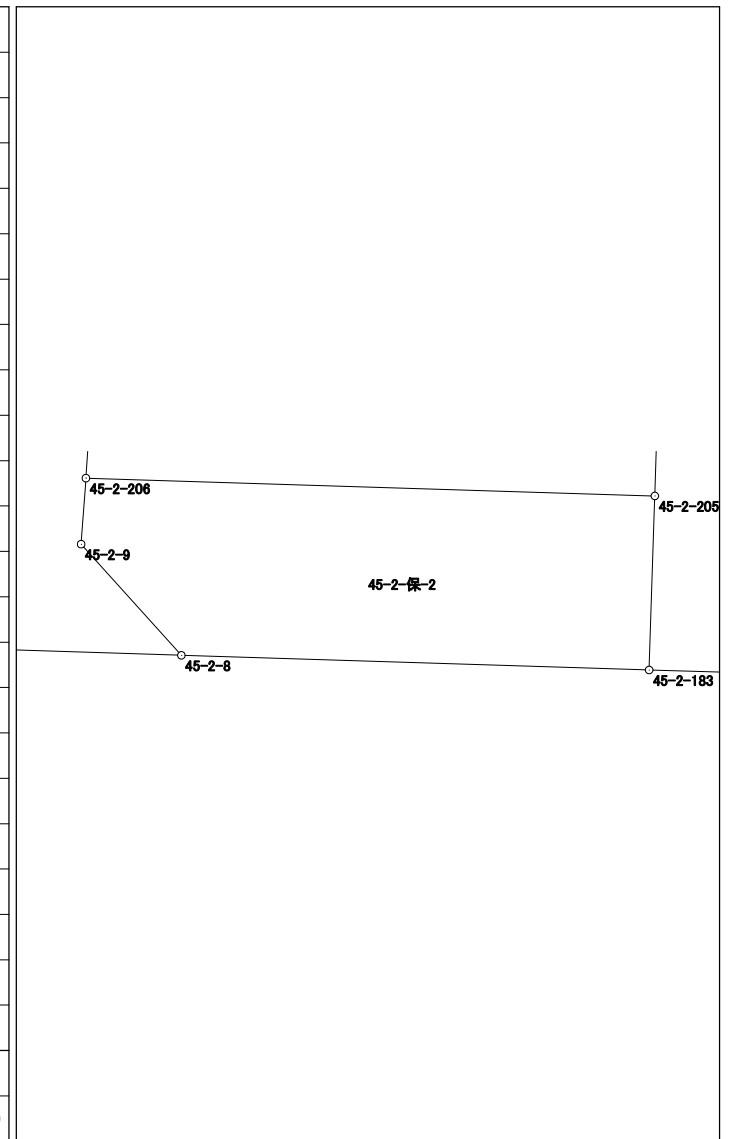


面積計算書 (座標法)

世界測地系 (測地成果2011)

所在	地番	公簿地目	現況地目	地積	所有者
前橋市六供町二丁目	45-2-保-3			53.00 m ²	

点名	X 座標	Y 座標	辺長	方向角	測角	DX	倍積 (Y×DX)
45-2-184	41300.658	-68607.740	8.321	91-40-00	87-32-52	-6.602	452948.299480
45-2-66	41300.416	-68599.423	2.598	4-07-41	92-27-41	2.349	-161140.044627
45-2-210	41303.007	-68599.236	3.513	4-06-49	179-59-08	6.095	-418112.343420
45-2-212	41306.511	-68598.984	0.266	4-06-04	179-59-15	3.769	-258549.570696
45-2-201	41306.776	-68598.965	8.321	271-40-00	87-33-56	0.507	-34779.675255
45-2-202	41307.018	-68607.282	6.376	184-07-08	92-27-08	-6.118	419739.351276

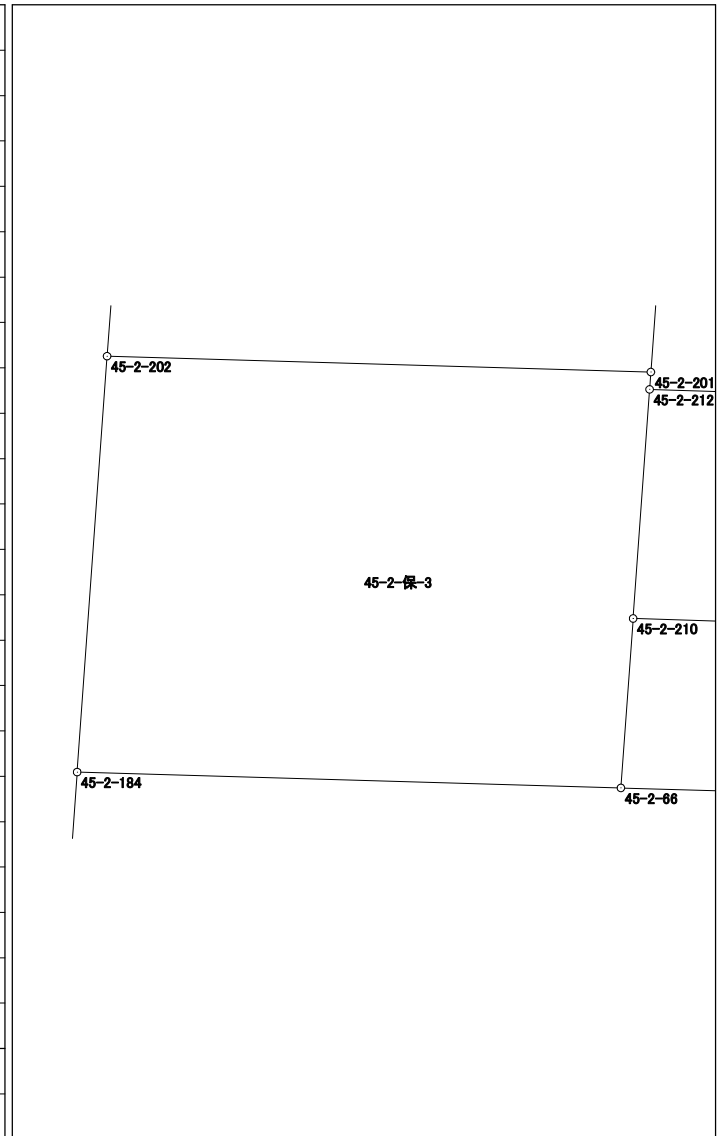


倍面積	106.016758
面積	53.0083790

面積計算書（座標法）

世界測地系（測地成果2011）

所 在	地 番	公簿地目	現況地目	地 積	所 有 者
前橋市六供町二丁目	45-2-保-4			63.00 m ²	

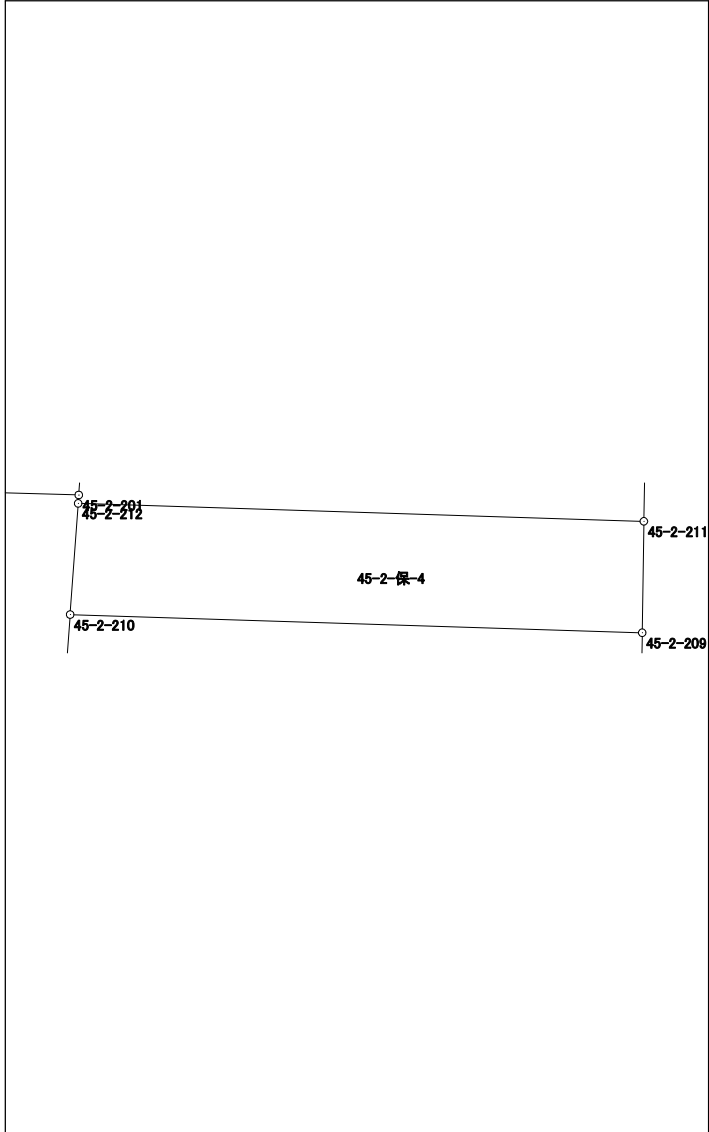点 名	X 座標	Y 座標	辺 長	方 向 角	測 角	DX	倍 積 (Y×DX)		
45-2-209	41302.434	-68581.199	3.512	0-49-55	89-00-45	2.939	-201560.143861		
45-2-211	41305.946	-68581.148	17.845	271-48-52	90-58-57	4.077	-279605.340396		
45-2-212	41306.511	-68598.984	3.513	184-06-49	92-17-57	-2.939	201612.413976		
45-2-210	41303.007	-68599.236	18.046	91-49-10	87-42-21	-4.077	279679.085172		
							倍面積		126.014891
							面 積		63.0074455

面積計算書 (座標法)

世界測地系 (測地成果2011)

所在	地番	公簿地目	現況地目	地積	所有者
前橋市六供町二丁目	45-2-保-5			47.00 m ²	

点名	X座標	Y座標	辺長	方向角	測角	DX	倍積 (Y×DX)
45-2-66	41300.416	-68599.423	6.444	91-47-47	87-40-06	-2.793	191598.188439
45-2-185	41300.214	-68592.982	11.752	91-49-43	180-01-56	-0.577	39578.150614
45-2-180	41299.839	-68581.236	2.595	0-49-01	88-59-18	2.220	-152250.343920
45-2-209	41302.434	-68581.199	18.046	271-49-10	91-00-09	3.168	-217265.238432
45-2-210	41303.007	-68599.236	2.598	184-07-41	92-18-31	-2.018	138433.258248
						倍面積	94.014949
						面積	47.0074745

