



4-347
⊕

8 3 街区 画地出来形確認図 (13782.21m²)

3-8
⊕

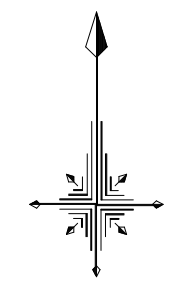

S=1/500

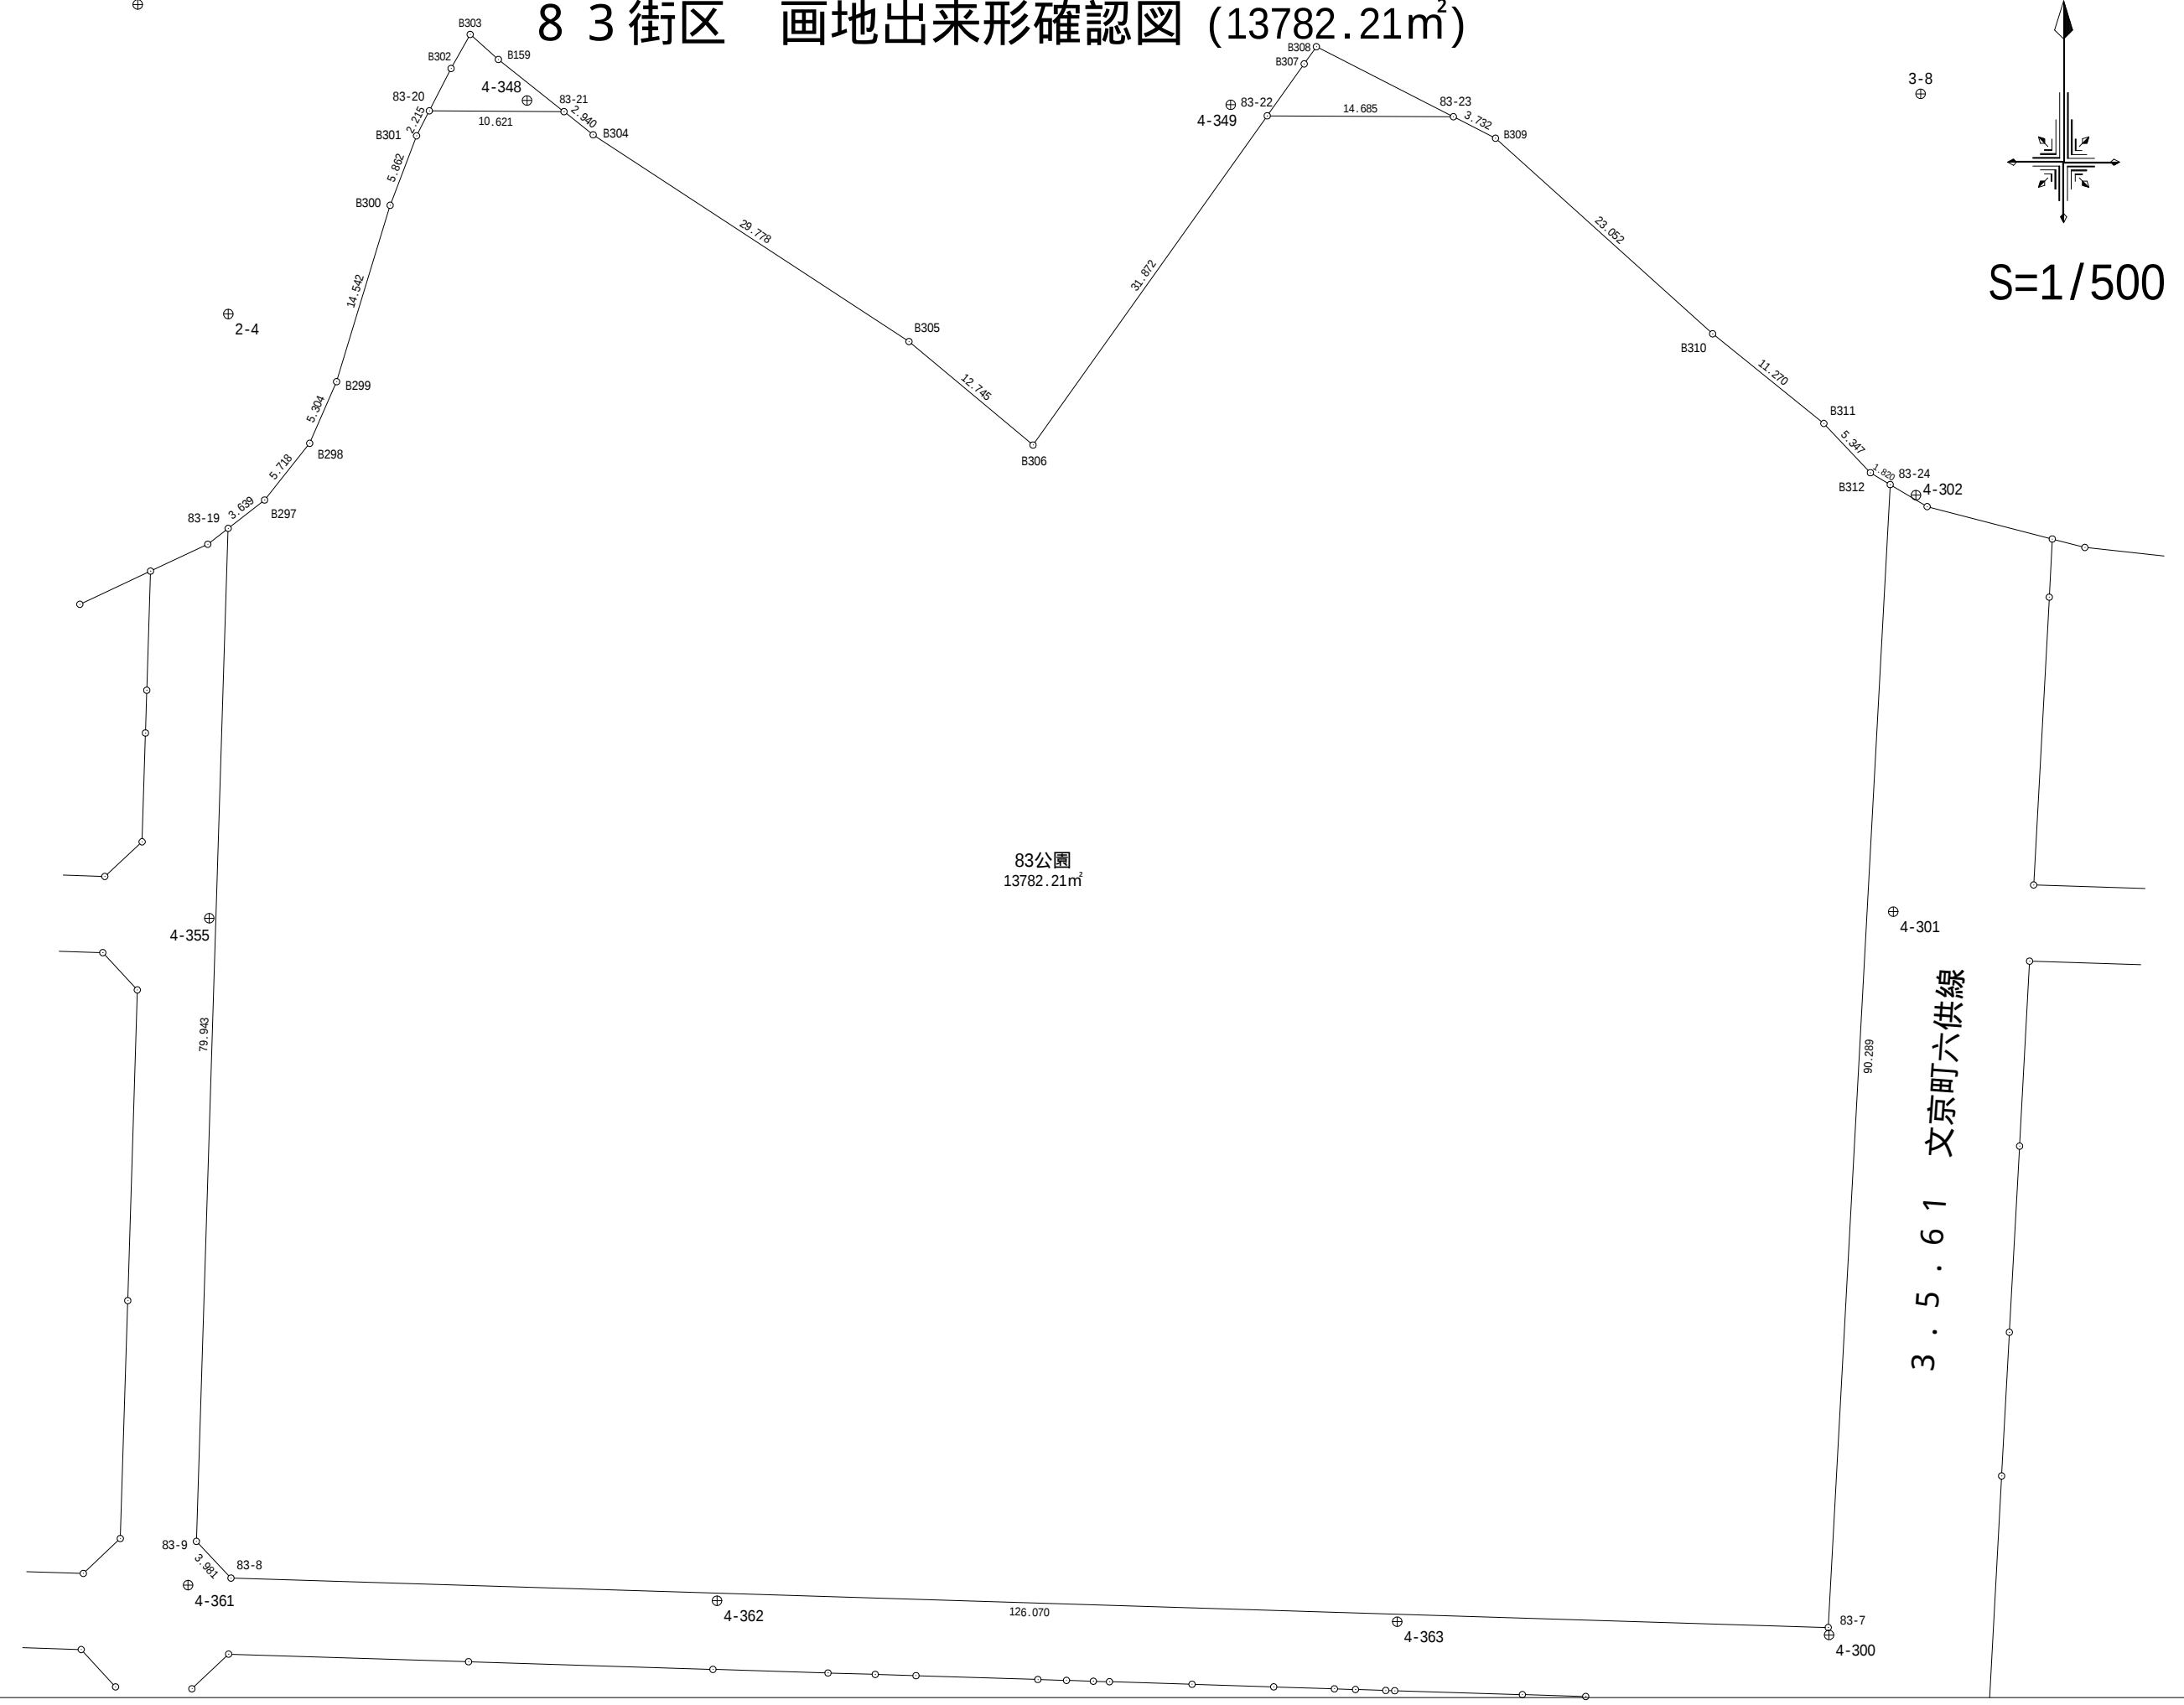

⊕
2-4

⊕
4-355

⊕
4-361

⊕
4-362

⊕
4-363

⊕
4-300

⊕
4-301

3・5・6 1 文京町六供線

面積計算書（座標法）

世界測地系（測地成果2011）

所 在	地 番	公簿地目	現況地目	地 積	所 有 者
前橋市六供町四丁目	83-公園			13782.21 m ²	

点 名	X 座標	Y 座標	辺 長	方 向 角	測 角	DX	倍 積 (Y×DX)
83-9	41519.550	-67677.491	3.981	136-42-35	134-54-38	-82.802	5603831.609782
83-8	41516.652	-67674.761	126.070	91-46-19	135-03-44	-6.796	459917.675756
83-7	41512.754	-67548.751	90.289	3-06-17	91-19-58	86.258	-5826620.163758
83-24	41602.910	-67543.861	1.820	300-50-03	117-43-46	91.089	-6152502.754629
B312	41603.843	-67545.424	5.347	316-39-08	195-49-05	4.821	-325636.489104
B311	41607.731	-67549.094	11.270	308-50-41	172-11-33	10.957	-740135.422958
B310	41614.800	-67557.872	23.052	312-00-39	183-09-58	22.497	-1519849.446384
B309	41630.228	-67575.000	3.732	297-03-59	165-03-20	17.126	-1157289.450000
83-23	41631.926	-67578.323	14.685	270-16-51	153-12-52	1.770	-119613.631710
83-22	41631.998	-67593.008	31.872	215-25-46	125-08-55	-25.898	1750523.721184
B306	41606.028	-67611.484	12.745	309-49-04	274-23-18	-17.809	1204092.918556
B305	41614.189	-67621.273	29.778	303-12-45	173-23-41	24.472	-1654827.792856
B304	41630.500	-67646.187	2.940	308-28-05	185-15-20	18.140	-1227101.832180
83-21	41632.329	-67648.489	10.621	270-20-04	141-51-59	1.891	-127923.292699
83-20	41632.391	-67659.110	2.215	207-09-18	116-49-14	-1.909	129161.240990
B301	41630.420	-67660.121	5.862	200-47-38	173-38-20	-7.451	504135.561571
B300	41624.940	-67662.202	14.542	196-53-41	176-06-03	-19.394	1312240.745588
B299	41611.026	-67666.428	5.304	203-34-08	186-40-27	-18.776	1270504.852128
B298	41606.164	-67668.549	5.718	218-31-03	194-56-55	-9.336	631753.573464
B297	41601.690	-67672.110	3.639	232-05-16	193-34-13	-6.710	454079.858100
83-19	41599.454	-67674.981	79.943	181-47-57	129-42-41	-82.140	5558822.939340

倍面積	27564.420181
面 積	13782.2100905

