



18街区 画地出来形確認図 (6776.39m²)

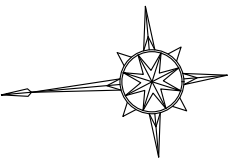


S=1:500

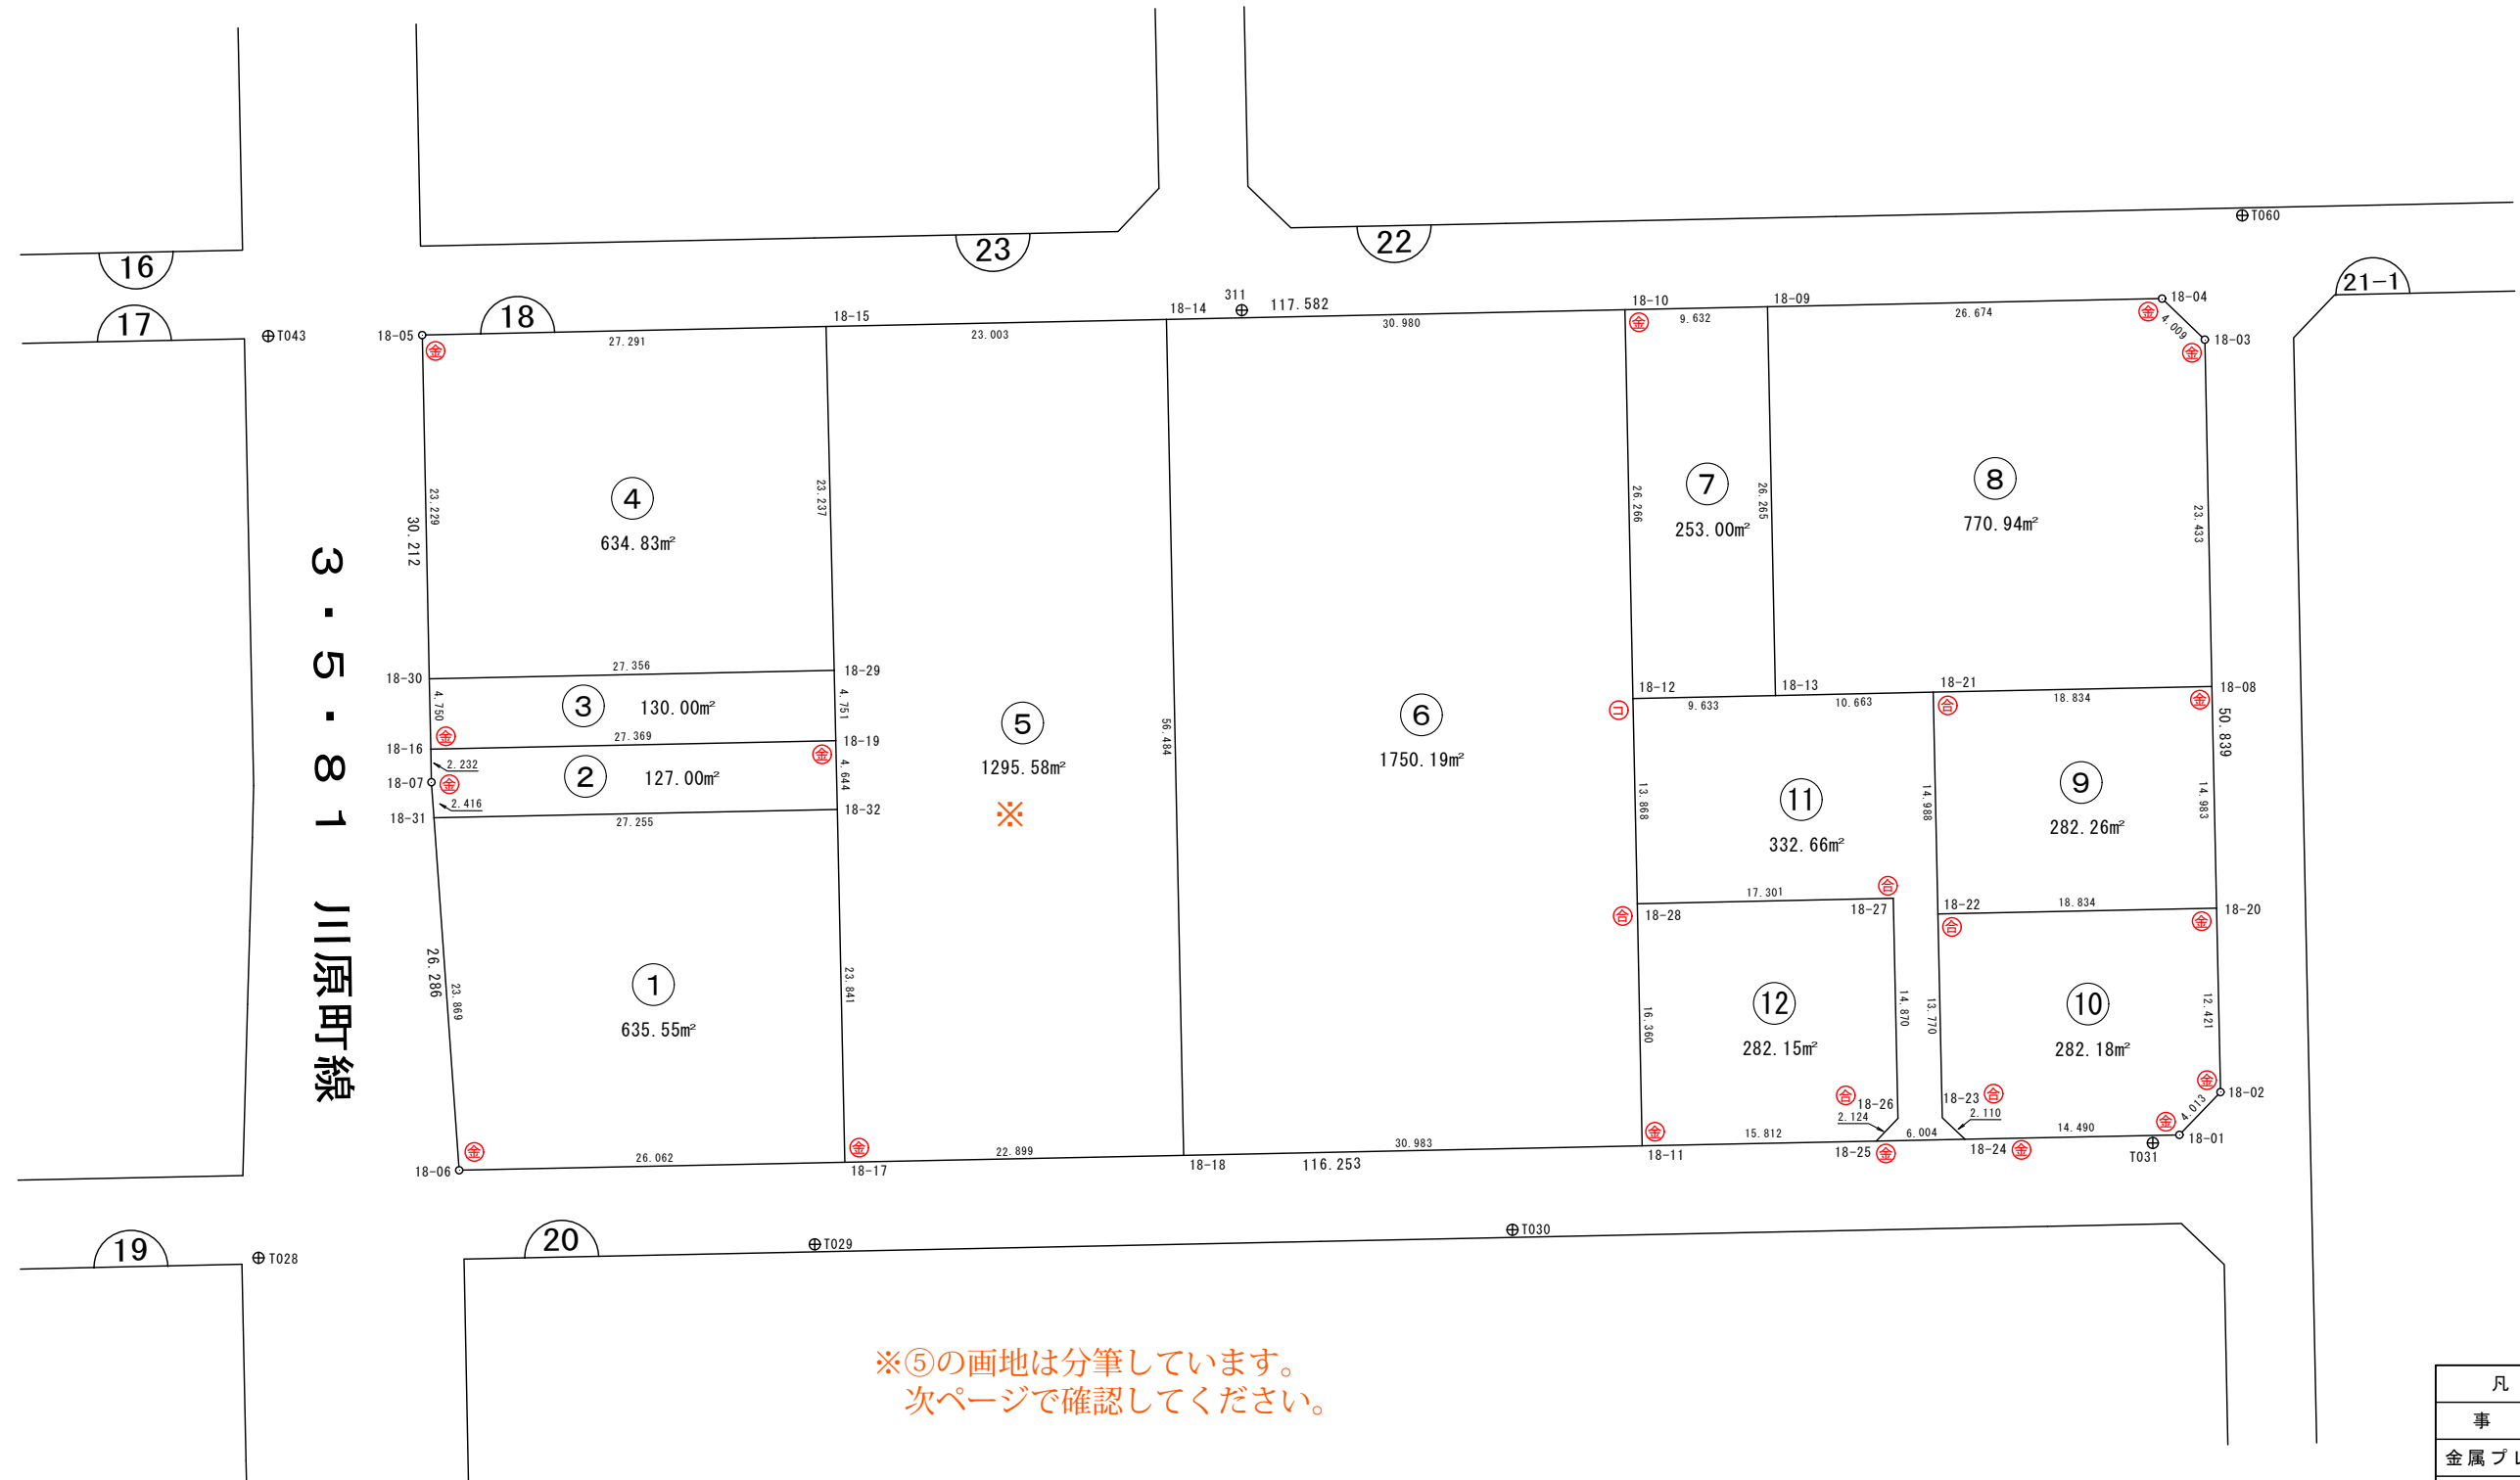


※⑤の画地は分筆しています。
次ページで確認してください。

凡 例	
事 項	記 号
金属プレート	⊕
コンクリート杭	⊖
金属 鈹	⊗
合成樹脂杭	⊙
マーキング	⊚

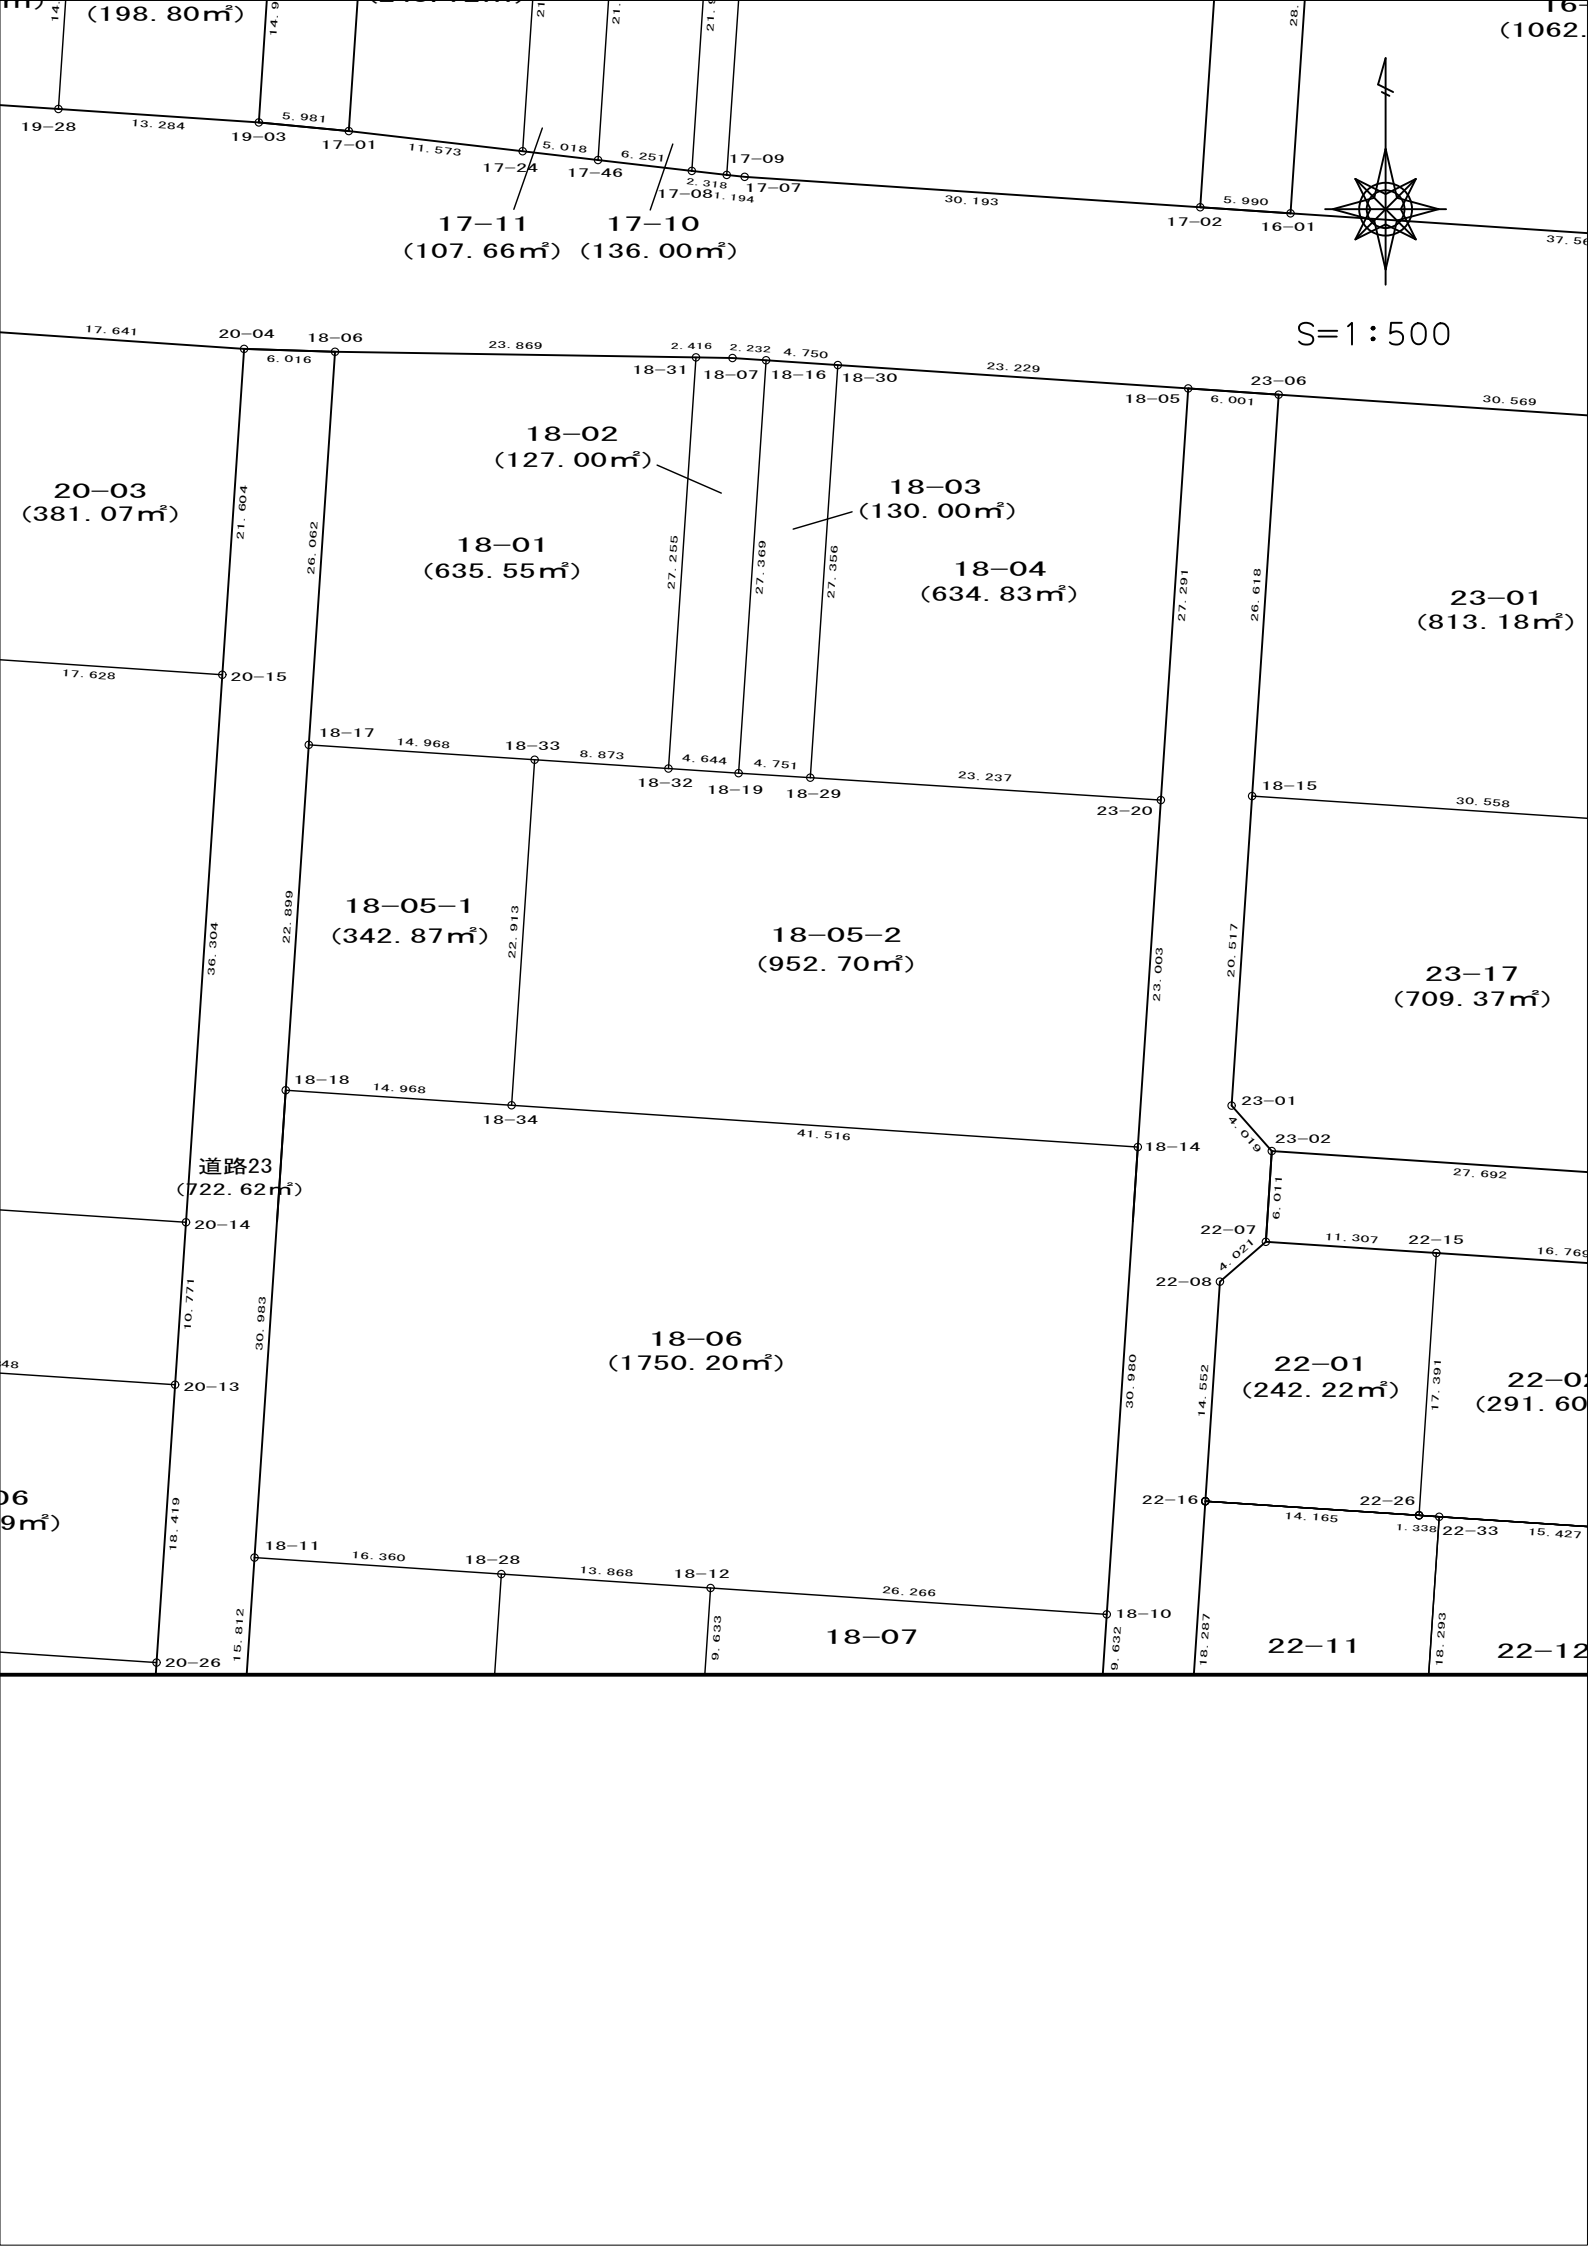

16 (1062.00m²)

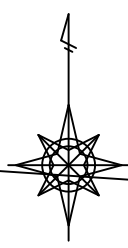

S=1:500

17-11 (107.66m²) 17-10 (136.00m²)

19-28 13.284 19-03 5.981 17-01 11.573 17-24 5.018 17-46 6.251 17-09 2.318 17-07 17-08 1.194 30.193 17-02 5.990 16-01 28. 37.56

17.641 20-04 6.016 18-06 23.869 2.416 2.232 4.750 18-31 18-07 18-16 18-30 23.229 18-05 6.001 23-06 30.569

20-03 (381.07m²)

18-02 (127.00m²)

18-03 (130.00m²)

18-01 (635.55m²)

18-04 (634.83m²)

23-01 (813.18m²)

17.628 20-15

18-17 14.968 18-33 8.873 4.644 4.751 18-32 18-19 18-29 23.237 23-20

18-05-1 (342.87m²)

18-05-2 (952.70m²)

23-17 (709.37m²)

道路23 (722.62m²)

20-14 10.771 30.983

18-15 30.558 23-01 4.019 23-02 27.692 18-14 6.011 22-07 11.307 22-15 16.766

18-06 (1750.20m²)

22-01 (242.22m²)

22-02 (291.60m²)

20-13 18.419 30.983

18-11 16.360 18-28 13.868 18-12 26.266 18-10 9.632 18-07 18-10 9.632 22-16 14.165 22-26 1.338 22-33 15.427

22-11

22-12

06 (9m²)

20-26 15.812

18.287 18.293 17.391

画地面積(座標法)計算簿

画地番号：18-01

点名	X _n	Y _n	距離	方向角	X _{n+1} -X _{n-1}	Y _{n+1} -Y _{n-1}	X _n *(Y _{n+1} -Y _{n-1})	Y _n *(X _{n+1} -X _{n-1})
18-32	47945.546	-71341.674	27.255	3° 48' 51"	26.613	10.667	511435.139182	-1898615.970162
18-31	47972.741	-71339.861	23.869	270° 53' 52"	27.569	-22.054	-1057990.830014	-1966768.627909
18-06	47973.115	-71363.728	26.062	183° 49' 09"	-25.631	-25.603	-1228255.663345	1829123.712368
18-17	47947.110	-71365.464	14.968	93° 45' 42"	-26.987	13.200	632901.852000	1925939.776968
18-33	47946.128	-71350.528	8.873	93° 45' 39"	-1.564	23.790	1140638.385120	111592.225792
							倍面積	-1271.117057
							面積	635.5585285
							地積	635.55

画地面積(座標法)計算簿

画地番号：18-02

点名	Xn	Yn	距離	方向角	X _{n+1} -X _{n-1}	Y _{n+1} -Y _{n-1}	X _n *(Y _{n+1} -Y _{n-1})	Y _n *(X _{n+1} -X _{n-1})
18-31	47972.741	-71339.861	27.255	183° 48' 51"	-27.157	-4.229	-202876.721689	1937376.605177
18-32	47945.546	-71341.674	4.644	93° 45' 56"	-27.500	2.821	135254.385266	1961896.035000
18-19	47945.241	-71337.040	27.369	3° 49' 01"	27.004	6.456	309534.475896	-1926385.428160
18-16	47972.550	-71335.218	2.232	273° 55' 49"	27.462	-0.405	-19428.882750	-1959007.756716
18-07	47972.703	-71337.445	2.416	270° 54' 04"	0.191	-4.643	-222737.260029	-13625.451995
							倍面積	-254.003306
							面積	127.0016530
							地積	127.00

画地面積(座標法)計算簿

画地番号：18-03

点名	X _n	Y _n	距離	方向角	X _{n+1} -X _{n-1}	Y _{n+1} -Y _{n-1}	X _n *(Y _{n+1} -Y _{n-1})	Y _n *(X _{n+1} -X _{n-1})
18-29	47944.938	-71332.298	27.356	3° 48' 53"	26.993	6.562	314614.683156	-1925472.719914
18-30	47972.234	-71330.478	4.750	273° 48' 51"	27.612	-2.920	-140078.923280	-1969577.158536
18-16	47972.550	-71335.218	27.369	183° 49' 01"	-26.993	-6.562	-314795.873100	1925551.539474
18-19	47945.241	-71337.040	4.751	93° 39' 22"	-27.612	2.920	140000.103720	1969758.348480
							倍面積	-260.009504
							面積	130.0047520
							地積	130.00

画地面積(座標法)計算簿

画地番号：18-04

点名	Xn	Yn	距離	方向角	X _{n+1} -X _{n-1}	Y _{n+1} -Y _{n-1}	X _n *(Y _{n+1} -Y _{n-1})	Y _n *(X _{n+1} -X _{n-1})
18-29	47944.938	-71332.298	23.237	93° 39' 33"	-28.779	21.370	1024583.325060	2052872.204142
18-15	47943.455	-71309.108	27.291	3° 47' 54"	25.749	24.998	1198490.488090	-1836138.221892
18-05	47970.687	-71307.300	23.229	273° 49' 07"	28.779	-21.370	-1025133.581190	-2052152.786700
18-30	47972.234	-71330.478	27.356	183° 48' 53"	-25.749	-24.998	-1199209.905532	1836688.478022
倍面積								-1269.673572
面積								634.8367860
地積								634.83

画地面積(座標法)計算簿

画地番号：18-05-1

点名	X _n	Y _n	距離	方向角	X _{n+1} -X _{n-1}	Y _{n+1} -Y _{n-1}	X _n *(Y _{n+1} -Y _{n-1})	Y _n *(X _{n+1} -X _{n-1})
18-17	47947.110	-71365.464	22.899	183° 49' 15"	-21.867	-16.462	-789305.324820	1560548.601288
18-18	47924.261	-71366.990	14.968	93° 48' 55"	-23.845	13.409	642616.415749	1701745.876550
18-34	47923.265	-71352.055	22.913	3° 49' 16"	21.867	16.462	788912.788430	-1560255.386685
18-33	47946.128	-71350.528	14.968	273° 45' 42"	23.845	-13.409	-642909.630352	-1701353.340160
							倍面積	-685.750993
							面積	342.8754965
							地積	342.87

画地面積(座標法)計算簿

画地番号：18-05-2

点名	Xn	Yn	距離	方向角	X _{n+1} -X _{n-1}	Y _{n+1} -Y _{n-1}	X _n *(Y _{n+1} -Y _{n-1})	Y _n *(X _{n+1} -X _{n-1})
18-33	47946.128	-71350.528	22.913	183° 49' 16"	-22.281	-10.381	-497728.754768	1589761.114368
18-34	47923.265	-71352.055	41.516	93° 48' 58"	-25.626	39.897	1911994.503705	1828467.761430
18-14	47920.502	-71310.631	23.003	3° 47' 46"	20.190	42.947	2058041.799394	-1439761.639890
18-15	47943.455	-71309.108	23.237	273° 39' 33"	24.436	-21.667	-1038790.839485	-1742509.363088
18-29	47944.938	-71332.298	4.751	273° 39' 22"	1.786	-27.932	-1339198.008216	-127399.484228
18-19	47945.241	-71337.040	4.644	273° 45' 56"	0.608	-9.376	-449534.579616	-43372.920320
18-32	47945.546	-71341.674	8.873	273° 45' 39"	0.887	-13.488	-646689.524448	-63280.064838
							倍面積	-1905.403434
							面積	952.7017170
							地積	952.70

画地面積(座標法)計算簿

画地番号：18-06

点名	Xn	Yn	距離	方向角	X _{n+1} -X _{n-1}	Y _{n+1} -Y _{n-1}	X _n *(Y _{n+1} -Y _{n-1})	Y _n *(X _{n+1} -X _{n-1})
18-14	47920.502	-71310.631	41.516	273° 48' 58"	33.675	-39.371	-1886678.084242	-2401385.498925
18-34	47923.265	-71352.055	14.968	273° 48' 55"	3.759	-56.359	-2700907.292135	-268212.374745
18-18	47924.261	-71366.990	30.983	183° 49' 11"	-29.919	-16.999	-814664.512739	2135228.973810
18-11	47893.346	-71369.054	16.360	93° 50' 03"	-32.009	14.260	682959.113960	2284452.049486
18-28	47892.252	-71352.730	13.868	93° 46' 29"	-2.007	30.162	1444526.104824	143204.929110
18-12	47891.339	-71338.892	26.266	93° 49' 05"	-2.662	40.046	1917856.561594	189904.130504
18-10	47889.590	-71312.684	30.980	3° 47' 59"	29.163	28.261	1353407.702990	-2079691.803492
							倍面積	-3500.405748
							面積	1750.2028740
							地積	1750.20

画地面積(座標法)計算簿

画地番号：18-07

点名	Xn	Yn	距離	方向角	X _{n+1} -X _{n-1}	Y _{n+1} -Y _{n-1}	X _n *(Y _{n+1} -Y _{n-1})	Y _n *(X _{n+1} -X _{n-1})
18-13	47881.727	-71339.529	26.265	93° 48' 57"	-11.360	25.570	1224335.759390	810417.049440
18-09	47879.979	-71313.322	9.632	3° 47' 52"	7.863	26.845	1285338.036255	-560736.650886
18-10	47889.590	-71312.684	26.266	273° 49' 05"	11.360	-25.570	-1224536.816300	-810112.090240
18-12	47891.339	-71338.892	9.633	183° 47' 29"	-7.863	-26.845	-1285642.995455	560937.707796
倍面積								-506.016110
面積								253.0080550
地積								253.00

画地面積(座標法)計算簿

画地番号：18-08

点名	Xn	Yn	距離	方向角	X _{n+1} -X _{n-1}	Y _{n+1} -Y _{n-1}	X _n *(Y _{n+1} -Y _{n-1})	Y _n *(X _{n+1} -X _{n-1})
18-09	47879.979	-71313.322	26.265	273° 48' 57"	28.364	-24.439	-1170138.806781	-2022731.065208
18-13	47881.727	-71339.529	10.663	183° 48' 06"	-8.892	-26.914	-1288688.800478	634351.091868
18-21	47871.087	-71340.236	18.834	183° 49' 25"	-29.433	-1.963	-93970.943781	2099757.166188
18-08	47852.294	-71341.492	23.433	93° 50' 03"	-20.360	22.125	1058732.004750	1452512.777120
18-03	47850.727	-71318.111	4.009	48° 53' 36"	1.069	26.402	1263354.894254	-76239.060659
18-04	47853.363	-71315.090	26.674	3° 48' 01"	29.252	4.789	229169.755407	-2086109.012680
							倍面積	-1541.896629
							面積	770.9483145
							地積	770.94

画地面積(座標法)計算簿

画地番号：18-09

点名	Xn	Yn	距離	方向角	X _{n+1} -X _{n-1}	Y _{n+1} -Y _{n-1}	X _n *(Y _{n+1} -Y _{n-1})	Y _n *(X _{n+1} -X _{n-1})
18-20	47853.284	-71356.443	18.834	3° 48' 30"	19.783	-13.700	-655589.990800	-1411644.511869
18-22	47872.077	-71355.192	14.988	93° 47' 14"	17.803	16.207	775862.751939	-1270336.483176
18-21	47871.087	-71340.236	18.834	183° 49' 25"	-19.783	13.700	655833.891900	1411323.888788
18-08	47852.294	-71341.492	14.983	273° 47' 18"	-17.803	-16.207	-775542.128858	1270092.582076
							倍面積	564.524181
							面積	282.2620905
							地積	282.26

画地面積(座標法)計算簿

画地番号：18-10

点名	X _n	Y _n	距離	方向角	X _{n+1} -X _{n-1}	Y _{n+1} -Y _{n-1}	X _n *(Y _{n+1} -Y _{n-1})	Y _n *(X _{n+1} -X _{n-1})
18-02	47854.101	-71368.838	4.013	318° 47' 19"	3.836	-15.039	-719677.824939	-273770.862568
18-01	47857.120	-71371.482	14.490	3° 51' 29"	17.477	-1.669	-79873.533280	-1247359.390914
18-24	47871.578	-71370.507	2.110	48° 13' 36"	15.864	2.549	122024.652322	-1132221.723048
18-23	47872.984	-71368.933	13.770	93° 46' 35"	0.499	15.315	733174.749960	-35613.097567
18-22	47872.077	-71355.192	18.834	183° 48' 30"	-19.700	12.490	597922.241730	1405697.282400
18-20	47853.284	-71356.443	12.421	273° 46' 16"	-17.976	-13.646	-653005.913464	1282703.419368
							倍面積	564.372329
							面積	282.1861645
							地積	282.18

画地面積(座標法)計算簿

画地番号：18-11

点名	Xn	Yn	距離	方向角	X _{n+1} -X _{n-1}	Y _{n+1} -Y _{n-1}	X _n *(Y _{n+1} -Y _{n-1})	Y _n *(X _{n+1} -X _{n-1})
18-24	47871.578	-71370.507	6.004	3° 48' 37"	4.585	-1.175	-56249.104150	-327233.774595
18-25	47877.569	-71370.108	2.124	138° 54' 47"	4.390	1.795	85940.236355	-313314.774120
18-26	47875.968	-71368.712	14.870	93° 46' 43"	-2.581	16.234	777218.464512	184202.645672
18-27	47874.988	-71353.874	17.301	3° 47' 28"	16.284	15.982	765138.058216	-1161926.484216
18-28	47892.252	-71352.730	13.868	93° 46' 29"	16.351	14.982	717521.719464	-1166688.488230
18-12	47891.339	-71338.892	9.633	183° 47' 29"	-10.525	13.201	632213.566139	750841.838300
18-13	47881.727	-71339.529	10.663	183° 48' 06"	-20.252	-1.344	-64353.041088	1444768.141308
18-21	47871.087	-71340.236	14.988	273° 47' 14"	-9.650	-15.663	-749804.835681	688433.277400
18-22	47872.077	-71355.192	13.770	273° 46' 35"	1.897	-28.697	-1373784.993669	-135360.799224
18-23	47872.984	-71368.933	2.110	228° 13' 36"	-0.499	-15.315	-733174.749960	35613.097567
							倍面積	665.320138
							面積	332.6600690
							地積	332.66

画地面積(座標法)計算簿

画地番号：18-12

点名	Xn	Yn	距離	方向角	$X_{n+1}-X_{n-1}$	$Y_{n+1}-Y_{n-1}$	$X_n*(Y_{n+1}-Y_{n-1})$	$Y_n*(X_{n+1}-X_{n-1})$
18-26	47875.968	-71368.712	2.124	318° 54' 47"	2.581	-16.234	-777218.464512	-184202.645672
18-25	47877.569	-71370.108	15.812	3° 49' 19"	17.378	-0.342	-16374.128598	-1240269.736824
18-11	47893.346	-71369.054	16.360	93° 50' 03"	14.683	17.378	832290.566788	-1047911.819882
18-28	47892.252	-71352.730	17.301	183° 47' 28"	-18.358	15.180	727004.385360	1309893.417340
18-27	47874.988	-71353.874	14.870	273° 46' 43"	-16.284	-15.982	-765138.058216	1161926.484216
							倍面積	564.300822
							面積	282.1504110
							地積	282.15