



# 25街区 画地出来形確認図 (5894.03m<sup>2</sup>)

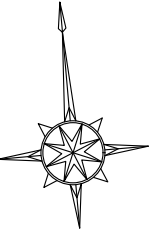

S=1:500

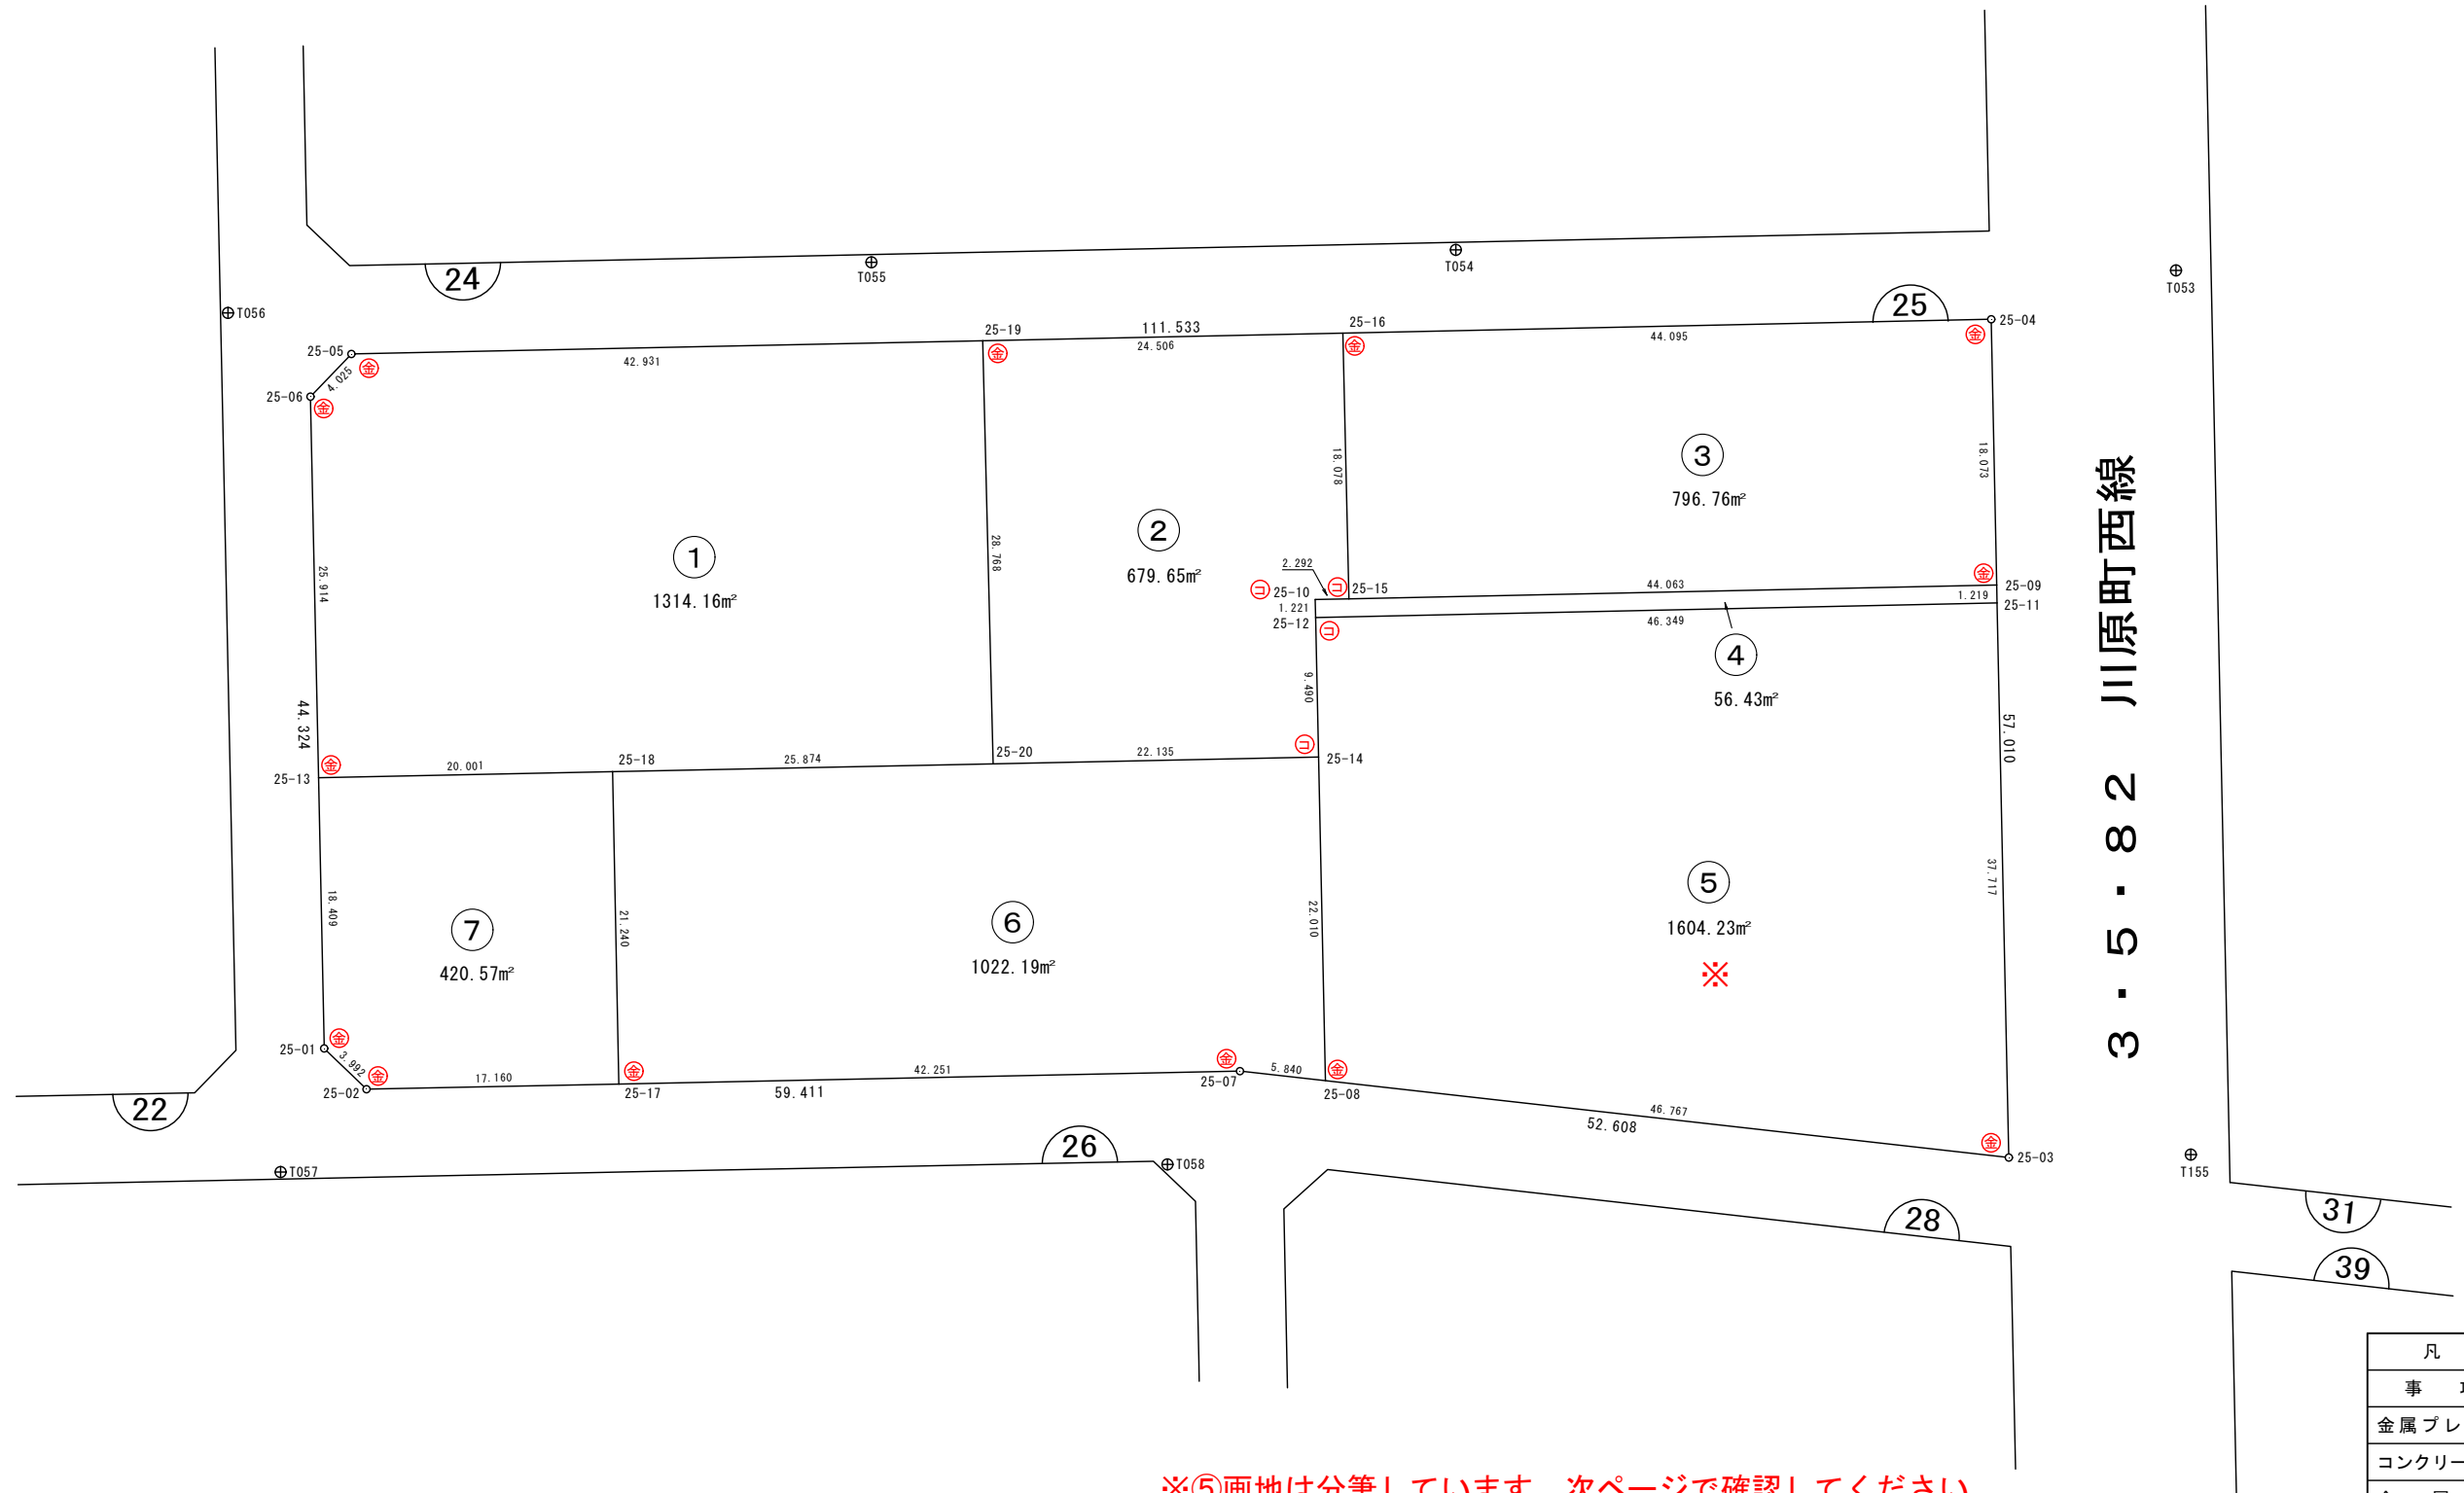

※⑤画地は分筆しています。次ページで確認してください。

凡 例	
事 項	記 号
金属プレート	⊕
コンクリート杭	⊖
金属鉄	⊗
合成樹脂杭	⊕
マーキング	⊗

24-02  

24-03  
(1401.54m<sup>2</sup>)

24-05  
(1435.60m<sup>2</sup>)

S=1:500

道路29  
(670.02m<sup>2</sup>)

25-02  
(679.65m<sup>2</sup>)

25-03  
(796.76m<sup>2</sup>)

道路02  
(3397.94m<sup>2</sup>)

25-04  
(56.43m<sup>2</sup>)

25-8  
(811.94m<sup>2</sup>)

25-06  
(1022.19m<sup>2</sup>)

25-11  
(214.02m<sup>2</sup>)

25-10  
(247.96m<sup>2</sup>)

25-9  
(330.31m<sup>2</sup>)

道路30  
(97.69m<sup>2</sup>)

26-05  
(165.74m<sup>2</sup>)

26-06  
(166.87m<sup>2</sup>)

28-01  
(217.76m<sup>2</sup>)

26-12  
(164.06m<sup>2</sup>)

26-07  
(165.50m<sup>2</sup>)

28-02  
(929.60m<sup>2</sup>)

26-09  
(51.40m<sup>2</sup>)

26-08  
(1.98m<sup>2</sup>)

道路26  
(298.06m<sup>2</sup>)







26-14  
(165.49m<sup>2</sup>)

26-13  
(170.77m<sup>2</sup>)







28-06  
(743.24m<sup>2</sup>)

28-05  
(139.00m<sup>2</sup>)

28-03  
(512.60m<sup>2</sup>)

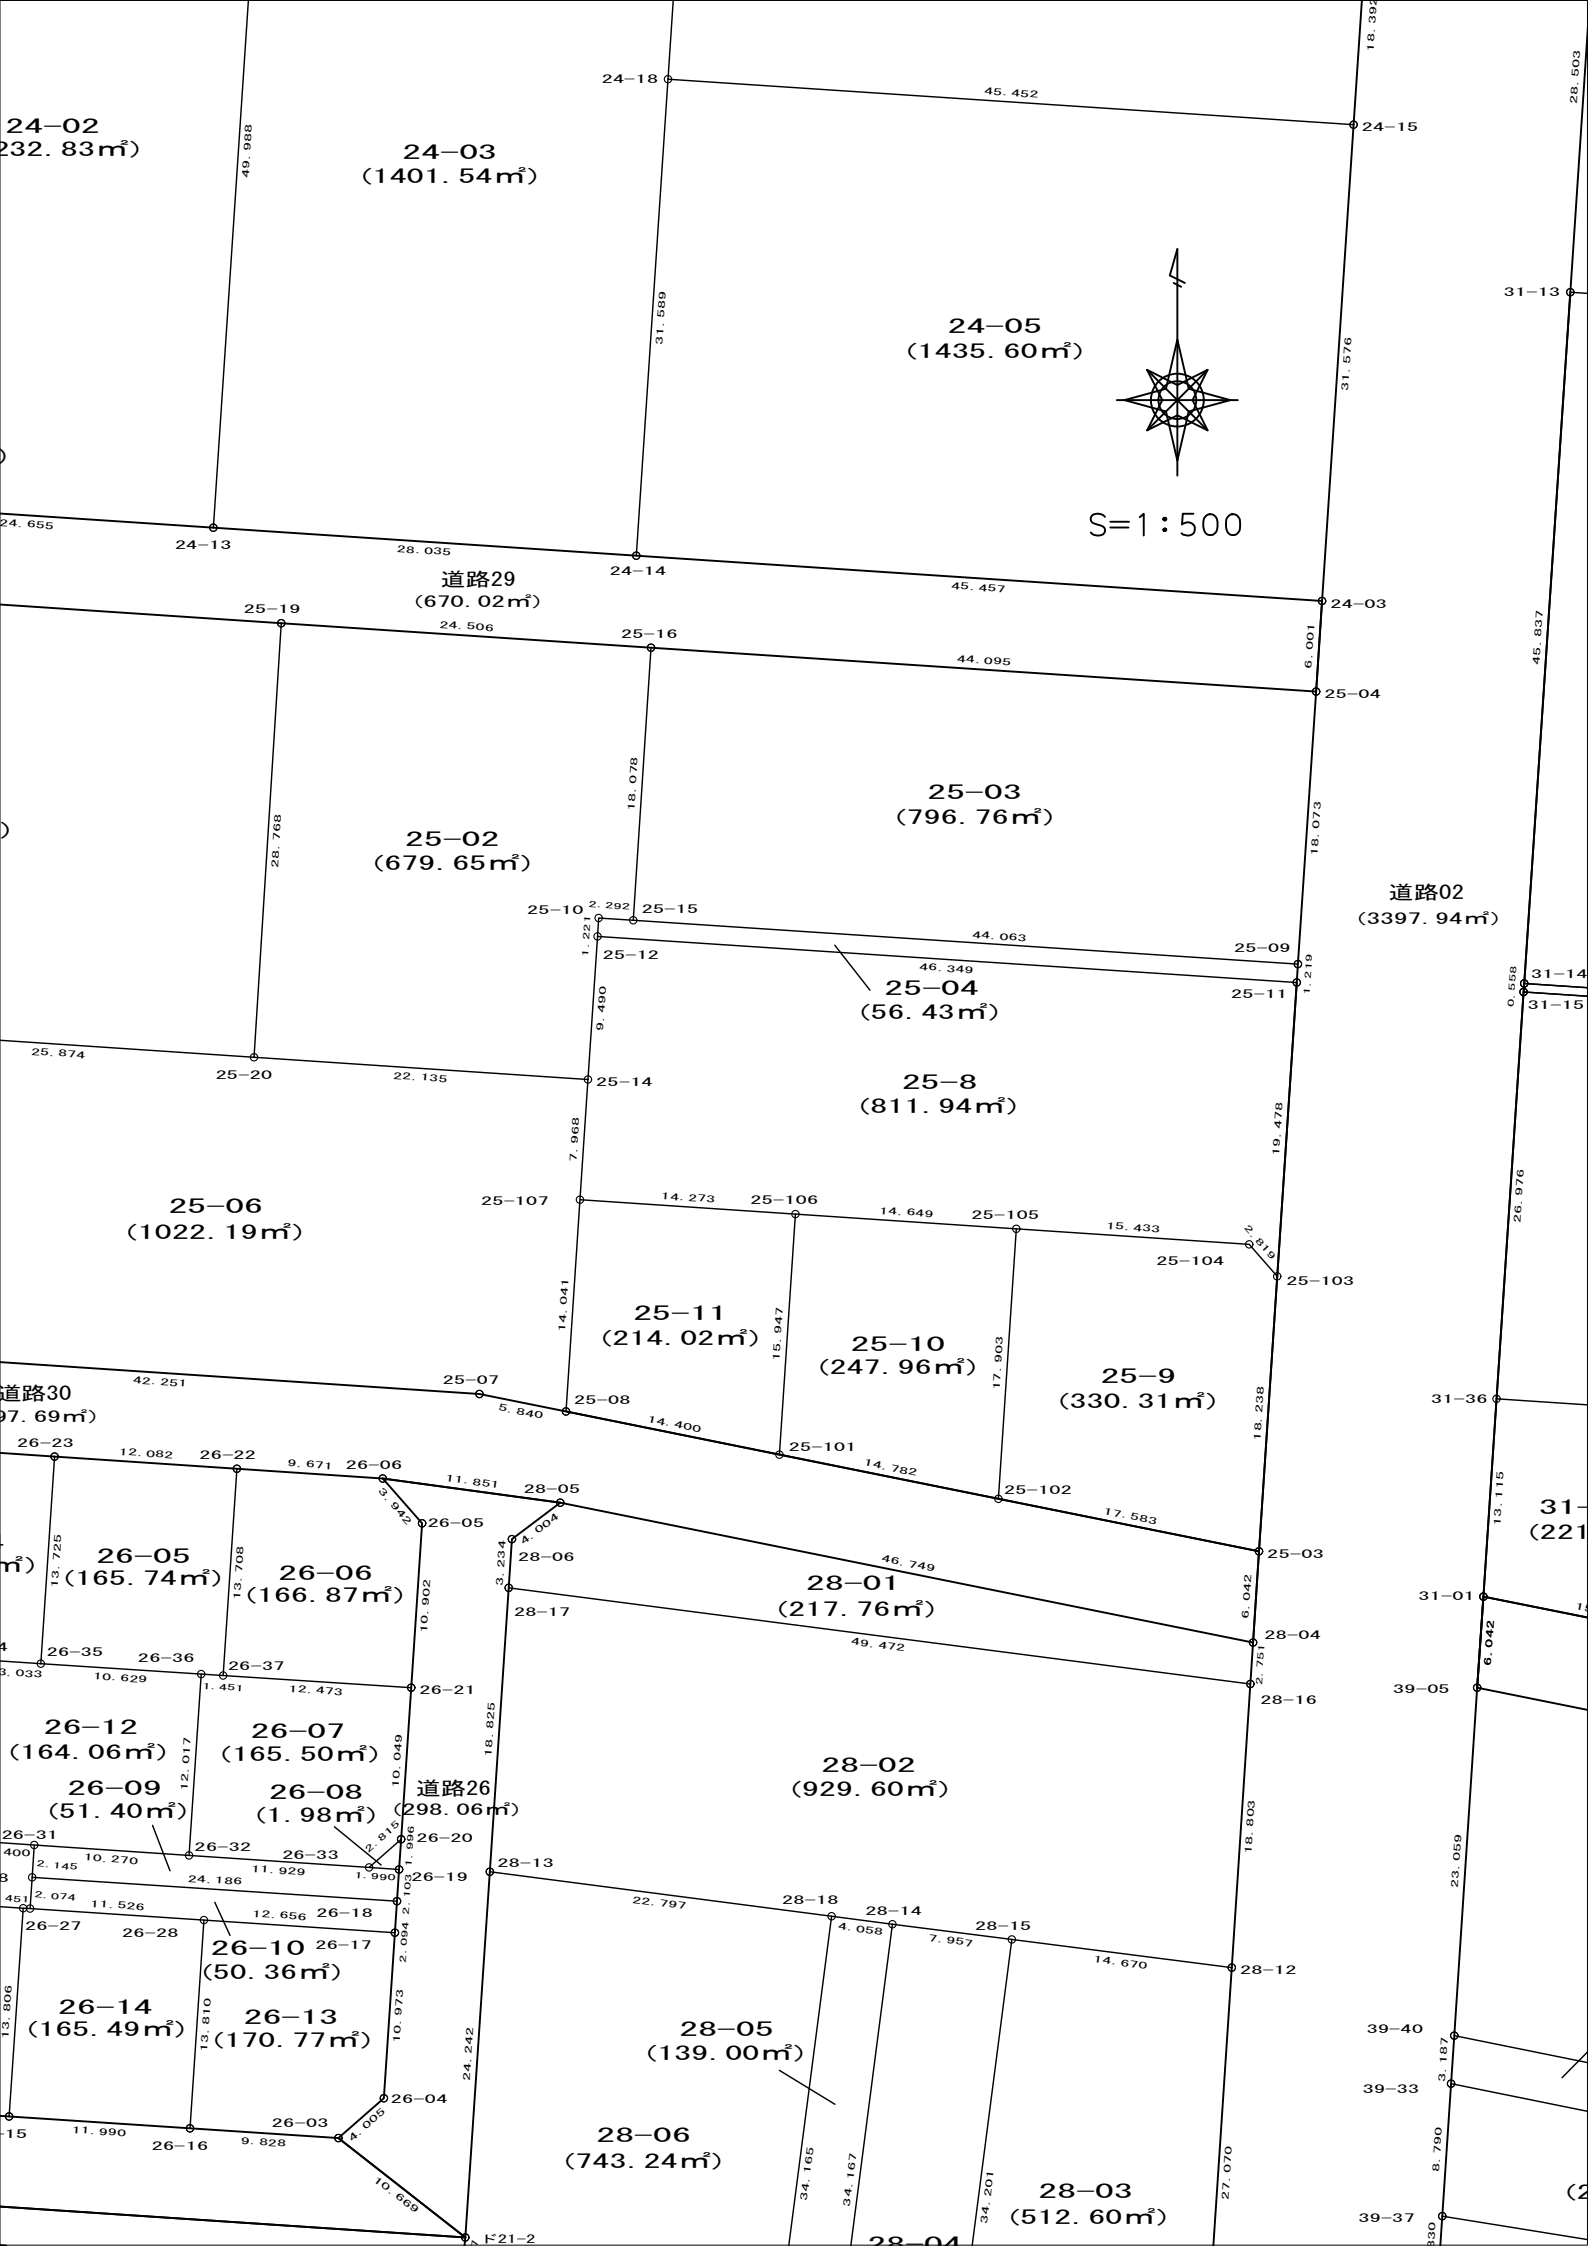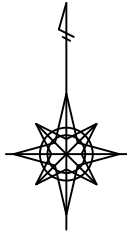

## 画地面積(座標法)計算簿

画地番号：25-01

点名	Xn	Yn	距離	方向角	X <sub>n+1</sub> -X <sub>n-1</sub>	Y <sub>n+1</sub> -Y <sub>n-1</sub>	X <sub>n</sub> *(Y <sub>n+1</sub> -Y <sub>n-1</sub> )	Y <sub>n</sub> *(X <sub>n+1</sub> -X <sub>n-1</sub> )
25-20	47823.223	-71210.967	28.768	3° 35' 07"	26.990	27.616	1320686.126368	-1921983.999330
25-19	47851.935	-71209.168	42.931	273° 48' 28"	31.563	-41.038	-1963747.708530	-2247574.969584
25-05	47854.786	-71252.005	4.025	228° 47' 48"	0.199	-45.866	-2194907.614676	-14179.148995
25-06	47852.134	-71255.034	25.914	183° 46' 37"	-28.510	-4.736	-226627.706624	2031481.019340
25-13	47826.276	-71256.741	20.001	93° 48' 56"	-27.189	18.250	872829.537000	1937399.531049
25-18	47824.945	-71236.784	25.874	93° 48' 58"	-3.053	45.774	2189139.032430	217485.901552
							倍面積	-2628.334032
							面積	1314.1670160
							地積	1314.16

## 画地面積(座標法)計算簿

画地番号：25-02

点名	X <sub>n</sub>	Y <sub>n</sub>	距離	方向角	X <sub>n+1</sub> -X <sub>n-1</sub>	Y <sub>n+1</sub> -Y <sub>n-1</sub>	X <sub>n</sub> *(Y <sub>n+1</sub> -Y <sub>n-1</sub> )	Y <sub>n</sub> *(X <sub>n+1</sub> -X <sub>n-1</sub> )
25-19	47851.935	-71209.168	28.768	183° 35' 07"	-27.100	-26.252	-1256208.997620	1929768.452800
25-20	47823.223	-71210.967	22.135	93° 48' 46"	-30.184	20.288	970237.548224	2149431.827928
25-14	47821.751	-71188.880	9.490	3° 48' 22"	7.998	22.717	1086366.717467	-569368.662240
25-12	47831.221	-71188.250	1.221	3° 31' 15"	10.689	0.705	33721.010805	-760931.204250
25-10	47832.440	-71188.175	2.292	93° 55' 38"	1.062	2.362	112980.223280	-75601.841850
25-15	47832.283	-71185.888	18.078	3° 43' 13"	17.883	3.460	165499.699180	-1273017.235104
25-16	47850.323	-71184.715	24.506	273° 46' 18"	19.652	-23.280	-1113955.519440	-1398922.019180
							倍面積	-1359.318104
							面積	679.6590520
							地積	679.65

## 画地面積(座標法)計算簿

画地番号：25-03

点名	X <sub>n</sub>	Y <sub>n</sub>	距離	方向角	X <sub>n+1</sub> -X <sub>n-1</sub>	Y <sub>n+1</sub> -Y <sub>n-1</sub>	X <sub>n</sub> *(Y <sub>n+1</sub> -Y <sub>n-1</sub> )	Y <sub>n</sub> *(X <sub>n+1</sub> -X <sub>n-1</sub> )
25-15	47832.283	-71185.888	18.078	3° 43' 13"	20.937	-42.795	-2046982.550985	-1490418.937056
25-16	47850.323	-71184.715	44.095	93° 46' 34"	15.136	45.173	2161542.640879	-1077451.846240
25-04	47847.419	-71140.715	18.073	183° 49' 23"	-20.937	42.795	2047630.296105	1489473.149955
25-09	47829.386	-71141.920	44.063	273° 46' 11"	-15.136	-45.173	-2160596.853778	1076804.101120
<b>倍面積</b>								1593.532221
<b>面積</b>								796.7661105
<b>地積</b>								796.76

## 画地面積(座標法)計算簿

画地番号：25-04

点名	Xn	Yn	距離	方向角	X <sub>n+1</sub> -X <sub>n-1</sub>	Y <sub>n+1</sub> -Y <sub>n-1</sub>	X <sub>n</sub> *(Y <sub>n+1</sub> -Y <sub>n-1</sub> )	Y <sub>n</sub> *(X <sub>n+1</sub> -X <sub>n-1</sub> )
25-12	47831.221	-71188.250	46.349	93° 46' 32"	-4.271	46.174	2208558.798454	304045.015750
25-11	47828.169	-71142.001	1.219	3° 48' 28"	-1.835	46.330	2215879.069770	130545.571835
25-09	47829.386	-71141.920	44.063	273° 46' 11"	4.114	-43.887	-2099088.263382	-292677.858880
25-15	47832.283	-71185.888	2.292	273° 55' 38"	3.054	-46.255	-2212482.250165	-217401.701952
25-10	47832.440	-71188.175	1.221	183° 31' 15"	-1.062	-2.362	-112980.223280	75601.841850
							倍面積	-112.868603
							面積	56.4343015
							地積	56.43

## 画地面積(座標法)計算簿

画地番号：25- 8

点名	X <sub>n</sub>	Y <sub>n</sub>	距離	方向角	X <sub>n+1</sub> -X <sub>n-1</sub>	Y <sub>n+1</sub> -Y <sub>n-1</sub>	X <sub>n</sub> *(Y <sub>n+1</sub> -Y <sub>n-1</sub> )	Y <sub>n</sub> *(X <sub>n+1</sub> -X <sub>n-1</sub> )
25-12	47831.221	-71188.250	9.490	183° 48' 22"	-6.418	-46.879	-2242279.809259	456886.188500
25-14	47821.751	-71188.880	7.968	183° 47' 31"	-17.421	-1.157	-55329.765907	1240181.478480
25-107	47813.800	-71189.407	14.273	93° 48' 44"	-8.900	13.715	655766.267000	633585.722300
25-106	47812.851	-71175.165	14.649	93° 48' 44"	-1.923	28.859	1379831.067009	136869.842295
25-105	47811.877	-71160.548	15.433	93° 48' 43"	-2.000	30.016	1435121.300032	142321.096000
25-104	47810.851	-71145.149	2.819	138° 41' 44"	-3.144	17.260	825215.288260	223680.348456
25-103	47808.733	-71143.288	19.478	3° 47' 18"	17.318	3.148	150501.891484	-1232059.461584
25-11	47828.169	-71142.001	46.349	273° 46' 32"	22.488	-44.962	-2150450.134578	-1599841.318488
							倍面積	-1623.895959
							面積	811.9479795
							地積	811.94

## 画地面積(座標法)計算簿

画地番号：25- 9

点名	Xn	Yn	距離	方向角	X <sub>n+1</sub> -X <sub>n-1</sub>	Y <sub>n+1</sub> -Y <sub>n-1</sub>	X <sub>n</sub> *(Y <sub>n+1</sub> -Y <sub>n-1</sub> )	Y <sub>n</sub> *(X <sub>n+1</sub> -X <sub>n-1</sub> )
25-105	47811.877	-71160.548	17.903	183° 47' 08"	-16.838	-16.581	-792768.732537	1198201.307224
25-102	47794.013	-71161.730	17.583	101° 24' 42"	-21.343	16.054	767285.084702	1518804.803390
25-03	47790.534	-71144.494	18.238	3° 47' 29"	14.720	18.442	881353.028028	-1047246.951680
25-103	47808.733	-71143.288	2.819	318° 41' 44"	20.317	-0.655	-31314.720115	-1445418.182296
25-104	47810.851	-71145.149	15.433	273° 48' 43"	3.144	-17.260	-825215.288260	-223680.348456
							倍面積	-660.628182
							面積	330.3140910
							地積	330.31



## 画地面積(座標法)計算簿

画地番号：25-10

点名	X <sub>n</sub>	Y <sub>n</sub>	距離	方向角	X <sub>n+1</sub> -X <sub>n-1</sub>	Y <sub>n+1</sub> -Y <sub>n-1</sub>	X <sub>n</sub> *(Y <sub>n+1</sub> -Y <sub>n-1</sub> )	Y <sub>n</sub> *(X <sub>n+1</sub> -X <sub>n-1</sub> )
25-106	47812.851	-71175.165	15.947	183° 47' 35"	-14.939	-15.672	-749323.000872	1063285.789935
25-101	47796.938	-71176.220	14.782	101° 24' 45"	-18.838	13.435	642151.862030	1340817.632360
25-102	47794.013	-71161.730	17.903	3° 47' 08"	14.939	15.672	749027.771736	-1063085.084470
25-105	47811.877	-71160.548	14.649	273° 48' 44"	18.838	-13.435	-642352.567495	-1340522.403224
							倍面積	-495.934601
							面積	247.9673005
							地積	247.96

## 画地面積(座標法)計算簿

画地番号：25-11

点名	Xn	Yn	距離	方向角	X <sub>n+1</sub> -X <sub>n-1</sub>	Y <sub>n+1</sub> -Y <sub>n-1</sub>	X <sub>n</sub> *(Y <sub>n+1</sub> -Y <sub>n-1</sub> )	Y <sub>n</sub> *(X <sub>n+1</sub> -X <sub>n-1</sub> )
25-107	47813.800	-71189.407	14.041	183° 47' 22"	-13.062	-15.170	-725335.346000	929876.034234
25-08	47799.789	-71190.335	14.400	101° 25' 09"	-16.862	13.187	630335.817543	1200411.428770
25-101	47796.938	-71176.220	15.947	3° 47' 35"	13.062	15.170	725079.549460	-929703.785640
25-106	47812.851	-71175.165	14.273	273° 48' 44"	16.862	-13.187	-630508.066137	-1200155.632230
<b>倍面積</b>								-428.045134
<b>面積</b>								214.0225670
<b>地積</b>								214.02

## 画地面積(座標法)計算簿

画地番号：25-06

点名	Xn	Yn	距離	方向角	X <sub>n+1</sub> -X <sub>n-1</sub>	Y <sub>n+1</sub> -Y <sub>n-1</sub>	X <sub>n</sub> *(Y <sub>n+1</sub> -Y <sub>n-1</sub> )	Y <sub>n</sub> *(X <sub>n+1</sub> -X <sub>n-1</sub> )
25-20	47823.223	-71210.967	25.874	273° 48' 58"	3.194	-47.904	-2290923.674592	-227447.828598
25-18	47824.945	-71236.784	21.240	183° 52' 16"	-19.470	-27.251	-1303277.576195	1386980.184480
25-17	47803.753	-71238.218	42.251	93° 48' 33"	-23.999	40.724	1946760.037172	1709645.993782
25-07	47800.946	-71196.060	5.840	101° 25' 31"	-3.964	47.883	2288852.697318	282221.181840
25-08	47799.789	-71190.335	14.041	3° 47' 22"	12.854	6.653	318011.996217	-915080.566090
25-107	47813.800	-71189.407	7.968	3° 47' 31"	21.962	1.455	69569.079000	-1563461.756534
25-14	47821.751	-71188.880	22.135	273° 48' 46"	9.423	-21.560	-1031036.951560	-670812.816240
							倍面積	-2044.392640
							面積	1022.1963200
							地積	1022.19

## 画地面積(座標法)計算簿

画地番号：25-07

点名	X <sub>n</sub>	Y <sub>n</sub>	距離	方向角	X <sub>n+1</sub> -X <sub>n-1</sub>	Y <sub>n+1</sub> -Y <sub>n-1</sub>	X <sub>n</sub> *(Y <sub>n+1</sub> -Y <sub>n-1</sub> )	Y <sub>n</sub> *(X <sub>n+1</sub> -X <sub>n-1</sub> )
25-17	47803.753	-71238.218	21.240	3° 52' 16"	20.046	18.556	887046.440668	-1428041.318028
25-18	47824.945	-71236.784	20.001	273° 48' 56"	22.523	-18.523	-885861.456235	-1604466.086032
25-13	47826.276	-71256.741	18.409	183° 48' 44"	-17.038	-21.181	-1013008.351956	1214072.353158
25-01	47807.907	-71257.965	3.992	138° 53' 23"	-21.377	1.401	66978.877707	1523281.517805
25-02	47804.899	-71255.340	17.160	93° 49' 45"	-4.154	19.747	944003.340553	295994.682360
							倍面積	-841.149263
							面積	420.5746315
							地積	420.57